
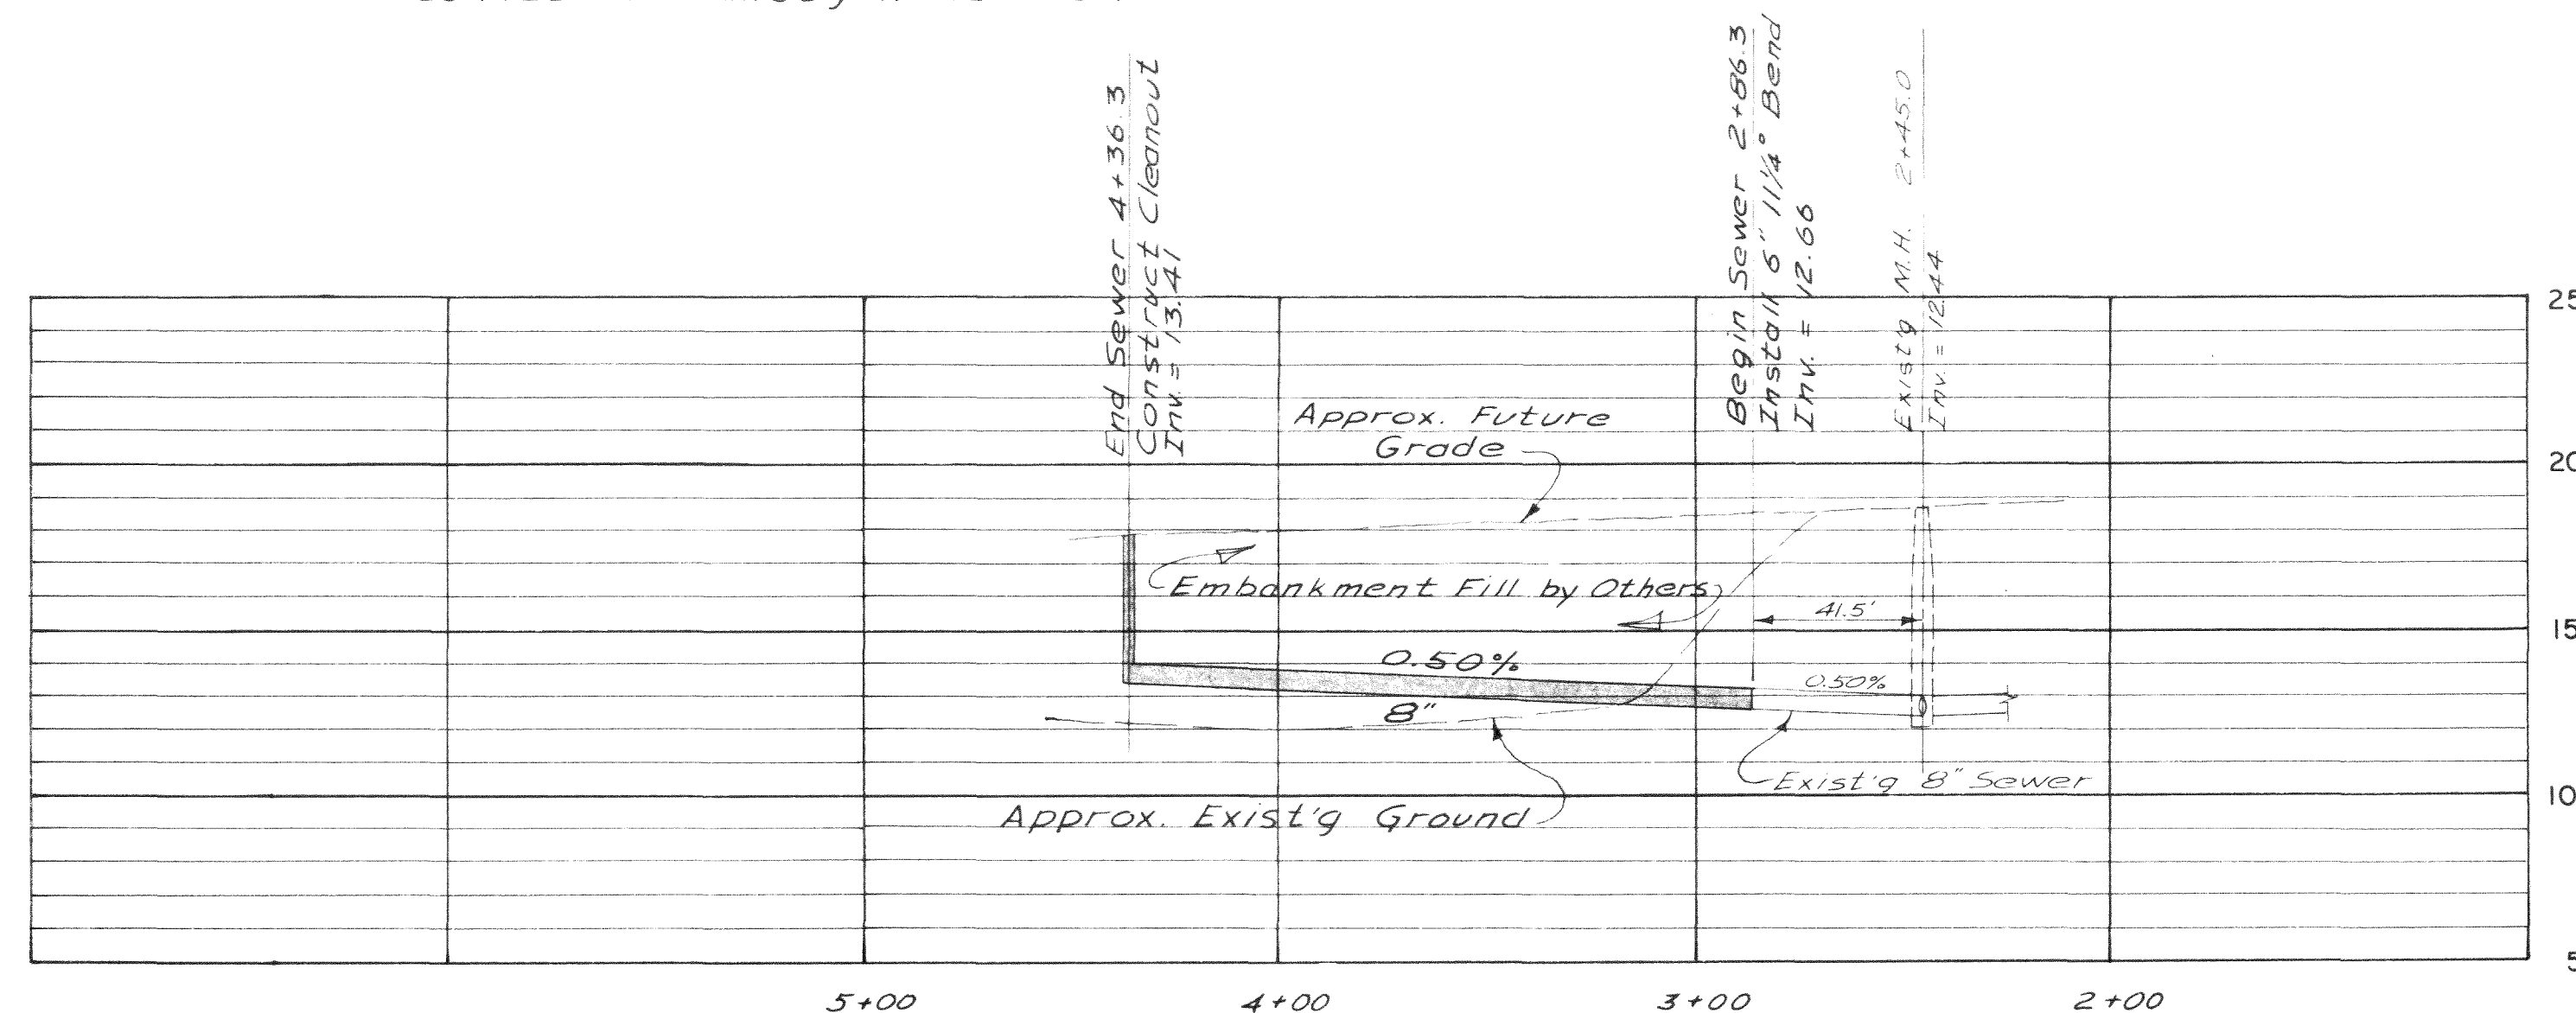


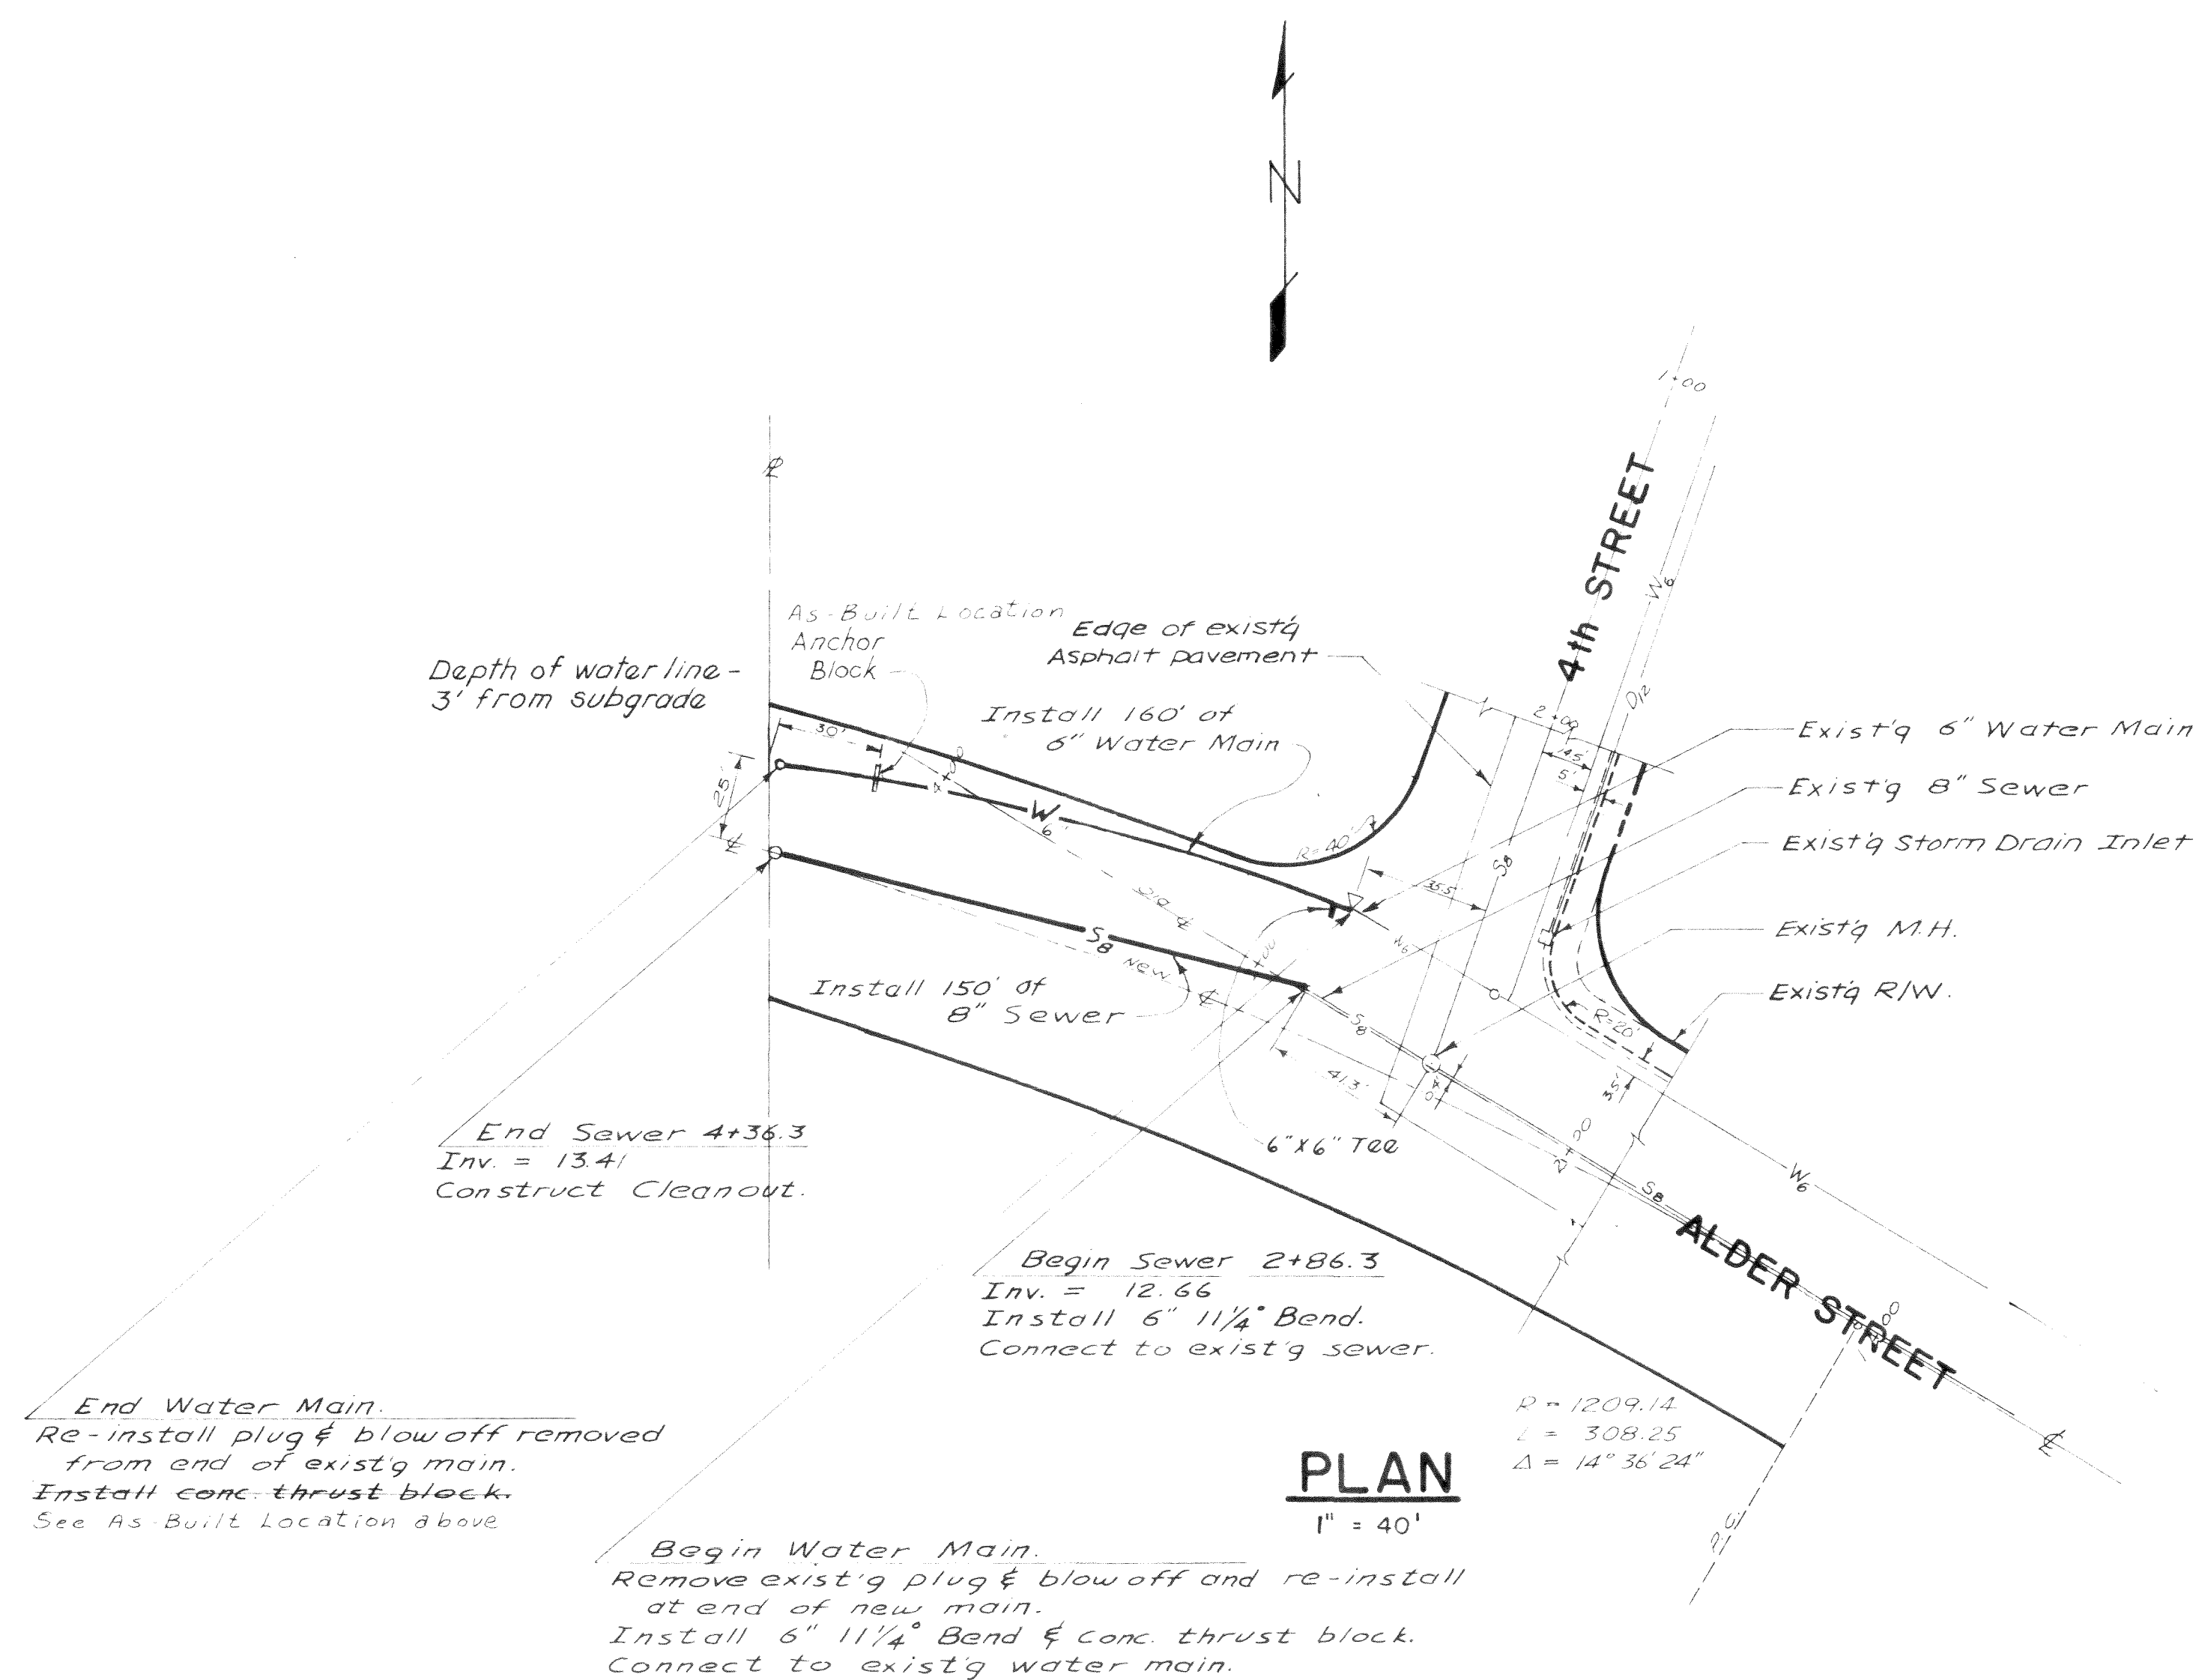

ALDER STREET

1" = 40' Hor.
1" = 5' Vert.

APPROVED FOR
CONSTRUCTION _____

Calvin M. Raper

7/03/80

PROJECT BENCH MARK:

U.S.G.S. Bronze Disk at S.E. End of S.W.
Sidewalk, River Bridge. ELEV. = 34.96

NOTE:

1. All workmanship and material shall conform to applicable provisions of the "Standard Specifications for Municipal Public Works Construction" prepared by the Washington State Chapter, A.P.W.A., and shall be subject to the approval of the City of Ferndale Utilities Department.
2. Sewer and water services shall be installed where directed in field.

AS-BUILT

2/25/81



FERNDALE PROPERTIES ALDER STREET WATER & SEWER EXT.

PLAN & PROFILE

GEORGE H. RAPER & ASSOCIATES
372 "H" Street
Blaine, WA. 98230

Scale: AS SHOWN Date: JULY 3, 80 Sheet 1 of 1

00374.001 12-10-08 AM

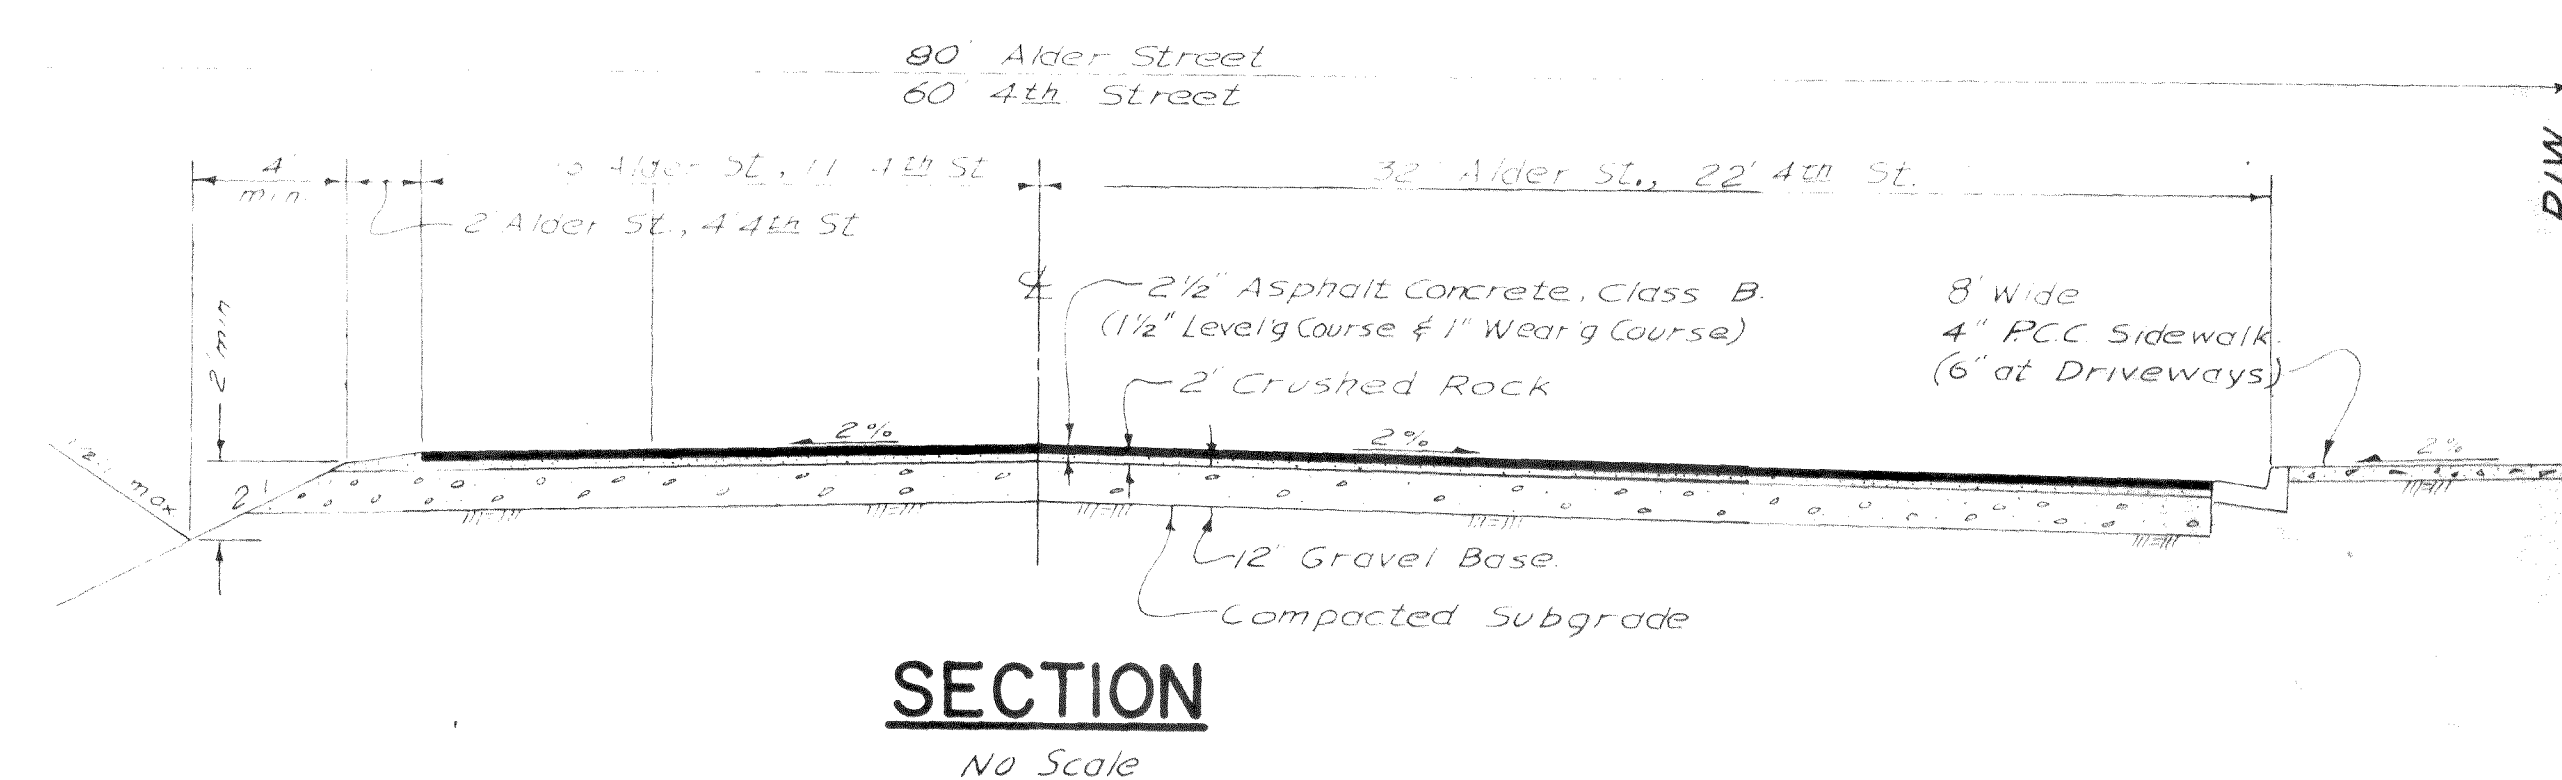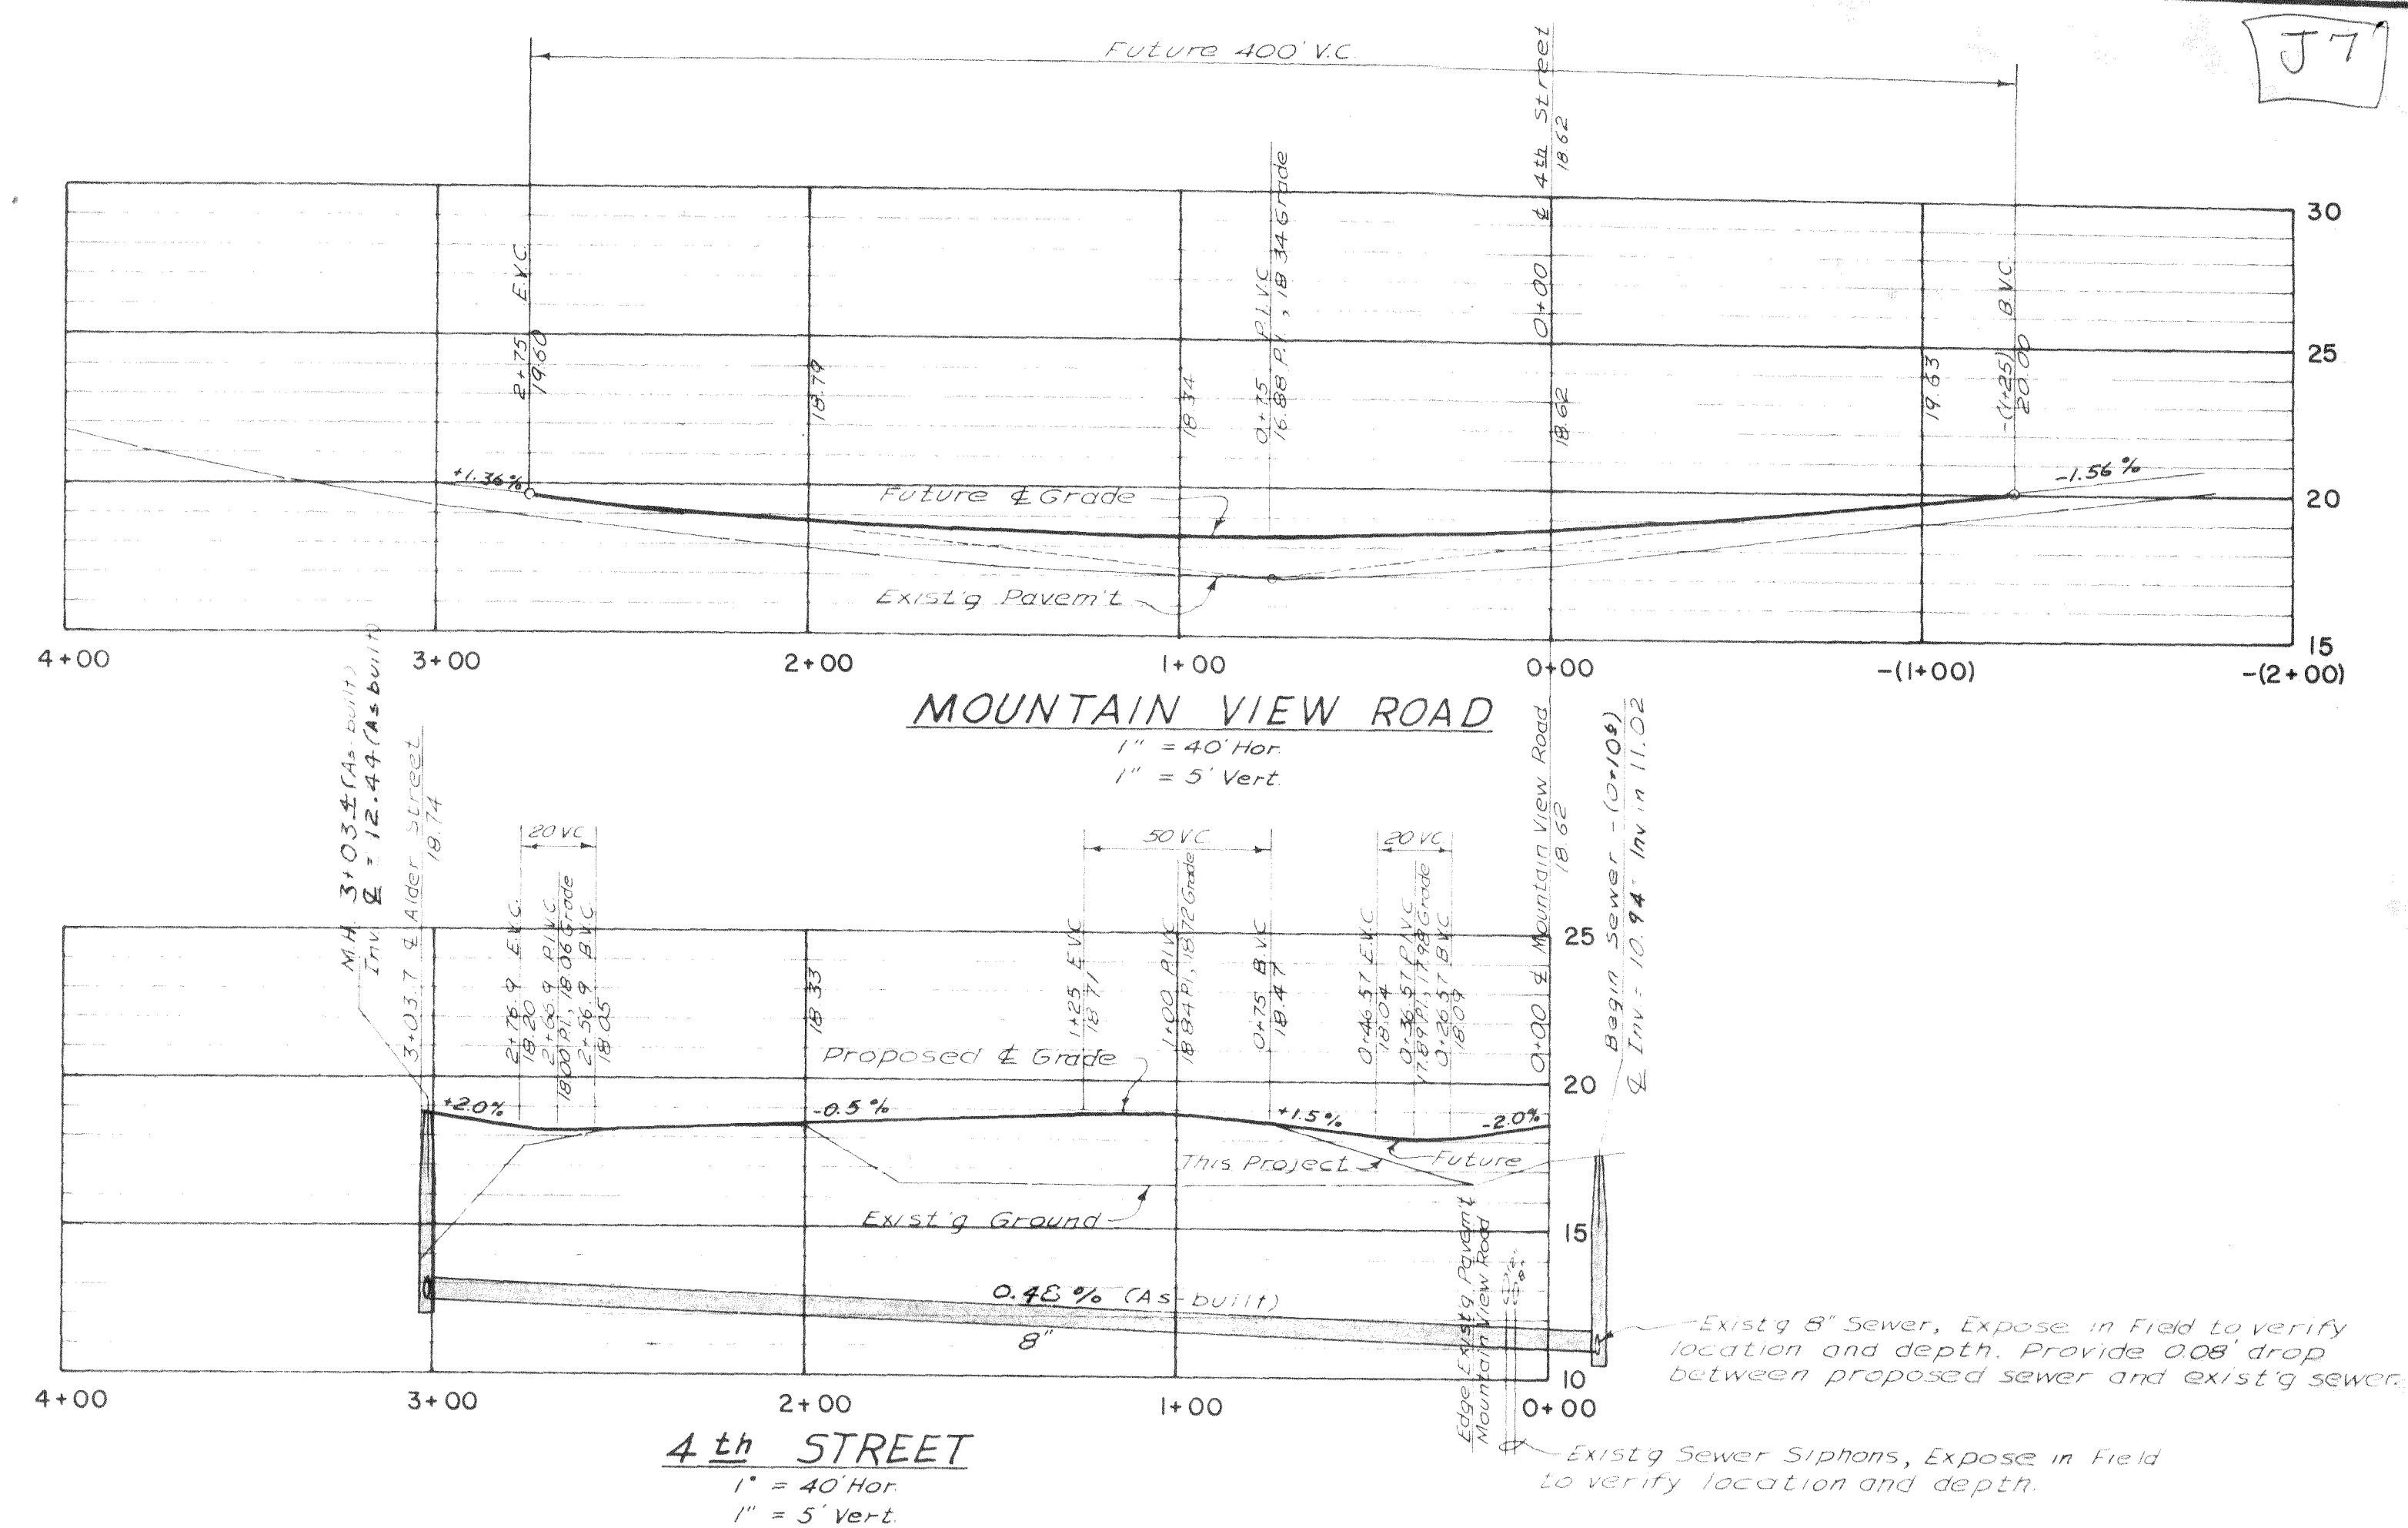

NOTE:

All workmanship and material shall conform to applicable provisions of the "Standard Specifications for Municipal Public Works Construction" prepared by the Washington State Chapter, APWA, and shall be subject to the approval of the City of Ferndale Utilities Department.

Contractor shall expose existg sewer at (10/13) and existg siphons, and verify locations and depths prior to constructing proposed sewer. (Adjustments to proposed elevations, if required, shall be computed by Engineer after existg sewer & siphons are exposed.)

Sewer and water services shall be installed where directed in field.

△ Sewer Stubout added on Alder Street. 6/07/77.

"AS-BUILT" 3/16/78
FERNDALE PROPERTIES SHORT PLAT
STORM DRAIN
WATER & SEWER
PLAN & PROFILE

GEORGE H. RAPER & ASSOCIATES
372 "H" Street

Blaine, Washington 98230



Book 26 Page 3 thru 6 Date 3/16/78 Scale As Shown

Book 26 Page 3 thru 6 Date 3/16/78 Scale As Shown

PROJECT BENCH MARK:

U.S.G.S. Bronze Disk at S.E. End of S.W. Sidewalk, River Bridge.
ELEV: = 34.96


00374.003 12-10-08 AM

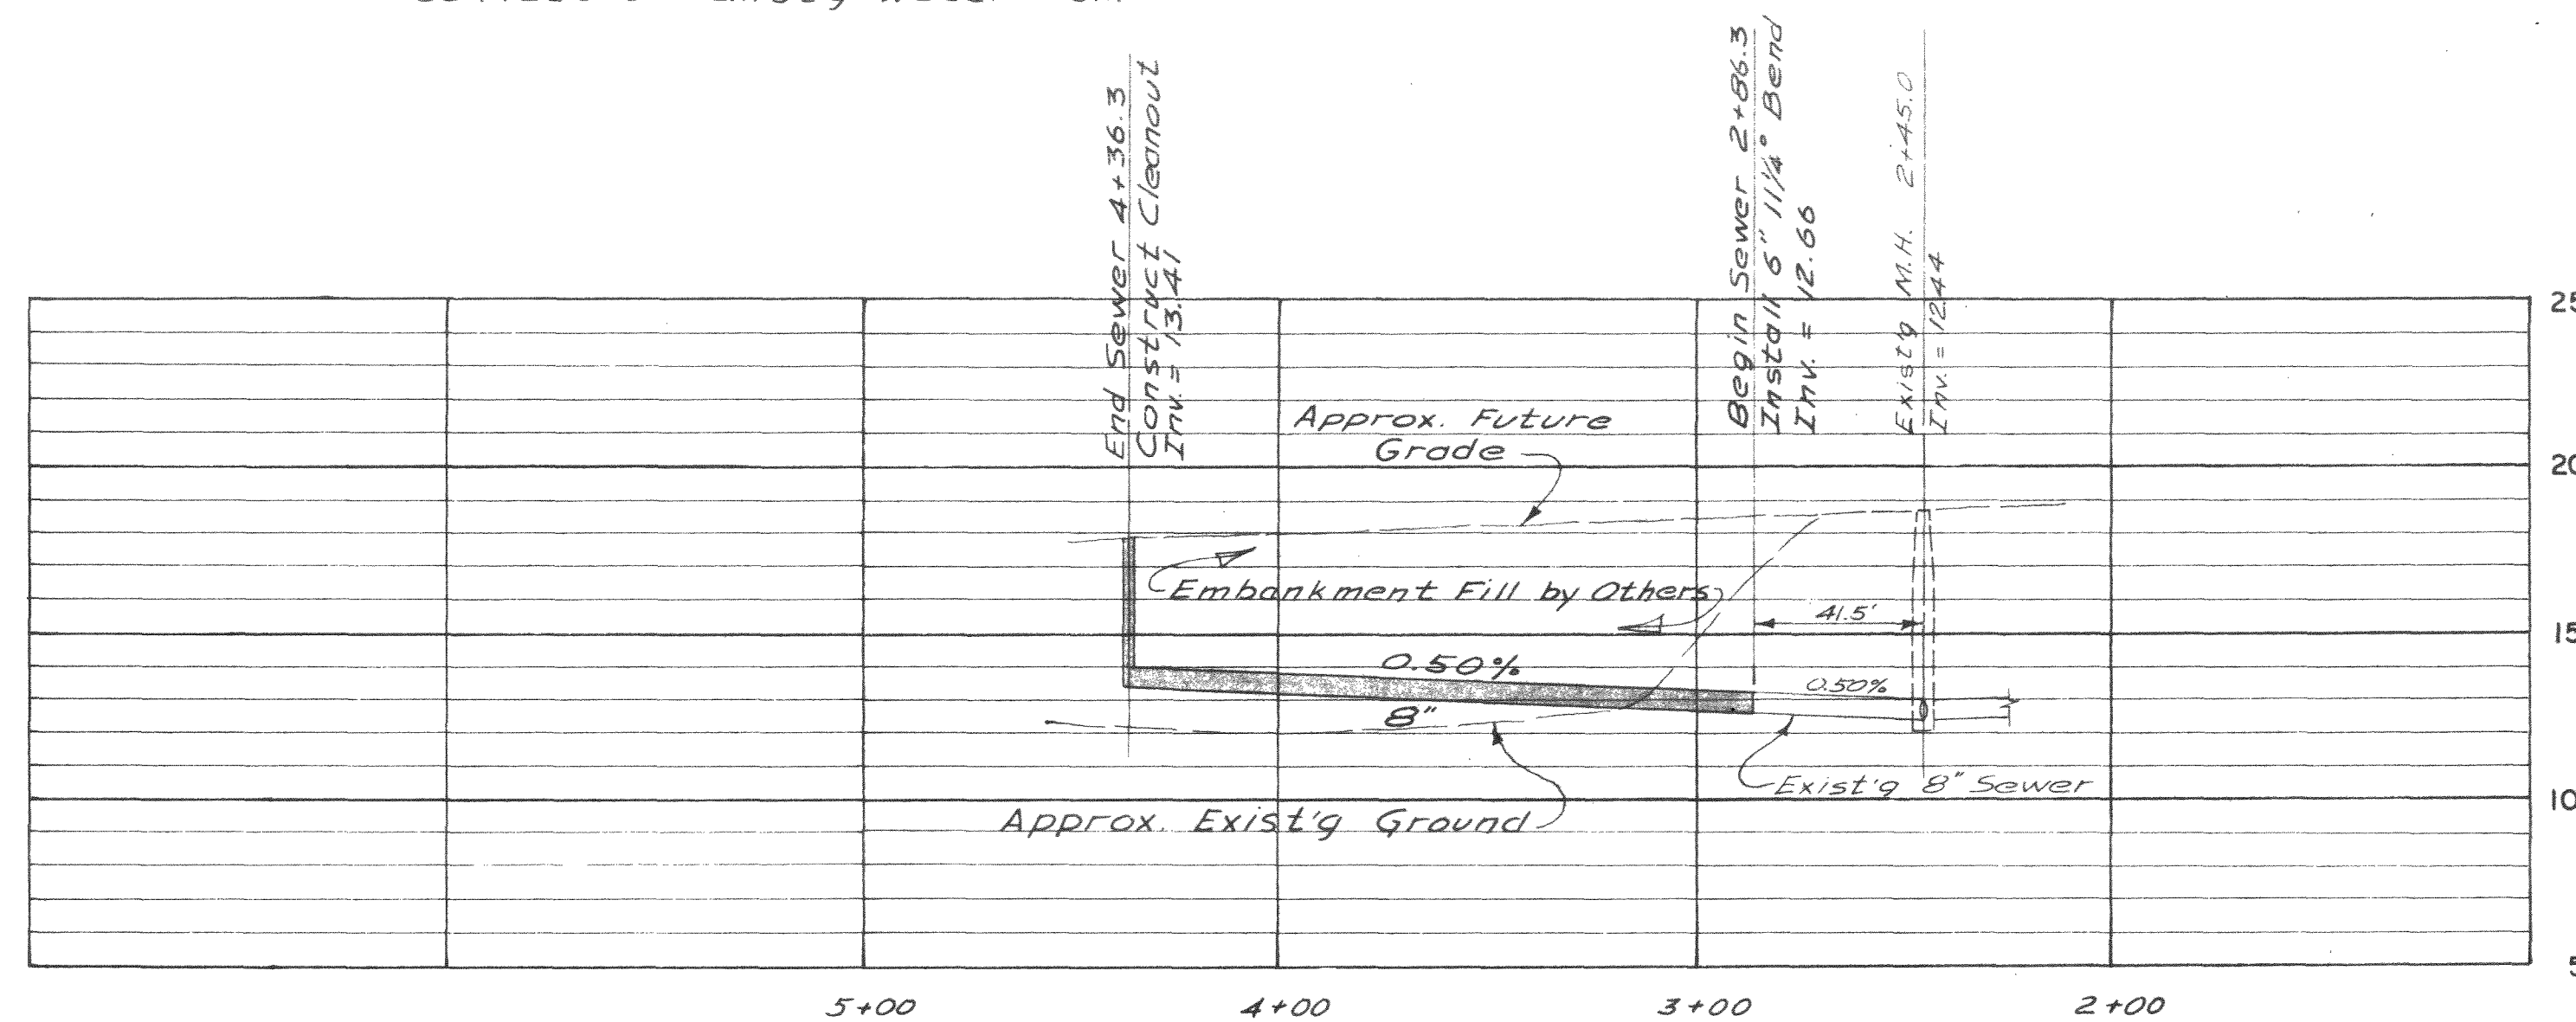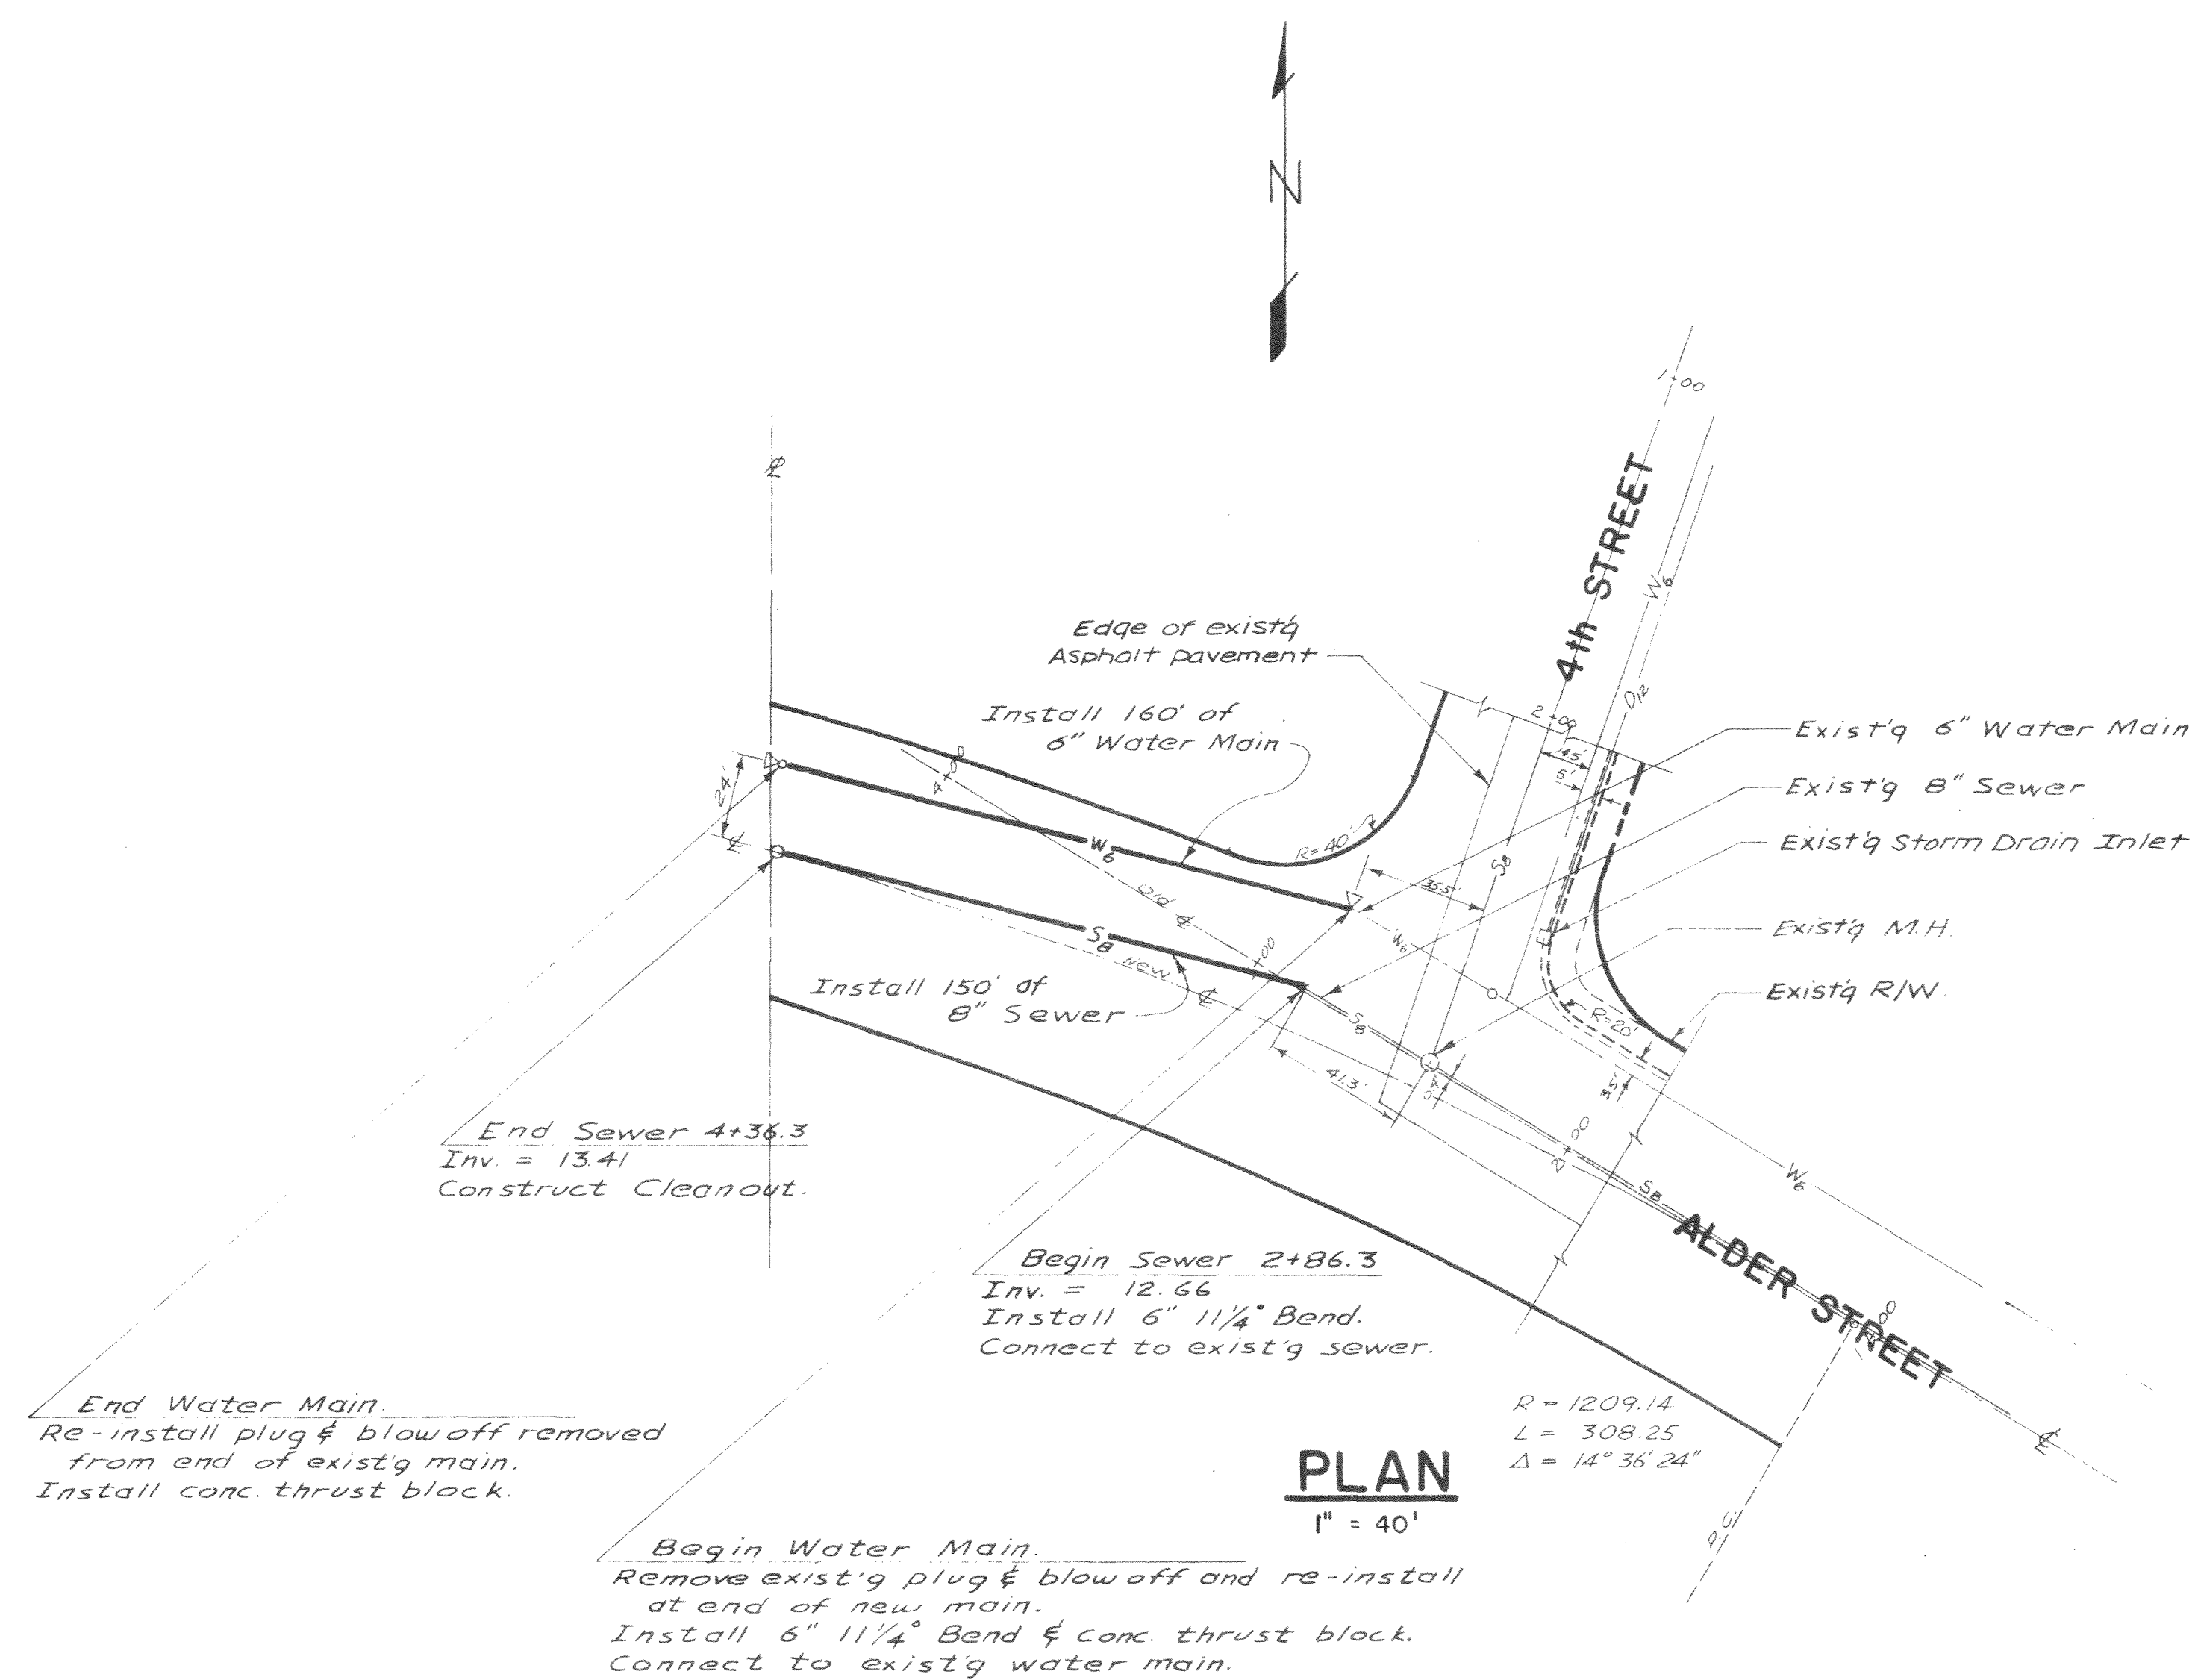

ALDER STREET

1" = 40' Hor.
1" = 5' Vert.

APPROVED FOR
CONSTRUCTION 7-18-80 J.H.

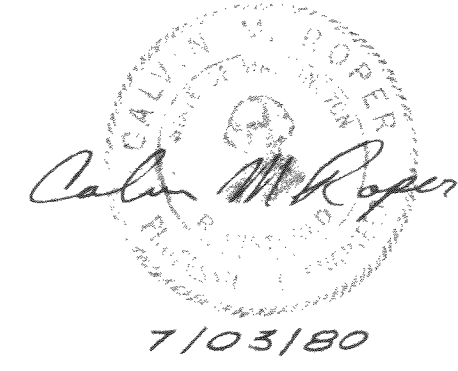

PROJECT BENCH MARK:
U.S.G.S. Bronze Disk at S.E. End of S.W.
Sidewalk, River Bridge. ELEV. = 34.96

- NOTE:**
1. All workmanship and material shall conform to applicable provisions of the "Standard Specifications for Municipal Public Works Construction" prepared by the Washington State Chapter, A.P.W.A., and shall be subject to the approval of the City of Ferndale Utilities Department.
 2. Sewer and water services shall be installed where directed in field.

CHECK PRINT

FERNDALDE PROPERTIES
**ALDER STREET
WATER & SEWER EXT.**
PLAN & PROFILE

GEORGE H. RAPER & ASSOCIATES
372 "H" Street
Blaine, WA. 98230

Scale: AS SHOWN Date: JULY 3, 80 Sheet 1 of 1