
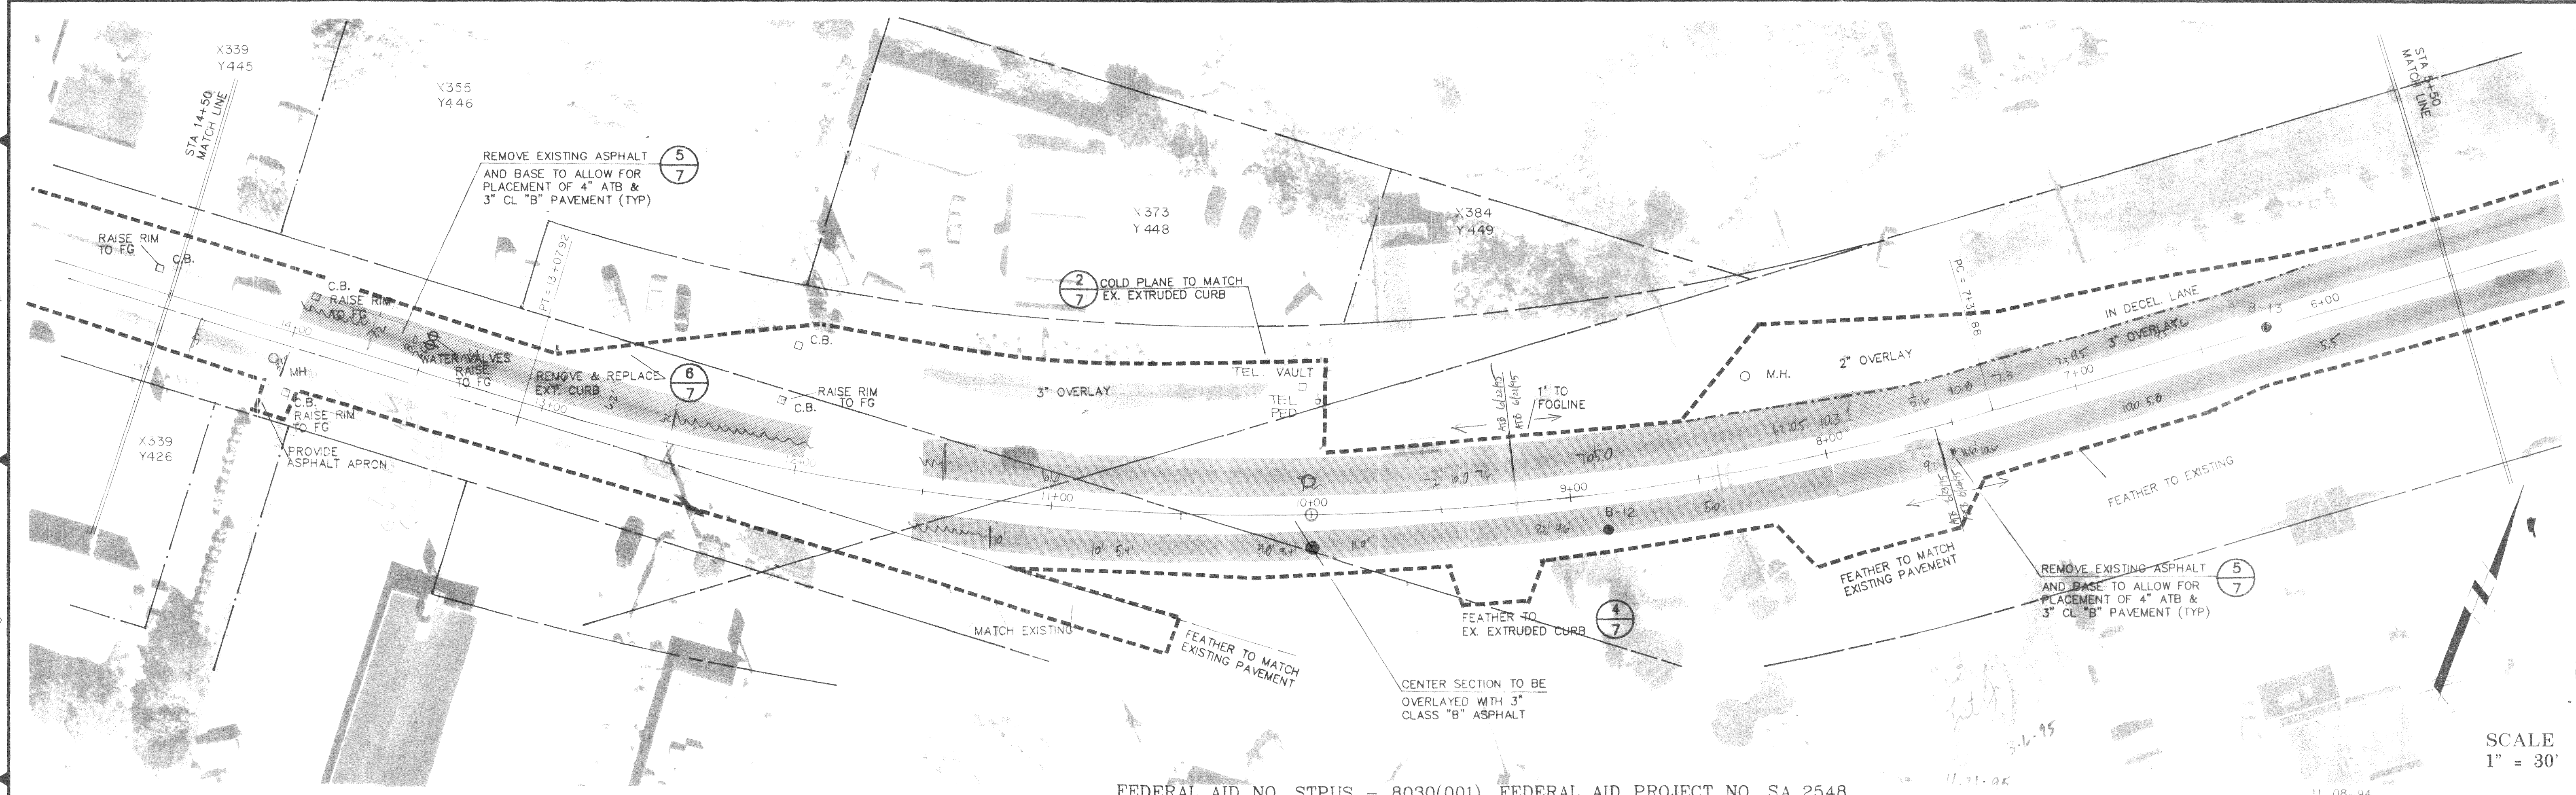


LEGEND

- APPROX. EXCAV/ATB PLACEMENT AREA
- LIMITS OF ATB WORK BY DAY
- WORK LOCATIONS (BASE LIFT) AT TIMES NOTED
- WORK LOCATIONS (FINISH LIFT) AT TIMES NOTED
- PREVIOUS CORE SAMPLE LOCATIONS
- POTENTIAL POINTS TO CHECK OVERLAY THICKNESS (SECONDARY)
- " " " " " (PRIMARY)


SCALE
1" = 30'

SCALE
1" = 30'

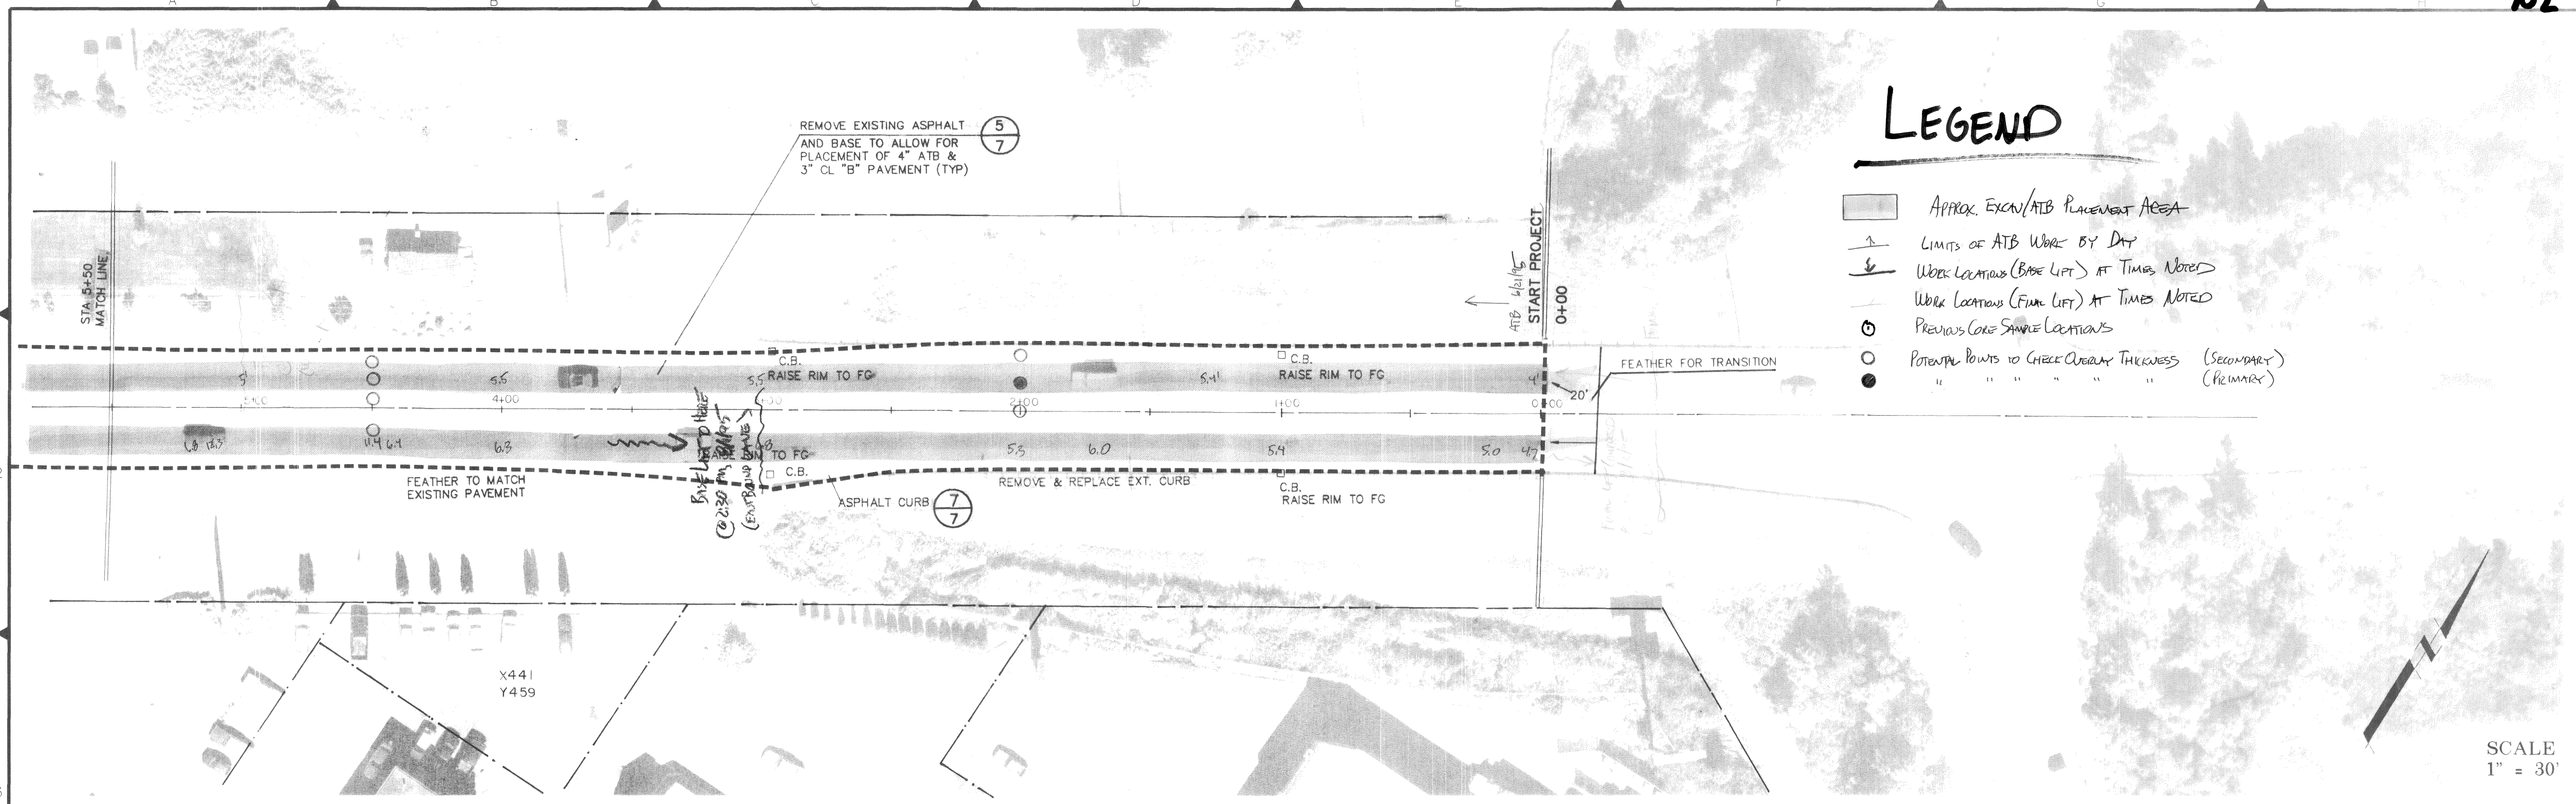

FEDERAL AID NO. STPUS - 8030(001), FEDERAL AID PROJECT NO. SA 2548

NO.	REVISIONS	BY	DATE

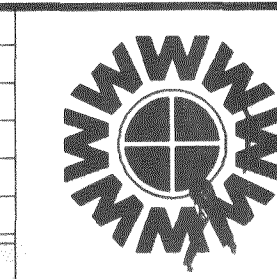



WEDEN ENGINEERING, INC.
119 GRAND AVENUE, SUITE D,
BELLINGHAM, WA. 98225 671-8200

ONE INCH AT FULL SCALE
IF NOT ONE INCH
SCALE ACCORDINGLY

DESIGNED BY
DRAWN BY
CHECKED BY


CITY OF FERNDALE
EAST MAIN STREET OVERLAY
STA 0+00 TO STA 14+50

DATE	10-26-94	SHEET	2
SCALE	1" = 30'	OF	7
REC. NO.	94053		

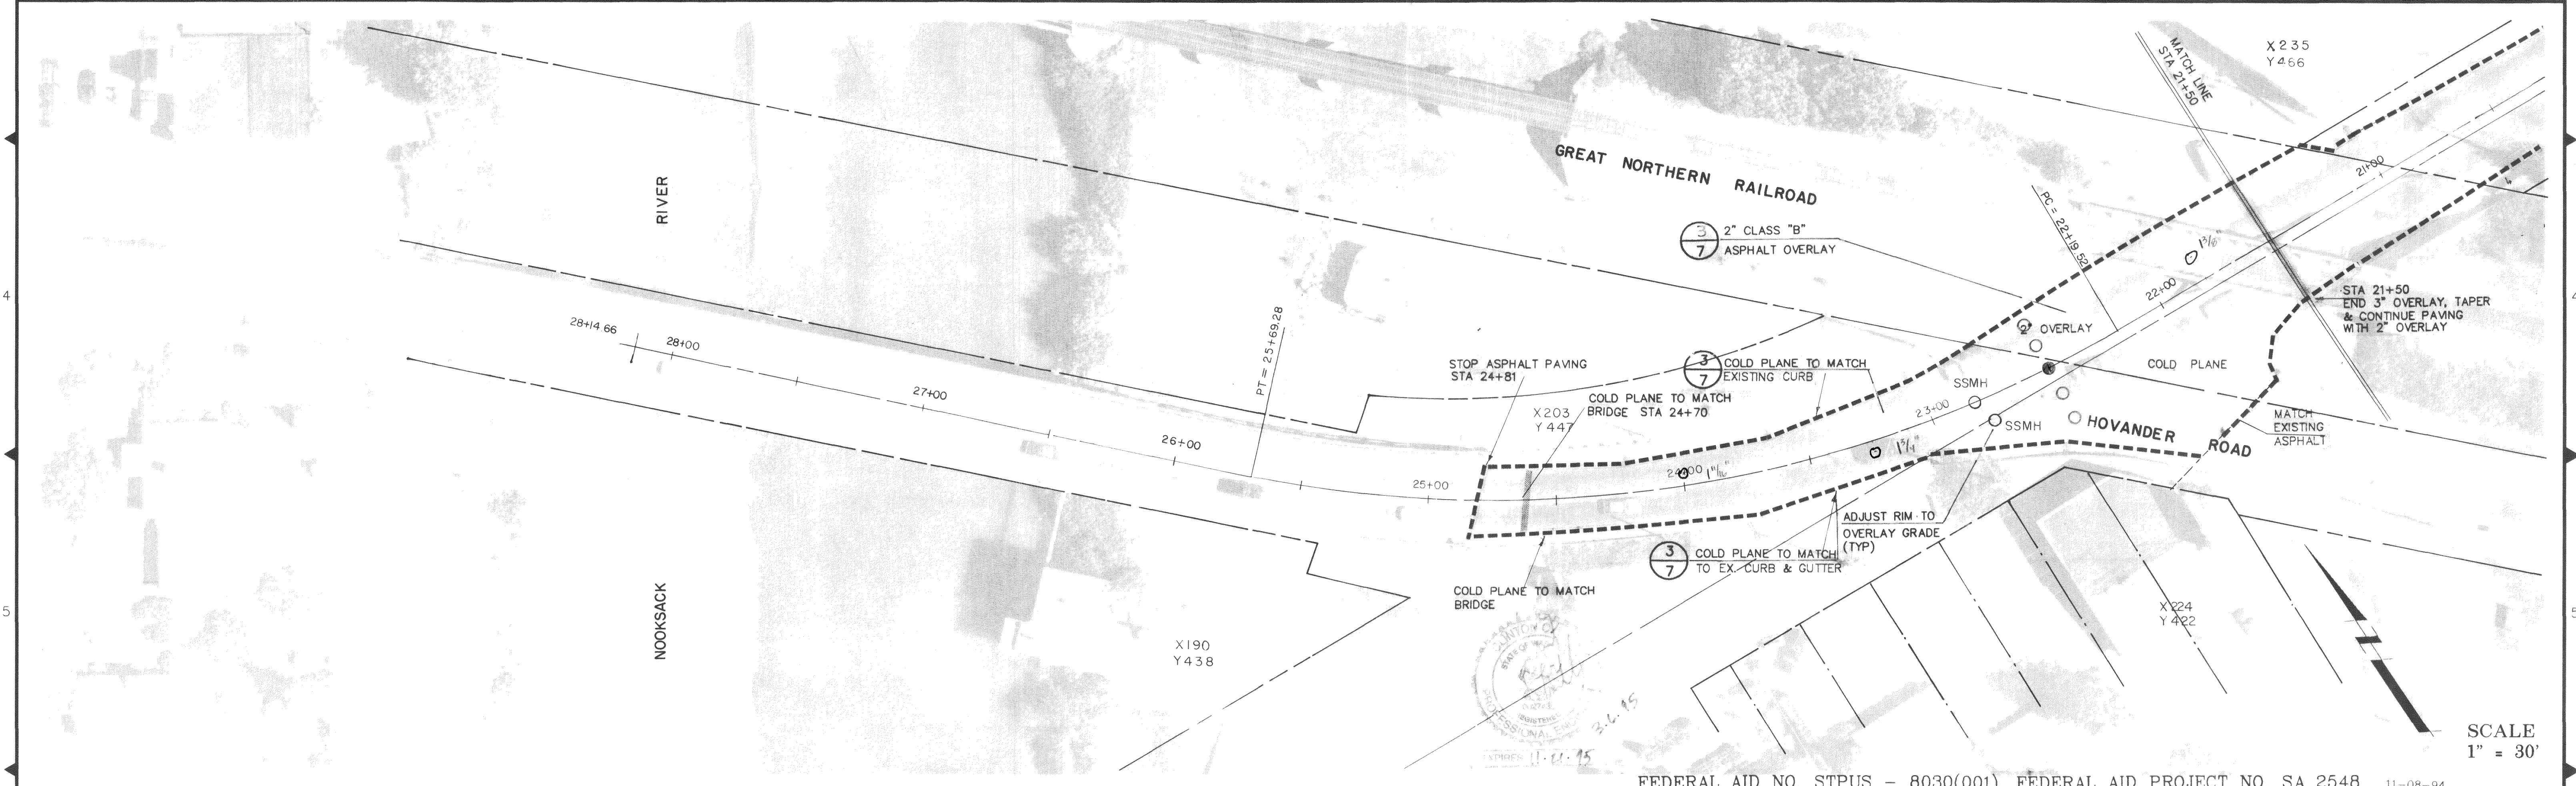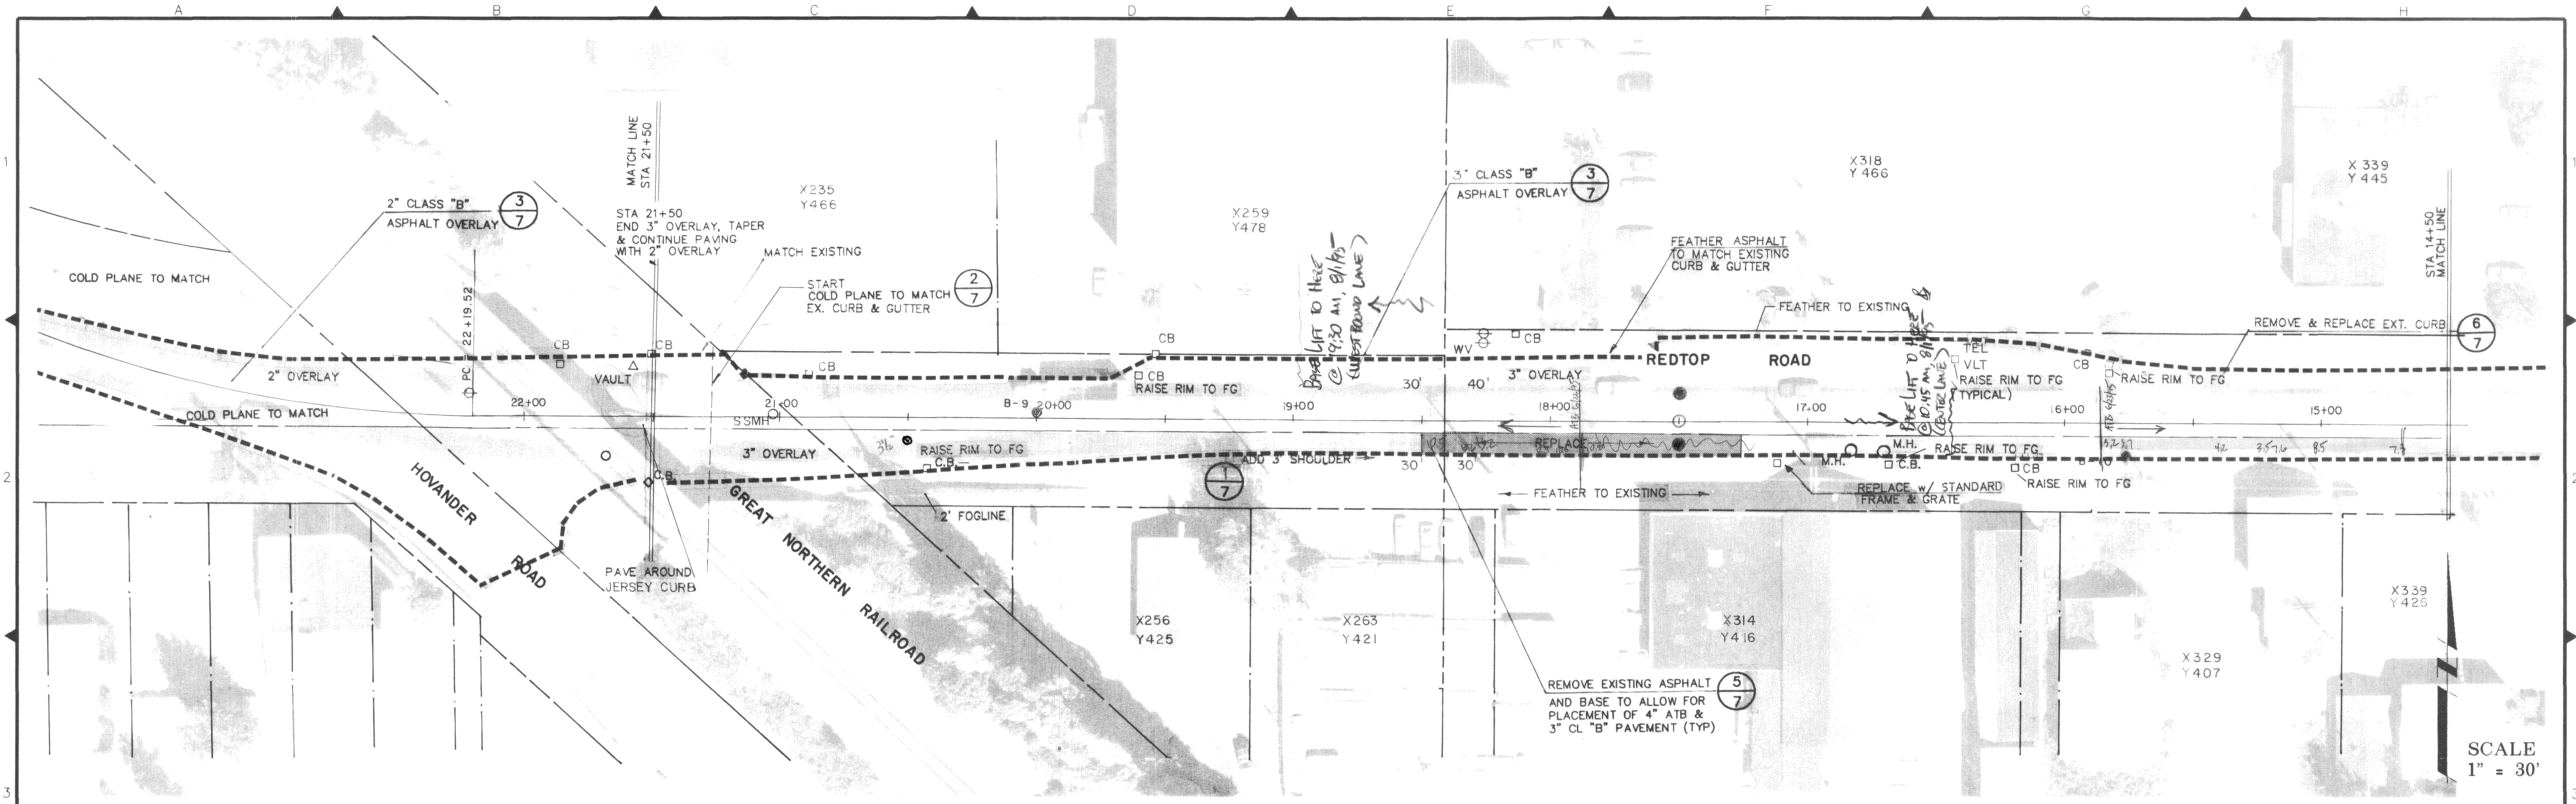


<table border="1" style="width: 100%; border-collapse: collapse;"> <tr> <th style="width: 5%;">NO.</th> <th style="width: 65%;">REVISIONS</th> <th style="width: 10%;">BY</th> <th style="width: 20%;">DATE</th> </tr> <tr><td> </td><td> </td><td> </td><td> </td></tr> <tr><td> </td><td> </td><td> </td><td> </td></tr> <tr><td> </td><td> </td><td> </td><td> </td></tr> <tr><td> </td><td> </td><td> </td><td> </td></tr> </table>	NO.	REVISIONS	BY	DATE																	WEDEN ENGINEERING, INC. 119 GRAND AVENUE, SUITE D, BELLINGHAM, WA. 98225 671-8200	ONE INCH AT FULL SCALE IF NOT ONE INCH SCALE ACCORDINGLY	DESIGNED BY DRAWN BY CHECKED BY	FEDERAL AID NO. STPUS - 8030(001), FEDERAL AID PROJECT NO. SA 2548 CITY OF FERNDALE EAST MAIN STREET OVERLAY STA 14+50 TO STA 24+81	DATE 10-26-94 SCALE 1" = 30' REC. NO. 94053	SHEET 3 OF 7
NO.	REVISIONS	BY	DATE																							

00373.002 12-10-08 AM

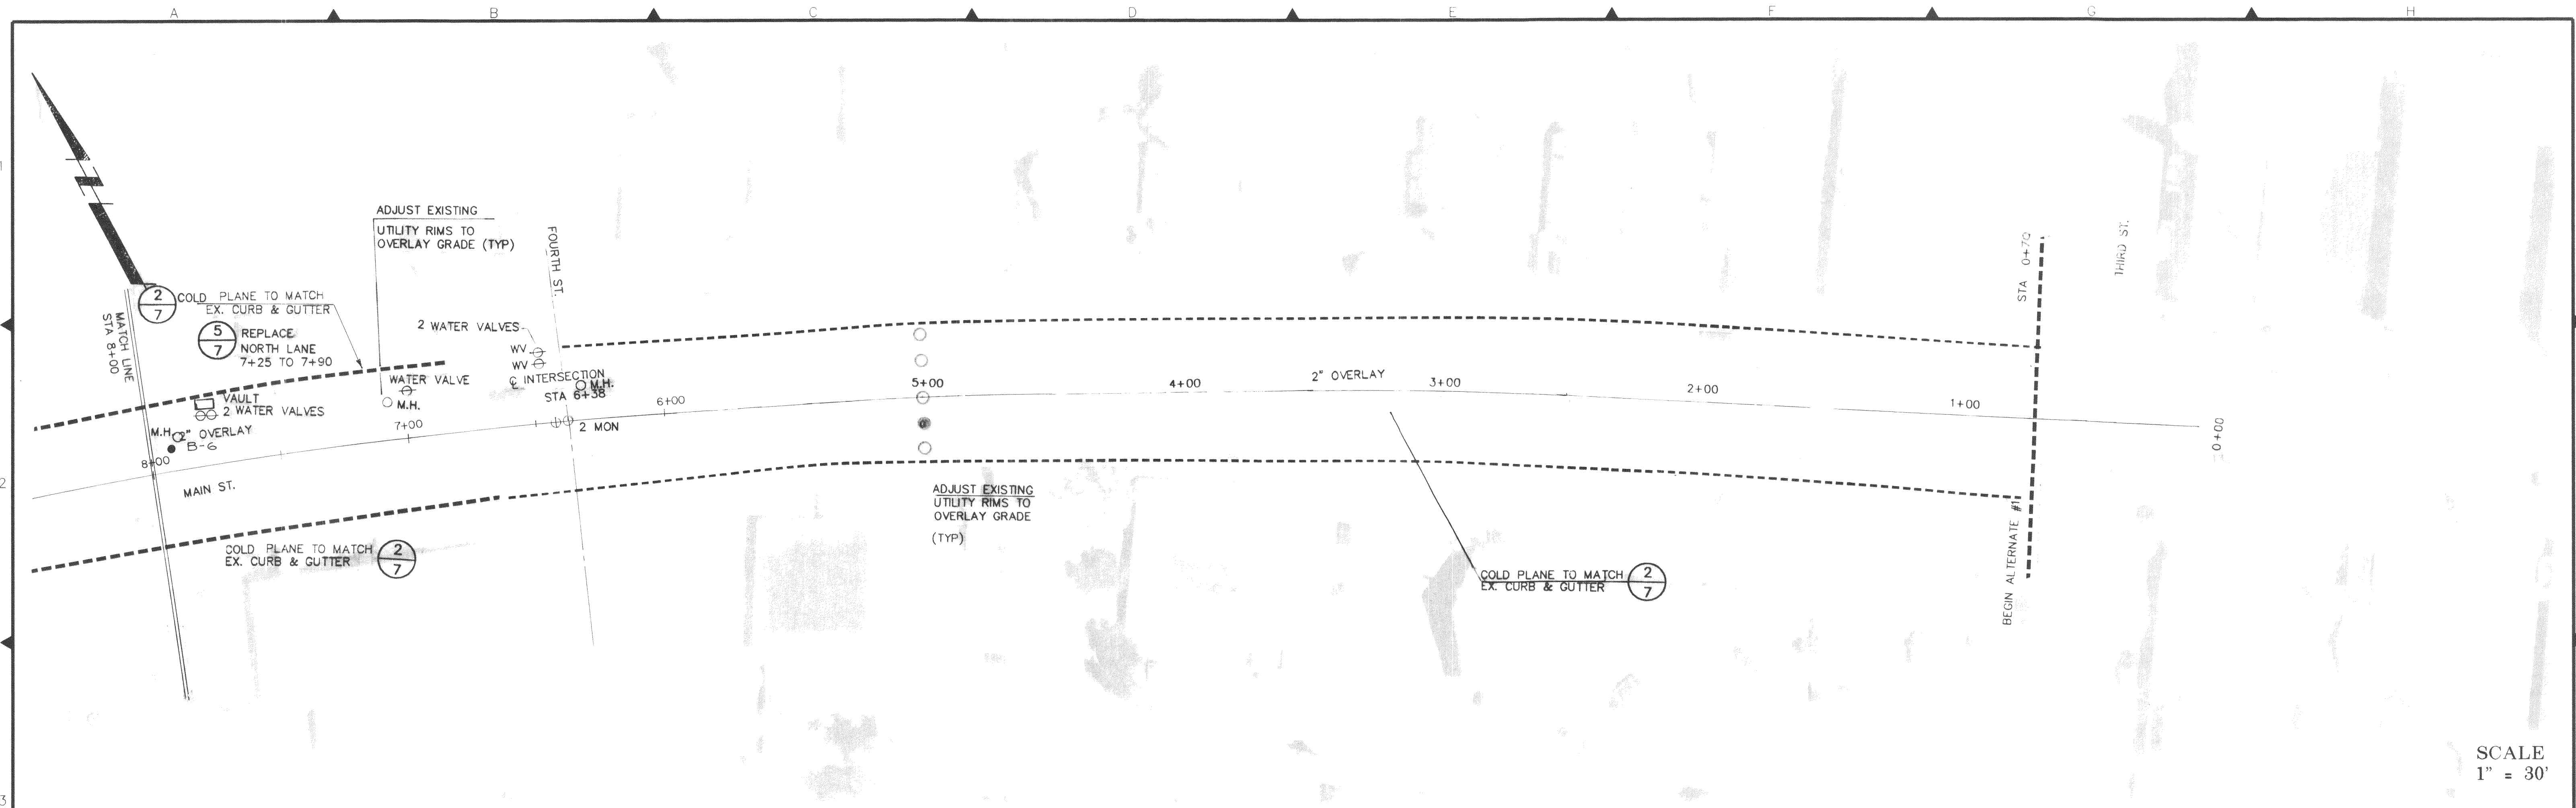


SCALE
1" = 30'

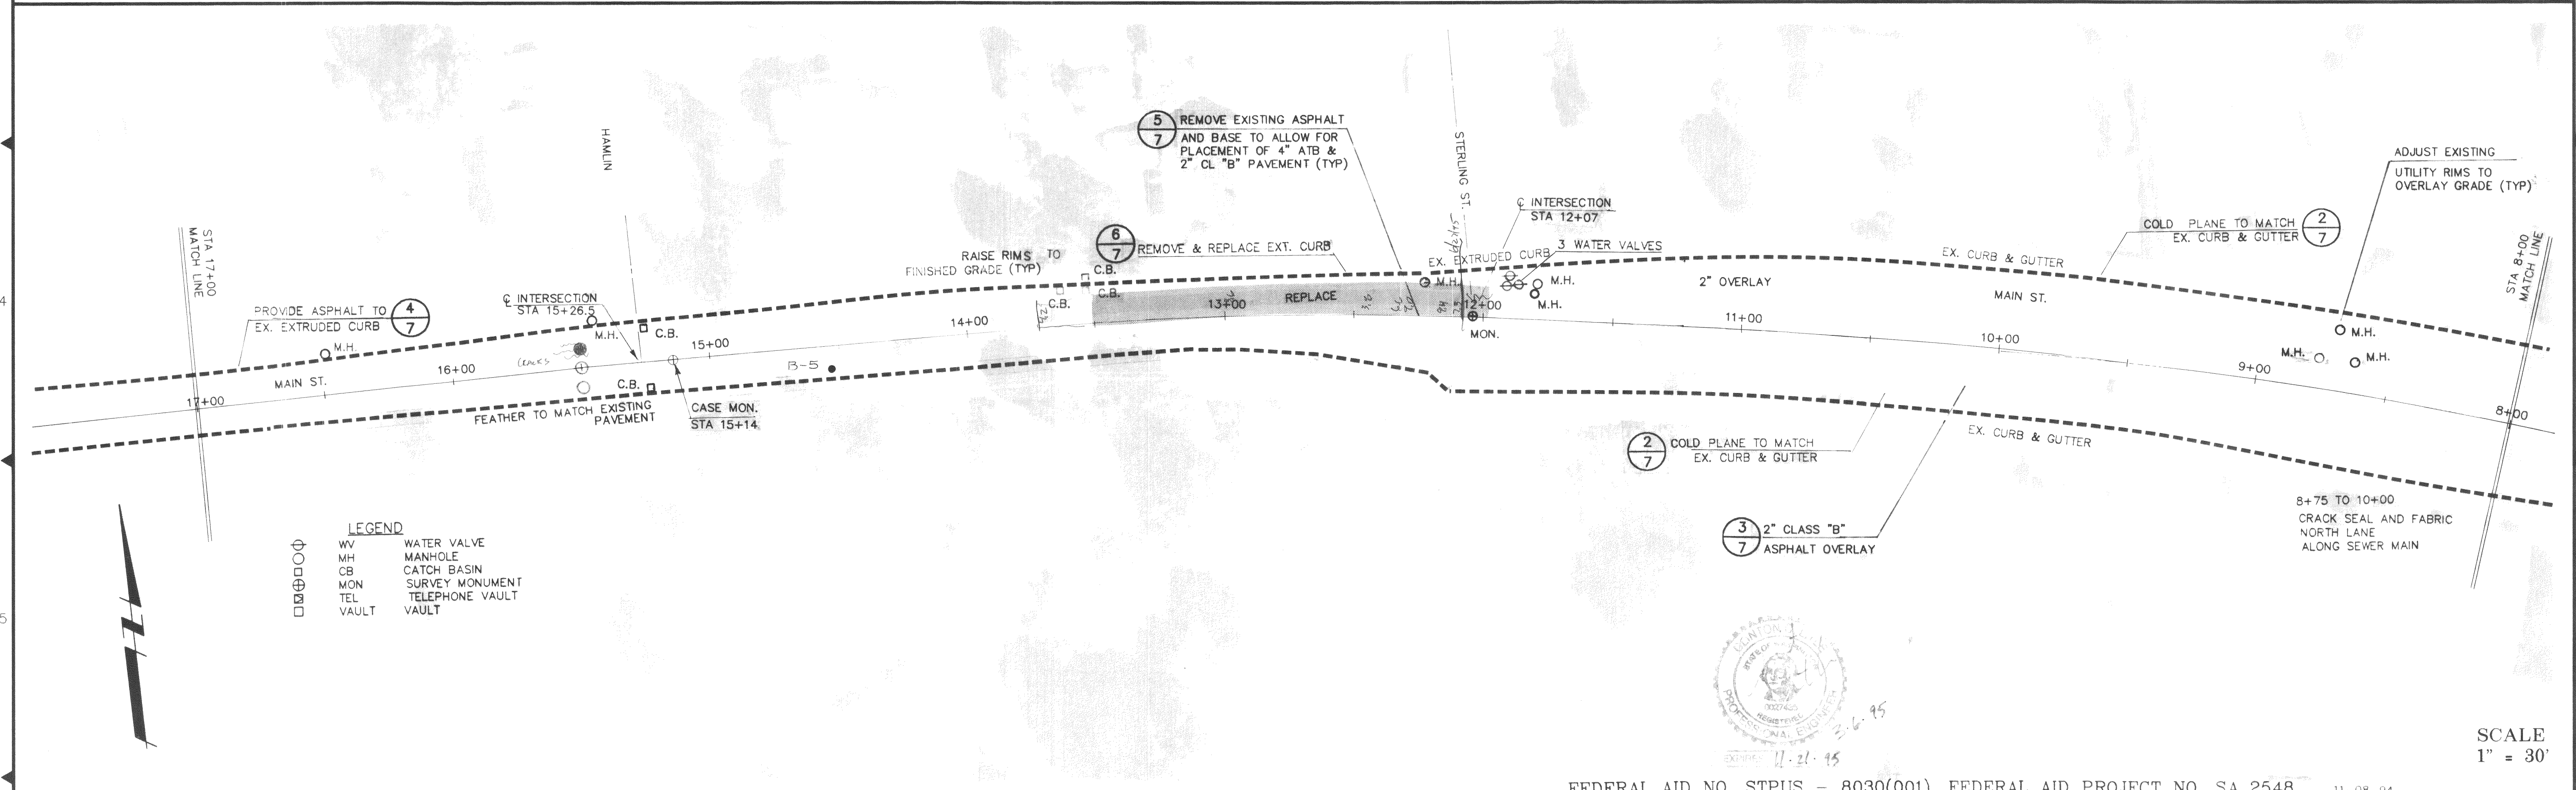


SCALE
1" = 30'

<table border="1" style="width: 100%; border-collapse: collapse;"> <tr> <th style="width: 10%;">NO.</th> <th style="width: 60%;">REVISIONS</th> <th style="width: 10%;">BY</th> <th style="width: 20%;">DATE</th> </tr> <tr><td> </td><td> </td><td> </td><td> </td></tr> <tr><td> </td><td> </td><td> </td><td> </td></tr> <tr><td> </td><td> </td><td> </td><td> </td></tr> </table>		NO.	REVISIONS	BY	DATE													WEDEN ENGINEERING, INC. 119 GRAND AVENUE, SUITE D, BELLINGHAM, WA. 98225 671-8200	ONE INCH AT FULL SCALE IF NOT ONE INCH SCALE ACCORDINGLY	<table border="1" style="width: 100%; border-collapse: collapse;"> <tr><td style="text-align: center;">DESIGNED BY</td></tr> <tr><td style="text-align: center;">DRAWN BY</td></tr> <tr><td style="text-align: center;">CHECKED BY</td></tr> </table>	DESIGNED BY	DRAWN BY	CHECKED BY	CITY OF FERNDALE WEST MAIN STREET OVERLAY STA + 70 TO STA 17+00	<table border="1" style="width: 100%; border-collapse: collapse;"> <tr><td style="text-align: center;">DATE 10-26-94</td></tr> <tr><td style="text-align: center;">SCALE 1" = 30'</td></tr> <tr><td style="text-align: center;">REC. NO. 94053</td></tr> </table>	DATE 10-26-94	SCALE 1" = 30'	REC. NO. 94053	SHEET 4 OF 7
NO.	REVISIONS	BY	DATE																										
DESIGNED BY																													
DRAWN BY																													
CHECKED BY																													
DATE 10-26-94																													
SCALE 1" = 30'																													
REC. NO. 94053																													


FEDERAL AID NO. STPUS - 8030(001), FEDERAL AID PROJECT NO. SA 2548 11-08-94

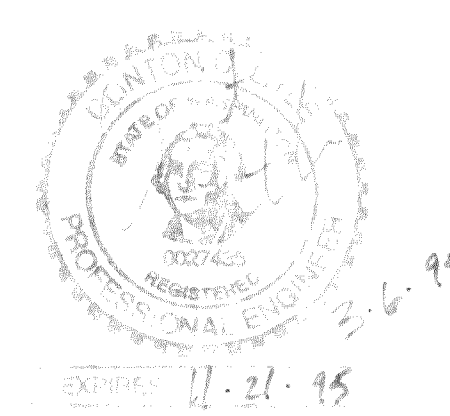


00279.003 12-10-08 AM

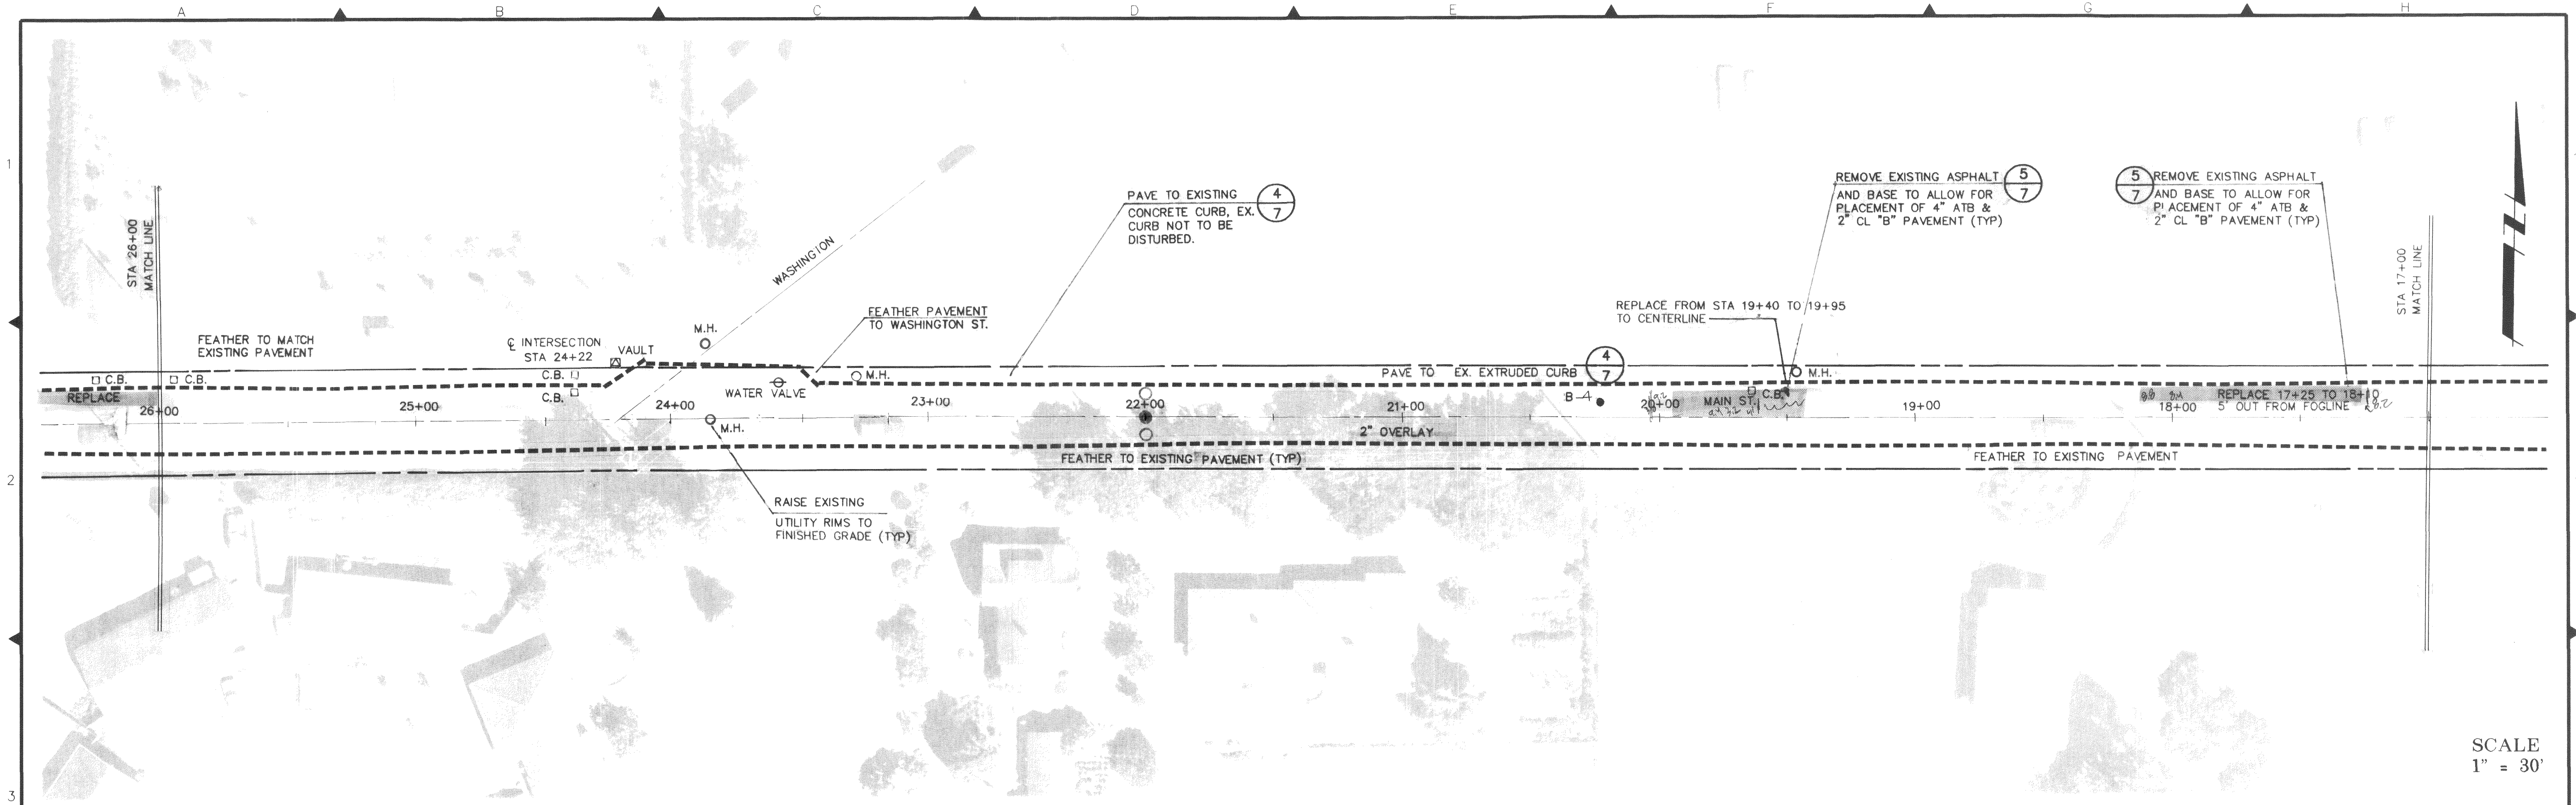

SCALE
1" = 30'

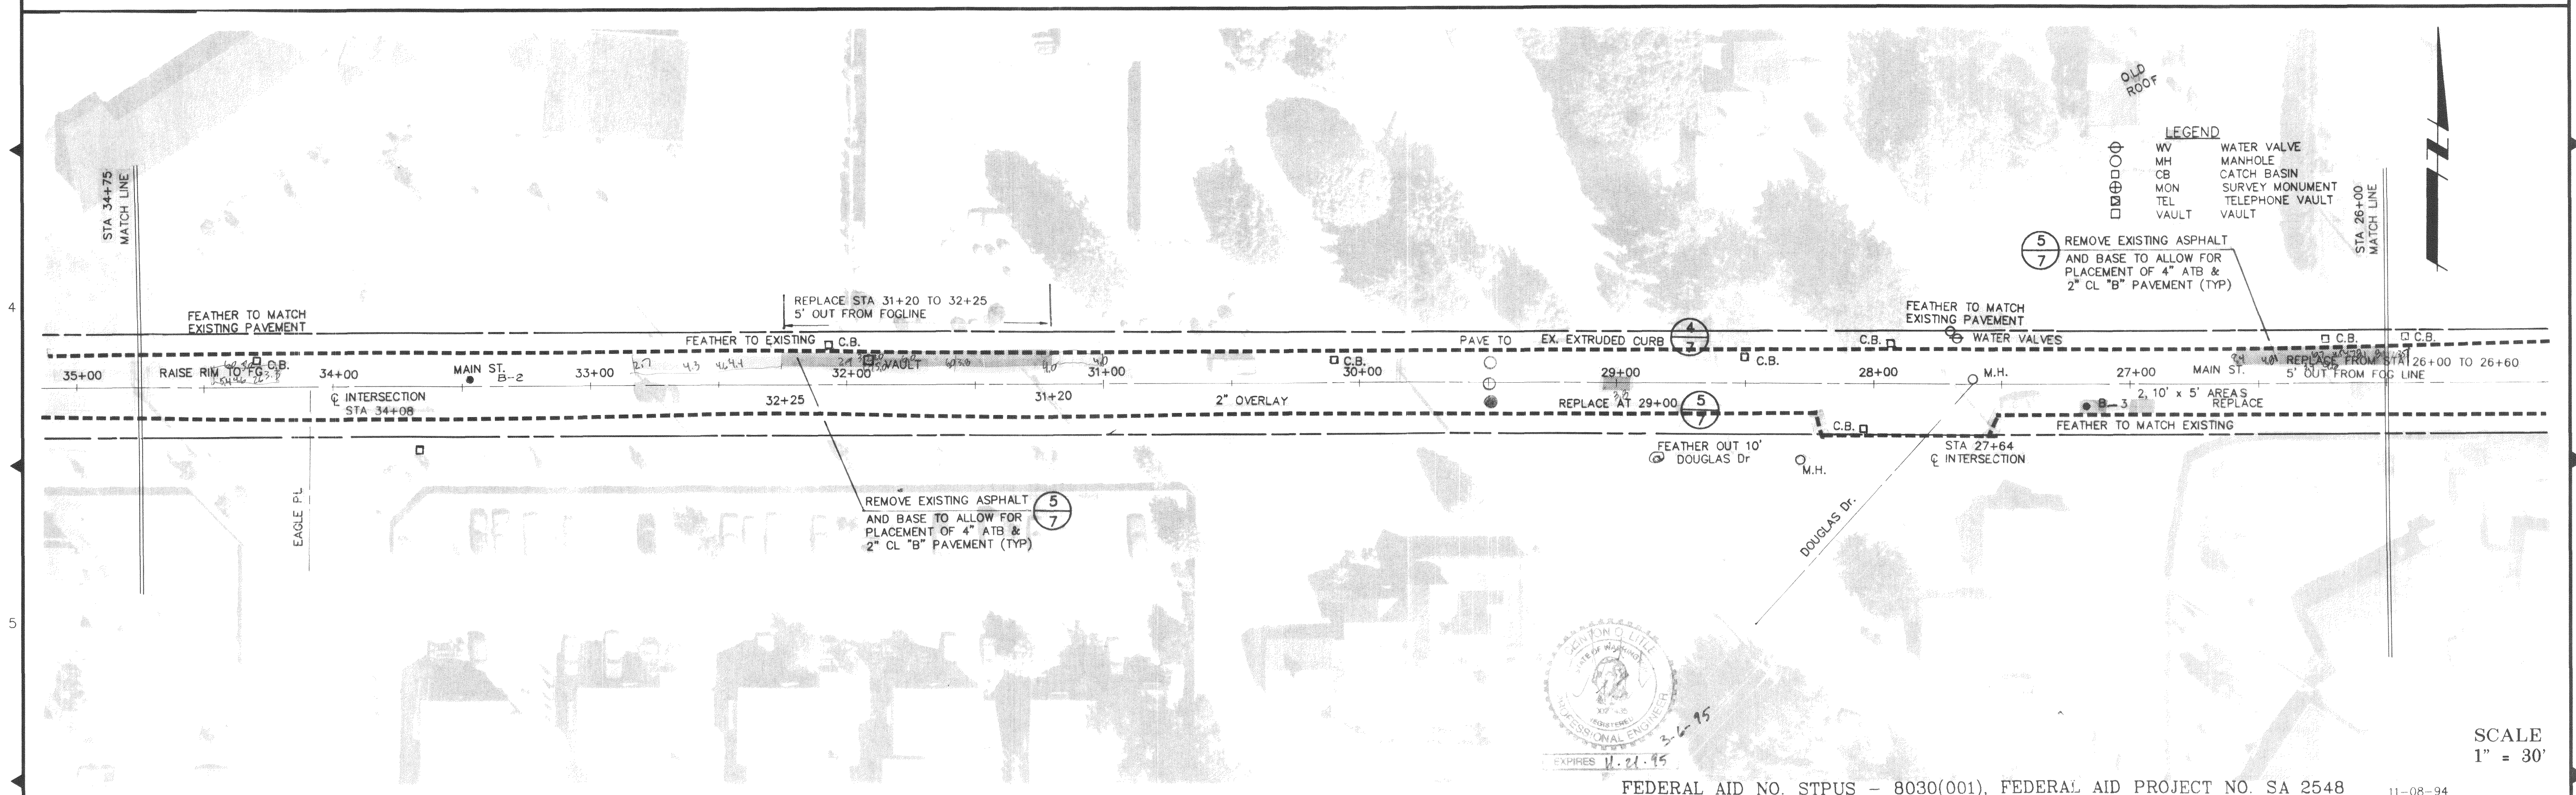


SCALE
1" = 30'

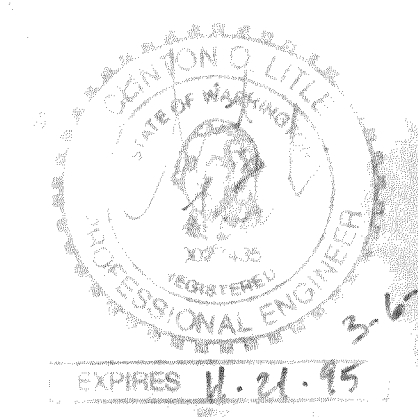

FEDERAL AID NO. STPUS - 8030(001), FEDERAL AID PROJECT NO. SA 2548

NO.	REVISIONS	BY	DATE

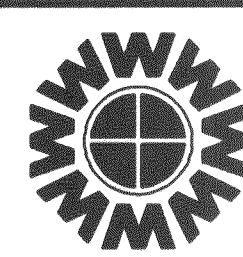

WEDEN ENGINEERING, INC.
119 GRAND AVENUE, SUITE D,
BELLINGHAM, WA. 98225 671-8200


ONE INCH AT FULL SCALE
IF NOT ONE INCH
SCALE ACCORDINGLY

DESIGNED BY
DRAWN BY
CHECKED BY


CITY OF FERNDALE
WEST MAIN STREET OVERLAY
STA 17+00 TO STA 34+75

DATE	10-26-94	SHEET	5
SCALE	1" = 30'	OF	7
REC. NO.	94053		

00873.004 12-10-08 AM

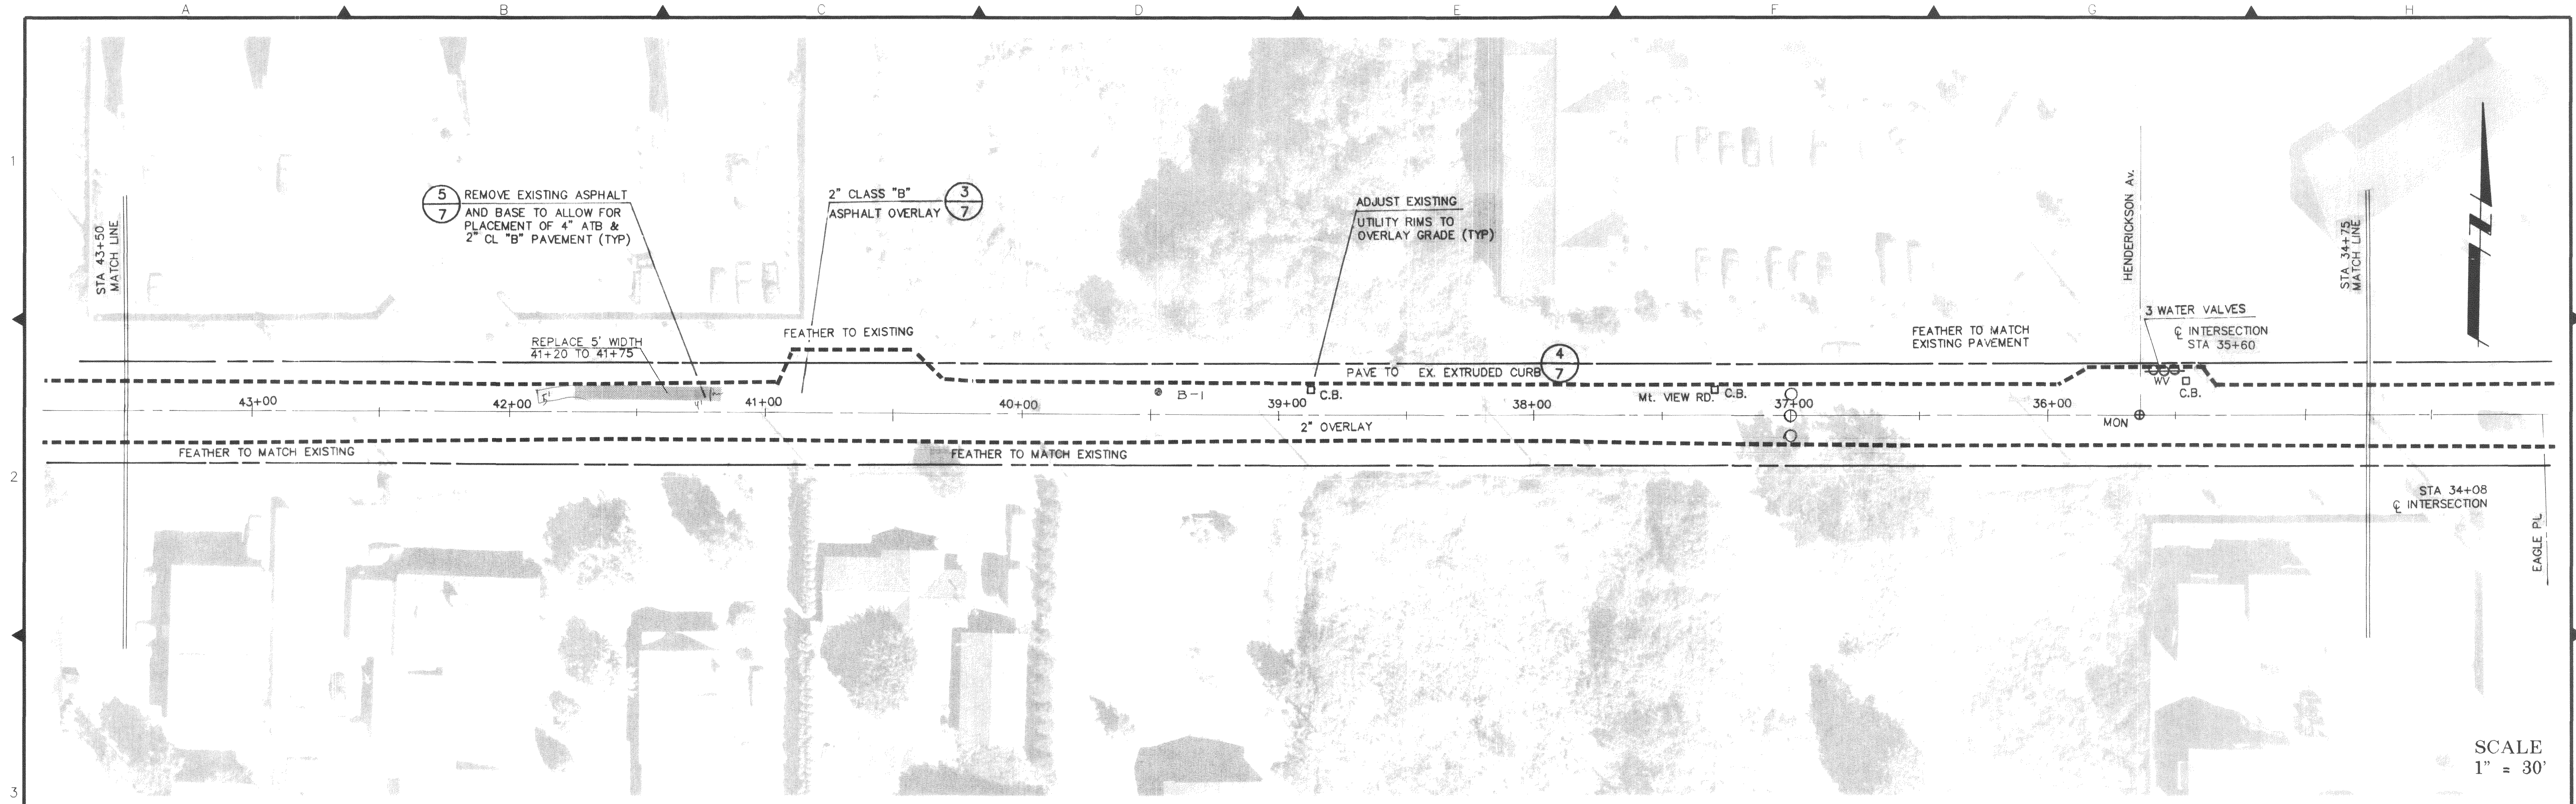


SCALE
1" = 30'

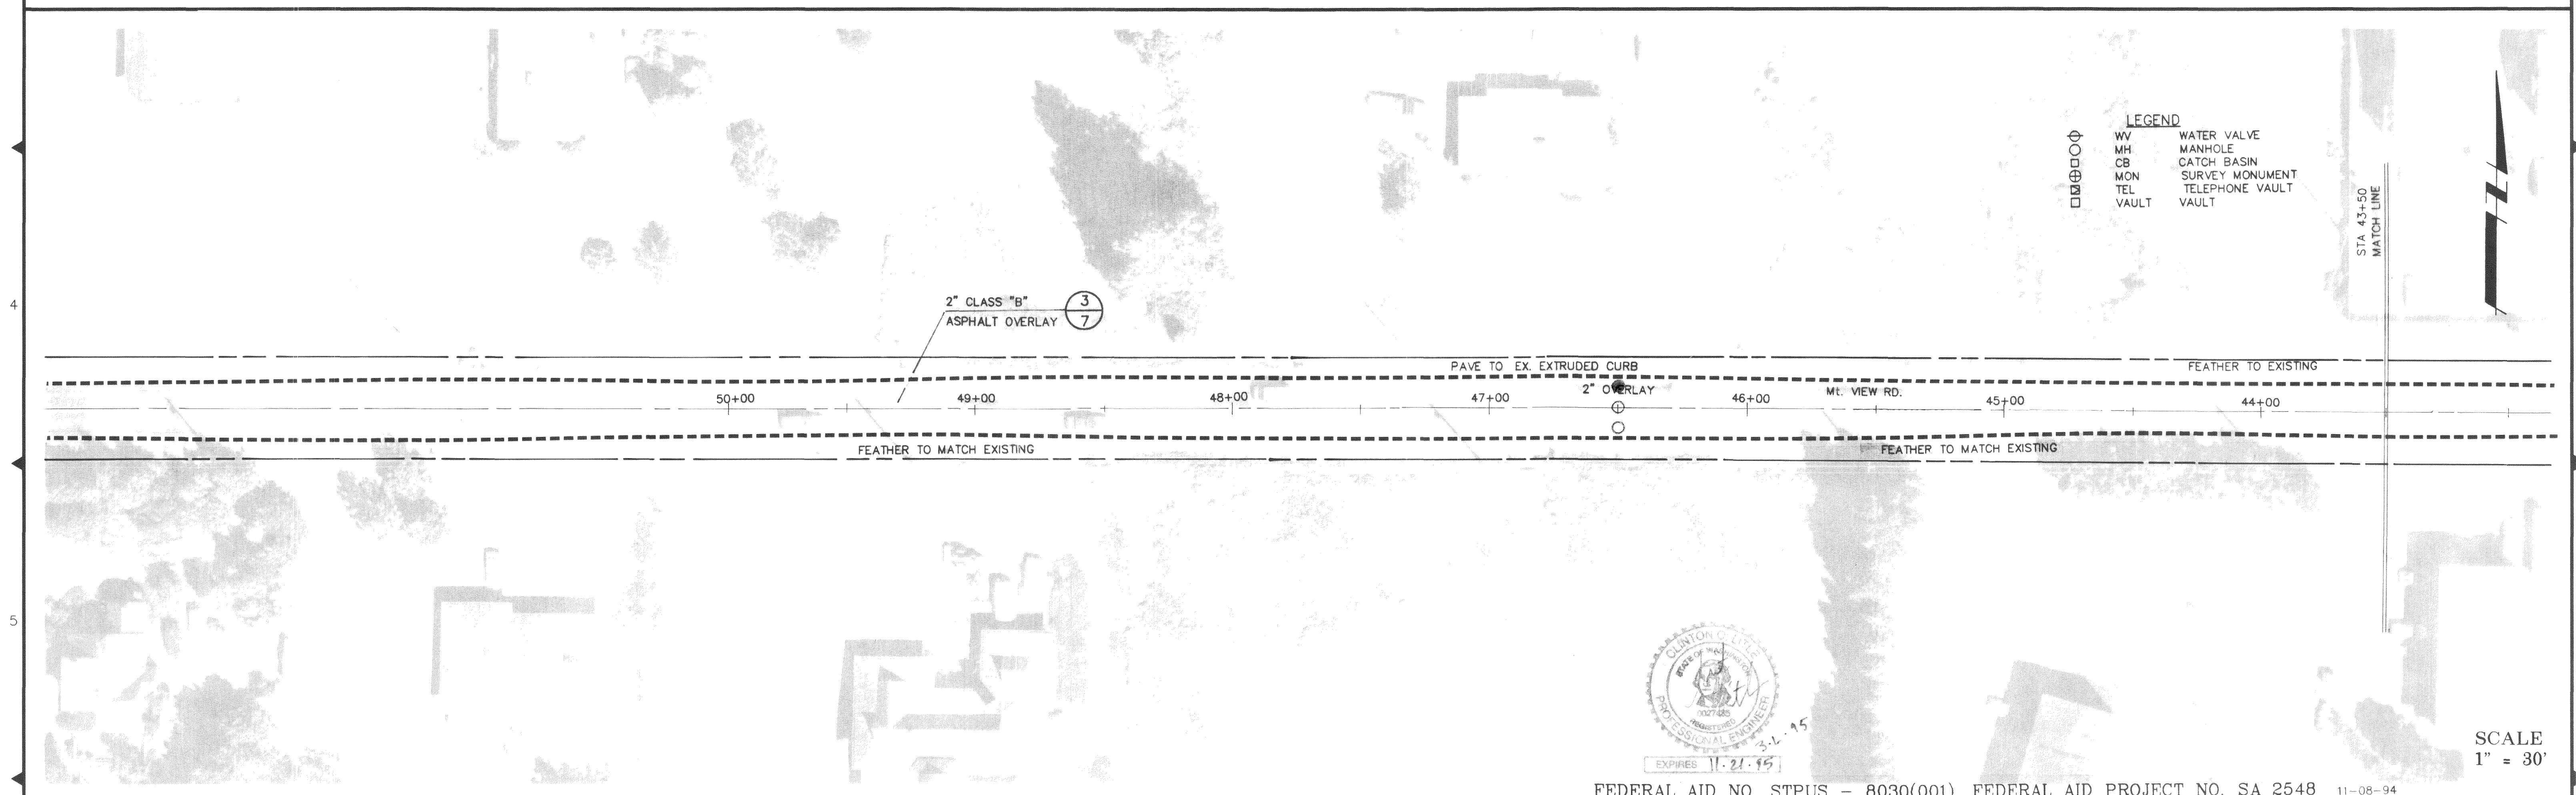


SCALE
1" = 30'

- LEGEND**
- WV WATER VALVE
 - MH MANHOLE
 - CB CATCH BASIN
 - MON SURVEY MONUMENT
 - TEL TELEPHONE VAULT
 - VAULT VAULT

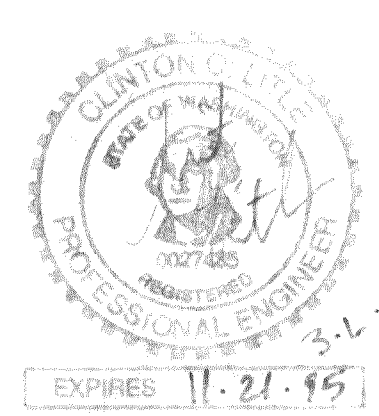

FEDERAL AID NO. STPUS - 8030(001), FEDERAL AID PROJECT NO. SA 2548 11-08-94

NO.	REVISIONS	BY	DATE

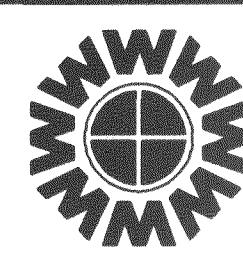

WEDEN ENGINEERING, INC.
119 GRAND AVENUE, SUITE D,
BELLINGHAM, WA. 98225 671-8200

ONE INCH AT FULL SCALE
IF NOT ONE INCH
SCALE ACCORDINGLY

DESIGNED BY
DRAWN BY
CHECKED BY

CITY OF FERNDALE
WEST MAIN STREET OVERLAY
STA 34+75 TO STA 50+00

DATE 10-26-94	SHEET 6
SCALE 1" = 30'	OF
REC. NO. 94053	7

00373.005 12-16-08 AM