

CITY OF FERNDALE

DEPARTMENT OF PUBLIC WORKS

FERNDALE, WASHINGTON

MAIN STREET - FOURTH AVENUE TO FIRST AVENUE

TRAFFIC SIGNAL IMPROVEMENTS

PROJECT NO. 288617-10

SCHEDULE OF DRAWINGS

<u>DWG. NO.</u>	<u>DESCRIPTION OF DRAWINGS</u>
1	TITLE SHEET
2-3	MAIN STREET AT FOURTH AVENUE SIGNAL PLAN, WIRING DIAGRAM
4-5	MAIN STREET AT THIRD AVENUE SIGNAL PLAN, WIRING DIAGRAM
6-7	MAIN STREET AT SECOND AVENUE SIGNAL PLAN, WIRING DIAGRAM
8-9	MAIN STREET AT FIRST AVENUE SIGNAL PLAN, WIRING DIAGRAM
10	SIGNAL POLE SCHEDULE

CITY OFFICIALS

MAYOR

LORNA GEMMELL

CITY COUNCIL MEMBERS

AL SCHMIDT
D.P. (PAT) SIZEMORE
DENNIS HAWKINSON
JACK WILLIAMS
GARY GIBBONS
MADELYN WASLOHN



CITY MANAGER

RON S. PETERSON

DIRECTOR OF PUBLIC WORKS

JOHN F. ELEY


VICINITY MAP

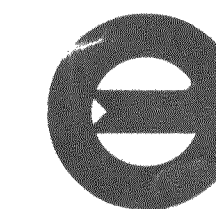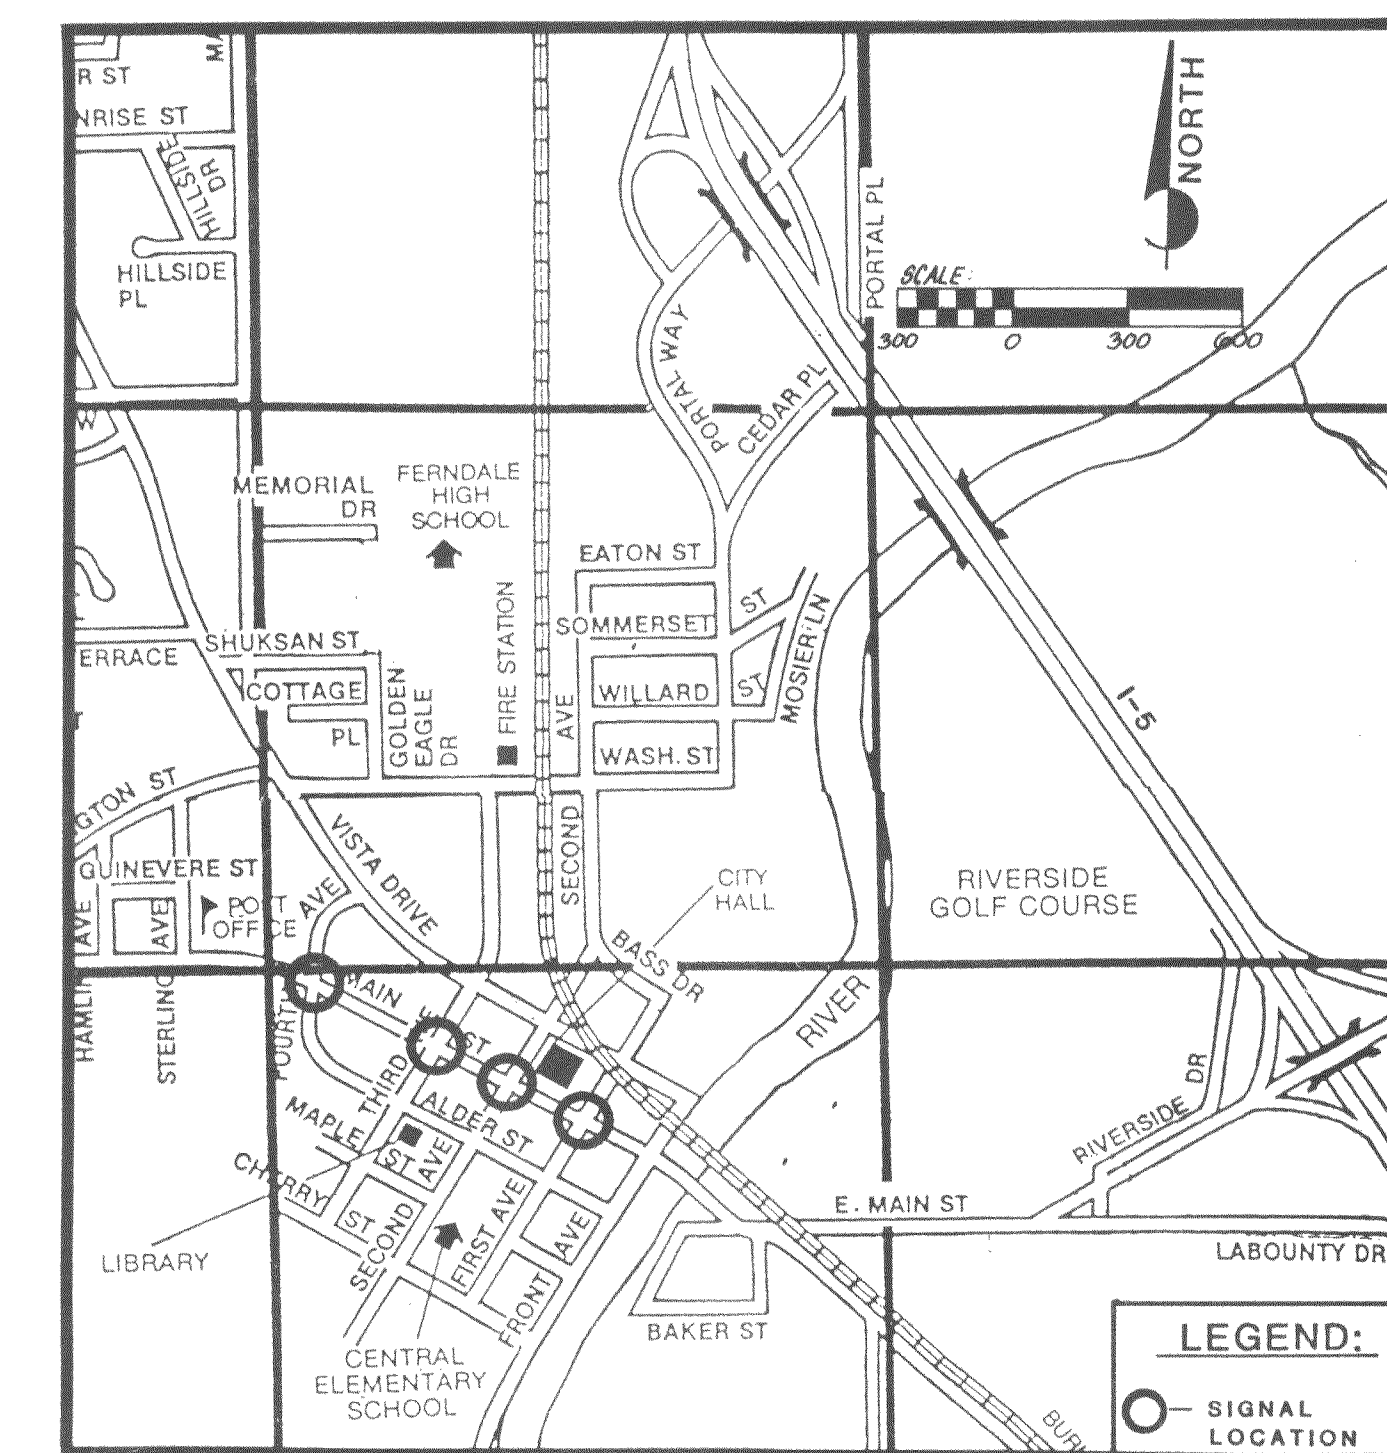

ENTRANCO ENGINEERS, INC.

100

COMMUNICATION CABLE

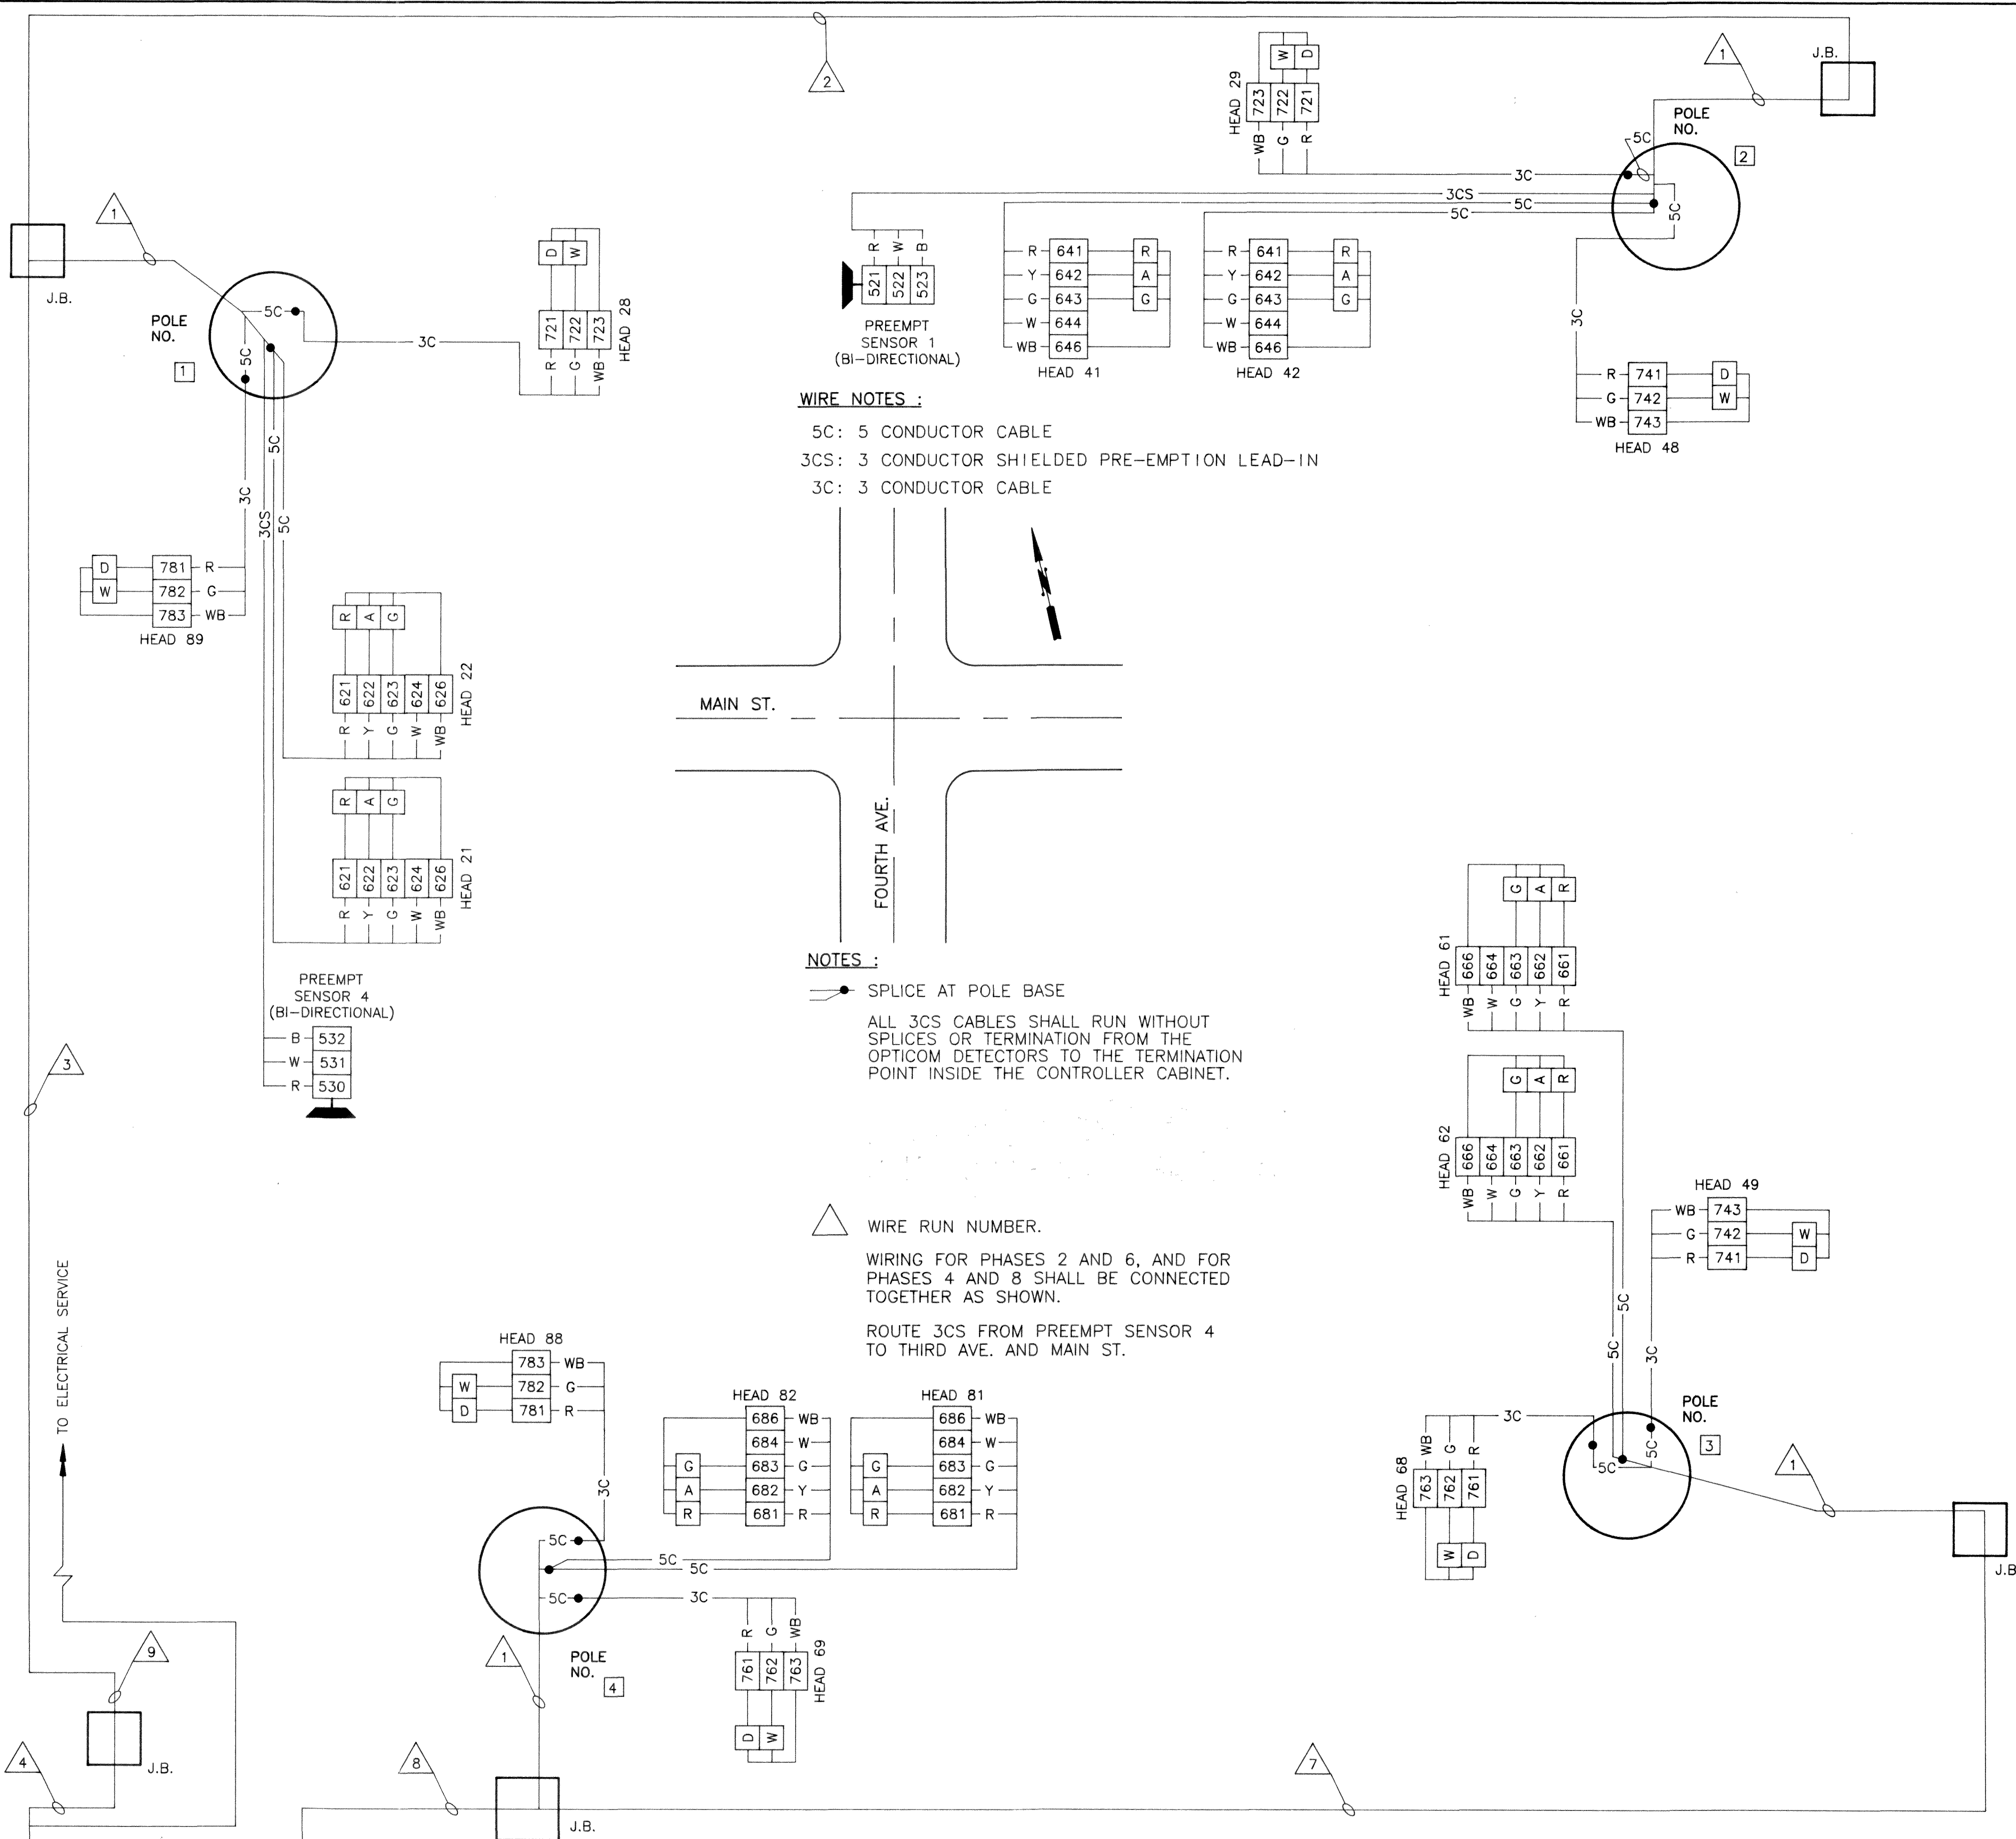

NOTES :

 SPLICE AT POLE BASE

ALL 3CS CABLES SHALL RUN WITHOUT SPLICES OR TERMINATION FROM THE OPTICOM DETECTORS TO THE TERMINATION POINT INSIDE THE CONTROLLER CABINET.

 WIRE RUN NUMBER.

WIRING FOR PHASES 2 AND 6, AND FOR PHASES 4 AND 8 SHALL BE CONNECTED TOGETHER AS SHOWN.


ROUTE 3CS FROM PREEMPT SENSOR 4 TO THIRD AVE. AND MAIN ST.

GENERAL NOTES



1. INSTALL VEHICLE SIGNAL HEADS WITH THE TYPE "N" ASTRO BRAC MOUNTING.
2. INSTALL PEDESTRIAN SIGNAL HEADS WITH THE TYPE "E" CLAMSHELL MOUNTING.
3. ALL VEHICLE SIGNAL HEADS SHALL HAVE TUNNEL VISORS.
4. ALL PEDESTRIAN SIGNAL HEADS SHALL HAVE EGGCRATE VISORS.
5. DELIVER SALVAGED WIRE, CABLE, SIGNAL HEADS AND CONTROLLERS TO THE CITY OF FERNDALE MAINTENANCE YARD.
6. WIRING FOR PEDESTRIAN SIGNAL SHALL BE INSTALLED TO EACH SIGNAL POLE AS PART OF THE BASIC CONTRACT.
7. SIGNAL POLES SHALL BE TAPPED, DRILLED AND PLUGGED BY THE MANUFACTURER TO ACCOMMODATE THE FUTURE INSTALLATION OF PEDESTRIAN PUSH-BUTTON ASSEMBLIES, TYPE PPB-1AB, AND PEDESTRIAN SIGNALS.
8. THE LOCATIONS OF THE JUNCTION BOXES DEPICTED ON THE PLANS ARE APPROXIMATE. THE CONTRACTOR SHALL FIELD MARK THE LOCATIONS FOR REVIEW AND ACCEPTANCE BY THE ENGINEER BEFORE CONSTRUCTION COMMENCES. JUNCTION BOXES SHALL BE POSITIONED OUT OF EXISTING WHEEL CHAIR RAMPS AND SHALL NOT STRADDLE CONCRETE SCORE LINE.
9. ALL CONDUIT USED FOR RISERS SHALL BE RIGID STEEL CONDUIT.
10. OPTICAL DETECTOR CABLE SHALL NOT BE SPLICED.

CONSTRUCTION NOTES


1. INSTALL A SIGNAL POLE FOUNDATION; A TYPE II GALVANIZED STEEL POLE; A MAST ARM WITH TWO VEHICLE SIGNAL HEADS, ONE STREET NAME SIGN AND ONE LEFT-TURN-YIELD-ON-GREEN SIGN; AND TWO PEDESTRIAN SIGNAL HEADS ON THE POLE.
2. INSTALL A SIGNAL POLE FOUNDATION; A TYPE II GALVANIZED STEEL POLE; A MAST ARM WITH TWO VEHICLE SIGNAL HEADS, ONE OPTICOM PRE-EMPTION SENSOR AND ONE STREET NAME SIGN; AND TWO PEDESTRIAN SIGNAL HEADS ON THE POLE.
3. INSTALL A SIGNAL POLE FOUNDATION, A TYPE II GALVANIZED STEEL POLE; A MAST ARM WITH TWO VEHICLE SIGNAL HEADS; AND ONE STREET NAME SIGN; AND TWO PEDESTRIAN SIGNAL HEADS ON THE POLE.
4. NOT IN CONTRACT.
5. REMOVE AND SALVAGE GUY ANCHORS, SPAN WIRE, ELECTRICAL CABLE AND SIGNAL HEADS, CUT SIGNAL POLES FLUSH WITH SIDEWALK, DISPOSE OF SIGNAL POLES. GROUT REMAINING POLE STUBS FLUSH WITH THE SIDEWALK.
6. REMOVE AND SALVAGE EXISTING CONTROLLER.
7. INSTALL FOUNDATION, CONTROLLER CABINET AND CONTROLLER AND ASSOCIATED EQUIPMENT. USE EXISTING POWER DROP AND METER BASE FOR EXISTING CONTROLLER TO EXTEND SERVICE TO NEW CONTROLLER.
8. INSTALL THE 3CS SUPPORTED BY THE INTERCONNECT CABLE SPAN FROM WOOD POLE TO WOOD POLE. PLASTIC CABLE TIES SHALL SECURE THE CABLE TO THE CABLE. TIES SHALL BE PLACED APPROXIMATELY 18" APART AND ENDS SHALL BE NEATLY TRIMMED.

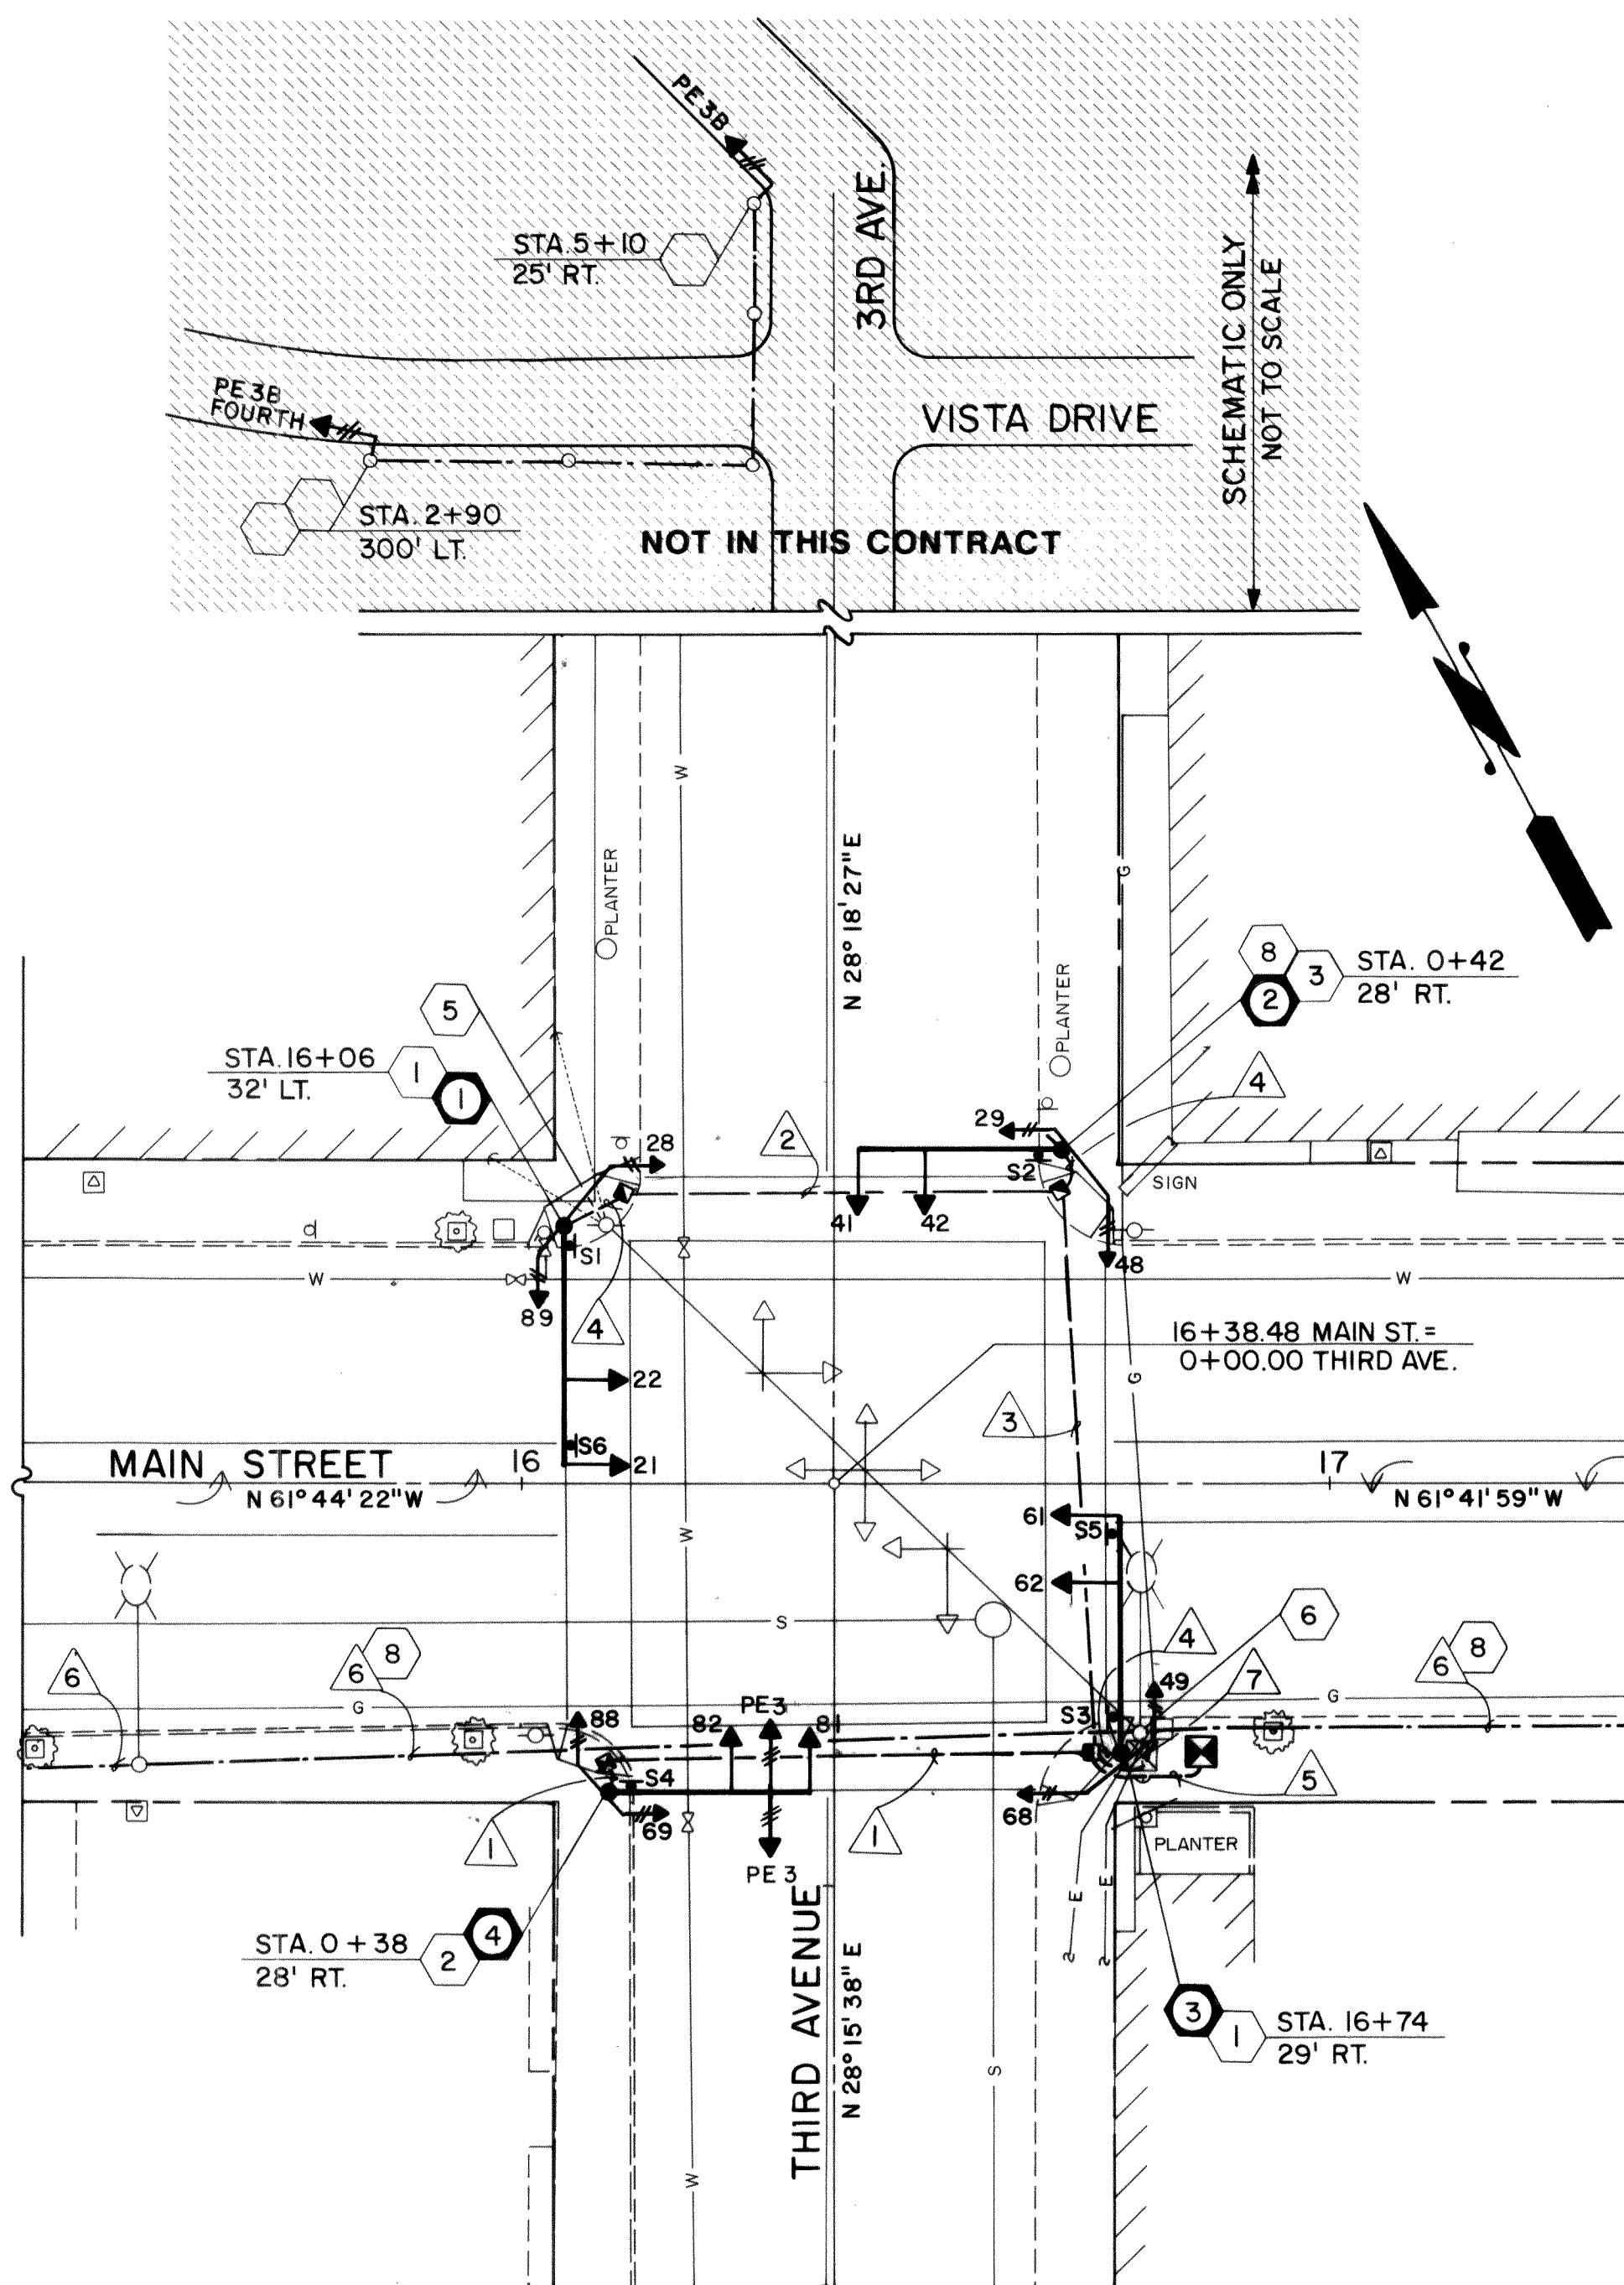


LEGEND:

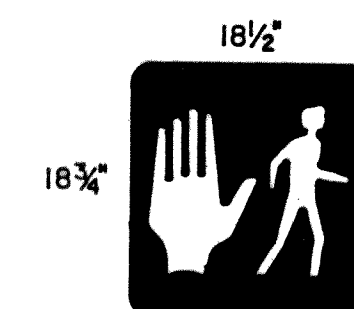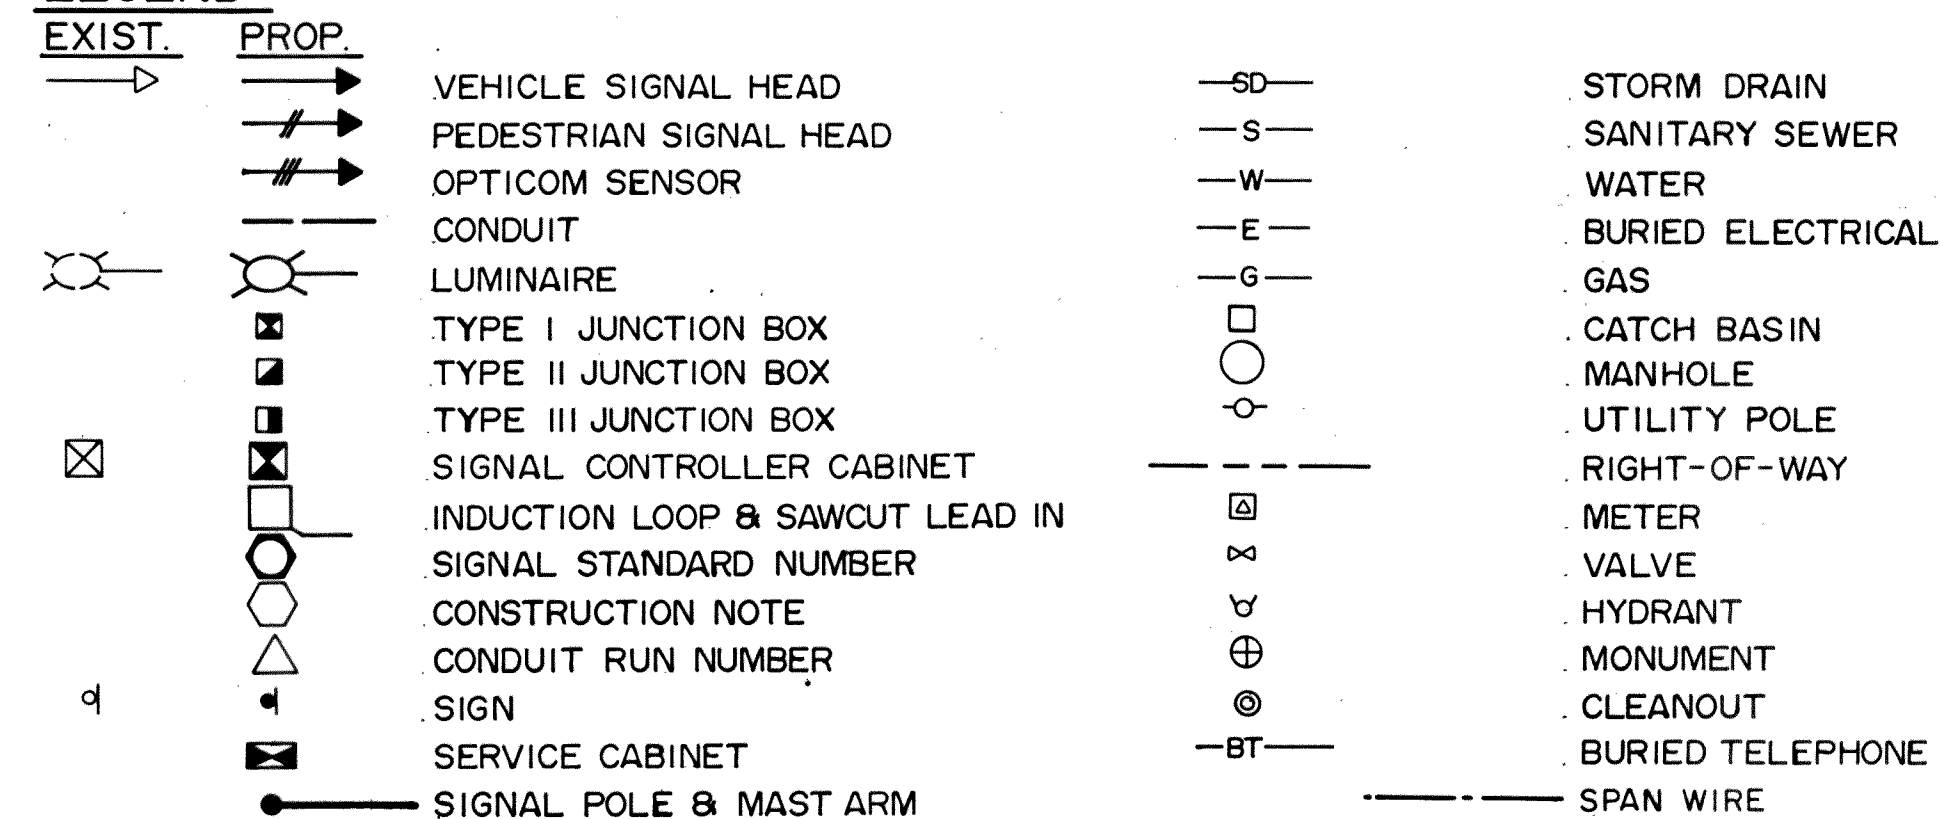


HEADS NO.
28,29,48,49
68,69,88,89

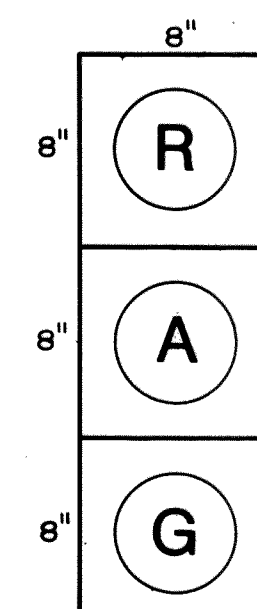

HEADS NO
21, 22
41, 42
61, 62
81, 82

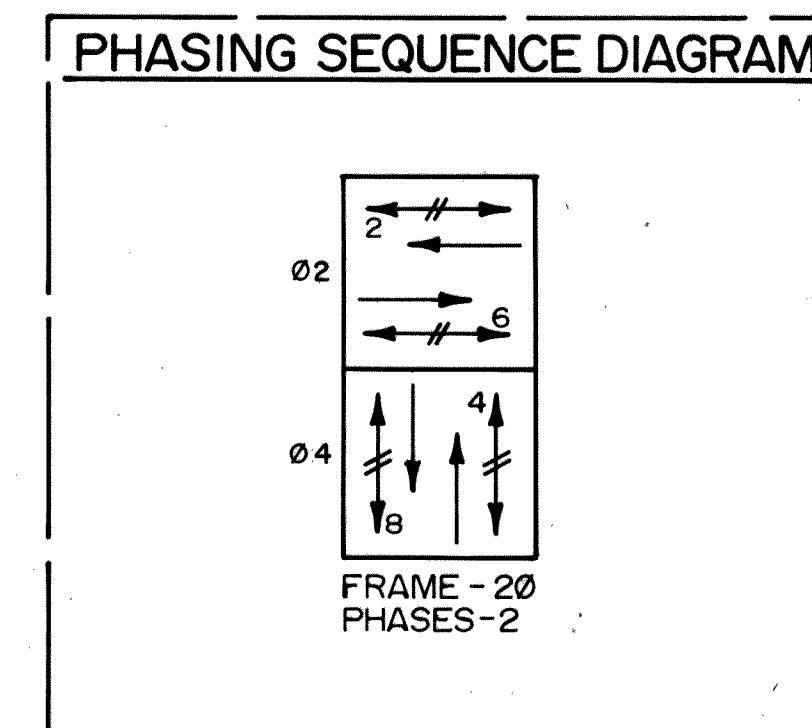

RUN NO.	CONDUIT SIZE	2CS	3CS	5C	#6	INTER-CONNECT	REMARKS
1	3"		1	3			
2	3"			3			
3	4"			6			
4	3"			3			
5	4"		3	3			
	4"			9			
	2"					2	
	1-1/2" 3"				3		Spare
6	Aerial		1			1	
7	2"					2	
	1-1/2"				3		

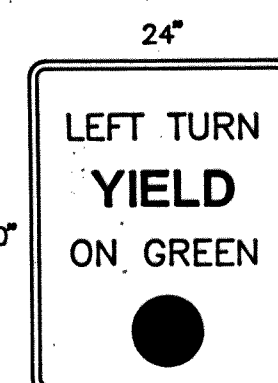

S5 & S6
 (R|O-|2)

48"

12"

MAIN ST

S2 & S4



60"

12"

THIRD AVE

STREET NAME SIGNS


No.	Date	By	Ckd.	Appr.	Revision

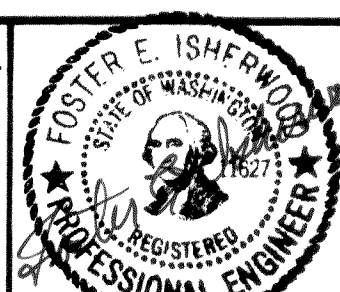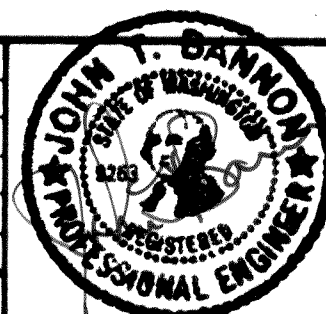

Approved By:

Approved By: John F. Eley

Drawn By: 1000 LRC/STV Date: 5-89
Designed By: JS 5/23/89
Checked By: JS 5/23/89
Approved By: JS 5/24/89

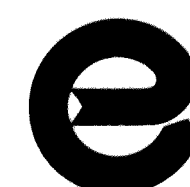**ENTRANCO ENGINEERS, INC.**


Kirkland and Everett, WA

Phoenix, AZ

Scale :
 Horiz. $1''=20'$
 Vert. N/A
 Job No. :
 288617-10

CITY OF FERNDALE
TRAFFIC SIGNAL IMPROVEMENTS
MAIN STREET AT THIRD AVENUE
SIGNAL PLAN

Sheet 4
of 10

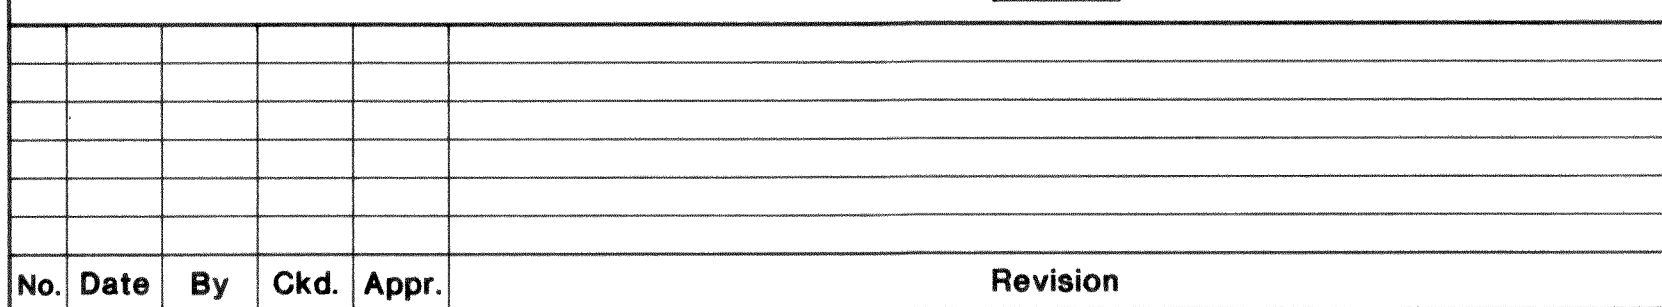

Drawn By:	Date:
<i>[Signature]</i>	2/11/8
Designed By:	2/11/8
<i>[Signature]</i>	2/11/8
Checked By:	2/11/8
<i>[Signature]</i>	2/11/8
Approved By:	2/11/8
<i>[Signature]</i>	2/11/8



CITY OF FERNDALE	
TRAFFIC SIGNAL IMPROVEMENTS	
MAIN STREET AT THIRD AVENUE	
WIRING DIAGRAM	

Sheet 5
of 10







[illegible]

GENERAL NOTES

1. INSTALL VEHICLE SIGNAL HEADS WITH THE TYPE "N" ASTRO BRAC MOUNTING.
2. INSTALL PEDESTRIAN SIGNAL HEADS WITH TYPE TYPE "E" CLAMSHELL MOUNTING.
3. ALL VEHICLE SIGNAL HEADS SHALL HAVE TUNNEL VISORS.
4. ALL PEDESTRIAN SIGNAL HEADS SHALL HAVE EGGCRATE VISORS.
5. DELIVER SALVAGED WIRE, CABLE, SIGNAL HEADS AND CONTROLLERS TO THE CITY OF FERNDALE MAINTENANCE YARD.
6. WIRING FOR PEDESTRIAN SIGNALS SHALL BE INSTALLED TO EACH SIGNAL POLE AS PART OF THE BASIC CONTRACT.
7. SIGNAL POLES SHALL BE TAPPED, DRILLED AND PLUGGED BY THE MANUFACTURER TO ACCOMMODATE THE FUTURE INSTALLATION OF PEDESTRIAN PUSH-BUTTON ASSEMBLIES, TYPE PPB-1AB, AND PEDESTRIAN SIGNALS.
8. THE LOCATIONS OF THE JUNCTION BOXES DEPICTED ON THE PLANS ARE APPROXIMATE. THE CONTRACTOR SHALL FIELD MARK THE LOCATIONS FOR REVIEW AND ACCEPTANCE BY THE ENGINEER BEFORE CONSTRUCTION COMMENCES. JUNCTION BOXES SHALL BE POSITIONED OUT OF EXISTING WHEEL CHAIR RAMPS AND SHALL NOT STRADDLE CONCRETE SCORE LINE.
9. ALL CONDUIT USED FOR RISERS SHALL BE RIGID STEEL CONDUIT.

CONSTRUCTION NOTES


1. INSTALL A SIGNAL POLE FOUNDATION; A TYPE II GALVANIZED STEEL POLE; A MAST ARM WITH TWO VEHICLE SIGNAL HEADS, ONE STREET NAME SIGN AND ONE LEFT-TURN-YIELD-ON-GREEN SIGN; AND TWO PEDESTRIAN SIGNAL HEADS ON THE POLE.
2. INSTALL A SIGNAL POLE FOUNDATION; A TYPE II GALVANIZED STEEL POLE; A MAST ARM WITH TWO VEHICLE SIGNAL HEADS, ONE STREET NAME SIGN; AND TWO PEDESTRIAN SIGNAL HEADS ON THE POLE.
3. INSTALL FOUNDATION, CONTROLLER CABINET AND CONTROLLER AND ASSOCIATED EQUIPMENT. USE EXISTING POWER DROP AND METER BASE FOR NEW CONTROLLER SERVICE.
4. REMOVE AND SALVAGE EXISTING CONTROLLER AND ASSOCIATED EQUIPMENT.
5. REMOVE AND SALVAGE GUY ANCHORS, SPAN WIRE, ELECTRICAL CABLE AND SIGNAL HEADS. CUT SIGNAL POLES FLUSH WITH SIDEWALK, DISPOSE OF SIGNAL POLES, GROUT REMAINING POLE STUBS FLUSH WITH SIDEWALK.
6. AWNING TO BE REMOVED BY OTHERS. COORDINATE WITH BUILDING OWNER.
7. INSTALL THE 3CS SUPPORTED BY THE INTERCONNECT CABLE SPAN FROM WOOD POLE TO WOOD POLE. PLASTIC CABLE TIES SHALL SECURE THE CABLE TO THE CABLE. TIES SHALL BE PLACED APPROXIMATELY 18" APART AND ENDS SHALL BE NEATLY TRIMMED.
8. INSTALL A SIGNAL POLE FOUNDATION; A TYPE II GALVANIZED STEEL POLE; A MAST ARM WITH TWO VEHICLE SIGNAL HEADS AND ONE STREET NAME SIGN; TWO PEDESTRIAN SIGNAL HEADS ON THE POLE; AND ONE OPTICOM PREEMPT SENSOR.

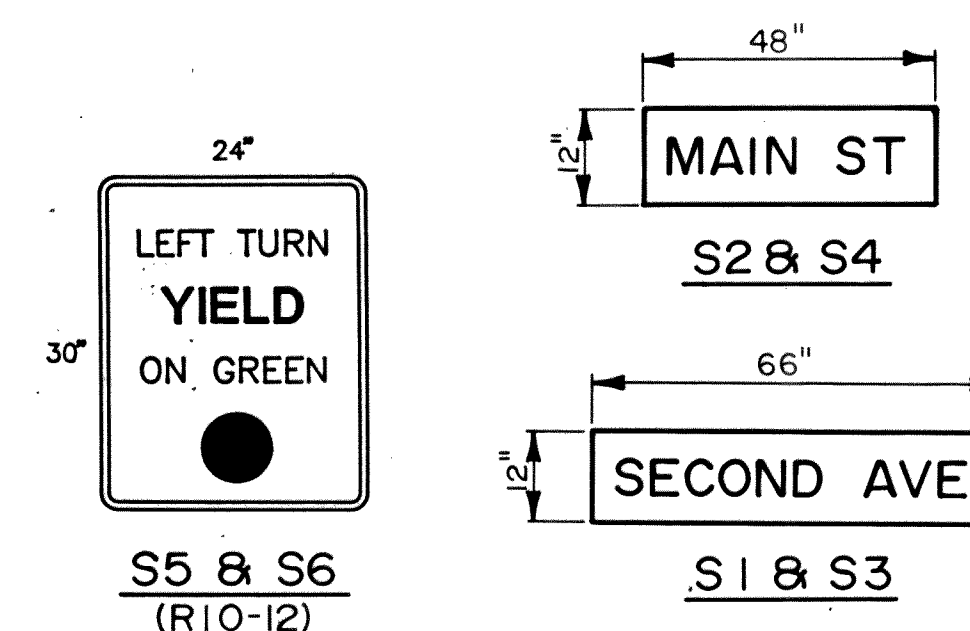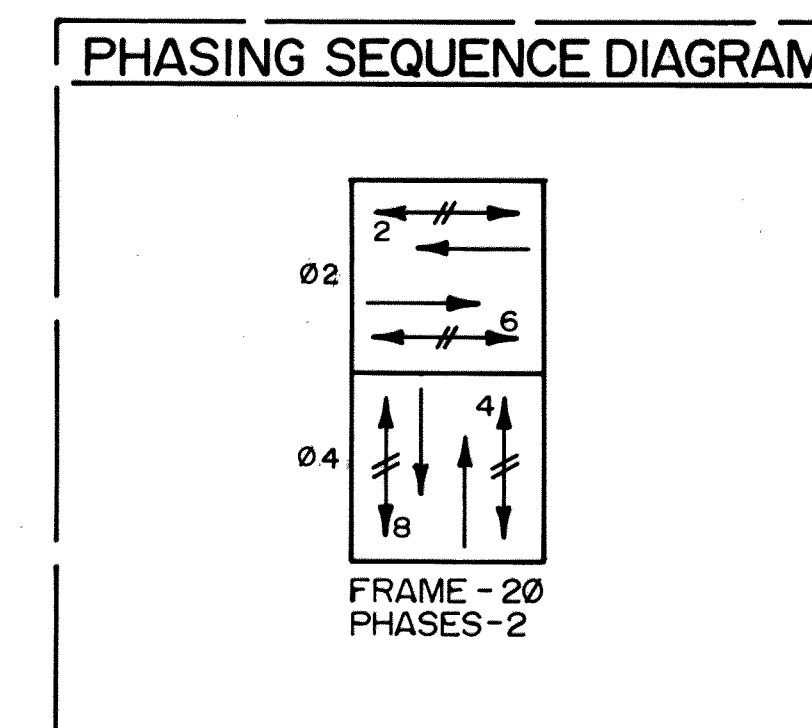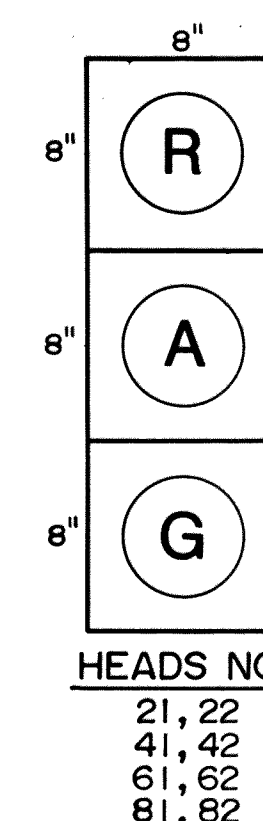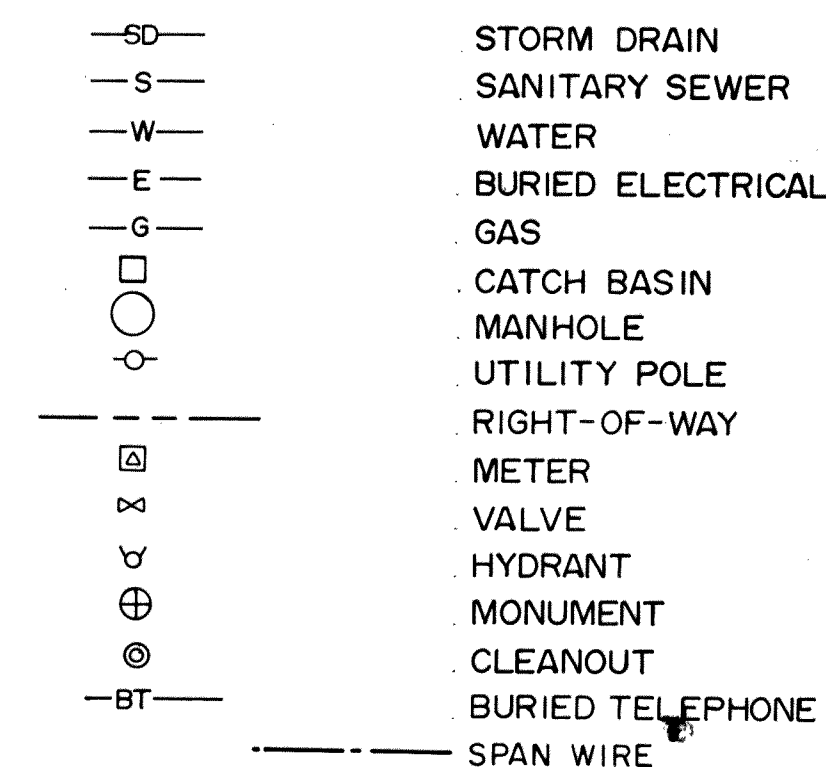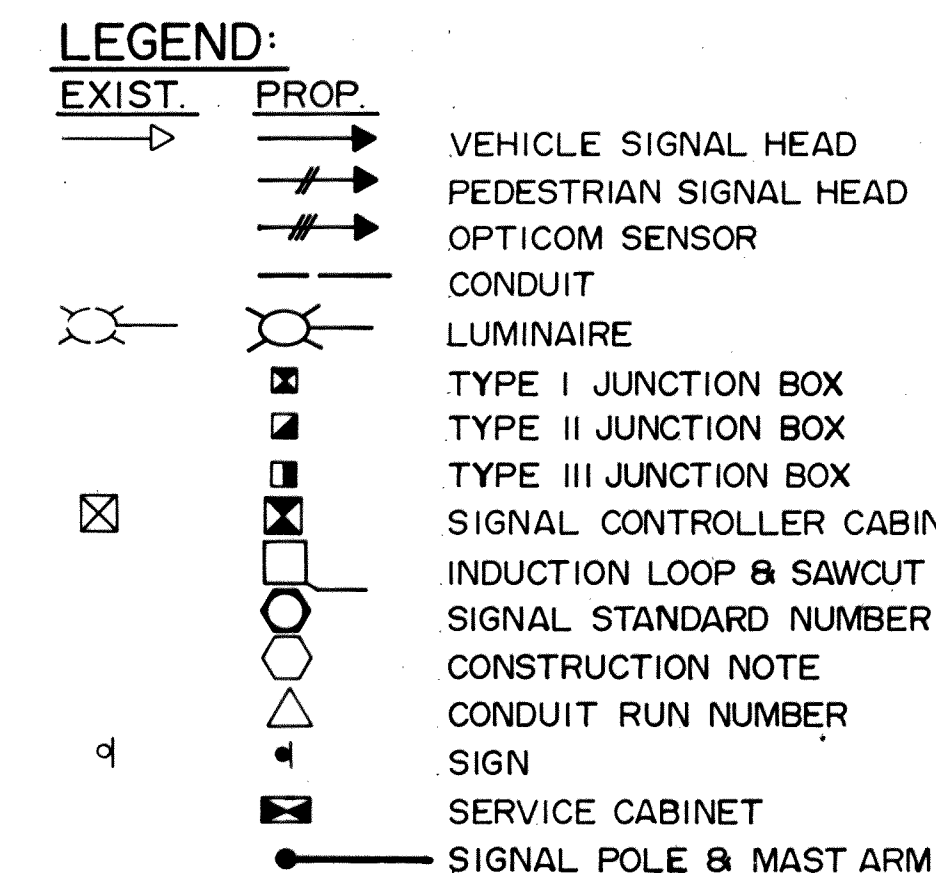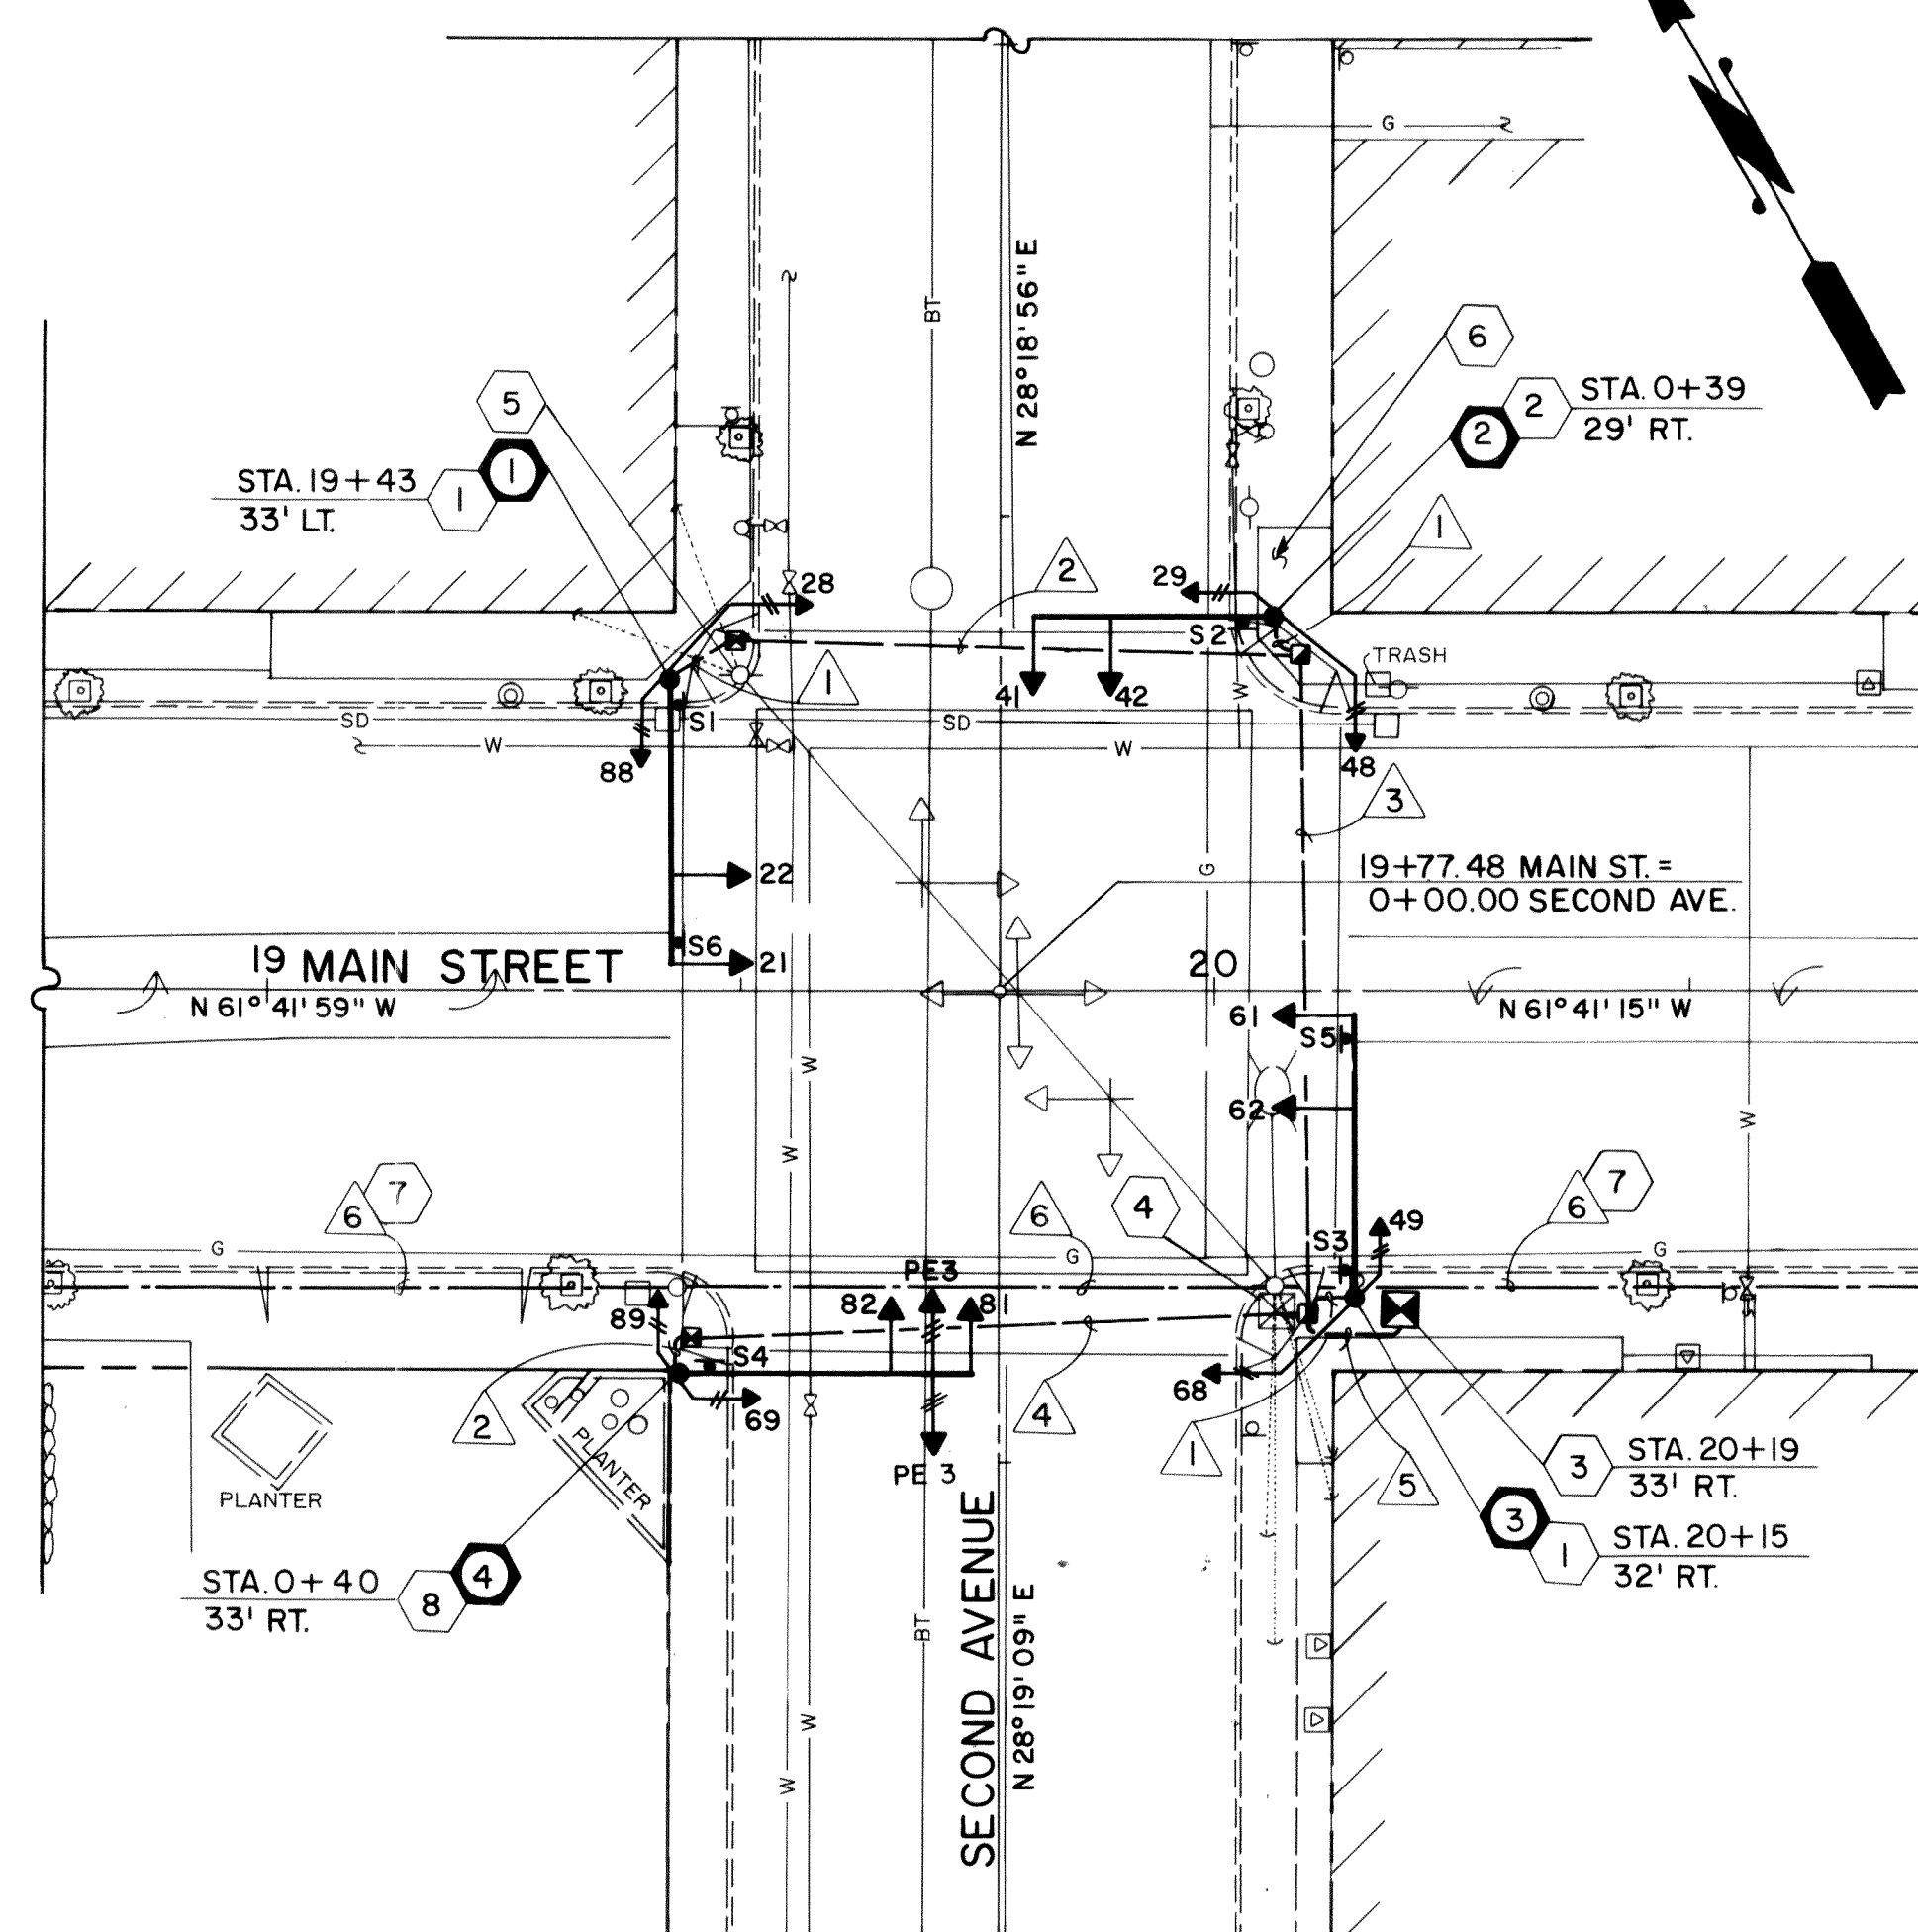

STREET NAME SIGNS
(D3-301)

WIRING SCHEDULE							
RUN NO.	CONDUIT SIZE	2CS	3CS	5C	#6	INTER-CONNECT	REMARKS
1	3"			3			
2	3"		1	3			
3	4"			6			
4	3"		1	3			
5	4"		1	3			
	4"			9			
	2"					2	
	1-1/2"				3		
	3"						Spare
6	Aerial					1	

									Approved By: <u>John T. Bannon</u>		Drawn By: <u>John T. Bannon</u> Date: <u>5/21/89</u>		Designed By: <u>John T. Bannon</u> Checked By: <u>John T. Bannon</u> Approved By: <u>John T. Bannon</u> Date: <u>5/21/89</u>		 ENTRANCO ENGINEERS, INC. Kirkland and Everett, WA Phoenix, AZ		Scale: <u>1" = 20'</u> Horiz. <u>N/A</u> Vert. <u>N/A</u> Job No.: <u>288617-10</u>		CITY OF FERNDALE TRAFFIC SIGNAL IMPROVEMENTS MAIN STREET AT SECOND AVENUE SIGNAL PLAN		Sheet <u>6</u> Of <u>10</u>	
No. Date By Ckd. Appr. Revision																						

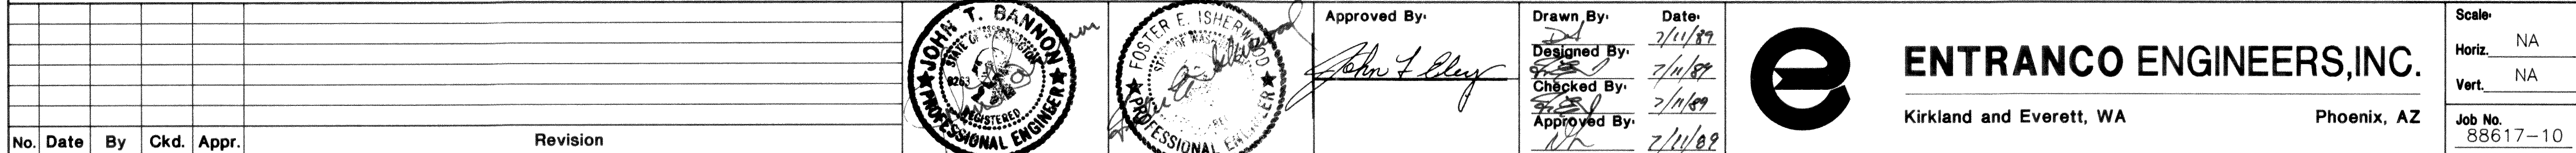

1

NO TERMINAL REQUIRED.
CONNECT IDENTIFIED WIRES
TO NEUTRAL (AC-) BUS.

NO TERMINAL REQUIRED.
CONNECT IDENTIFIED WIRES
TO DETECTOR COMMON BUS.

TERMINAL REQUIRED.
CONNECT IDENTIFIED WIRES
TO IDENTIFIED TERMINAL.

	NOTE	PPB	HEAD	θ
501		AC+		
502		AC-		
521				
522		FIRE CALL 1		4
523				
524				
525		FIRE CALL 2		6
526				
527				
528		FIRE CALL 3		8
529				
530				
531		FIRE CALL 4		2
532				

621		21,22	2
622			
623			
624			
626	X		

641		41,42	4
642			
643			
644			
646	X		

661		61,62	2
662			
663			
664			
666	X		


681		81,82	4
682			
683			
684			
686	X		

721				
722				
723	X			
724		28,29		
725	+	28,29		
			28,29	
				2

741				
742				
743	X		48,49	
744		48,49		
745	+			
				4

761				
762				
763	x		69,69	
764				
765	+	68,69		

781			88,89	4
782				
783	X			
784		88,89		
785	+	88,89		

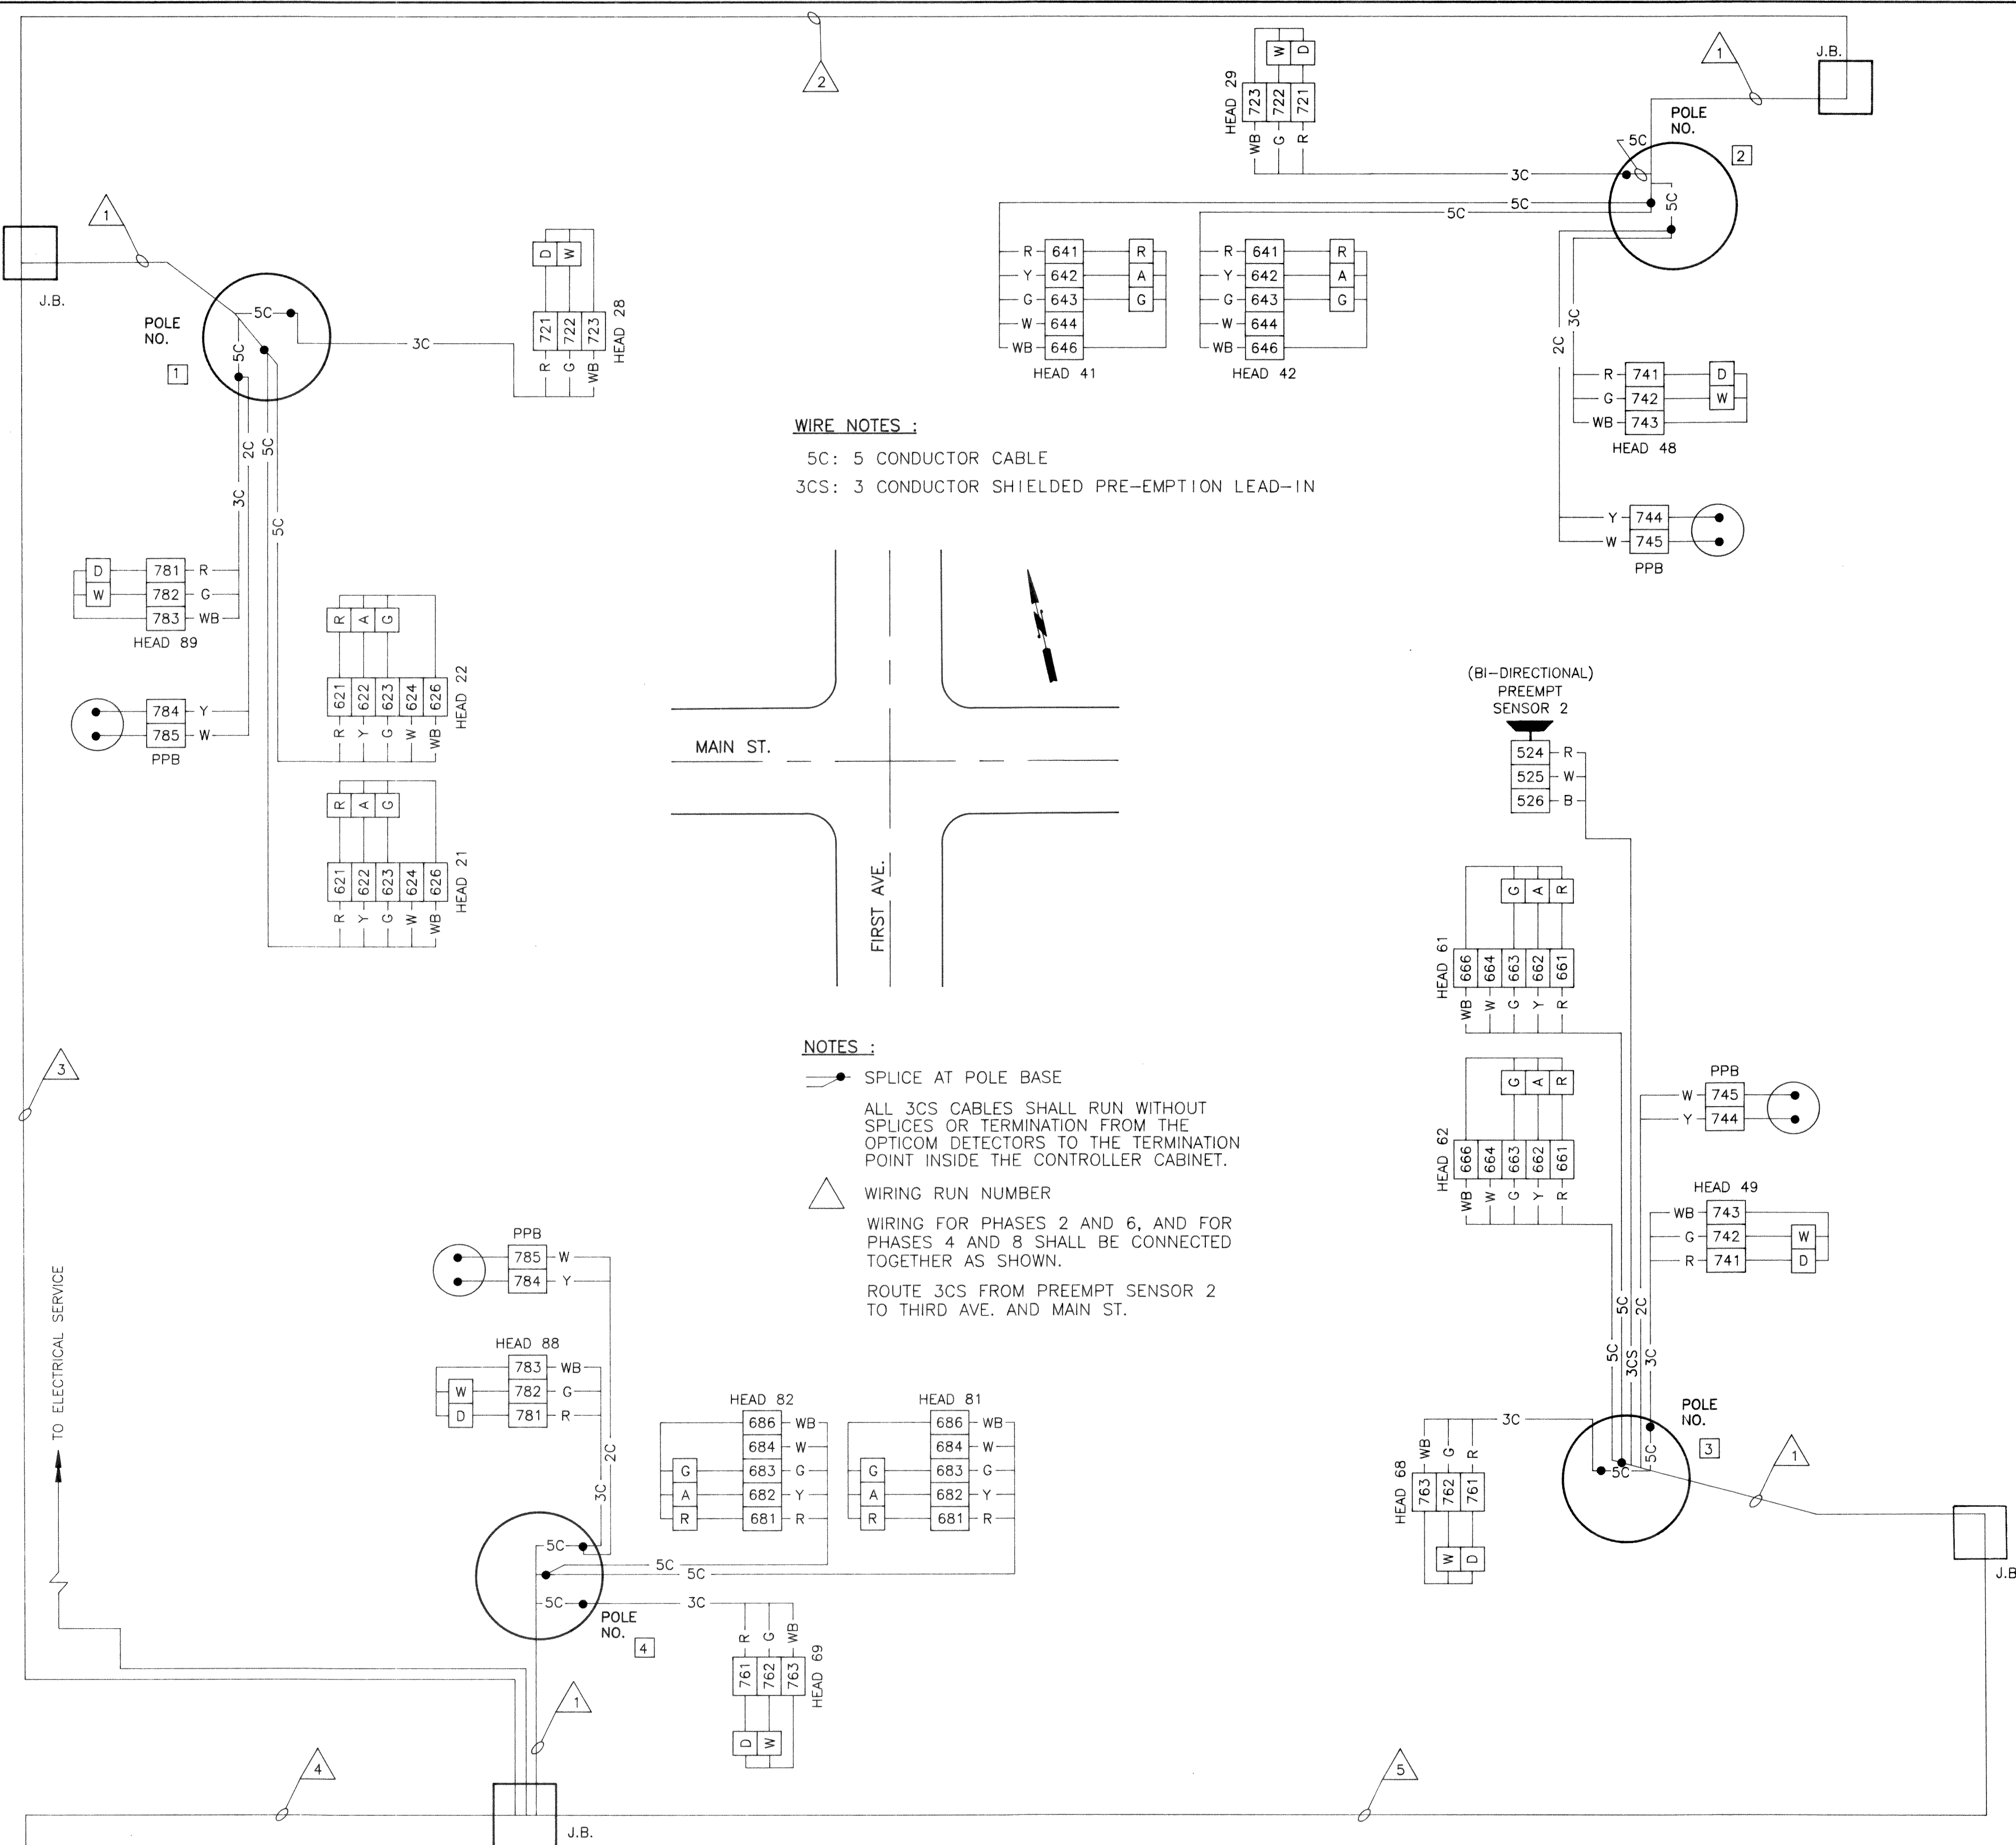

5C: 5 CONDUCTOR CABLE
3CS: 3 CONDUCTOR SHIELDED PRE-EMPTION LEAD-IN

 SPLICE AT POLE BASE


ALL 3CS CABLES SHALL RUN WITHOUT SPLICES OR TERMINATION FROM THE OPTICOM DETECTORS TO THE TERMINATION POINT INSIDE THE CONTROLLER CABINET.

 WIRING RUN NUMBER

WIRING FOR PHASES 2 AND 6, AND FOR PHASES 4 AND 8 SHALL BE CONNECTED TOGETHER AS SHOWN.

ROUTE 3CS FROM PREEMPT SENSOR 2 TO THIRD AVE. AND MAIN ST.


No.	Date	By	Ckd.	Appr.	Revision
-----	------	----	------	-------	----------

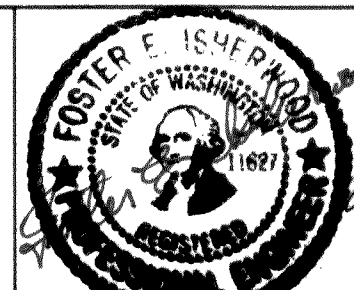

John F. Clay

Designed By: 7/11/8
Checked By: 7/11/8
Approved By: 7/11/8

7/11/8
7/11/8
7/11/8

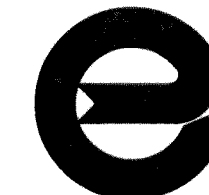

Phoenix, AZ


Job No.

CITY OF FERNDALE	
TRAFFIC SIGNAL IMPROVEMENTS	
MAIN STREET AT FIRST AVENUE	
WIRING DIAGRAM	

Sheet 9
of 10





- a. Vehicle Signal Head
- b. Lane Control Sign
- c. Street Name Sign
- d. Pre-Empt Detector
- e. Pre-Empt Indicator
- f. Pedestrian Signal Head
- g. Cabinet
- h. Pedestrian Push Button Assembly, J-5a
- i. Handhole
- j. Luminaire

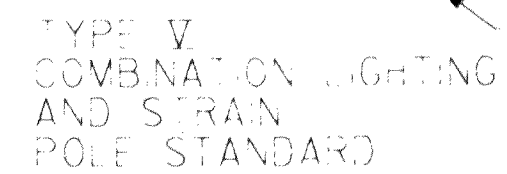

ST.D. NO.	FIELD LOCATION				STRAIN POLE CLASS	TYPE	MOUNTING HEIGHT(FT)	SIGNAL MAST ARM DATA																				LUMINAIRE ARM(FT)	POLE ATTACHMENT POINT ANGLES(deg)								FOUNDATION DEPTHS(FT) ④				REMARKS	
	STATION	OFFSET(FT)	L	R				OFFSET DISTANCES (FT) (Z) (POLE C TO ATTACHMENT POINT)										WINDLOAD AREAS (FT) ² (X)(Y)											(X)(Y)(Z) ³	D	E1	E2	F	G1	G2	H	I1	I2	3' RD.	3' SQ.		4' RD.
								A1	A2	B1	B2	B3	B4	B5	B6	B7	B8	B9	B10	B11	B1	B2	B3	B4	B6	B7	B9															
1	9+60	42	X	0		II	18.5	35	33	25		30		5.0	8	5	8					5.5	672.5					70	180		0	270	10	7	7	FOURTH & MAIN						
2	0+38	38		X	0	II	18.5	30		22		26		4.0	8		8					4.0	632.0					90	180		0	270	10	7	7	"						
3	10+51	40	X	0		II	18.5	35	33			26		5.0	8	5			8			5.5	680.5					70	180		0	270	10	7	7	"						
4	0+42	32		X	0	II	18.5	25		17				4.0	8		8					4.0	352.0					90	180		0	270	10	7	7	"						
1	16+06	32	X	0		II	18.5	30	28	19				4.5	8	5	8					5.0	554.5					90	180		180	270	10	7	7	THIRD & MAIN						
2	0+42	28		X	0	II	18.5	25		17				4.0	8		8					4.0	352.0					90	180		180	270	10	7	7	"						
3	16+74	29		X	0	II	18.5	30	28	22				4.5	8	5	8					5.0	578.5					90	180		180	270	10	7	7	"						
4	0+38	28		X	0	II	18.5	25				22	15	4.0	8				8			4.0	336.0					90	180		180	270	10	7	7	"						
1	19+43	33	X	0		II	18.5	30	28	21				5.0	8	5	8					5.5	575.5					90	180		180	270	10	7	7	SECOND & MAIN						
2	0+39	29		X	0	II	18.5	25		17				4.0	8		8					4.0	352.0					90	180		180	270	10	7	7	"						
3	20+15	32		X	0	II	18.5	30	28	21				5.0	8	5	8					5.5	567.5					90	180		180	270	10	7	7	"						
4	0+40	33		X	0	II	18.5	30		22		26		4.0	8		8					4.0	432.0					90	180		0	270	10	7	7	"						
1	23+14	33	X	0		II	18.5	30	28			20		5.5	8	5	8					4.5	565.0					90	180		90	180	10	7	7	FIRST & MAIN						
2	0+37	23		X	0	II	18.5	20		12				4.0	8		8					4.0	252.0					90	180		180	270	10	7	7	(PPB AT I I)						
3	23+65	37		X	0	II	18.5	30	28	22		26		4.5	8		8					4.5	576.0					90	180		90	270	10	7	7	"						
4	0+38	17		X	0	II	18.5	15		7				4.0	8		8					4.0	192.0					90	180		180	270	10	7								

No.	Date	By	Ckd.	Appr.	Revision

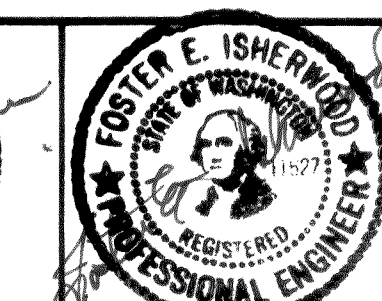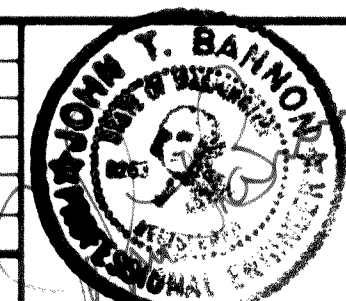

Approved By:

Drawn By :

Date:


STV 5-80

Designed By: 781 562/PS

Checked By:

5/31/81

124/39

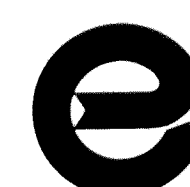**ENTRANCO ENGINEERS, INC.**

Kirkland and Everett, WA

Phoenix, AZ

Scale :

Media: N/A

Horiz. N/A

Vert. N/A

Job No. :

288617-1

CITY OF FERNDALE

TRAFFIC SIGNAL IMPROVEMENTS

SIGNAL POLE SCHEDULE

Sheet 10

10

© 2006 The Authors
Journal compilation © 2006 Blackwell Publishing Ltd

00175.010.2.8.06 KL