


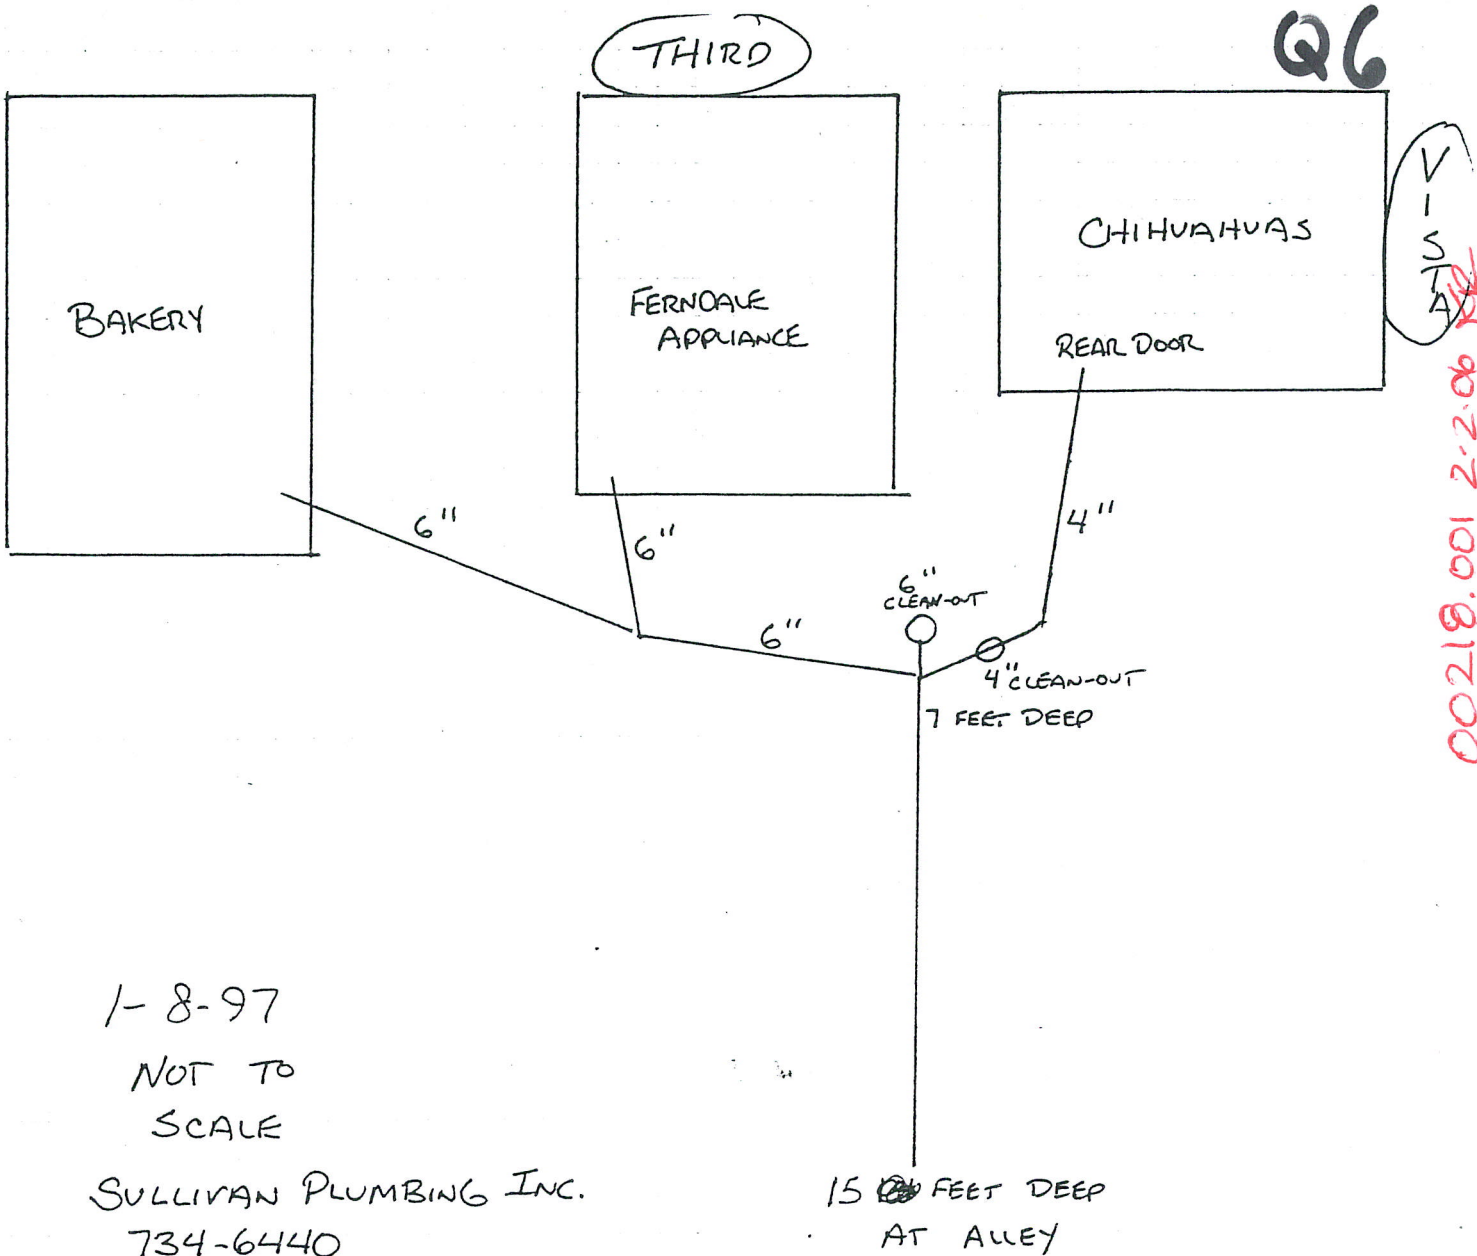

1-8-97

NOT TO
SCALE

SULLIVAN PLUMBING INC.
734-6440

15 ~~20~~ FEET DEEP
AT AVEY

SULLIVAN
PLUMBING

Contractor's License #SULLIP1132RO

(360) 734-6440

Gary S. Jensen

Plumbing in Whatcom County since 1966
State Certified Journeyman Plumber

1825 Franklin St., Bellingham, WA 98225

FAX (360) 647-9561