


CALL BEFORE  
YOU DIG  
1-800-424-5555

- NOTES**
- OFF-SITE FIELD DATA PER LARRY STEELE & ASSOCIATES SURVEYS PERFORMED OCTOBER, 2002.
  - ON-SITE ELEVATION DATA COLLECTED BY FABER BROS. CONSTRUCTION. ON-SITE GRADING IS BASED ON THESE ELEVATIONS, WHICH HAS BEEN TRANSLATED TO CITY OF FERDALE DATUM (NGVD 1929).
  - ALL CONSTRUCTION SHALL BE IN ACCORDANCE WITH CITY OF FERDALE STANDARDS AND CURRENT WSDOT/APWA STANDARD SPECIFICATIONS FOR ROAD, BRIDGE, AND MUNICIPAL CONSTRUCTION.

**AS-BUILT DRAWING CERTIFICATION**

I hereby certify that a representative sample of the improvements in Sam-Cher Phase 3 have been inspected by Millennium Engineering Group, Inc. and constructed in conformance with the plans approved by the Public Works Director for said development and the general specifications adopted by the City of Ferndale Department of Public Works.

**DATUM**  
VERTICAL  
CITY OF FERDALE (NGVD 1929)  
HORIZONTAL  
ASSUMED COORDINATES AT NW PROPERTY CORNER  
N 10000.00 E 10000.00  
**BASIS OF BEARINGS**  
ROS FILED UNDER AF #900503083

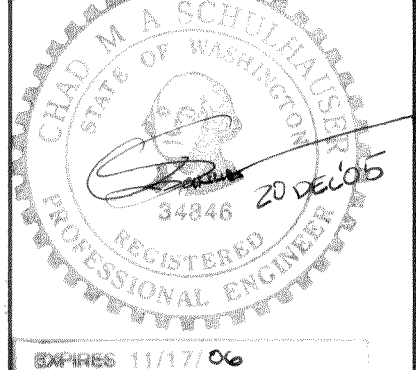

**MILLENNIUM**  
Engineering Group, Inc.

109-3rd ST., PO BOX 137, LYNDEN, WA 98264  
PH: (360) 354-8141 FAX: (360) 354-3744  
mail@2001egi.com www.2001egi.com

SAM-CHER SITE DEVELOPMENT  
8802 HOVANDER ROAD  
**SITE STORMWATER PLAN & WATER CONNECTION - PHASE III**

FOR  
FABER BROS. CONSTRUCTION

PTN. NW1/4, SE1/4, SEC.29, T39N, R2E, W.M.  
CITY OF FERDALE, WHATCOM COUNTY, WASHINGTON

SCALE: 1" = 20'  
DATE: 11/01/05  
DRAWN BY: LLCP  
REVISED: 12/20/05  
SHEET:  
**1 OF 1**  
JOB NUMBER:  
01027C