


480.00
100.00
478.00

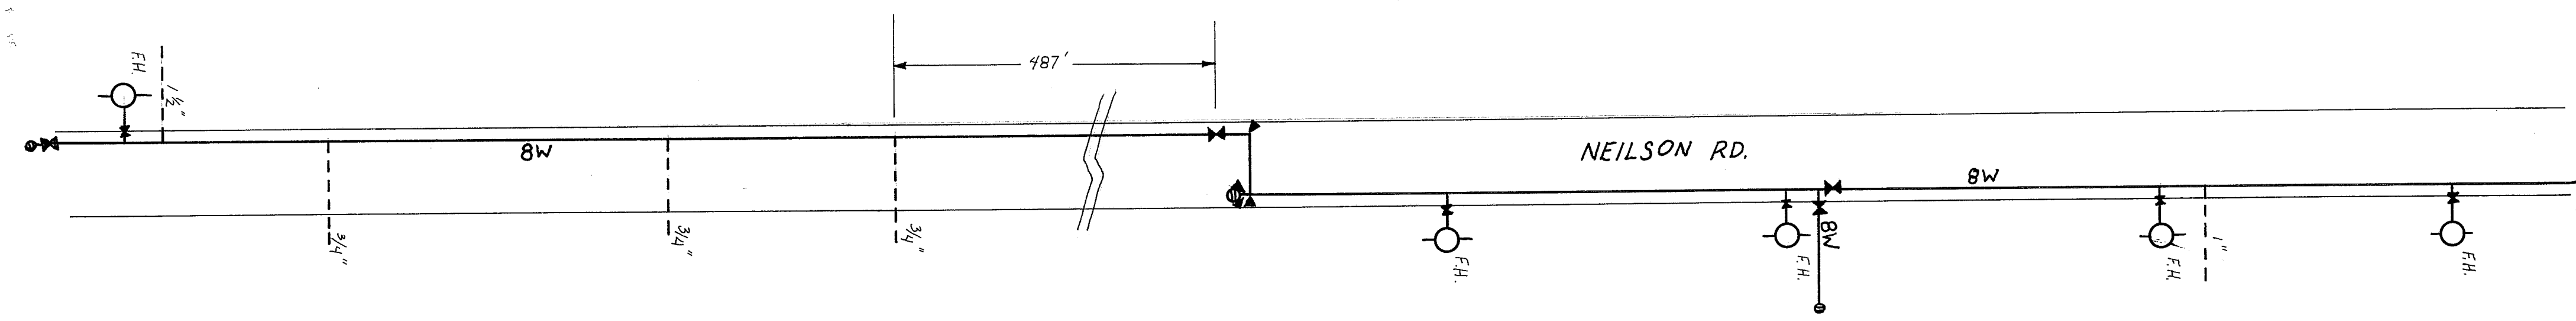

1
N
1" = 100 ft.