


FAI-5
 BELLINGHAM TO FERNDALE
 PSH No. 1
 WHATCOM COUNTY
 Scale: 1"=400' R.L. 64 C.S. 3702
 August, 1963 P.J. McKay Dist. Eng.

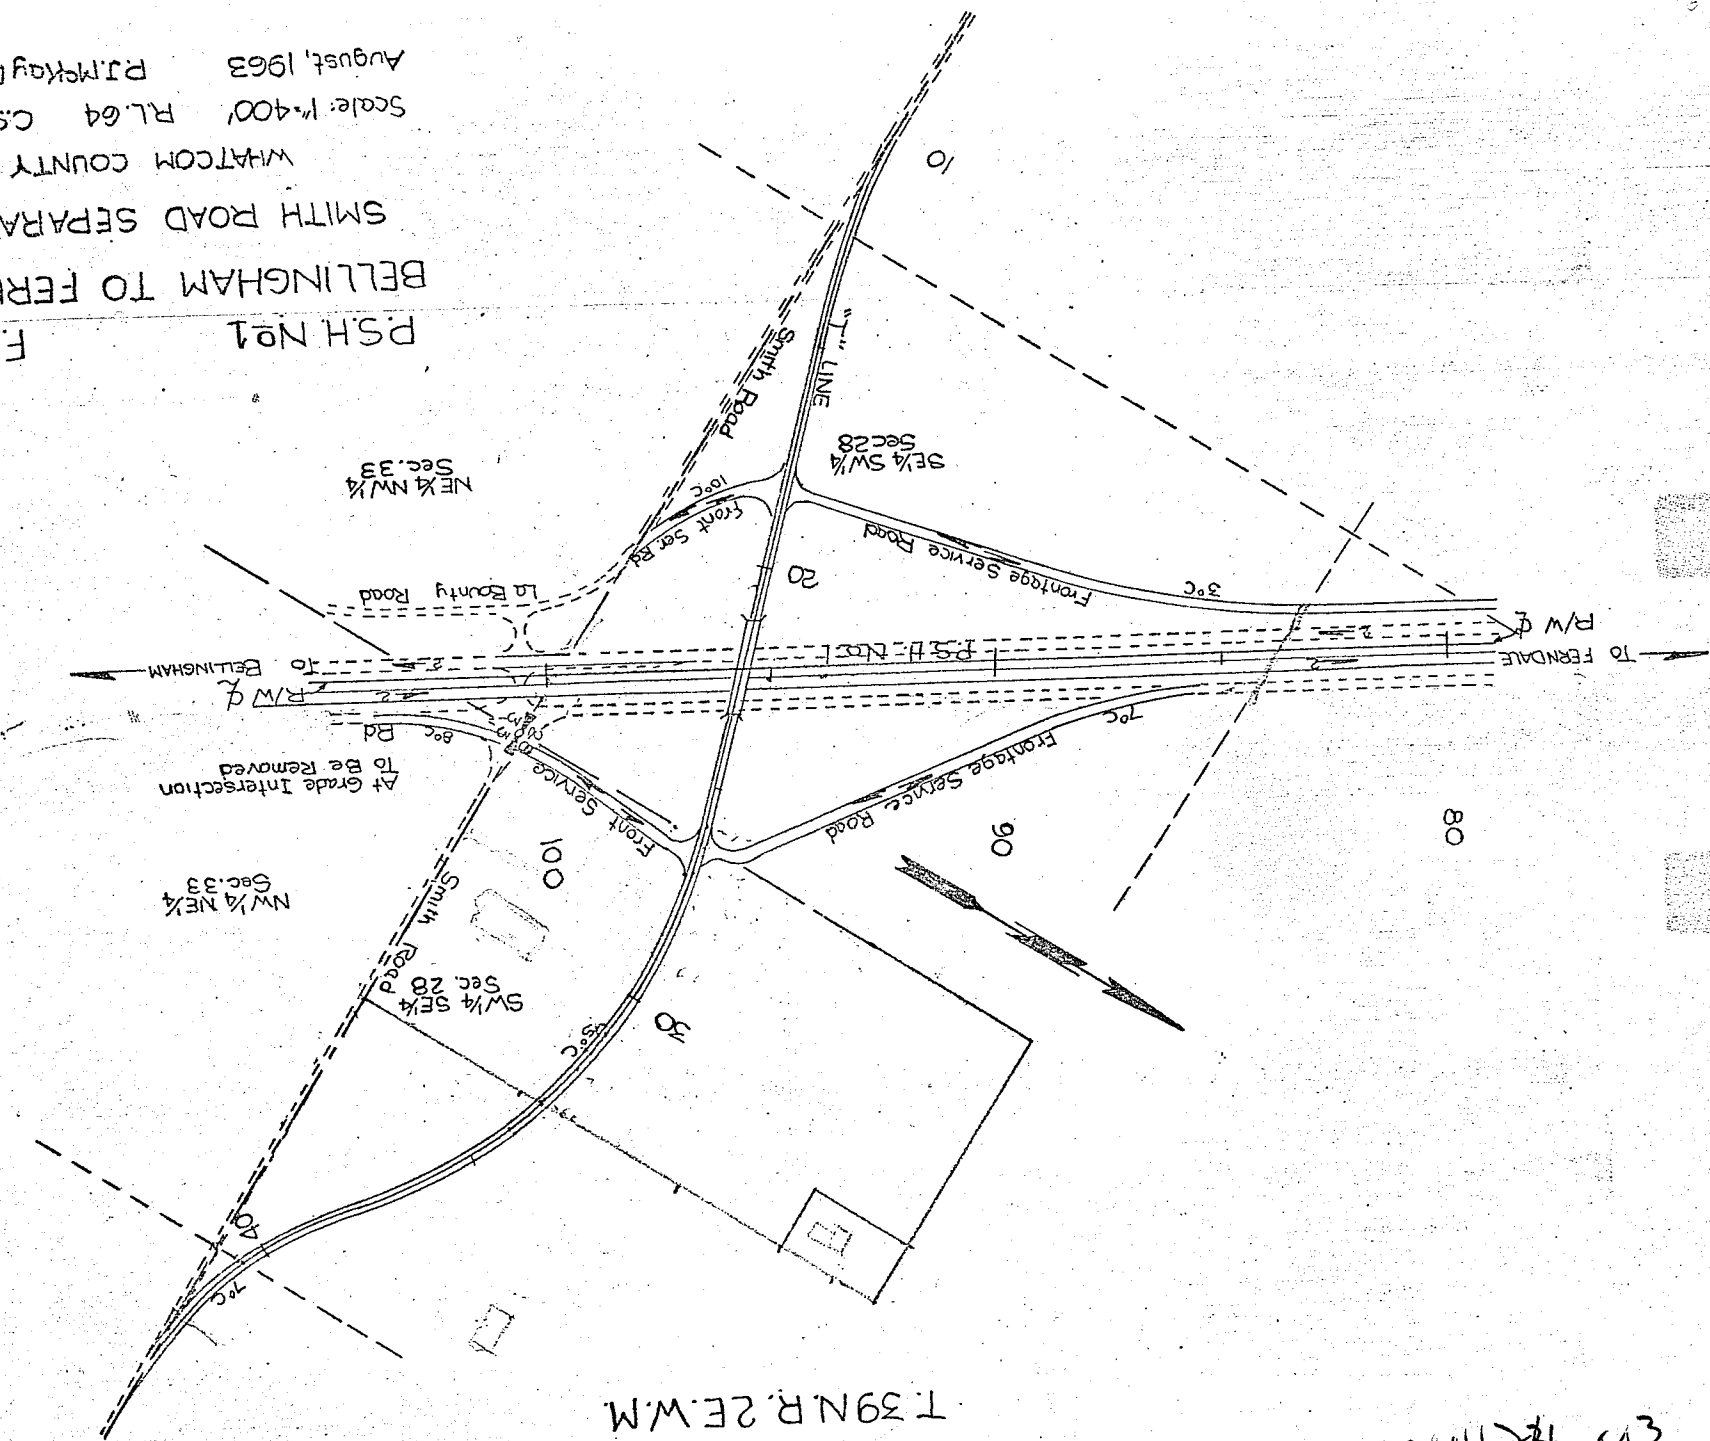


0504.003

XERO COPY

XERO COPY

XERO COPY

XERO COPY

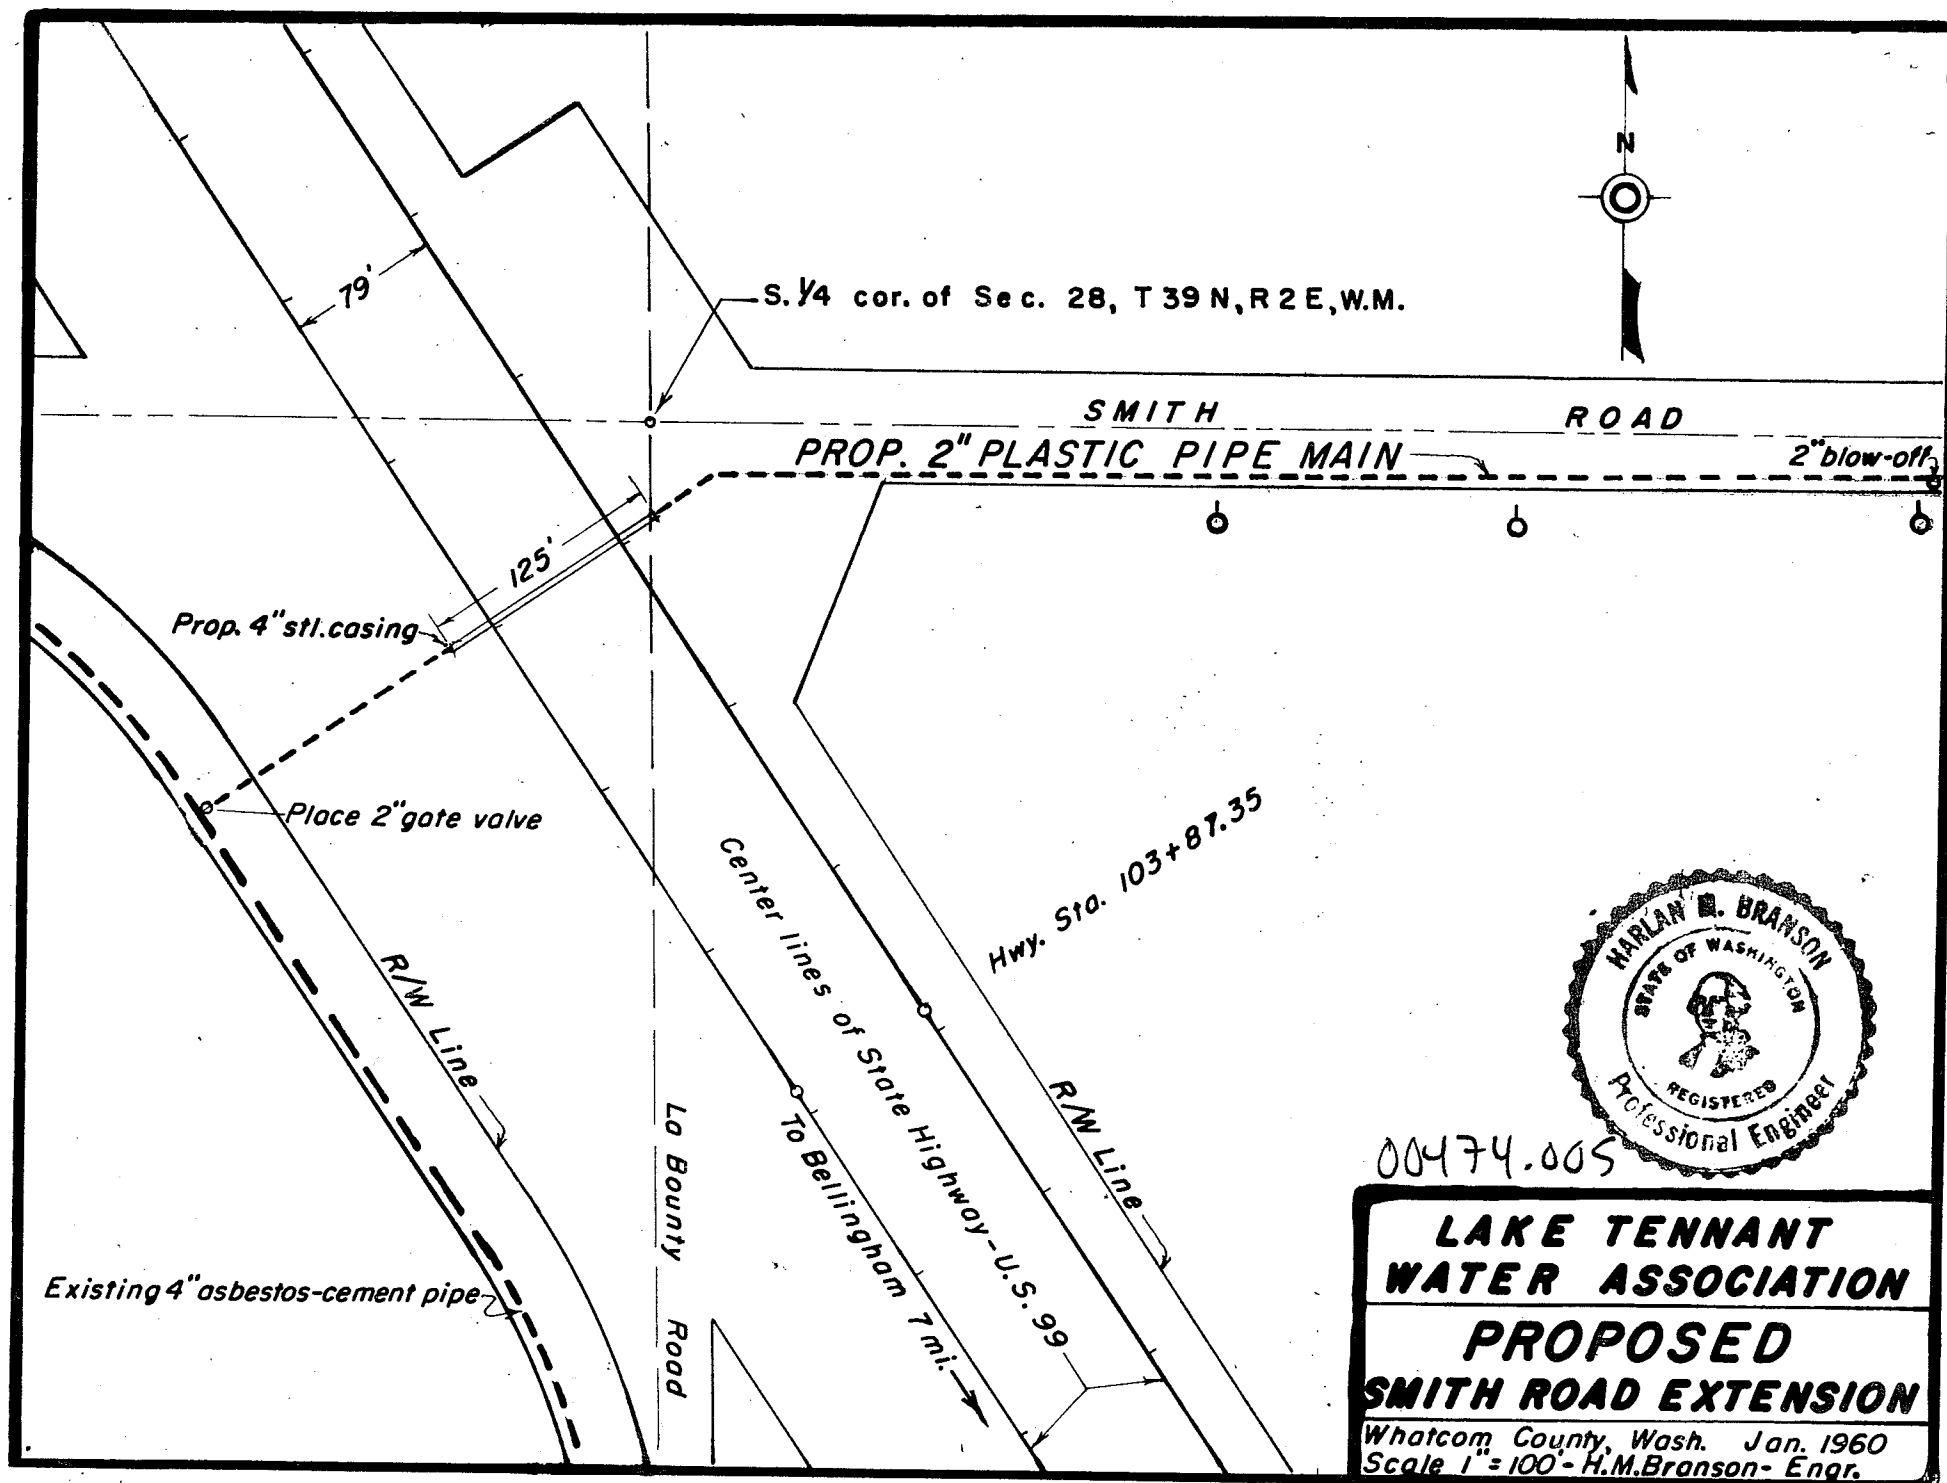



S. 1/4 cor. of Sec. 28, T 39 N, R 2 E, W.M.

SMITH
PROP. 2" PLASTIC PIPE MAIN ROAD

2" blow-off

Prop. 4" stl. casing

Place 2" gate valve


R/W Line

Existing 4" asbestos-cement pipe

Lo Bounty Road


Center lines of State Highway - U.S. 99
Hwy. Sta. 103+87.35
To Bellingham 7 mi.

R/W Line

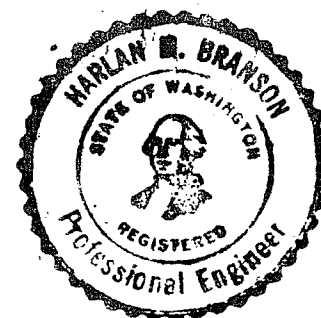

00474.006

**LAKE TENNANT
WATER ASSOCIATION
PROPOSED
SMITH ROAD EXTENSION**
Whatcom County, Wash. Jan. 1960
Scale 1" = 100'

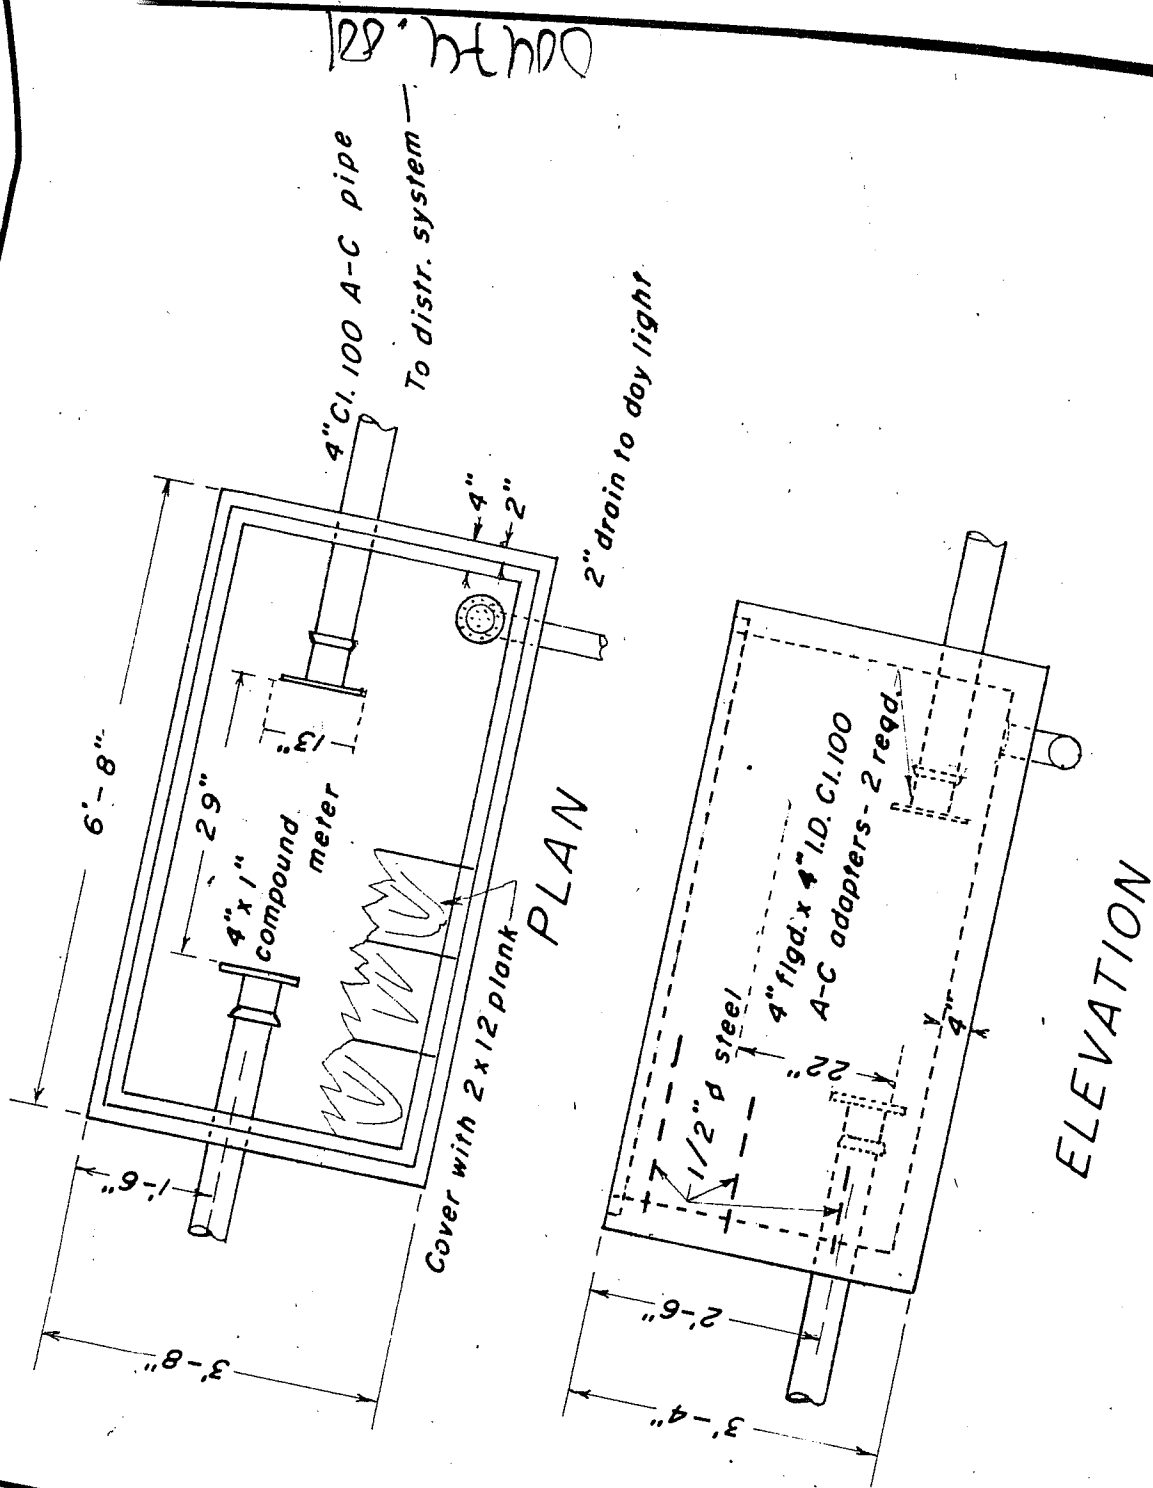

LAKE TENNANT
WATER ASSOCIATION

4" Master Meter

Whatcom County, Wash. July 1959
Scale 1/2" = 1' - Harlan M. Branson, Enr.

P.S.H. No. 1
FAI-5
BELLINGHAM TO FERNDALE
SMITH ROAD SEPARATION
WHATCOM COUNTY
Scale: 1"=400' R.L. 64 C.S. 3702
August, 1963 P.J. McKay Dist. Eng.


P.S.H. No. 1

WATCOM COUNTY

August, 1963

Scale: 1"=400' R.L. 64 C.S. 3702


P.J. McKay Dist. Eng.

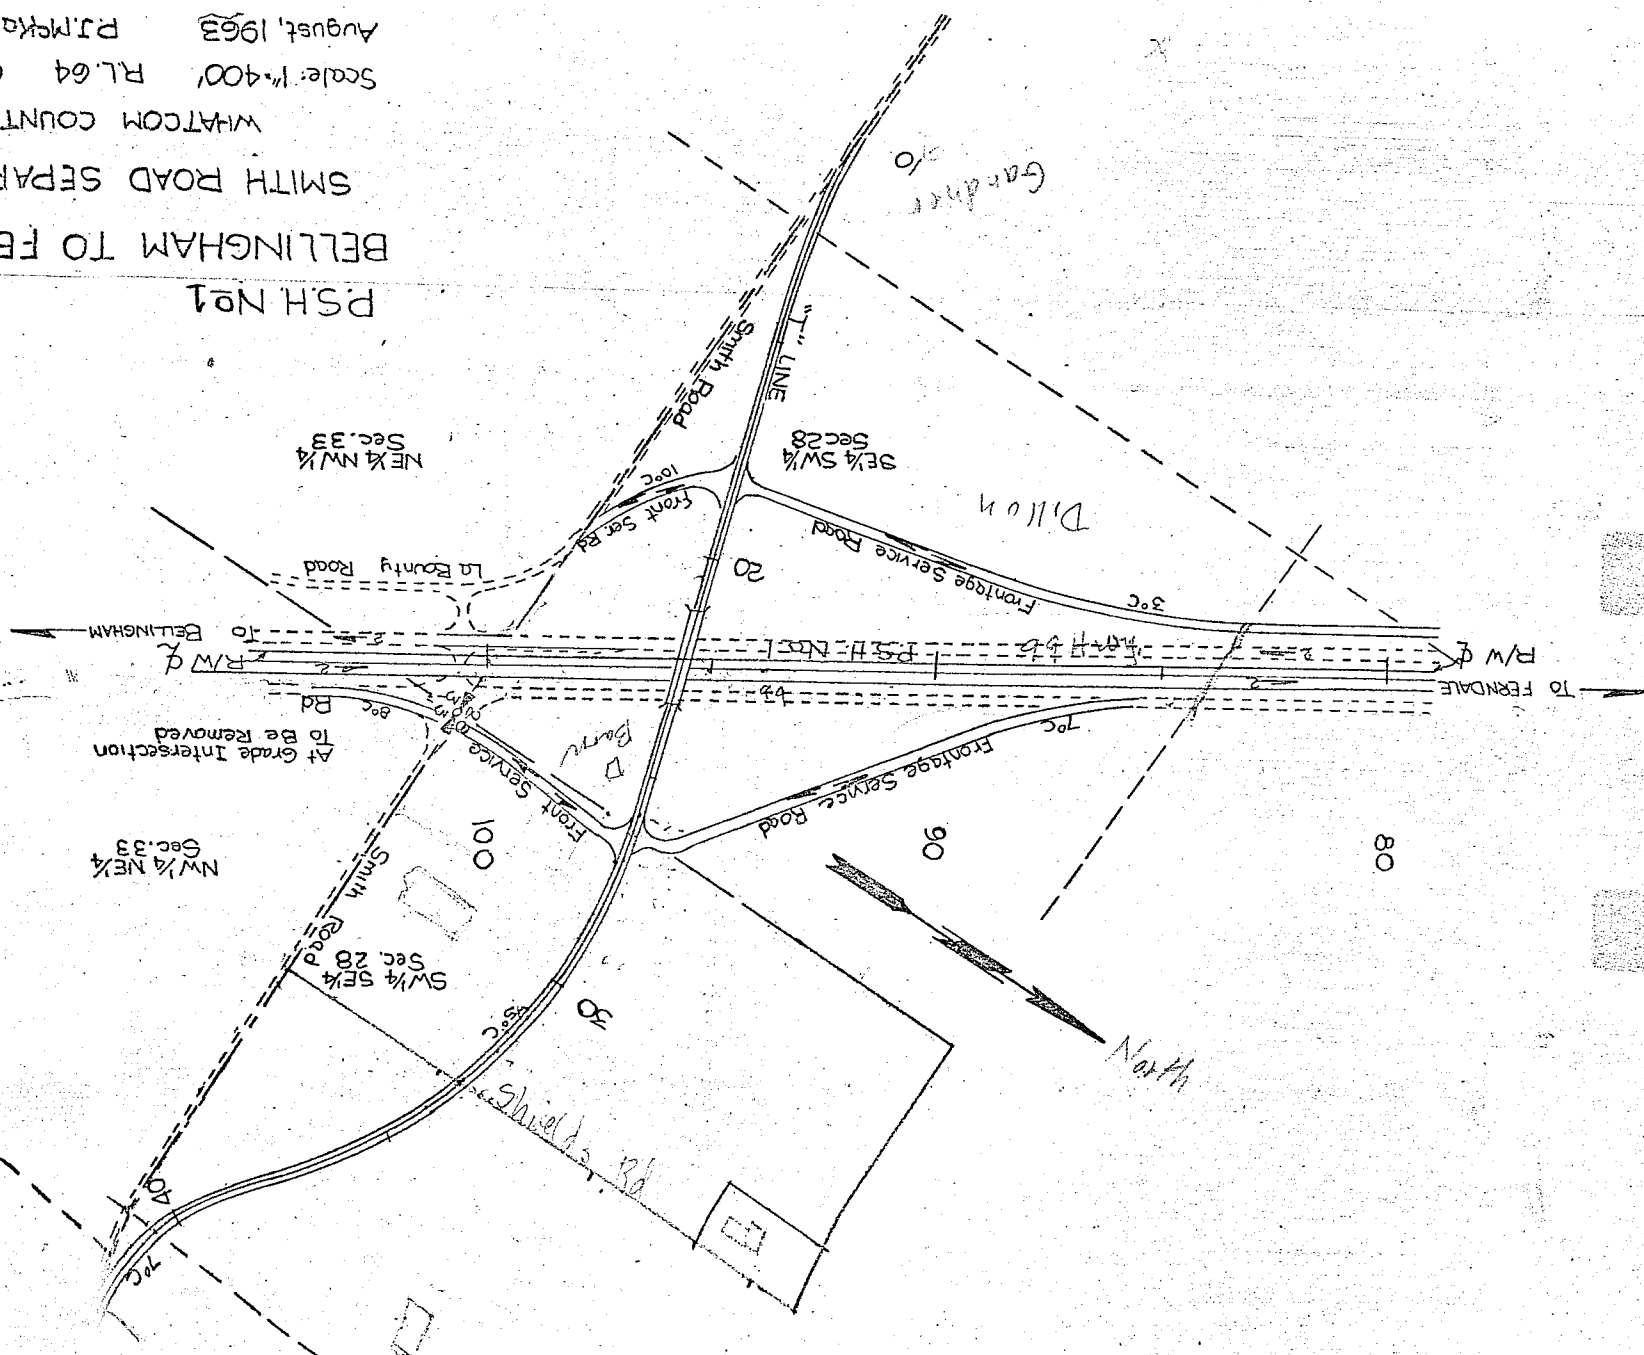

T.39N.R.2E.W.M.

00474.0824

T. 39 N. R. 2 E. W. M.

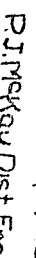



**LAKE TENNANT
WATER ASSOCIATION
PROPOSED
SMITH ROAD EXTENSION**



Whoicom County, Wash. Jan. 1960
Scale 1"=100'-H.M. Branson - Engr.

4444444

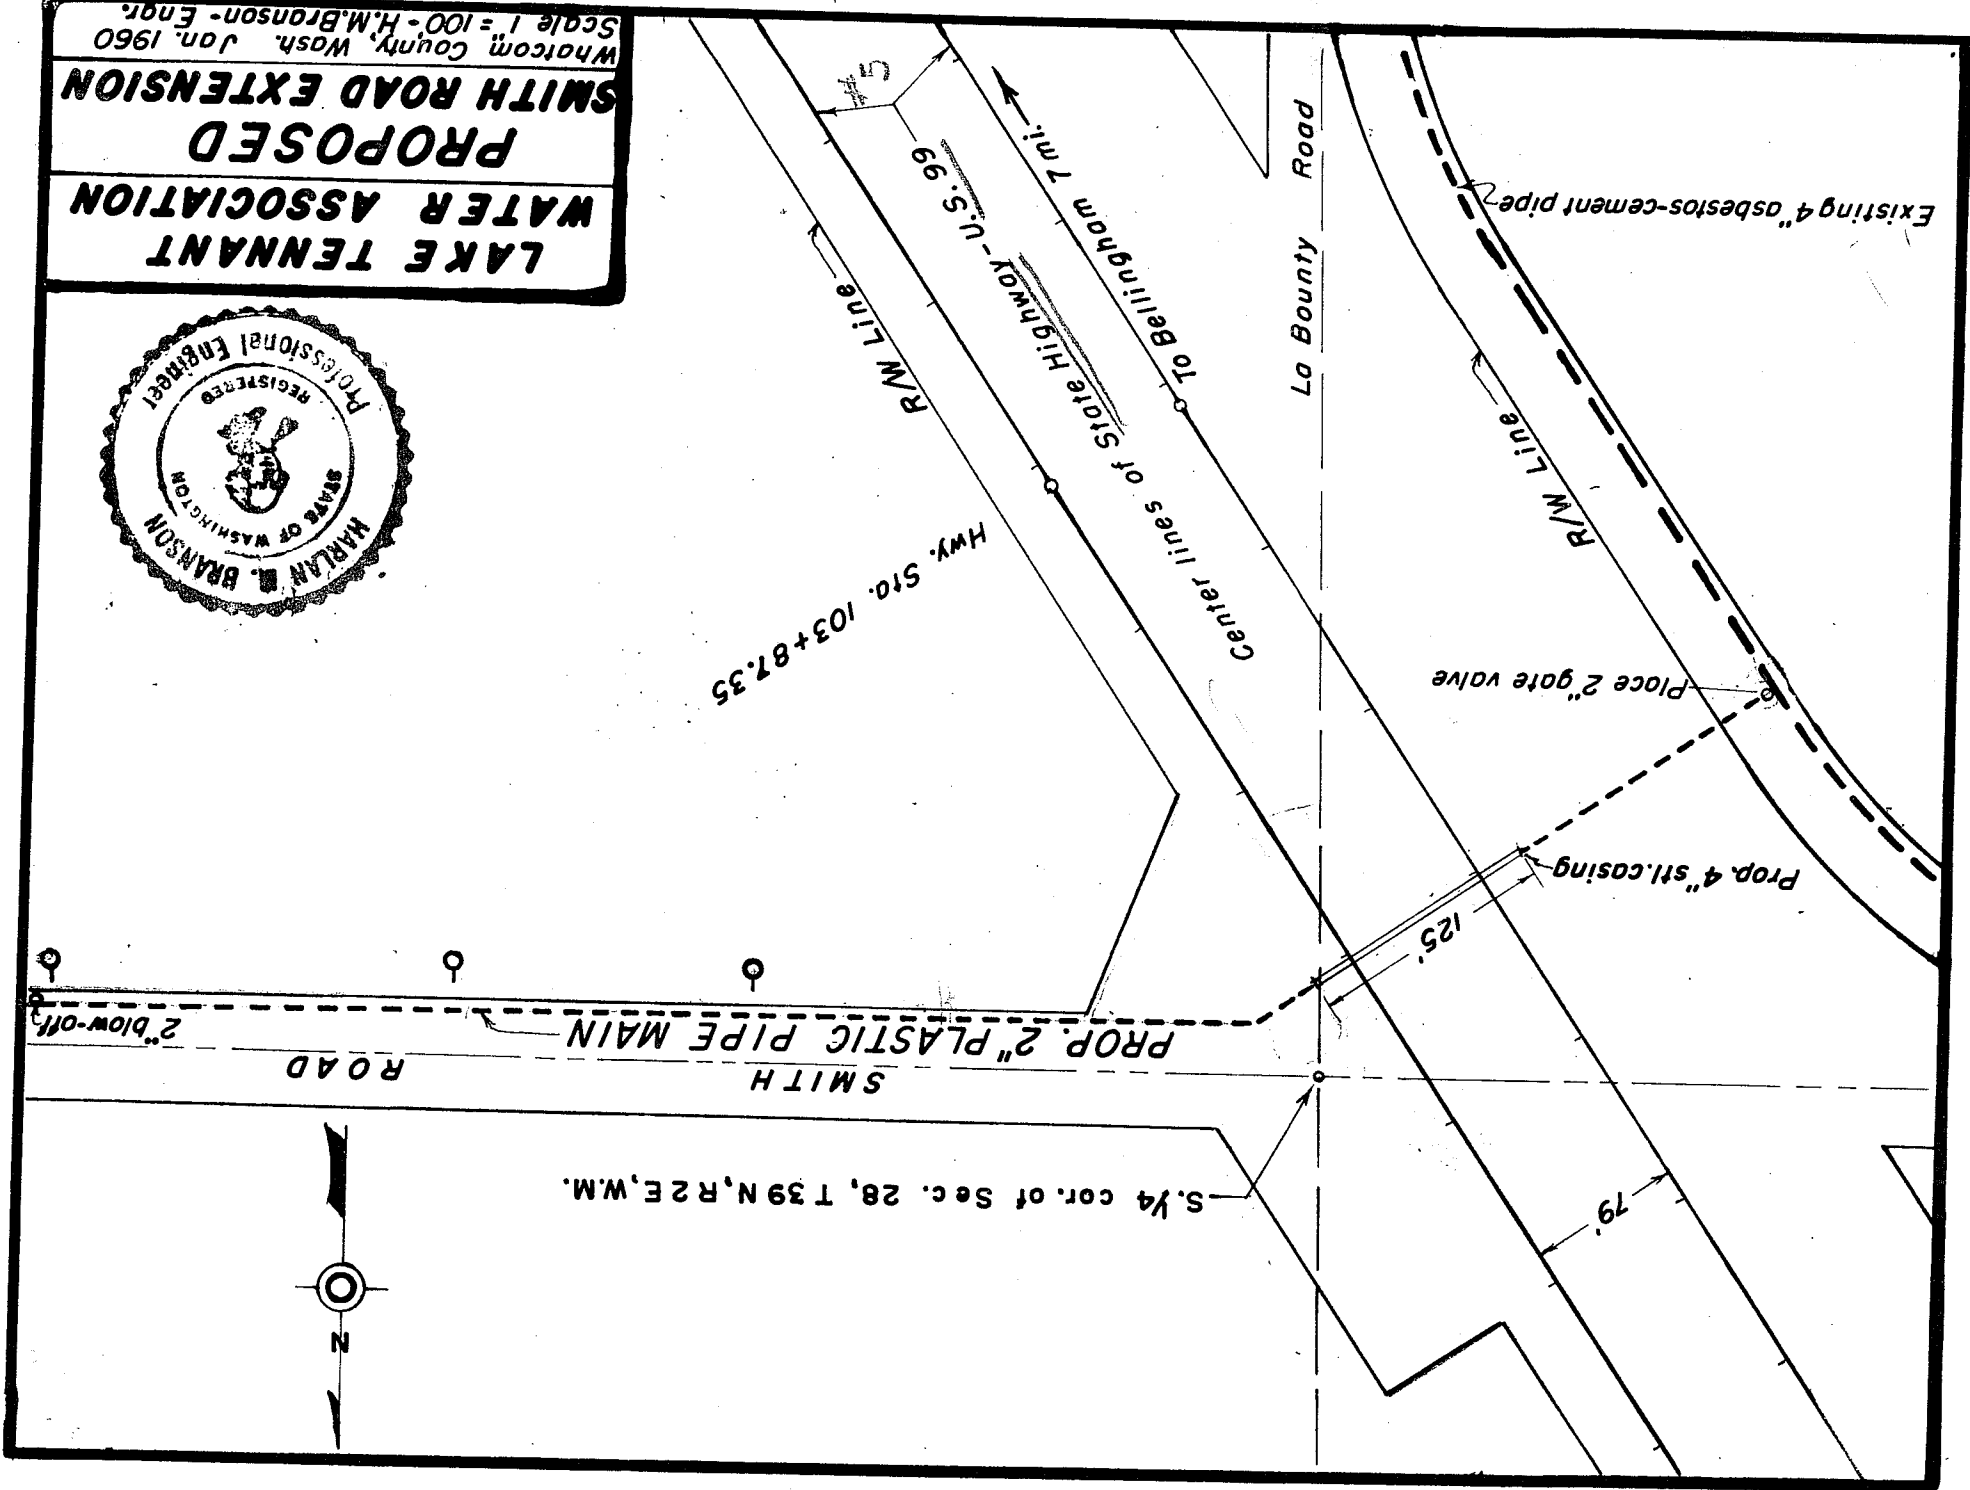

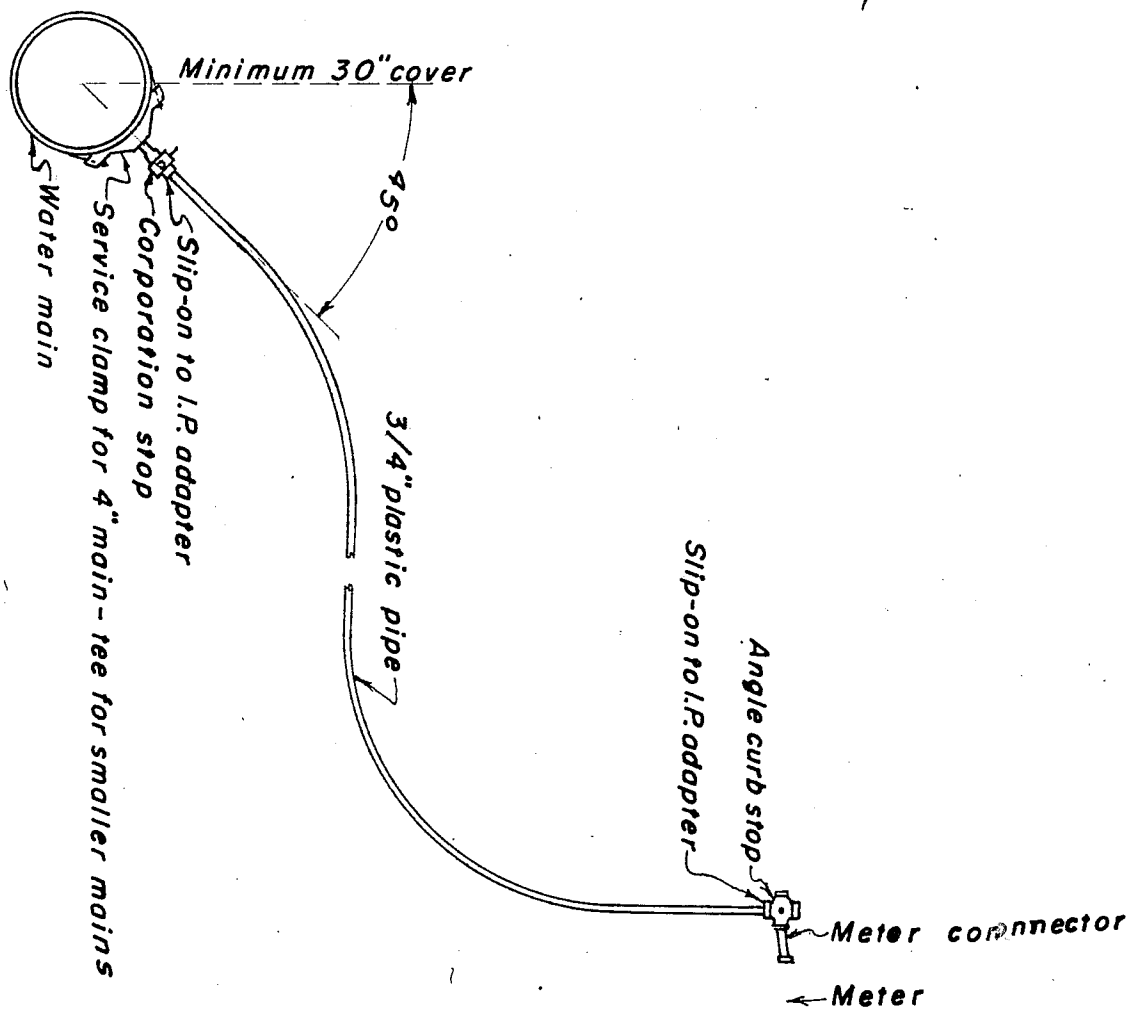

TYPICAL SERVICE CONNECTION



Not to scale




LAKE TENNANT
WATER ASSOCIATION
Service Connection
Whatcom County - Wash.
Scale - 1/8 inch = 1 foot

800.474.008

T39N, R2E, W.M.

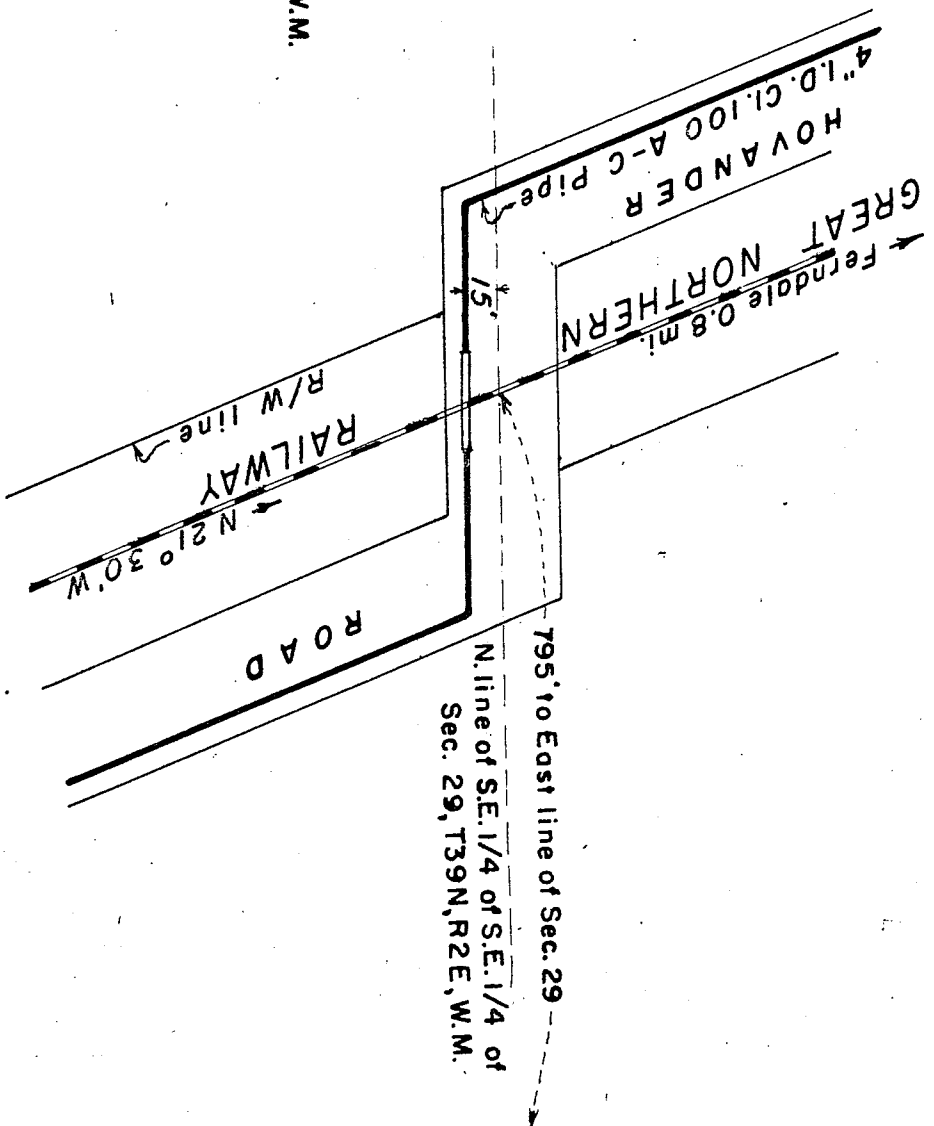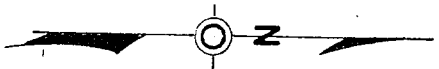

PLAN
Scale 1"=100'

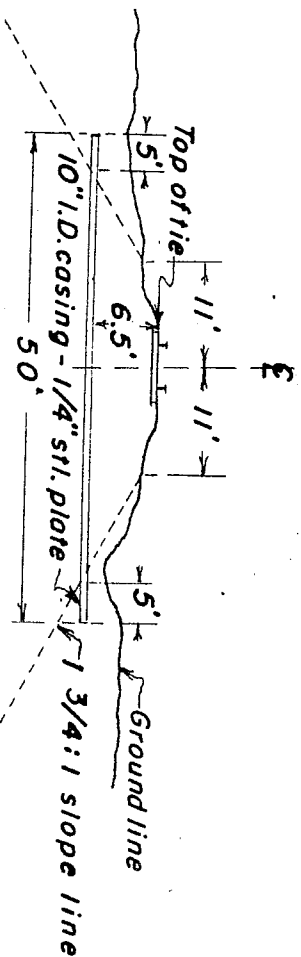

SECTION
Scale 1"=20'

LAKE TENNANT
WATER ASSOCIATION


G.N.RY.

PIPE LINE CROSSING

Whatcom. County, Wash. Sept. 7, 1958
Scale—as shown—H.M. BRIGGS, JR., ENGR.

28. h f m p

FAI-5
PSH No. 1
BELLINGHAM TO FERNDALE
SMITH ROAD SEPARATION
WHATCOM COUNTY
Scale: 1"=400' R.L. 64 C.S. 3702
August, 1963 P.J. McKay Dist. Eng.

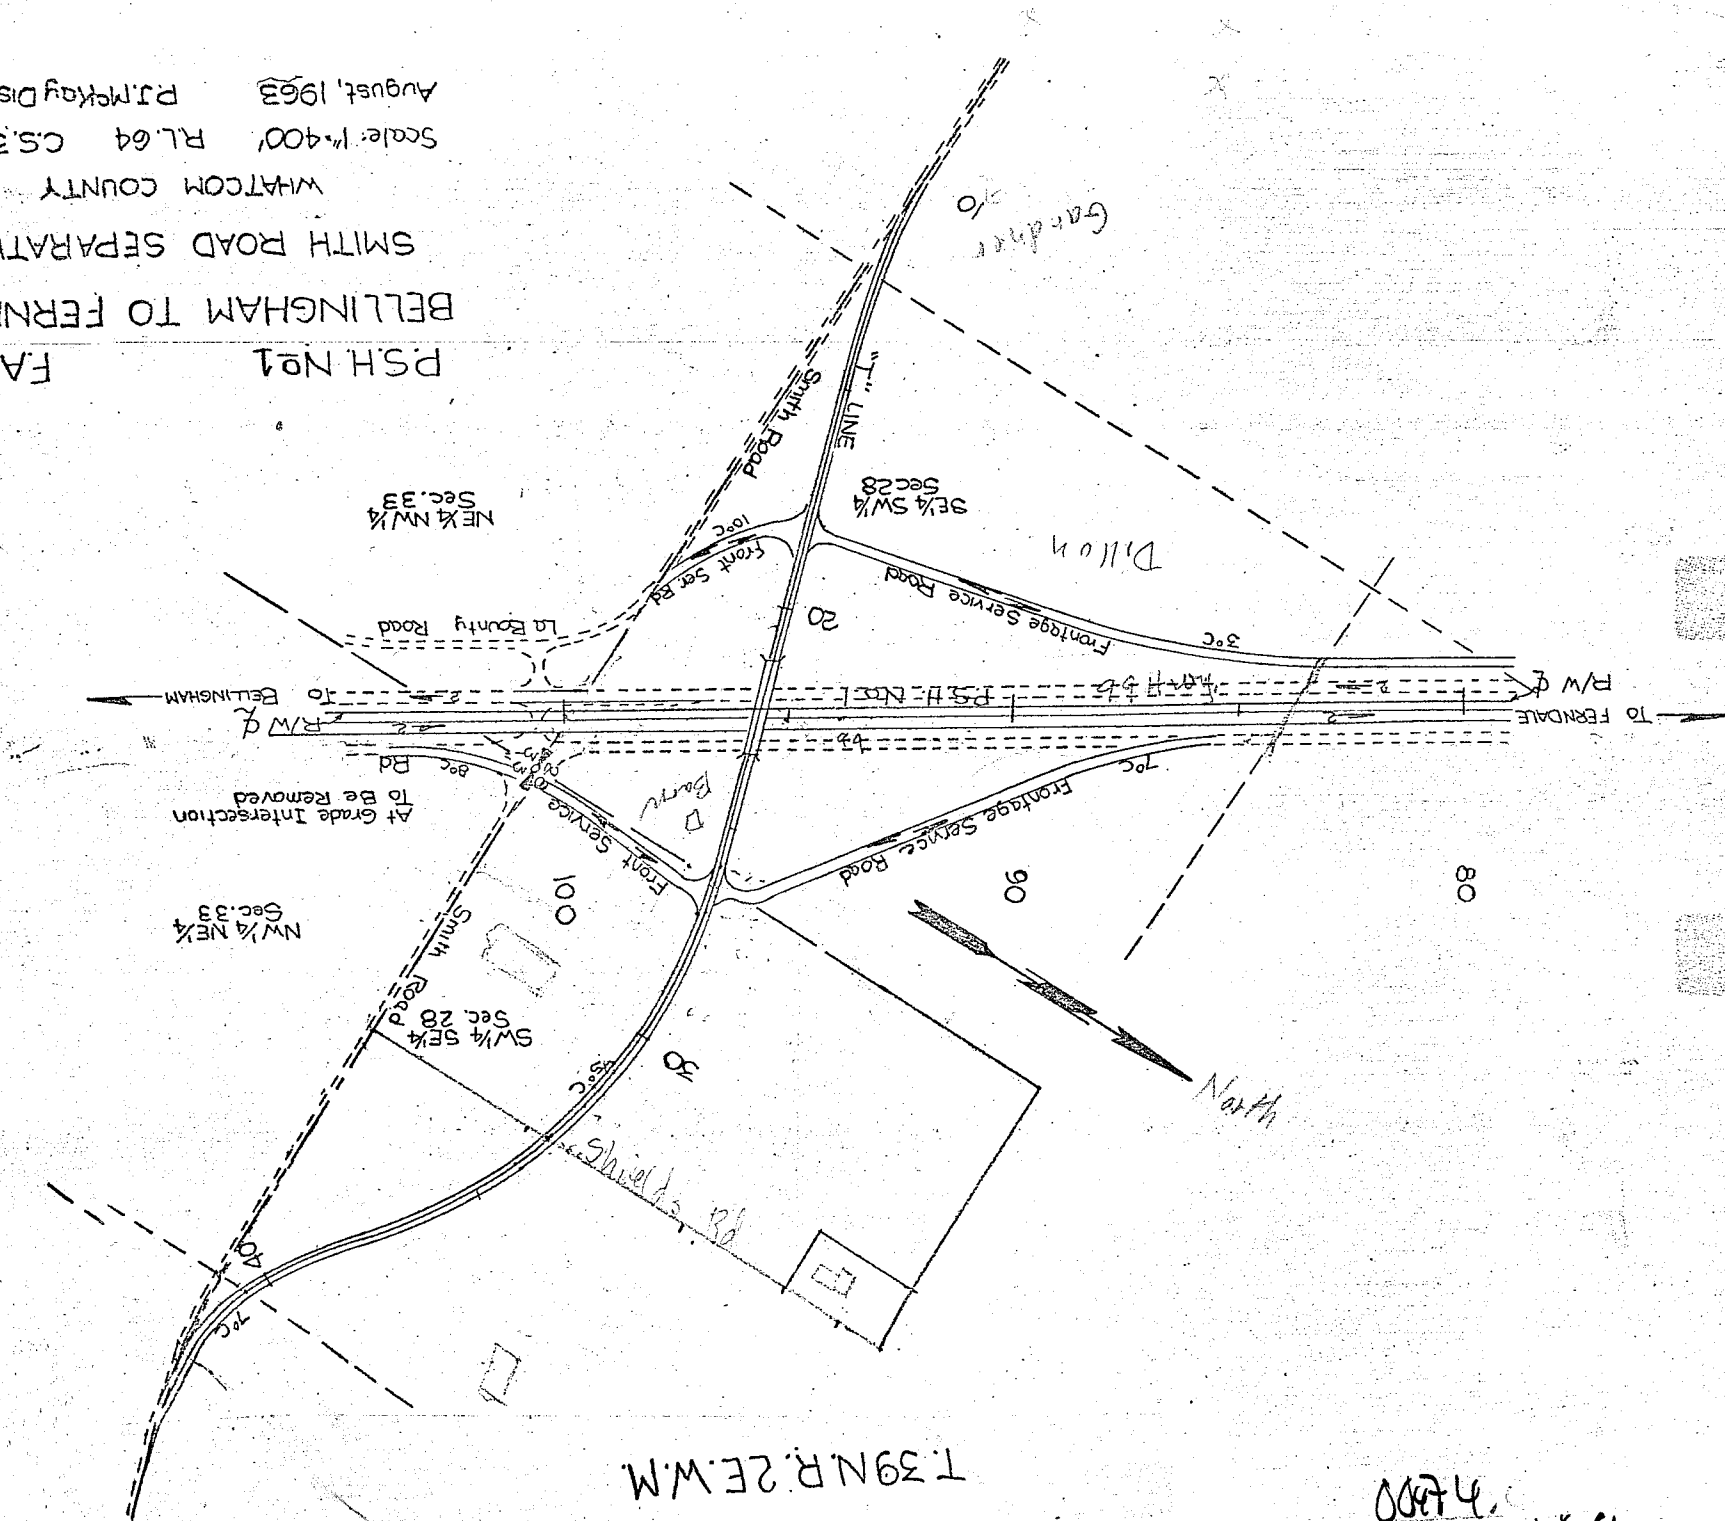

XERO COPY

XERO COPY


XERO COPY

XERO COPY

XERO COPY

5887490

T.39 N. R. 2E. W. M.

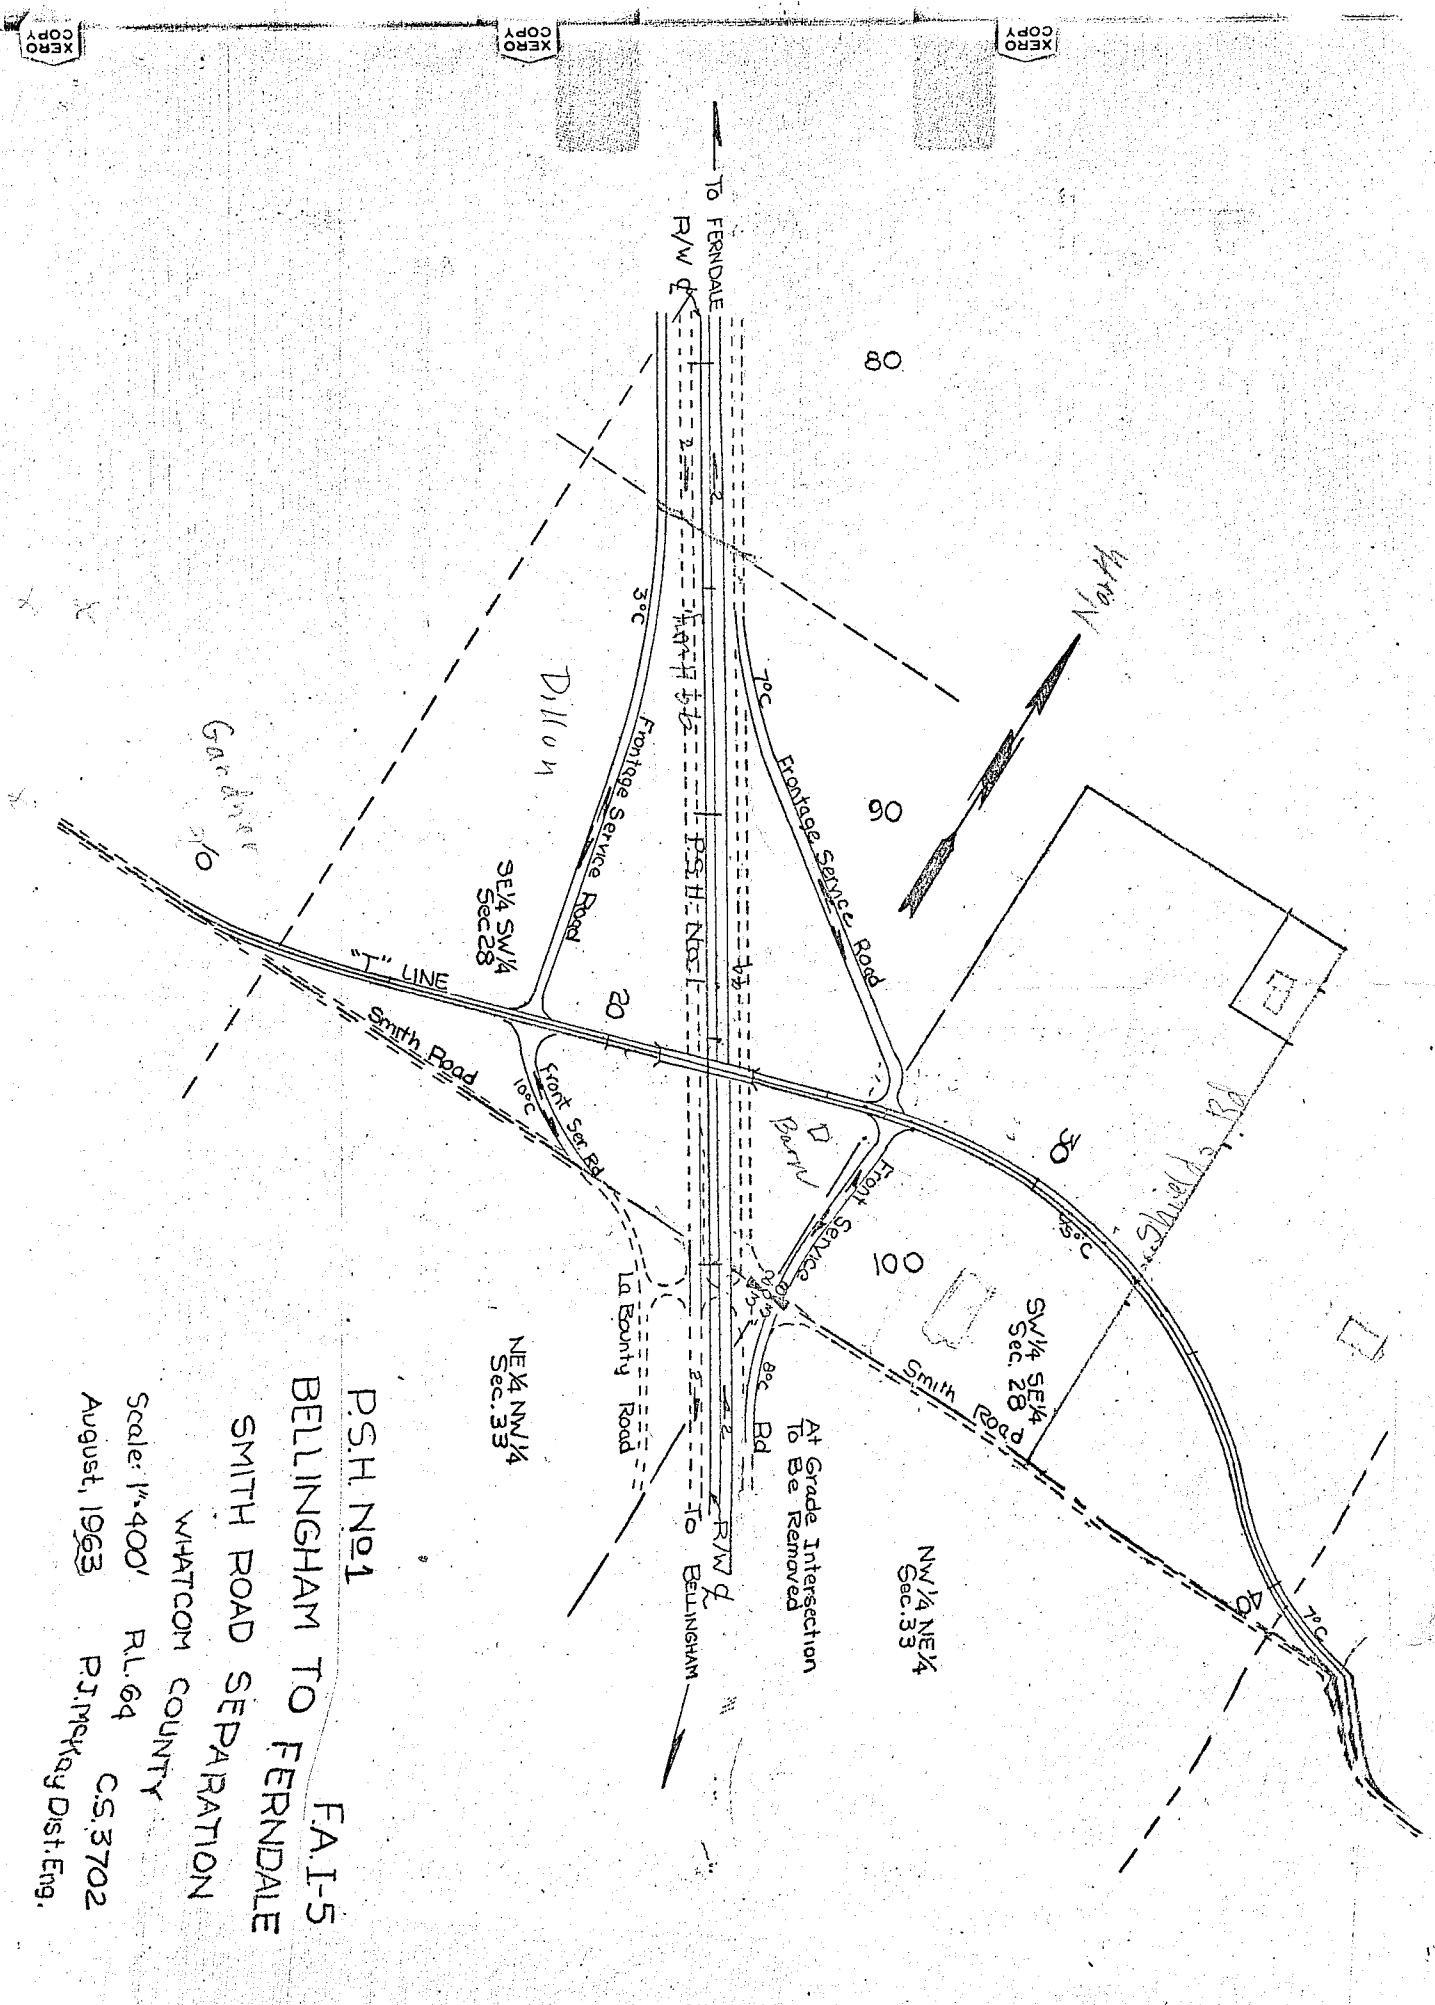


P.S.H. No. 1
BELLINGHAM TO FERNDAL
SMITH ROAD SEPARATION
WHATCOM COUNTY
Scale: 1"=400' R.L. 64
August, 1963 P.I. Map by Dist. Eng.
C.S. 3702

XERO COPY


XERO COPY

XERO COPY

00474.009

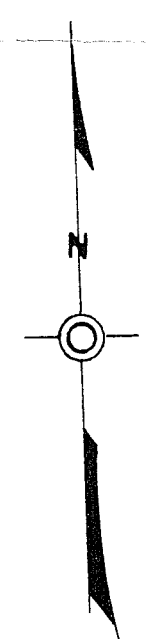

T39N, R2E, W.M.

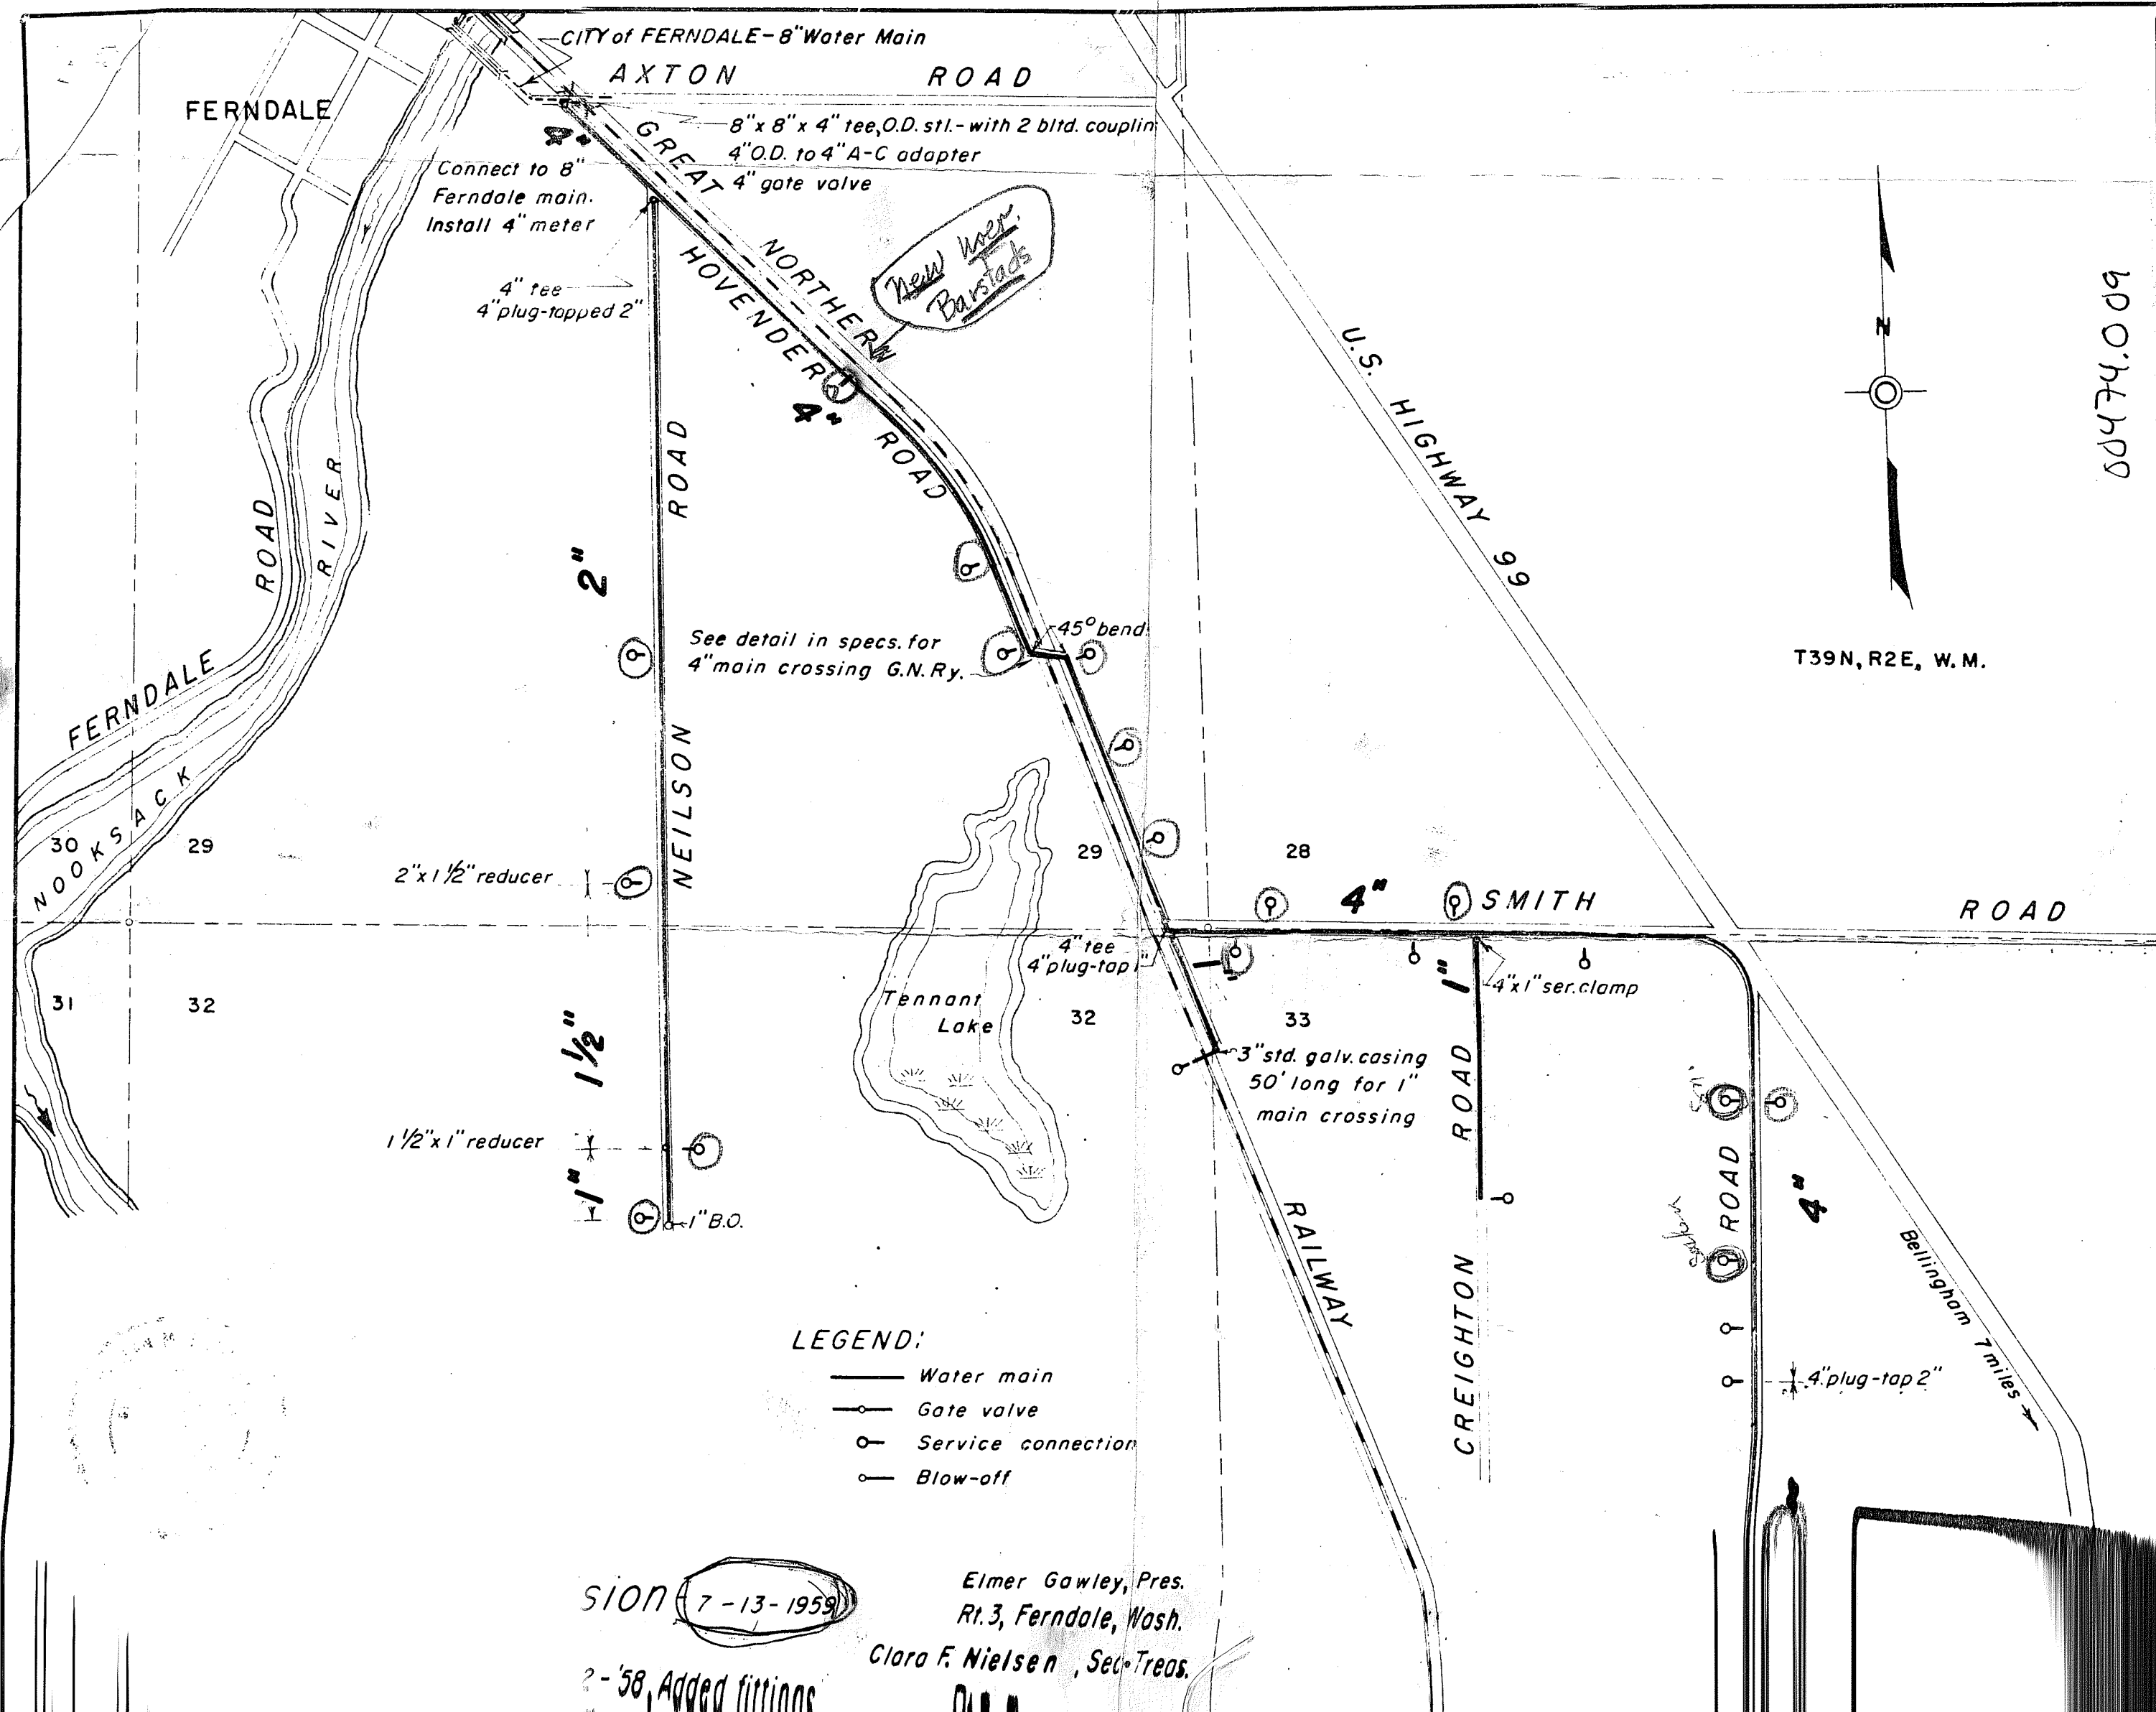

CITY of FERNDAL-8" Water Main
Connect to 8" Ferndale main.
Install 4" meter

4" tee
4" plug-tapped 2"

8"x 8"x 4" tee, O.D. stl.-with 2 bltd. couplin
4" O.D. to 4" A-C adapter
4" gate valve

New Wren
Barstads

See detail in specs. for
4" main crossing G.N. Ry.

2"x 1 1/2" reducer

1 1/2"x 1" reducer

1" B.O.

4" tee
4" plug-tap

3" std. galv. casing
50' long for 1"
main crossing

4"x 1" ser. clamp

4"

4" plug-tap 2"

Bellingham 7 miles

LEGEND:

- Water main
- Gate valve
- Service connection
- Blow-off

SION 7-13-1959

2-'58, Added fittings

Elmer Gawley, Pres.
Rt. 3, Ferndale, Wash.
Clara F. Nielsen, Sec. Treas.

Horton M. Branson, Engr.
Rt. 1, Box 648
Warrenton, Ore.


General Revision

7-13-1959

REVISION "A" 10-2-'58, Added fittings.

Elmer Gawley, Pres.
Rt. 3, Ferndale, Wash.
Clara F. Nielsen, Sec. Treas.
Rt. 3, Ferndale, Wash.


LAKE TENNANT
WATER ASSOCIATION
DOMESTIC WATER
SUPPLY SYSTEM
Whatcom County, Wash. - May 1958
Scale 1" = 660' (8 in. = 1 mile)

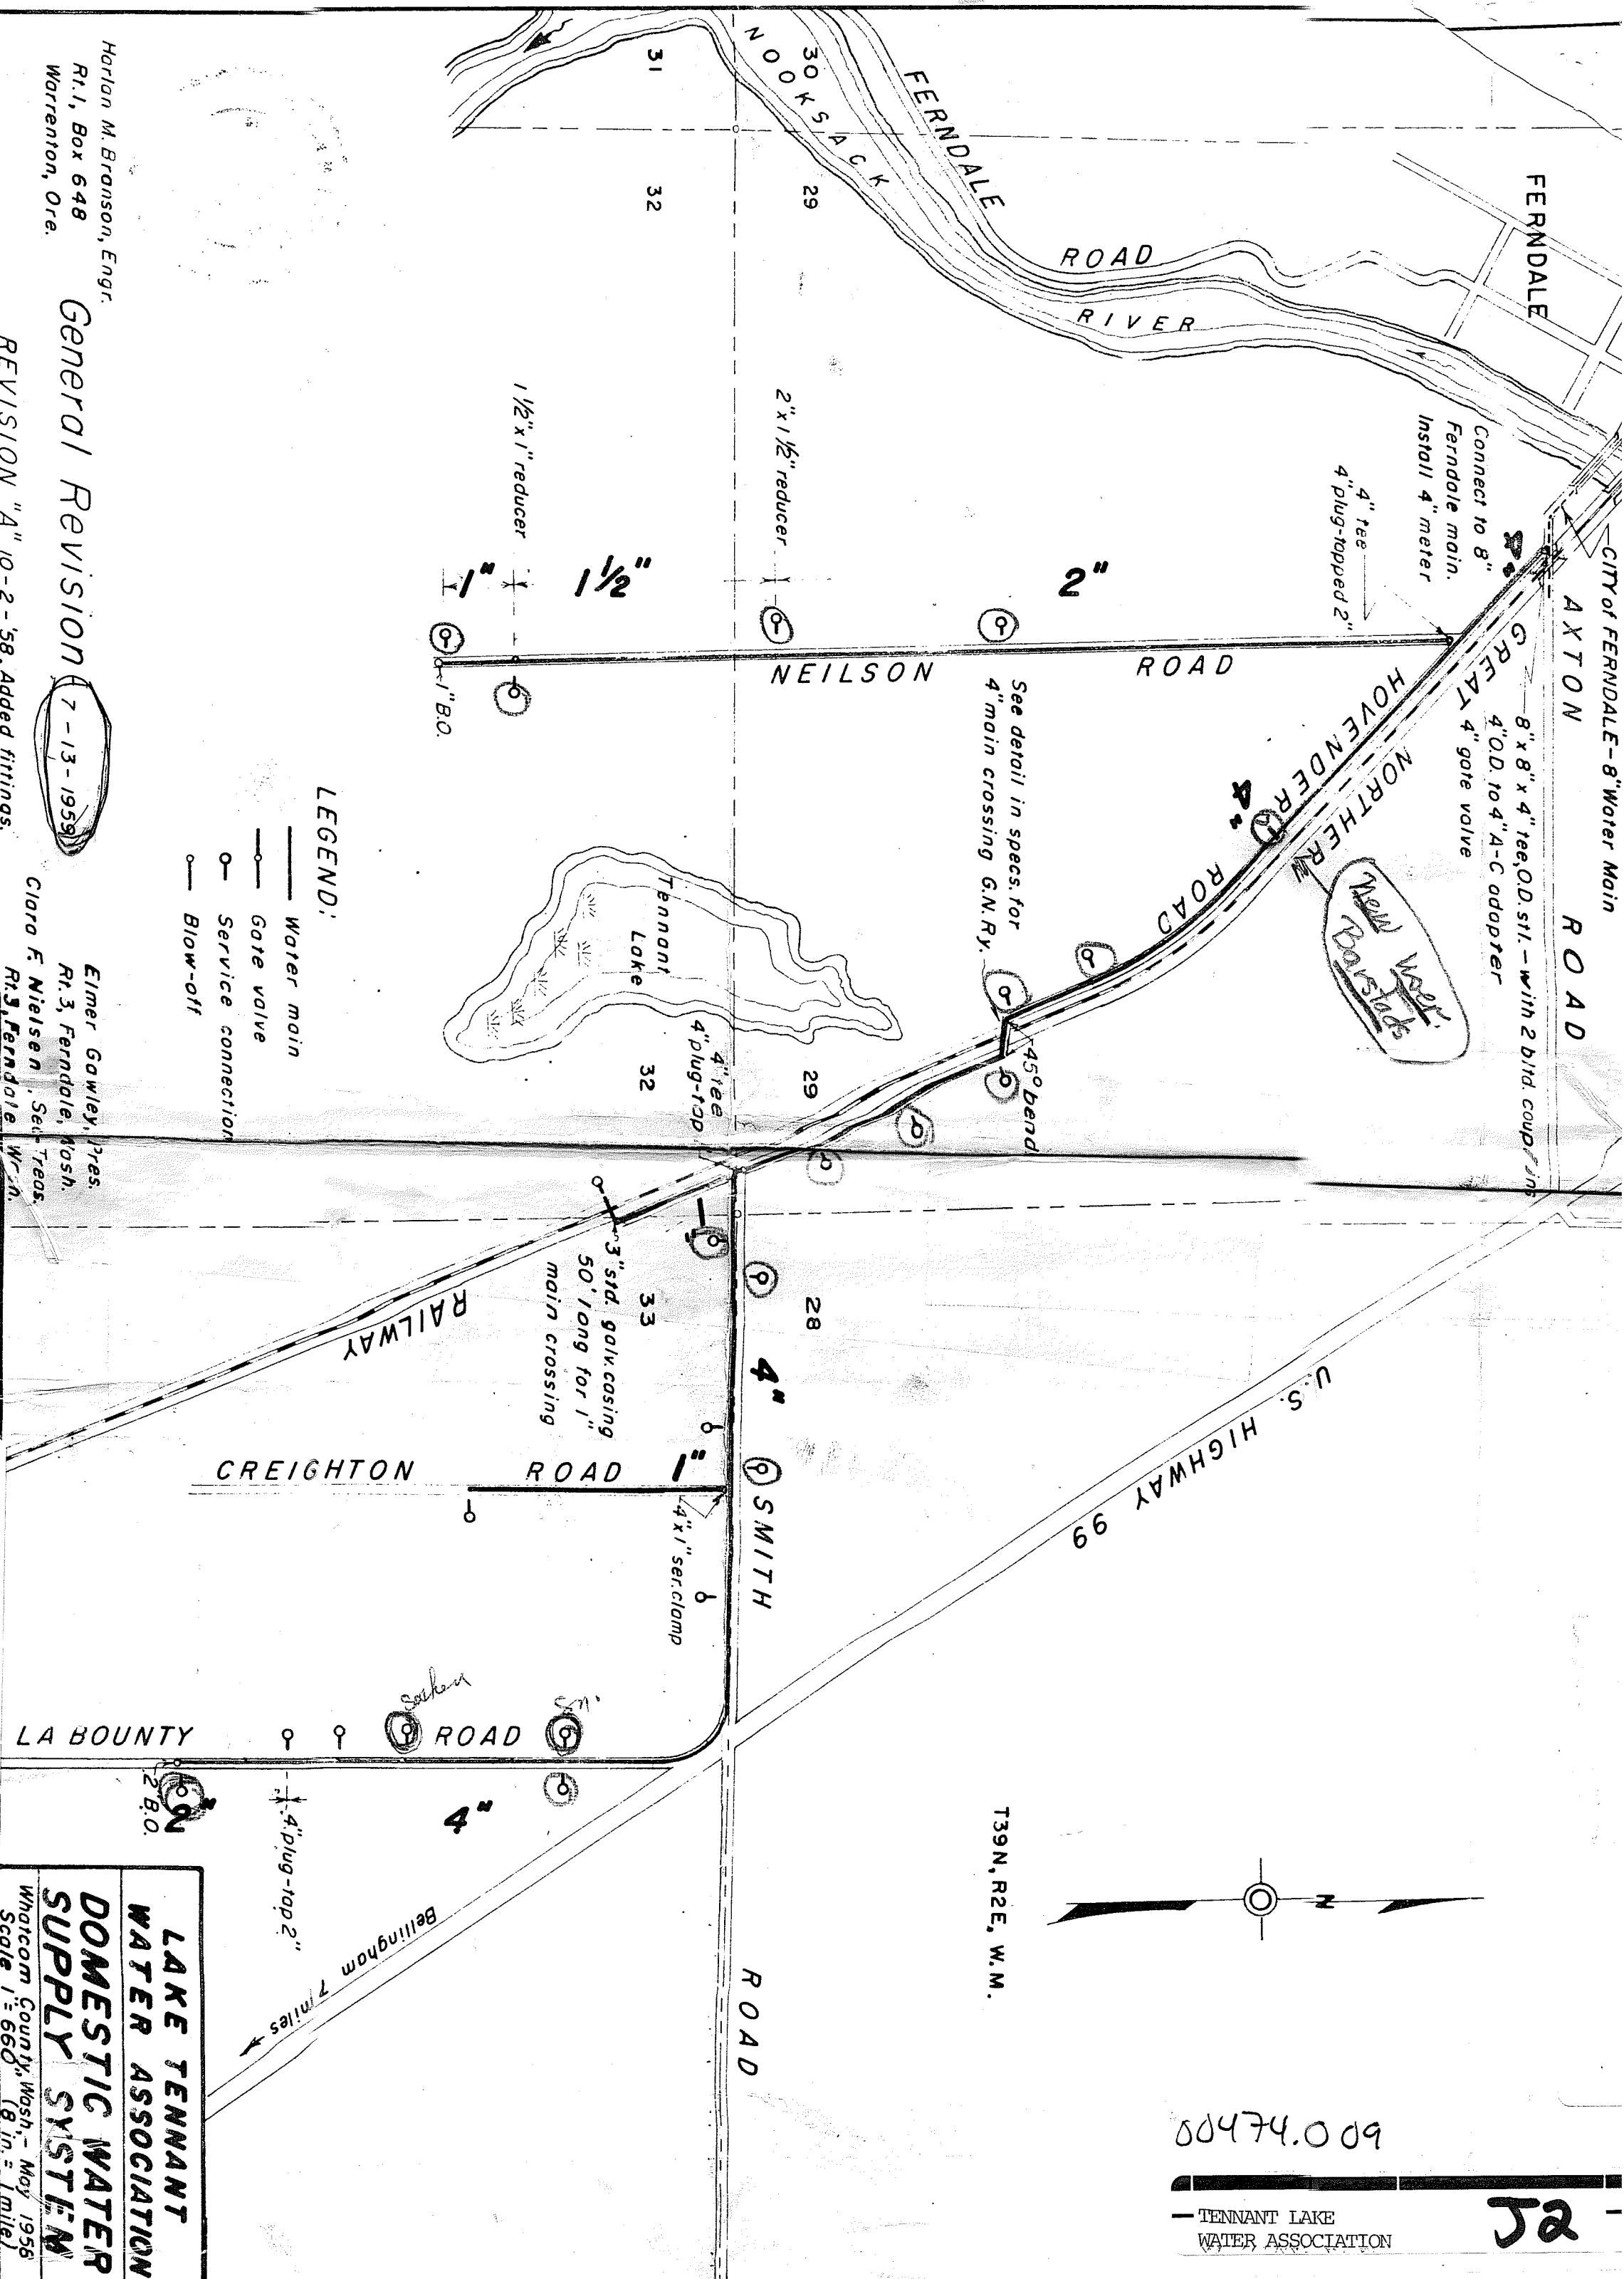


60474.009

TENNANT LAKE
WATER ASSOCIATION

52

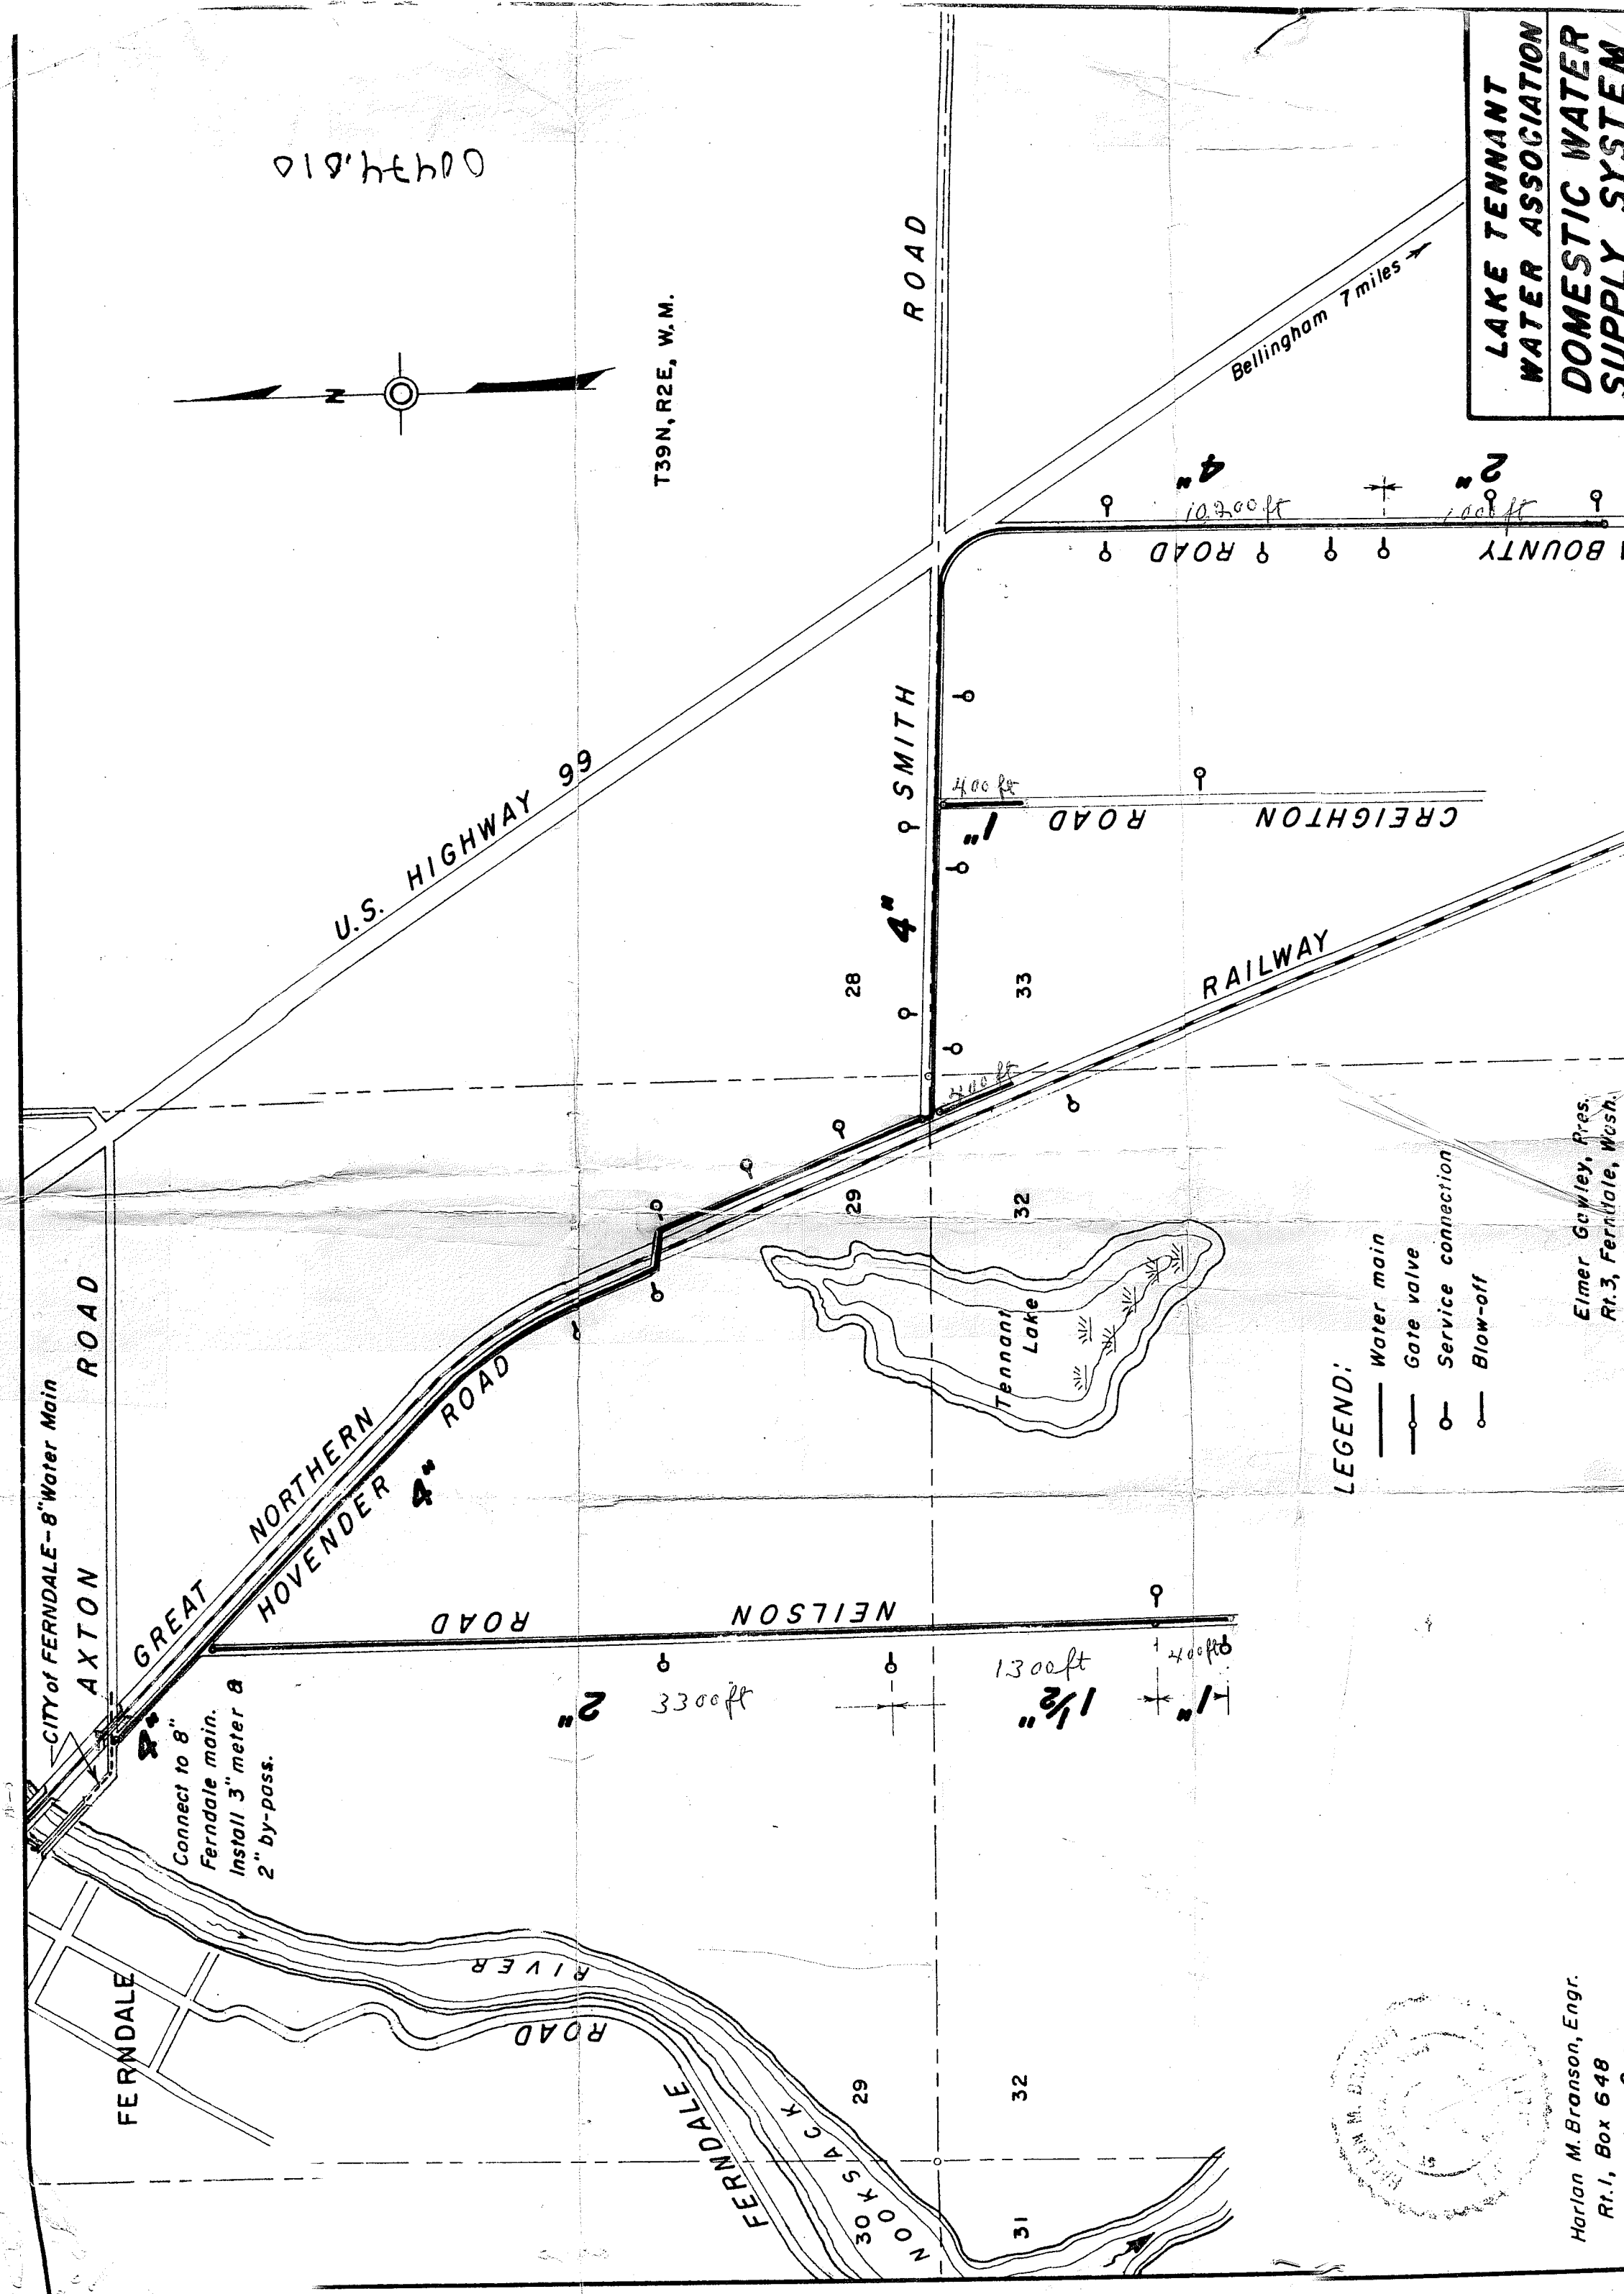

01844.810

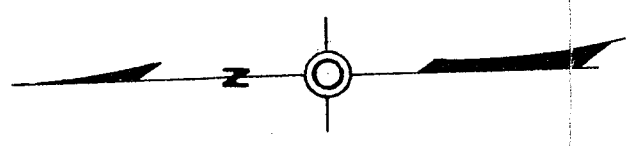

T39N, R2E, W.M.

Bellingham 7 miles

LAKE TENNANT
WATER ASSOCIATION
DOMESTIC WATER
SUPPLY SYSTEM

LEGEND:

- Water main
- Gate valve
- Service connection
- Blow-off

Elmer Gwiley, Pres.
Rt. 3, Ferndale, Wash.
Wm. G. Gwiley, Sec. Treas.

Harlan M. Branson, Engr.
Rt. 1, Box 648
Warrenton, Ore.

