



CITY OF FERNDALE, WA

PUMP STATION NO. 4 UPGRADE – CITY PROJECT No. SS2014-05

VICINITY MAP - NOT TO SCALE

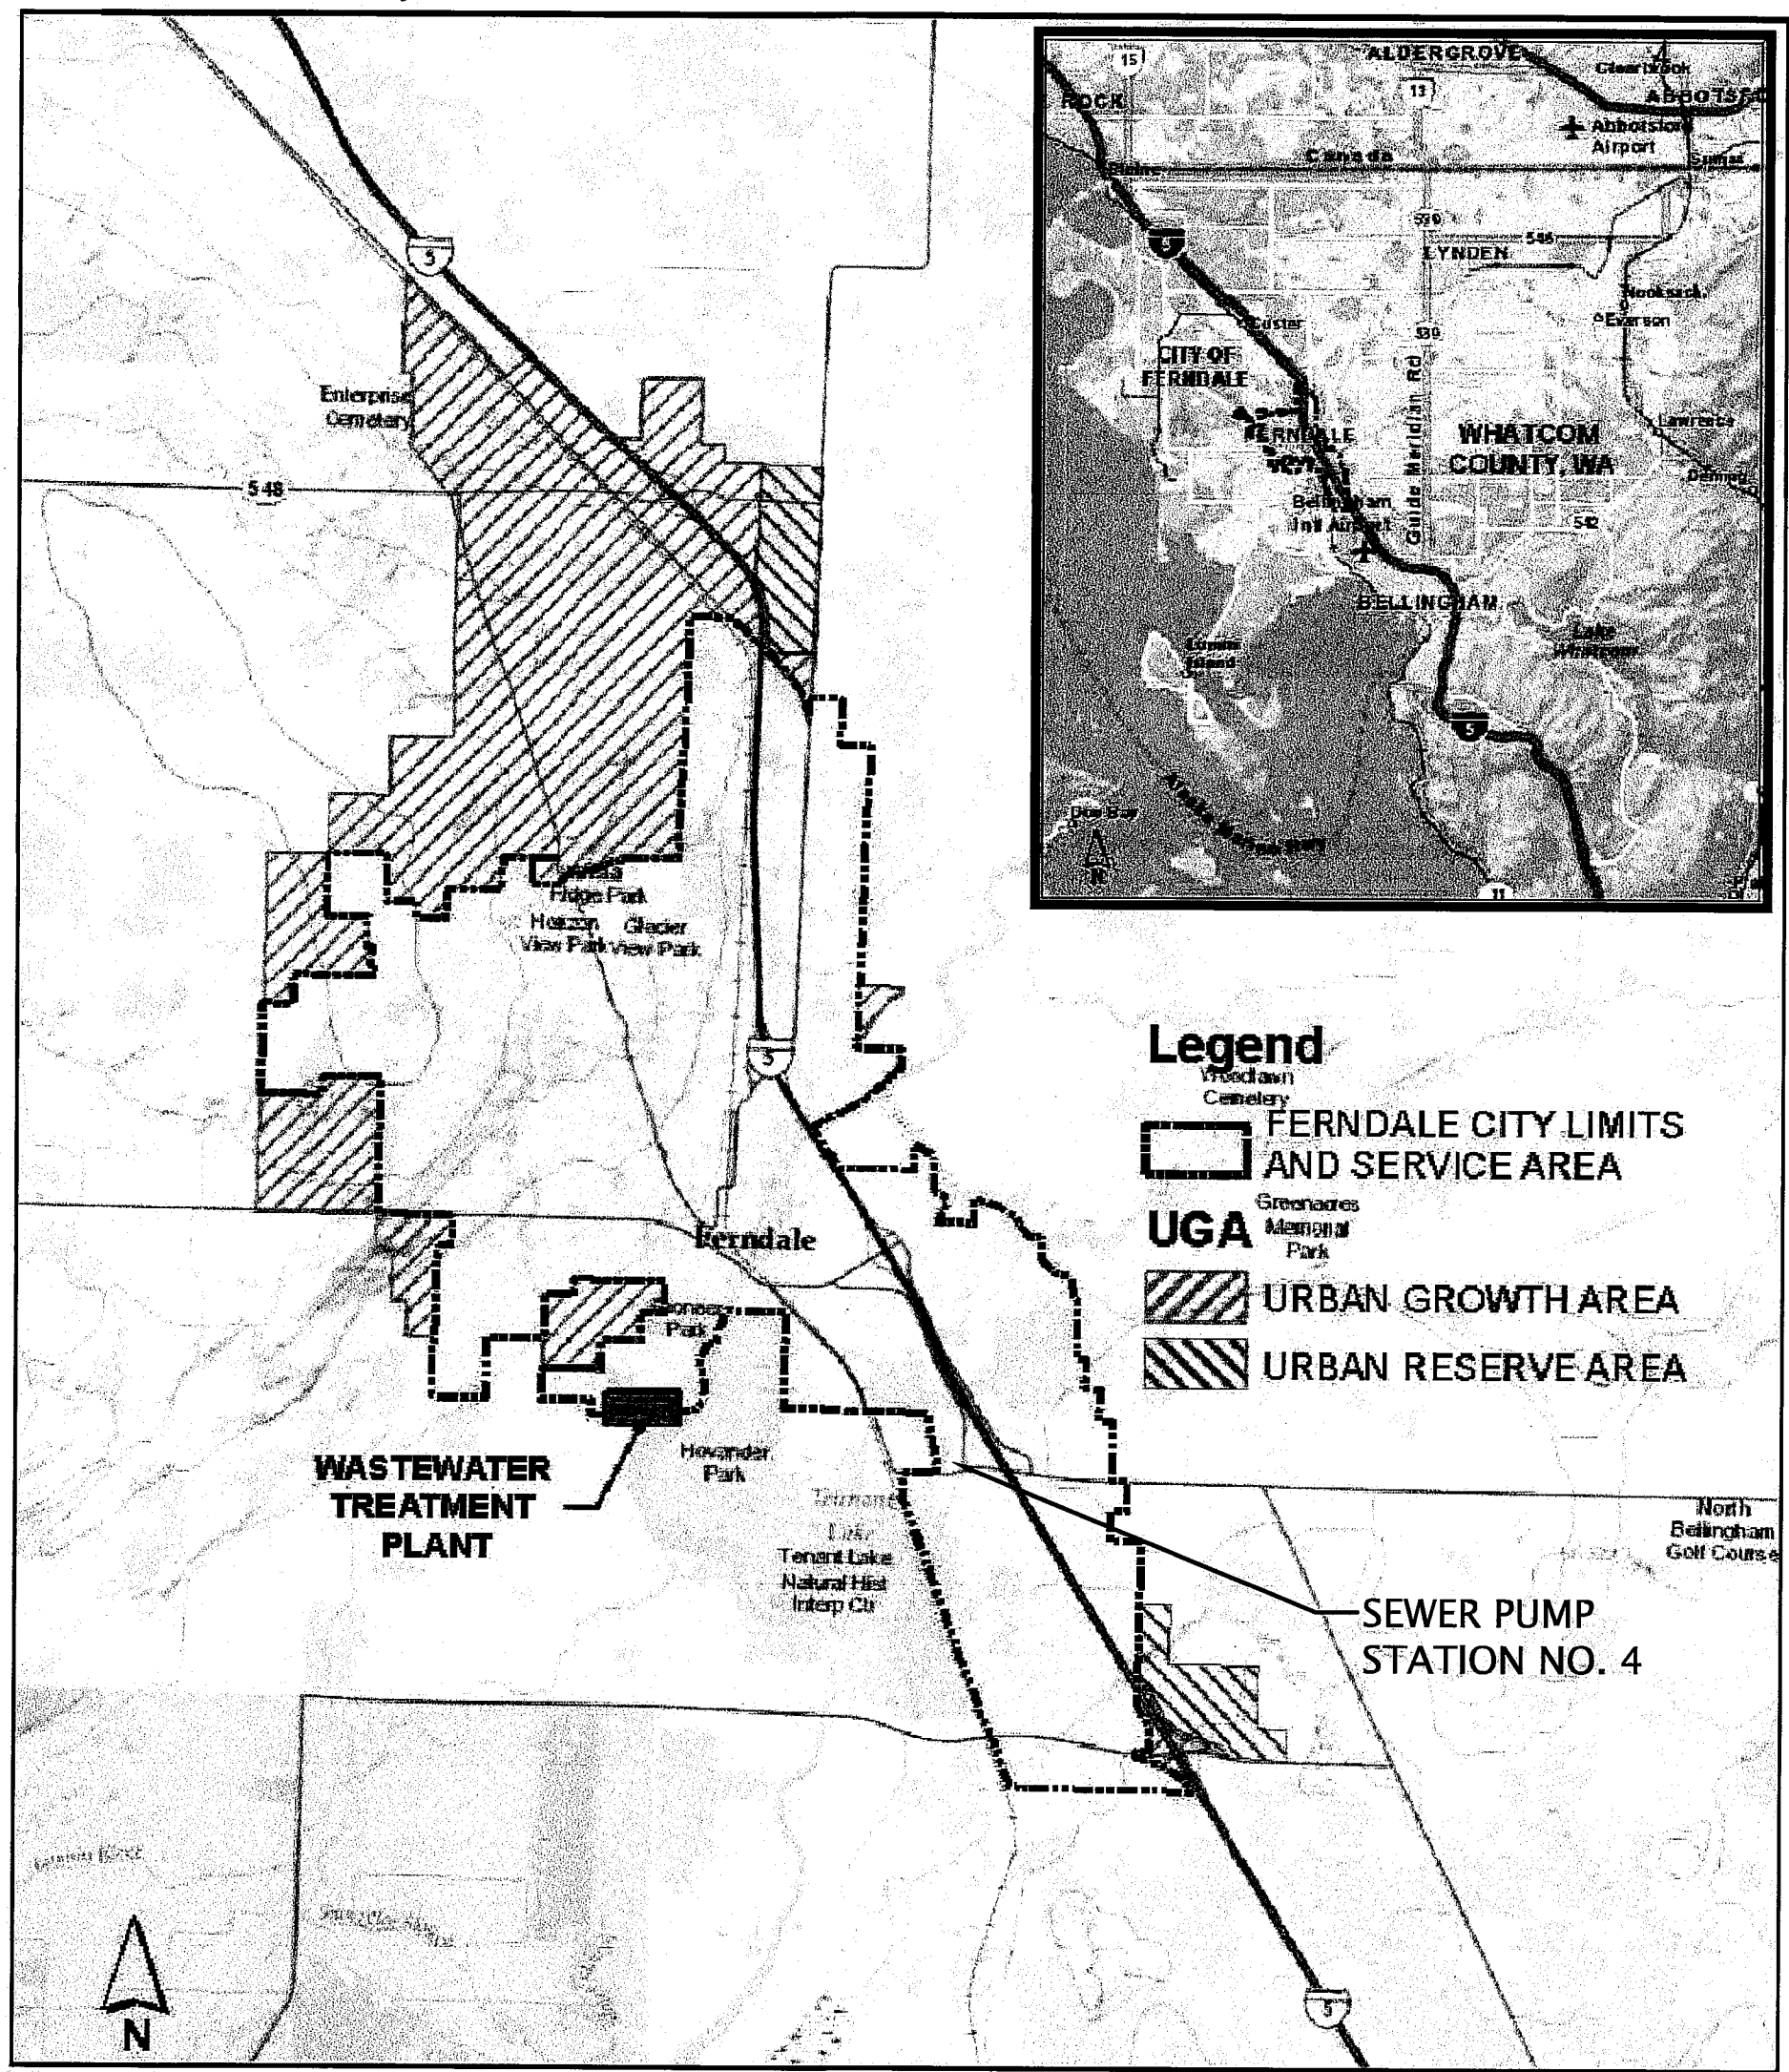

LOCATION MAP - NOT TO SCALE

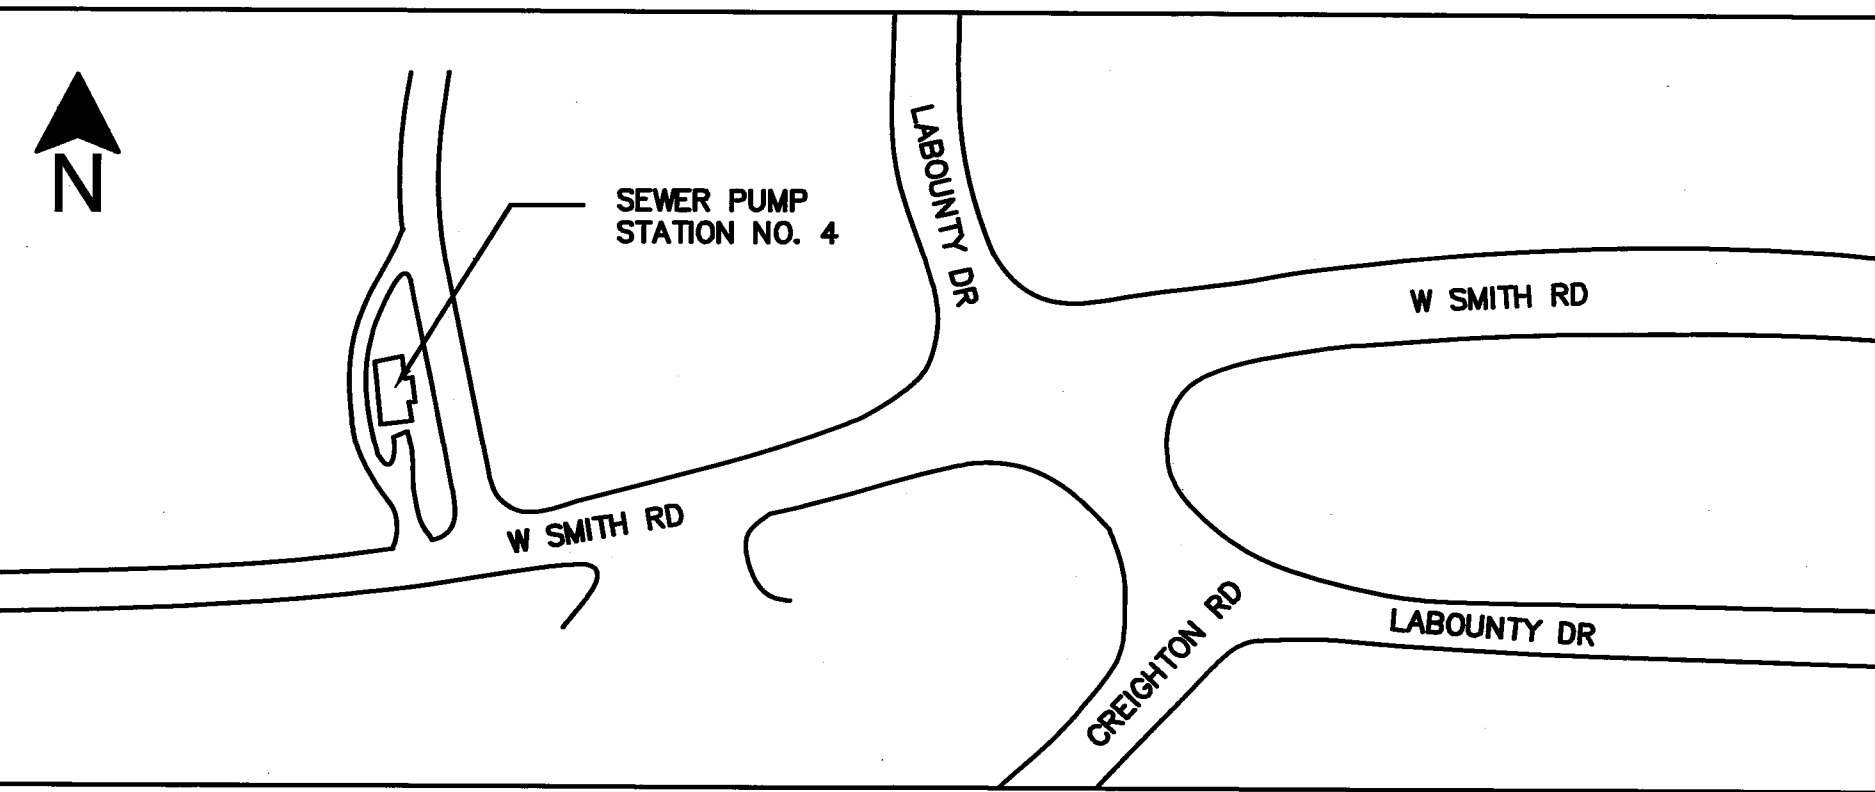

GENERAL NOTES

- ALL WORKMANSHIP AND MATERIALS SHALL BE IN ACCORDANCE WITH CITY OF FERNDALE STANDARDS AND THE MOST CURRENT COPY OF THE STATE OF WASHINGTON STANDARD SPECIFICATIONS FOR ROAD, BRIDGE AND MUNICIPAL CONSTRUCTION (WSDOT/APWA).
- ALL APPROVALS AND PERMITS REQUIRED BY THE CITY OF FERNDALE SHALL BE OBTAINED PRIOR TO THE START OF CONSTRUCTION.
- THE CONTRACTOR SHALL BE FULLY RESPONSIBLE FOR THE LOCATION AND PROTECTION OF ALL EXISTING UTILITIES. THE CONTRACTOR SHALL VERIFY ALL UTILITY LOCATIONS PRIOR TO CONSTRUCTION BY CALLING THE UNDERGROUND LOCATE LINE AT 1-800-332-2344 A MINIMUM OF 2 BUSINESS DAYS PRIOR TO ANY EXCAVATION.
- ALL NEW PLASTIC PIPE AND SERVICES SHALL BE INSTALLED WITH CONTINUOUS TRACER TAPE INSTALLED 8" TO 12" UNDER THE PROPOSED FINISHED SUBGRADE. THE MARKER SHALL BE PLASTIC NON-BIODEGRADABLE, METAL CORE OR BACKING MARKED WATER WHICH CAN BE DETECTED BY A STANDARD METAL DETECTOR.
- EROSION CONTROL MEASURES SHALL BE TAKEN BY THE CONTRACTOR DURING CONSTRUCTION TO PREVENT SILTATION TO EXISTING STORM DRAINAGE FACILITIES AND ROADWAYS.
- IT SHALL BE THE RESPONSIBILITY OF THE CONTRACTOR TO HAVE A COPY OF THESE APPROVED PLANS ON CONSTRUCTION SITE AT ALL TIMES.
- ANY CHANGES TO THE DESIGN SHALL FIRST BE REVIEWED AND APPROVED BY THE PROJECT ENGINEER.
- ALL LINES SHALL BE CLEANED AND PRESSURE TESTED PRIOR TO PAVING IN CONFORMANCE WITH THE ABOVE REFERENCED SPECIFICATIONS. TESTING SHALL TAKE PLACE AFTER ALL UNDERGROUND UTILITIES ARE INSTALLED AND COMPACTION OF THE ROADWAY SUBGRADE IS COMPLETED.
- PRIOR TO BACKFILL ALL MAINS AND APPURTENANCES SHALL BE INSPECTED AND APPROVED BY THE CITY OF FERNDALE CONSTRUCTION INSPECTOR. APPROVAL SHALL NOT RELIEVE THE CONTRACTOR FOR CORRECTION OF ANY DEFICIENCIES AND/OR FAILURES AS DETERMINED BY SUBSEQUENT TESTING AND INSPECTIONS. IT SHALL BE THE CONTRACTOR'S RESPONSIBILITY TO NOTIFY THE INSPECTOR FOR THE REQUIRED INSPECTIONS.
- ALL WORK AND MATERIALS SHALL BE GUARANTEED BY THE CONTRACTOR FOR ONE YEAR AFTER FINAL ACCEPTANCE.
- THE LOCATIONS OF ALL EXISTING UTILITIES SHOWN ON THE PLANS ARE APPROXIMATE AND NOT ALL ARE SHOWN. THE CONTRACTOR IS RESPONSIBLE TO VERIFY AND PROTECT ALL UTILITIES.
- ALL RESTORATION AND LANDSCAPING WITHIN PUBLIC OR PRIVATE PROPERTY SHALL OCCUR WITHIN THREE WEEKS OF DISTURBANCE. THIS SHALL INCLUDE, BUT NOT BE LIMITED TO, ALL LAWNS, LANDSCAPING, FENCES, GRAVEL, ASPHALT AND CONCRETE.
- THE CONTRACTOR SHALL KEEP A RECORD OF AS-BUILT INFORMATION THROUGHOUT THE ENTIRE PROJECT. THIS INFORMATION SHALL INCLUDE ALL DEVIATIONS FROM THE PLANS AND ANY OTHER INFORMATION NOT SHOWN ON THE PLANS AND THE LOCATION OF ALL SIDE SEWER CONNECTIONS TO THE MAIN LINE.
- THE CONTRACTOR SHALL REPLACE ALL MONUMENTS, RIGHT-OF-WAY MARKERS, PROPERTY STAKES, ETC. THAT ARE DISTURBED DURING CONSTRUCTION. THE CONTRACTOR SHALL USE A SURVEYOR REGISTERED IN THE STATE OF WASHINGTON TO COMPLETE ALL SURVEY WORK.

EROSION AND SEDIMENTATION CONTROL

- IT IS THE CONTRACTOR'S RESPONSIBILITY TO PREVENT POLLUTION AND EROSION IN ACCORDANCE WITH WSDOT SECTION 1.07.15. EROSION CONTROL BEST MANAGEMENT PRACTICES SHALL CONFORM TO THE CURRENT WASHINGTON DEPARTMENT OF ECOLOGY STORMWATER MANAGEMENT MANUAL.

EXISTING UTILITIES

- CONTRACTOR IS ADVISED THAT UNDERGROUND WATER, SEWER, STORM, TELEPHONE, FIBER OPTIC, AND GAS MAY BE LOCATED IN THE VICINITY OF THIS PROJECT. NO ATTEMPT WAS MADE TO SHOW ALL UTILITIES ON THE PLAN. LOCATIONS SHOWN FOR EXISTING UTILITIES ARE APPROXIMATE. OTHER UTILITIES MAY EXIST WHICH ARE NOT SHOWN ON THE PLANS.
- IT SHALL BE THE RESPONSIBILITY OF THE CONTRACTOR TO DETERMINE THE TRUE AND CORRECT LOCATIONS OF EXISTING UTILITIES THAT MAY IMPACT THE WORK. CONTRACTOR SHALL NOTIFY ENGINEER PRIOR TO COMMENCING CONSTRUCTION IF MARKED UTILITIES APPEAR TO CONFLICT WITH PROPOSED IMPROVEMENTS. THE COST OF LOCATING, PROTECTING AND ACCOMMODATING EXISTING UTILITIES SHALL BE INCIDENTAL TO THE COST OF THE PROJECT. IF AN ACTUAL CONFLICT REQUIRES RELOCATION OF AN EXISTING UTILITY OR THE REDESIGN OF THE PROPOSED IMPROVEMENT, THE ENGINEER WILL DETERMINE IF EXTRA PAY IS WARRANTED TO ACCOMMODATE THE CHANGED OR UNFORESEEN CONDITION. MINOR HORIZONTAL OR VERTICAL ADJUSTMENTS OF THE PROPOSED IMPROVEMENTS TO AVOID CONFLICTS SHALL NOT ENTITLE THE CONTRACTOR TO EXTRA PAY.

TRAFFIC CONTROL

- CONTRACTOR IS NOT ALLOWED TO COMPLETELY CLOSE ANY STREET TO TRAFFIC. THE NUMBER OF OPEN LANES OF TRAFFIC TO BE MAINTAINED IN EACH AREA IS ONE LANE. TRAFFIC SHALL BE MAINTAINED ACCORDING TO WSDOT SECTION 1-07.23, AND THE MANUAL OF UNIFORM TRAFFIC CONTROL DEVICES.

CONTROL NOTES

- BASIS OF COORDINATES:** FOUND SURFACE MONUMENT "FERN12" IN THE NORTHWEST CORNER OF SMITH ROAD AND LABOUNTY ROAD INTERSECTION 2' EAST OF CURB LINE AT THE SOUTH END OF SIDEWALK.

NORTHING = 673,760.111 USFT
EASTING = 1,222,546.506 USFT
ELEV. = 31.27'
- BASIS OF BEARINGS:** BEARINGS ARE NAD83/91 PER THE CITY OF FERNDALE SURVEY MONUMENT NETWORK OF 2001. HELD DERIVED INVERSE BETWEEN THE ABOVE-MENTIONED CONTROL POINT "FERN12" AND "FERN11" SAID BEARING BEING N 60°49'52" W, A DISTANCE OF 3355.21'. THE FOLLOWING COORDINATES WERE HELD FOR "FERN11":

NORTHING = 675,395.391 USFT
EASTING = 1,219,616.779 USFT
ELEV. = 47.47'
- BASIS OF ELEVATIONS:** ELEVATIONS ARE NGVD29 PER THE CITY OF FERNDALE SURVEY MONUMENT NETWORK OF 2001. HELD PUBLISHED ELEVATION FOR "FERN12" OF 31.27'.

SITE BENCHMARK: "FERN12"
- SITE CONTROL POINTS:**

NO.	NORTHING	EASTING	ELEVATION	DESCRIPTION
109	673643.2000	1222241.7800	18.29	SET BERNITSEN SPIKE
200	673742.1010	1222494.3148		MON DISTURBED
900	673864.6910	1222551.0011		CASED MONUMENT
901	673760.1111	1222546.5061	31.27	BSM "FERN12"
902	673701.8033	1222610.5694		CASED MONUMENT
903	673697.3295	1222597.2083		CASED MONUMENT
904	673641.2292	1222429.9737		CASED MONUMENT
905	674494.2165	1222306.0238		REBAR / CAP
906	674613.5978	1222568.9920		CASED MONUMENT
907	675395.3910	1219616.7788	47.47	BSM "FERN11"
908	673590.4221	1222062.6952		CASED MONUMENT



INDEX TO DRAWINGS

- C1.1 COVER SHEET
- C1.2 LEGEND & ABBREVIATIONS
- C2.1 ORIGINAL SITE PLAN PRIOR TO CONSTRUCTION ACTIVITIES
- C2.2 PROPOSED PIPING SITE PLAN
- C2.3 PROPOSED SITE GRADING AND DRAINAGE
- C2.4 TESC PLAN, DETAILS & NOTES
- E3.1 EXISTING PLAN AND PROFILE LAYOUT
- C3.2 PROPOSED PLAN AND PROFILE LAYOUT
- C4.1 DETAILS
- C4.1A DETAILS (NEW SHEET)
- C4.2 DETAILS
- S1.1 TYPICAL DETAILS
- E1 ELECTRICAL SYMBOLS AND ABBREVIATIONS
- E2 ELECTRICAL DEMOLITION
- E3 POWER PLAN AND SCHEDULES
- E4 INSTRUMENTATION AND CONTROL PLAN
- E5 ELECTRICAL ENCLOSURE ELEVATIONS
- E6 ELECTRICAL ENCLOSURE ELEVATIONS
- E7 PUMP CONTROL WIRING DIAGRAMS
- E8 PUMP WIRING DIAGRAMS
- E9 TELEMETRY PANEL WIRING DIAGRAMS
- E10 ELECTRICAL DETAILS
- E11 ELECTRICAL SCHEDULES

ADDENDA ITEMS, CHANGE ORDERS AND CONSTRUCTION ADJUSTMENTS HAVE BEEN POSTED TO THIS SET

CALL TWO BUSINESS DAYS BEFORE YOU DIG 1-800-424-5555 UTILITIES UNDERGROUND LOCATION CENTER

RECORD DRAWINGS

WILSON ENGINEERING, LLC
805 DUPONT STREET
BELLINGHAM, WA 98225
(360) 733-6100 • FAX (360) 647-9061
www.wilsonengineering.com

Wilson
SURVEY/ENGINEERING

DESIGNED BY JCC
DRAWN BY ROG
CHECKED BY AWL

CITY OF FERNDALE
WHATCOM COUNTY
PUMP STATION NO. 4
COVER SHEET








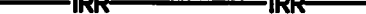

DATE 01/27/2016
SCALE AS SHOWN
JOB NUMBER 2013-037

SHEET C1.1 OF 22

00597.001 4/7/16 8H

EXISTING HATCH PATTERNS

SURFACE FEATURES EXISTING PLAN LINETYPES	DESCRIPTION
	BRIDGE
	BUILDING LINE
	BUILDING COLUMN
	BUILDING OVERHANG
	BULKHEAD
	CONCRETE EDGE
	CREEK EDGE
	CROWN OF ROAD
	CURB
	DITCH CENTERLINE
	DECK
	DOCK
	EDGE OF SAWCUT
	EDGE OF PAVEMENT
	FENCE
	HIGH VISIBILITY FENCE
	GATE
	GRADE
	GRAVEL
	GUARDRAIL
	JERSEY BARRIER
	LAKE/POND WATER EDGE
	LIP OF CURB
	MISC SURFACE FEATURE
	MISC TRAFFIC
	PLANTER
	PATH
	RAILROAD
	RAMP (WOOD)
	RETAINING WALL
	ROAD STRIPING
	ROCKERY
	RIVERBANK/ShORELINE
	THALWAG LINE
	TOP OF BANK/SLOPE
	TOE OF BANK/SLOPE
	VEGETATION/SHRUB LINE
	WETLAND/SWAMP PERIMETER
	WETLAND BUFFER

PROPOSED PLAN UTILITY LINETYPES		DESCRIPTION
	W	WATER
	8" W	8" WATER
	IRR	IRRIGATION
	RW	RECLAIMED WATER
	PW	POTABLE WATER
	W	WATER SERVICE
	FDC	WATER STRUCTURE
	FP	FIRE DEPARTMENT CONNECTION
	FP	FIRE PROTECTION LINE

STORM DRAIN

————— D ————— D —————

----- D ----- D ----- D ----- D ----- D -----

----- FD ----- FD ----- FD ----- FD ----- FD -----

—————

STORM DRAIN — SUBJECT PIPE

STORM DRAIN — OTHER PIPE

STORM SERVICE





FOOTING DRAIN

STORM STRUCTURE

GRADING








--- GB --- GB --- GB --- GRADE BREAK

← or SLOPE ARROWS




DEMOLITION	DESCRIPTION
	SURFACE FEATURE OR UTILITY TO BE REMOVED
	SAWCUT
	CLEARING LIMIT
	TREE OR BUSH TO BE REMOVED

PROFILE LINETYPES	DESCRIPTION
-----	PROFILE EX. GRND \varnothing
=====	PROFILE FINISH GRND \varnothing
-----	PROFILE GRID
-----	PROFILE VERTICAL GRID
-----	PROFILE EX. GROUND LEFT
-----	PROFILE EXISTING GROUND RIGHT
-----	FIBER OPTIC PROFILE (EXISTING)
-----	GAS PROFILE (EXISTING)
-----	POWER PROFILE (EXISTING)
-----	RAILROAD PROFILE (EXISTING)
-----	SANITARY PROFILE (EXISTING)
-----	SANITARY PROFILE (PROPOSED)
-----	STORM PROFILE (EXISTING)
-----	TELEPHONE PROFILE (EXISTING)
-----	STORM PROFILE (PROPOSED)
-----	TV PROFILE (EXISTING)
-----	UTILITY PROFILE (EXISTING)
-----	WATER PROFILE (EXISTING)
-----	WATER PROFILE (PROPOSED)



SANITARY SEWER SYMBOLS		
EXISTING	PROPOSED	DESCRIPTION
○	●	SAN. SEWER CLEAN OUT
◯	● 2	SAN. SEWER MANHOLE

STORM DRAIN SYMBOLS		
EXISTING	PROPOSED	DESCRIPTION
 	■	STORM DRAIN CB TYPE 1
	 	STORM DRAIN CB TYPE 2
	●	STORM DRAIN CB TYPE 2 W/CB LID
	●	STORM DRAIN WITH OVERFLOW GRATE
○	●	STORM DRAIN CLEAN-OUT

SURVEY SYMBOLS

	BRASS SURFACE MONUMENT
	NAIL IN CONCRETE
	REBAR & CAP

AL	=ALIGNMENT
ANC	=UTILITY POLE ANCHOR
APPROX	=APPROXIMATE
ASPH or AC	=ASPHALT
ASSY	=ASSEMBLY
ASTM	=AMERICAN SOCIETY FOR TESTING & MATERIALS
BLDG	=BUILDING
BMT	=BENCH MANAGEMENT PRACTICE
BVCs	=BEGIN VERTICAL CURVE STATION
BVCE	=BEGIN VERTICAL CURVE ELEVATION
CB	=CATCH BASIN
CK	=CHECK VALVE
C/L	=CENTERLINE
CESCL	=CERTIFIED EROSION SEDIMENT CONTROL LEAD
COL	=COLUMN
CMP	=CORRUGATED METAL PIPE
C.O.	=CLEAN OUT
CONC. C	=CONCRETE
COR	=CORNER
CPP	=CORRUGATED POLYETHYLENE PIPE
CSD	=CUSHED SURFACING TOP COURSE
DDCA	=DOUBLE DETECTOR CHECK VALVE ASSEMBLY
DF	=DRAIN FIELD
DI	=DUCTILE IRON
DO	=DISSOLVED OXYGEN
DR	=DIAMETER RATIO
DS	=DOWNSPOUT
EB	=EXPLORATION BORING
EFFLT	=EFFLUENT
EG	=EXISTING GRADE
ELEV. EL	=ELEVATION
EOG	=EDGE OF GRAVEL
EOP	=EDGE OF PAVEMENT
EP	=EXPLORATION PIT
EXIST, EX	=EXISTING
EVCS	=END VERTICAL CURVE STATION
EVCE	=END VERTICAL CURVE ELEVATION
FD	=FIRE DEPARTMENT CONNECTION
FF	=FINISH GRADE
FG	=FINISH GRADE
FL	=FLOWLINE OR FLANGE (CONNECTION)
FL	=FLOWLINE
FLC	=FLOWLINE OF CURB
FNC	=FENCE
GB	=GRADE BREAK
GMET	=GAS METER
GP	=GUY POLE
GPM	=GALLONS PER MINUTE
GRVL, G	=GRAVEL
GUTT	=GUTTER
GV	=GATE VALVE
HB	=HOSE BIB
HGD	=HOT-DIP GALVANIZED
HDPE	=HIGH DENSITY POLYETHYLENE
H-V	=HORIZONTAL/VERTICAL
HWL	=HIGH WATER LEVEL
HYD	=HYDRANT
IE	=INVERT ELEVATION
INV	=INVERT
LF	=LINEAR FEET
LUM	=LUMINAIRE
L	=LEFT
MAX	=MAXIMUM
MB	=MAN BOX
MBR	=MEMBRANE BIO-REACTOR
MC	=MAINTENANCE CLEANING
MFEM	=MEMBRANE FILTRATION EQUIPMENT
MFR	=MANUFACTURER
MH	=MANHOLE
MIN	=MINIMUM
MISC	=MISCELLANEOUS
MJ	=MECHANICAL JOINT
MLS	=MIXED LIQUOR SUSPENDED SOLIDS
MW	=MONITORING WELL
NPDDES	=NATIONAL POLLUTANT DISCHARGE ELIMINATION SYSTEM
O.C.	=ON CENTER
O.C.E.W	=ON CENTER EACH WAY
OD	=OUTSIDE DIAMETER
OHF	=OVERHEAD POWER
OHT	=OVERHEAD TELEPHONE
OSHA	=OCCUPATIONAL SAFETY AND HEALTH ADMINISTRATION
PC	=POINT OF CURVATURE
PCC	=POINT OF CONTINUING CURVATURE
PV	=POST INDICATOR VALVE
P/L	=PROPERTY LINE
PLC	=PROGRAMMABLE LOGIC CONTROLLER
PLTR	=PLANTER
POL	=POINT ON LINE
PROP	=PROPOSED
PS	=PUMP STATION
PSI	=POUNDS PER SQUARE INCH
PT	=POINT OF TANGENCY
PVC	=POLYVINYL CHLORIDE
PVI	=POINT OF VERTICAL INTERSECTION
PW	=POTABLE WATER
R	=RADIUS
ROCK	=ROCK/BOULDER
RET	=RETAINING
REC	=RECORD
REQ'D	=REQUIRED
RI	=RAPID INFILTRATION
RPBA	=REUSE PRESSURE BACKFLOW ASSEMBLY
RR	=RAILROAD
RT	=RIGHT
R/W or ROW	=RIGHT-OF-WAY
RW	=REUSE WATER
SCADA	=SUPERVISORY CONTROL AND DATA ACQUISITION
SCH	=SCHEDULE
SCDB	=STORM DRAIN CATCH BASIN
SD	=STORM DRAIN
SDMH	=STORM DRAIN MANHOLE
SFH	=SINGLE FAMILY HOUSING
SH	=SHRUB/BUSH
SN	=SIGN
SPD	=STANDARD PROCTOR DENSITY
SPK	=SPIKE
SS	=SANITARY SEWER
SSCO	=SANITARY SEWER CLEAN-OUT
SSMH	=SANITARY SEWER MANHOLE
STA	=STATION
STEP	=SEPTIC TANK EFFLUENT PUMP
S/W	=SIDEWALK
TBC	=TOP BACK OF CURB
TBD	=TO BE DETERMINED
TBM	=TEMPORARY BENCH MARK
T.O.W.	=TOP OF WALL
TP	=TYPICAL
UP	=UTILITY POLE
VAC	=VACATED
VC	=VERTICAL CURVE
VOI	=VOLATILE CORROSION INHIBITOR
VEG	=VEGETATION
VFD	=VARIABLE FREQUENCY DRIVE
WAS	=WASTE ACTIVATED SLUDGE
WL	=WATERLINE
WM	=WATER METER
WS	=WATER SURFACE
WSDOT	=WASHINGTON STATE DEPARTMENT OF TRANSPORTATION
WV	=WATER VALVE
WWTP	=WASTE WATER TREATMENT PLANT
YD	=YARD DRAIN
YL	=YARD LIGHT


SHEET	C1.2	DATE 01/27/2016	CITY OF FERNDALE	DESIGNED BY JCC	DRAWN BY ROC	CHECKED BY AWL			Wilson SURVEY / ENGINEERING	WILSON ENGINEERING, LLC 805 DUPONT STREET BELLINGHAM, WA 98225 (360) 733-6100 • FAX (360) 647-9061 www.wilsonengineering.com
	OF	22								
		SCALE AS SHOWN	WHATCOM' COUNTY WASHINGTON							
		JOB NUMBER 2013-037	PUMP STATION NO. 4 LEGEND & ABBREVIATIONS							

00547.002 4/7/10 8#


CALL
TWO BUSINESS DAYS
BEFORE YOU DIG
1-800-424-5555
UTILITIES UNDERGROUND LOCATION CENTER

RECORD DRAWINGS

NO.	REVISIONS	BY	DATE
0	RECORD DRAWINGS	JGC	01/27/15

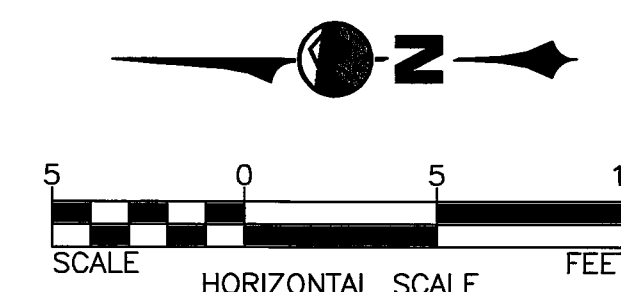

WILSON ENGINEERING, LLC
805 DUPONT STREET
BELLINGHAM, WA 98225
(360) 733-6100 • FAX (360) 647-9061
www.wilsonengineering.com

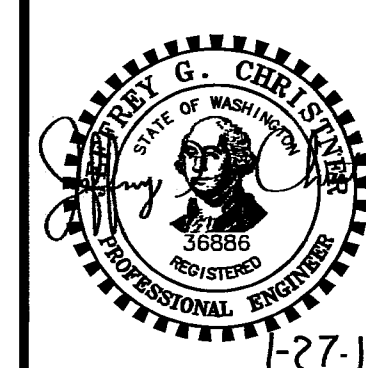

DESIGNED BY	JGC
DRAWN BY	ROG
CHECKED BY	AWI

CITY OF FERNDALE

HATCOM COUNTY


WASHINGTON


PUMP STATION NO. 4

PROPOSED SITE GRADING AND DRAINAGE

DATE	01/27/2016
SCALE	AS SHOWN
JOB NUMBER	2013-037

SHEET

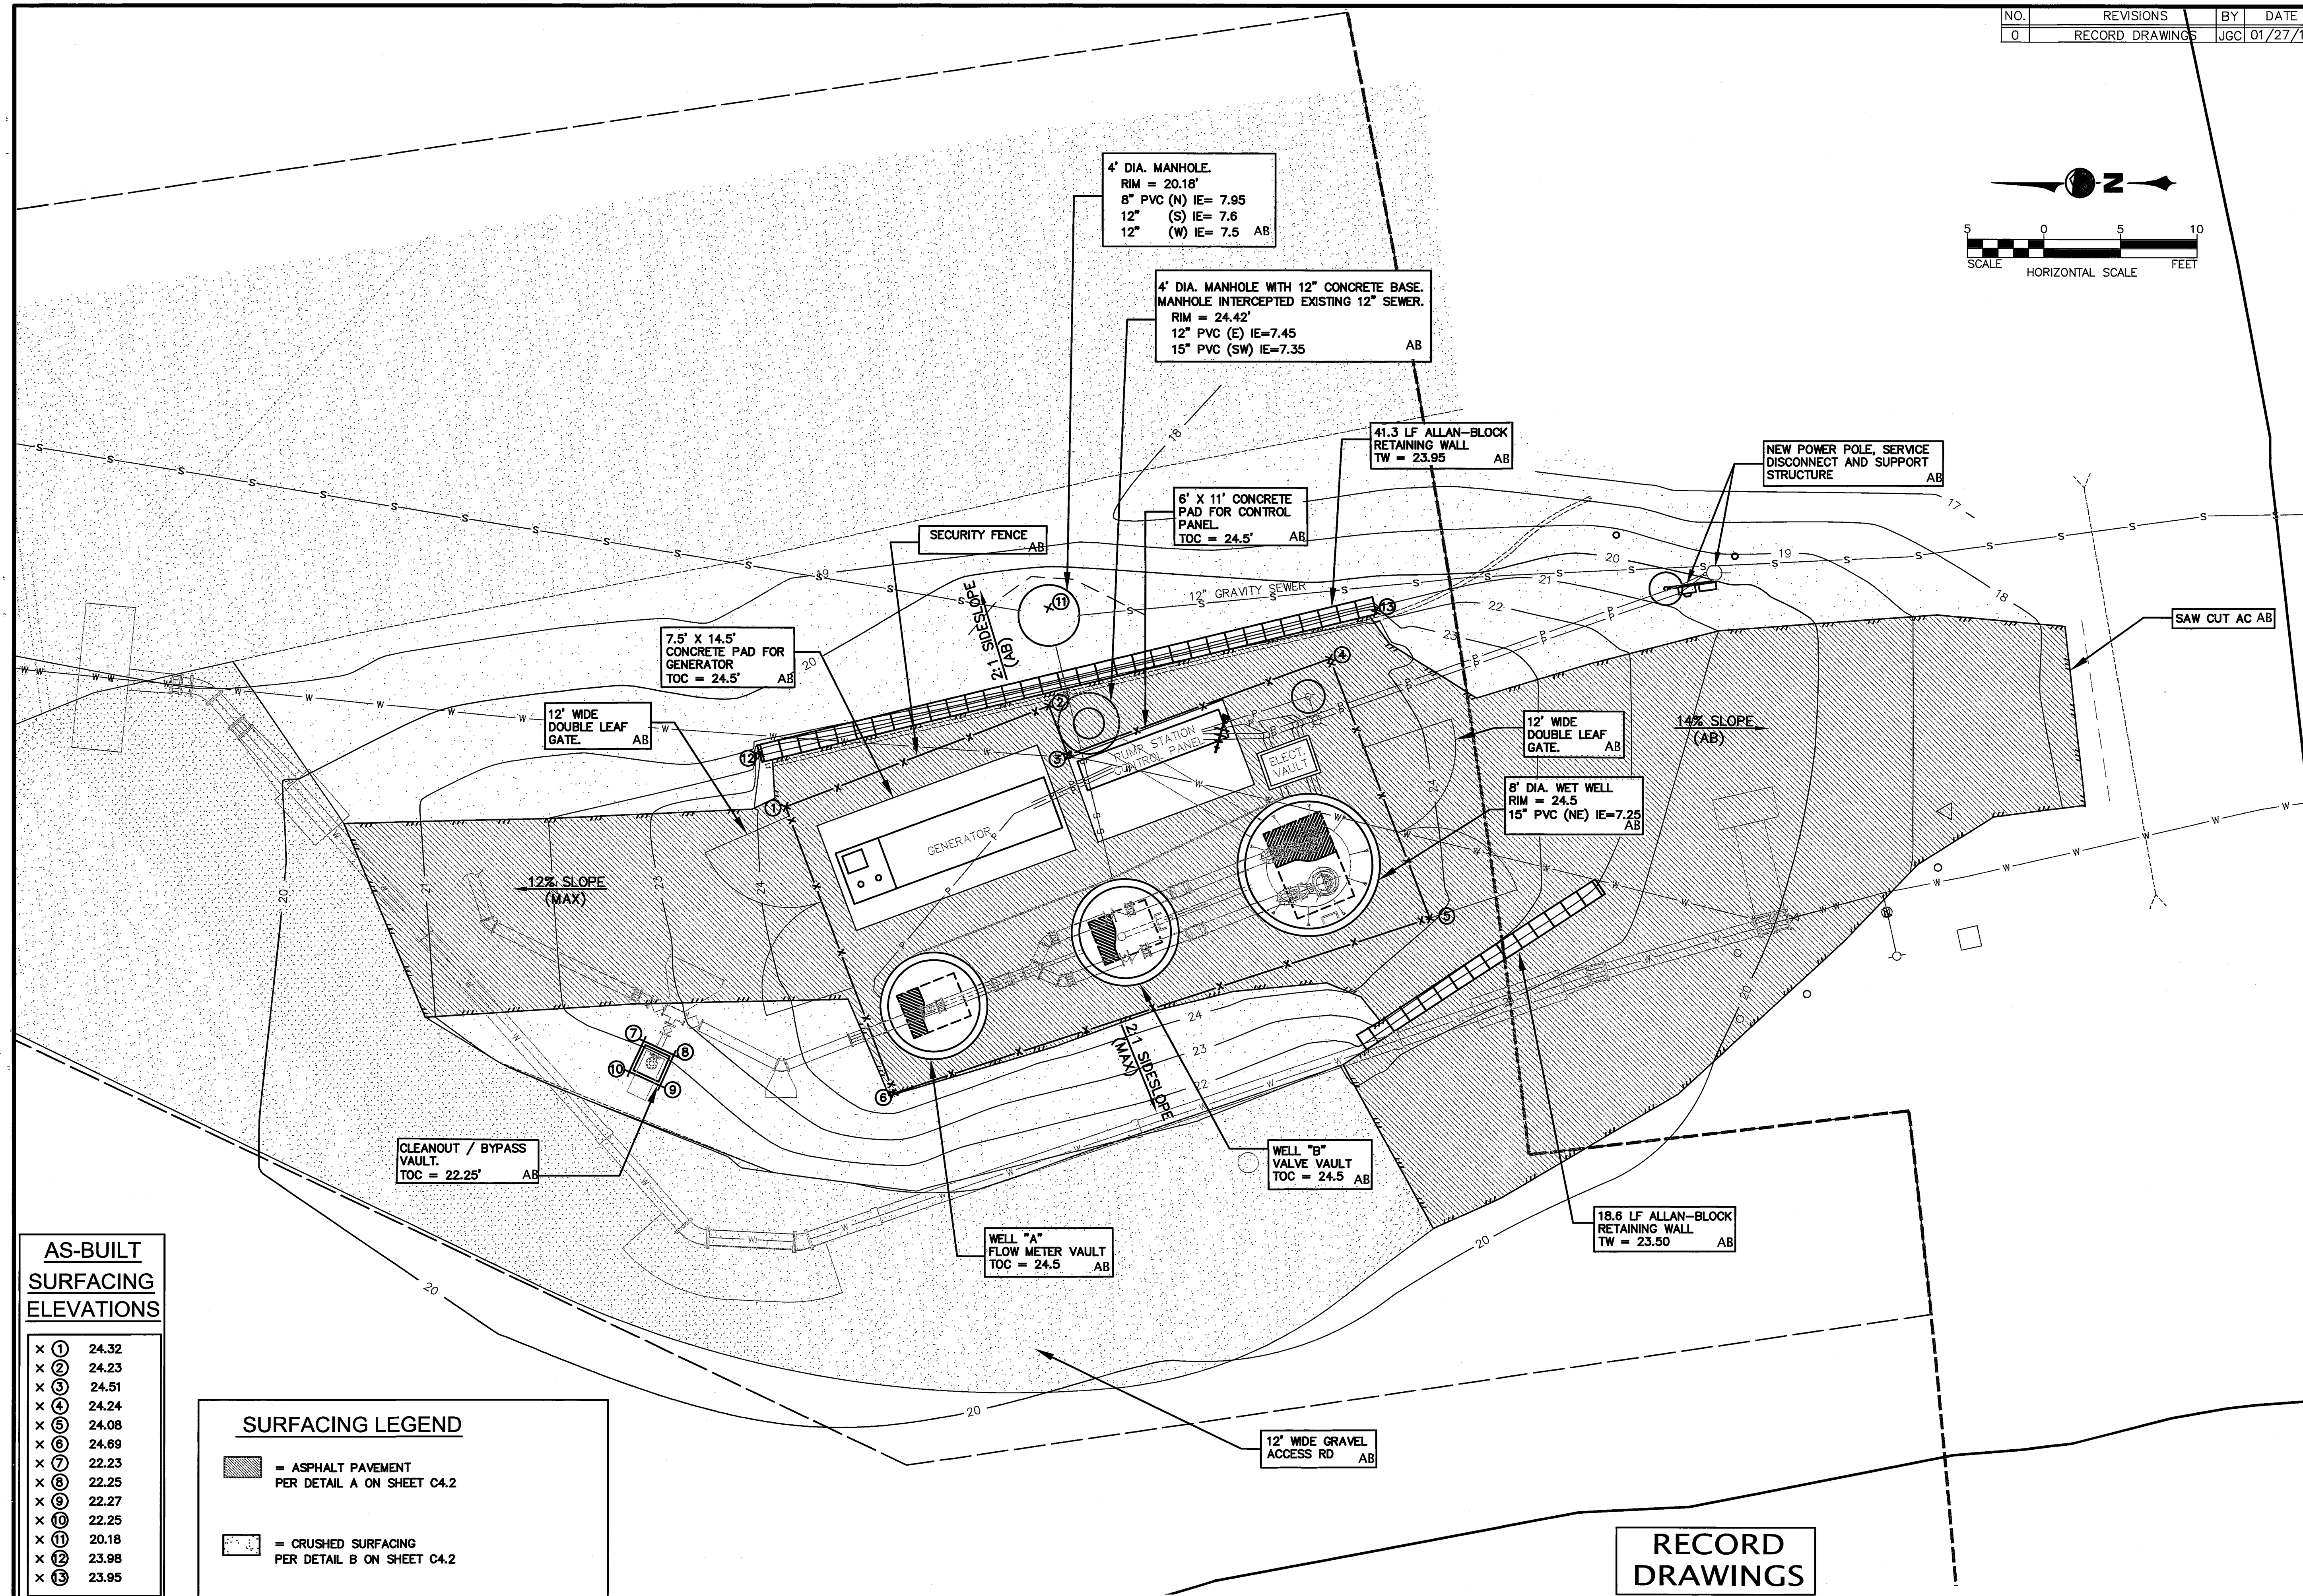22
OF

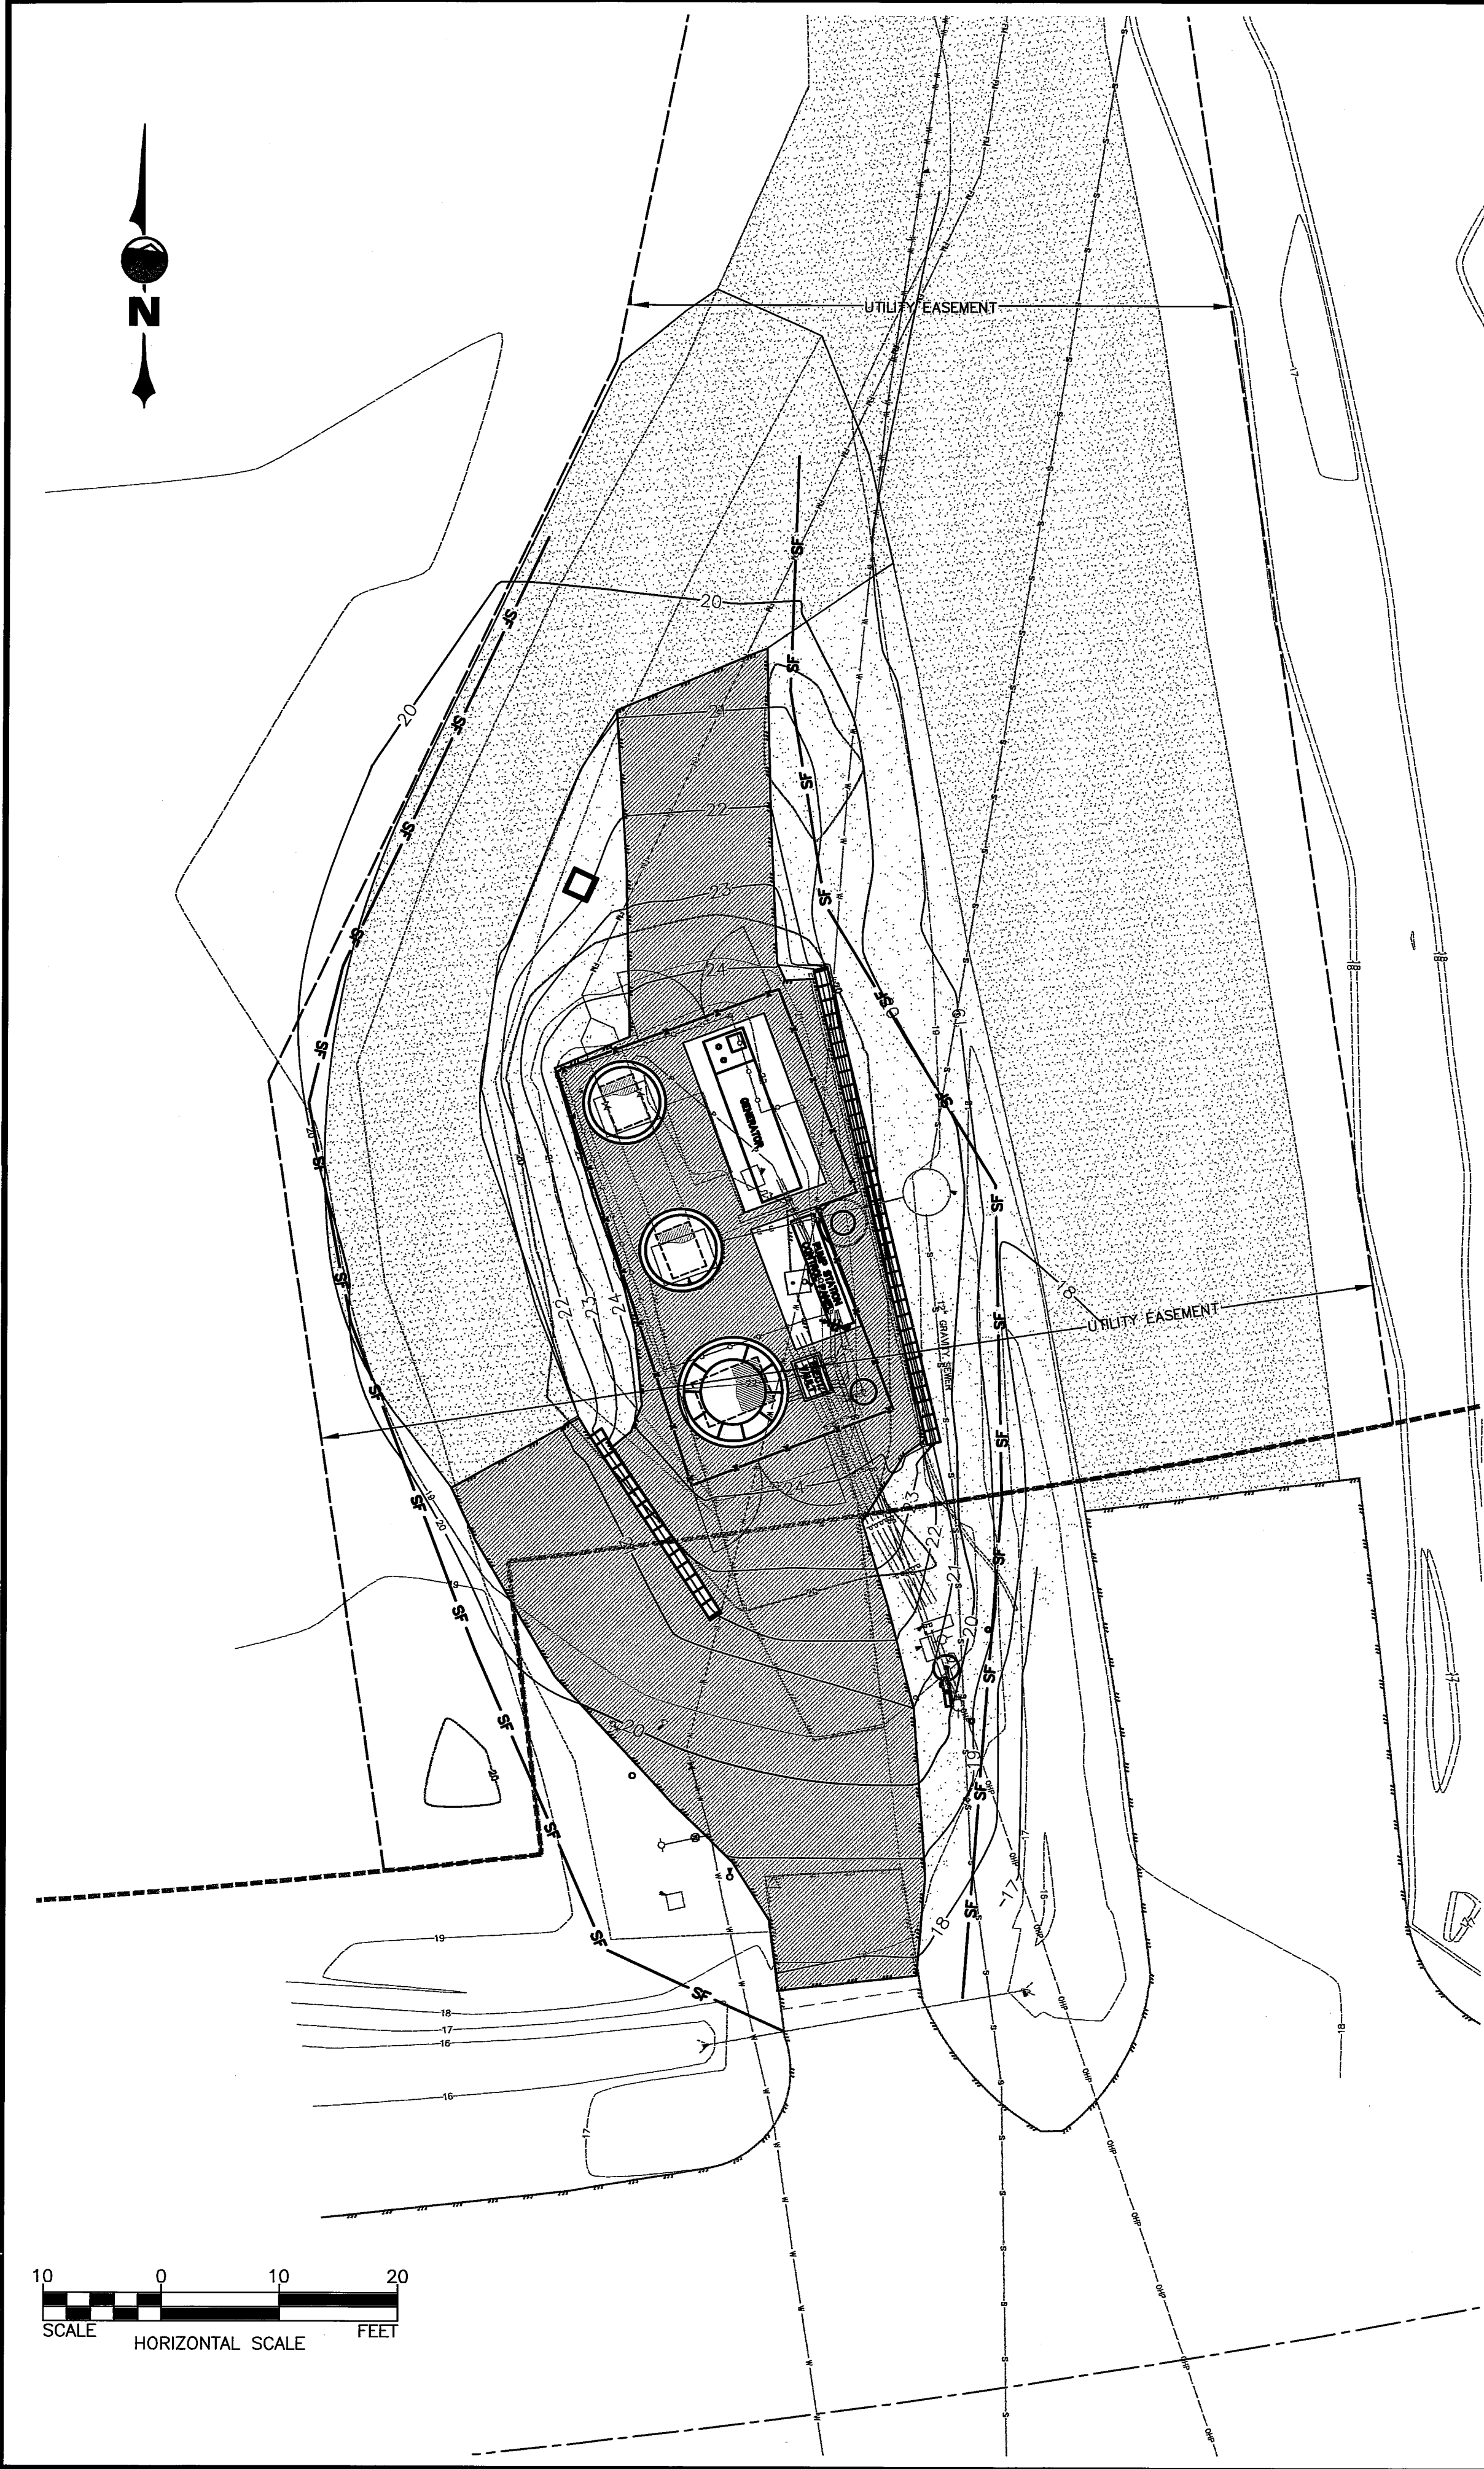

TESC PLAN

NARRATIVE

EROSION AND SEDIMENT CONTROL BMPs: ANTICIPATED BMPs THAT WILL BE UTILIZED INCLUDE: MINIMIZING VEGETATION REMOVAL, TEMPORARY COVER MEASURES, PERMANENT SEEDING & PLANTING, SURFACE ROUGHENING, AND FILTER FENCING. OTHER BMPs MAY BE UTILIZED TO MINIMIZE EROSION AND SEDIMENT TRANSPORT AS CONSTRUCTION SCHEDULES AND WEATHER CONDITIONS DICTATE.

TEMPORARY STABILIZATION: ALL DISTURBED AREAS SHALL BE STABILIZED IF IN THE EVENT OF RAIN. ALL DISTURBED AREAS SHALL BE STABILIZED IF UNWORKED FOR SEVEN DAYS.

PERMANENT STABILIZATION: ALL DISTURBED AREAS OUTSIDE OF ROADWAY SHOULDERS AND PARKING AREAS WILL BE PERMANENTLY LANDSCAPED OR SEEDED AND RESTORED TO THEIR EXISTING CONDITIONS.

CONVEYANCE BYPASS: PROVISION FOR BYPASS OF STORMWATER CONVEYANCE SHALL BE PROVIDED. BYPASS SHALL BE INSTALLED FOR THE DURATION OF THE WORK. MATERIALS FOR BYPASS NEED NOT BE INSTALLED WHILE WORK IS IN PROGRESS AT A PARTICULAR LOCATION, BUT MATERIALS AND EQUIPMENT FOR IMMEDIATE INSTALLATION SHALL BE ON HAND. BYPASS SHALL BE IN PLACE WHILE SITE IS UNATTENDED FOR GREATER THAN 12 HOURS. A TRENCH MAY BE DUG FOR THE BYPASS PRIOR TO INSTALLATION OF BYPASS IF NECESSARY AND FEASIBLE. ANY PIPING USED FOR BYPASS SHALL BE OF A DIAMETER AT LEAST 3/4 OF THE EXISTING PIPE/CULVERT DIAMETER.

MAINTENANCE: THE BMPs SHALL BE INSPECTED AS NEEDED (MINIMUM OF ONCE EVERY THREE DAYS) AND DURING/AFTER RAINFALL EVENTS. THE BMPs WILL BE MAINTAINED UNTIL THE RISK OF EROSION HAS PASSED AND THE AREA IS PERMANENTLY STABILIZED.

GENERAL NOTES

1. BMPs: BEST MANAGEMENT PRACTICES (BMPs) REFERRED TO ON THIS PLAN AND IN THESE NOTES SHALL BE CONSTRUCTED AND MAINTAINED AS DESCRIBED IN DEPARTMENT OF ECOLOGY'S STORMWATER MANAGEMENT MANUAL FOR THE PUGET SOUND BASIN, CHAPTER II-5, "STANDARDS AND SPECIFICATIONS FOR BEST MANAGEMENT PRACTICES FOR EROSION AND SEDIMENT CONTROL."
2. EXTENT: THE EXTENT OF EROSION AND SEDIMENTATION CONTROL MEASURES IS DEPENDENT ON WEATHER CONDITIONS, SITE SLOPES, LENGTH OF TIME GROUND IS LEFT EXPOSED, AND THE AREA OF EXPOSED GROUND. THE CONTRACTOR SHALL AT ALL TIMES MINIMIZE THE RISK OF SITE EROSION BY CAREFUL SCHEDULING AND BY IMPLEMENTING AND MAINTAINING BMPs UNTIL THE SITE IS PERMANENTLY STABILIZED.
3. UNWORKED SOILS: ALL EXPOSED AND UNWORKED SOILS SHALL BE STABILIZED BY SUITABLE AND TIMELY APPLICATION OF BMPs.
4. VEGETATION: EXISTING VEGETATION SHALL BE PRESERVED WHERE ATTAINABLE.
5. SLOPES: CUT AND FILL SLOPES SHALL BE CONSTRUCTED IN A MANNER THAT WILL MINIMIZE EROSION. SLOPES SHALL BE STABILIZED AS SOON AS POSSIBLE.
6. OUTLETS: STABILIZATION ADEQUATE TO PREVENT EROSION OF OUTLETS AND ADJACENT STREAM BANKS SHALL BE PROVIDED AT THE OUTLETS OF ALL CONVEYANCE SYSTEMS.
7. INLETS: ALL EXISTING AND PROPOSED STORM DRAIN INLETS SHALL BE PROPERLY MAINTAINED AND PROTECTED FROM SILTATION.
8. ENTRANCES: PROVISION SHALL BE MADE TO MINIMIZE THE TRANSPORT OF SOIL ONTO THE PAVED ROAD. IF SOIL IS TRANSPORTED ONTO A ROAD SURFACE, THE ROADS ADJACENT TO THE CONSTRUCTION SITE SHALL BE CLEANED ON A WEEKLY BASIS. STREET WASHING SHALL BE ALLOWED ONLY IF WASHWATER IS INFILTRATED IN THE RIGHT OF WAY.
9. TEMPORARY CONSTRUCTION ENTRANCE: IN PLACE OF A CONSTRUCTED CONSTRUCTION ENTRANCE, CONTRACTOR SHALL PROVIDE ADEQUATE PROVISIONS TO ENSURE THAT NO SEDIMENT IS TRACKED OFF THE CONSTRUCTION SITE. IN THE EVENT THAT SEDIMENT TRACKING OCCURS, CONTRACTOR SHALL REMOVE ALL TRACKED SEDIMENT IMMEDIATELY.
10. SITE RUNOFF: PRIOR TO FLOWING OFF THE SITE, STORMWATER RUNOFF SHALL PASS THROUGH A SILT FENCE OR EQUAL BMP.
11. ADJACENT PROPERTIES: PROPERTIES ADJACENT TO THE PROJECT SHALL BE PROTECTED FROM SEDIMENT DEPOSITION.
12. DOWNSTREAM WATERWAYS & PROPERTY: PROPERTIES AND WATERWAYS DOWNSTREAM FROM THE CONSTRUCTION SITE SHALL BE PROTECTED FROM EROSION DUE TO ANY TEMPORARY CHANGES IN VOLUME, VELOCITY, AND PEAK FLOW OF STORMWATER RUNOFF FROM THE PROJECT SITE.
13. REMOVAL OF BMPs: ALL TEMPORARY EROSION AND SEDIMENT CONTROL BMPs SHALL BE REMOVED WITHIN 30 DAYS AFTER FINAL SITE STABILIZATION IS ACHIEVED OR AFTER THE TEMPORARY BMPs ARE NO LONGER NEEDED. TRAPPED SEDIMENT SHALL BE REMOVED OR STABILIZED ON-SITE. DISTURBED SOIL AREAS RESULTING FROM REMOVAL SHALL BE PERMANENTLY STABILIZED.
14. INSPECTIONS: ALL BMPs SHALL BE INSPECTED, MAINTAINED, AND REPAIRED BY THE CONTRACTOR AS NEEDED TO ASSURE CONTINUED PERFORMANCE OF THEIR INTENDED FUNCTION. ALL ON-SITE EROSION AND SEDIMENT CONTROL MEASURES SHALL BE INSPECTED REGULARLY AS NEEDED (AT LEAST ONCE EVERY SEVEN DAYS) AND DURING/WITHIN 24 HOURS AFTER ANY STORM EVENT OF GREATER THAN 0.5-INCHES OF RAIN PER 24-HOUR PERIOD.
15. REPORTS: THE CONTRACTOR SHALL PREPARE AND MAINTAIN REPORTS SUMMARIZING THE SCOPE OF INSPECTIONS, THE PERSONNEL CONDUCTING THE INSPECTION, THE DATES OF THE INSPECTION, MAJOR OBSERVATIONS ACTIONS TAKEN AS A RESULT OF THESE INSPECTIONS.
16. OTHER REQUIREMENTS: THE ENGINEER, OWNER, CITY OF FERNDALE, DEPARTMENT OF ECOLOGY, OR OTHER AGENCIES MAY REQUIRE BMPs IN ADDITION TO WHAT IS SHOWN ON THIS PLAN IF NECESSARY TO PREVENT VIOLATIONS OF SURFACE WATER QUALITY. THE CONTRACTOR SHALL IMPLEMENT THE BMPs AS REQUIRED.
17. IF AREA OF DISTURBANCE WILL EXCEED 1.0 ACRES, CONTRACTOR SHALL COMPLY WITH NPDES CONSTRUCTION GENERAL PERMIT REQUIREMENTS INCLUDING, BUT NOT LIMITED TO: FILING OF N.O.I. PUBLIC NOTICE, PREPARATION AND MAINTENANCE OF A SWPPP, MONITORING, REPORTING AND FILING OF A N.O.T.

LEGEND

—sf— = SILT FENCE BMP C-233

NO.	REVISIONS	BY	DATE
0	RECORD DRAWINGS	JGC	01/27/15

BMP C233 — SILT (FILTER FABRIC) FENCE


PURPOSE: USE OF A SILT FENCE REDUCES THE TRANSPORT OF COARSE SEDIMENT FROM A CONSTRUCTION SITE BY PROVIDING A TEMPORARY PHYSICAL BARRIER TO SEDIMENT AND REDUCING THE RUNOFF VELOCITIES OF OVERLAND FLOW.

INSTALLATION: USE DOWN SLOPE OF DISTURBED AREAS AS SHOWN ON THE PLAN AND AS NEEDED TO RESPOND TO SITE SPECIFIC CONDITIONS. GEOTEXTILE SHALL MEET THE FOLLOWING STANDARDS: POLYMERIC MESH AOS (ASTM D4751) = 0.60 MM MAXIMUM FOR SLIT FILM WOVENS, 0.30 MM MAXIMUM FOR ALL OTHER GEOTEXTILES TYPES, AND 0.15 MM FOR ALL FABRIC TYPES, WATER PERMITTIVITY (ASTM D4491) = 0.2 SEC(-1) MINIMUM, GRAB TENSILE STRENGTH (ASTM D4632) = 180 POUNDS MINIMUM FOR EXTRA STRENGTH FABRIC, 100 POUNDS MINIMUM FOR STANDARD STRENGTH FABRIC, GRAB TENSILE ELONGATION (ASTM D4632) = 30% MAXIMUM, ULTRAVIOLET RESISTANCE (ASTM D4355) = 70% MINIMUM.

STANDARD STRENGTH FABRICS SHALL BE SUPPORTED WITH WIRE MESH, CHICKEN WIRE, 2-INCH X 2-INCH WIRE, SAFETY FENCE, OR JUTE MESH TO INCREASE THE STRENGTH OF THE FABRIC. SILT FENCE MATERIALS ARE AVAILABLE THAT HAVE SYNTHETIC MESH BACKING ATTACHED.

THE MINIMUM HEIGHT OF THE TOP OF THE SILT FENCE SHALL BE 2 FEET AND THE MAXIMUM HEIGHT SHALL BE 2.5 FEET.

MAINTENANCE: INSPECT THE FENCE AFTER RAINFALL EVENTS FOR SEDIMENT DEPOSITS UPSTREAM OF THE FENCE. REMOVE SEDIMENT DEPOSITS WHEN THEY REACH A DEPTH OF APPROXIMATELY 8 INCHES DEEP. REPLACE FILTER FABRIC FENCES DAMAGED BY CONSTRUCTION EQUIPMENT OR ULTRAVIOLET BREAKDOWN.

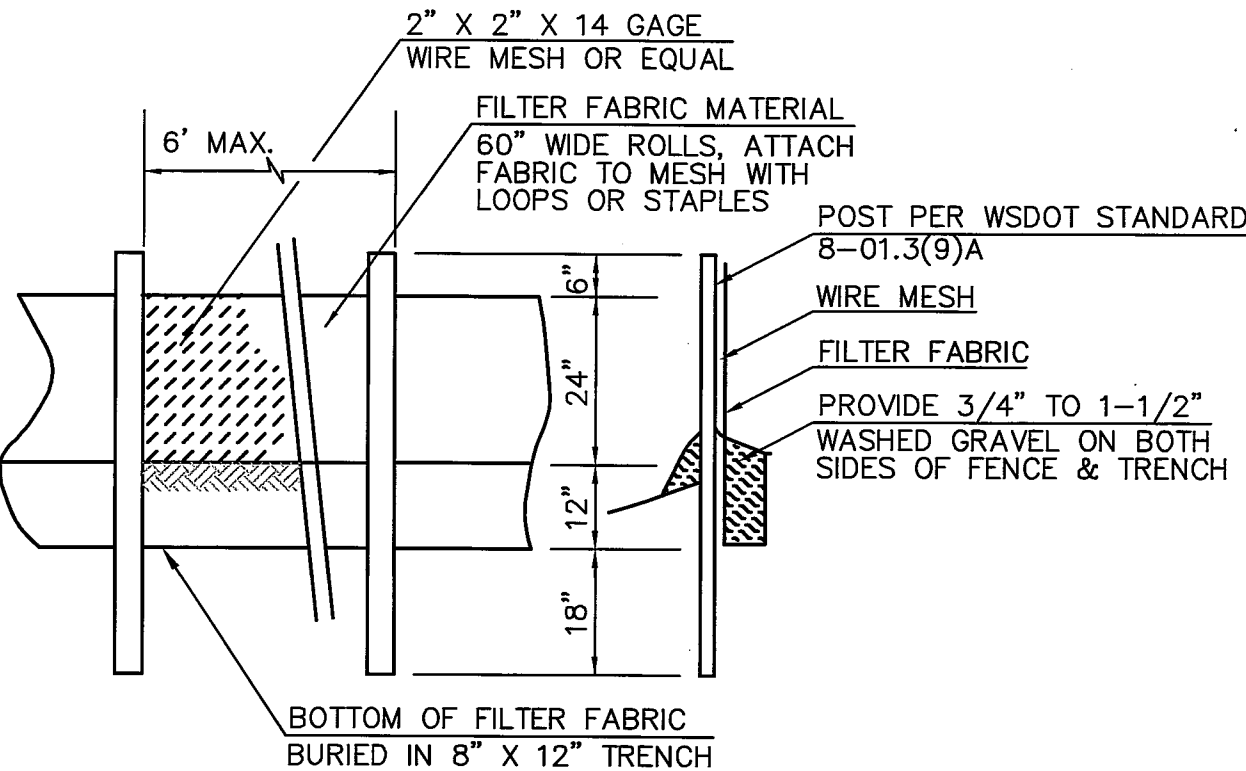


BMP C-233
SILT FENCE
NOT TO SCALE

IN PLACE OF A CONSTRUCTED CONSTRUCTION ENTRANCE, CONTRACTOR SHALL PROVIDE ADEQUATE PROVISIONS TO ENSURE THAT NO SEDIMENT IS TRACKED OFF THE CONSTRUCTION SITE. IN THE EVENT THAT SEDIMENT TRACKING OCCURS, CONTRACTOR SHALL REMOVE ALL TRACKED SEDIMENT IMMEDIATELY.

WILSON ENGINEERING, LLC
805 DUPONT STREET
BELLINGHAM, WA 98225
(360) 733-6100 • FAX (360) 647-9061
www.wilsonengineering.com

Wilson
SURVEY/ENGINEERING

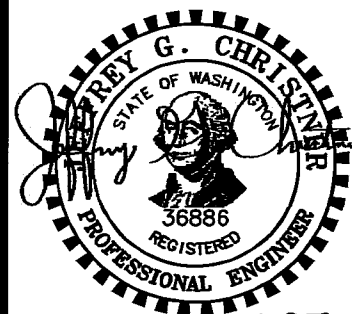

DESIGNED BY	JGC
DRAWN BY	ROC
CHECKED BY	AWL


CITY OF FERNDALE
WHATCOM COUNTY
WASHINGTON
PUMP STATION NO. 4
TESC PLAN, DETAILS & NOTES

DATE	01/27/2016
SCALE	AS SHOWN
JOB NUMBER	2013-037



SHEET	C2.4
OF	22

RECORD
DRAWINGS



478 911711 4116 847 00 574 00

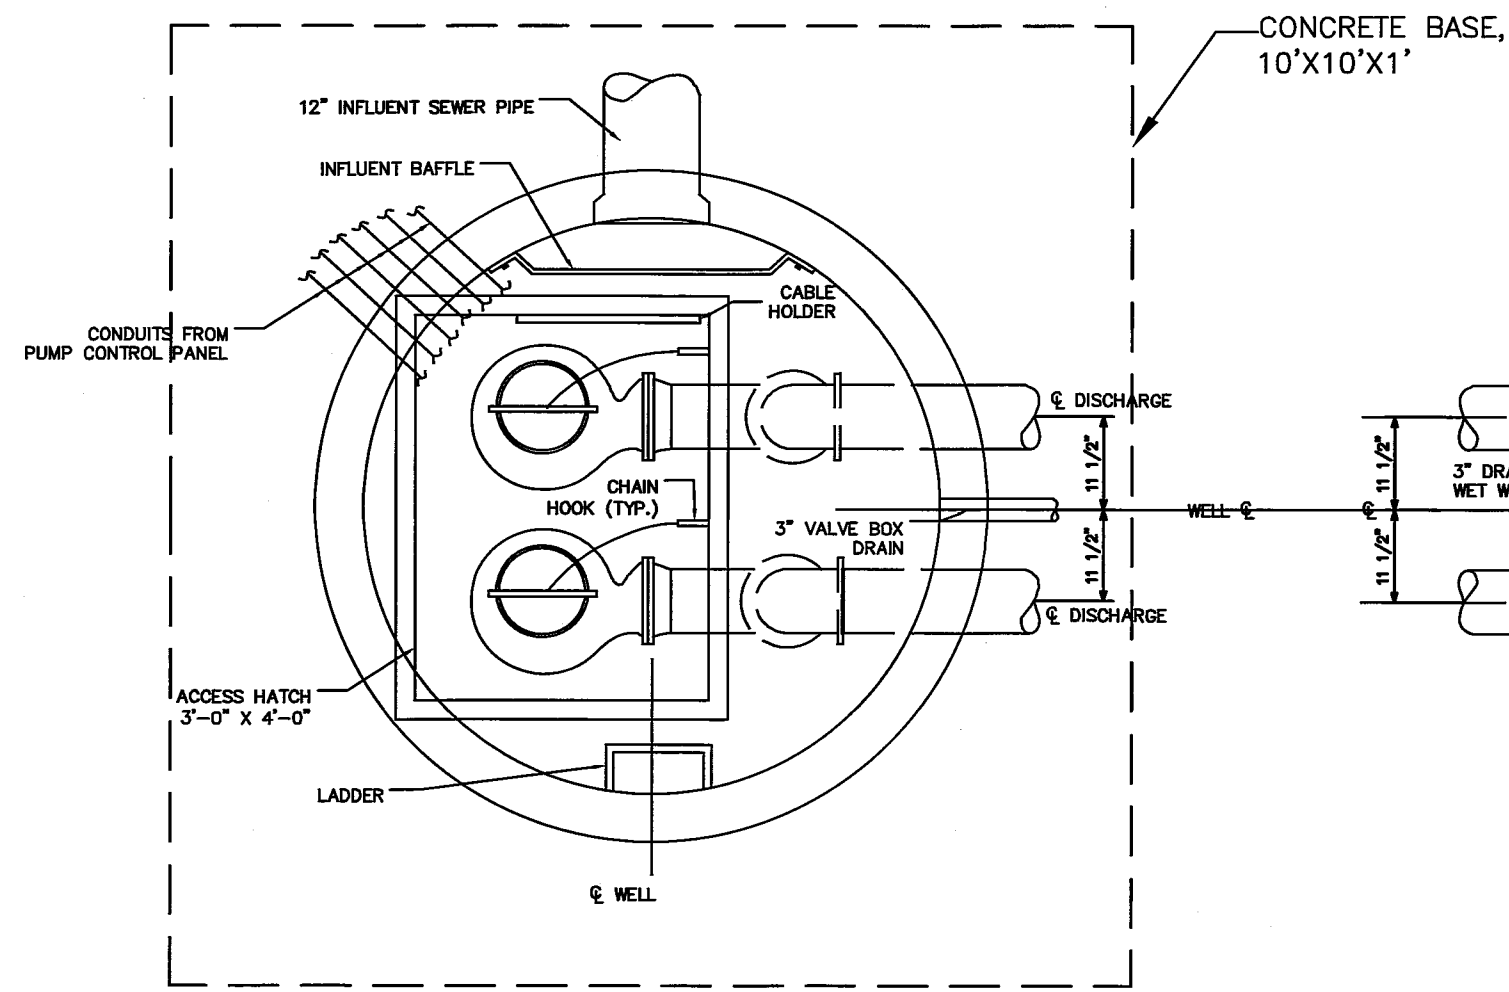



EXISTING WELL B PLAN

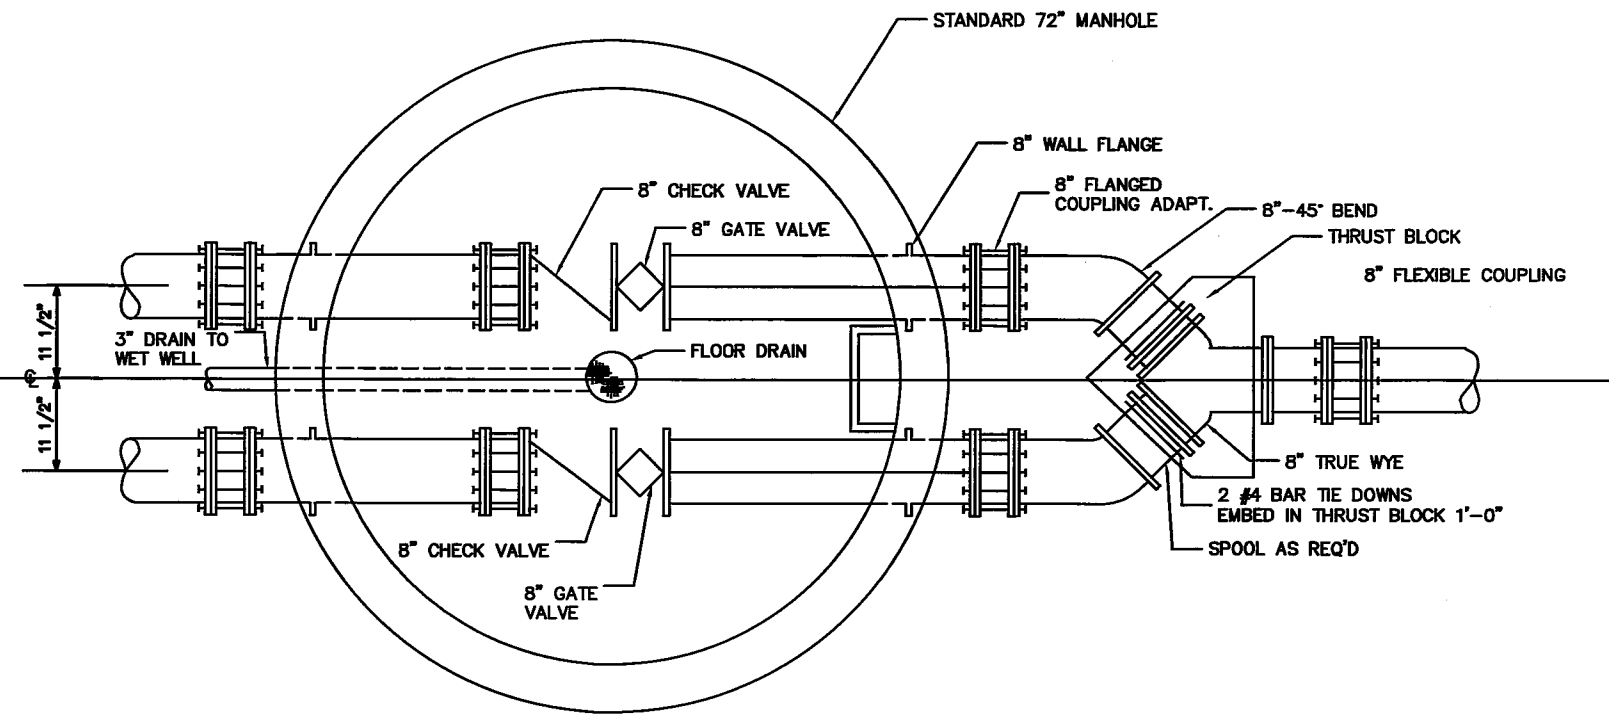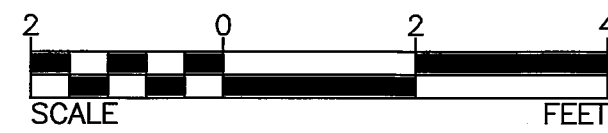


EXISTING WELL A PLAN

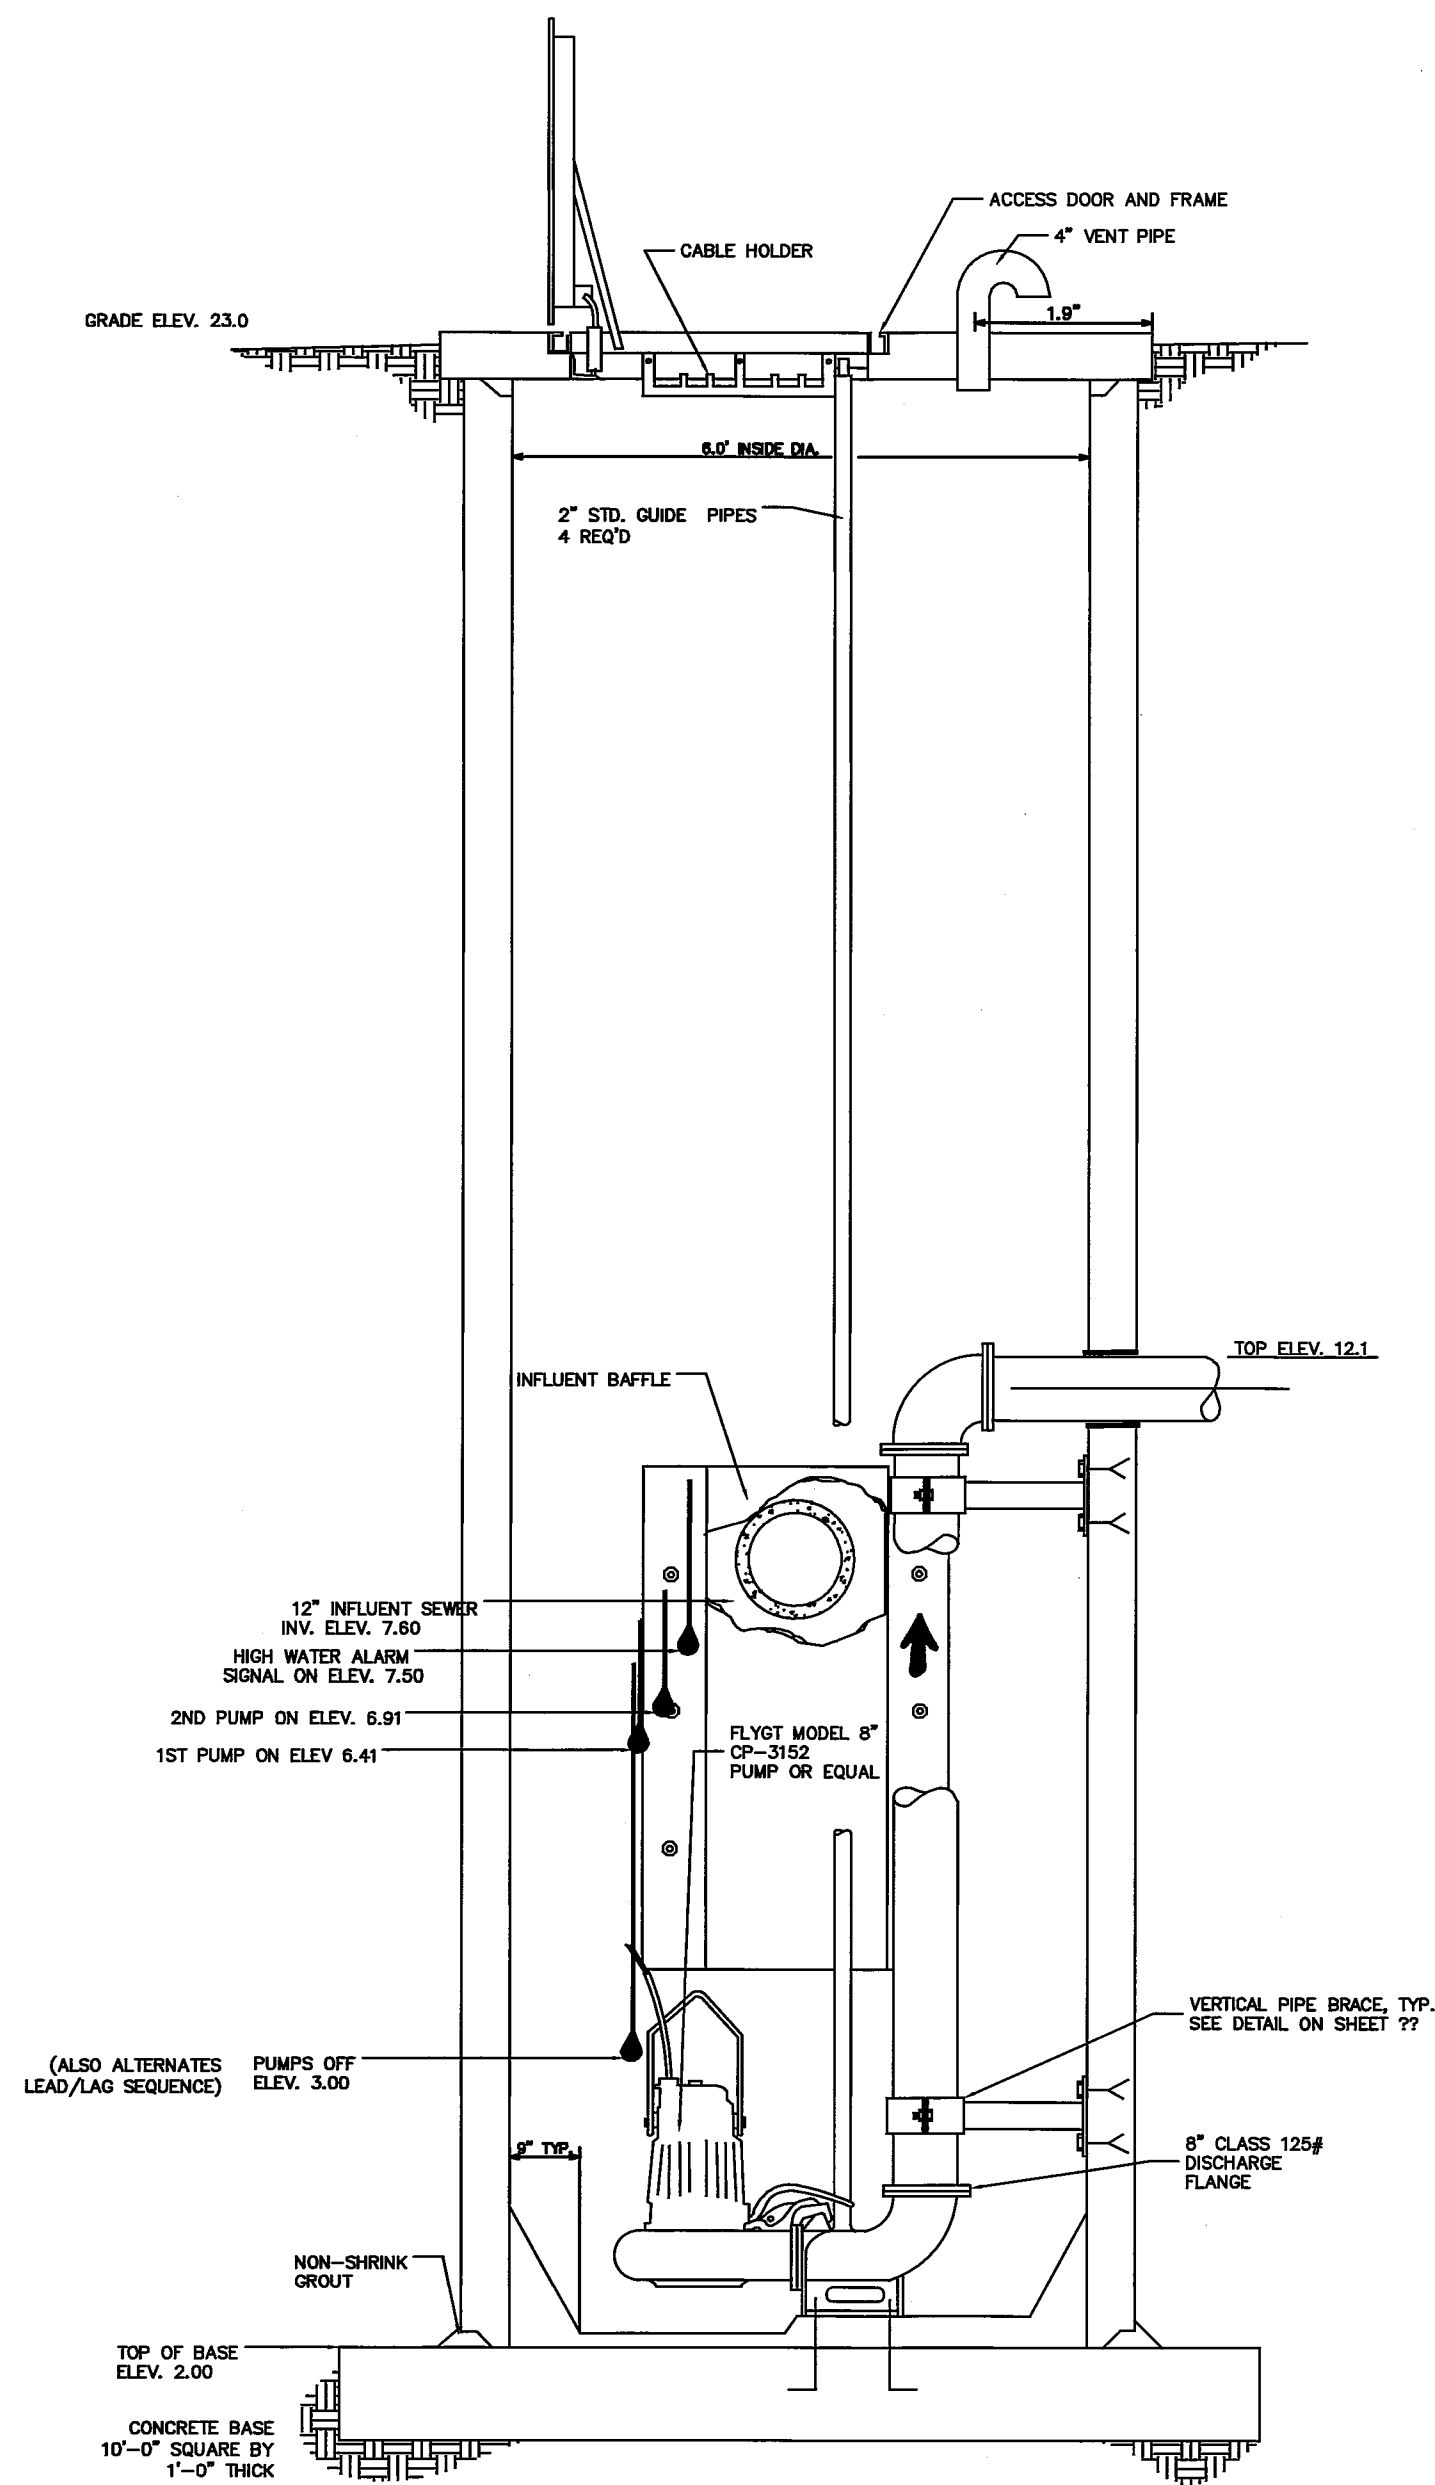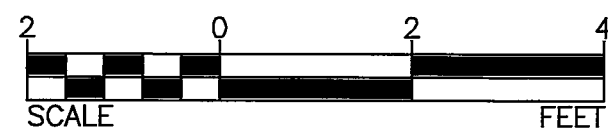

EXISTING WELL B PROFILE

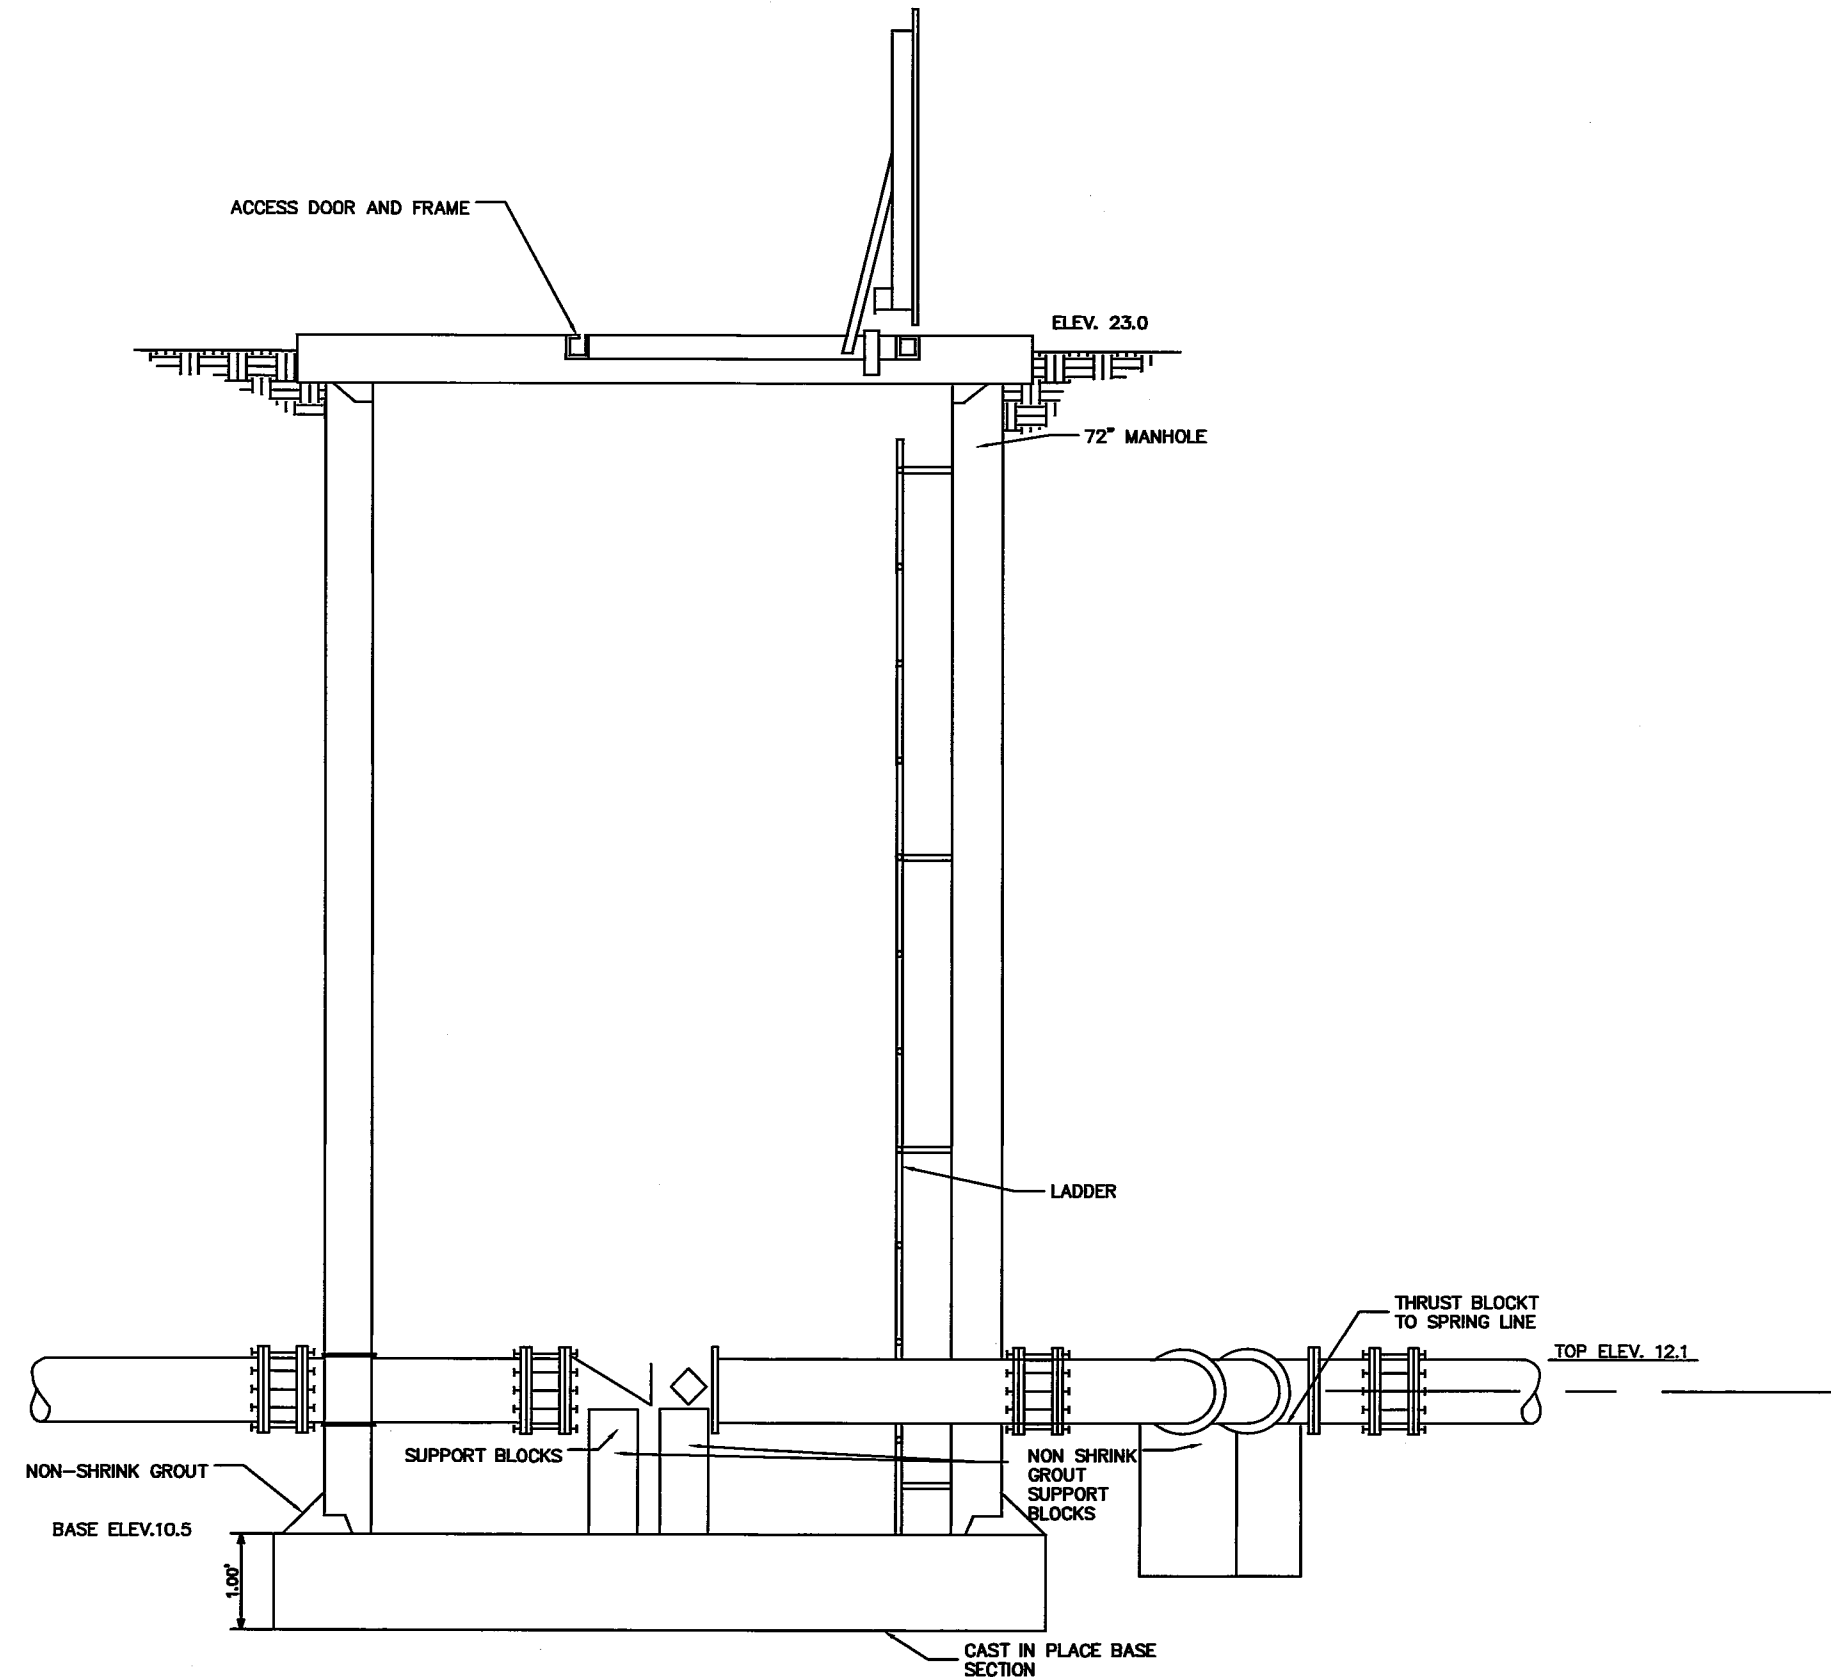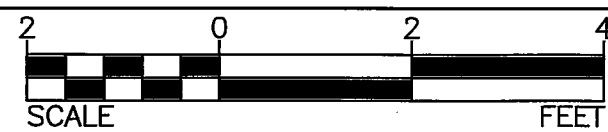


EXISTING WELL A PROFILE

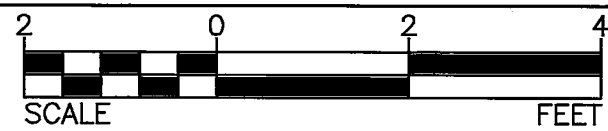

NO.	REVISIONS	BY	DATE
0	RECORD DRAWINGS	JGC	01/27/15

WILSON ENGINEERING, LLC
805 DUPONT STREET
BELLINGHAM, WA 98225
(360) 733-6100 • FAX (360) 647-9061
www.wilsonengineering.com

Wilson
SURVEY/ENGINEERING

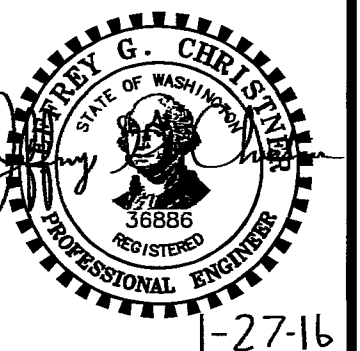

DESIGNED BY	JGC
DRAWN BY	CJP
CHECKED BY	AWL


CITY OF FERDALE
PUMP STATION NO. 4
EXISTING PLAN AND PROFILE LAYOUT

DATE	01/27/2016
SCALE	AS SHOWN
JOB NUMBER	2013-037

SHEET	C3.1
OF	22



RECORD
DRAWINGS

00547-007 4/7/16 SH

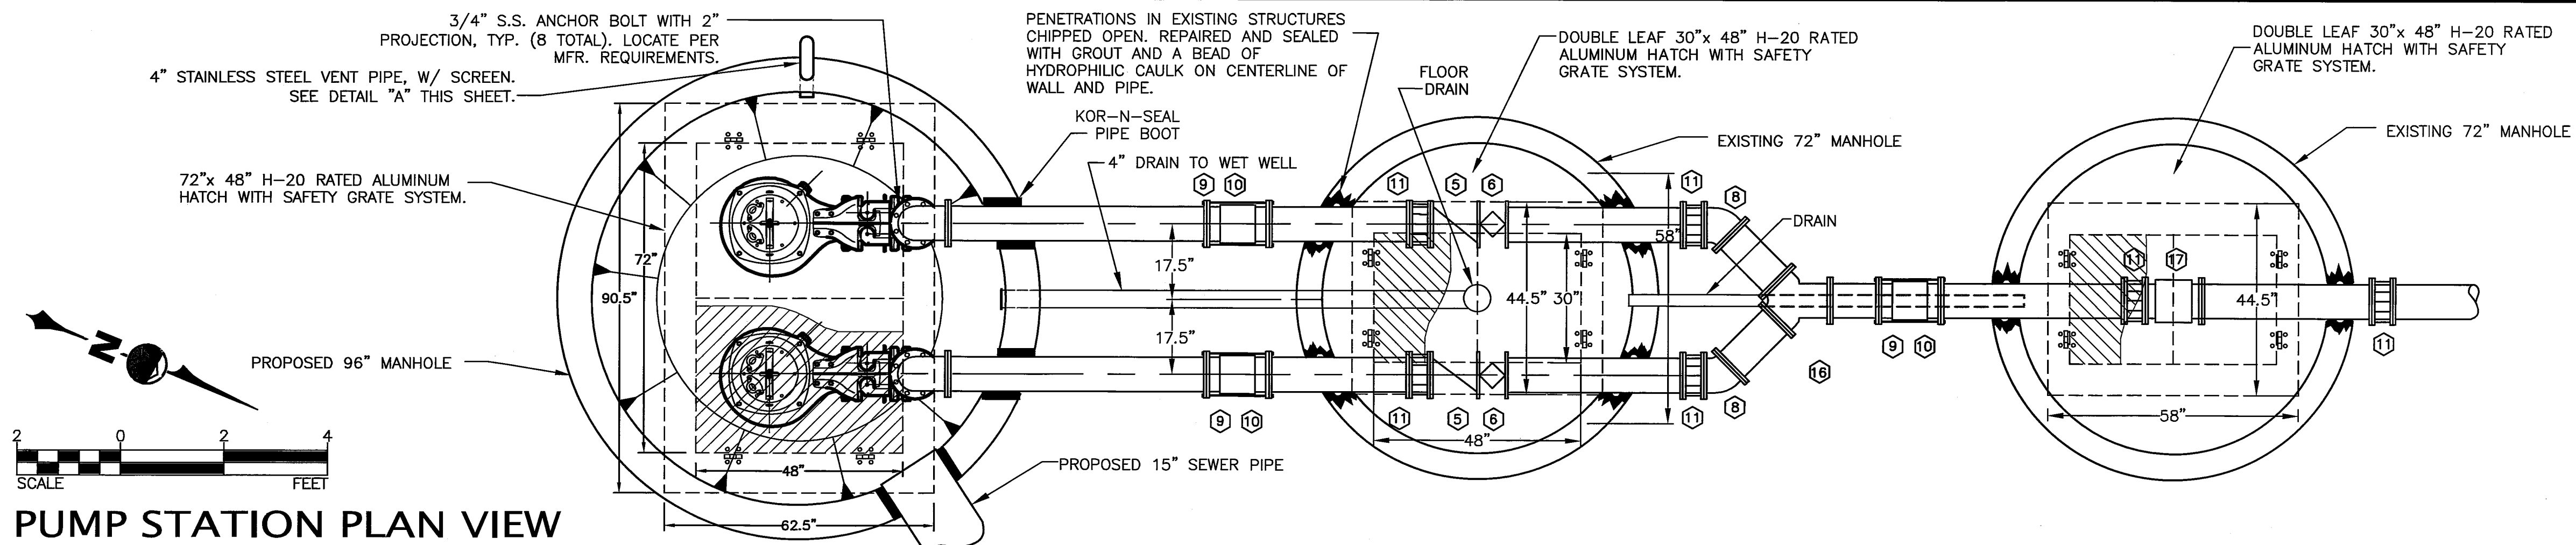

PUMP STATION PLAN VIEW

NO.	REVISIONS	BY	DATE
0	RECORD DRAWINGS	JGC	01/27/15
1	8" D.I. SPOOL, FxMJ		
2	8" D.I. SPOOL, FxF		
3	8" D.I. 90° BEND, FxF		
4	NOT USED		
5	8" CHECK VALVE, FxF		
6	8" GATE VALVE, FxF		
7	8" D.I. 22½" BEND, FLxFL		
8	8" D.I. 45° BEND, FLxFL		
9	8" BOLTED FLEX COUPLING, ROMAC STYLE "501" OR EQUAL.		
10	8" ROMAC STYLE "611" PIPE RESTRAINING SYSTEM OR EQUAL (200 PSI MINIMUM RESTRAINT)		
11	8" FLANGED COUPLING ADAPTOR (RESTRAINED)		
12	8" D.I. PIPE, FORCE MAIN, MJ		
13	PRESSURE GAGE, ISOLATOR, & SHUTOFF VALVE		
14	ADJUSTABLE PIPE SUPPORTS (6 TOTAL)		
15	8"x6" D.I. REDUCER (NOMINAL) FOR PUMP DISCHARGE, FxF. CONFIRM SIZE WITH PUMP MFR.		
16	8" TRUE WYE		
17	8" ELECTROMAGNETIC FLOW METER		
18	4" FLAP GATE FOR DRAIN PIPE.		

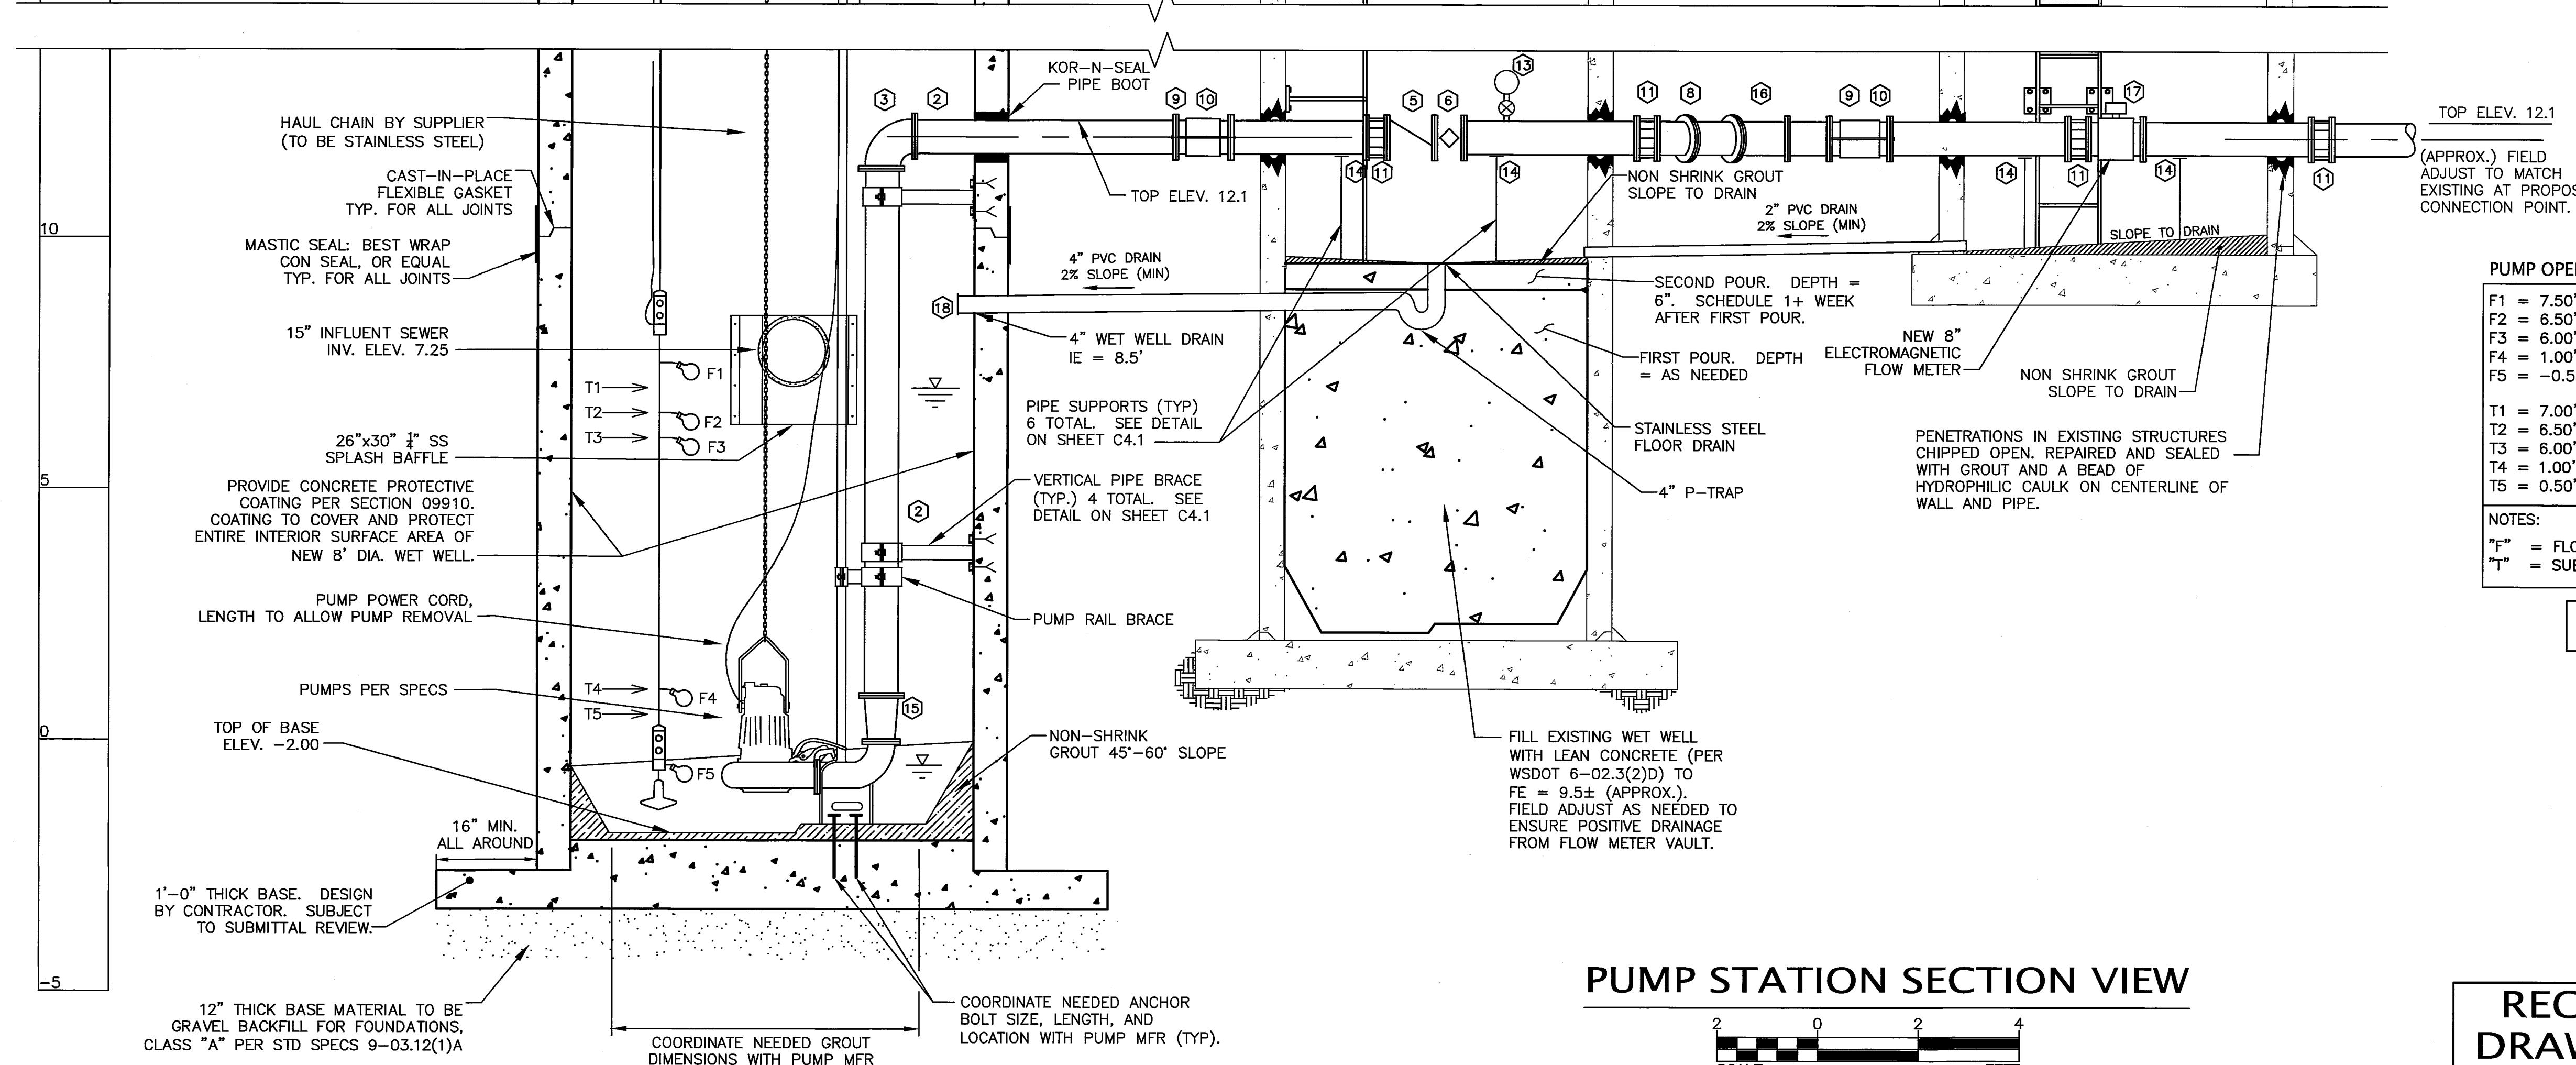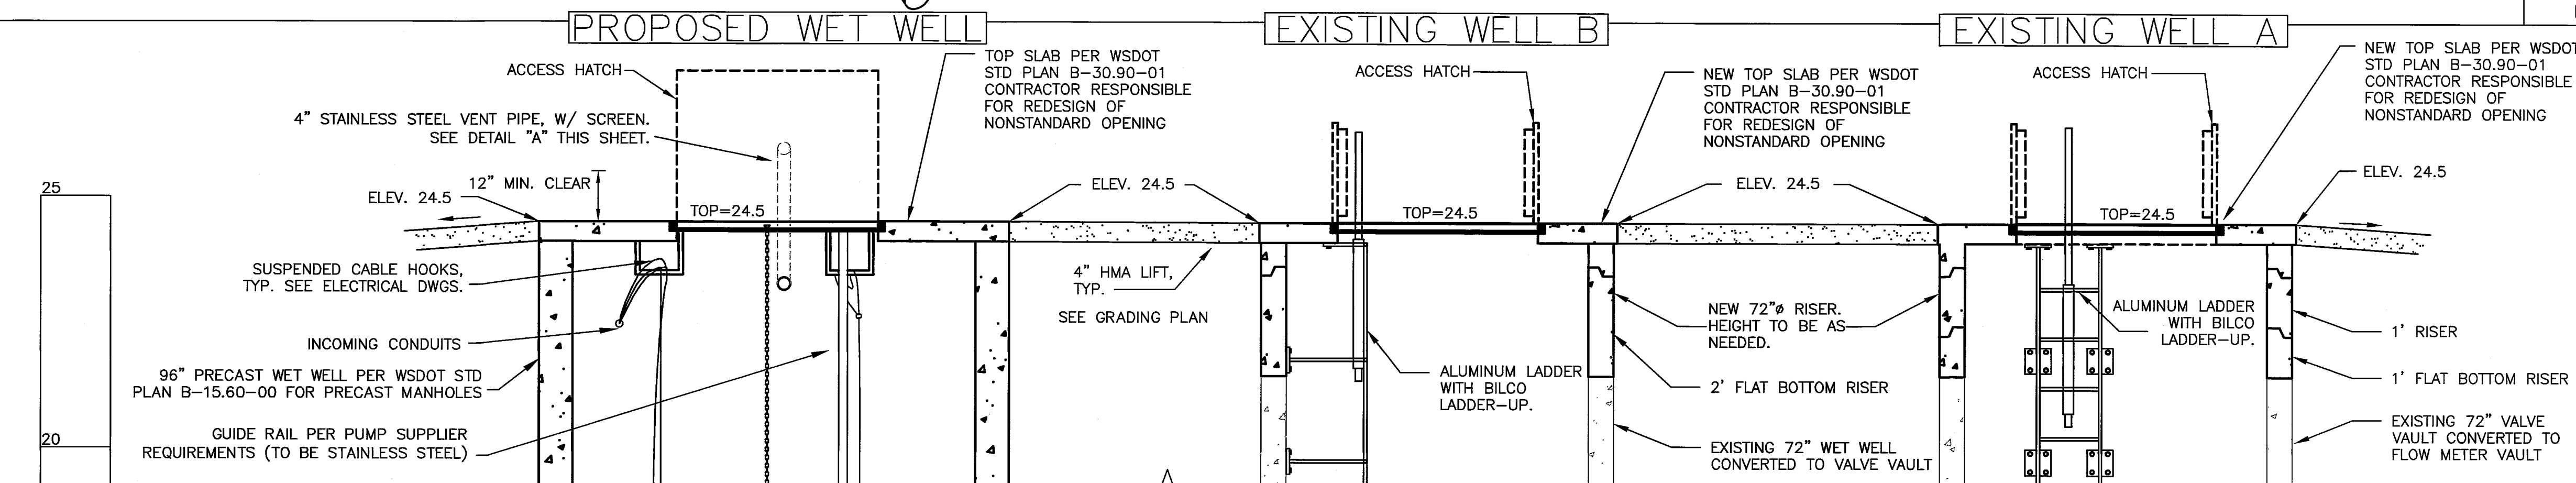

PUMP STATION SECTION VIEW

PUMP OPERATION LEVELS	
F1 = 7.50'	HWL ALARM AND REDUNDANT BOTH PUMPS ON
F2 = 6.50'	LAG PUMP ON
F3 = 6.00'	LEAD PUMP ON
F4 = 1.00'	PUMP(S) OFF
F5 = -0.50'	LWL ALARM AND REDUNDANT PUMP(S) OFF
T1 = 7.00'	HWL ALARM AND REDUNDANT BOTH PUMPS ON
T2 = 6.50'	PUMPS ON
T3 = 6.00'	LEAD PUMP ON
T4 = 1.00'	PUMP(S) OFF
T5 = 0.50'	LWL ALARM AND REDUNDANT PUMP(S) OFF
NOTES:	
"F"	= FLOAT CONTROL
"T"	= SUBMERSIBLE TRANSDUCER CONTROL (PLC CONTROL)
SINGLE PUMP DESIGN FLOW: 1250 GPM	

RECORD
DRAWINGS

WILSON ENGINEERING, LLC
805 DUPONT STREET
BELLINGHAM, WA 98225
(360) 733-6100 • FAX (360) 647-9061
www.wilsonengineering.com

Wilson
SURVEY/ENGINEERING

PROFESSIONAL ENGINEER
STATE OF WASHINGTON
NO. 36856
EXPIRATION DATE 12-31-16

DESIGNED BY JGC
DRAWN BY ROG
CHECKED BY CP


CITY OF FERDALE
WHATCOM COUNTY
WASHINGTON

PUMP STATION NO. 4
PROPOSED PLAN AND PROFILE LAYOUT


DATE 01/27/2016
SCALE AS SHOWN
JOB NUMBER 2013-037

SHEET C3.2
OF 22

00547.008 4/7/16 SH

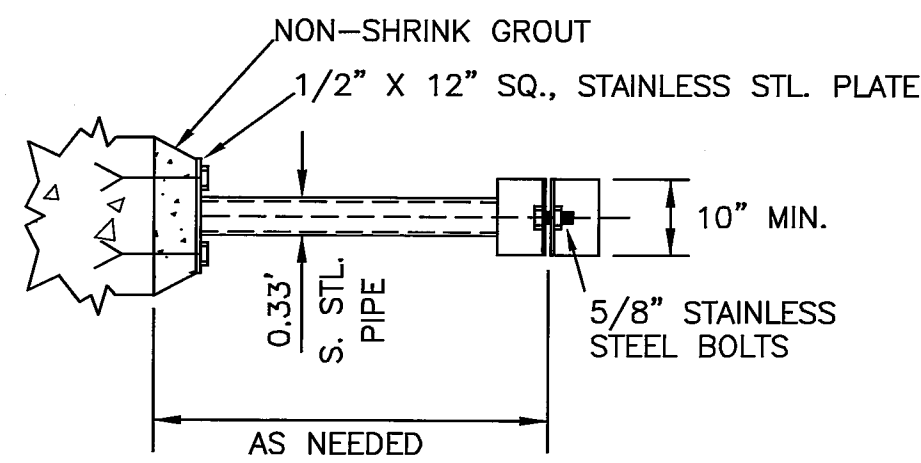

ELEVATION

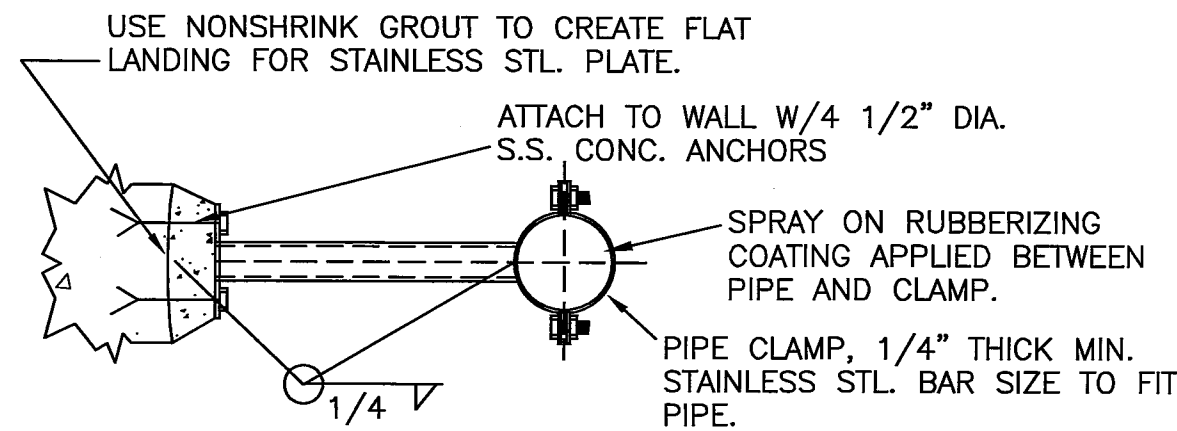


PLAN VIEW

A

VERTICAL PIPE BRACE

* NOT TO SCALE

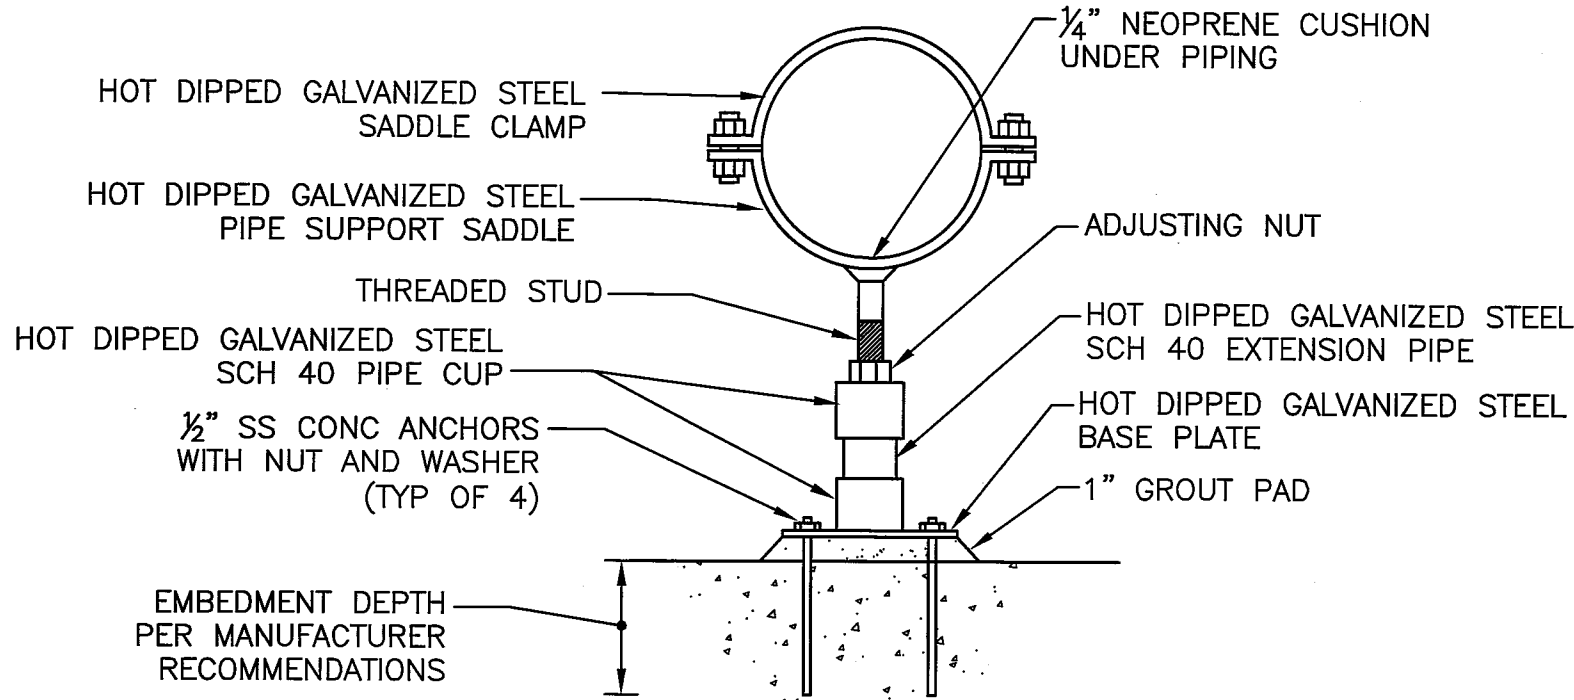


SADDLE SIZE	1/2"x2"
THREADED STUD	1"x6"
CUP ID	2 1/2"
1/4" BASE PLAT	6"x6"
EXTENSION PIPE DIA	2"

- NOTES:
- TO INSURE PROPER SUPPORT AND STABILITY, AFTER FINAL HEIGHT ADJUSTMENT IS ATTAINED, APPLY TACK WELDS TO BOTH SUPPORT CUPS AND EXTENSION PIPE. USE E70XX ELECTRODE FOR WELDS.
 - ALL PARTS TO BE STAINLESS STEEL.
 - FIELD PAINT AS SPECIFIED, PER 09900


B

PIPE SUPPORT DETAIL

* NOT TO SCALE

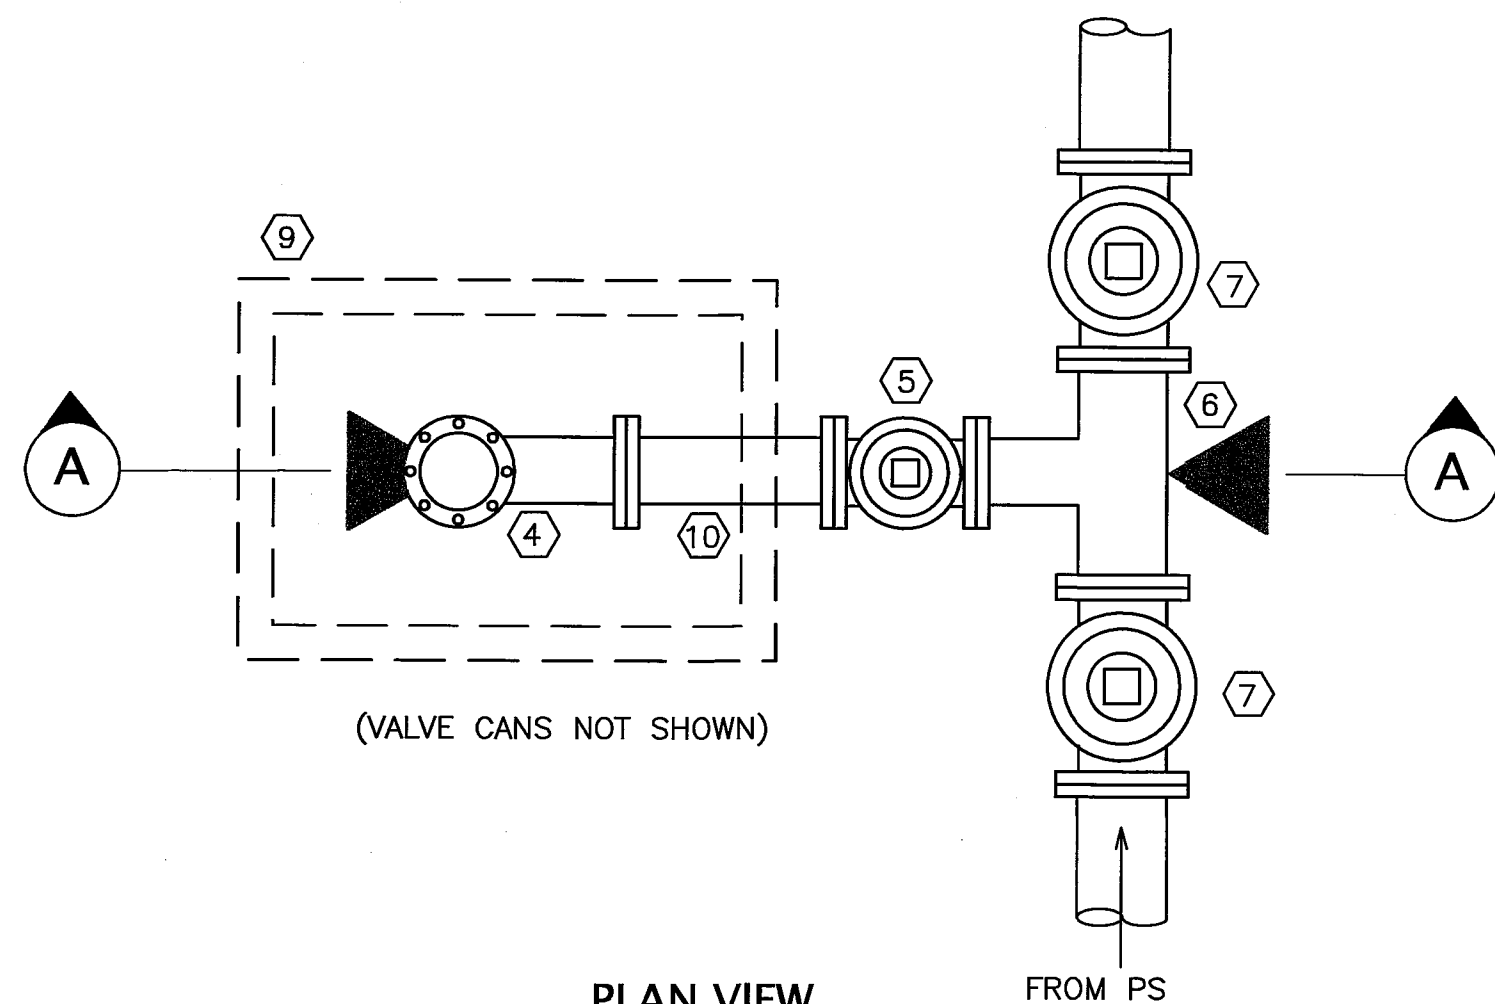

PLAN VIEW

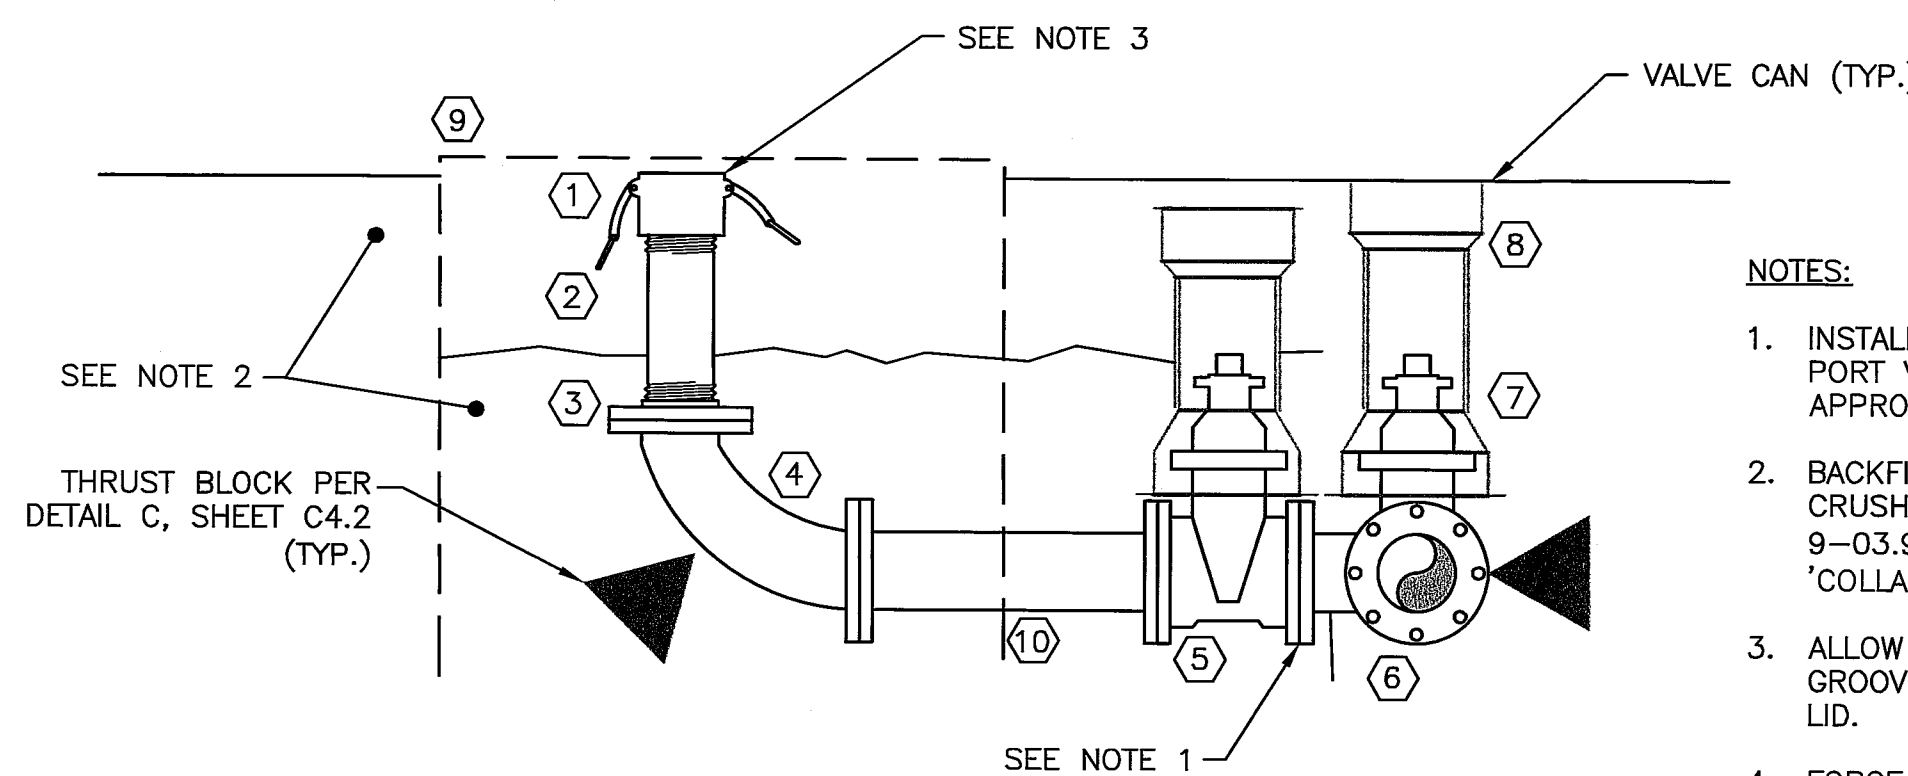

SECTION A-A

- 6-IN. STAINLESS STEEL FEMALE CAM & GROOVE BY 6-IN. FNPT ADAPTER
- 6-IN. DUCTILE IRON PIPE
- 6-IN. D.I. FLANGE TO 6-IN. FNPT ADAPTER (COMPANION FLANGE)
- 6-IN. D.I. LONG RADIUS BEND (FL)
- 6-IN. GATE VALVE (FL)
- D.I. TEE (FL) - SEE NOTE 4
- 8-IN. GATE VALVE (FLXMJ) - SEE NOTE 4
- CAST IRON VALVE BOX
- H2O LOADING CONCRETE METER BOX WITH CAST ITON LID. LID TO BE LOCKABLE WITH PAD LOCK
- 8" DI SPOOL (FXMJ)


- NOTES:
- INSTALL ADDITIONAL PIPING BETWEEN TEE AND PUMPING PORT VALVE AS REQUIRED TO INSTALL PORT IN LOCATION APPROVED BY ENGINEER.
 - BACKFILL IN AND AROUND METER BOX SHALL BE CRUSHED SURFACING TOP COURSE PER WSDOT 9-03.9(3). INSTALL MINIMUM 1 FOOT WIDE GRAVEL 'COLLAR' AROUND BOX.
 - ALLOW 4-IN. SPACE BETWEEN THE TOP OF THE CAM & GROOVE FITTING AND THE INSIDE OF THE METER BOX LID.
 - FORCE MAIN IS 8-IN. D.I. SNORKEL WILL REQUIRE AN 8x6 TEE AND TWO 8-IN. GATE VALVES (FLXMJ).

C

BYPASS PUMPING PORT ASSEMBLY

* NOT TO SCALE

RECORD
DRAWINGS

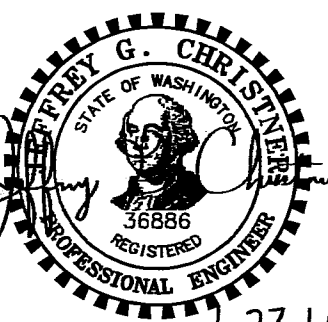

DESIGNED BY JGC
DRAWN BY ROG
CHECKED BY AWL



CITY OF FERNDALE
PUMP STATION NO. 4
DETAILS

DATE 01/27/2016
SCALE AS SHOWN
JOB NUMBER 2013-037

SHEET C4.1
OF 22

Wilson
SURVEY/ENGINEERING
WILSON ENGINEERING, LLC
805 DUPONT STREET
BELLINGHAM, WA 98225
(360) 733-6100 • FAX (360) 647-9061
www.wilsonengineering.com

00547.009 4/1/14 SH

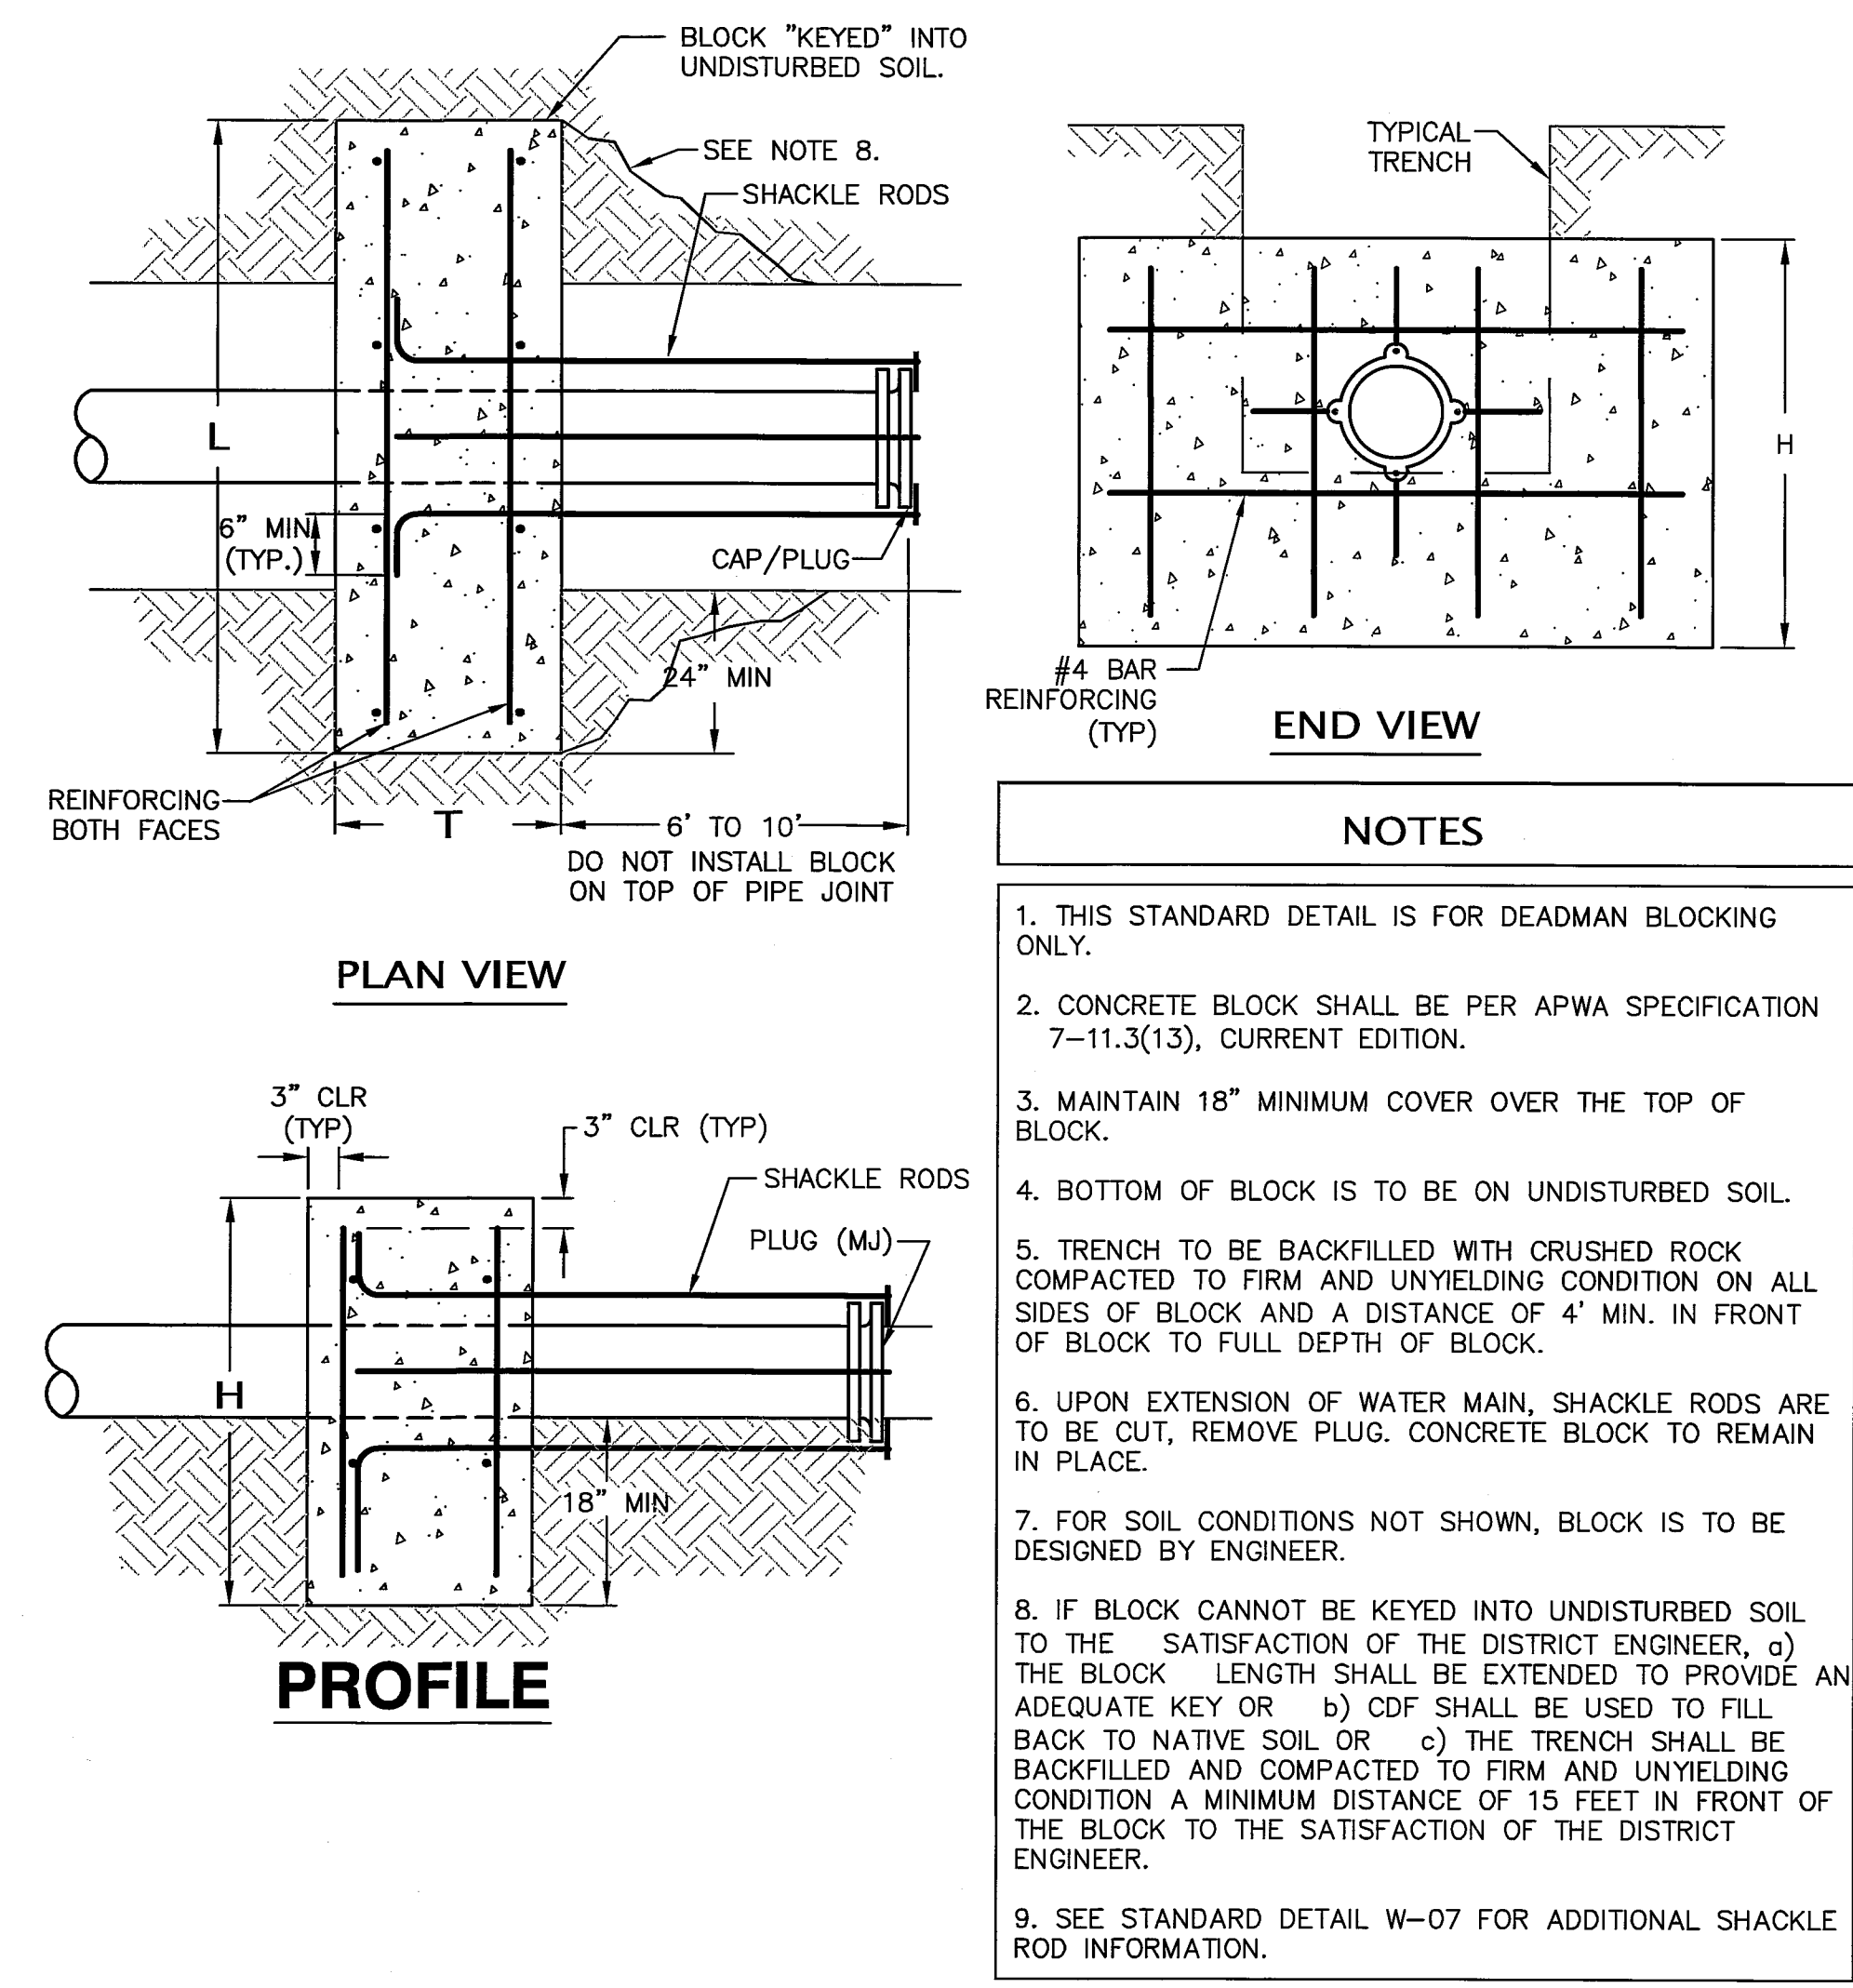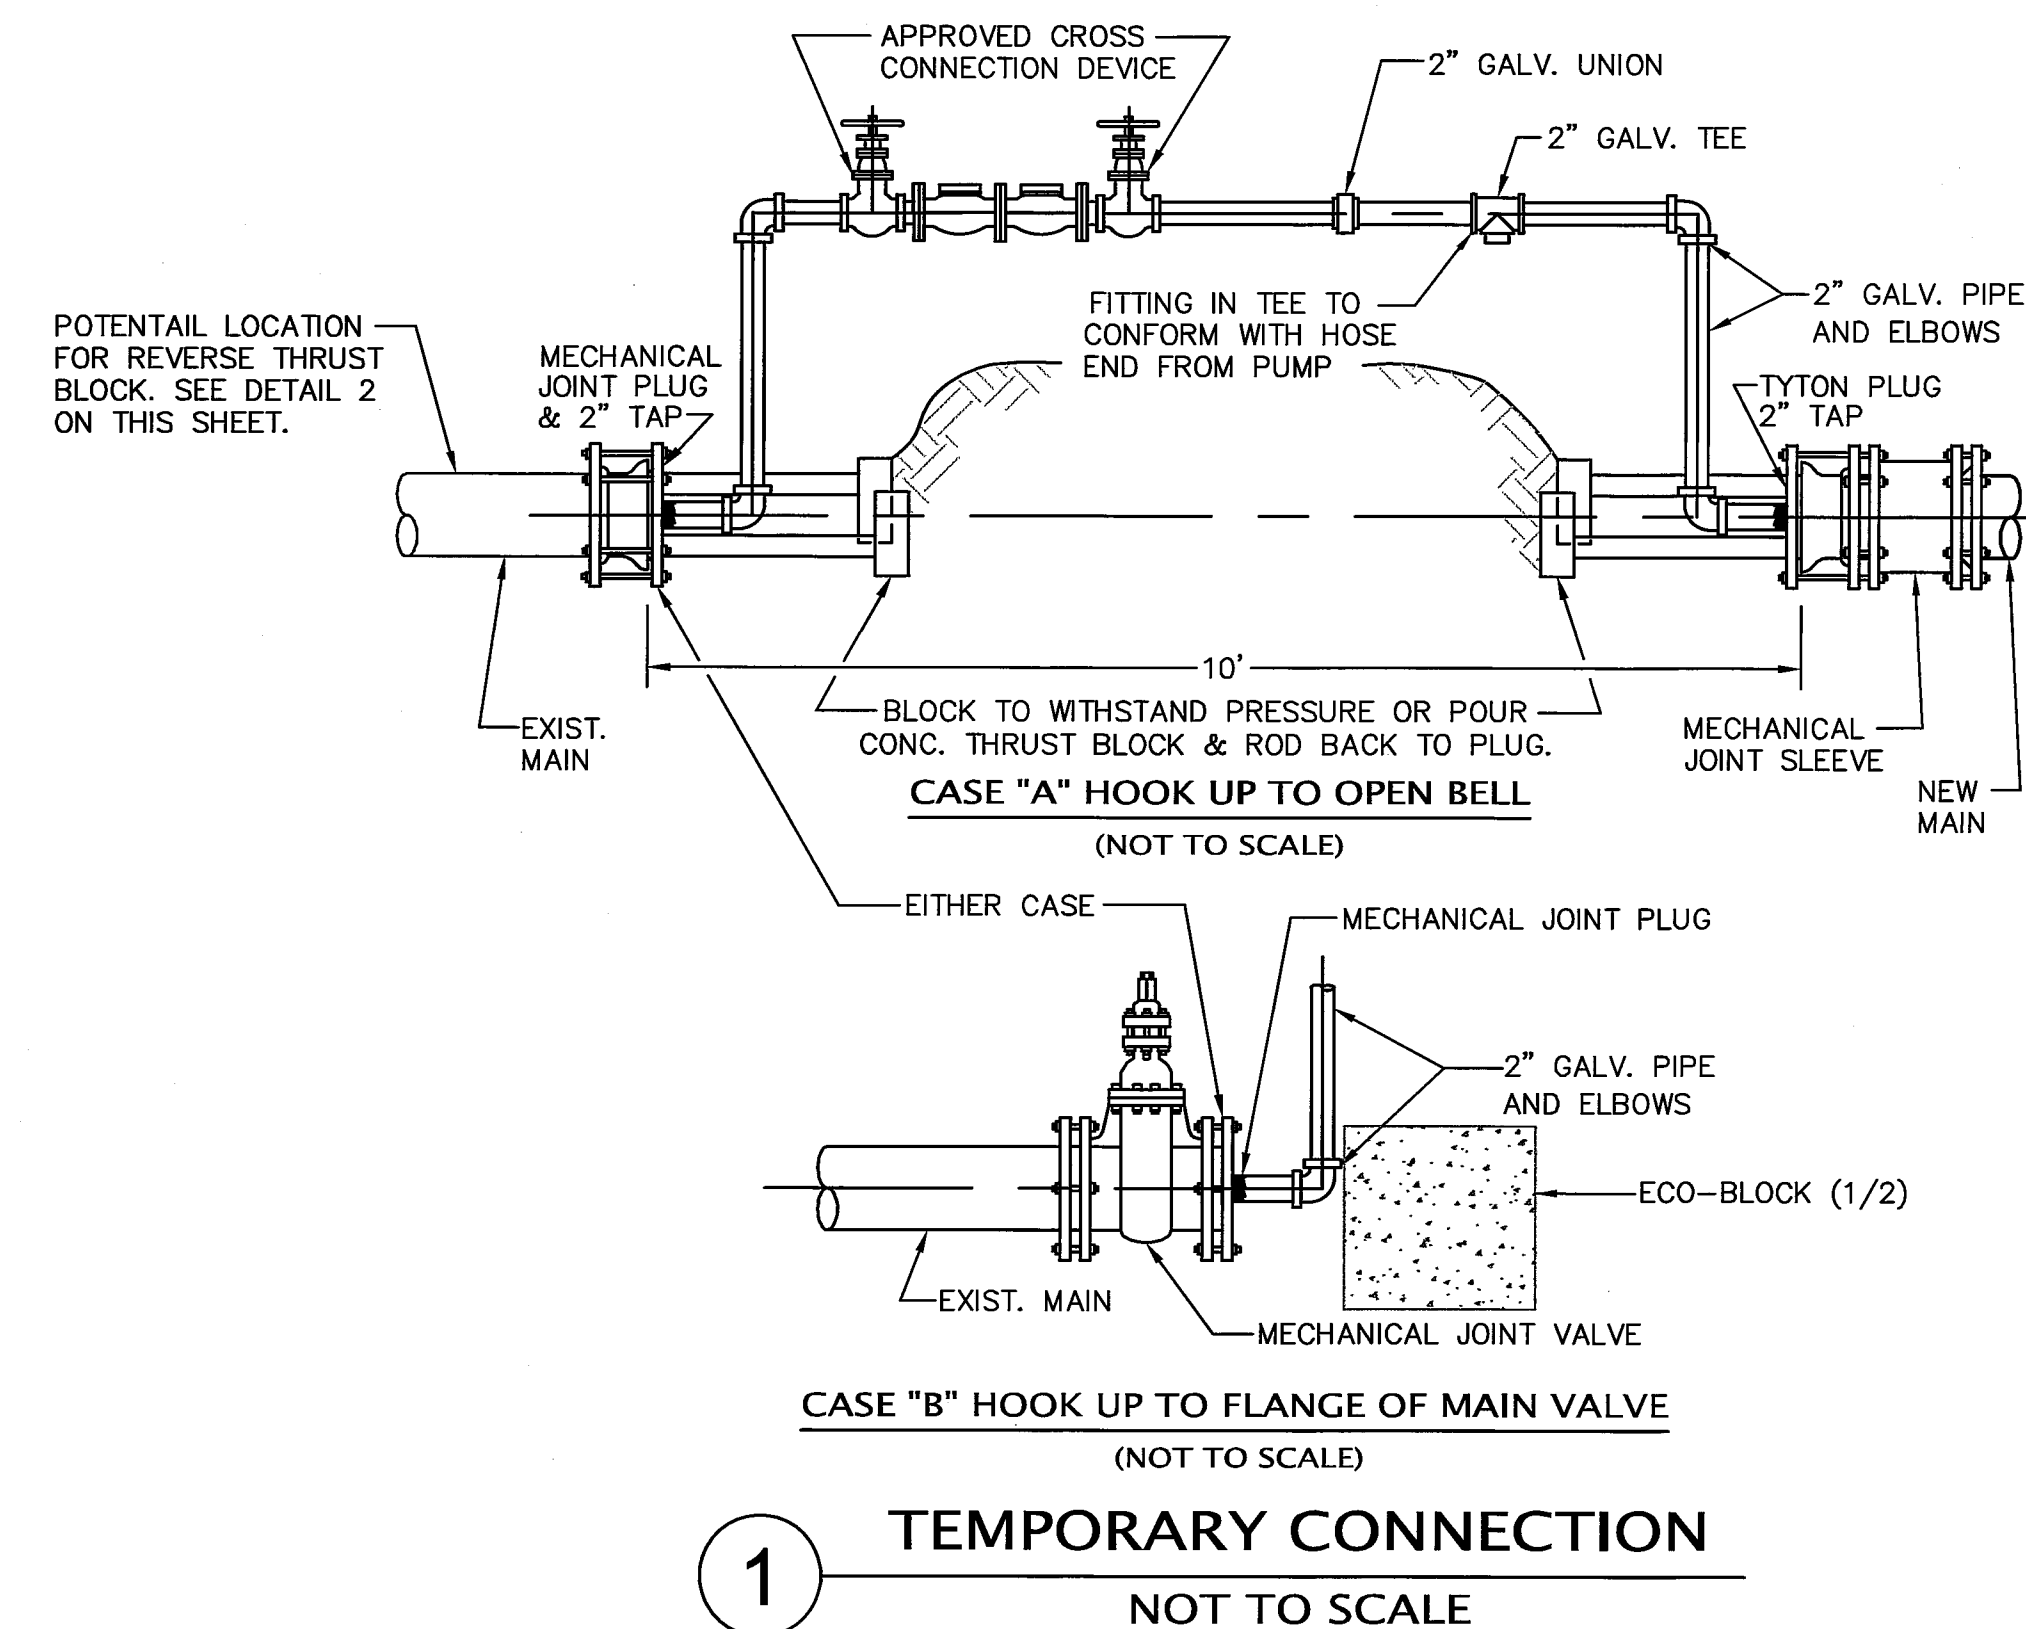

SIZING TABLE					MIN. BLOCK LENGTH (L)						
PIPE DIA	T (min)	H (min)	SHACKLE RODS	REINFORCING	SOIL CONDITION						
6"	18"	36"	(4) 5/8" dia	#4 @ 10" OC EW	PIPE Ø	SOFT CLAY	SILT	SANDY SILT	SAND	SANDY CLAY	HARD CLAY
8"	18"	42"	(4) 3/4" dia	#4 @ 12" OC EW	6"	84"	72"	72"	72"	72"	72"
10"	24"	52"	(6) 3/4" dia	#4 @ 12" OC EW	8"	108"	84"	75"	75"	75"	75"
12"	24"	54"	(6) 7/8" or (8) 3/4" dia	#4 @ 8" OC EW	10"	132"	104"	77"	77"	77"	77"
14"	24"	56"	(8) 7/8" or (10) 3/4" dia	#4 @ 6" OC EW	12"	180"	138"	82"	80"	80"	80"
16"	30"	58"	(10) 7/8" dia	#4 @ 5" OC EW	14"	228"	174"	102"	82"	82"	82"
					16"	288"	216"	126"	100"	84"	84"


BLOCK SIZES GOOD TO MAXIMUM 300psi TEST PRESSURE

2 REVERSE THRUST BLOCK DETAIL
NOT TO SCALE

RECORD
DRAWINGS

NO.	REVISIONS	BY	DATE
0	RECORD DRAWINGS	JGC	01/27/15

WILSON ENGINEERING, LLC
805 DUPONT STREET
BELLINGHAM, WA 98225
(360) 733-6100 • FAX (360) 647-9061
www.wilsonengineering.com

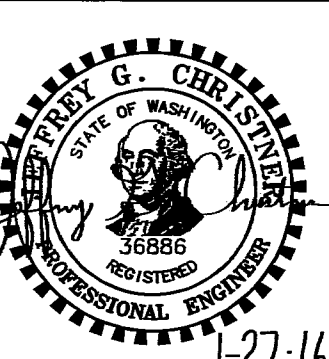


DESIGNED BY	JGC	DRAWN BY	ROG	CHECKED BY	CJP
-------------	-----	----------	-----	------------	-----

CITY OF FERNDALE
PUMP STATION NO. 4 ADDENDUM No. 1
WATER MAIN CONNECTION DETAILS

DATE	01/27/2016	SCALE	AS SHOWN	JOB NUMBER	2013-037
------	------------	-------	----------	------------	----------

SHEET
C4.1A
OF
22


00547.010 4/17/16 SH

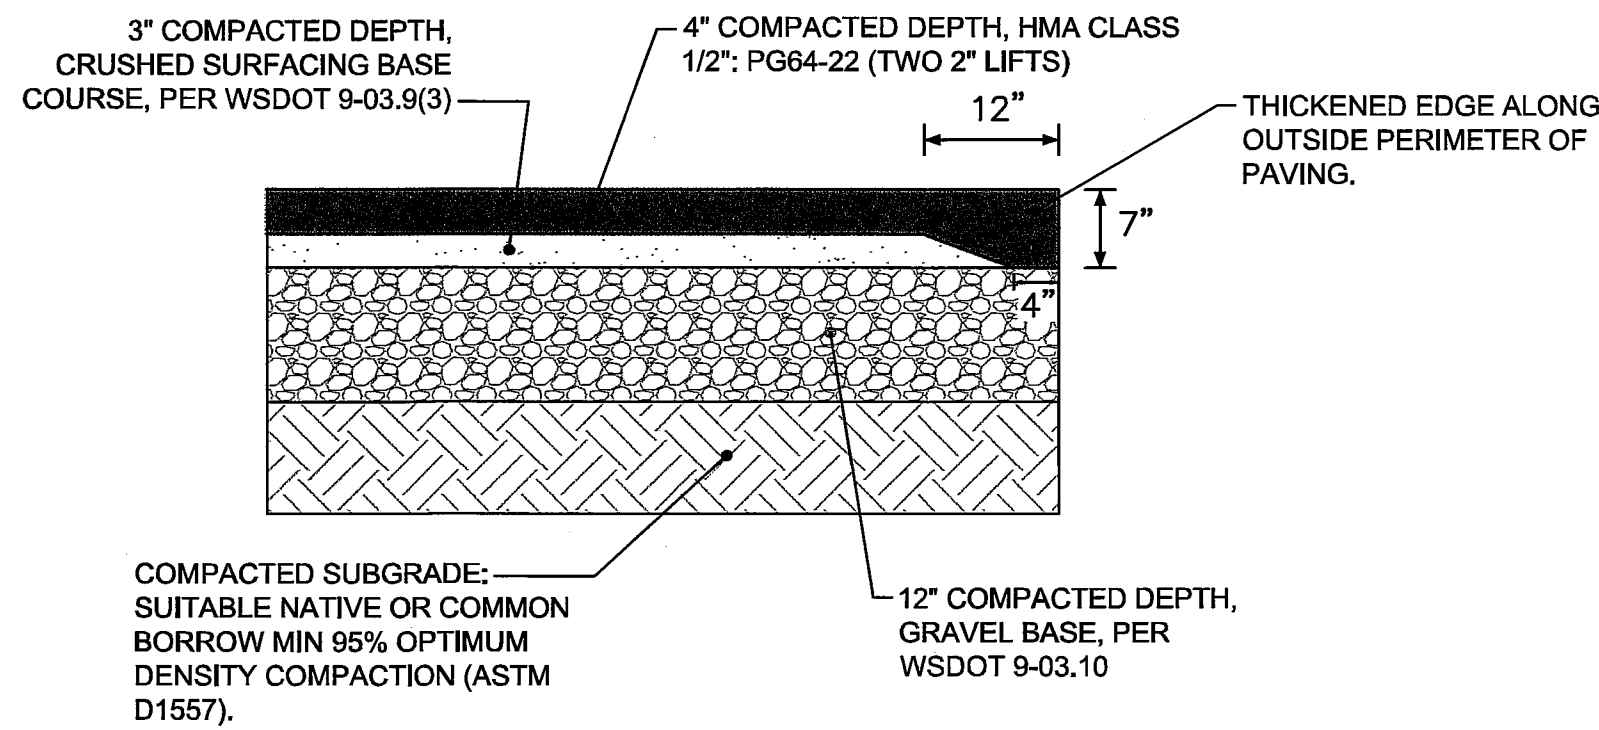

STANDARD ASPHALT SECTION


**TYPICAL ASPHALT
CONCRETE PAVEMENT SECTION**

A
* NOT TO SCALE

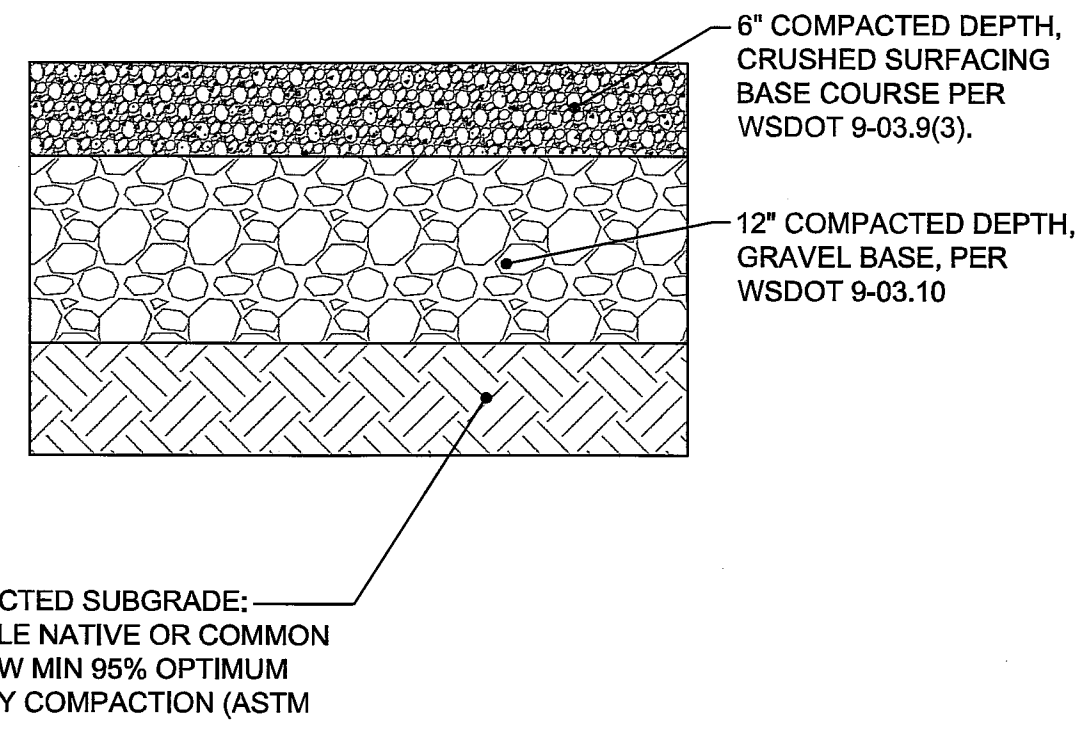


TYPICAL GRAVEL ACCESS SECTION

B
* NOT TO SCALE

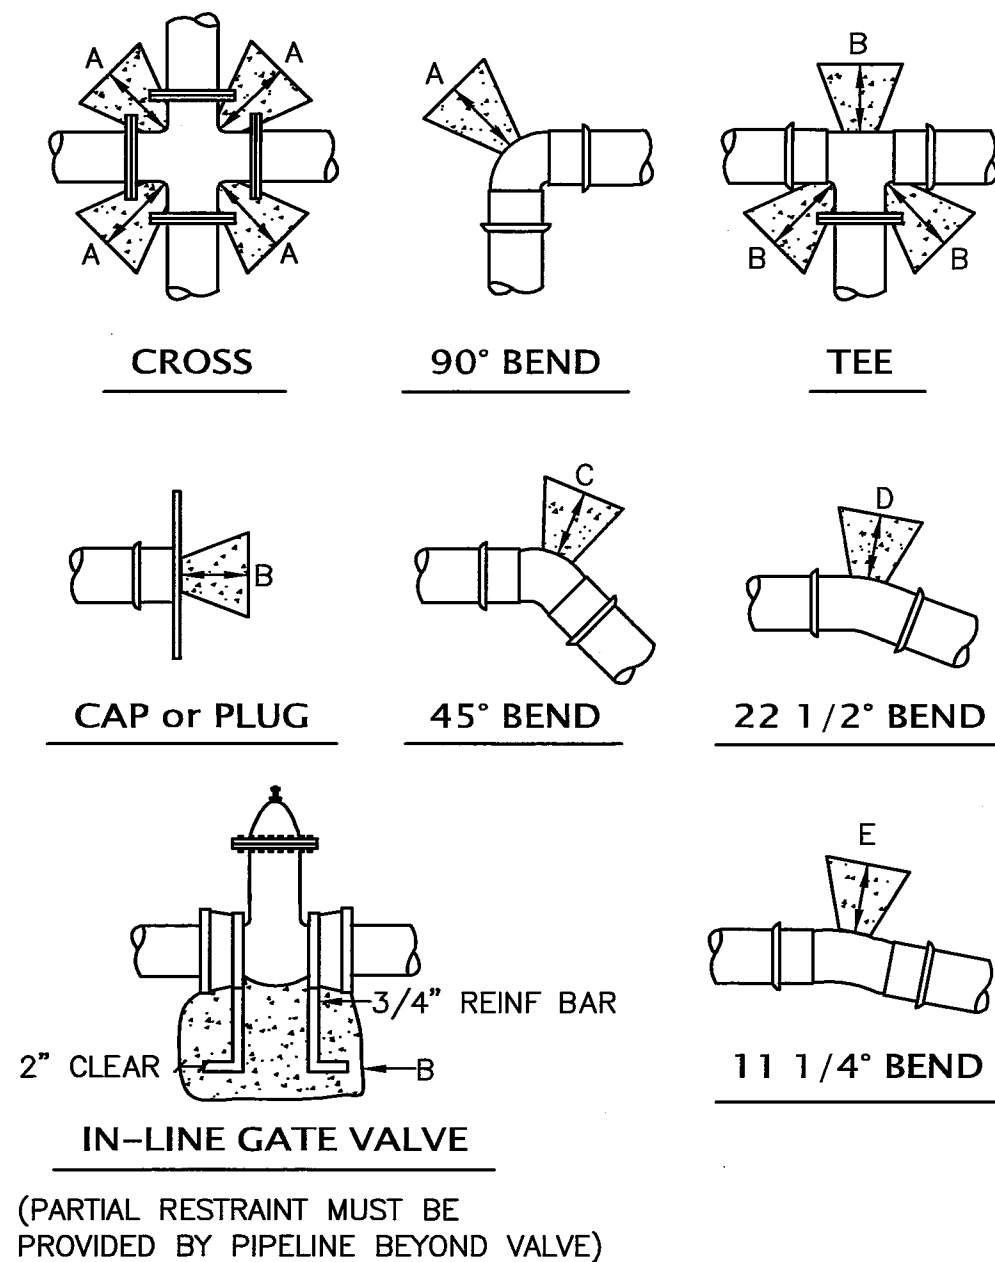

THRUST BLOCK TABLE					
MINIMUM BEARING AREA AGAINST UNDISTURBED SOIL IN SQUARE FEET					
PIPE SIZE	A	B	C	D	E
4"	2	2	2	2	2
6"	4	3	2	2	2
8"	7	5	4	2	2
10"	11	8	6	3	2
12"	16	12	9	5	3
16"	29	20	16	8	4
20"	45	32	24	13	6

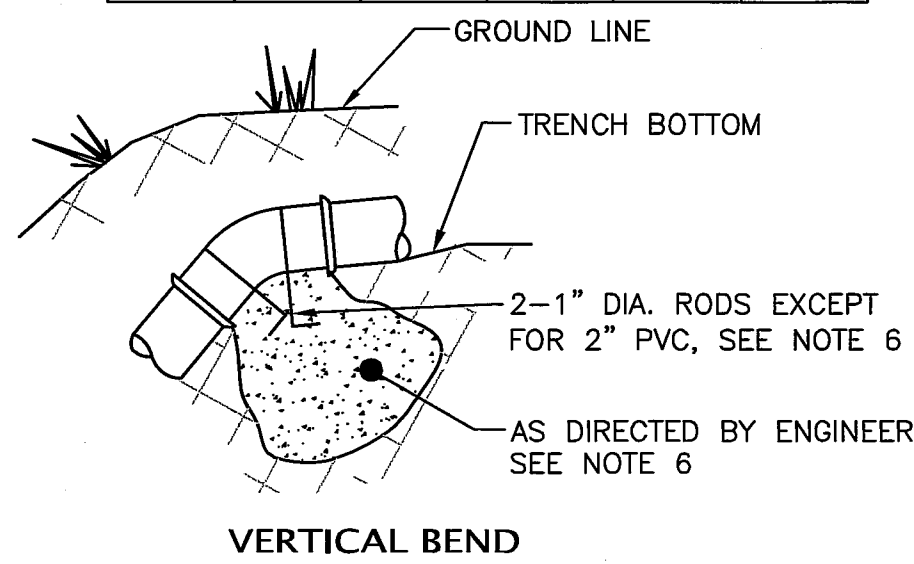


- NOTES**
1. SQUARE FEET OF CONCRETE THRUST BLOCK AREA IS BASED ON 200 P.S.I. INTERNAL PRESSURE, A SOIL SAFE BEARING OF 3000 POUNDS PER SQUARE FOOT AND A FACTOR OF SAFETY OF 1.5.
 2. BEARING AREA MUST BE ADJUSTED FOR INTERNAL PRESSURES AND LOWER SOIL BEARING VALUES.
 3. CONCRETE BLOCKING SHALL BE CAST IN PLACE AND HAVE A MINIMUM OF 1/4 SQUARE FOOT BEARING AGAINST THE FITTING.
 4. BLOCK SHALL BEAR AGAINST FITTINGS ONLY AND SHALL BE CLEAR OF JOINTS TO PERMIT TAKING UP OR DISMANTLING JOINT.

5. THE CONTRACTOR SHALL INSTALL BLOCKING WHICH IS ADEQUATE TO WITHSTAND FULL TEST PRESSURE AS WELL AS TO CONTINUOUSLY WITHSTAND OPERATING PRESSURE UNDER ALL CONDITIONS OF SERVICE.
6. STAINLESS STEEL BANDING SHALL BE USED AT 2" PVC VERTICAL BENDS INSTEAD OF 1" RODS. CONTACT ENGINEER FOR SIZING OF THRUST BLOCK AND DETAILS.
7. ALL BENDS, TEES & CROSSES SHALL INCLUDE RESTRAINED JOINTS (ROMAC GRIPPER) AS WELL AS THRUST BLOCKING.

C WATERLINE AND FORCEMAIN THRUST BLOCKING SCHEDULE

* NOT TO SCALE

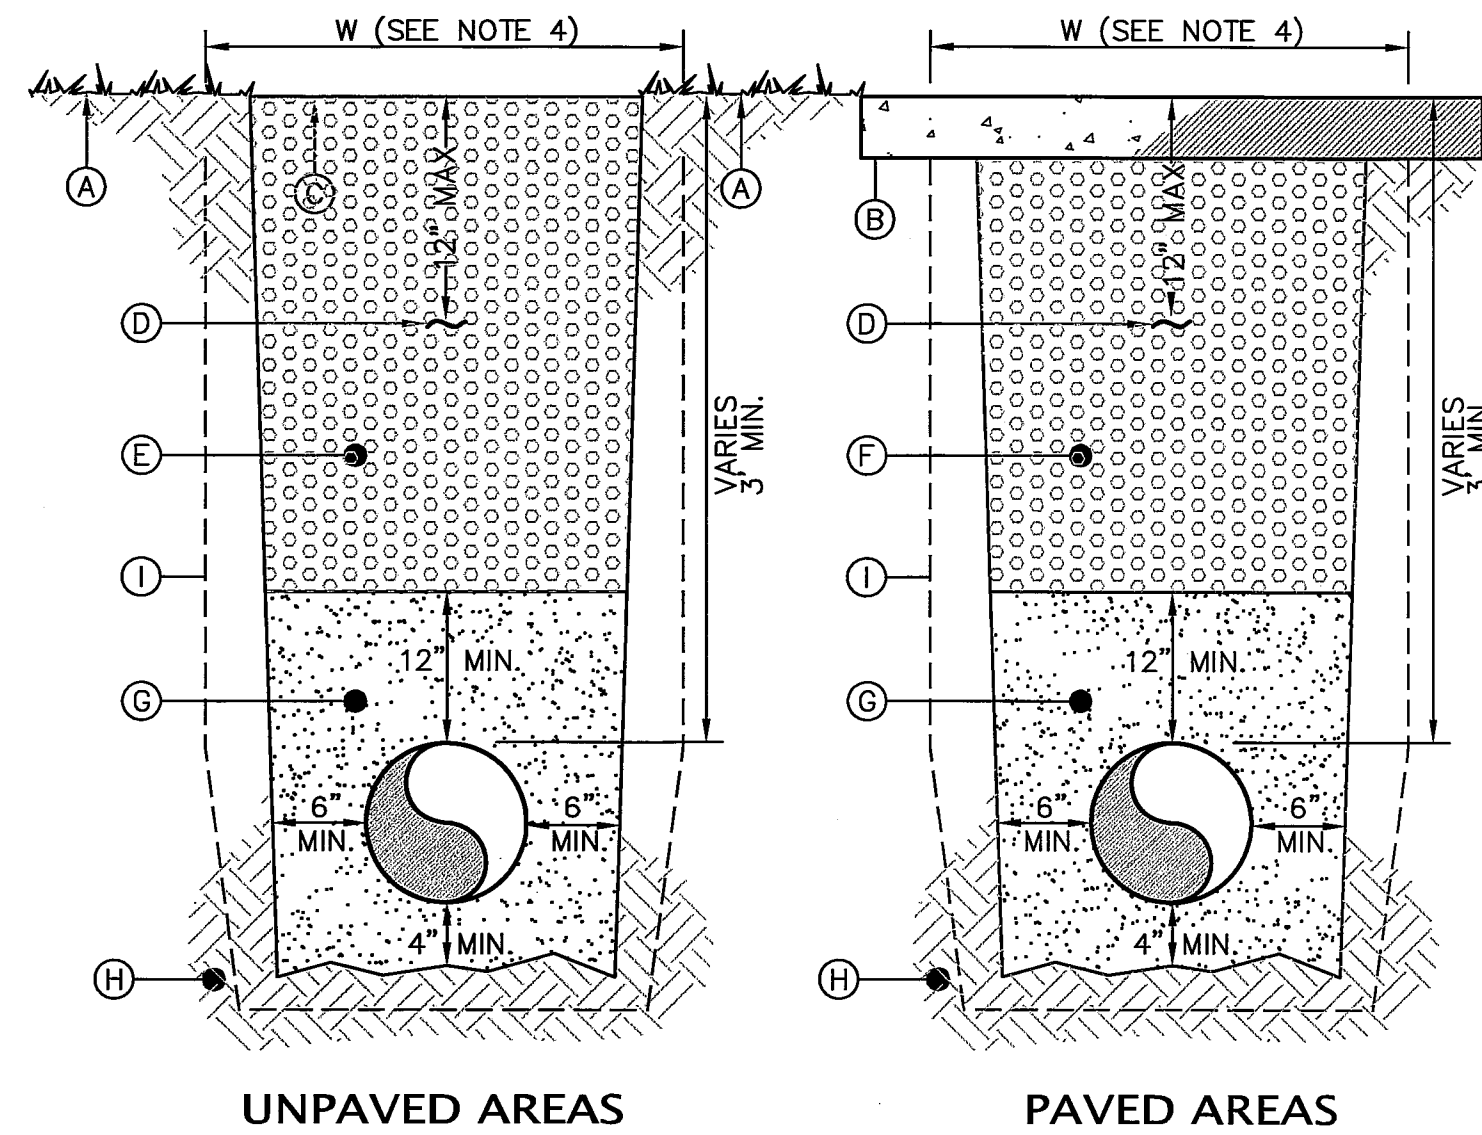

UNPAVED AREAS

PAVED AREAS

- TRENCH NOTES:**
- A. HYDROSEED EXPOSED AREAS.
 - B. NEW SIDEWALK OR PAVEMENT
 - C. NEW LANDSCAPED SURFACE.
 - D. 2" METALLIC DETECTOR TAPE 8" TO 12" BELOW FINISH GRADE.
 - E. BANK RUN GRAVEL BACKFILL PER WSDOT 9-03.19 COMPACTED TO 90% MAX. DENSITY INSIDE RIGHT-OF-WAY. NATIVE BACKFILL MATERIAL (8" MAX.) COMPACTED TO 90% MAX. DENSITY PERMITTED OUTSIDE OF RIGHT-OF-WAY.
 - F. BANK RUN GRAVEL BACKFILL PER WSDOT 9-03.19 COMPACTED TO 95% MAX. DENSITY
 - G. PIPE ZONE GRAVEL BEDDING PER WSDOT 9-03.12(3) COMPACTED TO 95% MAX. DENSITY
 - H. UNDISTURBED NATIVE MATERIAL
 - I. ROCK EXCAVATION PAY LIMITS PER WSDOT STANDARD SPECIFICATIONS.

- FLEXIBLE PIPE NOTES:**
- 1) PROVIDE UNIFORM SUPPORT UNDER BARRELS.
 - 2) HAND TAMP UNDER HAUNCHES.
 - 3) COMPACT BEDDING MATERIAL TO 95% MAX. DENSITY; DIRECTLY OVER PIPE, HAND TAMP ONLY.
 - 4) SEE "EXCAVATION AND PREPARATION OF TRENCH" IN SANITARY SEWERS SECTION OF THE STANDARD WSDOT/APWA SPECIFICATIONS FOR TRENCH WIDTH "W" AND TRENCHING OPTIONS. THE PIPE ZONE WILL BE THE ACTUAL TRENCH WIDTH. THE MINIMUM CONCRETE WIDTH SHALL BE 1-1/2 I.D. + 18".
 - 5) ROCKS OR LUMPS LARGER THAN 1" PER FOOT OF PIPE DIAMETER SHALL NOT BE USED IN THE BACKFILL MATERIAL.
 - 6) SEE "BEDDING MATERIAL FOR FLEXIBLE PIPE" IN AGGREGATES SECTION OF THE WSDOT/APWA STANDARD SPECIFICATIONS FOR THE MATERIAL SPECIFICATIONS.

D TYPICAL PIPE TRENCHING & BACKFILL

* NOT TO SCALE

RECORD
DRAWINGS

NO.

REVISIONS

BY

DATE

0

RECORD DRAWINGS

JGC

01/27/15

WILSON ENGINEERING, LLC

805 DUPONT STREET

BELLINGHAM, WA 98225

(360) 733-6100 • FAX (360) 647-9061

www.wilsonengineering.com

Wilson

SURVEY/ENGINEERING

DESIGNED BY

JCC

DRAWN BY

ROG

CHECKED BY

AWL

CITY OF FERNDALE

WHATCOM COUNTY

WASHINGTON

PUMP STATION NO. 4

DETAILS

DATE

01/27/2016

SCALE

AS SHOWN

JOB NUMBER

2013-037


SHEET

C4.2

OF

22

AS 11/16 4/7/16 ST

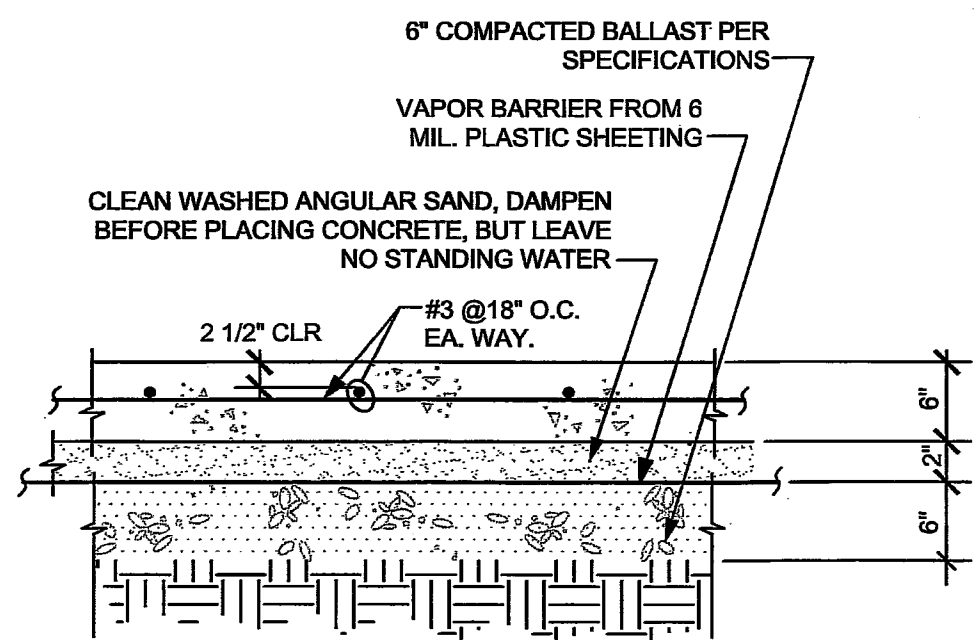

NOTES:
1. PLACE SLAB ON FIRM BEARING MATERIAL.
2. OMIT VAPOR BARRIER AT SIMILAR OUTDOOR SLABS.

A
S4.0

Concrete Pad for Generator

Scale: N.T.S.

STRUCTURAL NOTES

BUILDING CODE CRITERIA

- All construction is to be in accordance with the minimum provisions of the 2009 International Building Code (IBC). Where these plans and specifications do not state specifically otherwise the provisions of the UBC shall apply.
- These drawings show the design of a foundation for a pre-manufactured metal building, as well as basic design criteria for which the metal building shall be designed. Wilson Engineering is not responsible for the design of the metal building. The manufacturer shall have on staff or retain a Professional Engineer for the design of the building itself. The design shall be based on the loads given below.
- Design Roof (Snow) Load: 25 PSF
- Lateral Loads:

Seismic Loading	Wind Loading (3 s gust)
Site Class D	Basic Wind Speed 90 MPH
S ds 1.14	Exposure C
S d1 0.33	Kzt (ASCE 7-10) 1.1
Importance Factor	1.5
- Special Inspections
No Special Inspections are required for this project. Footing concrete requires $f'c \leq 2500$ psi for structure; higher strengths have been specified for other reasons. Special inspection is not required.
- Structural Observation
The Structural Engineer of record will perform Structural Observations as defined by the IBC, if required.

01000 GENERAL

- Employ good standards of workmanship throughout. Provide all materials and perform all construction as indicated. Secure architect's approval for substitutions.
- See specifications for detailed material and methods. In case of conflict between applicable codes, these notes, and the drawings, the more stringent will govern.
- Verify all dimensions in the field, and upon discovery of any discrepancies between the drawings and/or field conditions notify Wilson Engineering.
- Use these drawings in conjunction with the architectural and other drawings. They are not to stand alone. These drawings and the designs herein are copyrighted by Wilson Engineering, and are for use on this project only. They may not be copied or used for any other project or purpose other than as originally intended without written approval from Wilson Engineering.
- Do not scale drawings.
- Use typical details and schedules wherever applicable.
- The drawings do not indicate the method of construction. The contractor is solely responsible for design and supply of all erection bracing and shoring, and for safety programs, methods, and procedures of operation for the construction of the design shown on these drawings.

02220 FOUNDATIONS & EARTHWORK

- Spread footings are designed for a maximum total pressure of 1500 PSF.
- Remove all topsoil and organic material from building area, including exterior slabs and walks attached to building.
- Place footings against firm, undisturbed bearing soil or approved fill, as identified in soils report prepared by GeoTest Services Inc., June 19, 2013.

03150 CONCRETE ACCESSORIES & HARDWARE

- Adhesive-installed anchor bolts shall be steel of a grade appropriate to the application, with epoxy or polymer resin adhesive of consistency appropriate to the application. Anchors shall have a current ICC-ES report stating that they are approved for use in cracked concrete.
Accepted products include:
 - Simpson Strong-Tie IXP anchor with Set-XP adhesive
 - Hilti HAS threaded rods with Hilti HIT-RE 500-SD system adhesive
- Expansion anchor-bolts shall be steel wedge-type bolts, with hold diameter equal to bolt diameter. Dry location bolts shall be cad-plated; bolts in exterior locations and wet locations shall be stainless steel. Anchors shall have a current ICC-ES report stating that they are approved for use in cracked concrete. Accepted products include:
 - Simpson "Strong-Bolt"
 - Hilti "HSL-3"
 - ITW Red Head "Tru-Bolt+" Seismic Wedge

- Expansion or epoxy anchor bolts shall have minimum embedment of 12 bolt diameters, unless noted otherwise on drawings. The hole diameter and preparation shall be per manufacturer's instructions; thoroughly clean holes before installing bolts.
- Cast-in-place anchor bolts set in concrete or masonry shall conform to ASTM F1554-07 Grade 36, with Supplement S1 and shall be either headed steel bolts with rolled or cut threads and a standard washer, or threaded steel rod with a standard nut and washer at the embedded end. Do not use "J" bolts without nuts and washer at the embedded end.
- Embedment (to the closest face of the washer) for cast-in-place anchors shall not be less than 7 inches.
- For further information regarding anchors at building column base plates, consult the metal building manufacturer.

03300 REINFORCED CONCRETE


- Reinforcing shall be ASTM A615, Gr. 60, except that #3 bars may be Gr. 40. Welded Wire Fabric: Do not use WWF in slabs, use rebar per details
- Bar detailing not shown otherwise, and support of reinforcing bars shall conform to the CRSI Manual of Standard Practice. Reinforcing which is marked "continuous" shall extend as far as possible in the concrete and terminate in a 12-diameter bend or per typical corner details, as appropriate. Shop fabricate all bends. Lap all continuous bars 48 dia., wire tie all lap splices. Welding of reinforcing is not permitted.
- Concrete Materials:
Stone aggregate per ASTM C33, ASTM C150 Type Type I or II Cement
Use ASTM C260 air entraining admixture for outdoor exposure conditions
Water-reducing ASTM C494 Type A is permitted
All concrete shall be ready-mix. Comply with requirements of ASTM C 94.
Concrete 28 day strengths and other properties shall be as follows:

Applications	$f'c$ (max)	w/c (max)	aggregate Content (psi)	Air Content (%)
Slabs and Footings	3500	0.45	3/4"	6.0 % \pm 1.5 %
- Hold all bolts, anchors, dowels, reinforcing bars and metal inserts firmly and accurately in place before concrete is poured; do not insert ("stab") after pouring concrete.
- See architectural drawings for all slab finish details, exact location of depressed slab areas, threshold requirements, floor drains, and slopes.
Walkways and sidewalks are not shown on the structural drawings; see architectural drawings for locations, dimensions, finishes, and elevations. Reinforce per typical details, these drawings.

RECORD
DRAWINGS

WILSON ENGINEERING, LLC
805 DUPONT STREET
BELLINGHAM, WA 98225
(360) 733-6100 • FAX (360) 647-9081
www.wilsonengineering.com

Wilson
SURVEY / ENGINEERING

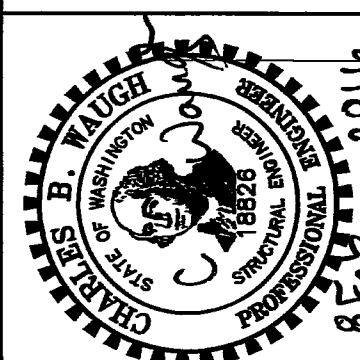

DESIGNED BY
CBW
DRAWN BY
SJW
CHECKED BY
JCC

CITY OF FERNDALE

WHATCOM COUNTY








WASHINGTON

PUMP STATION NO. 4
TYPICAL DETAILS

DATE
1/27/16
SCALE
AS SHOWN
JOB NUMBER
2013-037

SHEET
S1.1
OF
22

00547.012 4/7/16 SH

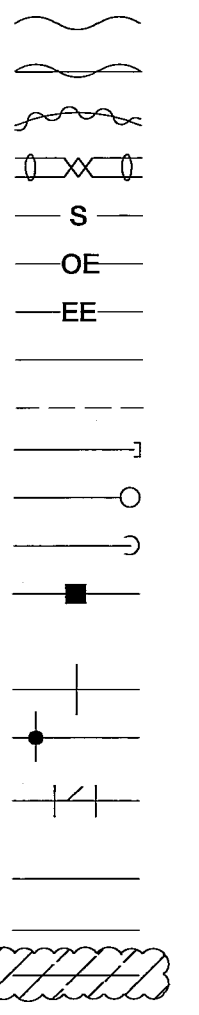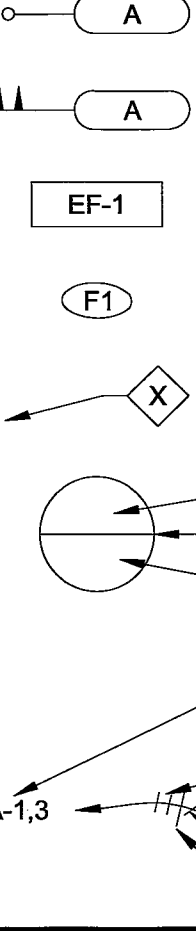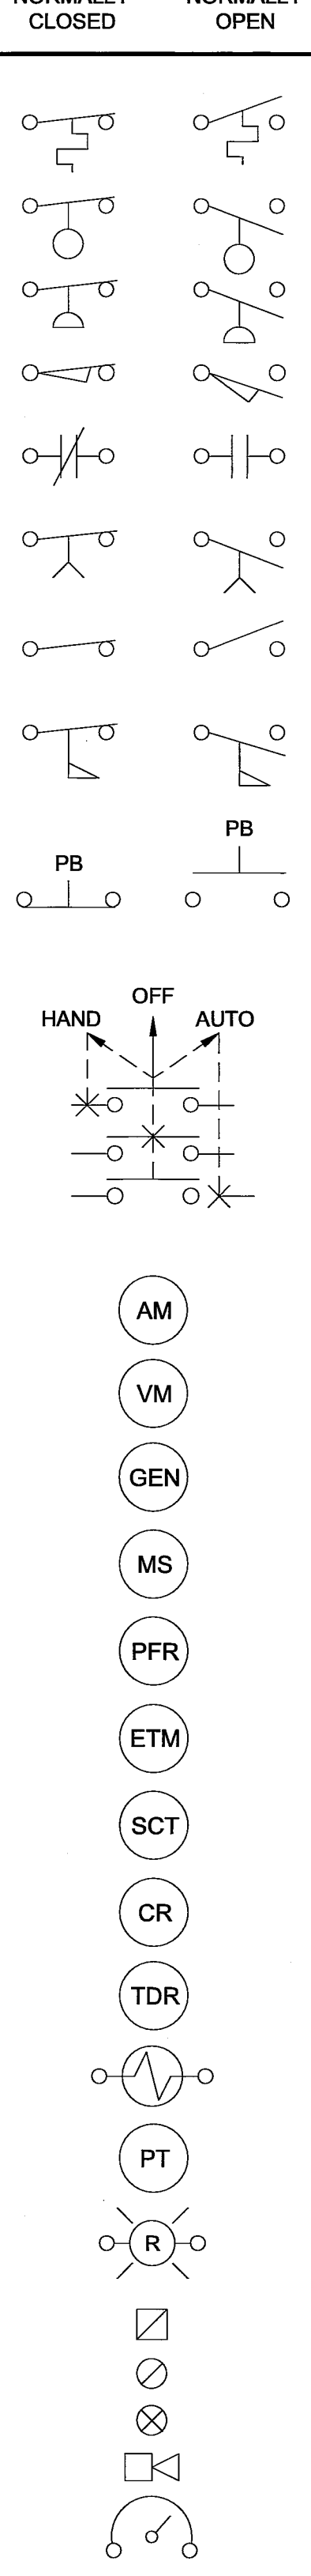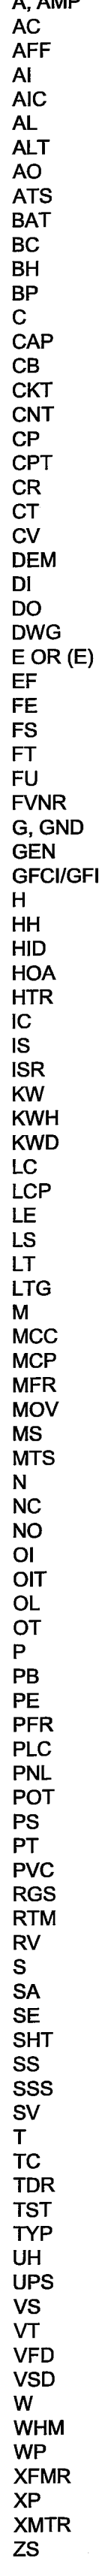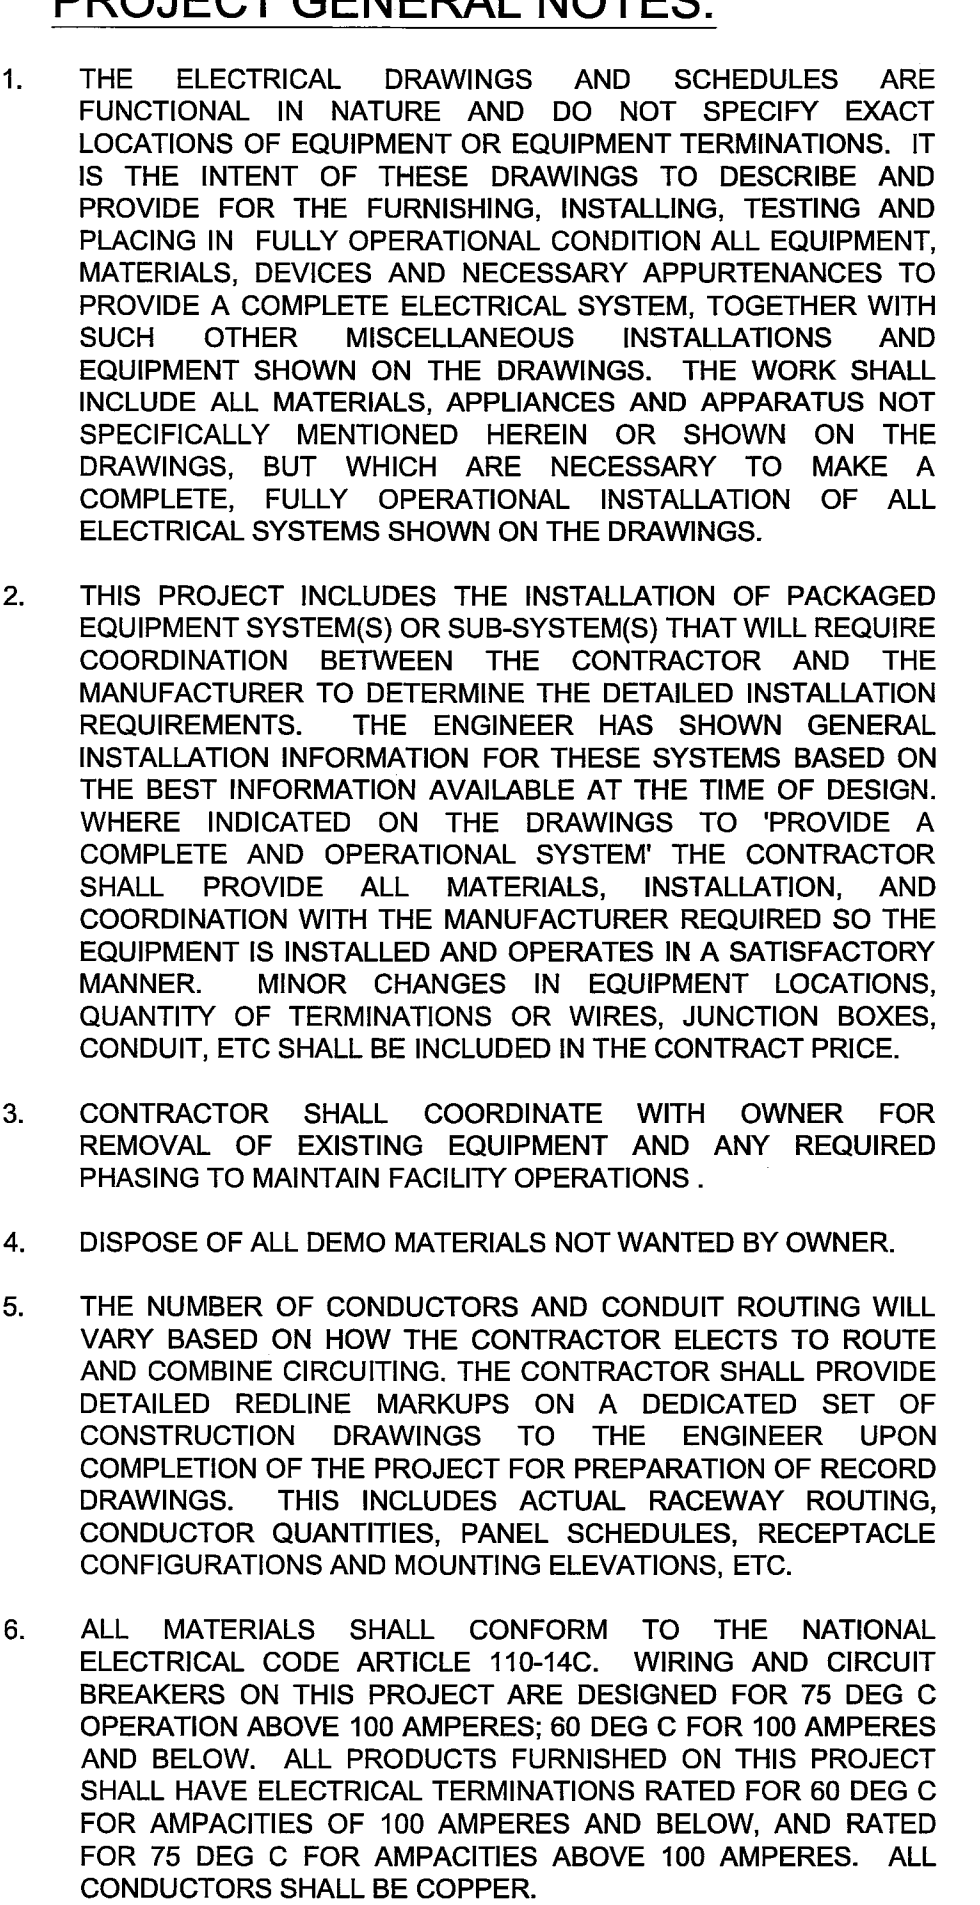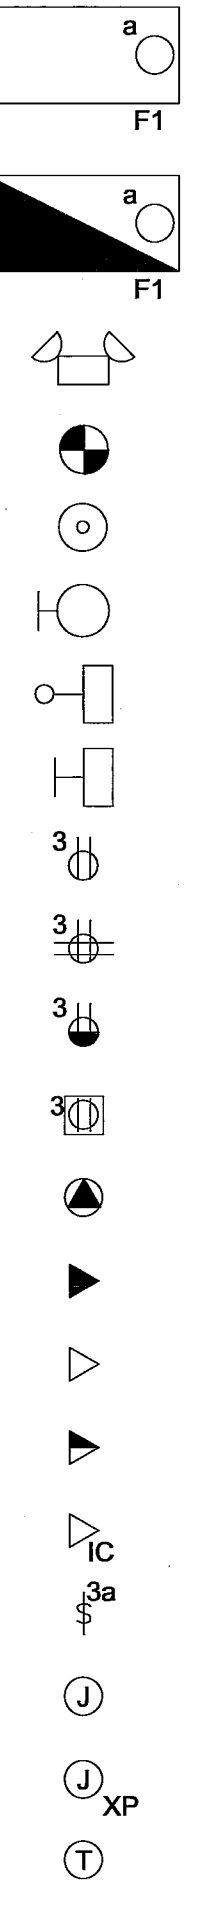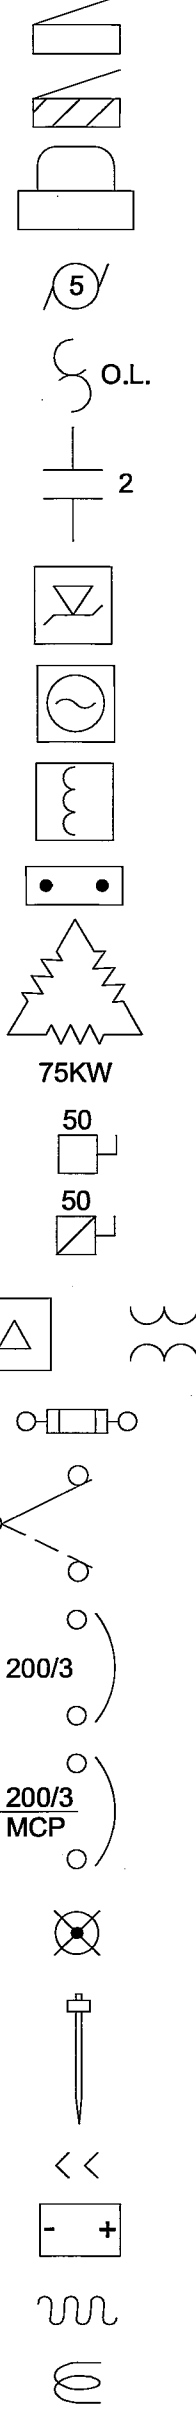RACEWAYS AND CONDUCTORS		CALLOUTS AND DESIGNATIONS		CONTROLS AND INSTRUMENTATION		STANDARD ABBREVIATIONS		PROJECT GENERAL NOTES:	
<div><div></div><div>MANUFACTURERS CORD/CABLE HEAT TAPE ON PIPING FLEXIBLE CONDUIT TWISTED SHIELDED PAIR SEWER LINE OVERHEAD ELECTRICAL EXISTING CONDUIT UNDERGROUND CONDUIT EXPOSED CONDUIT BELOW GRADE OR CONCEALED CONDUIT CAPPED CONDUIT BENT UP OR TOWARD CONDUIT BENT DOWN OR AWAY GROUNDING CAD WELD CONNECTION CONDUCTORS NOT CONNECTED CONDUCTORS CONNECTED CONDUIT SEALS CLASS 1, DIV. 1 EXPLOSION PROOF NEW EQUIPMENT (STANDARD LINEWEIGHT) EXISTING EQUIPMENT (E) (LIGHT LINEWEIGHT) EQUIPMENT TO BE REMOVED</div></div>		<div><div></div><div>CONDUIT CALLOUT TRENCH CALLOUT EQUIPMENT CALLOUT LIGHTING FIXTURE CALLOUT: SEE SCHEDULE DRAWING KEY NOTE CALLOUT DETAIL NUMBER DETAIL IDENTIFIER REFERENCE DRAWING NUMBER PANEL AND CIRCUIT (EXAMPLE: PANEL LPA, CIRCUITS 1 AND 3) PHASE/SWITCHLEG CONDUCTOR HOMERUN/CONDUIT GROUND CONDUCTOR NEUTRAL CONDUCTOR</div></div>		<div><div></div><div>NORMALLY CLOSED NORMALLY OPEN TEMPERATURE SWITCH - TS LEVEL SWITCH - LS PRESSURE SWITCH - PS LIMIT SWITCH - LS CONTACT - CR = CONTROL RELAY, MS-MOTOR STARTER, OR AS INDICATED TIME DELAY CONTACT - TR = TIME DELAY RELAY SWITCH - SW FLOW SWITCH - FS PUSHBUTTON - PB SELECTOR SWITCH, HAND-OFF-AUTO SHOWN. X'S INDICATE CONTACT SWITCHING CONVENTION.</div></div>		<div><div></div><div>A, AMP AC AFF AI AIC AL ALT AO ATS BAT BH BP C CAP CB CKT CNT CP CPT CR CT CV DEM DI DO DWG E OR (E) EF FE FS FT FU FVNR G, GND GEN GFCI/GFI H HH HID HOA HTR IC IS ISR KW KWH KWD LC LCP LE LS LT LTG M MCC MCP MFR MOV MS MTS N NC NO OI OIT OL OT P PB PE PFR PLC PNL POT PS PT PVC RGS RTM RV S SA SE SHT SS SSS SV T TC TDR TST TYP UH UPS VS VT VFD VSD W WHM WP XFMR XP XMTR ZS</div><div>AMPERE AIR COMPRESSOR ABOVE FINISHED FLOOR ANALOG INPUT POINT (PLC) AMPERES INTERRUPTING CAPACITY ALARM ALTERNATOR ANALOG OUTPUT POINT (PLC) AUTOMATIC TRANSFER SWITCH BATTERY BATTERY CHARGER BLOCK HEATER BYPASS CONTACTOR CONDUIT (RGS) CAPACITOR CIRCUIT BREAKER CIRCUIT COUNTER CONTROL PANEL CONTROL POWER TRANSFORMER CONTROL RELAY CURRENT TRANSFORMER CHECK VALVE DEMAND DIGITAL INPUT POINT (PLC) DIGITAL OUTPUT POINT (PLC) DRAWING EXISTING DEVICE EXHAUST FAN FLOW ELEMENT FLOW SWITCH FLOW TRANSMITTER FUSED FULL VOLTAGE NON-REVERSING GROUND GENERATOR GROUND FAULT CIRCUIT INTERRUPTER HOT, HIGH HAND HOLE HIGH INTENSITY DISCHARGE HAND-OFF-AUTO HEATER ISOLATION CONTACTOR INTRINSICALLY SAFE INTRINSICALLY SAFE RELAY KILOWATT KILOWATT HOUR KILOWATT DEMAND LIGHTING CONTACTOR LOCAL CONTROL PANEL LEVEL ELEMENT LIMIT SWITCH LEVEL TRANSMITTER LIGHTING METER MOTOR CONTROL CENTER MAIN CONTROL PANEL MANUFACTURER MOTOR OPERATED VALVE MOTOR STARTER MANUAL TRANSFER SWITCH NEUTRAL NORMALLY CLOSED NORMALLY OPEN OPERATOR INTERFACE OPERATOR IN TROUBLE OVERLOAD RELAY OVER TEMP POWER PUSH BUTTON PHOTO ELECTRIC RELAY PHASE FAILURE RELAY PROGRAMMABLE LOGIC CONTROLLER PANEL POTENTIOMETER PRESSURE SWITCH POTENTIAL TRANSFORMER POLY VINYL CHLORIDE (CONDUIT) RIGID GALVANIZED STEEL (CONDUIT) RUN TIME METER REDUCED VOLTAGE SIGNAL SURGE ARRESTOR SERVICE ENTRANCE SHEET STAINLESS STEEL SOLID STATE STARTER SOLENOID VALVE THERMOSTAT TIME CLOCK TIME DELAY TWISTED SHIELDED THREE CONDUCTOR (TRIAD) TYPICAL UNIT HEATER UNINTERRUPTABLE POWER SUPPLY VIBRATION SWITCH VIBRATION TRANSMITTER VARIABLE FREQUENCY DRIVE VARIABLE SPEED DRIVE WATT WATT HOUR METER WEATHER PROOF TRANSFORMER EXPLOSION PROOF TRANSMITTER LIMIT SWITCH</div></div>		<div><div></div><div>1. THE ELECTRICAL DRAWINGS AND SCHEDULES ARE FUNCTIONAL IN NATURE AND DO NOT SPECIFY EXACT LOCATIONS OF EQUIPMENT OR EQUIPMENT TERMINATIONS. IT IS THE INTENT OF THESE DRAWINGS TO DESCRIBE AND PROVIDE FOR THE FURNISHING, INSTALLING, TESTING AND PLACING IN FULLY OPERATIONAL CONDITION ALL EQUIPMENT, MATERIALS, DEVICES AND NECESSARY APPURTENANCES TO PROVIDE A COMPLETE ELECTRICAL SYSTEM, TOGETHER WITH SUCH OTHER MISCELLANEOUS INSTALLATIONS AND EQUIPMENT SHOWN ON THE DRAWINGS. THE WORK SHALL INCLUDE ALL MATERIALS, APPLIANCES AND APPARATUS NOT SPECIFICALLY MENTIONED HEREIN OR SHOWN ON THE DRAWINGS, BUT WHICH ARE NECESSARY TO MAKE A COMPLETE, FULLY OPERATIONAL INSTALLATION OF ALL ELECTRICAL SYSTEMS SHOWN ON THE DRAWINGS. 2. THIS PROJECT INCLUDES THE INSTALLATION OF PACKAGED EQUIPMENT SYSTEM(S) OR SUB-SYSTEM(S) THAT WILL REQUIRE COORDINATION BETWEEN THE CONTRACTOR AND THE MANUFACTURER TO DETERMINE THE DETAILED INSTALLATION REQUIREMENTS. THE ENGINEER HAS SHOWN GENERAL INSTALLATION INFORMATION FOR THESE SYSTEMS BASED ON THE BEST INFORMATION AVAILABLE AT THE TIME OF DESIGN. WHERE INDICATED ON THE DRAWINGS TO 'PROVIDE A COMPLETE AND OPERATIONAL SYSTEM' THE CONTRACTOR SHALL PROVIDE ALL MATERIALS, INSTALLATION, AND COORDINATION WITH THE MANUFACTURER REQUIRED SO THE EQUIPMENT IS INSTALLED AND OPERATES IN A SATISFACTORY MANNER. MINOR CHANGES IN EQUIPMENT LOCATIONS, QUANTITY OF TERMINATIONS OR WIRES, JUNCTION BOXES, CONDUIT, ETC SHALL BE INCLUDED IN THE CONTRACT PRICE. 3. CONTRACTOR SHALL COORDINATE WITH OWNER FOR REMOVAL OF EXISTING EQUIPMENT AND ANY REQUIRED PHASING TO MAINTAIN FACILITY OPERATIONS . 4. DISPOSE OF ALL DEMO MATERIALS NOT WANTED BY OWNER. 5. THE NUMBER OF CONDUCTORS AND CONDUIT ROUTING WILL VARY BASED ON HOW THE CONTRACTOR ELECTS TO ROUTE AND COMBINE CIRCUITING. THE CONTRACTOR SHALL PROVIDE DETAILED REDLINE MARKUPS ON A DEDICATED SET OF CONSTRUCTION DRAWINGS TO THE ENGINEER UPON COMPLETION OF THE PROJECT FOR PREPARATION OF RECORD DRAWINGS. THIS INCLUDES ACTUAL RACEWAY ROUTING, CONDUCTOR QUANTITIES, PANEL SCHEDULES, RECEPTACLE CONFIGURATIONS AND MOUNTING ELEVATIONS, ETC. 6. ALL MATERIALS SHALL CONFORM TO THE NATIONAL ELECTRICAL CODE ARTICLE 110-14C. WIRING AND CIRCUIT BREAKERS ON THIS PROJECT ARE DESIGNED FOR 75 DEG C OPERATION ABOVE 100 AMPERES; 60 DEG C FOR 100 AMPERES AND BELOW. ALL PRODUCTS FURNISHED ON THIS PROJECT SHALL HAVE ELECTRICAL TERMINATIONS RATED FOR 60 DEG C FOR AMPACITIES OF 100 AMPERES AND BELOW, AND RATED FOR 75 DEG C FOR AMPACITIES ABOVE 100 AMPERES. ALL CONDUCTORS SHALL BE COPPER.</div></div>	
LIGHTING AND RECEPTACLES		ELECTRICAL AND POWER DISTRIBUTION							
<div><div></div><div>F1 FLUORESCENT LIGHTING FIXTURE. FIXTURE IDENTIFIER AND SWITCHED CIRCUIT INDICATED. REFER TO LIGHTING SCHEDULE FOR FIXTURE AND LAMP TYPE. FLUORESCENT LIGHTING FIXTURE WITH EMERGENCY BATTERY PACK LIGHTING FIXTURE, EMERGENCY DUAL HEAD WITH INTEGRAL BATTERY PACK. EXIT SIGN WHERE INDICATED. LED EXIT SIGN INCANDESCENT, COMPACT FLUORESCENT OR H.I.D. LIGHTING FIXTURE, CEILING MOUNTED PHOTOELECTRIC CONTROL UNIT. WALL MOUNTED LIGHTING FIXTURE, POLE MOUNT LIGHTING FIXTURE, WALL MOUNT DUPLEX RECEPTACLE, NUMBER INDICATES CIRCUIT. GFCI WHERE INDICATED FOURPLEX RECEPTACLE, NUMBER INDICATES CIRCUIT. DUPLEX RECEPTACLE MOUNTED 6" ABOVE COUNTER NUMBER INDICATES CIRCUIT. DUPLEX RECEPTACLE FLOOR MOUNTED, NUMBER INDICATES CIRCUIT. SPECIAL PURPOSE RECEPTACLE OR DEDICATED EQUIPMENT CONNECTION, AS NOTED. TELEPHONE OUTLET DATA OUTLET SPLIT TELEPHONE DATA OUTLET INTERCOM SWITCH, NUMBERS REFER TO SWITCH TYPE AND SWITCHED CIRCUIT. JUNCTION BOX JUNCTION BOX, EXPLOSION PROOF THERMOSTAT</div></div>		<div><div></div><div>PANELBOARD 208Y/120V OR 120/240V PANELBOARD 480Y/277V UTILITY METER MOTOR CONNECTION NUMBER INDICATES HORSEPOWER THERMAL OVERLOAD RELAY FULL VOLTAGE NON REVERSING MOTOR STARTER NUMBER INDICATES NEMA SIZE REDUCED VOLTAGE SOLID STATE STARTER VARIABLE FREQUENCY DRIVE LINE REACTOR BUS CONNECTION (N=NEUTRAL, G=GROUND) HEATER, NUMBER INDICATES KW DISCONNECT SWITCH - HP RATED, AS INDICATED DISCONNECT SWITCH (FUSED) TRANSFORMER CARTRIDGE FUSE AND FUSEHOLDER ATS - AUTOMATIC TRANSFER SWITCH MTS - MANUAL TRANSFER SWITCH THERMAL MAG CIRCUIT BREAKER, RATING/NO. POLES INDICATING LIGHT, LETTER INDICATES: R-RED, G-GREEN, A-AMBER, W-WHITE, B-BLUE MOTOR CIRCUIT PROTECTOR, RATING/NO. POLES GROUND ROD AND WELL GROUNDING ELECTRODE PULL OUT PLUG-RECEPTACLE/MCC CONNECTION BATTERY SIDEWALK SNOWMELT CT - CURRENT TRANSFORMER</div></div>							

DESIGNED BY
BZ

DRAWN BY
GH

CHECKED BY
BZ

CITY OF FERNDALE

WHATCOM COUNTY

PUMP STATION NO. 4

ELECTRICAL SYMBOLS AND ABBREVIATIONS

DATE
01/27/2016


SCALE
AS SHOWN

JOB NUMBER
2013-037


SHEET
E1

OF
E11

WILSON ENGINEERING, LLC
805 DUPONT STREET
BELLINGHAM, WA 98225
(360) 733-6100 • FAX (360) 647-9061
www.wilsonengineering.com

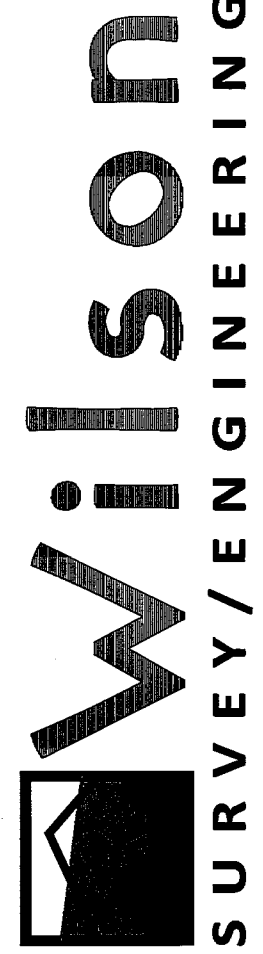


WILSON
SURVEY/ENGINEERING




00547.013 4/7/16 SH

ELECTRICAL DEMOLITION NOTES:

1. PROVIDE COMPLETE DEMOLITION OF ALL EXISTING EQUIPMENT INCLUDING WET WELL PUMPING SYSTEM, PUMP CONTROL PANEL, INSTRUMENTATION, CONDUIT AND WIRING.
2. RETURN ALL DEMO EQUIPMENT TO OWNER. LEGALLY DISPOSE OF ALL DEMO MATERIALS NOT WANTED BY OWNER.
3. COORDINATE WITH OWNER TO MAINTAIN OPERATIONS DURING CONSTRUCTION PERIOD. SEE CIVIL SPECIFICATIONS.

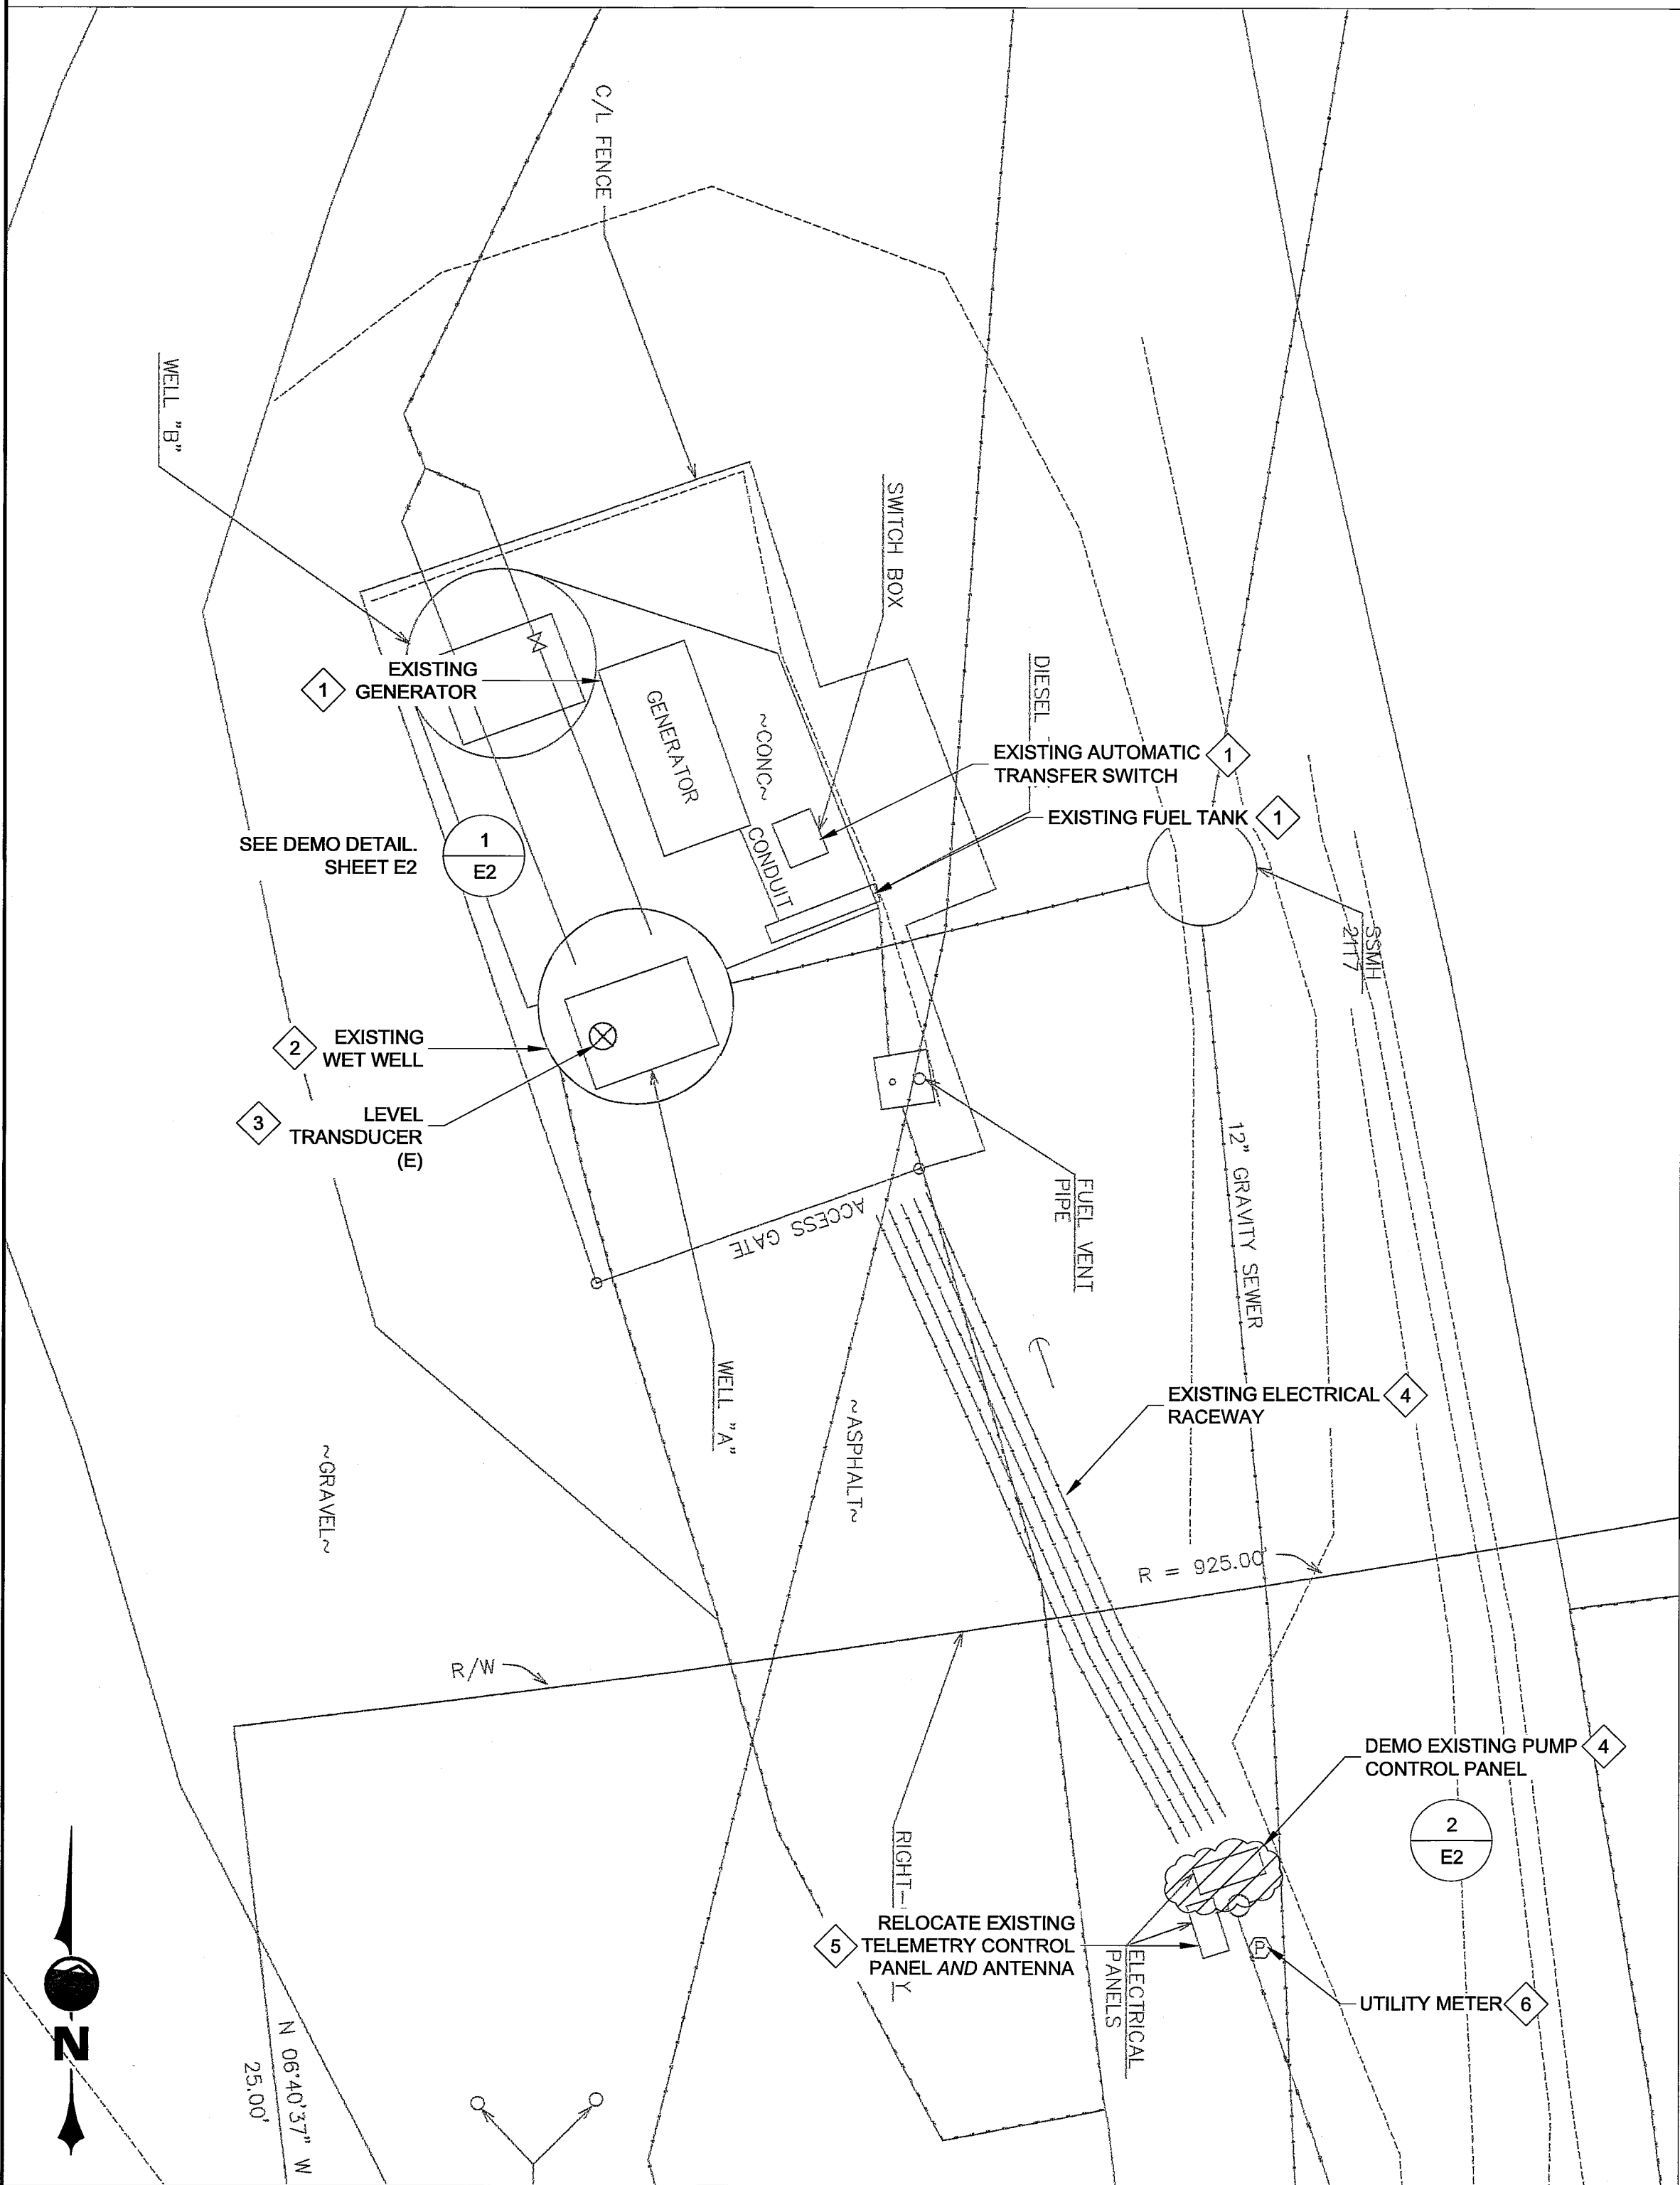

ELECTRICAL DEMO PLAN
SCALE: 1" = 5' AT FULL SCALE

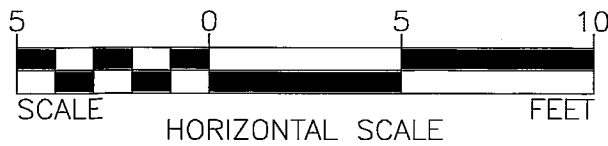

DEMO NOTES:

1. PROVIDE COMPLETE ELECTRICAL DEMOLITION OF EXISTING GENERATOR, DIESEL FUEL TANK, AND AUTOMATIC TRANSFER SWITCH.
2. PROVIDE COMPLETE DEMOLITION OF EXISTING WET WELL PUMPS AND INSTRUMENTATION.
3. REMOVE EXISTING LEVEL TRANSDUCER. MAINTAIN AND PROTECT, RETURN TO OWNER FOR FUTURE USE.

1
E2
ELECTRICAL EQUIPMENT DEMO DETAIL
SCALE: NONE



DEMO NOTES:

4. PROVIDE COMPLETE ELECTRICAL DEMOLITION OF EXISTING PUMP CONTROL PANEL AND ELECTRICAL RACEWAY.
5. RELOCATE EXISTING TELEMETRY PANEL TO NEW EQUIPMENT ENCLOSURE. PROVIDE NEW TELEMETRY ANTENNA MOUNTING PER DETAIL ON SHEET E5. PROVIDE NEW ANTENNA CABLE AND RACEWAY, ROUTE TO NEW TELEMETRY PANEL LOCATION.
6. DEMO EXISTING METER BASE AND 100 AMP SERVICE DISCONNECT. PROVIDE NEW METER BASE, FUSED DISCONNECT AHEAD OF METER BASE, AND POLE RISER PER PSE REQUIREMENTS. PROVIDE NEW UNDERGROUND SERVICE RACEWAY FROM NEW METER BASE ON POLE TO NEW SERVICE DISCONNECT IN EQUIPMENT ENCLOSURE; SEE SHEETS E3, E5. COORDINATE WITH PUGET SOUND ENERGY FOR ELECTRICAL SERVICE UPGRADE.

2
E2
POWER POLE DEMO DETAIL
SCALE: NONE



Z-engineers, PLLC
One Fifth Street, Ste 150
Wenatchee, WA 98801
Tel: 509.888.9364
Fax: 509.888.9365
www.z-engineers.com

NO.	REVISIONS	BY	DATE
0	RECORD DRAWINGS	BZ	01/27/16


WILSON ENGINEERING, LLC
805 DUPONT STREET
BELLINGHAM, WA 98225
(360) 733-6100 • FAX (360) 647-9061
www.wilsonengineering.com

Wilson
SURVEY/ENGINEERING


1-27-2016

DESIGNED BY	BZ	DRAWN BY	GH	CHECKED BY	BZ
CITY OF FERDALE		WHATCOM COUNTY		WASHINGTON	
PUMP STATION NO. 4		ELECTRICAL DEMOLITION			
DATE	01/27/2016	SCALE	AS SHOWN	JOB NUMBER	2013-037
SHEET	E2	OF	E11		

00587.014 4/7/16 SH

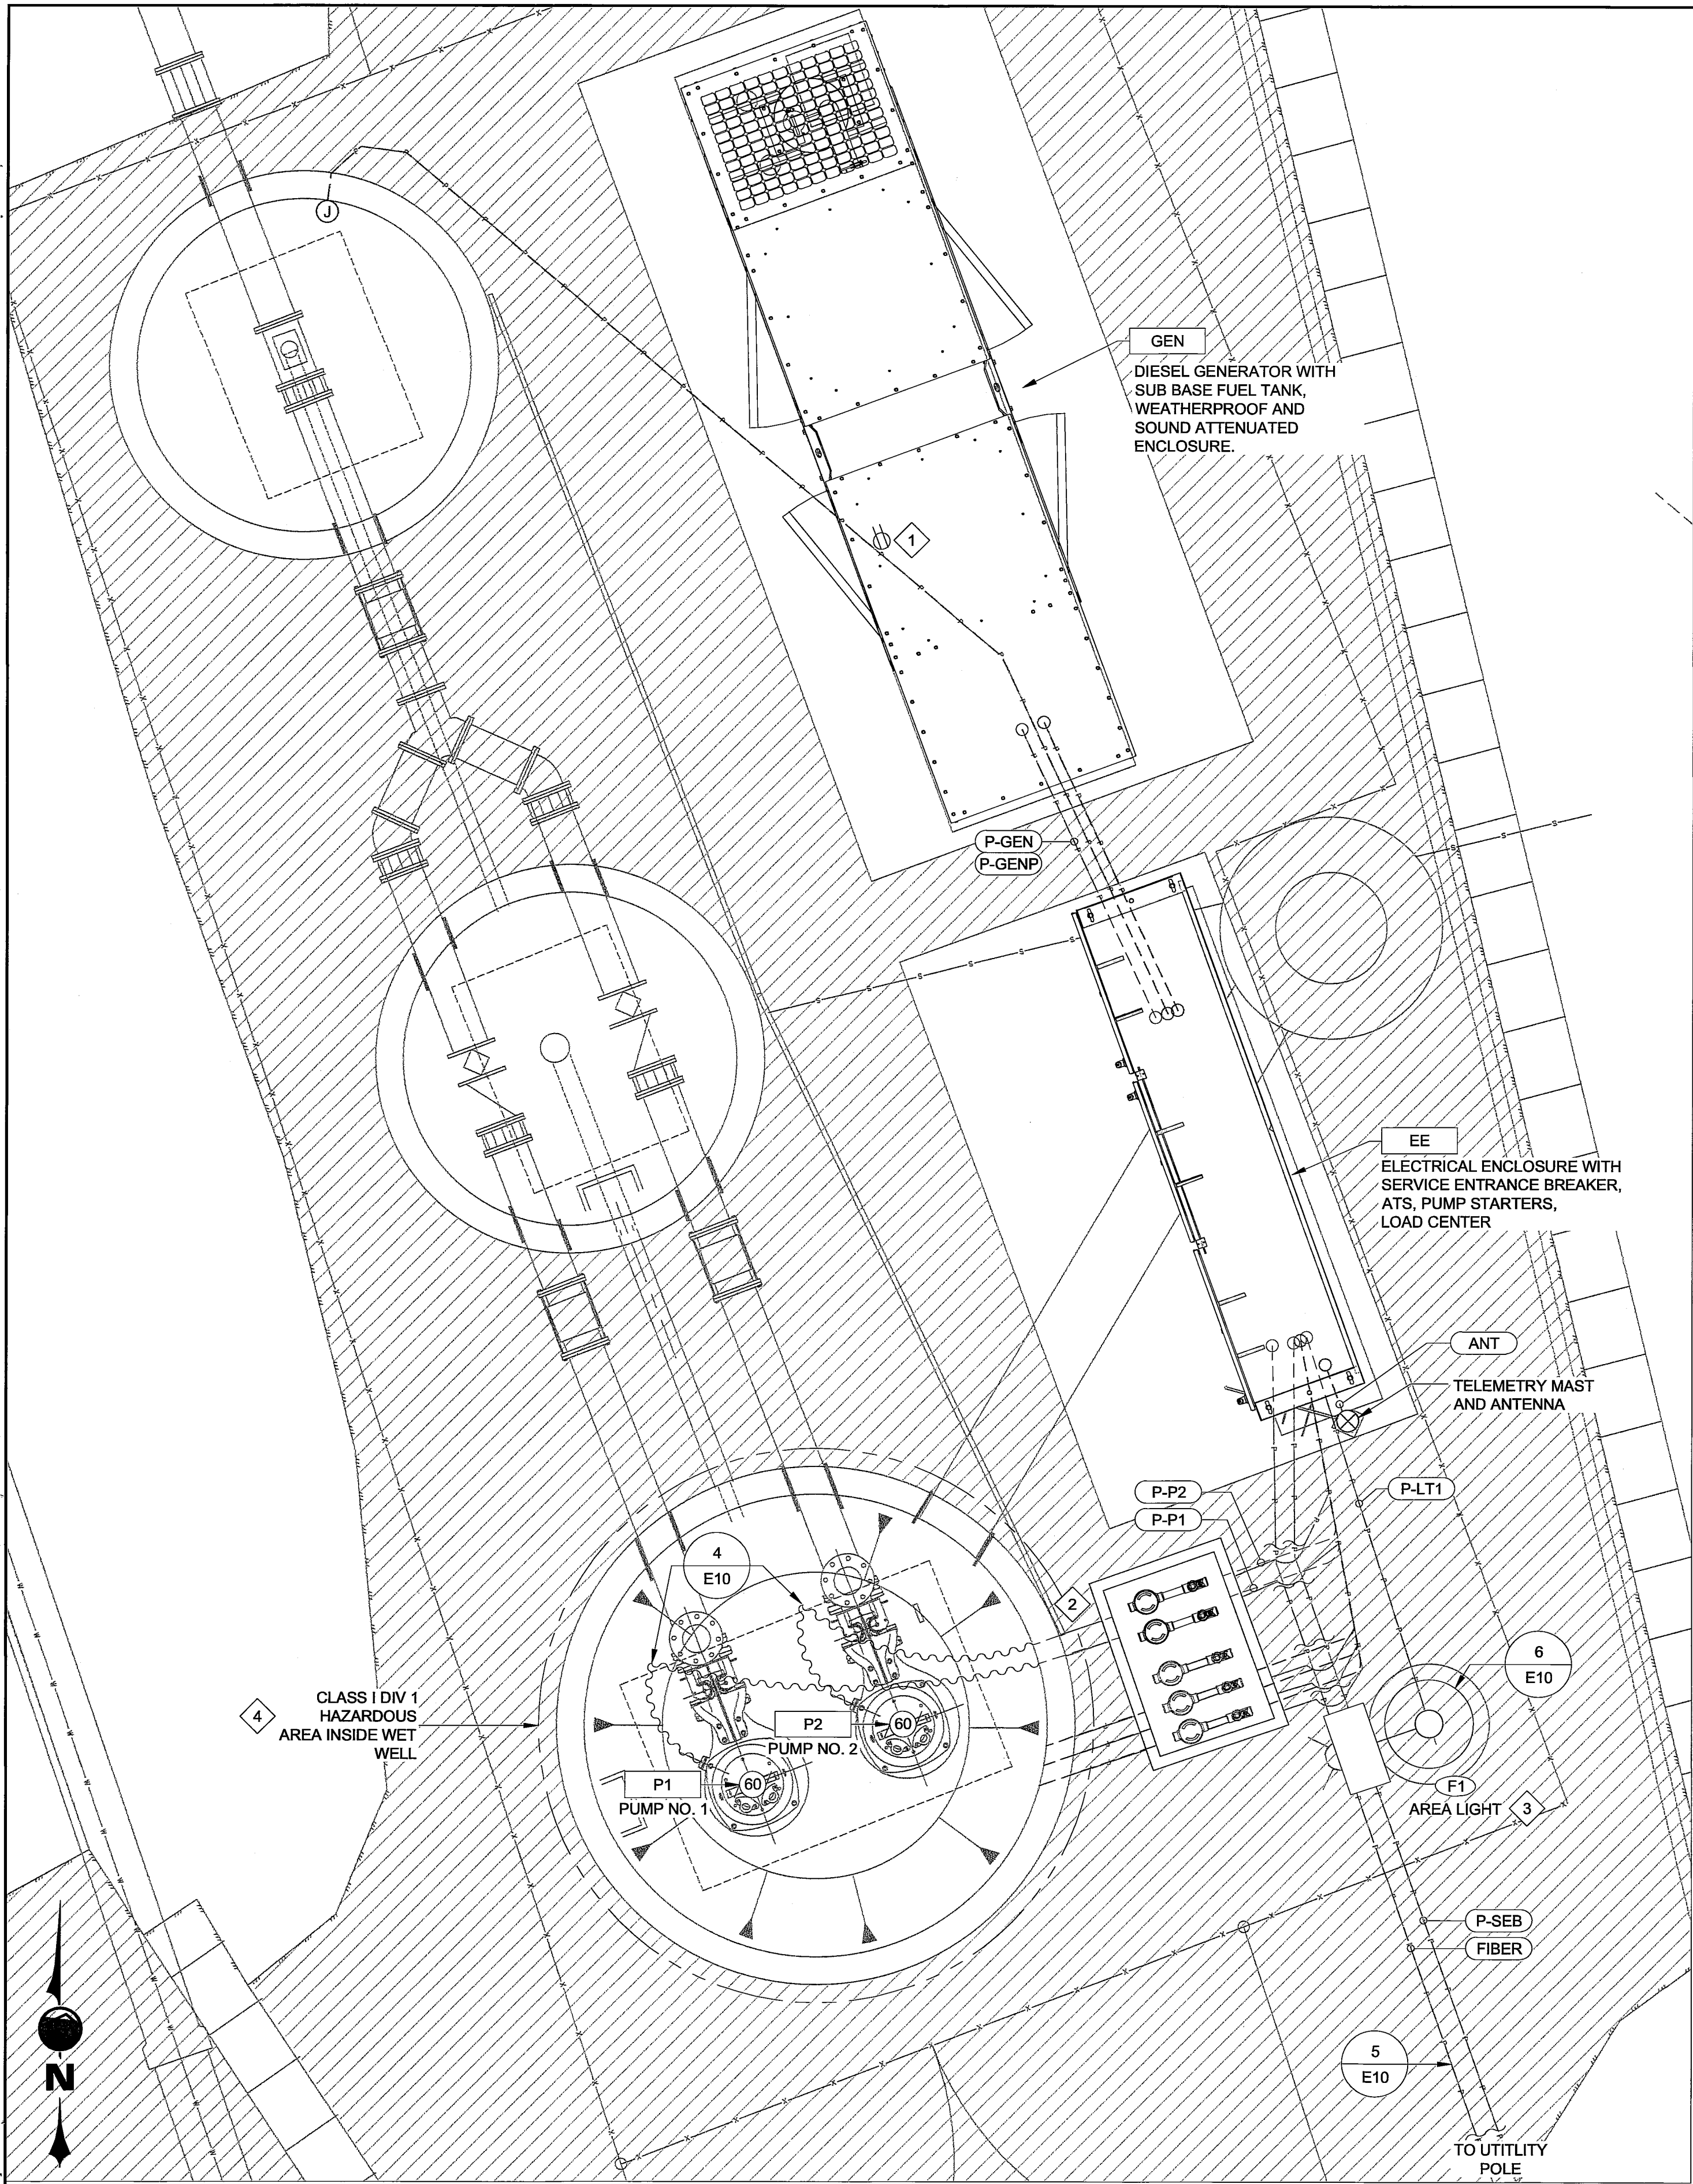

ELECTRICAL POWER PLAN
SCALE: 1" = 2' AT FULL SCALE

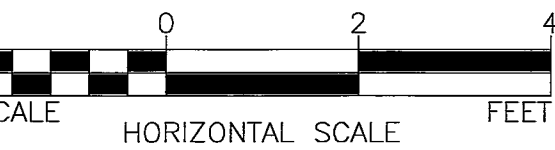


GENERAL NOTES:

- ALL CONDUIT ROUTING IS NOT SHOWN. ELECTRICAL CONTRACTOR SHALL DETERMINE THE BEST ROUTING PATH AND CIRCUIT COMBINATIONS BASED ON FIELD CONDITIONS AND ELECTRICAL CODES.
- CONDUCTOR AND CONDUIT SIZING SHALL BE AS REQUIRED BY NEC.
- EQUIPMENT LOCATIONS AND ARRANGEMENT ARE SCHEMATIC. CONTRACTOR SHALL COORDINATE WITH EQUIPMENT MANUFACTURER FOR DETAILED CONNECTION REQUIREMENTS AND PROVIDE MATERIALS AND INSTALLATION FOR A COMPLETE AND OPERATIONAL SYSTEM.
- THESE DRAWINGS SHOW ONLY FUNCTIONAL REQUIREMENTS OF THE ELECTRICAL ENCLOSURE AND CONTROL SYSTEM. DETAILED WIRING DIAGRAMS, PANEL SIZING AND LAYOUT, AND BILL OF MATERIALS ARE INCLUDED IN THE PROJECT O&M MANUAL PROVIDED BY PROCESS SOLUTION INC., PROJECT #Q647210.

KEY NOTES:

- PROVIDE RECEPTACLE IN GENERATOR ENCLOSURE FOR BATTERY CHARGER AND BLOCK HEATER.
- OVERSIZE CONDUITS TO WET WELL FOR PUMP CABLES.
- COORDINATE FINAL LOCATION OF AREA LIGHT FIXTURE DURING CONSTRUCTION.
- HAZARDOUS LOCATIONS - WET WELL AND HANDHOLE ARE CLASS I, DIV 1 PER NFPA 820, TABLE 4.2, ROW16a. FLOW METER VAULT IS CLASS I, DIV 2 PER NFPA 820, TABLE 4.2, ROW 31a. ALL INSTRUMENTATION, ELECTRICAL EQUIPMENT AND INSTALLATION SHALL BE IN ACCORDANCE WITH NEC ARTICLE 500.

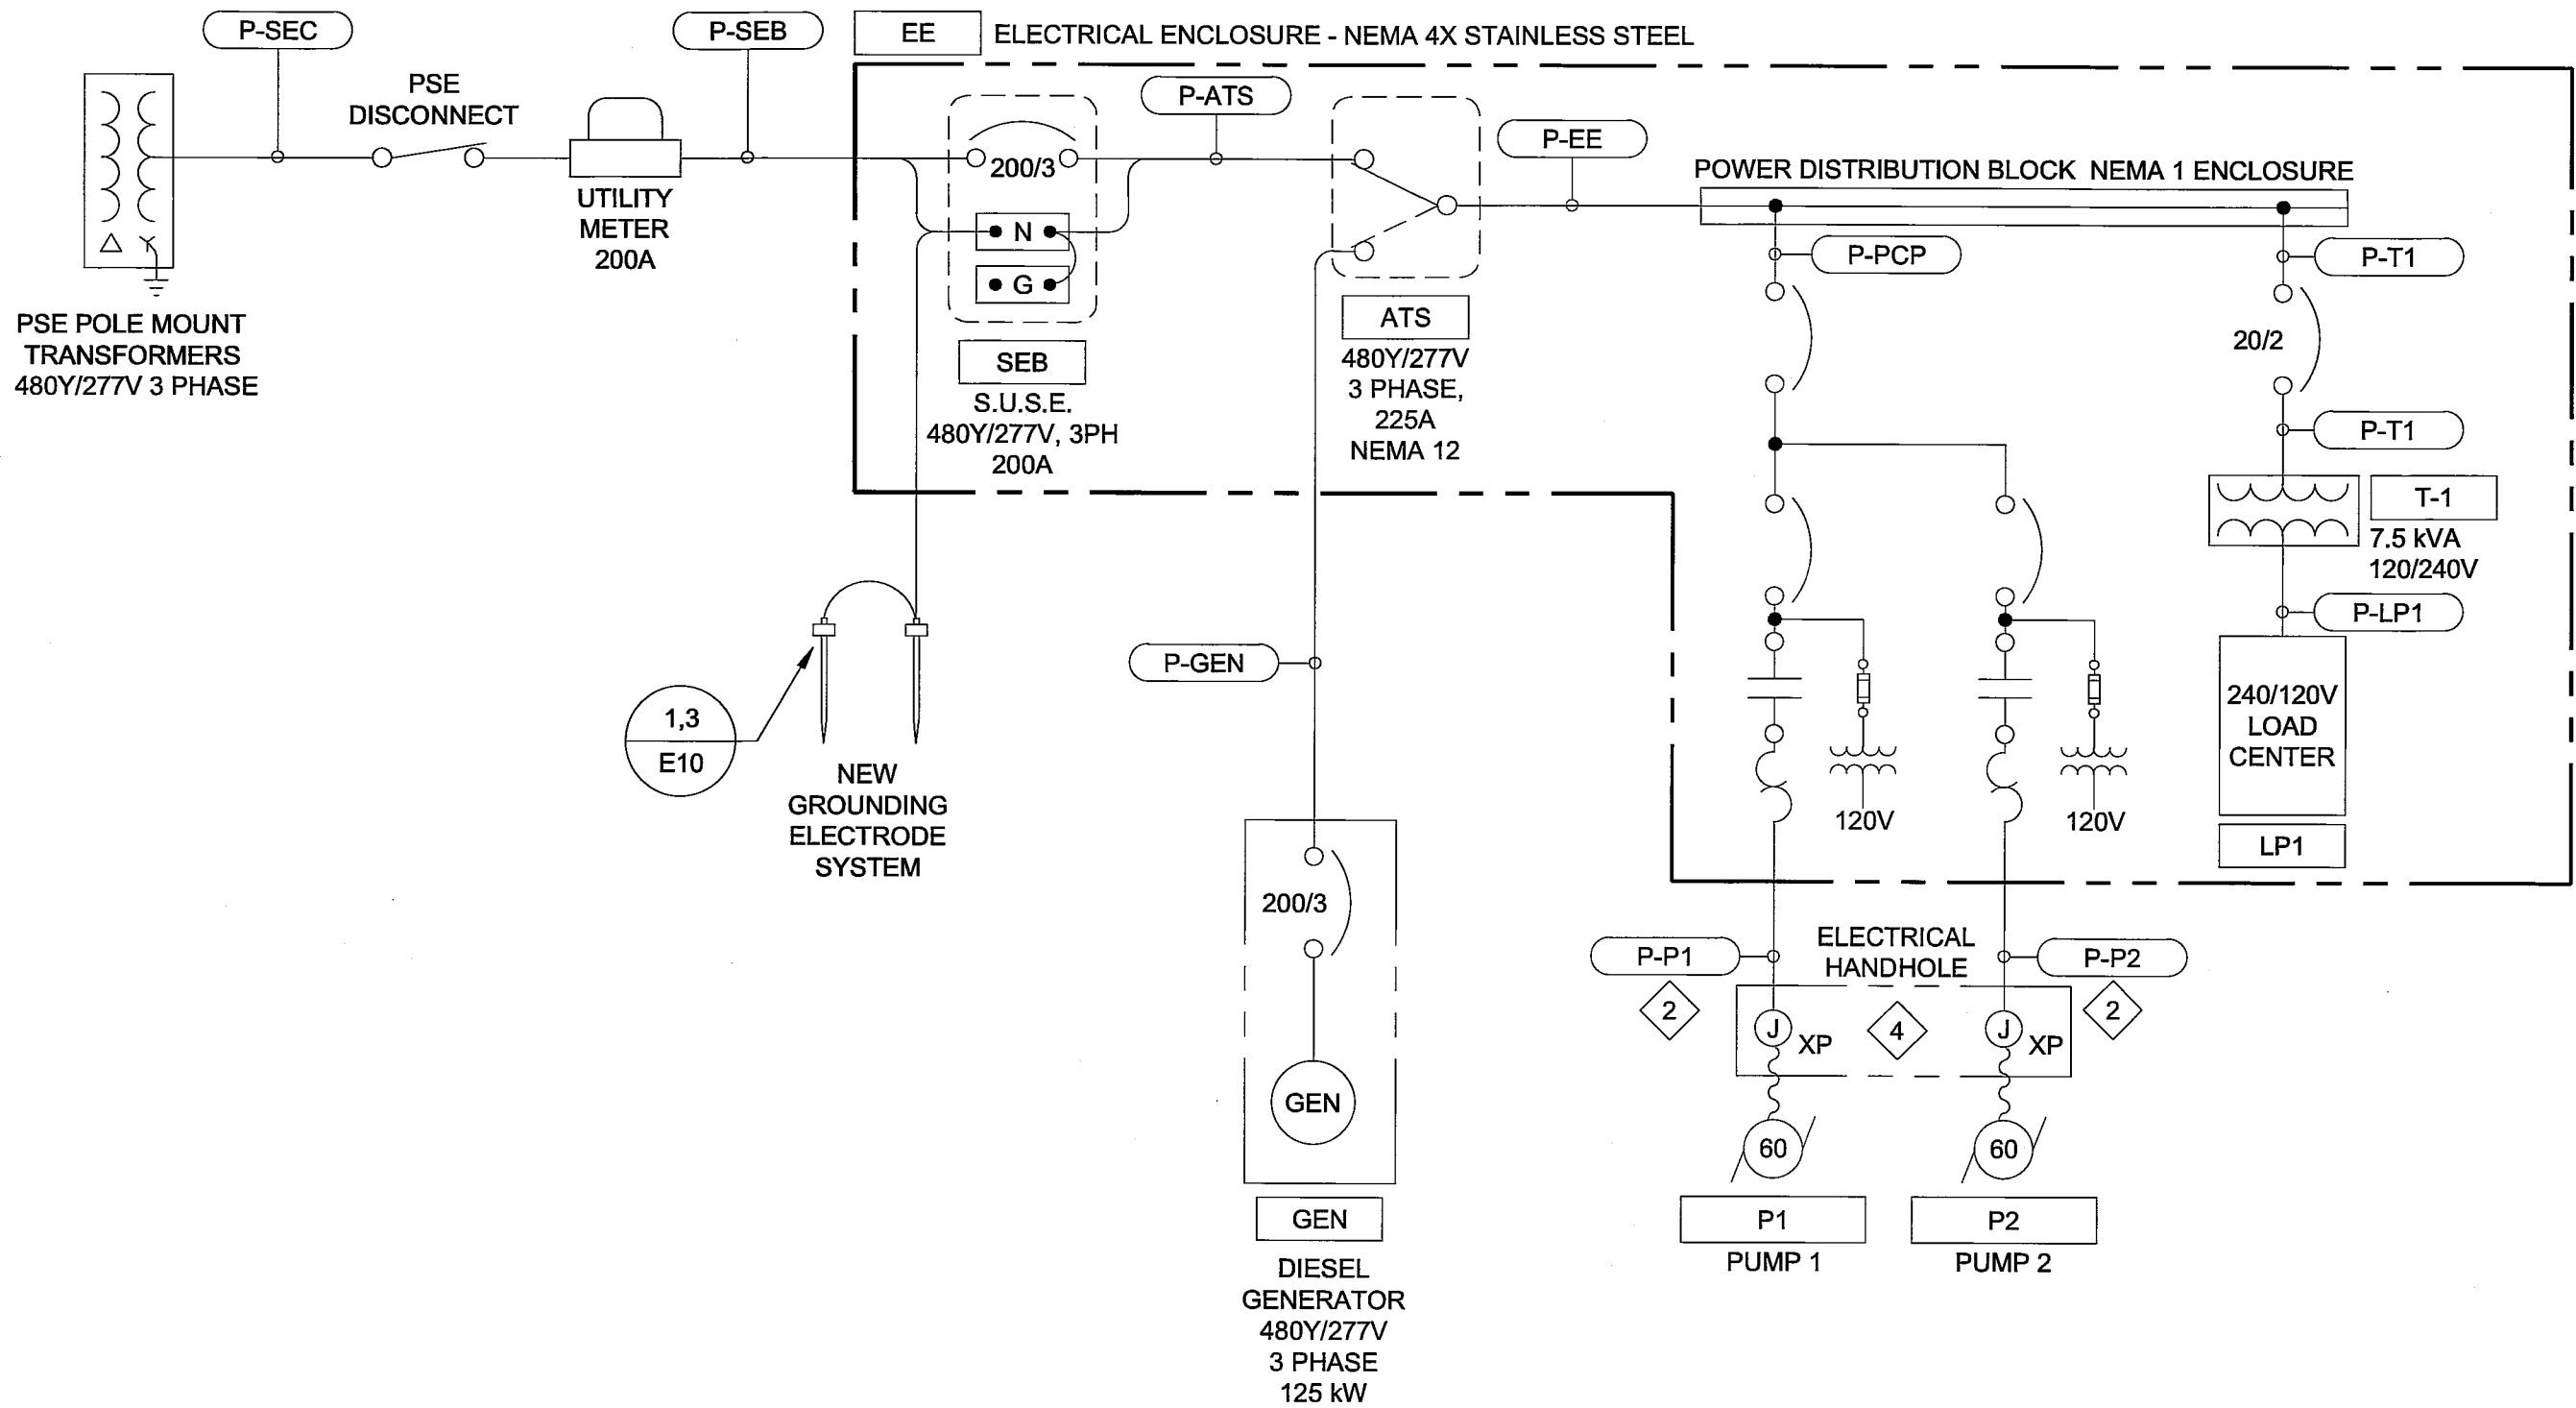

ONE LINE DIAGRAM
SCALE: NONE

LOAD CALCULATION - 480 VAC, 3 PHASE						
EQUIPMENT NO.	DESCRIPTION	KVA/HP	AMPS	DEMAND FACTOR	DEMAND LOAD AMPS	DEMAND FACTOR
P1	PUMP 1 - FLYGT MODEL NP 3202 HT	60 HP	69.0	1.25	86.3	1.25
P2	PUMP 2 - FLYGT MODEL NP 3202 HT	60 HP	69.0	1.00	69.0	1.00
LP1	LOAD CENTER	7.5 KVA	15.6	0.65	10.1	0.65
TOTAL			153.6		165.4	

LOAD CALCULATION
SCALE: NONE



Z Engineers, PLLC
One Fifth Street, Ste 150
Wenatchee, WA 98801
Tel: 509.888.9364
Fax: 509.888.9365
www.z-engineers.com

WILSON ENGINEERING, LLC
805 DUPONT STREET
BELLINGHAM, WA 98225
(360) 733-6100 • FAX (360) 647-9061
www.wilsonengineering.com


Wilson
SURVEY/ENGINEERING

DESIGNED BY: BZ
DRAWN BY: CH
CHECKED BY: BZ


CITY OF FERNDALE
PUMP STATION NO. 4
POWER PLAN AND SCHEDULES

DATE: 01/27/2016
SCALE: AS SHOWN
JOB NUMBER: 2013-037

SHEET: E3 OF E11

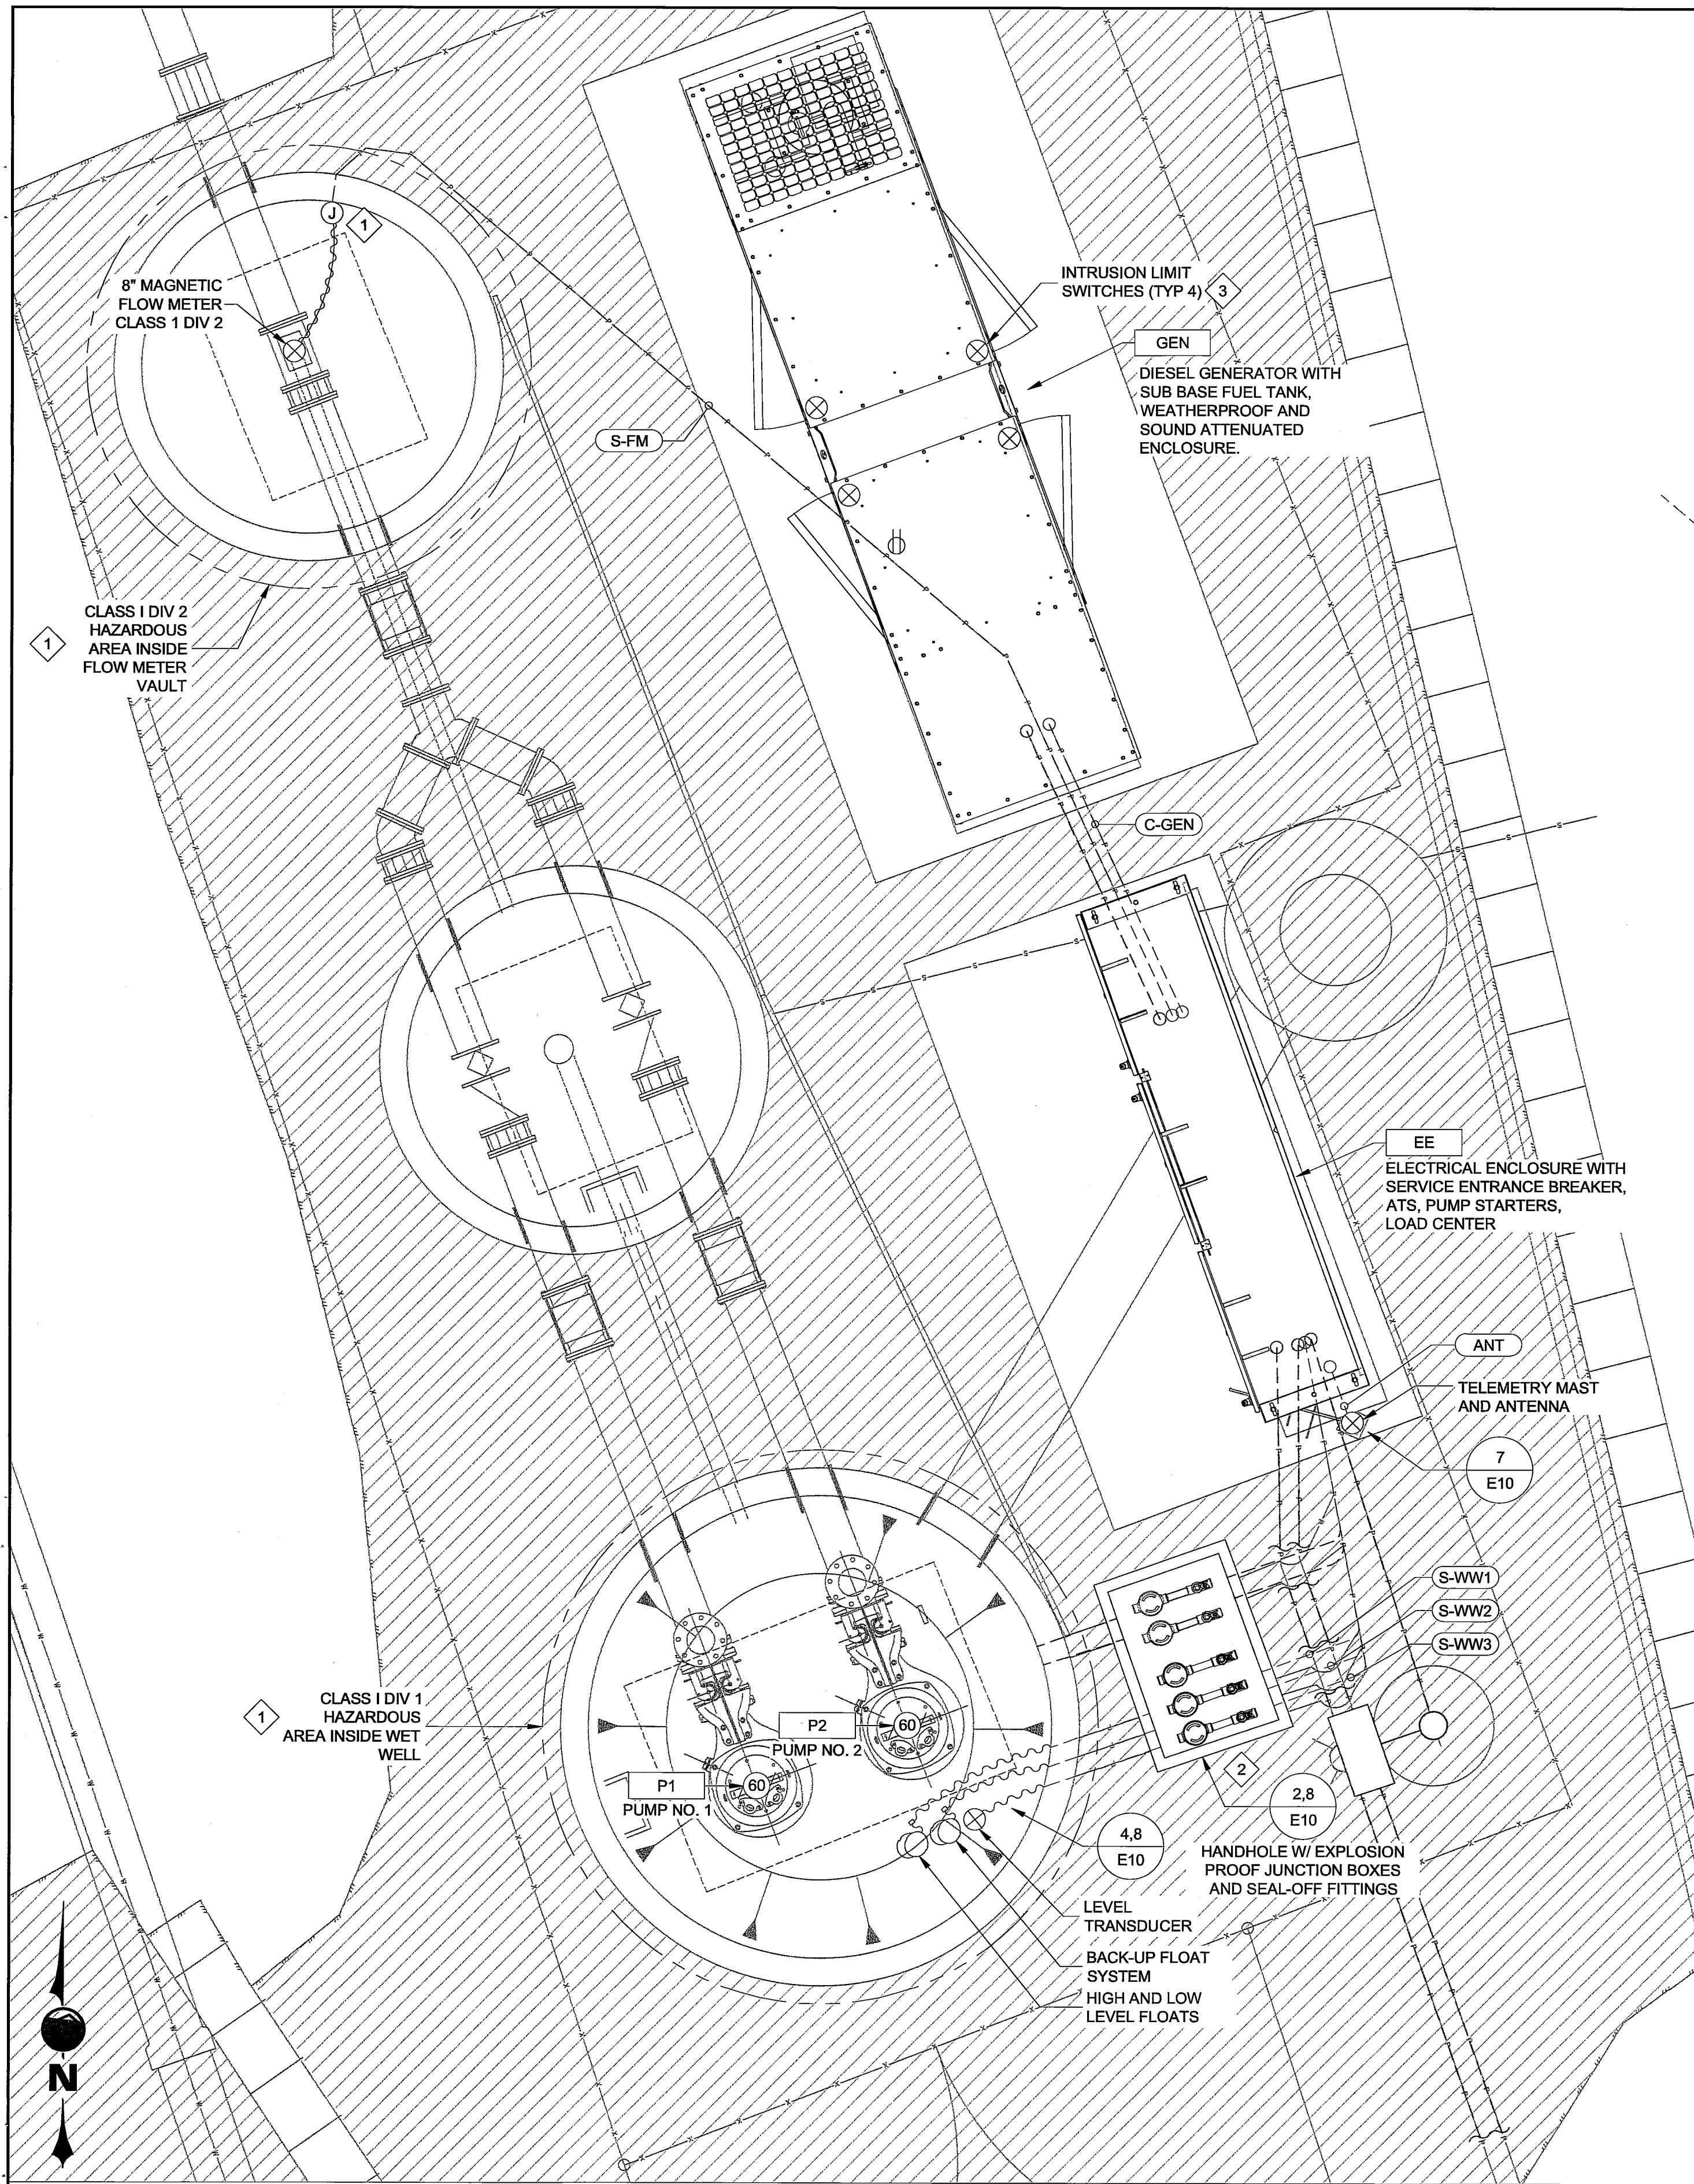

INSTRUMENTATION & CONTROL PLAN
SCALE: 1" = 2' AT FULL SCALE

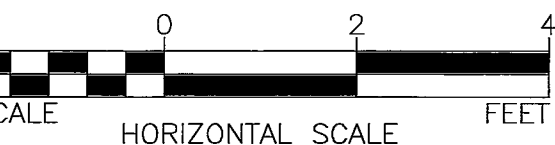


KEY NOTES:

- HAZARDOUS LOCATIONS - WET WELL IS CLASS 1, DIV 1 PER NFPA 820, TABLE 4.2, ROW 16a. FLOW METER VAULT IS CLASS 1, DIV 2 PER NFPA 820, TABLE 4.2, ROW 31a. ALL INSTRUMENTATION, ELECTRICAL EQUIPMENT AND INSTALLATION SHALL BE IN ACCORDANCE WITH NEC ARTICLE 500.
- FIELD COORDINATE HAND HOLE LOCATION. HANDHOLE SHALL BE TRAFFIC RATED AND SIZED PER NEC. SIZE CONDUITS PER NEC TO ACCOMMODATE PUMP AND INSTRUMENTATION CABLES.
- PROVIDE LIMIT SWITCHES FOR EACH GENERATOR DOOR. WIRE LIMIT SWITCHES IN SERIES TO PROVIDE ONE INTRUSION STATUS TO THE TELEMETRY PANEL PLC.

GENERAL NOTES:

- ALL CONDUIT ROUTING IS NOT SHOWN. ELECTRICAL CONTRACTOR SHALL DETERMINE THE BEST ROUTING PATH AND CIRCUIT COMBINATIONS BASED ON FIELD CONDITIONS AND ELECTRICAL CODES.
- EQUIPMENT LOCATIONS AND ARRANGEMENT ARE SCHEMATIC. CONTRACTOR SHALL COORDINATE WITH EQUIPMENT MANUFACTURER FOR DETAILED CONNECTION REQUIREMENTS AND PROVIDE MATERIALS AND INSTALLATION FOR A COMPLETE AND OPERATIONAL SYSTEM.
- THESE DRAWINGS SHOW ONLY FUNCTIONAL REQUIREMENTS OF THE ELECTRICAL ENCLOSURE AND CONTROL SYSTEM. DETAILED WIRING DIAGRAMS, PANEL SIZING AND LAYOUT, AND BILL OF MATERIALS ARE INCLUDED IN THE PROJECT O&M MANUAL PROVIDED BY PROCESS SOLUTION INC., PROJECT #Q647210.

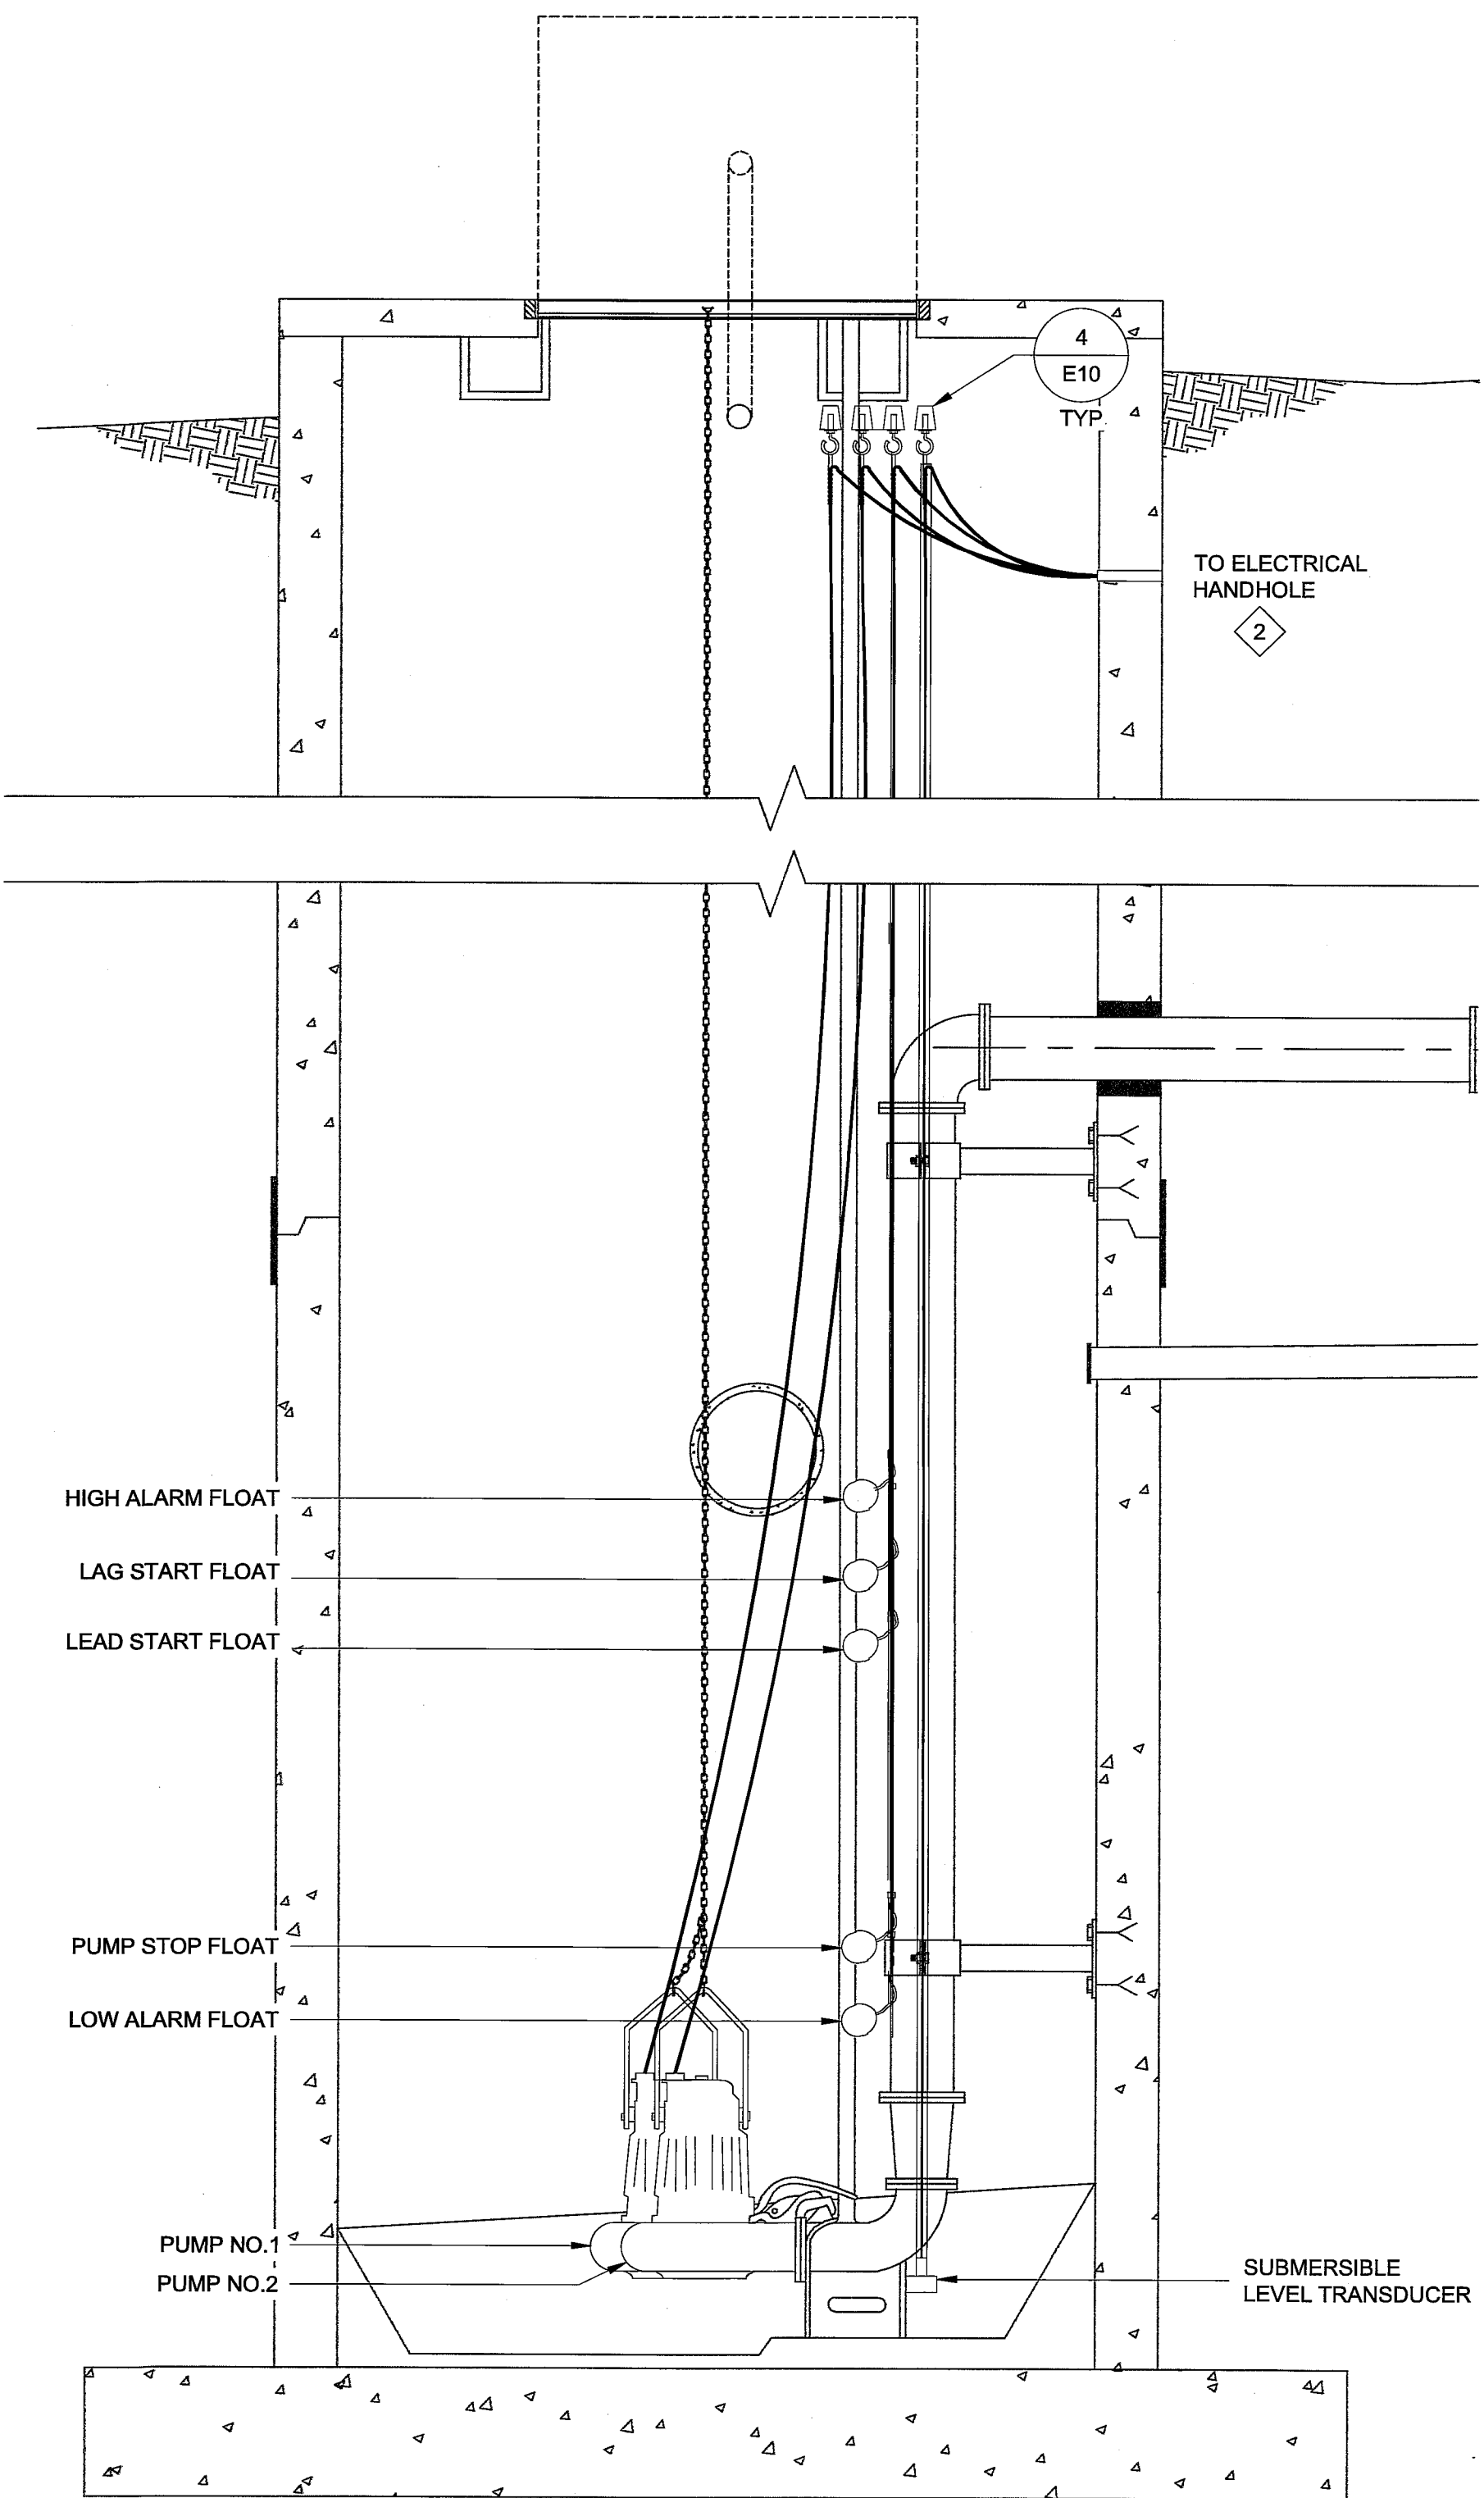

WET WELL ELEVATION
SCALE: NONE



Z-engineers, PLLC
One Fifth Street, Ste 150
Wenatchee, WA 98801
Tel: 509.888.9364
Fax: 509.888.9365
www.z-engineers.com

NO.		REVISIONS		BY	DATE
0		RECORD DRAWINGS		BZ	01/27/16

WILSON ENGINEERING, LLC
805 DUPONT STREET
BELLINGHAM, WA 98225
(360) 733-6100 • FAX (360) 647-9061
www.wilsonengineering.com

Wilson
SURVEY/ENGINEERING

DESIGNED BY BZ	DRAWN BY CH	CHECKED BY BZ
-------------------	----------------	------------------

CITY OF FERNDALE

WHATCOM COUNTY

WASHINGTON

PUMP STATION NO. 4

INSTRUMENTATION AND CONTROL PLAN

DATE 01/27/2016	SCALE AS SHOWN	JOB NUMBER 2013-037
--------------------	-------------------	------------------------

SHEET
E4


OF

E11

00547.016 47116 st

RADIO ANTENNA MOUNTING INFORMATION:


1. PROVIDE COMPLETE ANTENNA MOUNTING ASSEMBLY INCLUDING A GROUNDED MAST, CONSISTING OF A 2" GALVANIZED RIGID STEEL MAST WITH WEATHERHEAD (SEE DETAIL) SET IN CONCRETE, OR SUPPORTED BY EQUIPMENT SUPPORT STRUCTURES.
2. ANTENNA ASSEMBLY SHALL INCLUDE A LIGHTNING SURGE ARRESTOR AND CONNECTION TO NEW GROUND ROD AND ELECTRICAL SERVICE GROUNDING ELECTRODE SYSTEM.
3. FIELD COORINATE FINAL ANTENNA MOUNTING HEIGHT AND AIMING. ANTENNA SHALL BE A MAXIMUM OF 20 FEET ABOVE GROUND LEVEL.

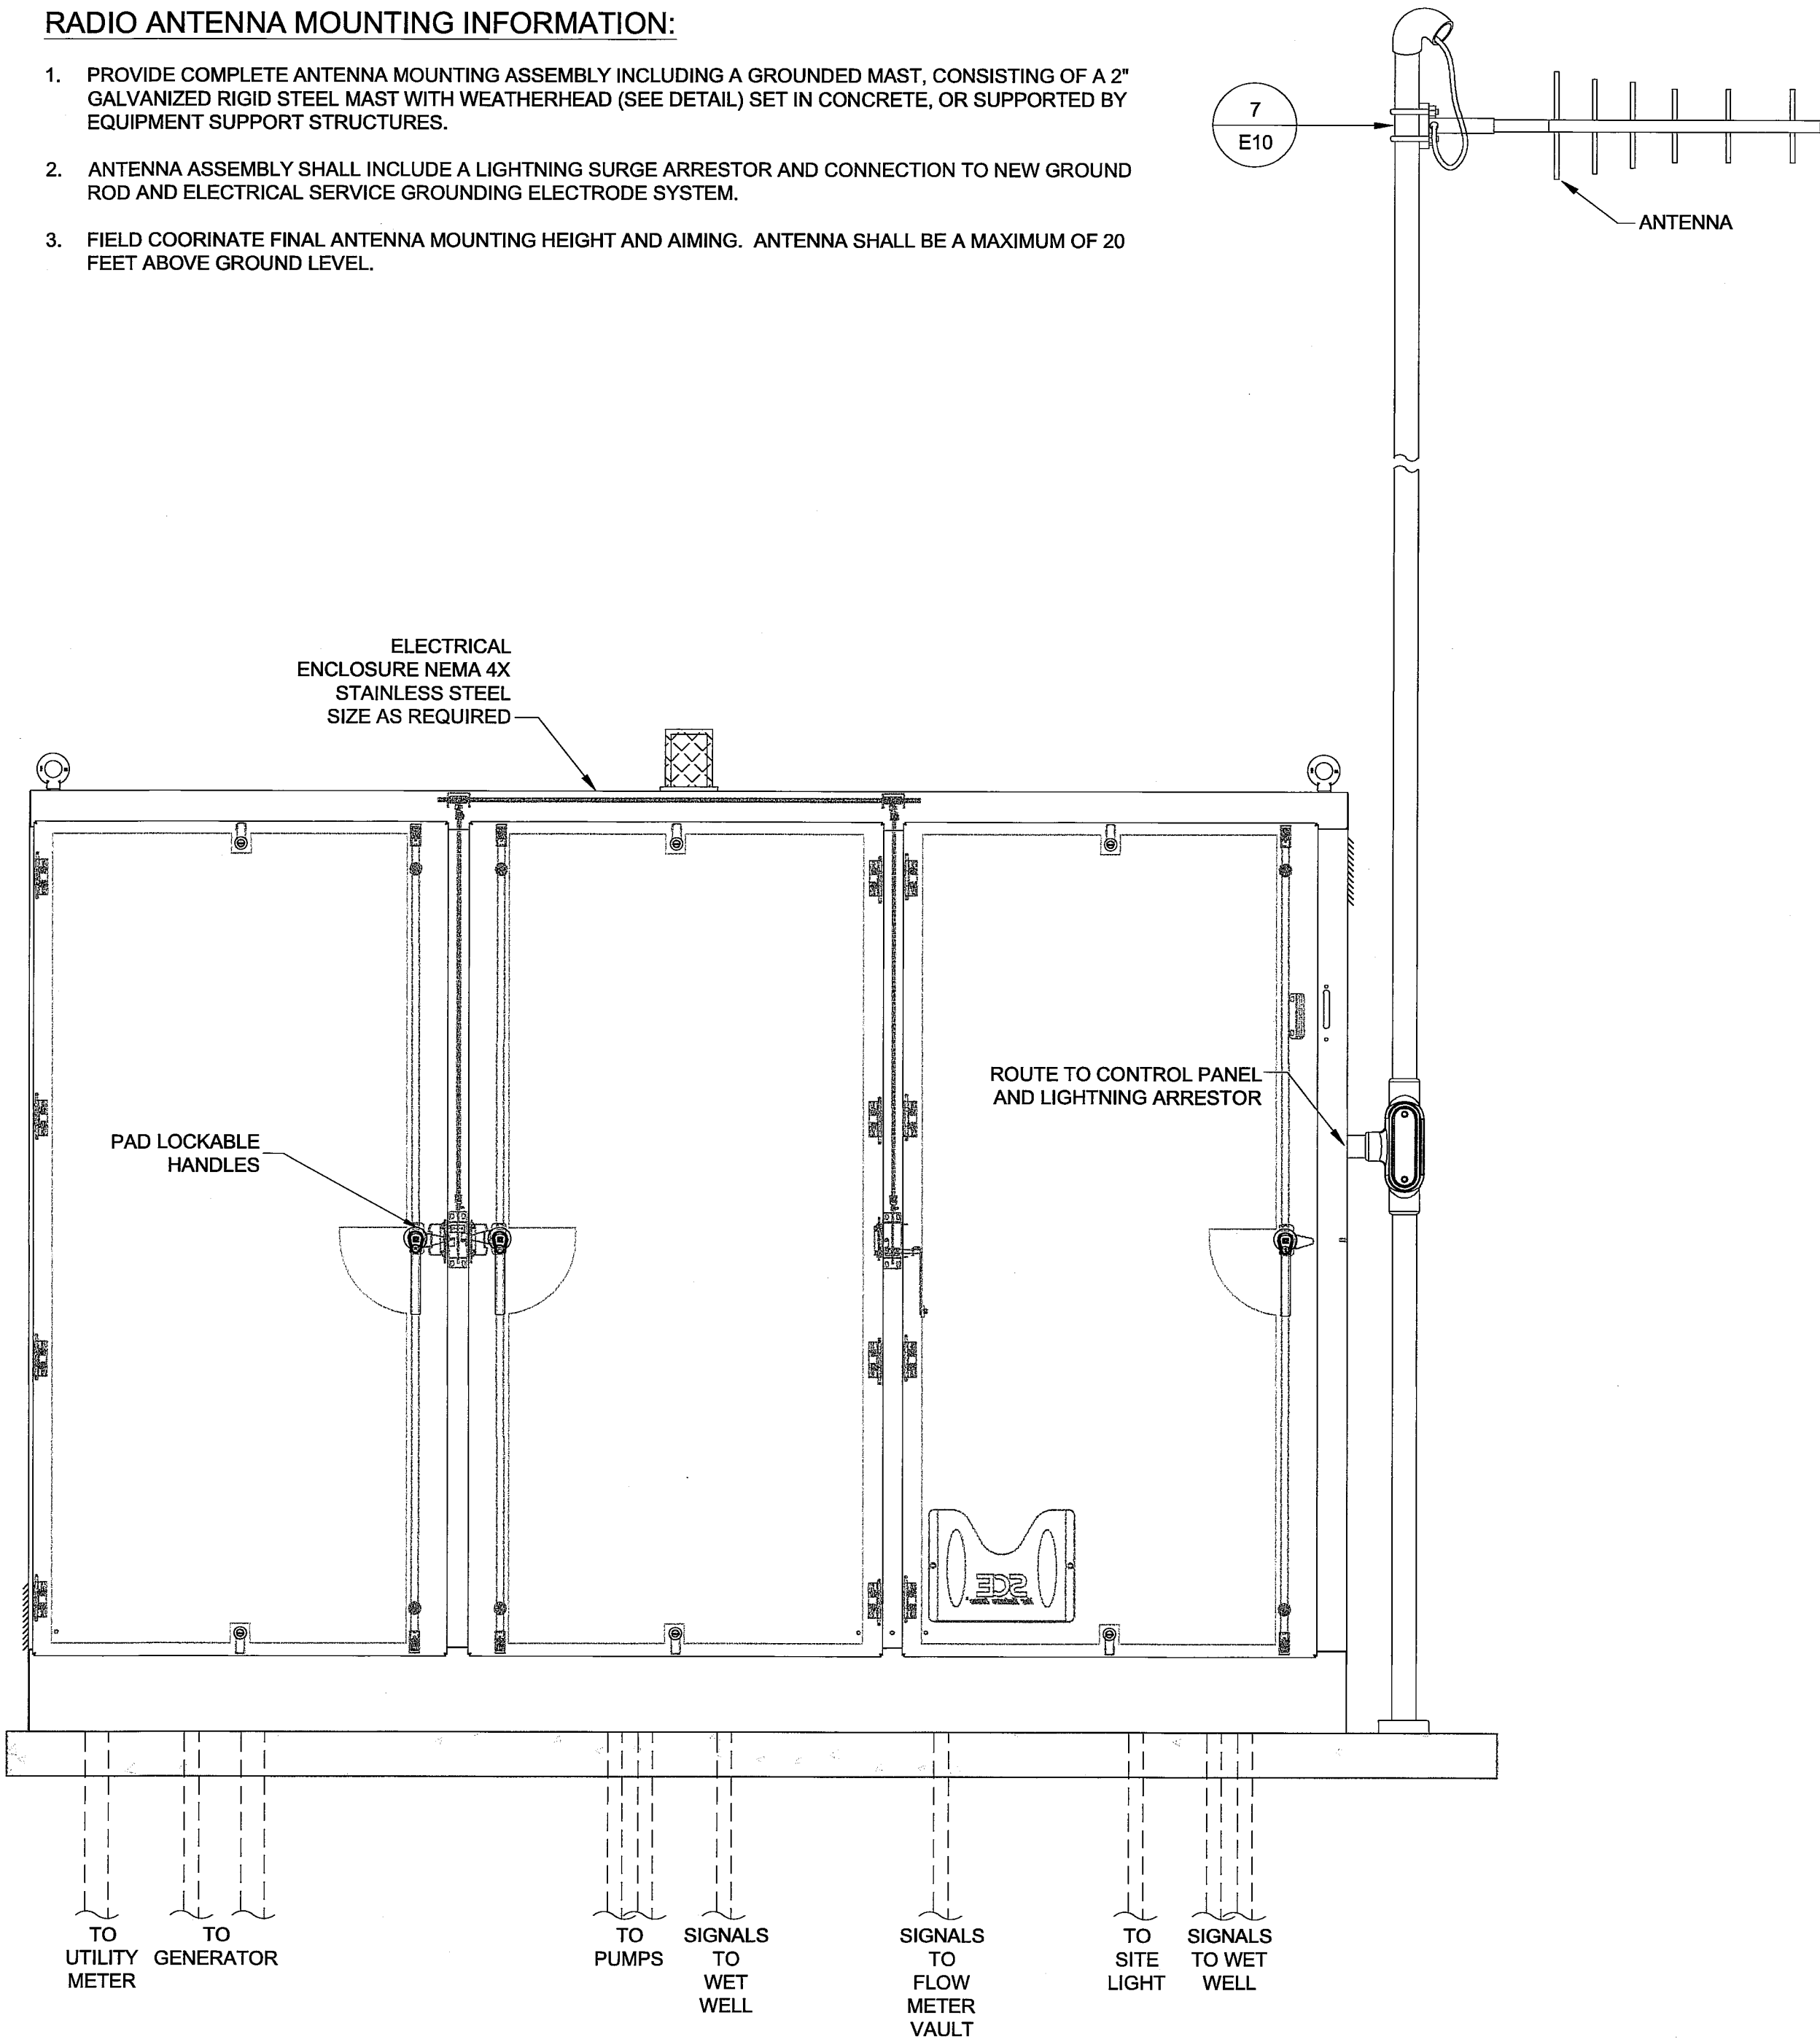

ELECTRICAL ENCLOSURE - EXTERIOR ELEVATION
SCALE: NONE

GENERAL NOTES:

1. THESE DRAWINGS SHOW ONLY FUNCTIONAL REQUIREMENTS OF THE ELECTRICAL ENCLOSURE AND CONTROL SYSTEM. DETAILED WIRING DIAGRAMS, PANEL SIZING AND LAYOUT, AND BILL OF MATERIALS ARE INCLUDED IN THE PROJECT O&M MANUAL PROVIDED BY PROCESS SOLUTION INC., PROJECT #Q647210.

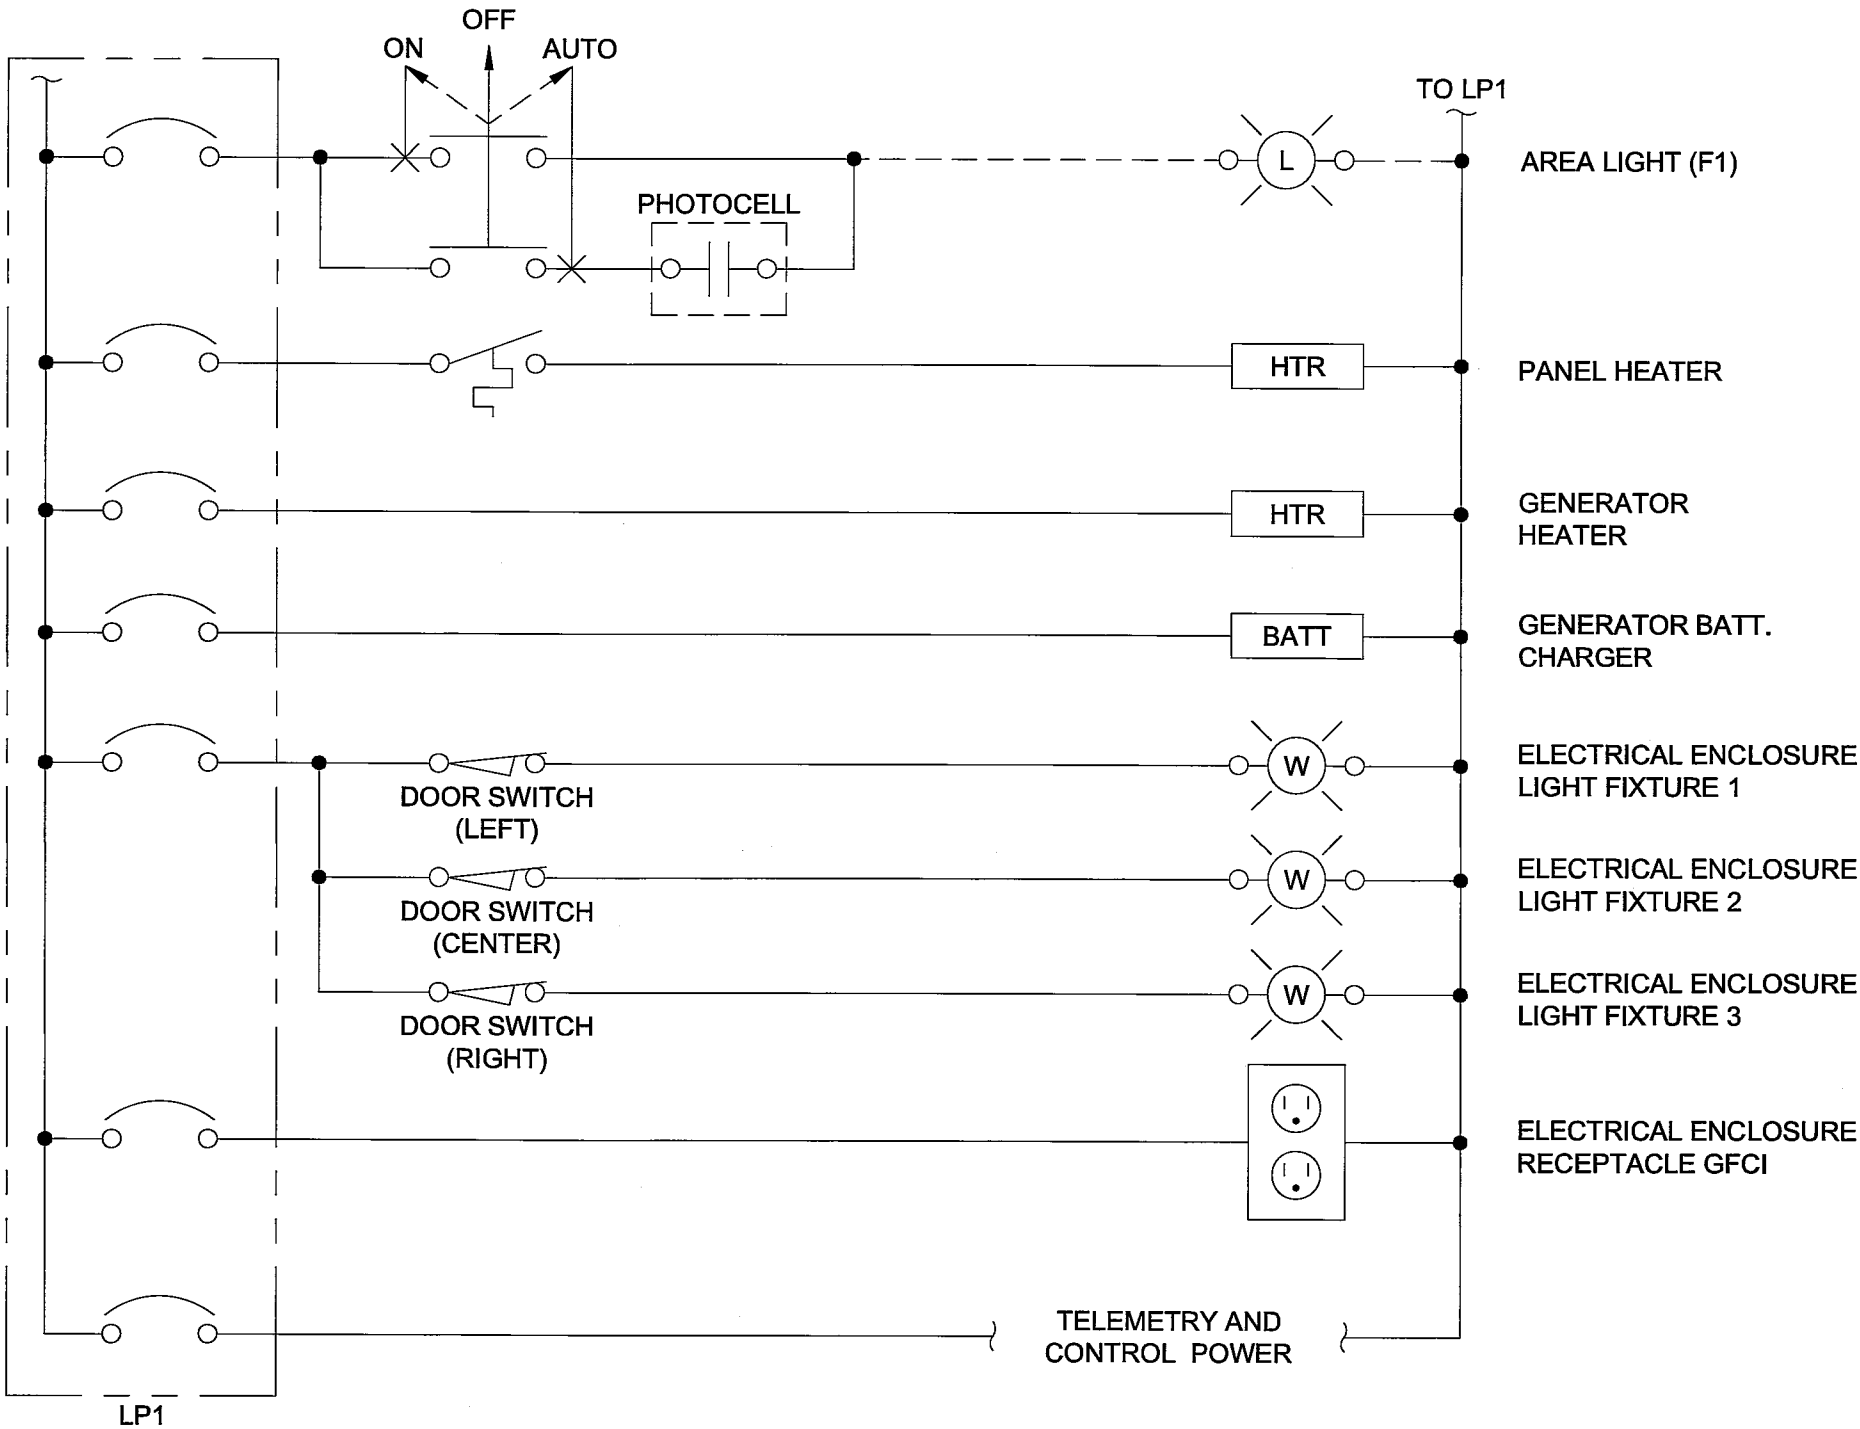

ELECTRICAL ENCLOSURE - WIRING DIAGRAM
SCALE: NONE



Z-engineers, PLLC
One Fifth Street, Ste 150
Wenatchee, WA 98801
Tel: 509.888.9364
Fax: 509.888.9365
www.z-engineers.com

NO.		REVISIONS		BY	DATE
0		RECORD DRAWINGS		BZ	01/27/16

WILSON ENGINEERING, LLC
805 DUPONT STREET
BELLINGHAM, WA 98225
(360) 733-6100 • FAX (360) 647-9061
www.wilsonengineering.com

Wilson
SURVEY/ENGINEERING

DESIGNED BY BZ	DRAWN BY CH	CHECKED BY BZ
-------------------	----------------	------------------

CITY OF FERNDALE

WHATCOM COUNTY

PUMP STATION NO. 4

ELECTRICAL ENCLOSURE ELEVATION

DATE 01/27/2016	SCALE AS SHOWN	JOB NUMBER 2013-037
--------------------	-------------------	------------------------


SHEET E5	OF	E11
-------------	----	-----

NO.	REVISIONS	BY	DATE
0	RECORD DRAWINGS	BZ	01/27/16

PANEL NAMEPLATE SCHEDULE			
LABEL	ENGRAVING TEXT	LABEL	ENGRAVING TEXT
N-1	CITY OF FERNDAL PUMP STATION NO.4	N-11	POWER STATUS (WHITE)
N-2	PUMP NO.1 HAND OFF AUTO	N-12	PUMP NO.2 HAND OFF AUTO
N-3	PUMP NO.1 RUNNING (GREEN)	N-13	PUMP NO.2 RUNNING (GREEN)
N-4	PUMP NO.1 FAIL (RED)	N-14	PUMP NO.2 FAIL (RED)
N-5	PUMP NO.1 OVERTEMP (RED)	N-15	PUMP NO.2 OVERTEMP (RED)
N-6	PUMP NO.1 SEAL FAIL (AMBER)	N-16	PUMP NO.2 SEAL FAIL (AMBER)
N-7	PUMP NO.1 RESET	N-17	PUMP NO.2 RESET
N-8	PUMP CONTROL / FLOAT - PLC	N-18	PUMP NO.2 AMMETER/SELECTOR
N-9	PUMP NO.1 AMMETER/SELECTOR	N-19	PUMP NO.2 ETM
N-10	PUMP NO.1 ETM	N-20	—

- KEY NOTES:
- 1 ALLEN BRADLEY PANELVIEW PLUS 6 700. OPERATOR INTERFACE PROGRAMMED BY CITY'S PROGRAMMER, L2 SYSTEMS, UNDER FORCE ACCOUNT. SEE SPECIFICATIONS.
 - 2 FLOW METER FM APPROVED FOR CLASS 1, DIV 2 HAZARDOUS AREA.
 - 3 WIRE ALL NEW INSTRUMENTATION TO INTRINSICALLY SAFE AREA IN ELECTRICAL ENCLOSURE AND TO TELEMETRY CONTROL PANEL.
 - 4 PROVIDE POWER DISTRIBUTION, STARTERS FOR DUPLEX PUMP CONTROL SYSTEM. PANEL BUILDER SHALL PROVIDE DETAILED DESIGN BASED ON FUNCTIONAL WIRING DIAGRAMS FOR A COMPLETE AND OPERATIONAL SYSTEM.

- GENERAL NOTES:
1. THESE DRAWINGS SHOW ONLY FUNCTIONAL REQUIREMENTS OF THE ELECTRICAL ENCLOSURE AND CONTROL SYSTEM. DETAILED WIRING DIAGRAMS, PANEL SIZING AND LAYOUT, AND BILL OF MATERIALS ARE INCLUDED IN THE PROJECT O&M MANUAL PROVIDED BY PROCESS SOLUTION INC., PROJECT #Q647210.

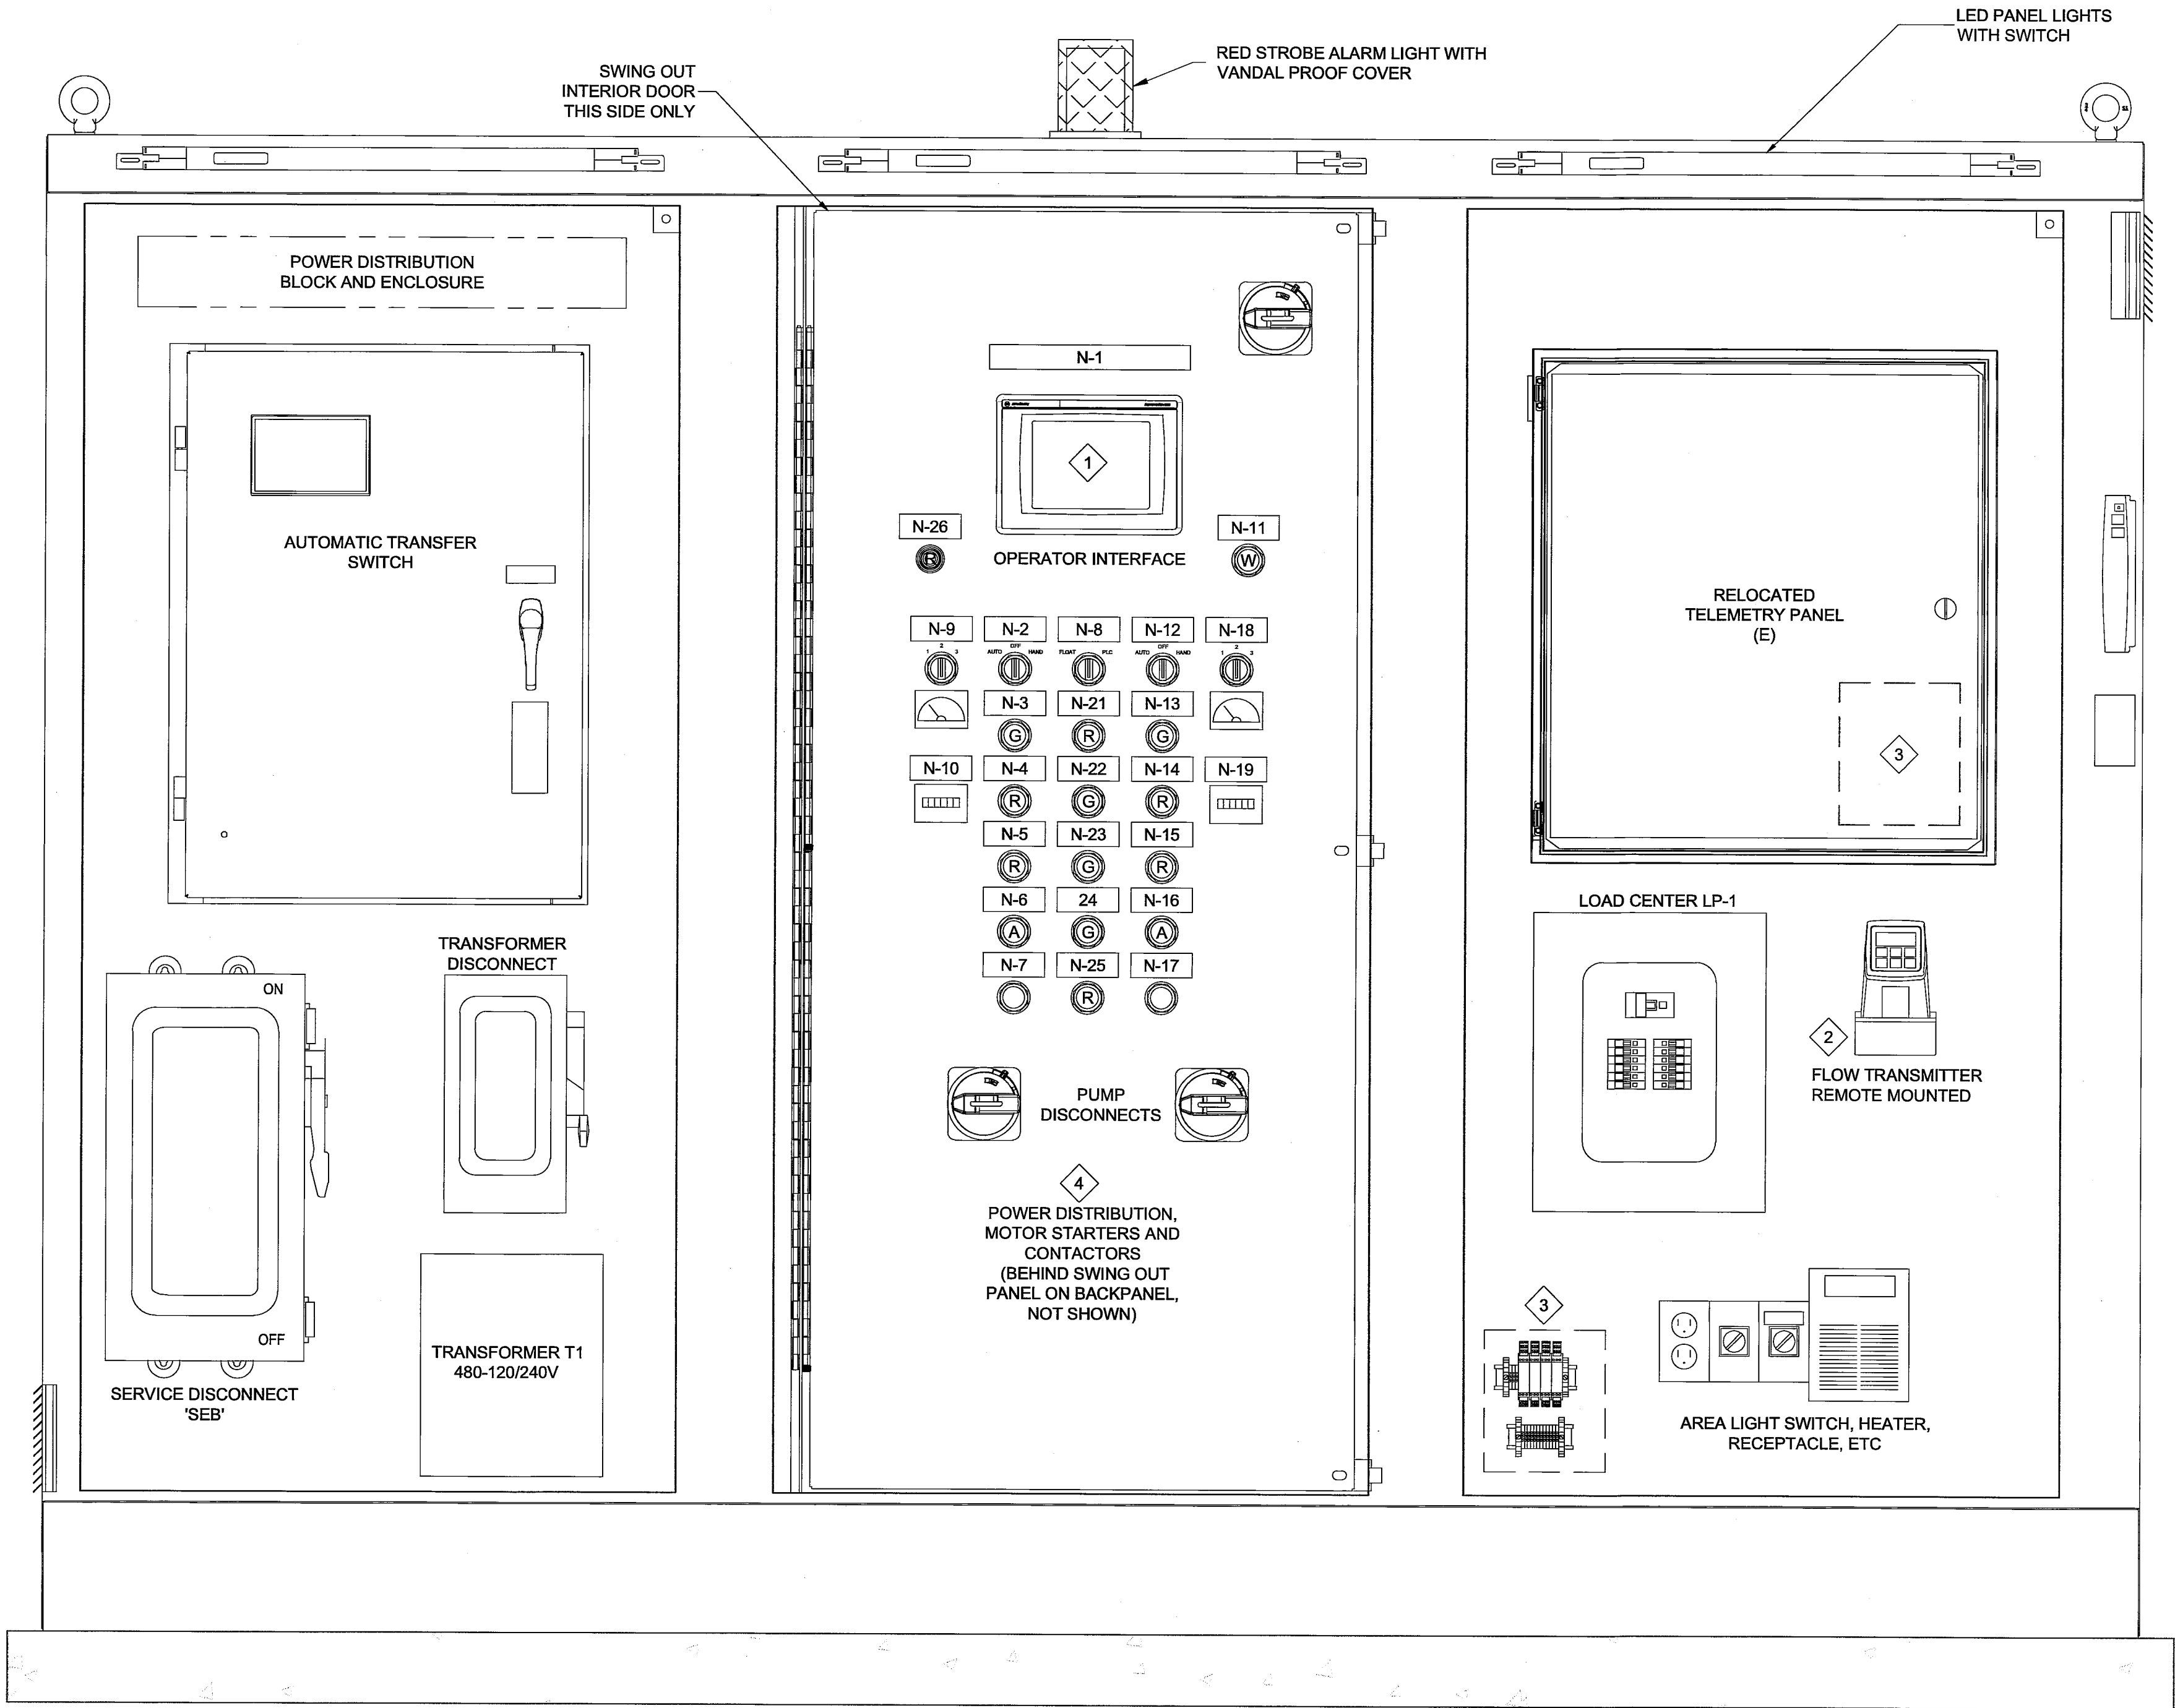

ELECTRICAL ENCLOSURE - ELEVATION
SCALE: NONE



Z Engineers, PLLC
One Fifth Street, Ste 150
Wenatchee, WA 98801
Tel: 509.888.9364
Fax: 509.888.9365
www.z-engineers.com



DESIGNED BY	BZ
DRAWN BY	CH
CHECKED BY	BZ

CITY OF FERNDAL	WHATCOM COUNTY	WASHINGTON
PUMP STATION NO. 4		
ELECTRICAL ENCLOSURE ELEVATION		

DATE	01/27/2016
SCALE	AS SHOWN
JOB NUMBER	2013-037

SHEET	E6	OF	E11
-------	----	----	-----


WILSON ENGINEERING, LLC
805 DUPONT STREET
BELLINGHAM, WA 98225
(360) 733-6100 • FAX (360) 647-9061
www.wilsonengineering.com

Wilson
SURVEY/ENGINEERING

NO.	REVISIONS	BY	DATE
0	RECORD DRAWINGS	BZ	01/27/16


GENERAL NOTES:

- THESE DRAWINGS SHOW ONLY FUNCTIONAL REQUIREMENTS OF THE ELECTRICAL ENCLOSURE AND CONTROL SYSTEM. DETAILED WIRING DIAGRAMS, PANEL SIZING AND LAYOUT, AND BILL OF MATERIALS ARE INCLUDED IN THE PROJECT O&M MANUAL PROVIDED BY PROCESS SOLUTION INC., PROJECT #Q647210.

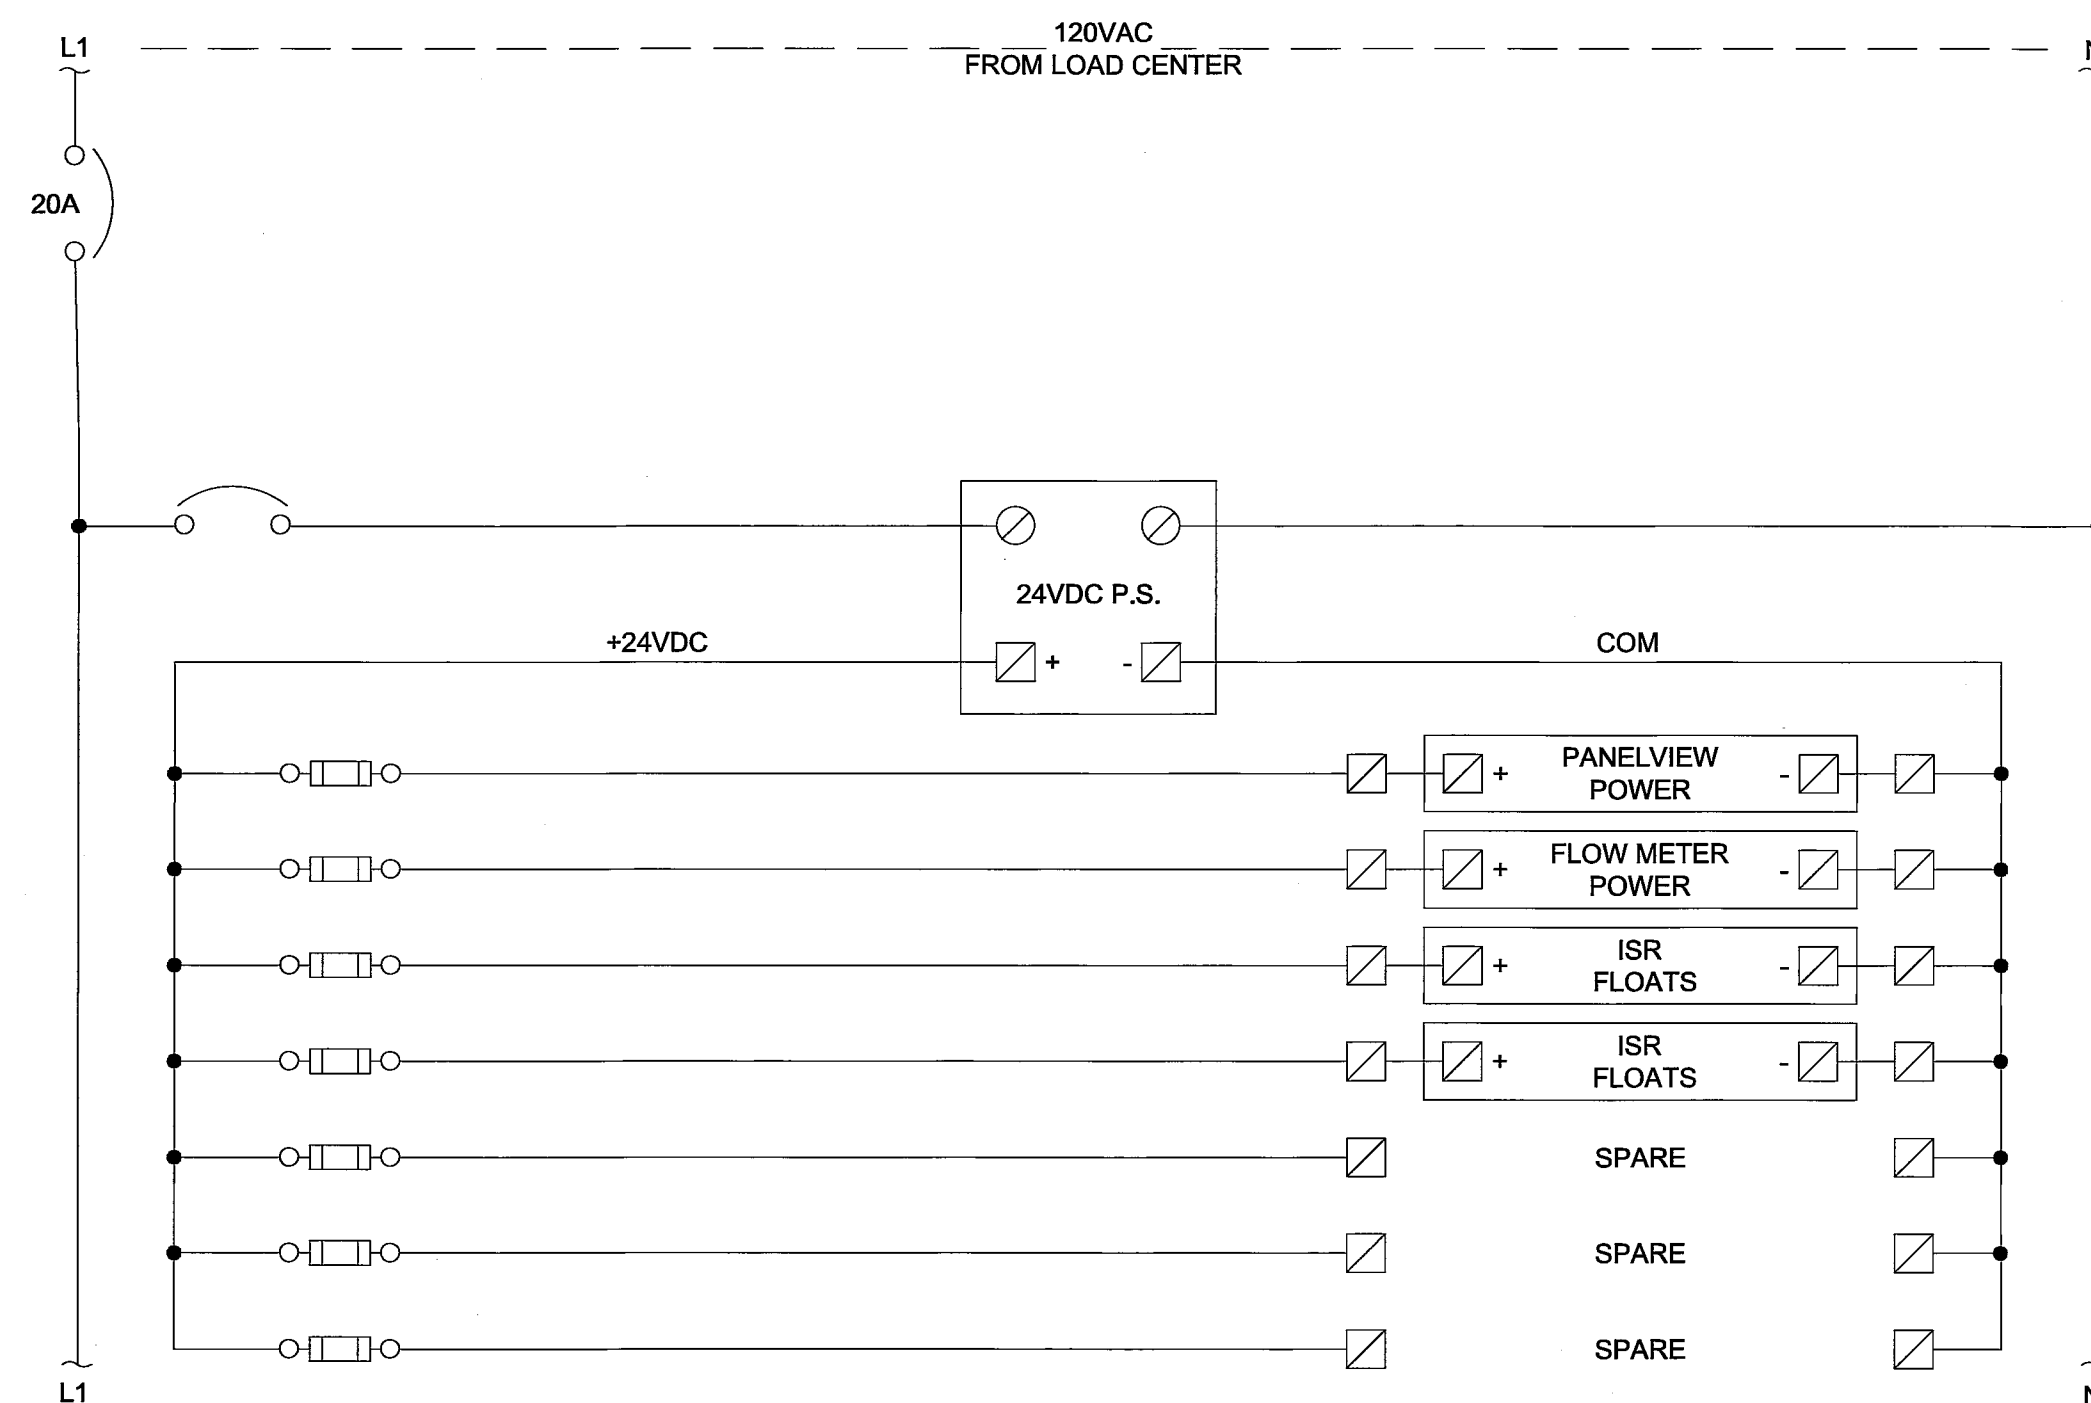


CONTROL POWER WIRING DIAGRAMS

SCALE: NONE

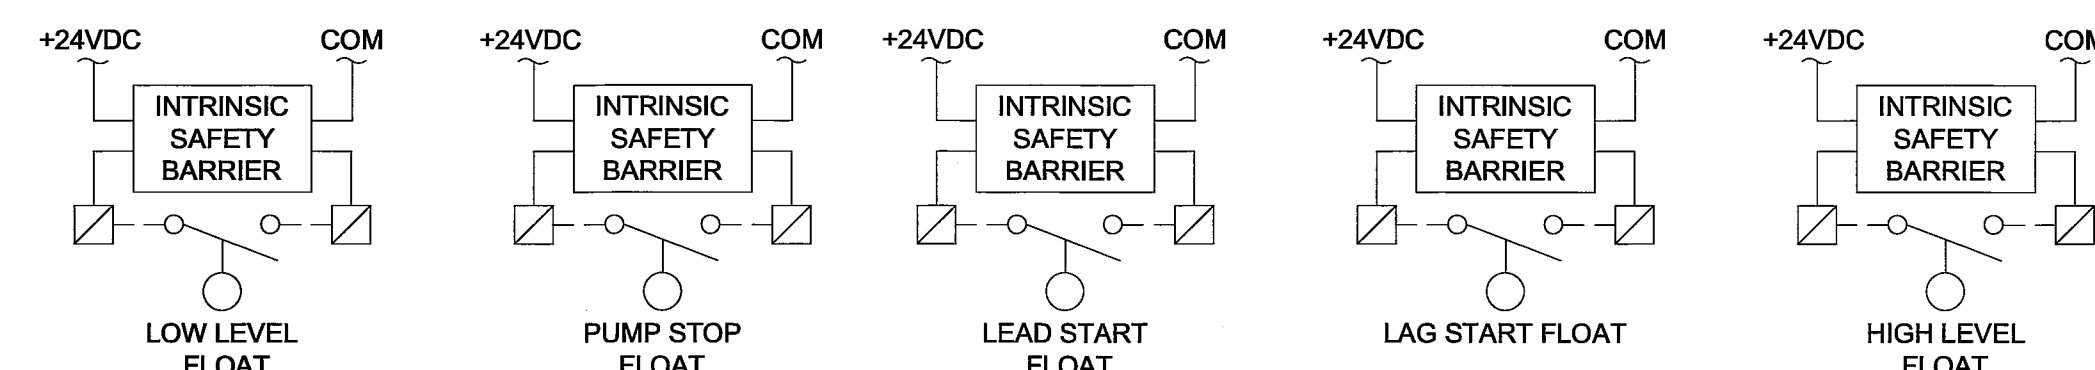

INTRINSICALLY SAFE FLOAT SWITCHES - WIRING DIAGRAM

SCALE: NONE

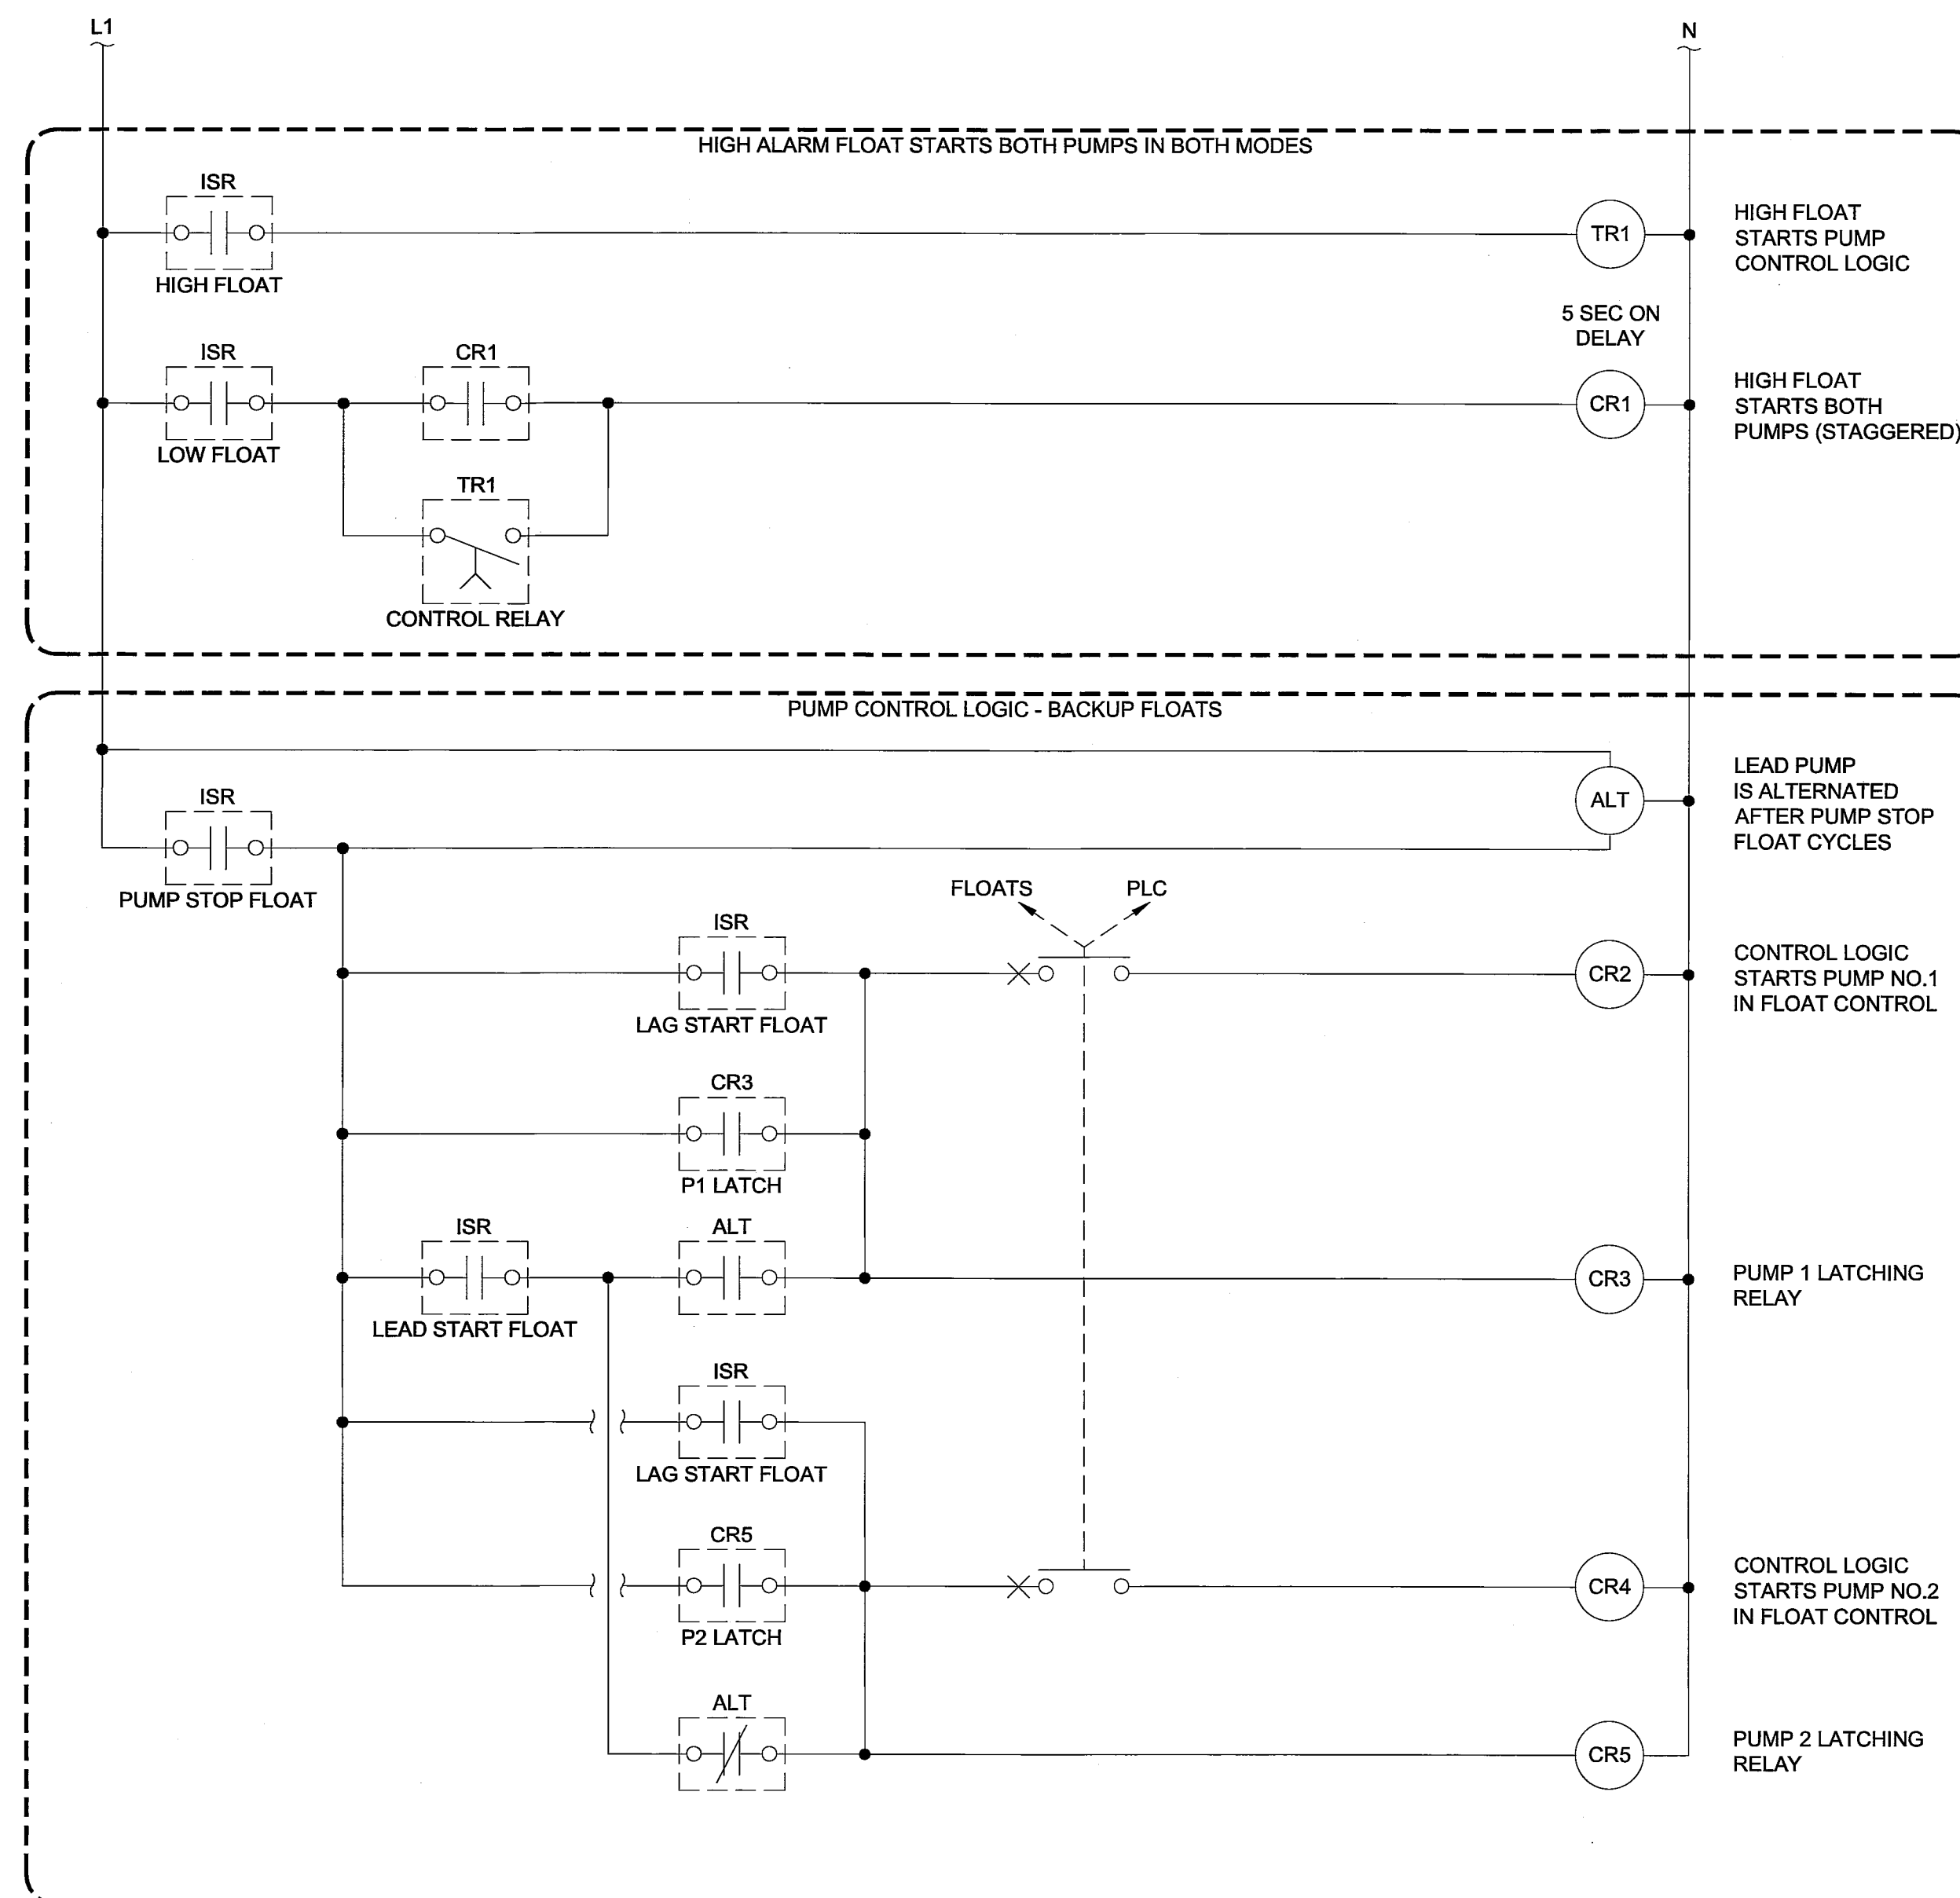

FLOAT CONTROL - WIRING DIAGRAM

SCALE: NONE



Zengineers, PLLC
One Fifth Street, Ste 150
Wenatchee, WA 98801
Tel: 509.888.9364
Fax: 509.888.9365
www.z-engineers.com

SHEET E7	OF E11	DATE 01/27/2016	SCALE AS SHOWN	JOB NUMBER 2013-037	
		CITY OF FERNDALE			
		PUMP STATION NO. 4			
		PUMP CONTROL WIRING DIAGRAMS			
DESIGNED BY BZ					
DRAWN BY GH					
CHECKED BY BZ					
WASHINGTON					
WHATCOM COUNTY					


WILSON ENGINEERING, LLC
805 DUPONT STREET
BELLINGHAM, WA 98225
(360) 733-6100 • FAX (360) 647-9061
www.wilsonengineering.com

Wilson
SURVEY/ENGINEERING

BRAD L. ZIESMER
PROFESSIONAL ENGINEER
37463
1-27-2016


00597.019 4/16/16

NO.	REVISIONS	BY	DATE
0	RECORD DRAWINGS	BZ	01/27/16

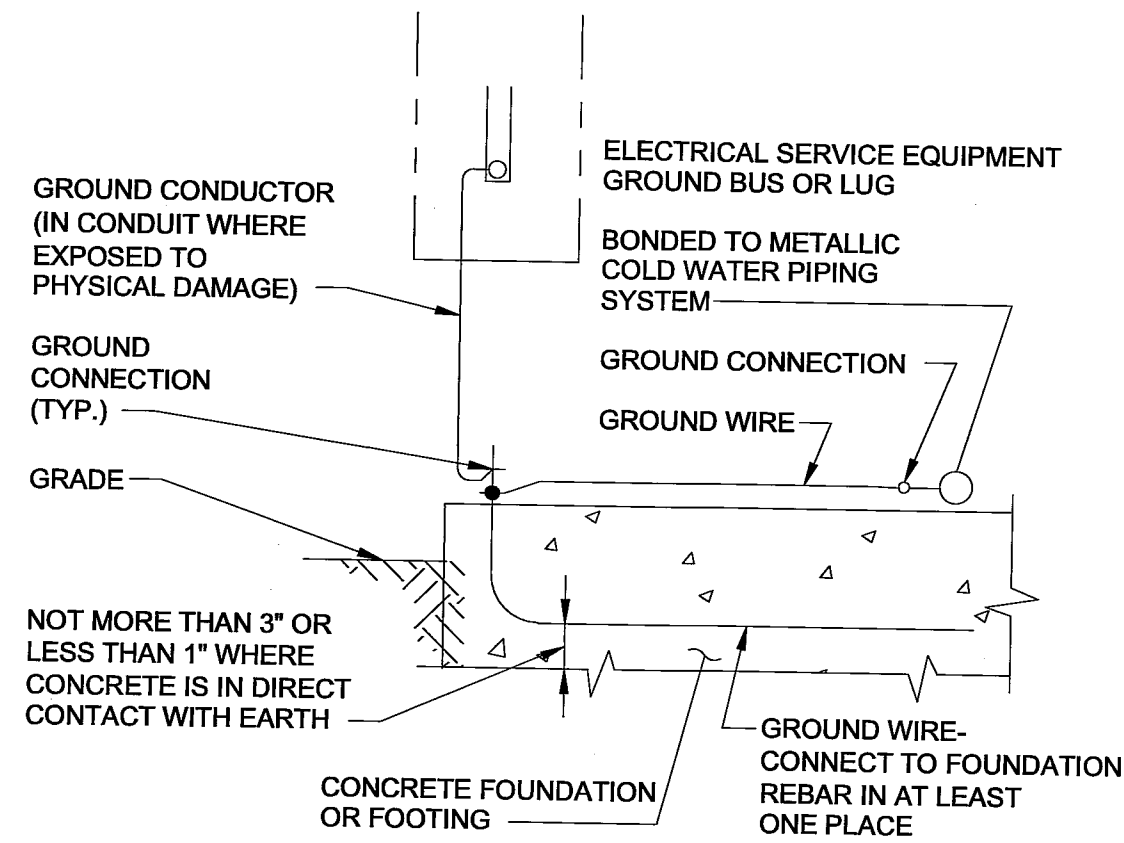

GENERAL NOTE: CONTRACTOR SHALL PROVIDE ALL REQUIRED GROUNDING AND BONDING TO MEET REQUIREMENTS OF NEC ARTICLE 250.


1 GROUNDING SYSTEM DETAIL
SCALE: NONE

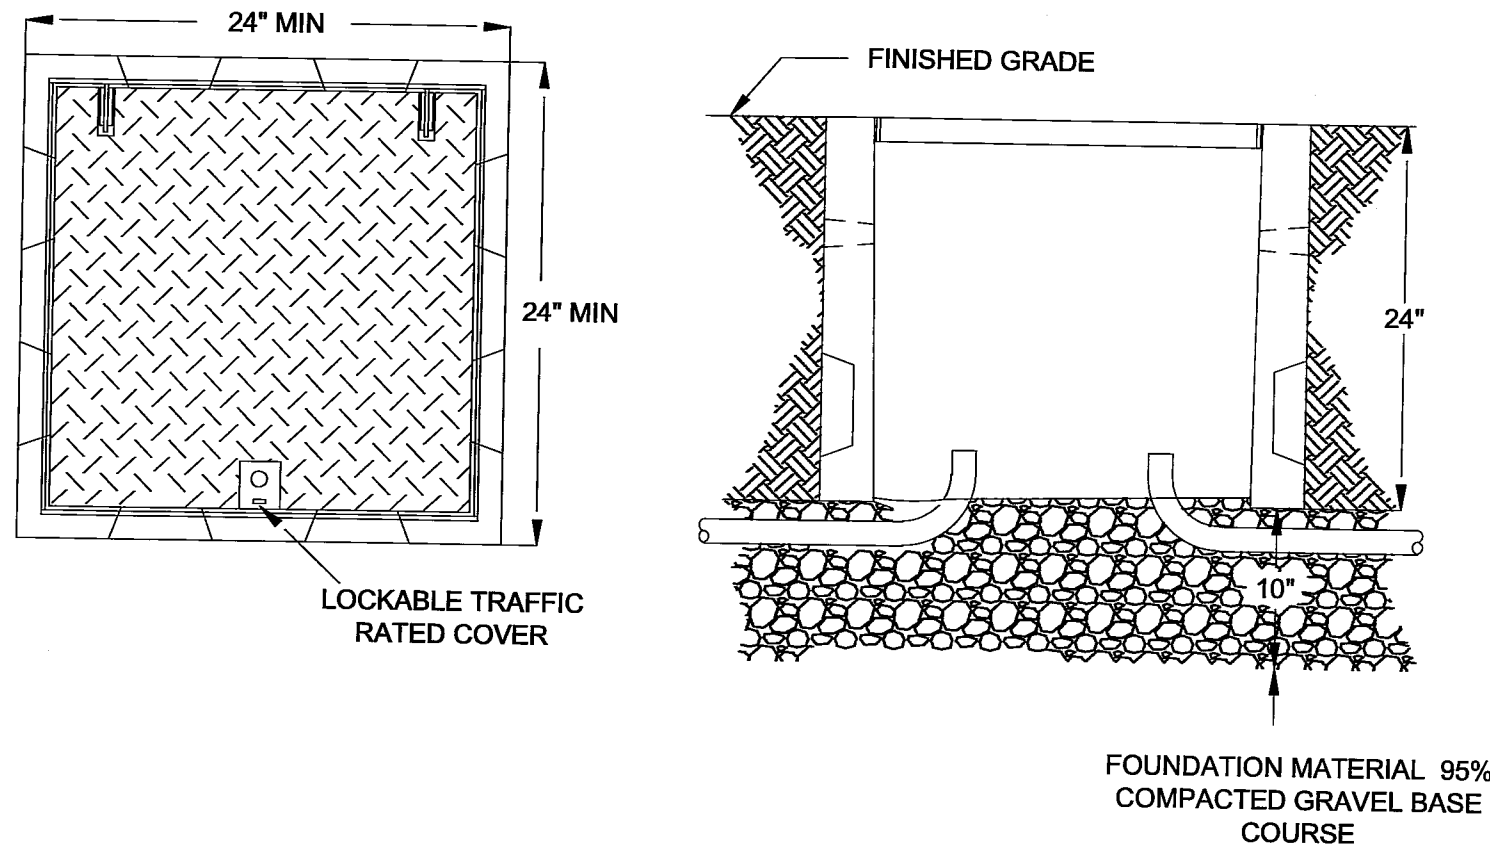


TYPICAL HANDHOLE PLAN
SCALE: NONE

TYPICAL HANDHOLE ELEVATION
SCALE: NONE


2 ELECTRICAL HANDHOLE DETAIL
SCALE: NONE

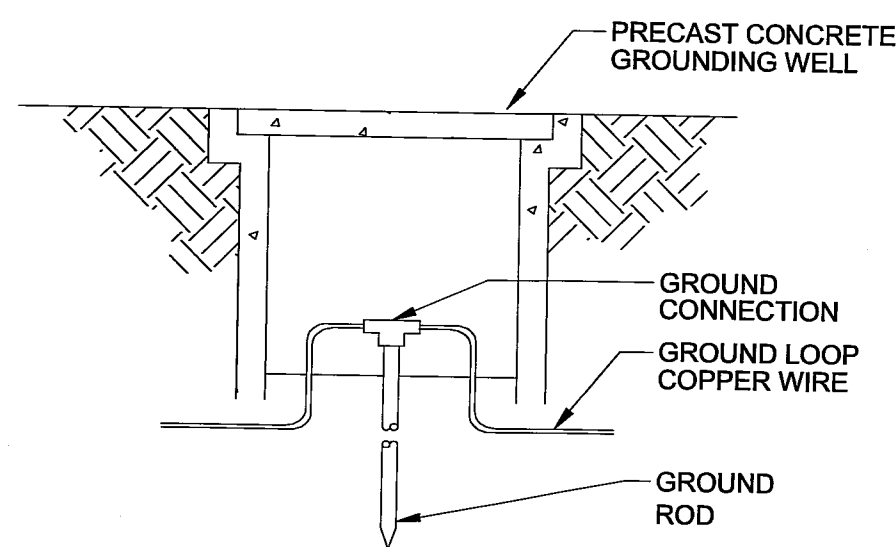

3 GROUND ROD DETAIL
SCALE: NONE

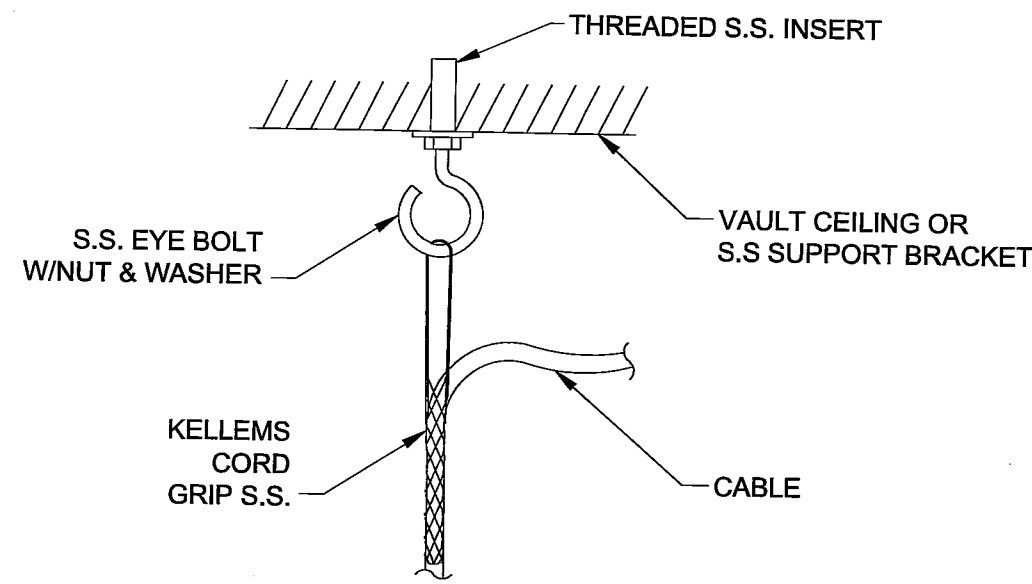


4 STRAIN RELIEF DETAIL
SCALE: NONE

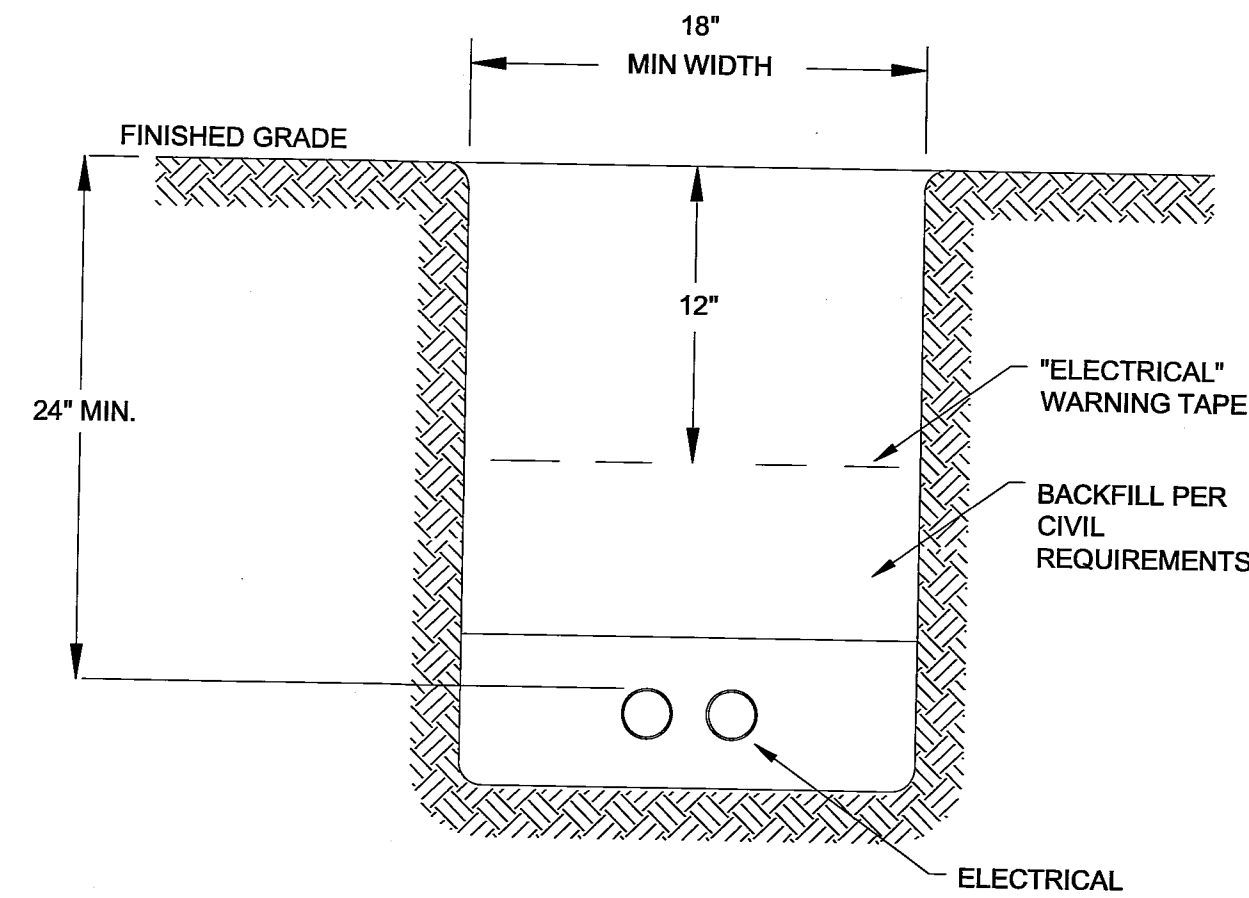


SECONDARY AND FEEDER RACEWAY
SCALE: NONE

- GENERAL NOTES:
1. MAINTAIN 12" MIN. SEPARATION BETWEEN WATER UTILITIES.
 2. PROVIDE 2" SEPARATION BETWEEN MULTIPLE CONDUITS AND NEAREST SIDEWALL.
 3. TRENCH WIDTH TO ACCOMMODATE ALL CONDUITS AND SERVICES. MINIMUM WIDTH 18".
 4. BACKFILL IN ACCORDANCE WITH UTILITY AND CIVIL STANDARDS.
 5. CONDUIT SHALL BE BEDDED W/SAND (3" BASE & 3" COVER MIN).


5 ELECTRICAL RACEWAY AND TRENCHING DETAILS
SCALE: NONE

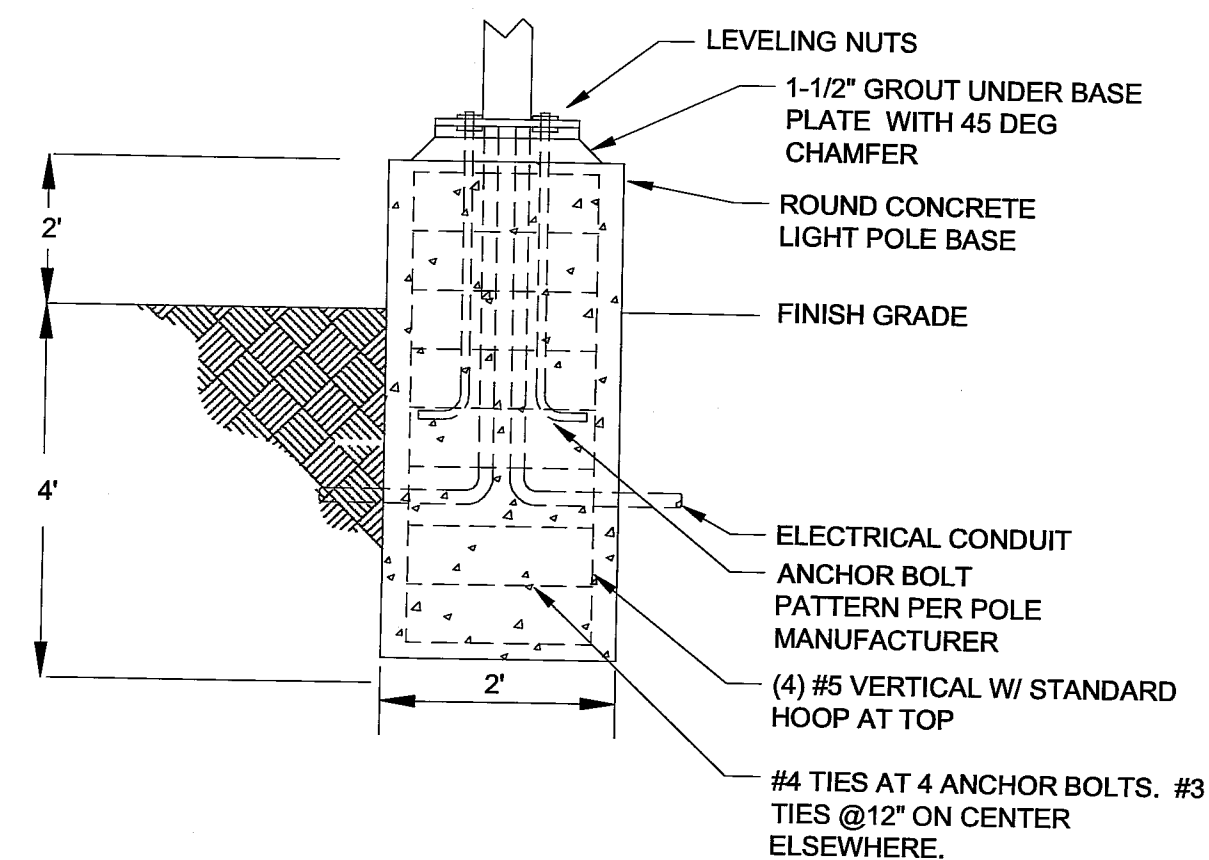

6 LIGHT POLE BASE DETAIL
SCALE: NONE

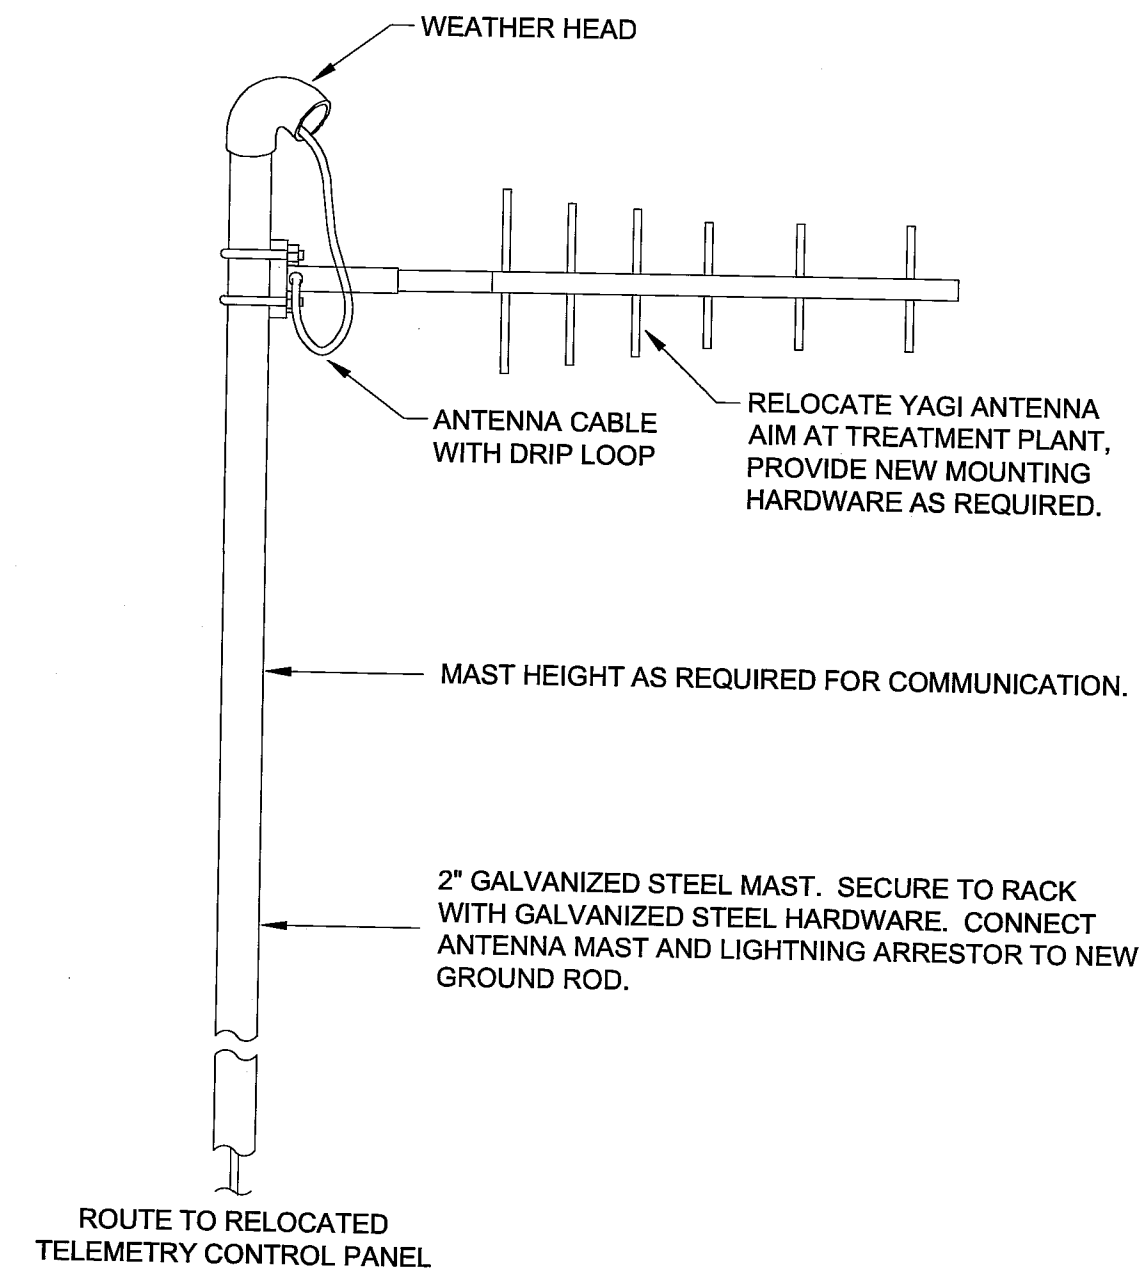

7 TELEMETRY ANTENNA MOUNTING DETAIL
SCALE: NONE

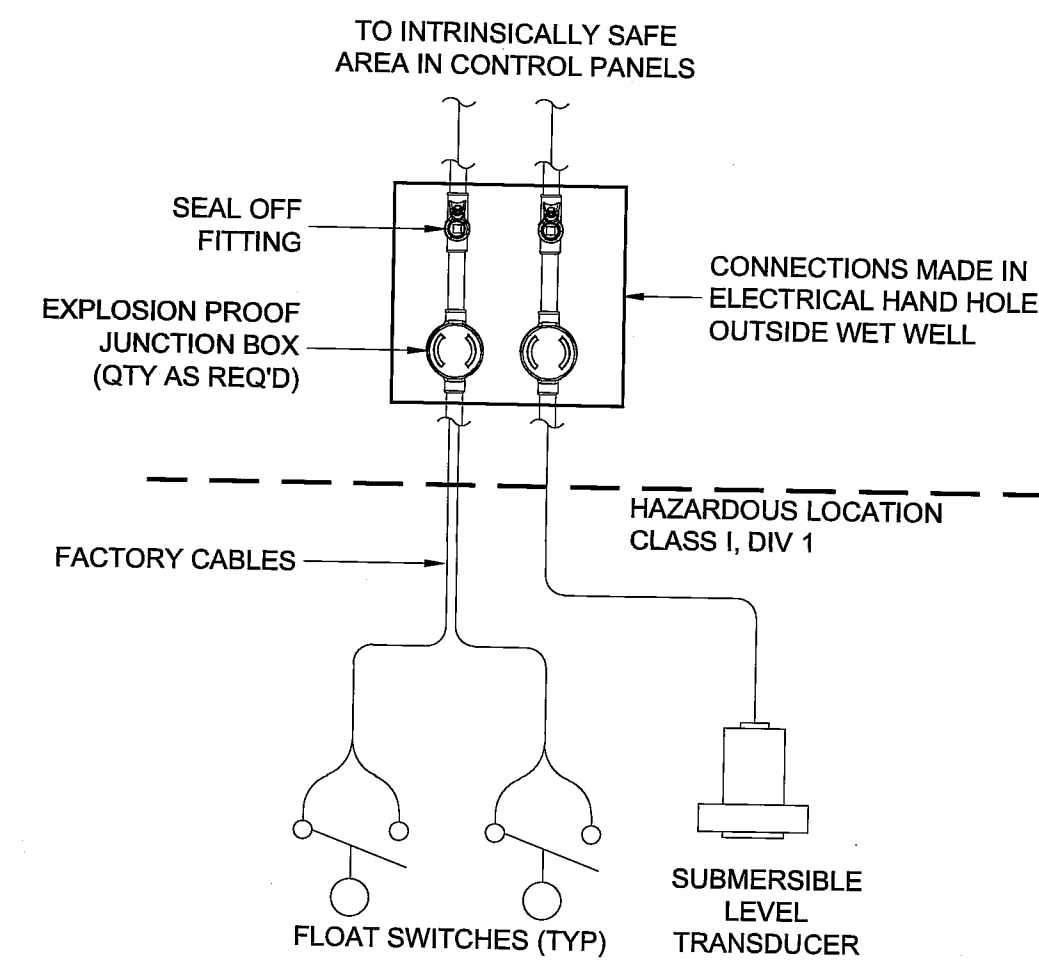


8 INTRINSICALLY SAFE RELAY CONNECTION DETAIL
SCALE: NONE



Z Engineers, PLLC
One Fifth Street, Ste 150
Wenatchee, WA 98801
Tel: 509.888.9364
Fax: 509.888.9365
www.z-engineers.com

WILSON ENGINEERING, LLC
805 DUPONT STREET
BELLINGHAM, WA 98225
(360) 733-6100 • FAX (360) 847-9061
www.wilsonengineering.com

Wilson
SURVEY/ENGINEERING

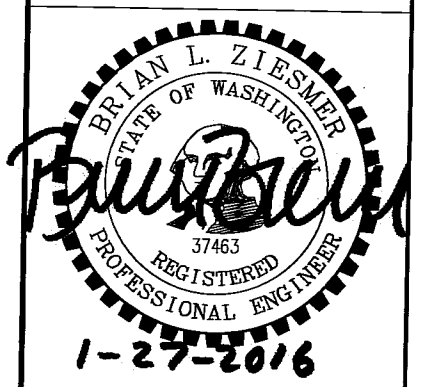

DESIGNED BY BZ
DRAWN BY CH
CHECKED BY BZ

CITY OF FERNDALE
WHATCOM COUNTY
WASHINGTON
ELECTPUMP STATION NO. 4
ELECTRICAL DETAILS

DATE 01/27/2016
SCALE AS SHOWN
JOB NUMBER 2013-037

SHEET E10 OF E11

00897.022 471654

NO.	REVISIONS	BY	DATE
0	RECORD DRAWINGS	BZ	01/27/16

ID	VOLTAGE	CONDUIT	WIRE QTY	SIZE	DESCRIPTION
P-SEB	480/277V	3"	4	#3/0 AWG	SECONDARY - METER BASE TO SERVICE DISCONNECT
P-GEN	480/277V	2"	4	#3/0 AWG	GENERATOR TO AUTOMATIC TRANSFER SWITCH
P-ATS	480/277V	2"	4	#3/0 AWG	SERVICE ENTRANCE BREAKER TO AUTOTRANSFER SWITCH
P-EE	480V	2"	3	#3/0 AWG	ELECTRICAL ENCLOSURE POWER
P-PCP	480V	2"	3	#3/0 AWG	PUMP CONTROL POWER
P-P1	480V	1-1/2"	3	#3 AWG	PUMP NO. 1 MOTOR LEADS
P-P2	480V	1-1/2"	3	#3 AWG	PUMP NO. 2 MOTOR LEADS
P-T1	480V	1/2"	2	#12 AWG	TRANSFORMER T1 POWER
P-GENP	120/240V	1"	4	#12 AWG	GENERATOR BLOCK HEATER/BATTERY CHARGER POWER
P-LT1	120/240V	1"	2	#12 AWG	AREA LIGHT POWER
P-LP1	120/240V	1"	3	#8 AWG	LIGHTING PANEL LP1 POWER
P-TEL	120/240V	1/2"	2	#12 AWG	TELEMETRY PANEL POWER
P-FM	24VDC	1/2"	2	#14 AWG	FLOW METER - REMOTE MOUNT POWER
C-ATS	24VDC	1"	8	#14 AWG	AUTOMATIC TRANSFER SWITCH/GENERATOR STATUS
C-GEN	24VDC	1"	10	#14 AWG	GENERATOR - RUNNING FAIL STATUS, GEN CONTROL, INTRUSION
C-TEL	24VDC	1"	AS REQ'D	#14 AWG	PUMP STATION DIGITAL I/O
S-FM	24VDC	1"	2	FC	FLOW METER - ELECTRODE AND COIL FACTORY CABLE
S-TEL	24VDC	1"	AS REQ'D	#18 TSP	PUMP STATION ANALOG I/O
S-WW1	24VDC	1"	1	#18 TSP	WET WELL LEVEL TRANSDUCER
S-WW2	24VDC	1"	6	#14 AWG	WET WELL FLOATS (BCKUP FLOAT CONTROL)
S-WW3	24VDC	1"	4	#14 AWG	WET WELL FLOATS (HIGH AND LOW LEVEL ALARM)
ANT	—	2"	1	COAX	TELEMETRY RADIO ANTENNA CABLE
ETH	—	1/2"	1	CAT 6	PANELVIEW COMMUNICATION CABLE
FIBER	—	2"	—	—	SPARE - (FUTURE FIBER)

*NOTE: PROVIDE EQUIPMENT GROUNDING PER NEC 250.

CONDUIT SCHEDULE

SCALE: NONE

LIGHTING SCHEDULE							
ID	DESCRIPTION	MOUNTING	LAMPS	VOLTAGE	LUMENS	WATTS	MANUFACTURER
F1	AREA LIGHT, POLE MOUNT	10' POLE	60 LED	120	14,461	134	LITHONIA CSX1 LED, OR EQUAL

LIGHTING SCHEDULE


SCALE: NONE

PANEL: LP1				PANEL SCHEDULE						PROJECT: City Of Ferndale Pump Station No.4			
120/240V, 1Ph, 3W.				100A Bus			40A M.C.B.			SURFACE MOUNTED			
CKT NO	DESCRIPTION / LOCATION	LOAD (VA)	LOAD TYPE	C.B. AMP	C.B. POLE	PHASE	C.B. POLE	C.B. AMP	LOAD TYPE	LOAD (VA)	DESCRIPTION / LOCATION	CKT NO	
1	RECEPTACLE - PANEL MOUNT	180	R	20	1	A	1	20	H	1,000	GENERATOR - BATTERY CHARGER	2	
3	PANEL HEATER	250	H	20	1	B	1	20	G	1,500	GENERATOR - COOLANT HEATER	4	
5	PANEL LIGHTING	64	L	20	1	A	1	20	L	500	SITE LIGHTING	6	
7	PUMP CONTROL	1,000	C	20	1	B	1	20			SPARE	8	
9	SPARE			20	1	A	1	20			SPARE	10	
11	SPARE			20	1	B					SPACE	12	
13	SPACE					A					SPACE	14	
15	SPACE					B					SPACE	16	
TOTAL CONNECTED LOAD:		PH A	1,744 VA	14.5 AMPS		DATE: April 16, 2015							
TOTAL CONNECTED LOAD:		PH B	2,750 VA	22.9 AMPS									
MAX PHASE CONNECTED LOAD:		PH B	2,750 VA			PANEL RATING:		10,000 AIC					
TOTAL CONNECTED LOAD (2 x MAX):			5.5 kVA	22.9 AMPS		TOTAL DEMAND LOAD:		4.9 kVA		20.4 AMPS			
		CONNECTED LOADS	SUBFED LOADS [S]	TOTAL LOADS	DEMAND FACTOR	DEMAND LOAD							
G	GENERAL (NON-CONTINUOUS)	1,500 VA	0 VA	1,500 VA	100%	1,500 VA							
L	LIGHTING	564 VA	0 VA	564 VA	125%	705 VA							
R	RECEPTACLES - UP TO 10 KVA	180 VA	0 VA	180 VA	100%	180 VA							
	OVER 10 KVA		0 VA	0 VA	50%	0 VA							
K	KITCHEN	0 VA	0 VA	0 VA	100%	0 VA							
H	HEATING	1,250 VA	0 VA	1,250 VA	100%	1,250 VA							
M	MOTORS	0 VA	0 VA	0 VA	100%	0 VA							
LM	LARGEST MOTOR	0 VA	0 VA	0 VA	125%	0 VA							
WH	WATER HEATER	0 VA	0 VA	0 VA	100%	0 VA							
C	CONTINUOUS (GENERAL LOAD)	1,000 VA	0 VA	1,000 VA	125%	1,250 VA							
N	NON-COINCIDENT	0 VA	0 VA	0 VA	0%	0 VA							
TOTAL:		4,494 VA	0 VA	4,494 VA		4,885 VA							

LIGHTING PANEL SCHEDULE

SCALE: NONE

WILSON ENGINEERING, LLC
805 DUPONT STREET
BELLINGHAM, WA 98225
(360) 733-6100 • FAX (360) 647-9061
www.wilsonengineering.com

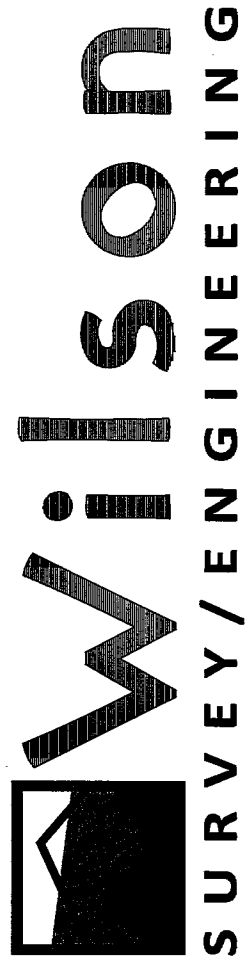

DESIGNED BY BZ
DRAWN BY CH
CHECKED BY BZ

CITY OF FERNDAL

WASHINGTON
WHATCOM COUNTY
ELECTPUMP STATION NO. 4
ELECTRICAL SCHEDULES

DATE 01/27/2016
SCALE AS SHOWN
JOB NUMBER 2013-037

SHEET E11 OF E11



Z Engineers, PLLC
One Fifth Street, Ste 150
Wenatchee, WA 98801
Tel: 509.888.9364
Fax: 509.888.9365
www.z-engineers.com

0597.023 47116 ST