

VANDERYACHT PARK

CITY OF FERNDALE



LEGEND

	= FOUND SURVEY MON. (PER. AF# 930806011)
	= FOUND REBAR/CAP #18927
	= FOUND REBAR/CAP (UNDERHILL)
	= EXIST CATCH BASIN
	= EXIST WATER FAUCET
	= EXIST TELEPHONE POLE
	= EXIST POWER POLE W/LIGHT
	= EXIST GUY WIRE ANCHOR
	= EXIST OVERHEAD POWER
	= EXIST STORM DRAIN PIPE
	= EXIST CONTOUR
	= 1/4 COR.
	= EXIST POPLAR TREE
	= EXIST FIR TREE
	= EXIST CULVERT
	= EXIST GATE
	= PROP. STORM DRAIN PIPE
	= PROP. CATCH BASIN
	= FINISHED GROUND SPOT ELEV.
	= PROP. 5 FT CONTOUR
	= PROP. EDGE OF GRAVEL

SHEET INDEX

- 1.) COVER SHEET
- 2.) POND SITE PLAN
- 3.) STORM DRAIN PLAN & PROFILE
- 4.) DETAIL SHEET

VICINITY MAP

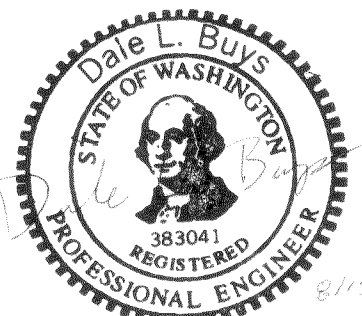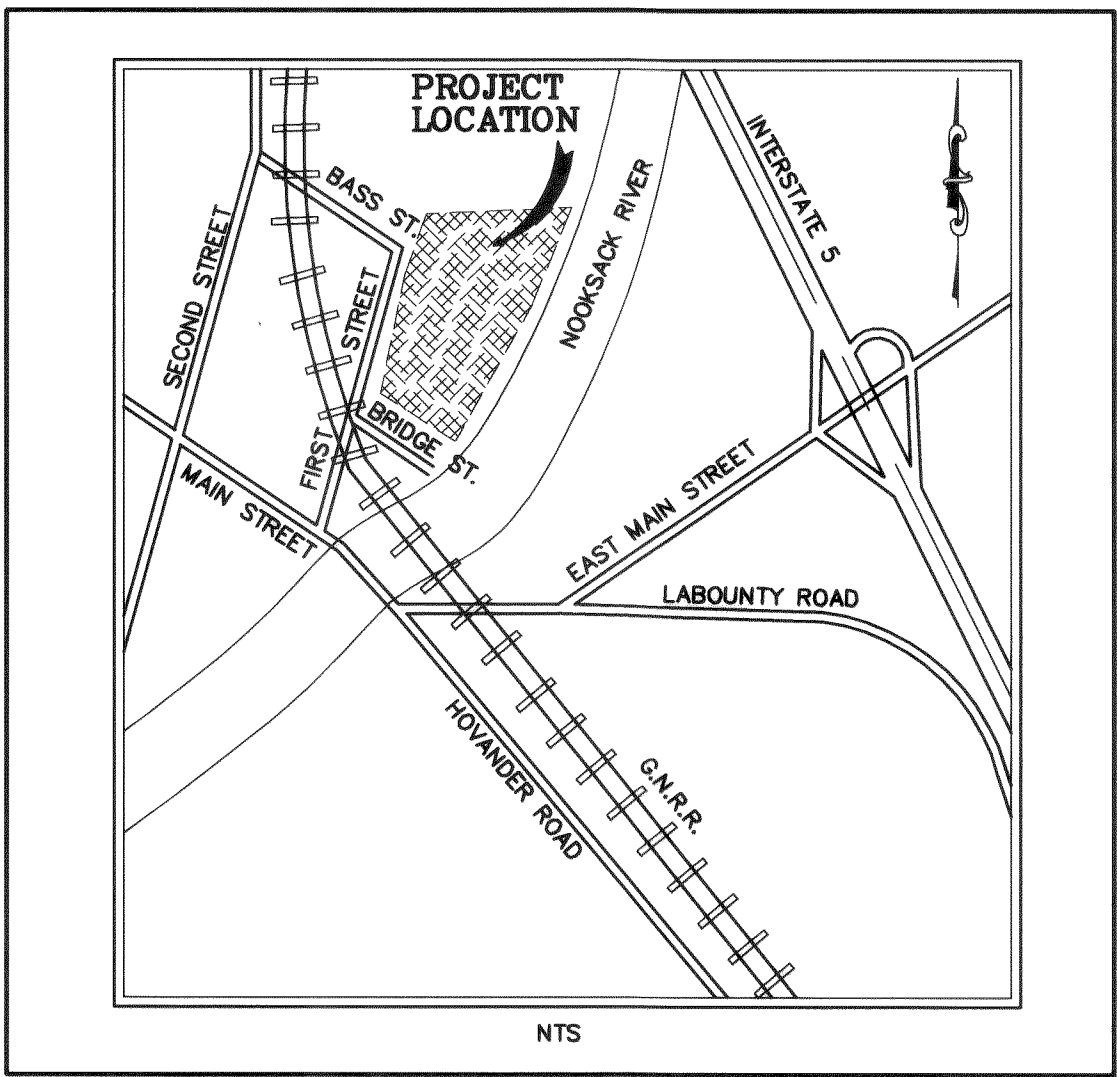

I hereby certify that the improvements in Vanderyacht Park have been inspected by Reichhardt and Ebe Engineering, Inc. and constructed in conformance with the plans approved by the Public Works Director for said development and the general specifications adopted by the City of Ferndale Department of Public Works.

APPROVED
OCT 1, 2002
BY *[Signature]*
CITY OF FERNDALE

DATE: 8-15-02
AS-BUILT


DESIGNED BY DLB		REICHHARDT & EBE ENGINEERING, INC. CONSULTING ENGINEERS PO Box 978 423 Front St., Ste 201 Lynden, Washington 98264	Ph (360) 354-3687 Fax (360) 354-0407
DRAWN BY LMC			
CHECKED BY GOE			

NO.	DATE	REVISION	BY






CITY OF FERNDALE
2095 MAIN STREET
FERNDALE, WA 98248

VANDERYACHT PARK
COVER SHEET


JOB# / DWG 8074	8074SP5	DATE 8-27-01
SCALE H: N/A	V: N/A	SHEET 1 of 4

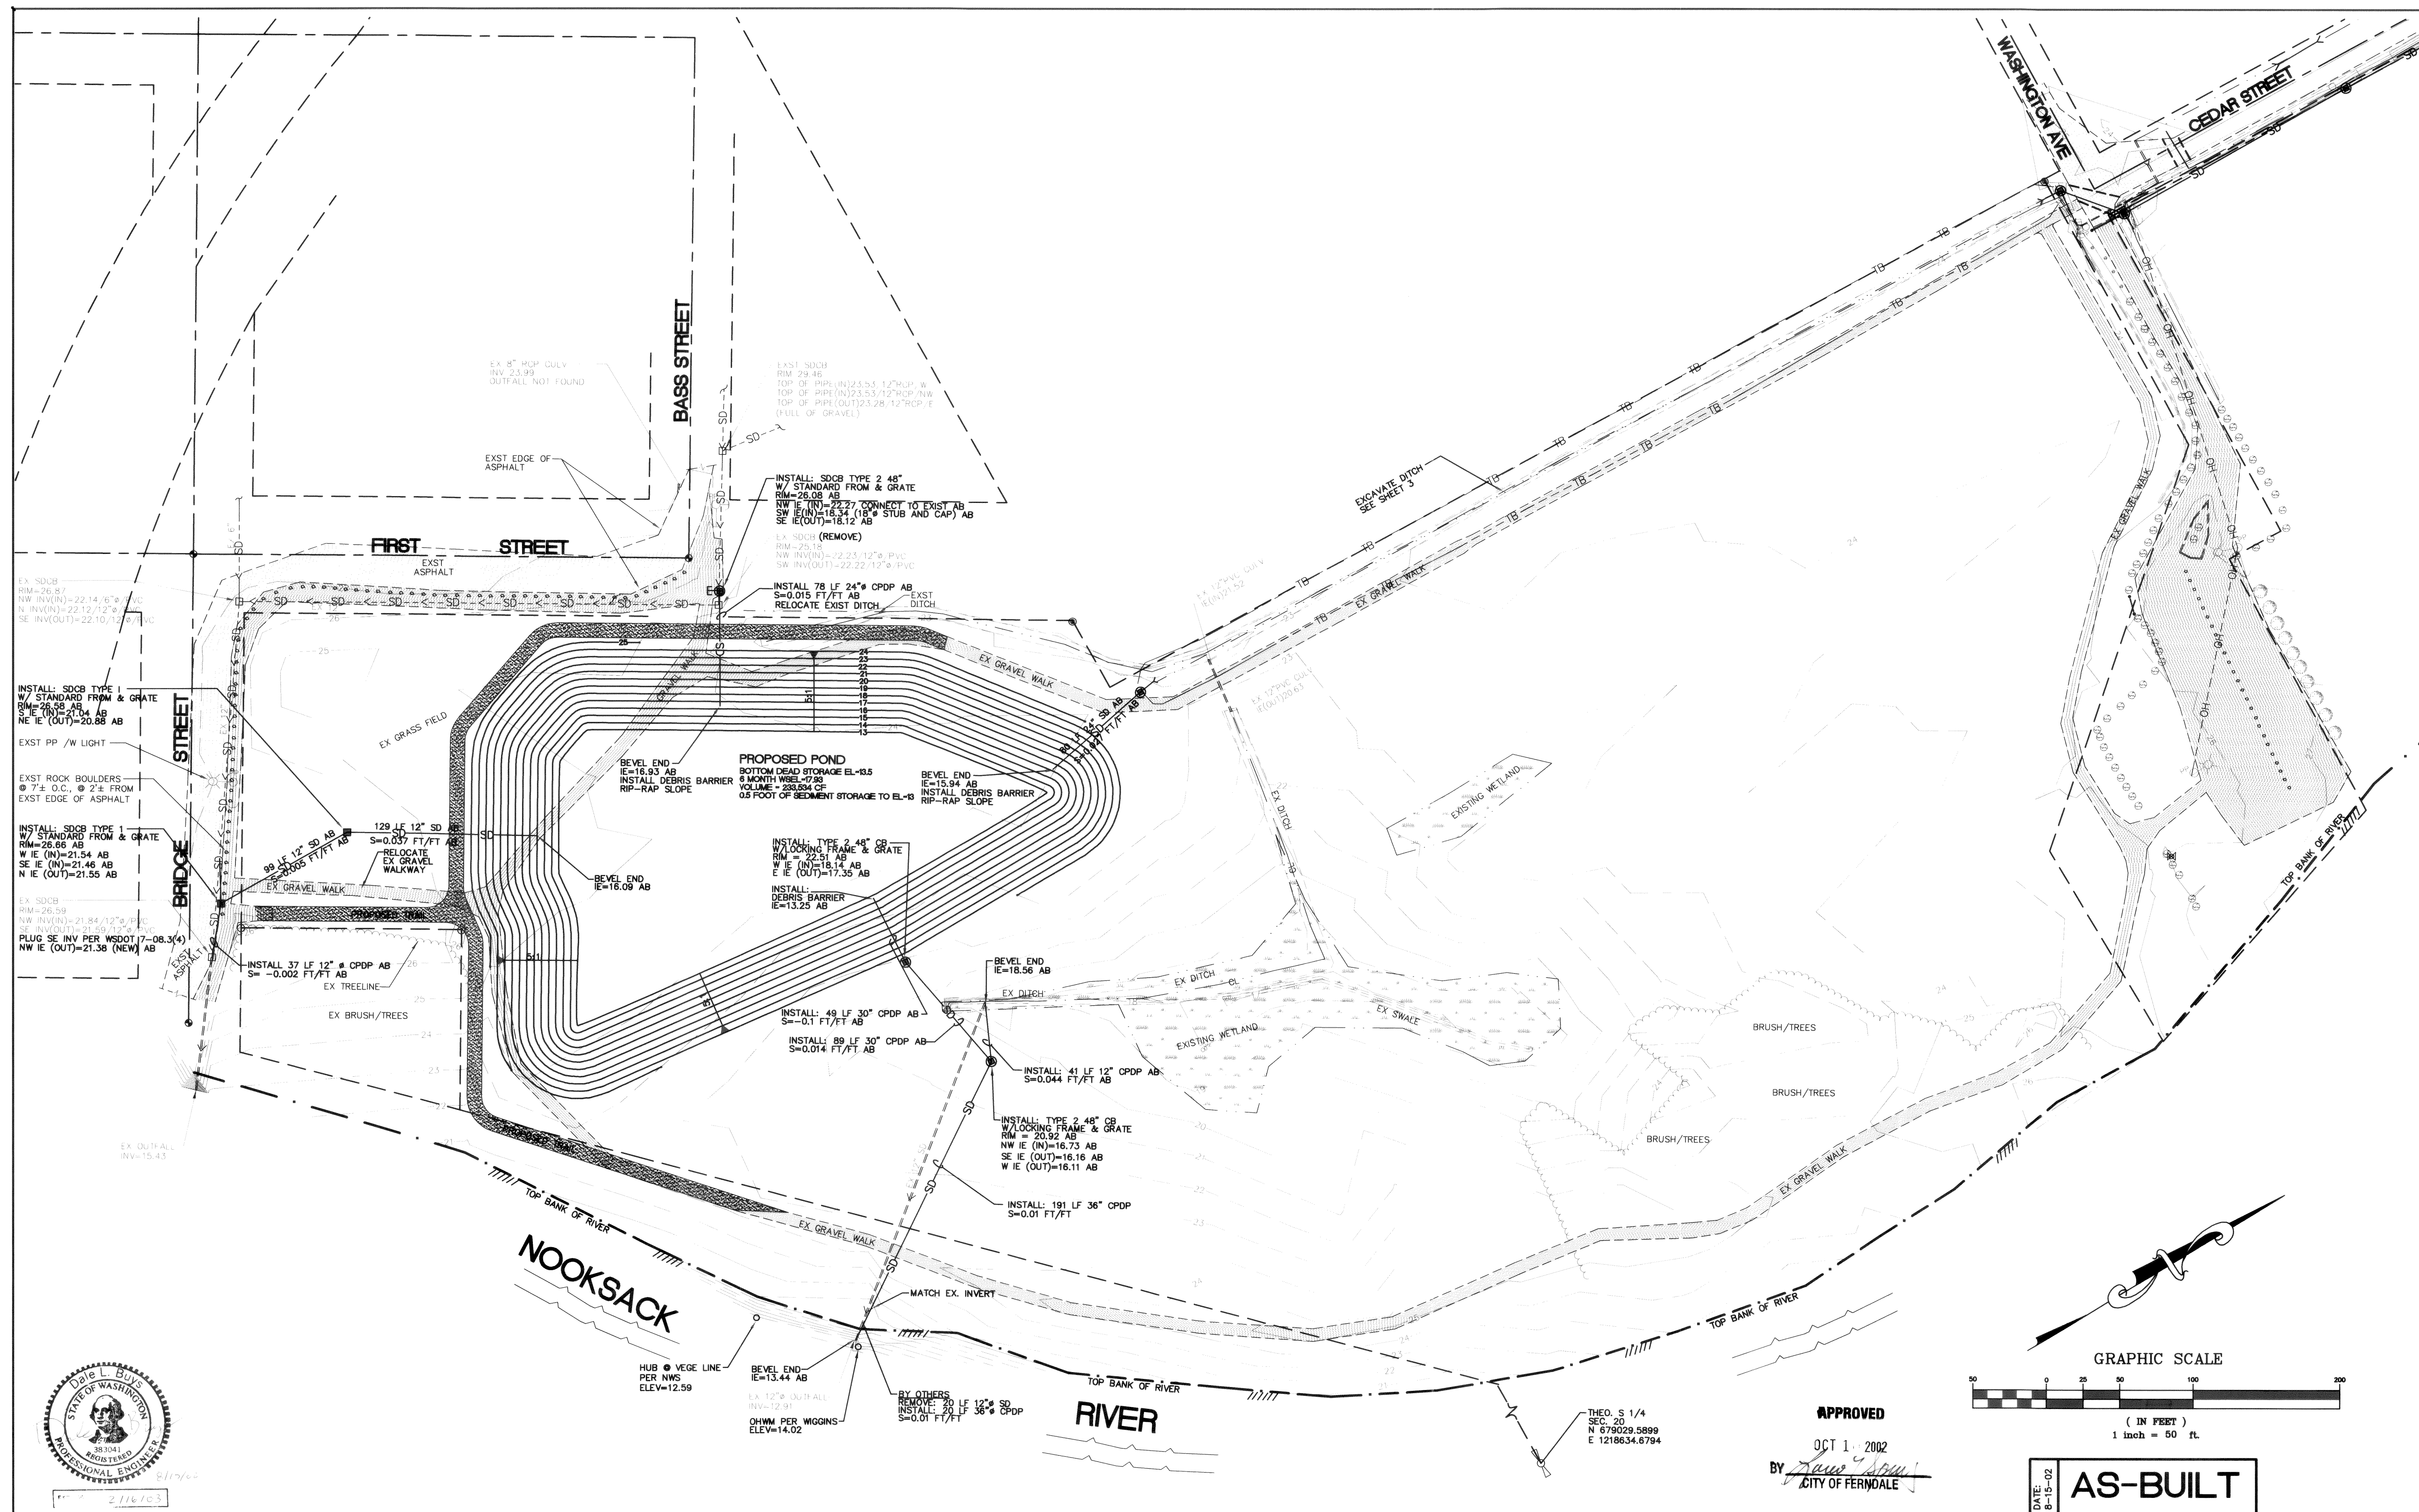

DESIGNED BY DLB		REICHHARDT & EBE				CITY OF FERDALE	VANDERYACHT PARK	JOB# / DWG 8074 8074SP5	DATE 11-14-0
DRAWN BY LMC		ENGINEERING, INC.				2095 MAIN STREET	POND & STORM DRAIN PLAN	SCALE	SHEET
CHECKED BY GDE		CONSULTING ENGINEERS				FERDALE, WA 98248		H: 1" = 50' V: N/A	2 of 4
	PO Box 978 423 Front St., Ste 201 Lynden, Washington 98264	Ph (360) 354-3687 Fax (360) 354-0407	NO.	DATE	REVISION	BY			

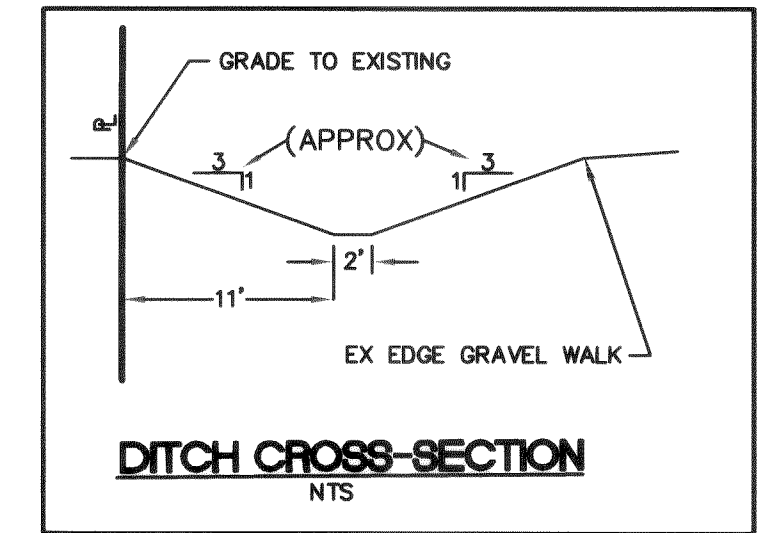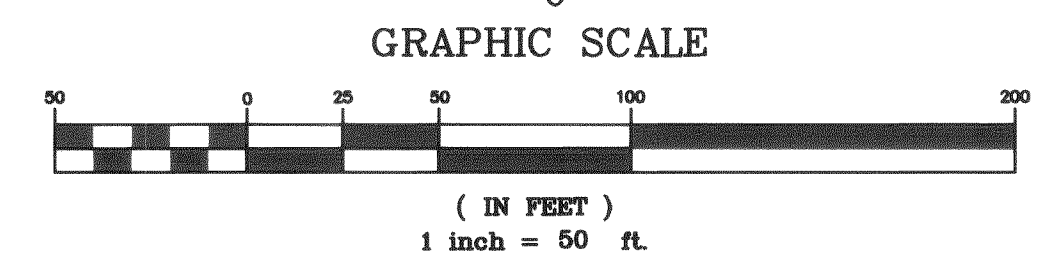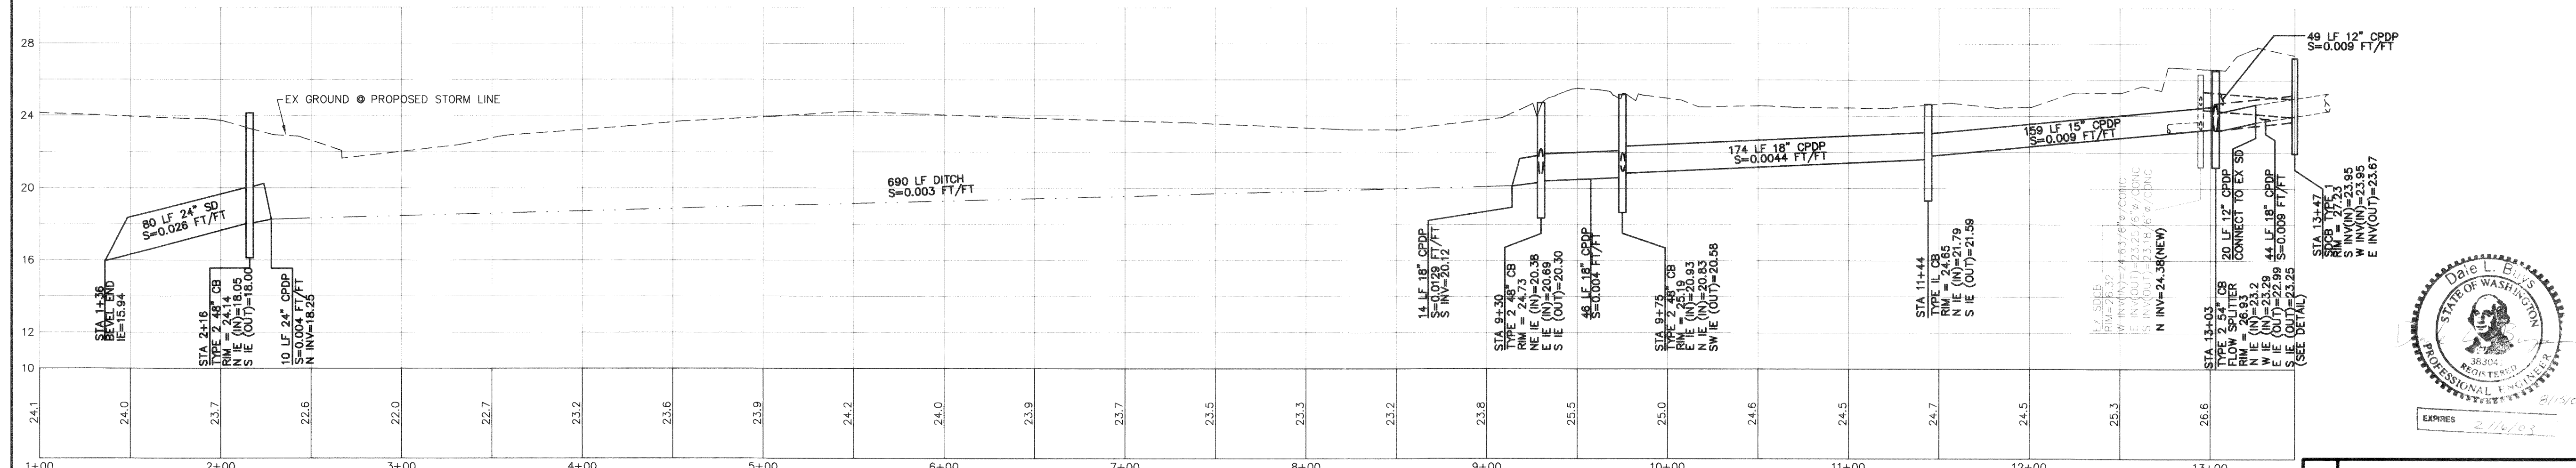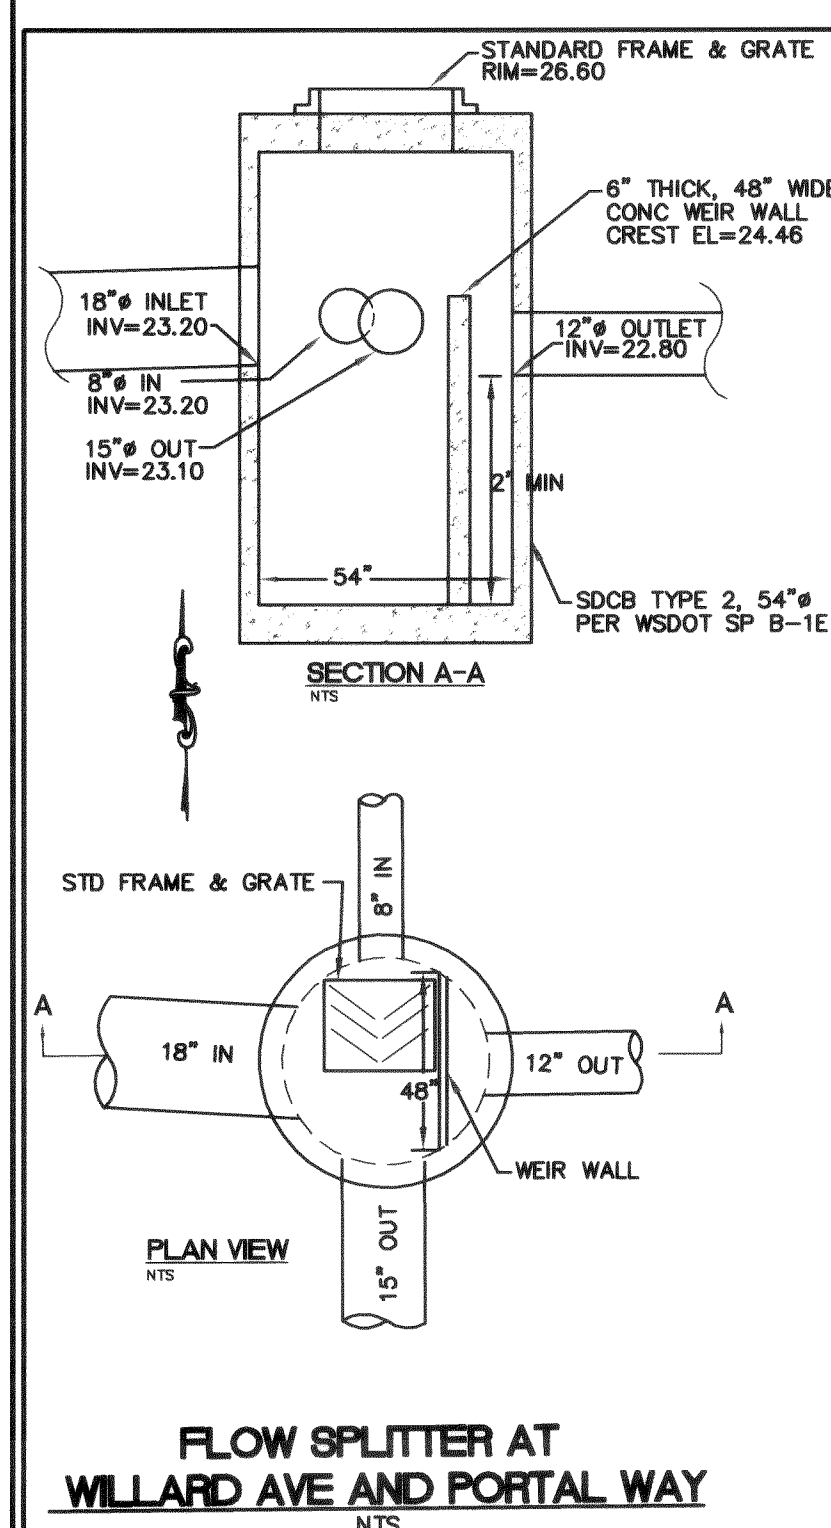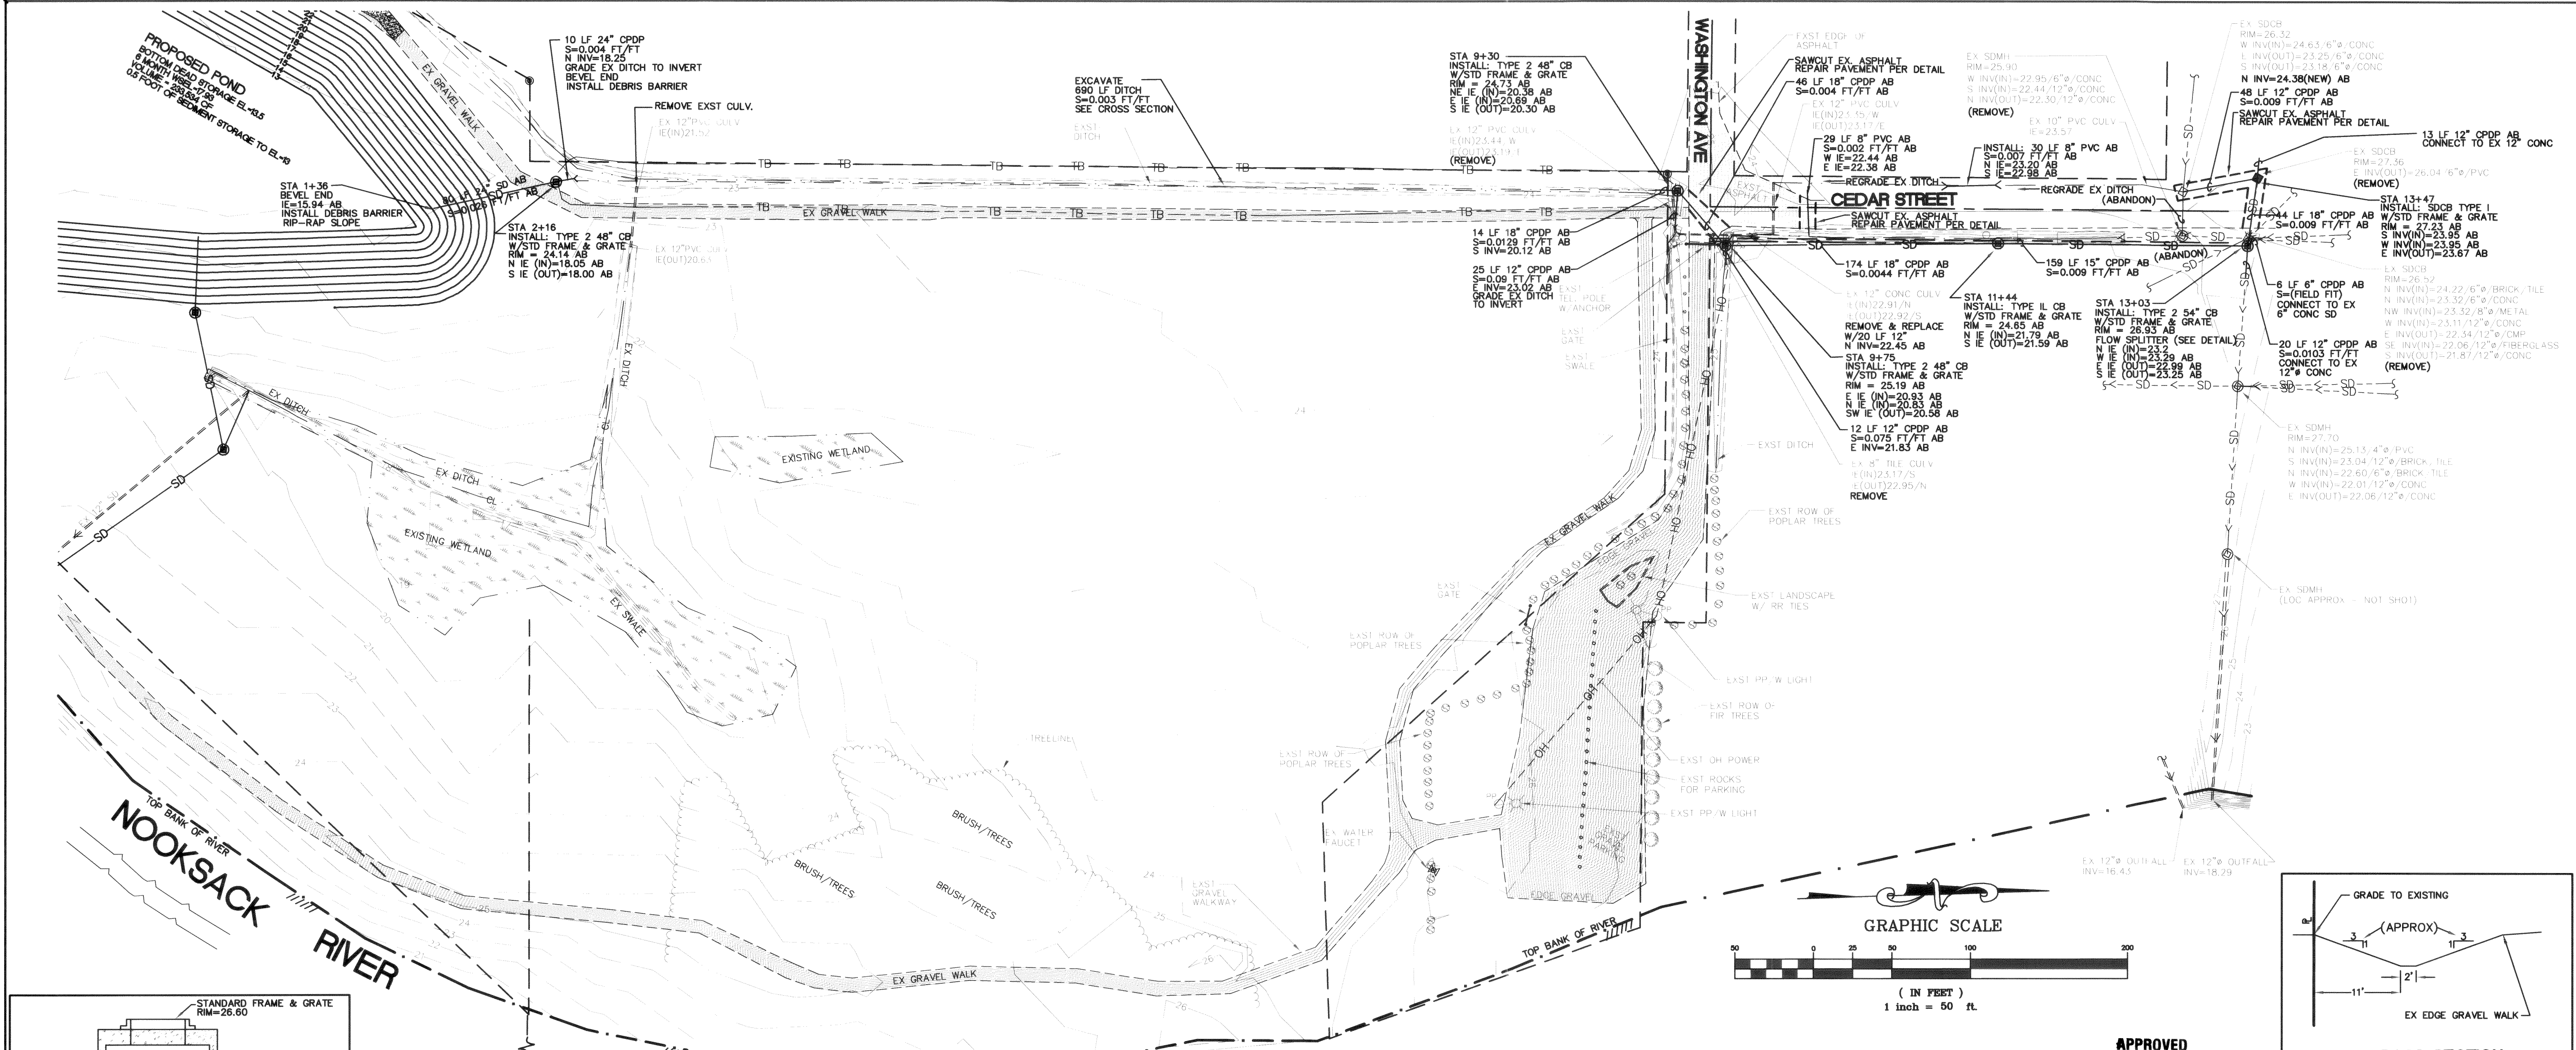

APPROVED
OCT 1 2002
BY *[Signature]*
CITY OF FERDALE

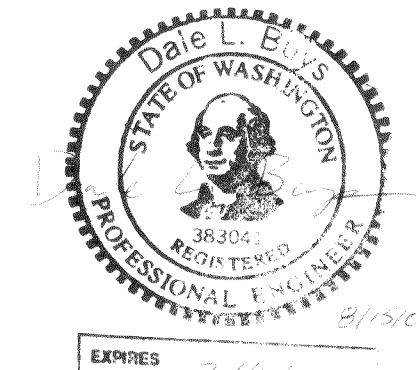

DATE: 8-15-02
AS-BUILT

DESIGNED BY DLB		REICHHARDT & EBE ENGINEERING, INC. CONSULTING ENGINEERS PO Box 978 423 Front St., Ste 201 Lynden, Washington 98264 Ph (360) 354-3687 Fax (360) 354-0407	NO.	DATE	REVISION	BY	CITY OF FERDALE 2005 MAIN STREET FERDALE, WA 98248	VANDERYACHT PARK STORM DRAIN PLAN, PROFILE & DETAIL	JOB# / DWG 8074 8074SP5	DATE 11-14-01
DRAWN BY LMC									SCALE H: 1"=50' V: 1"=5'	SHEET 3 of 4
CHECKED BY GDE										

00154.003 2-16-06 JR

