


EATON, SOMERSET, WILLARD AND WASHINGTON SEWER PROJECT No. SS2011-01

ADDENDUM 1

CITY OF FERNDALE

00552.001 3/26/13 SH

VICINITY MAP
NTS

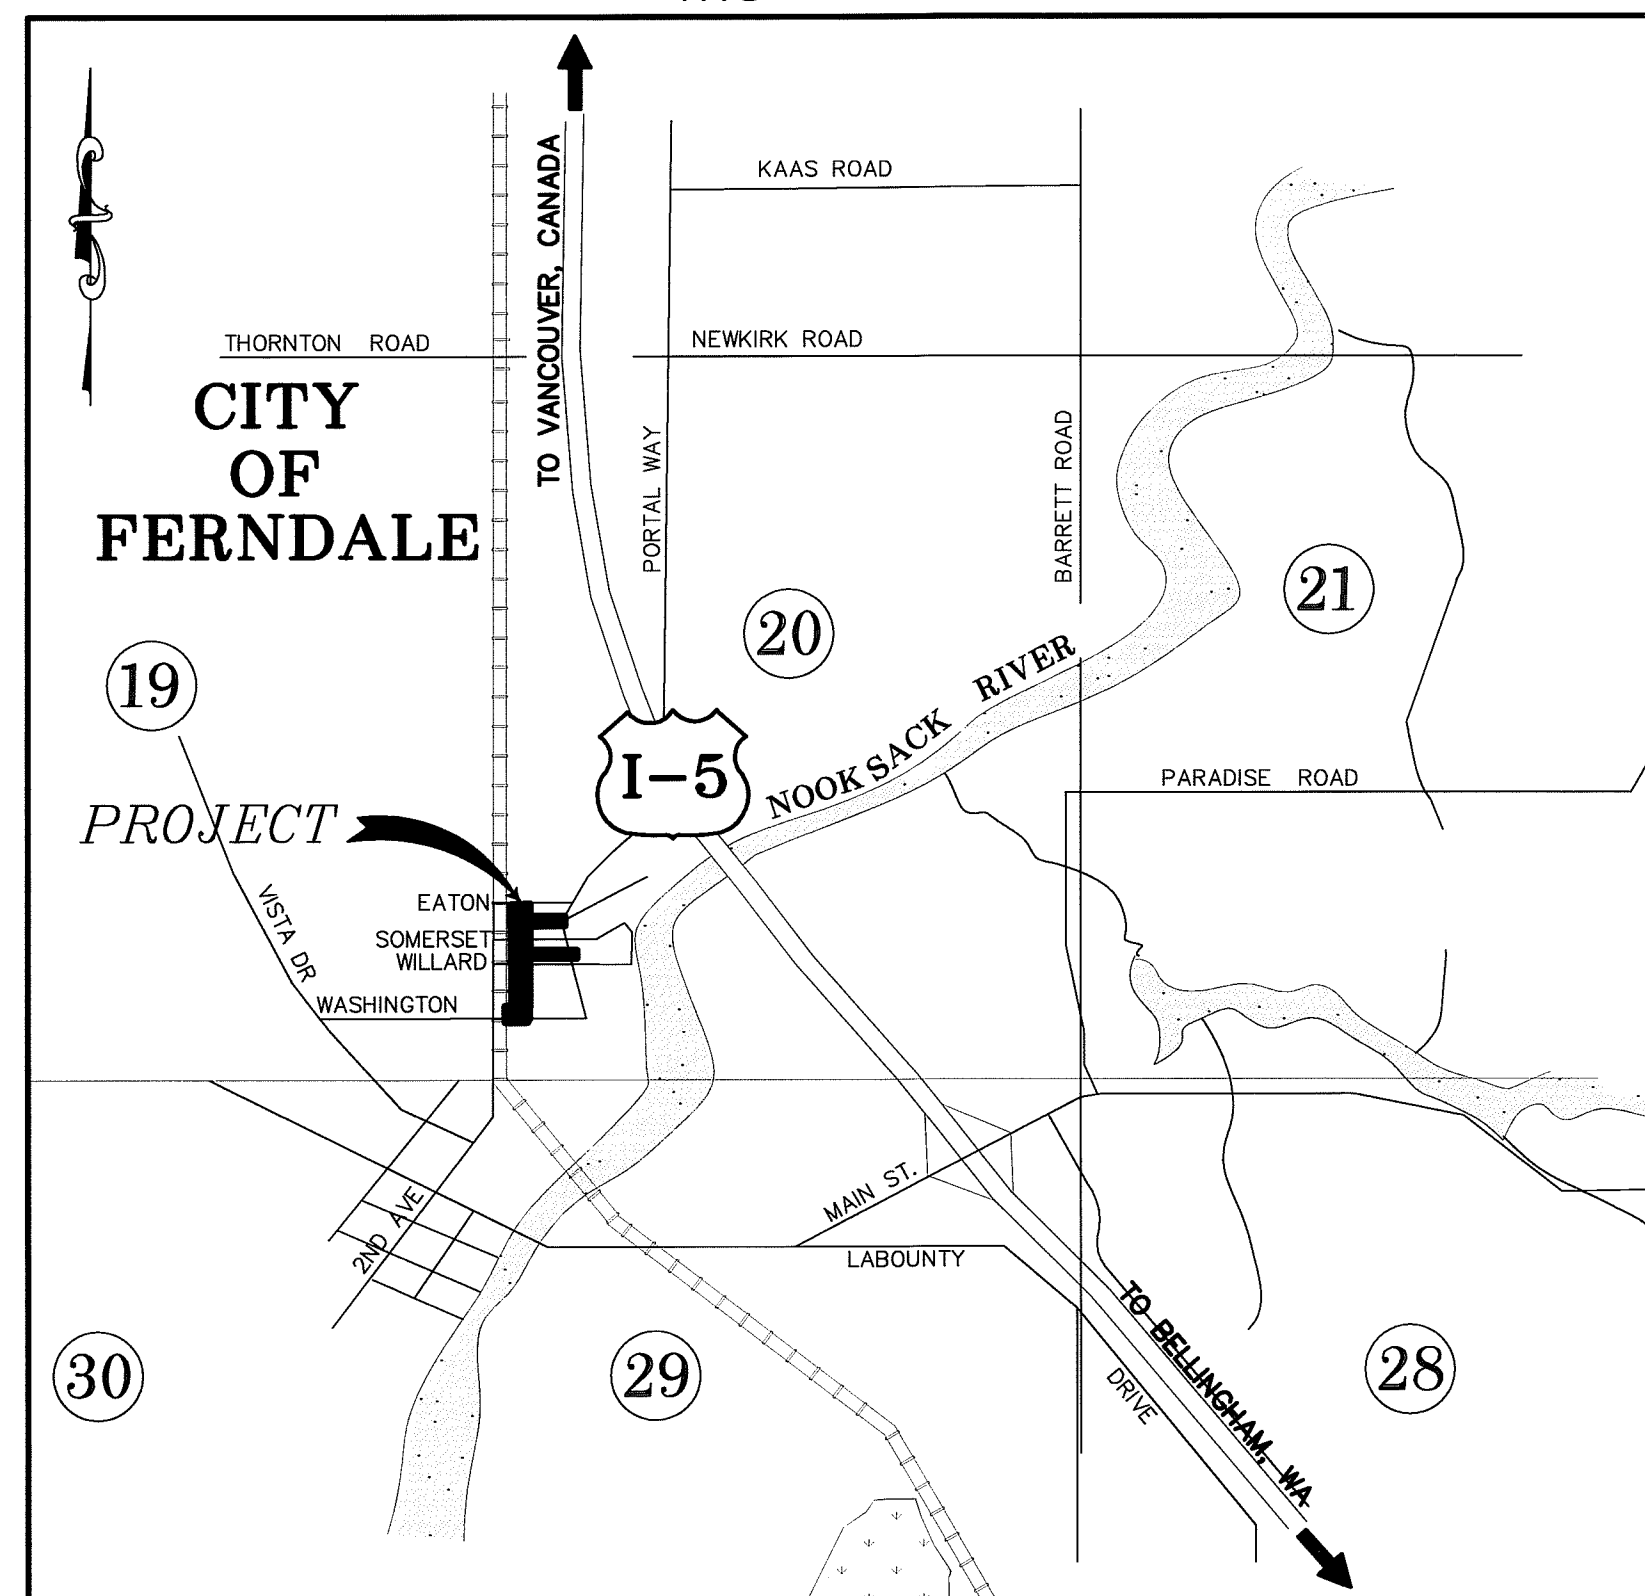

SHEET INDEX

- 1.) COVER SHEET
- 2.) KEY MAP
- 3.) EXISTING CONDITIONS, TESC AND DEMO PLAN
- 4.) EXISTING CONDITIONS, TESC AND DEMO PLAN
- 5.) EXISTING CONDITIONS, TESC AND DEMO PLAN
- 6.) PROPOSED SANITARY SEWER PLAN & PROFILE BASE BID
- 7.) PROPOSED SANITARY SEWER PLAN & PROFILE BASE BID
- 8.) PROPOSED SANITARY SEWER PLAN & PROFILE BASE BID
- 9.) PROPOSED SANITARY SEWER PLAN & PROFILE BASE BID
- 10.) PROPOSED SANITARY SEWER PLAN & PROFILE ALTERNATE A1
- 11.) DETAIL SHEET
- 12.) DETAIL SHEET


EXISTING	LEGEND	PROPOSED
BB	EX TOE OF BANK	PROPOSED AUTOTURN
OH	EX OVERHEAD POWER	PROPOSED DITCH CL
95	EX CONCRETE	PROPOSED BUILDING
95	EX MAJOR CONTOUR	PROPOSED TOE OF BANK
95	EX MINOR CONTOUR	PROPOSED CONDUIT
95	EX CULVERT	PROPOSED TOP OF BANK
95	EX DITCH CL	PROPOSED MAJOR CONTOUR
95	EX FENCE	PROPOSED MINOR CONTOUR
95	EX FIBER OPTICS LINE	PROPOSED FENCE
95	EX GAS MAIN	PROPOSED HANDRAIL
95	EX GUARDRAIL	PROPOSED CONSTRUCTION EASEMENT
95	EX GRAVEL	PROPOSED SANITARY SEWER FORCE MAIN
95	EX PROPERTY BOUNDARY	PROPOSED FIBER OPTICS
95	EX POWER BURIED	PROPOSED GRADE BREAK
95	EX ROAD CL	PROPOSED GUARDRAIL
95	EX EDGE OF PAVEMENT	PROPOSED GRAVEL
95	EX RIGHT OF WAY	PROPOSED PATH
95	EX TREE LINE	PROPOSED PARKING STRIPE
95	EX STORM DRAIN	PROPOSED TRAFFIC STRIPE
95	EX TRAFFIC SIGNAL CONDUCTOR	PROPOSED ROCK WALL
95	EX SANITARY SEWER	PROPOSED BACK OF CURB
95	EX TRAFFIC STRIPING	PROPOSED ROAD CL
95	EX PARKING STRIPING	PROPOSED ROAD EDGE OF PAVEMENT
95	EX TOP OF BANK	PROPOSED ROAD FACE OF CURB
95	EX TELEPHONE LINE	PROPOSED ROAD UP OF GUTTER
95	EX OVERHEAD TELEPHONE	PROPOSED RIGHT OF WAY
95	EX TV LINE	PROPOSED SAWCUT
95	EX WATER LINE	PROPOSED STORM DRAIN
95	EX SIDEWALK	PROPOSED FIELD STORM DRAIN
95	EX WETLANDS BOUNDARY	PROPOSED TRAFFIC SIGNAL CONDUCTOR
95	EX EASEMENT	PROPOSED SILT FENCE
95	EX GRADE BREAK	PROPOSED SANITARY SEWER
95	EX SANITARY SEWER FORCE MAIN	PROPOSED TREE LINE
95	EX FLOWLINE	PROPOSED WATERMAIN
95	EXISTING RR TRACKS	PROPOSED SIDEWALK
95	EX BUILDING	PROPOSED PAVEMENT VALLEY
95	EX CONCRETE	
95	EX MONITORING WELL	PROPOSED ACP REMOVAL
95	EX SOIL BORING LOCATION	PROPOSED DEMOLITION AREA
95	EX GUY WIRE	PROPOSED ASPHALT APRON
95	EX STORM CLEANOUT	PROPOSED RIGHT OF WAY TAKE
95	EX SEWER CLEANOUT	PROPOSED CONC. SIDEWALK / DRIVEWAY
95	EX JBOX	PROPOSED INFILTRATION TRENCH
95	EX STREET LIGHT	PROPOSED INFILTRATION FILTER MEDIA
95	EX MAIL BOX	PROPOSED BUILDING
95	EX WATER METER	
95	EX WATER SPIGOT	PROPOSED MONITORING WELL
95	EX WATER VALVE	PROPOSED STORM DRAIN CATCH BASIN TYPE I
95	EX FIRE HYDRANT	PROPOSED STORM DRAIN CATCH BASIN TYPE II
95	EX TRAFFIC SIGNAL VAULT	PROPOSED STORM CLEANOUT
95	EX SEWER MANHOLE	PROPOSED STORM DRAIN INLET
95	EX STORM DRAIN CATCH BASIN TYPE I	PROPOSED SANITARY SEWER MANHOLE
95	EX STORM DRAIN CATCH BASIN TYPE II	PROPOSED SANITARY SEWER MANHOLE
95	EX UTILITY POLE	PROPOSED SANITARY SEWER CLEAN OUT
95	EX GAS METER	PROPOSED HYDRANT
95	EX TRANSFORMER PAD	PROPOSED WATER METER
95	EX POWER VAULT	PROPOSED WATER VALVE
95	EX SIGN	PROPOSED COUPLER
95	EX TELEPHONE PEDESTAL	PROPOSED UTILITY POLE
95	EX SIGNAL POLE AND ARM W/ LUMINAIRE	PROPOSED SIGN
95	EX TREE	PROPOSED SIGN
95	EX VEGETATION	PROPOSED TREE

APPROVED

MAR 22 2013

BY *J. M. P. P.*
CITY OF FERNDAL

AS-BUILT

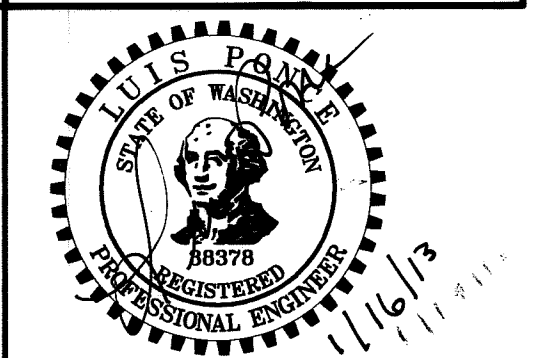

DESIGNED BY
LP
DRAWN BY
LMC
CHECKED BY
LP



REICHHARDT & EBE
ENGINEERING, INC.
CONSULTING ENGINEERS

PO Box 978 423 Front St., Ste 201
Lynden, Washington 98244
Ph (360) 354-3687
Fax (360) 354-0407

NO. DATE

REVISION


BY


CITY OF FERNDAL
2085 MAIN ST
FERNDAL, WA 98248


**EATON, SOMERSET, WILLARD AND
WASHINGTON SEWER PROJECT**
COVER SHEET

JOB# / DWG
11007.1 AD1 SP2.AB
SCALE
H:n/a V:n/a

DATE
9-19-11
SHEET
1 of 12

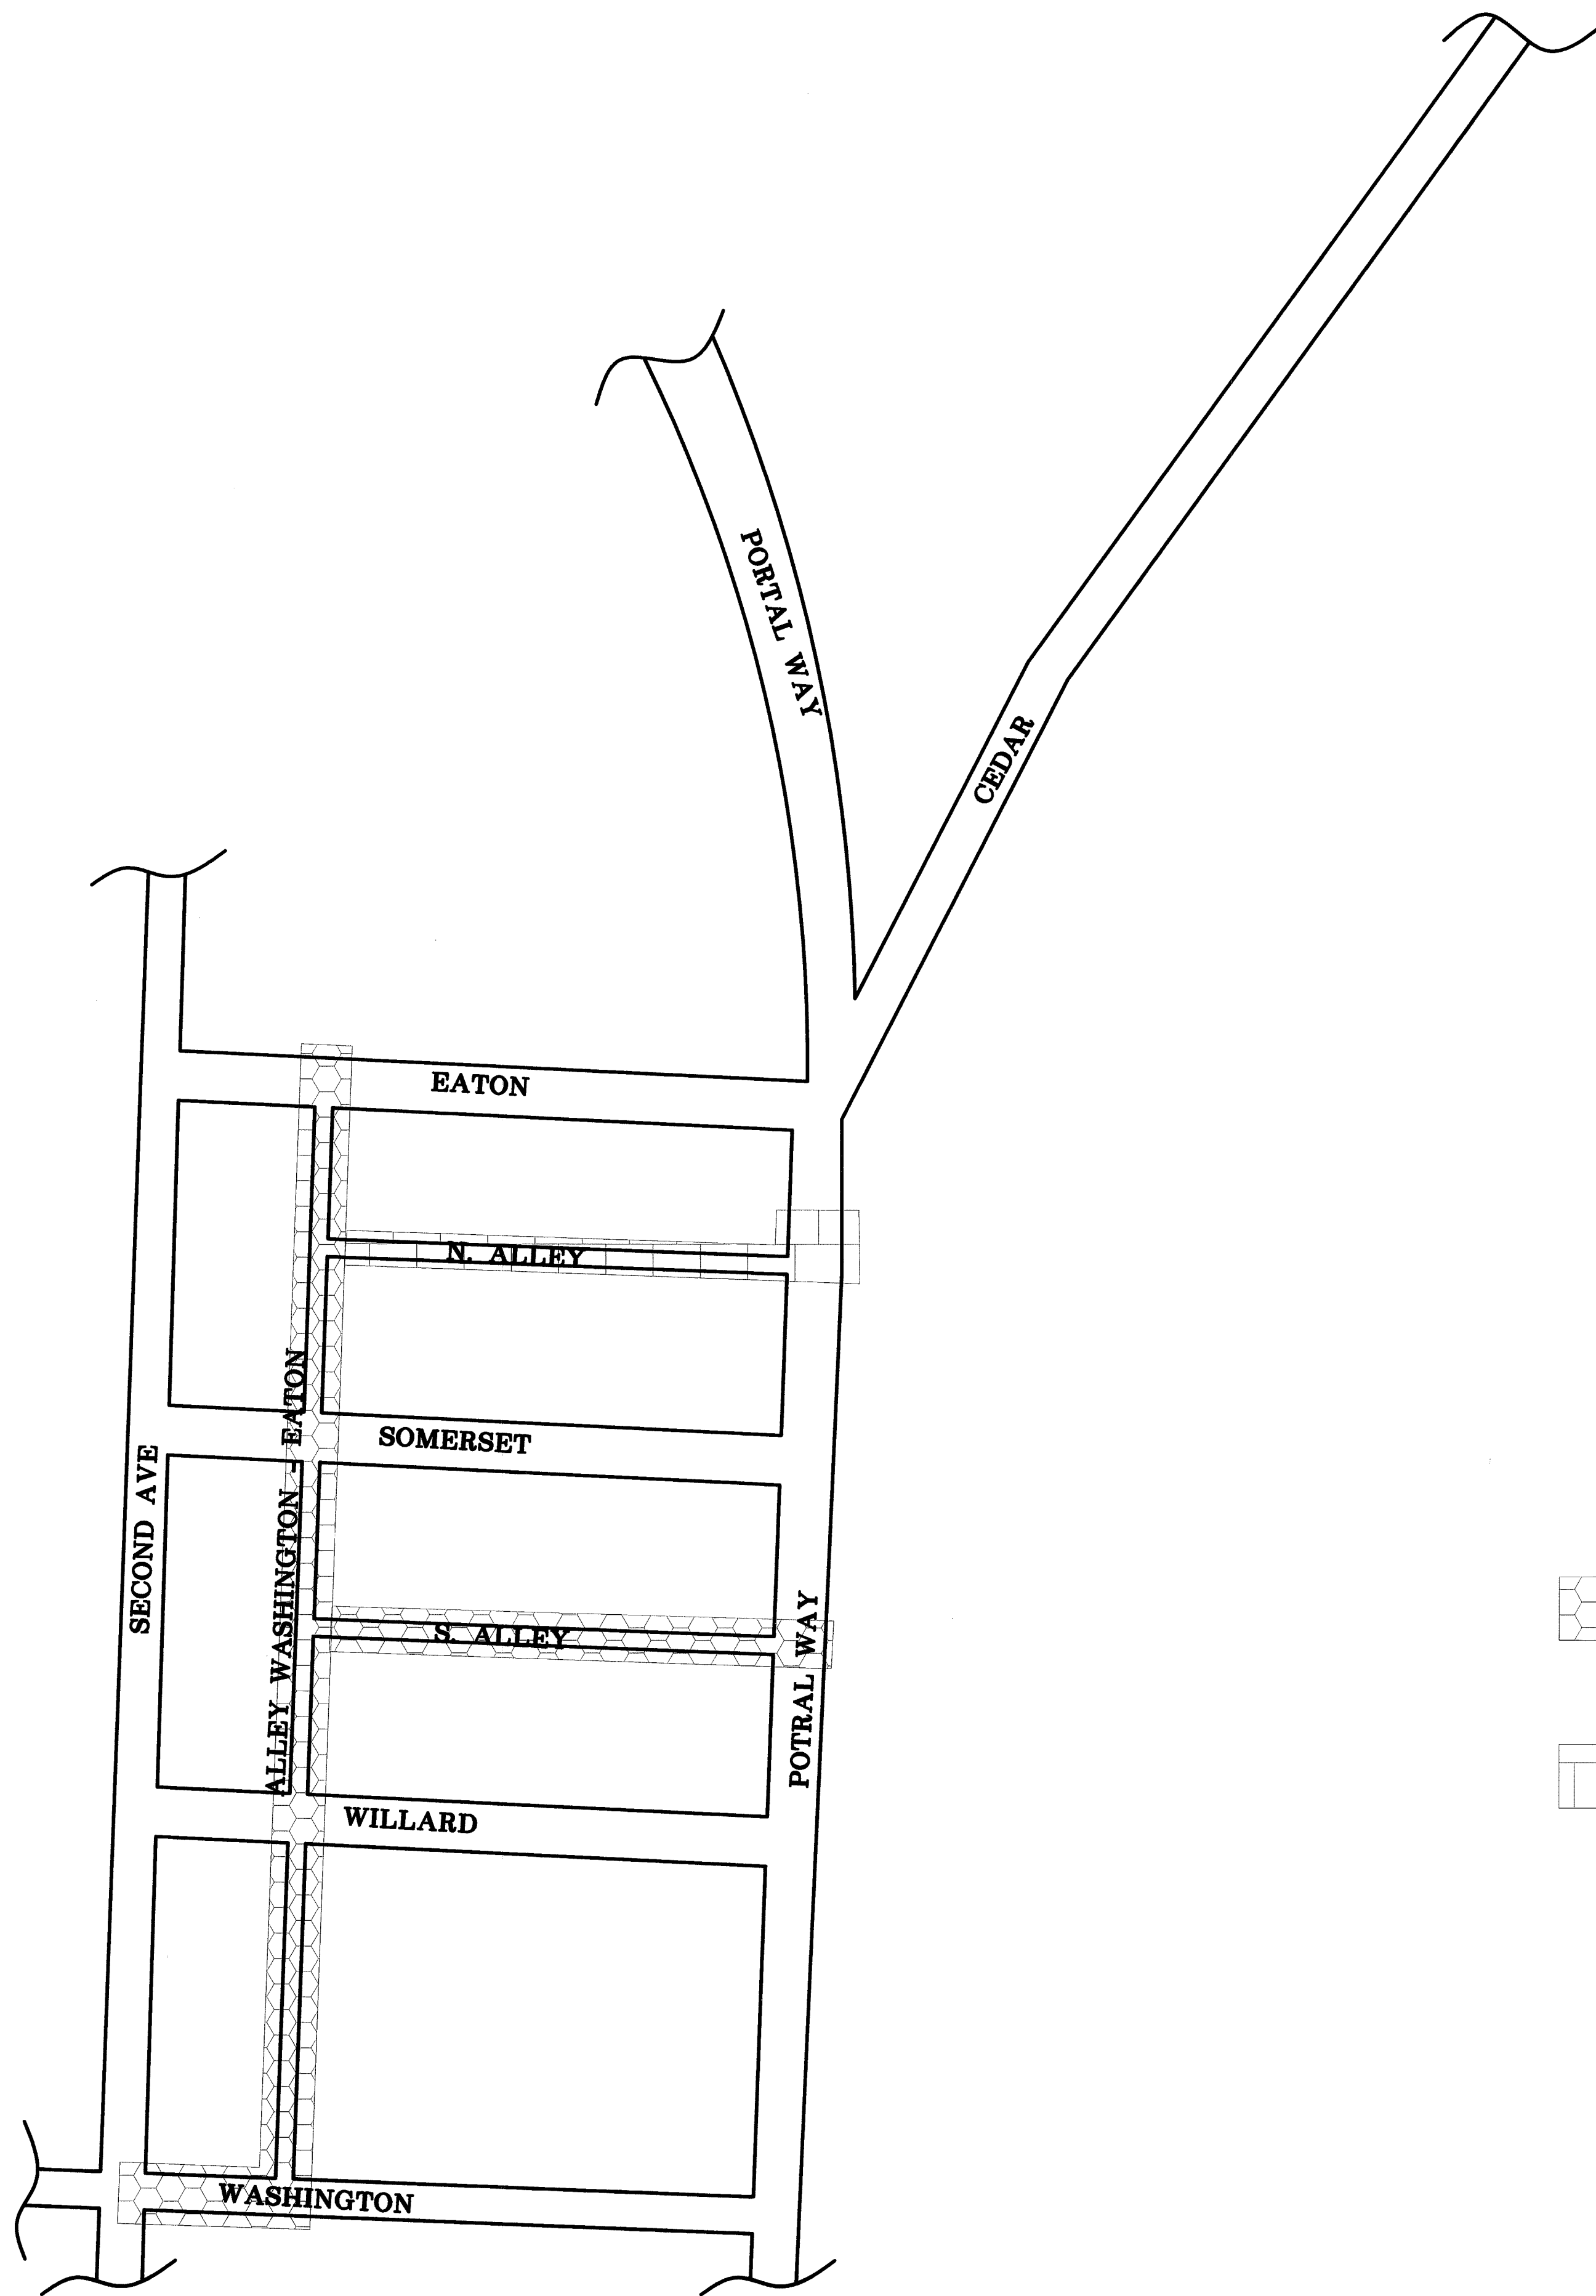

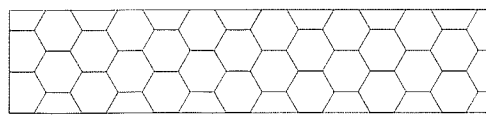 = BASE BID

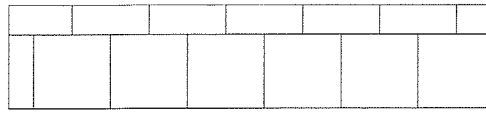 = ALTERNATE A1

APPROVED
MAR 22 2013
BY *J. P. E.*
CITY OF FERNDALE



SUBMITTED WITH
DESIGN PLAN

DESIGNED BY
LP
DRAWN BY
LMC
CHECKED BY
LP



REICHHARDT & EBE
ENGINEERING, INC.
CONSULTING ENGINEERS
PO Box 978 423 Front St., Ste 201 Ph (360) 354-3687
Lynden, Washington 98264 Fax (360) 354-0407


NO.	9-19-11	ADDENDUM 1	LP
DATE		REVISION	BY



CITY OF FERNDALE
2095 MAIN ST
FERNDALE, WA 98248

EATON, SOMERSET, WILLARD AND
WASHINGTON SEWER PROJECT
KEY MAP

JOB# / DWG 11007.1 AD1 SP2.AB	DATE 9-26-11
SCALE H: n/a V: n/a	SHEET 2 of 12

00552.002 2/26/13 SH

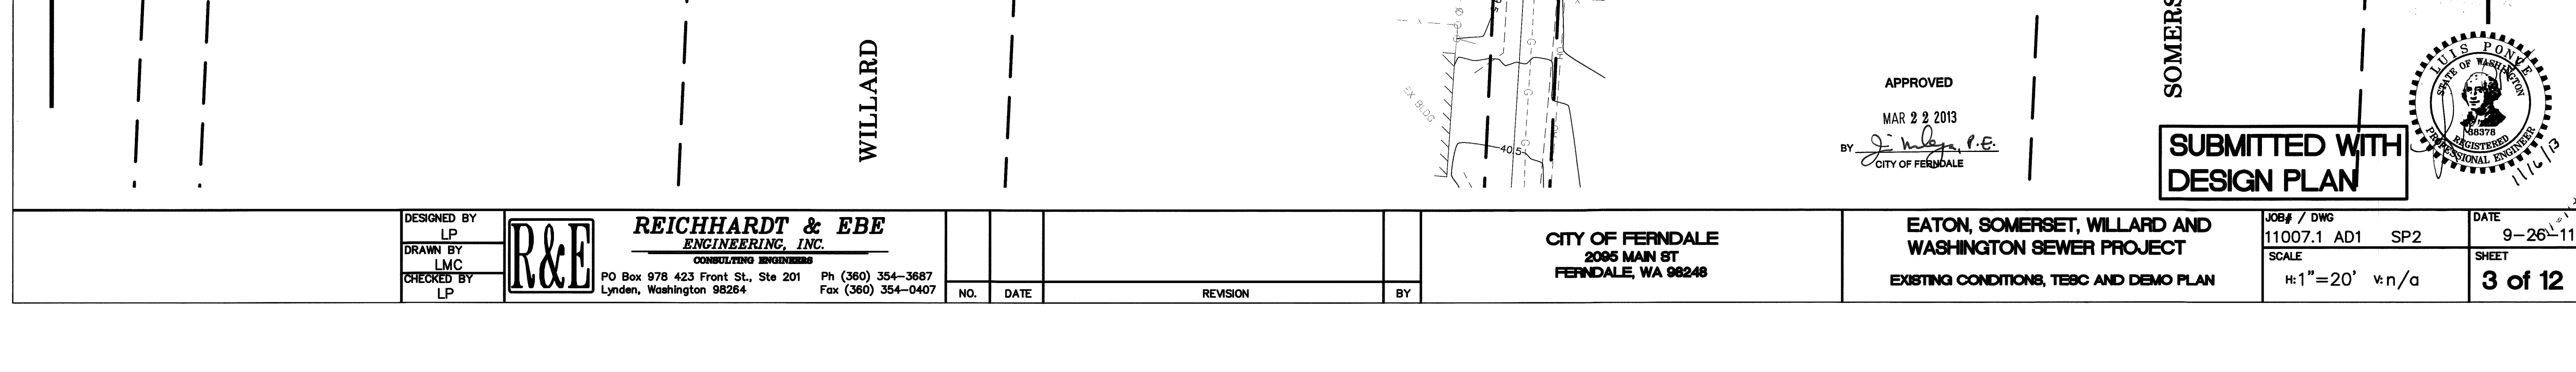

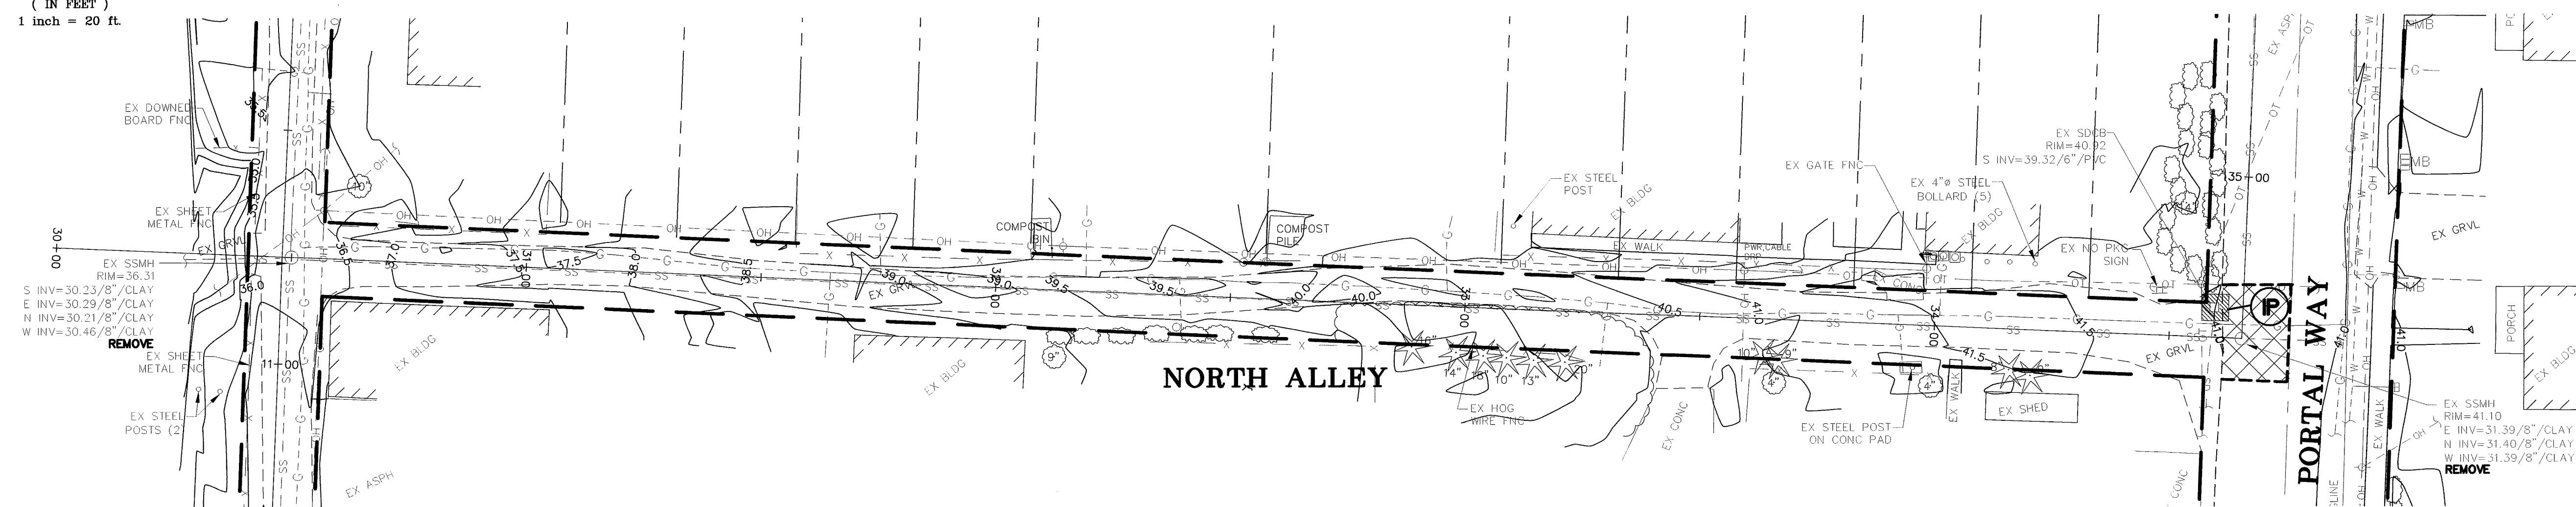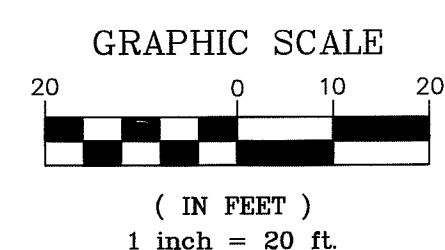

  = INLET PROTECTION

APPROVED

MAR 22 2013

BY J. M. Lopez, P.E.
CITY OF FERRDALE




**SUBMITTED WITH
DESIGN PLAN**

DESIGNED BY LP	 REICHARDT & EBE <i>ENGINEERING, INC.</i> CONSULTING ENGINEERS PO Box 978 423 Front St., Ste 201 Ph (360) 354-3687 Lynden, Washington 98264 Fax (360) 354-0407					CITY OF FERDALE 2065 MAIN ST FERDALE, WA 98248	EATON, SOMERSET, WILLARD AND WASHINGTON SEWER PROJECT EXISTING CONDITIONS, TBEC AND DEMO PLAN	JOB# / DWG 11007.1 AD1 SP2	DATE 9-26-1
DRAWN BY LMC								SCALE 1/4"=1'-0" v:n/a	SHEET 5 of 12
CHECKED BY IP		NO.	DATE	REVISION	BY				


00552.005	3/26/13	st
-----------	---------	----

1007\\dwg\\ADDENDUM 1 9-9-11\\SP2.dwg, EX COND-EC-DEMO, 1/15/2013 10:07:18 AM

0552.006. 3/26/13 ST

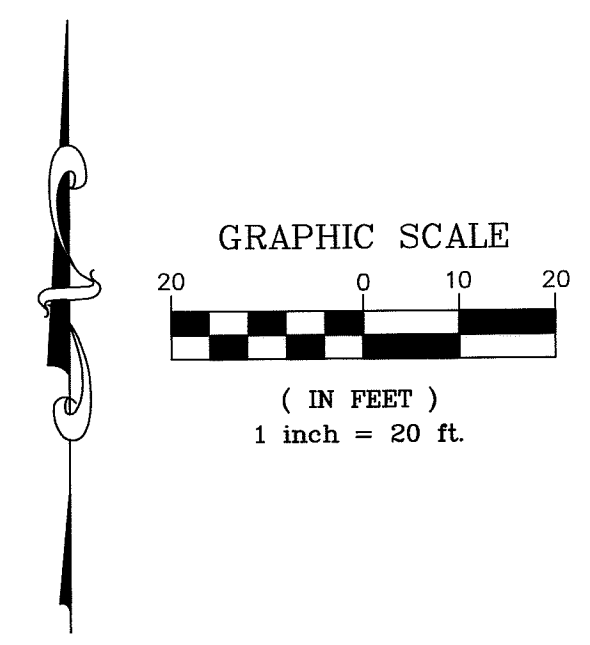


MATCHLINE SHT 7

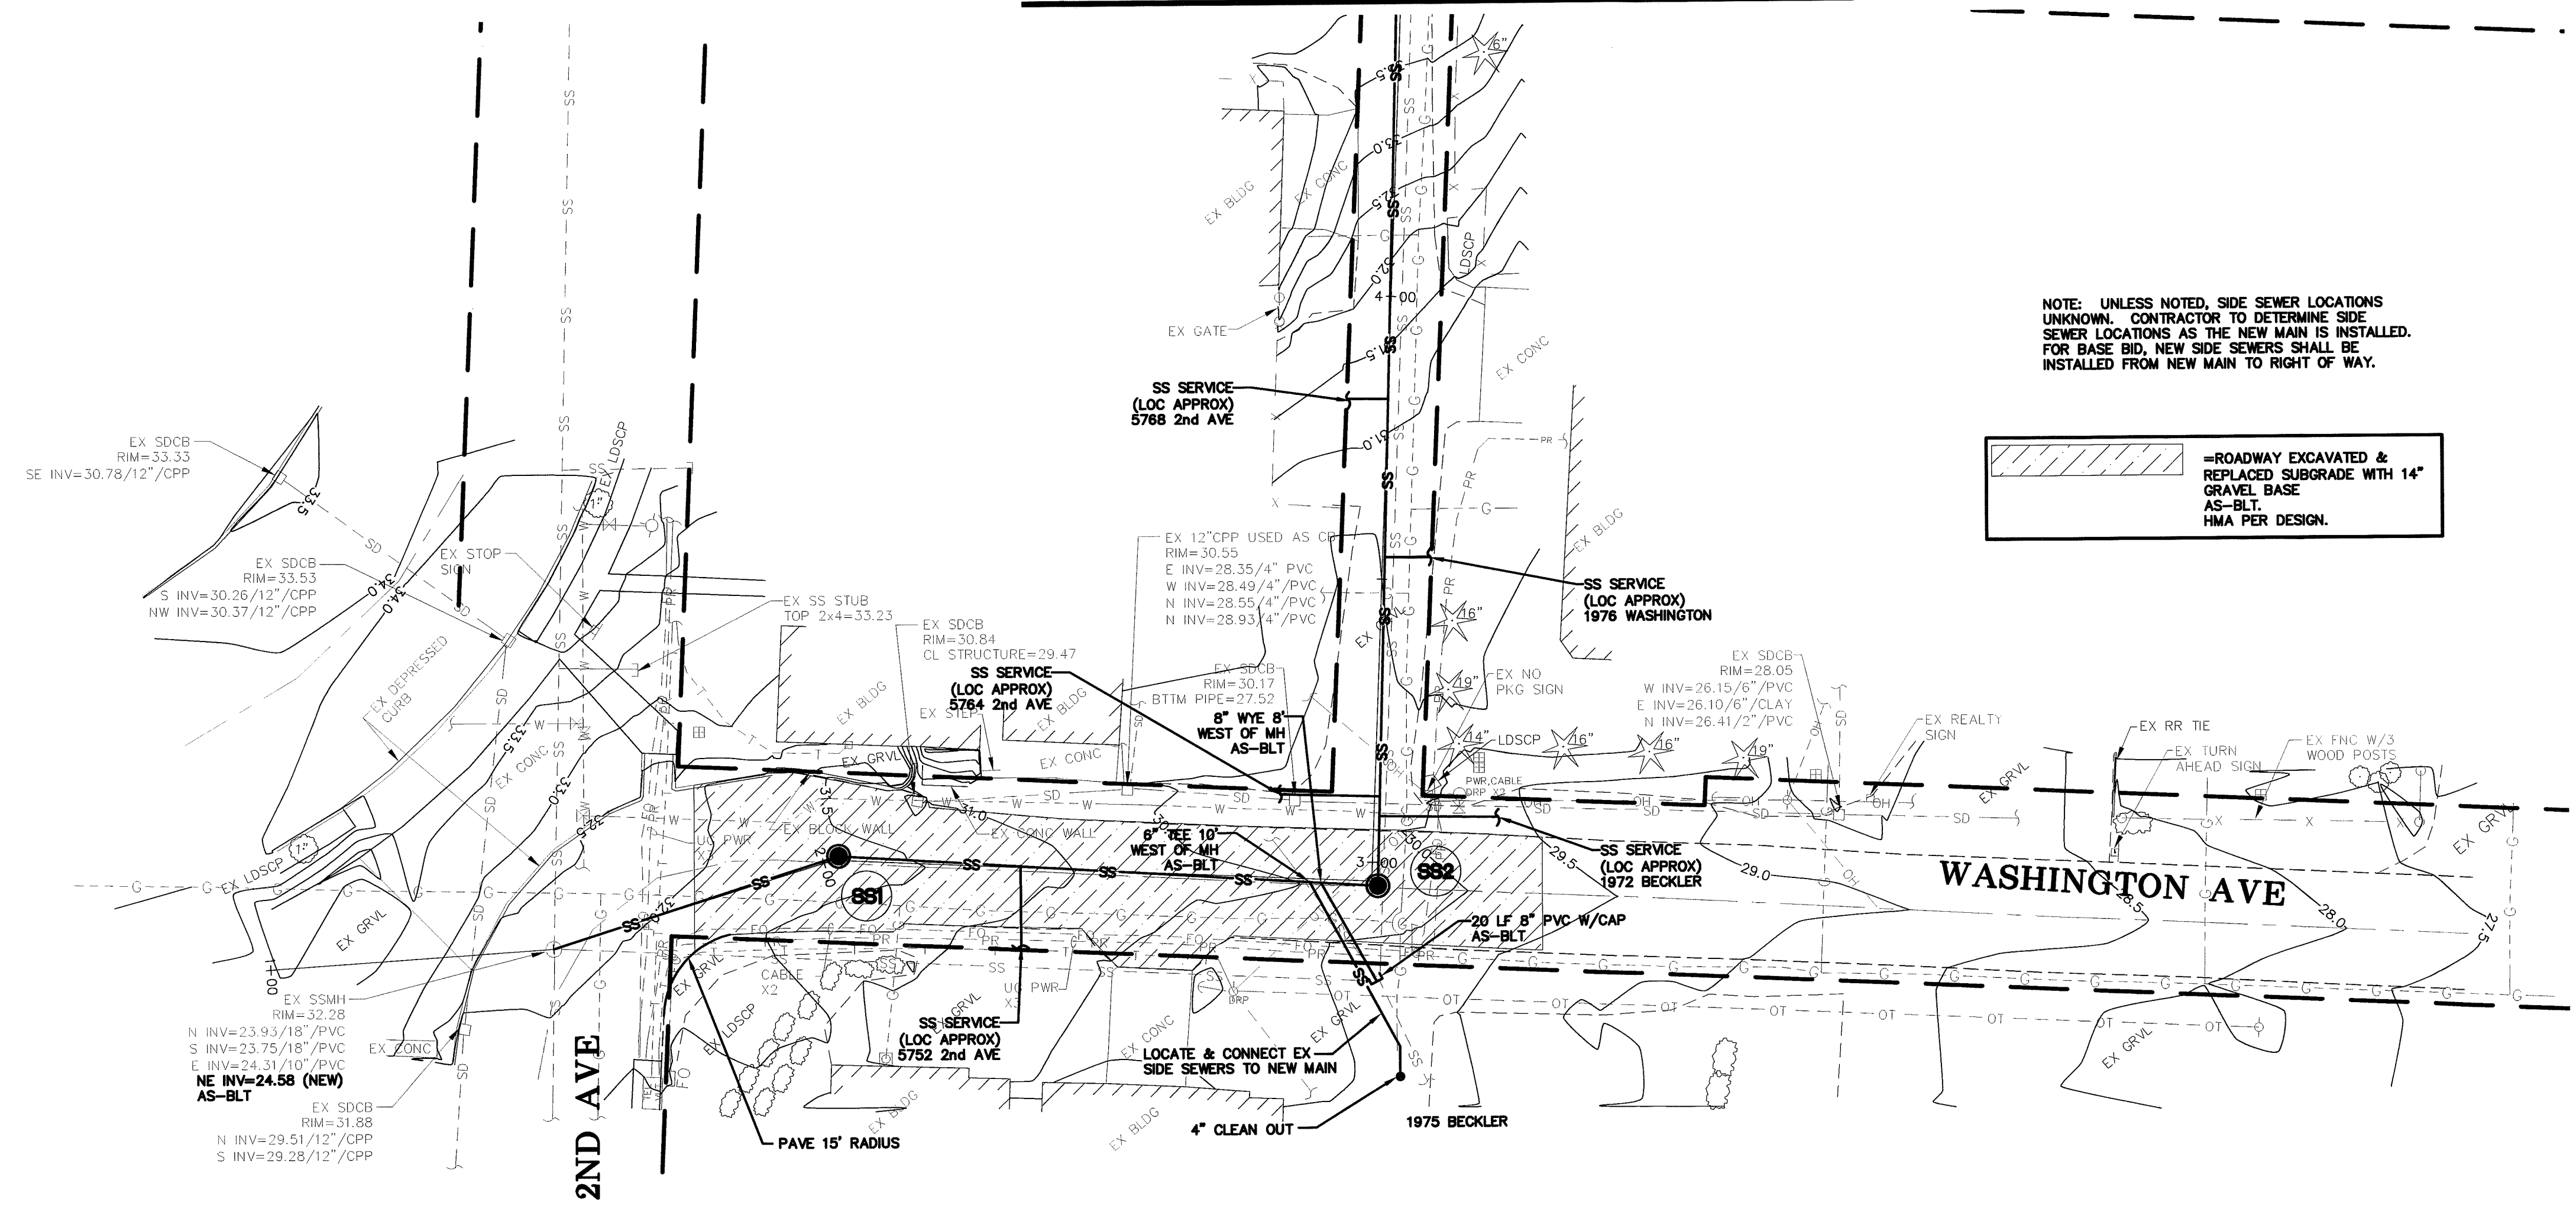


NOTE: UNLESS NOTED, SIDE SEWER LOCATIONS UNKNOWN. CONTRACTOR TO DETERMINE SIDE SEWER LOCATIONS AS THE NEW MAIN IS INSTALLED. FOR BASE BID, NEW SIDE SEWERS SHALL BE INSTALLED FROM NEW MAIN TO RIGHT OF WAY.

ROADWAY EXCAVATED & REPLACED SUBGRADE WITH 14\"/>

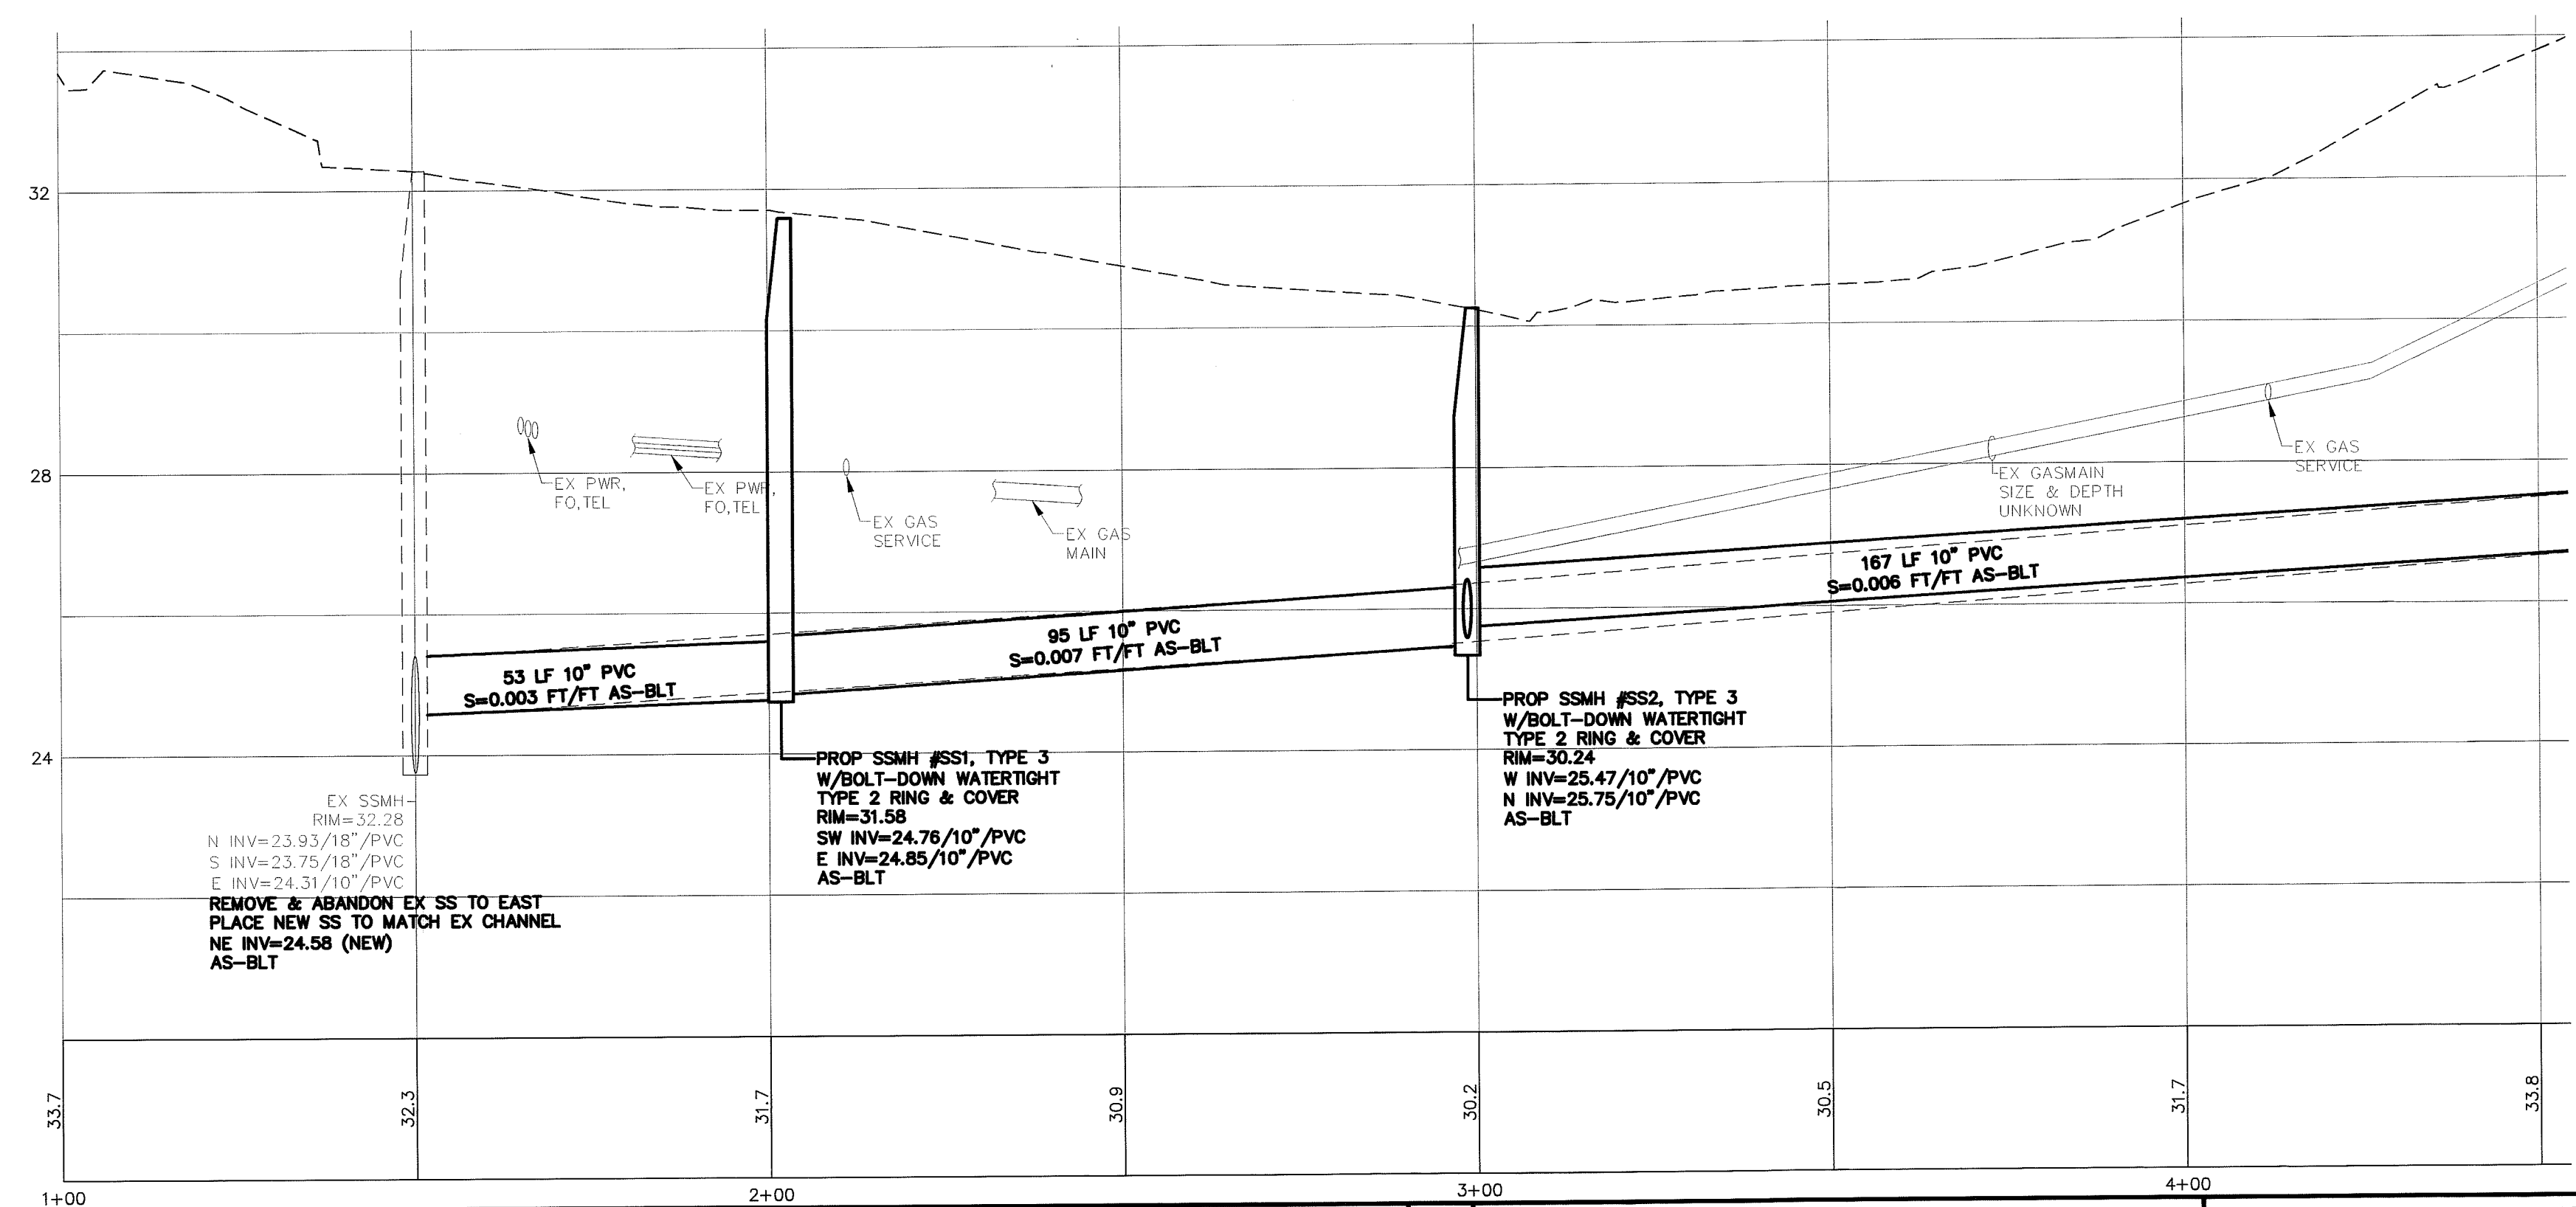


APPROVED
MAR 22 2013
BY *J. M. Lopez, P.E.*
CITY OF FERNDAL

AS-BUILT

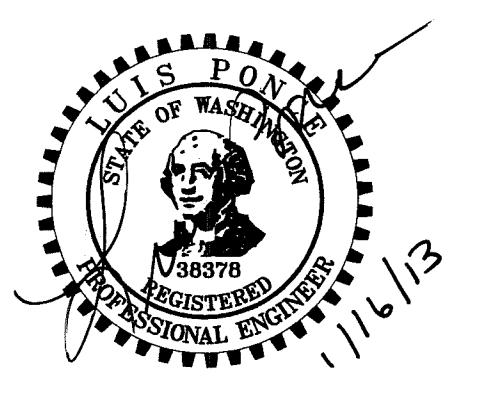


DESIGNED BY LP	REICHHARDT & EBE ENGINEERING, INC. CONSULTING ENGINEERS PO Box 978 423 Front St., Ste 201 Lynden, Washington 98264 Ph (360) 354-3687 Fax (360) 354-0407	NO.	DATE	REVISION	BY	CITY OF FERNDAL 2095 MAIN ST FERNDAL, WA 98248	EATON, SOMERSET, WILLARD AND WASHINGTON SEWER PROJECT PROPOSED SANITARY SEWER BASE BID	JOB# / DWG 11007.1 AD1 SP2.AB	DATE 9-26-11
DRAWN BY LMC								SCALE H:1"=20' V:1"=2'	SHEET 6 of 12
CHECKED BY LP									

11007.dwg\\ADDENDUM 1 9-2-11\\SP2.AB.dwg, WASHINGTON, 11/5/2013 10:12:38 AM

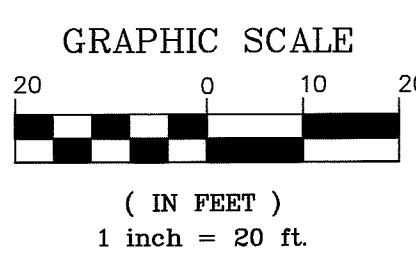


MATCHLINE SHT 7

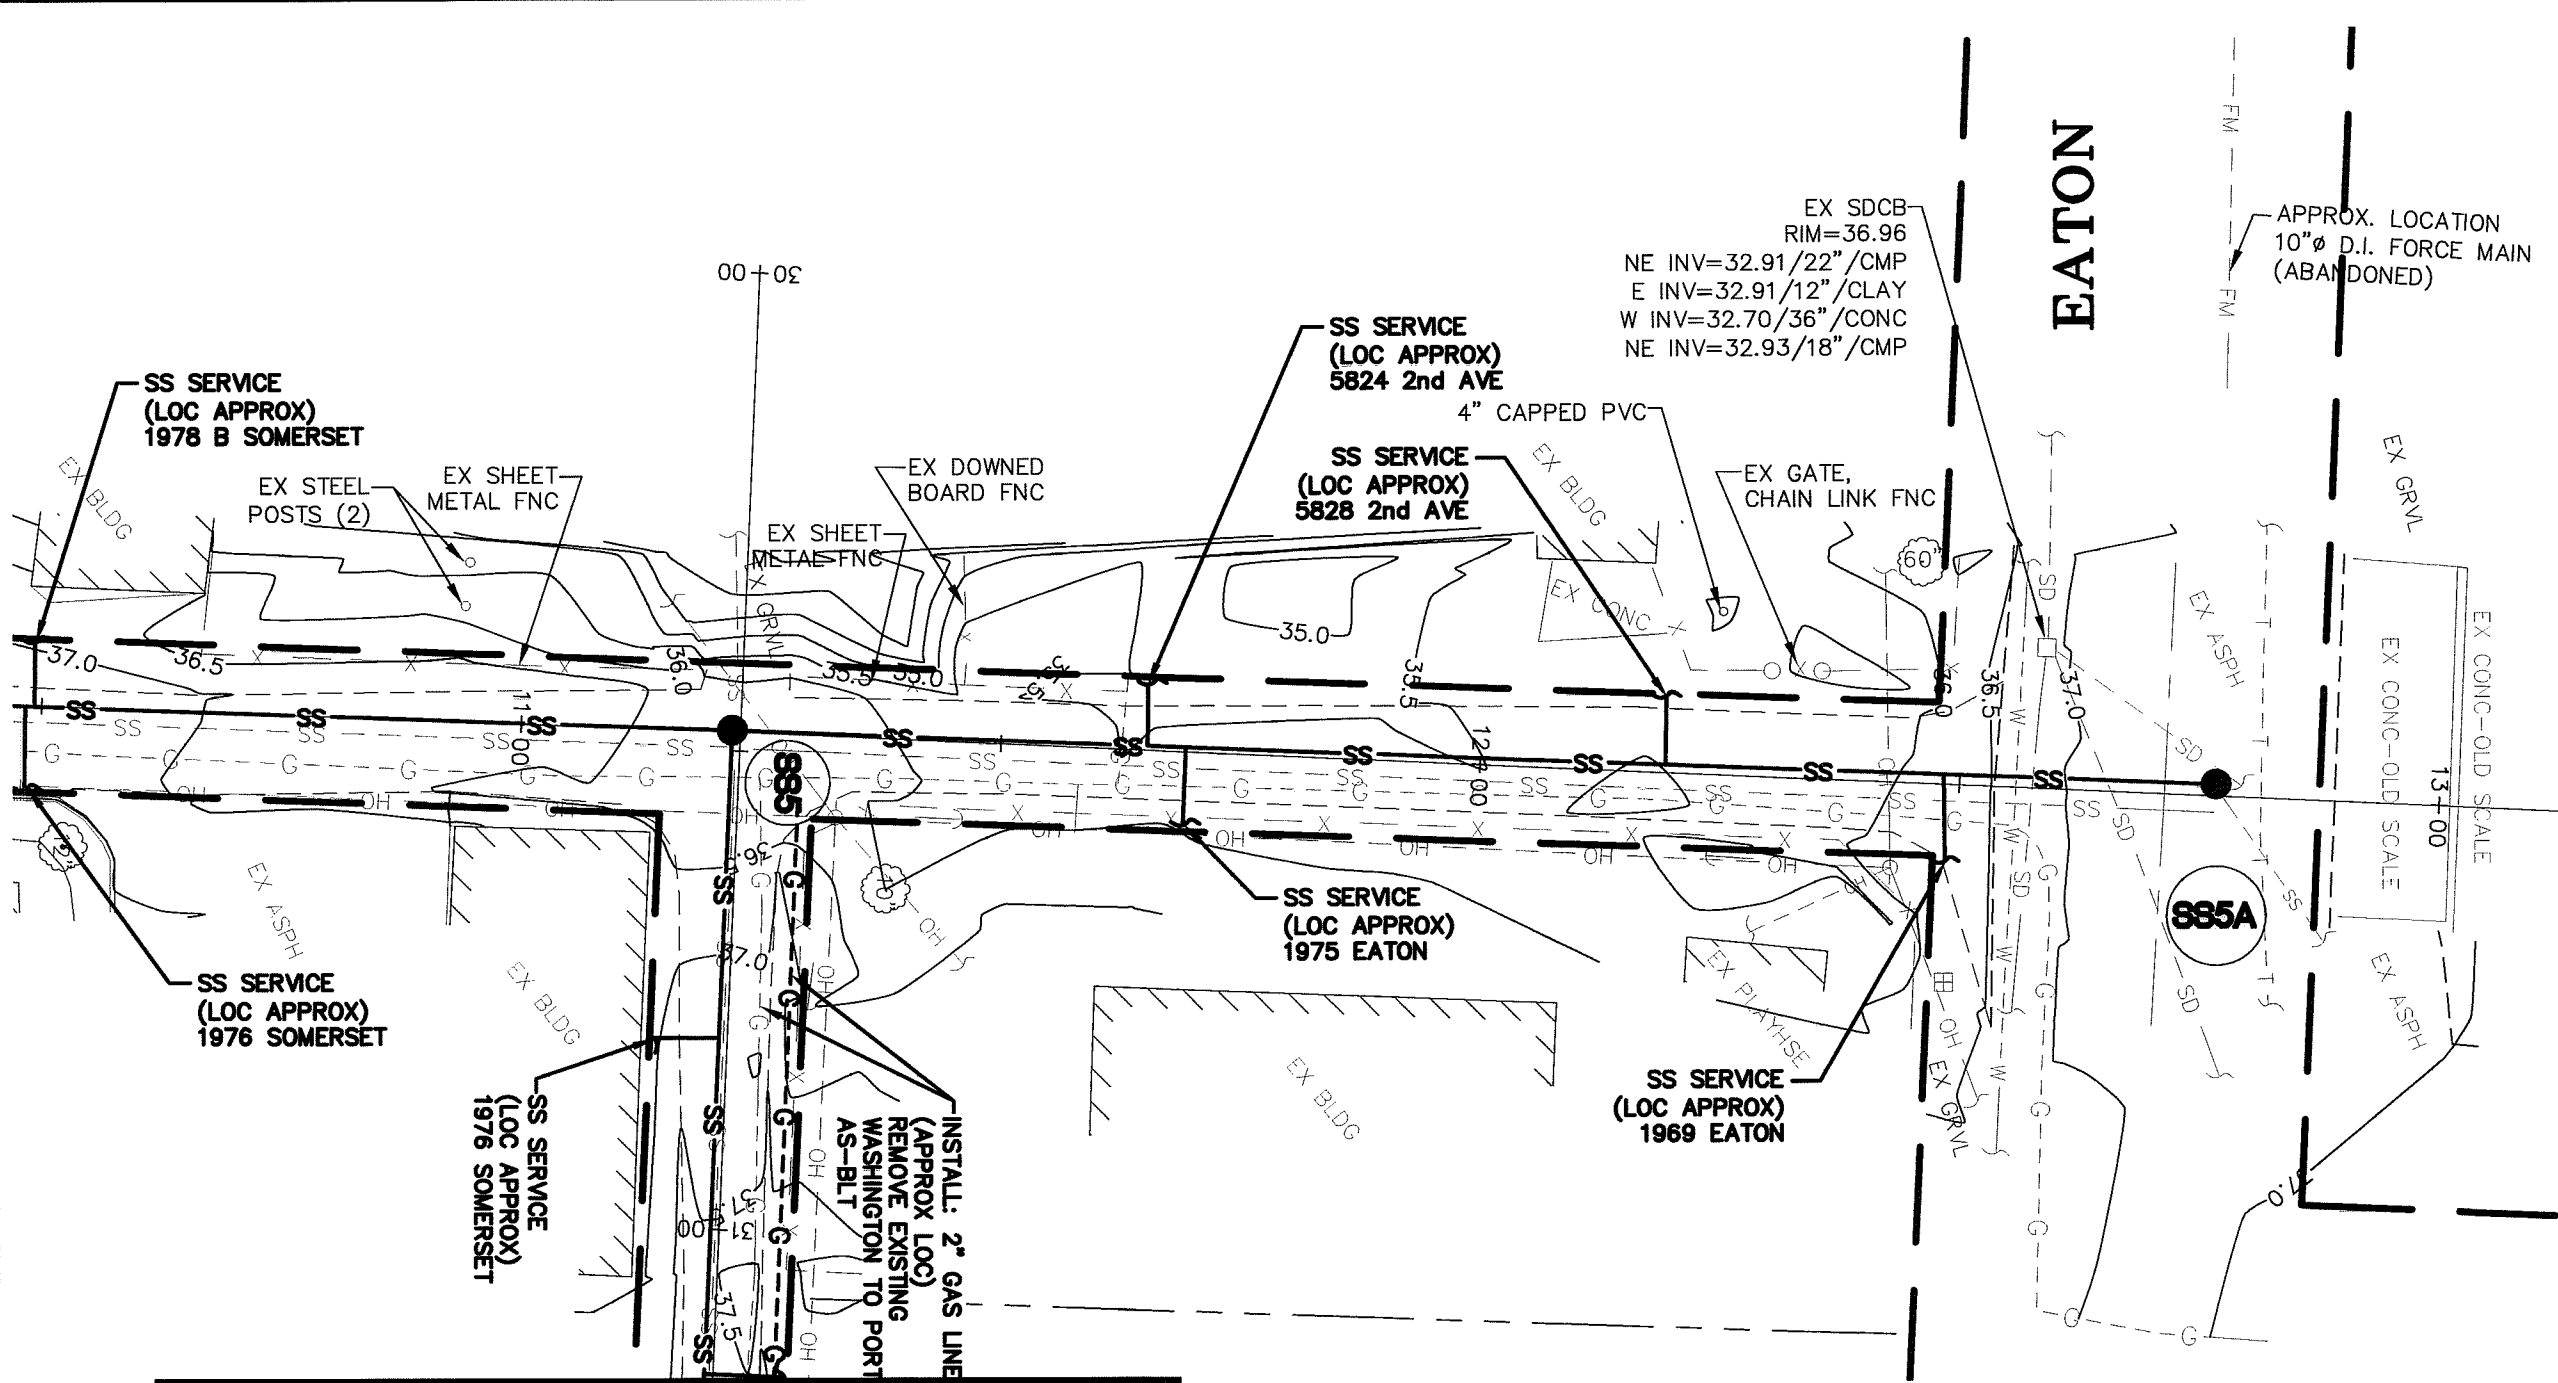

NOTE: UNLESS NOTED, SIDE SEWER LOCATIONS UNKNOWN. CONTRACTOR TO DETERMINE SIDE SEWER LOCATIONS AS THE NEW MAIN IS INSTALLED. FOR BASE BID, NEW SIDE SEWERS SHALL BE INSTALLED FROM NEW MAIN TO RIGHT OF WAY.

SHT 10 FOR CONTINUATION

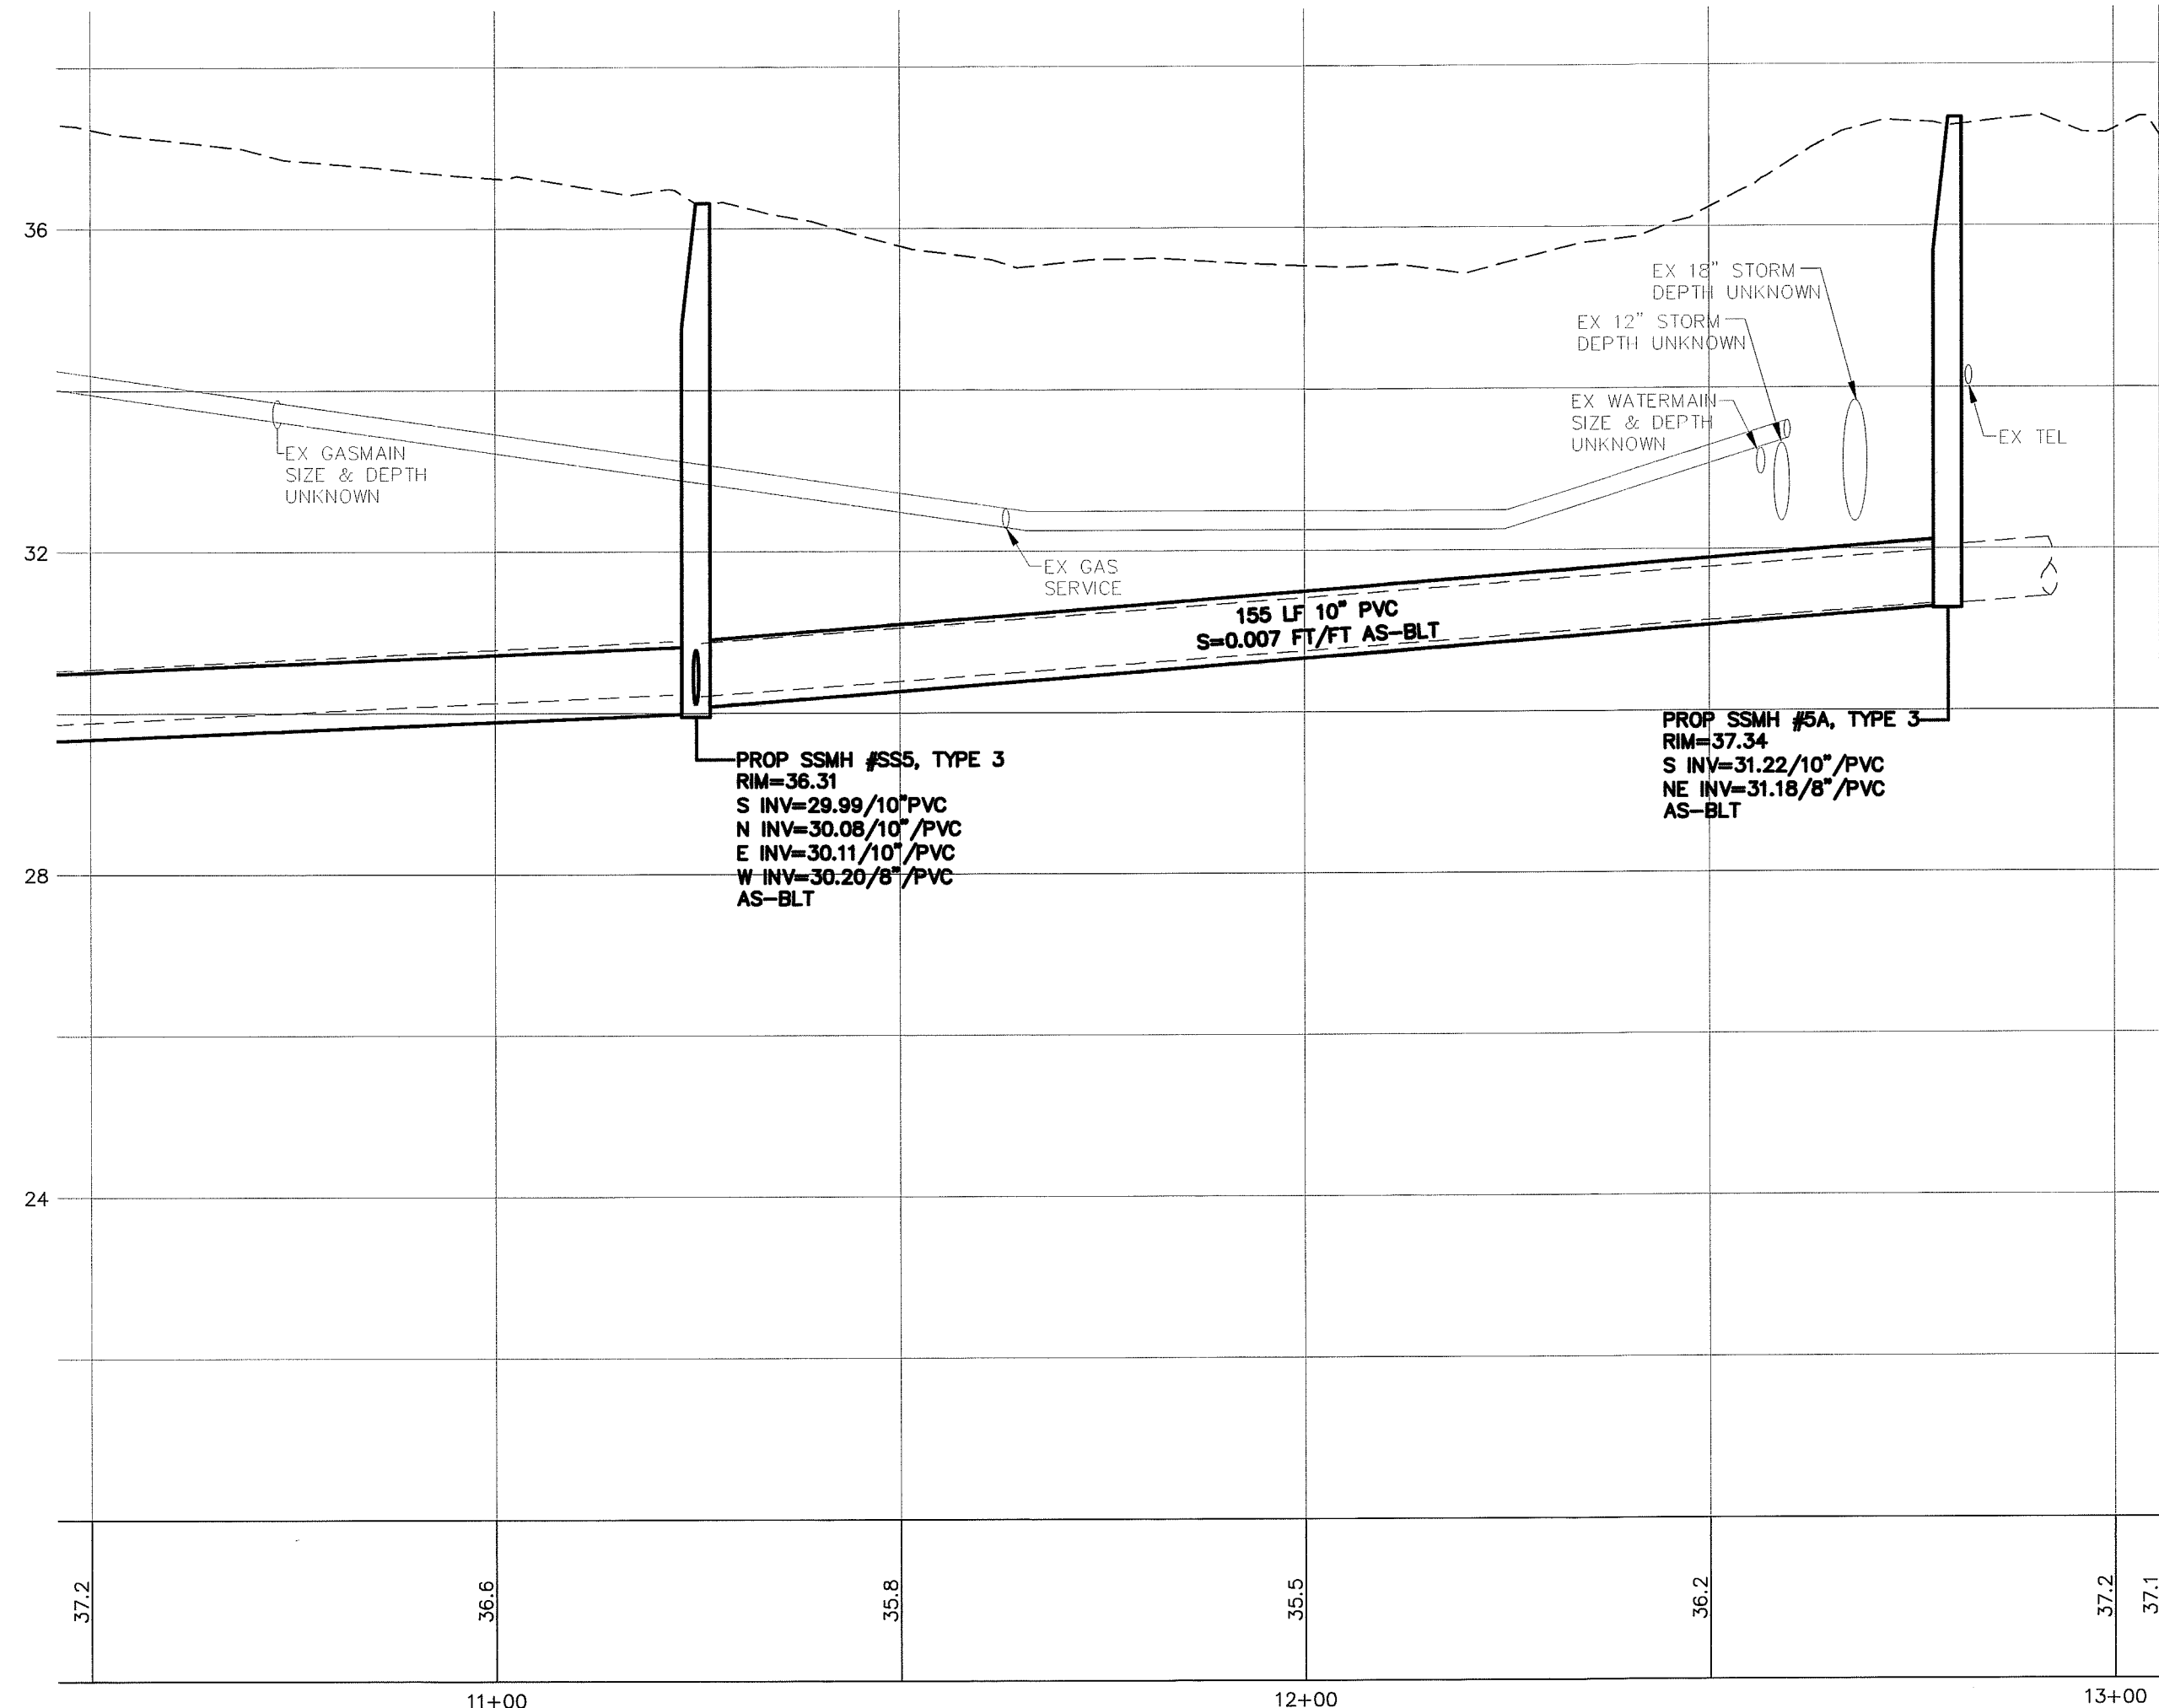

APPROVED

MAR 22 2013
BY *J. M. L...* P.E.
CITY OF FERDALE


DATE: 1-15-13
AS-BUILT



DESIGNED BY LP	 REICHHARDT & EBE ENGINEERING, INC. CONSULTING ENGINEERS PO Box 978 423 Front St., Ste 201 Lynden, Washington 98264 Ph (360) 354-3687 Fax (360) 354-0407						CITY OF FERINDALE 2095 MAIN ST FERINDALE, WA 98248	EATON, SOMERSET, WILLARD AND WASHINGTON SEWER PROJECT PROPOSED SANITARY SEWER BASE BID	JOB# / DWG 11007.1 AD1 SP2.AB	DATE 9-26-11
DRAWN BY LMC									SCALE H: 1" = 20' V: 1" = 2'	SHEET 8 of 12
CHECKED BY LP										

11007.dwg\\ADDENDUM 1 9-9-11\\SP2\\AB.dwg, ALLEY, WA-EATON 2, 11/5/2013 10:13:21 AM

11007.dwg\\ADDENDUM 1 9-9-11\\SP2\\AB.dwg, ALLEY, WA-EATON 2, 11/5/2013 10:13:21 AM

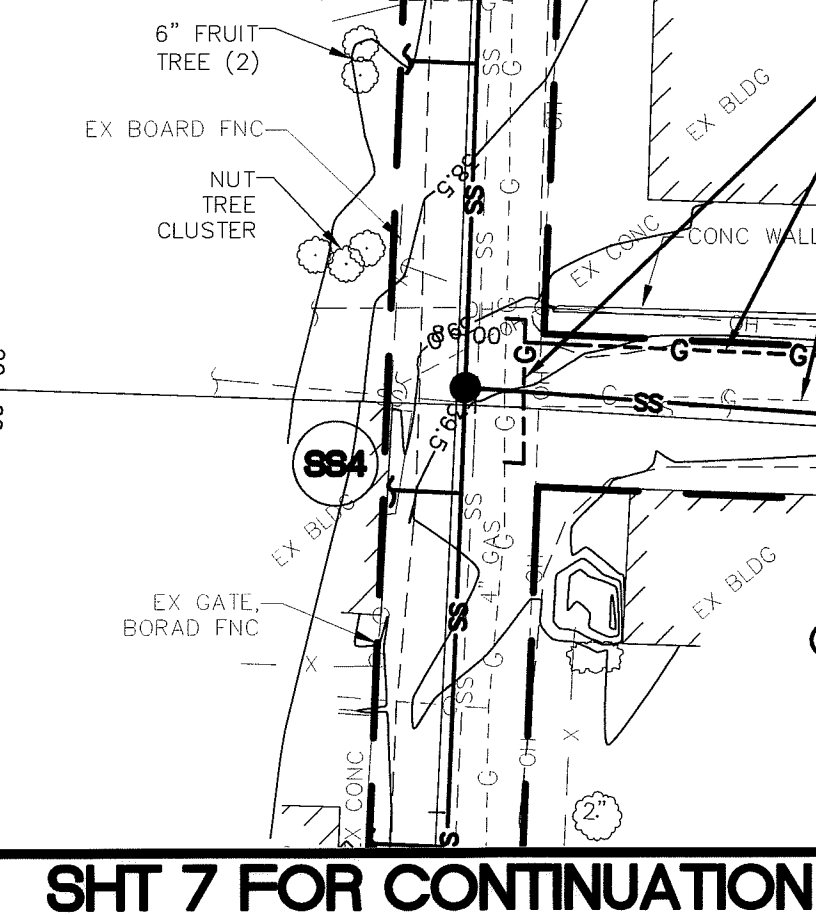

SS SERVICE-
(LOC APPROX)
1949 SOMERSET


SS SERVICE
(LOC APPROX)
5802 CEDAR

SS SERVICE (4" PVC)
(LOC APPROX)
5796 CEDAR

SS SERVICE
(LOC APPROX)

8.07 SS SERVICE (6" P
(LOC APPROX)
5786 CEDAR

SS SERVICE (2" PUMP MAIN)
(LOC APPROX)
5784 PORTAL WAY

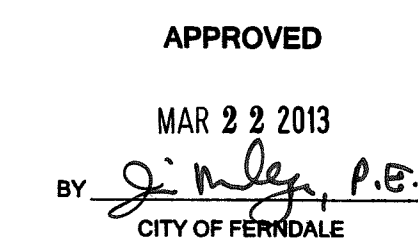

DATE:

AS-BUILT

PROP SSMH #SS4.2, TYPE 1
RIM=32.55
INV=30.95/8"
(NOT AS-BLT)




JOB# / DWG
11007.1 AD1 SP2.AE
SCALE
H:1"=20' V:1"=2'



DATE	9-26-11
------	---------

SHEET
9 of 12


00552.010 3/26/13 514

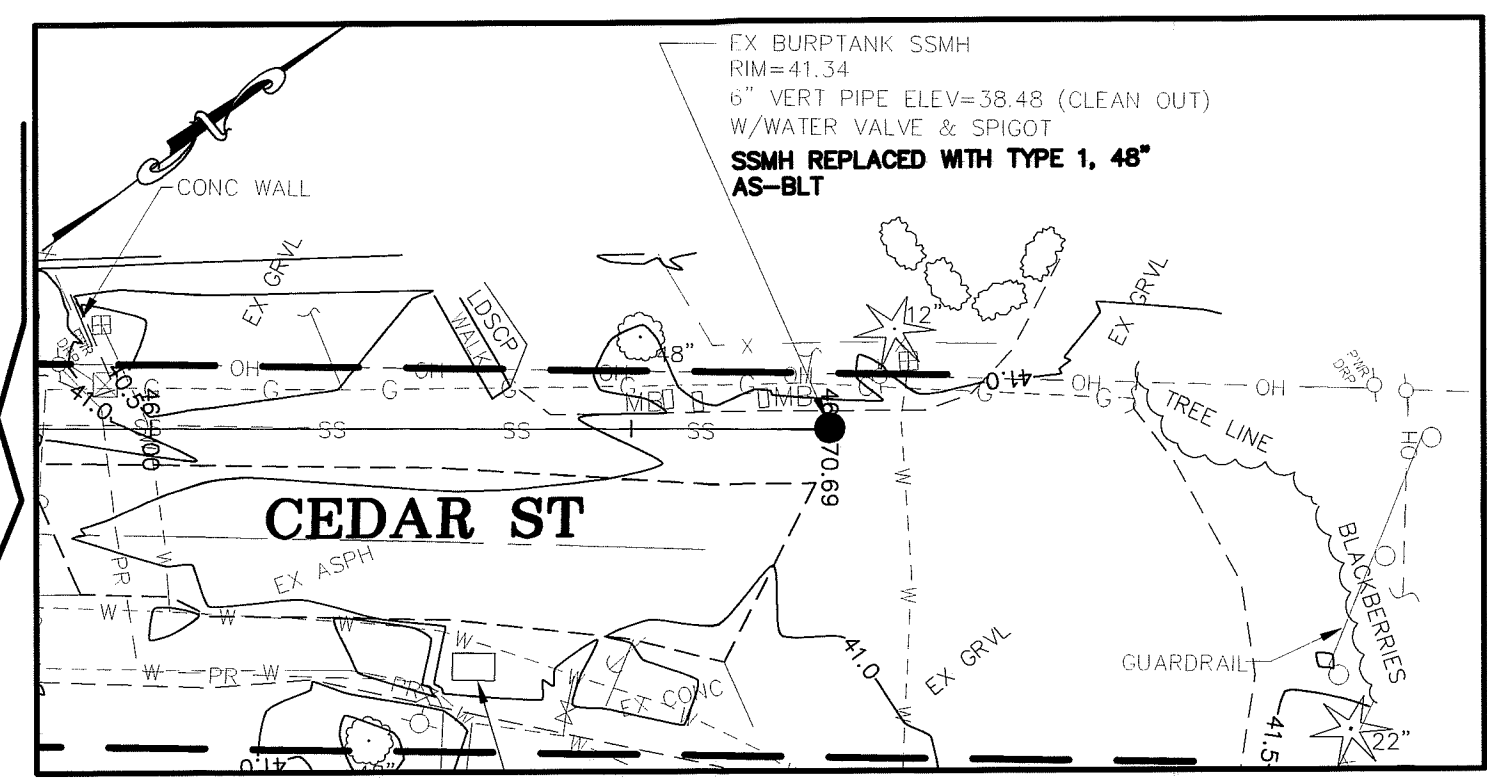

1190± TO NEW SSMH AT STA 46+70

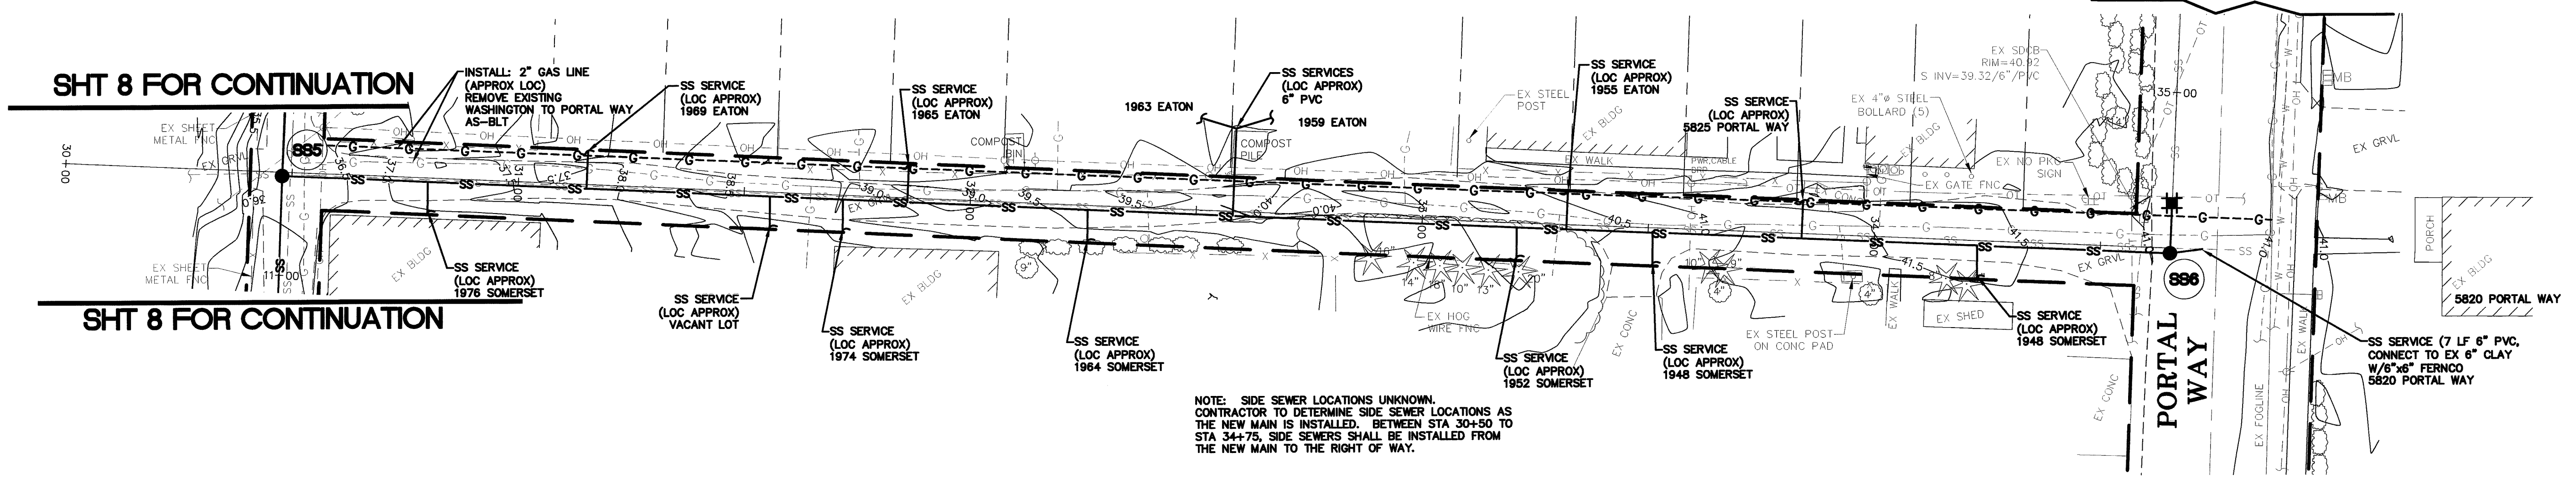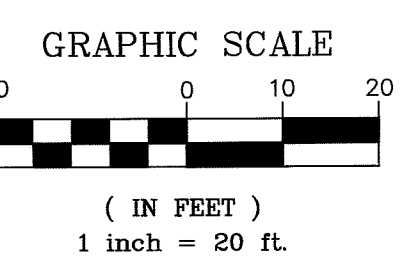


NOTE: SIDE SEWER LOCATIONS UNKNOWN. CONTRACTOR TO DETERMINE SIDE SEWER LOCATIONS AS THE NEW MAIN IS INSTALLED. BETWEEN STA 30+50 TO STA 34+75, SIDE SEWERS SHALL BE INSTALLED FROM THE NEW MAIN TO THE RIGHT OF WAY.

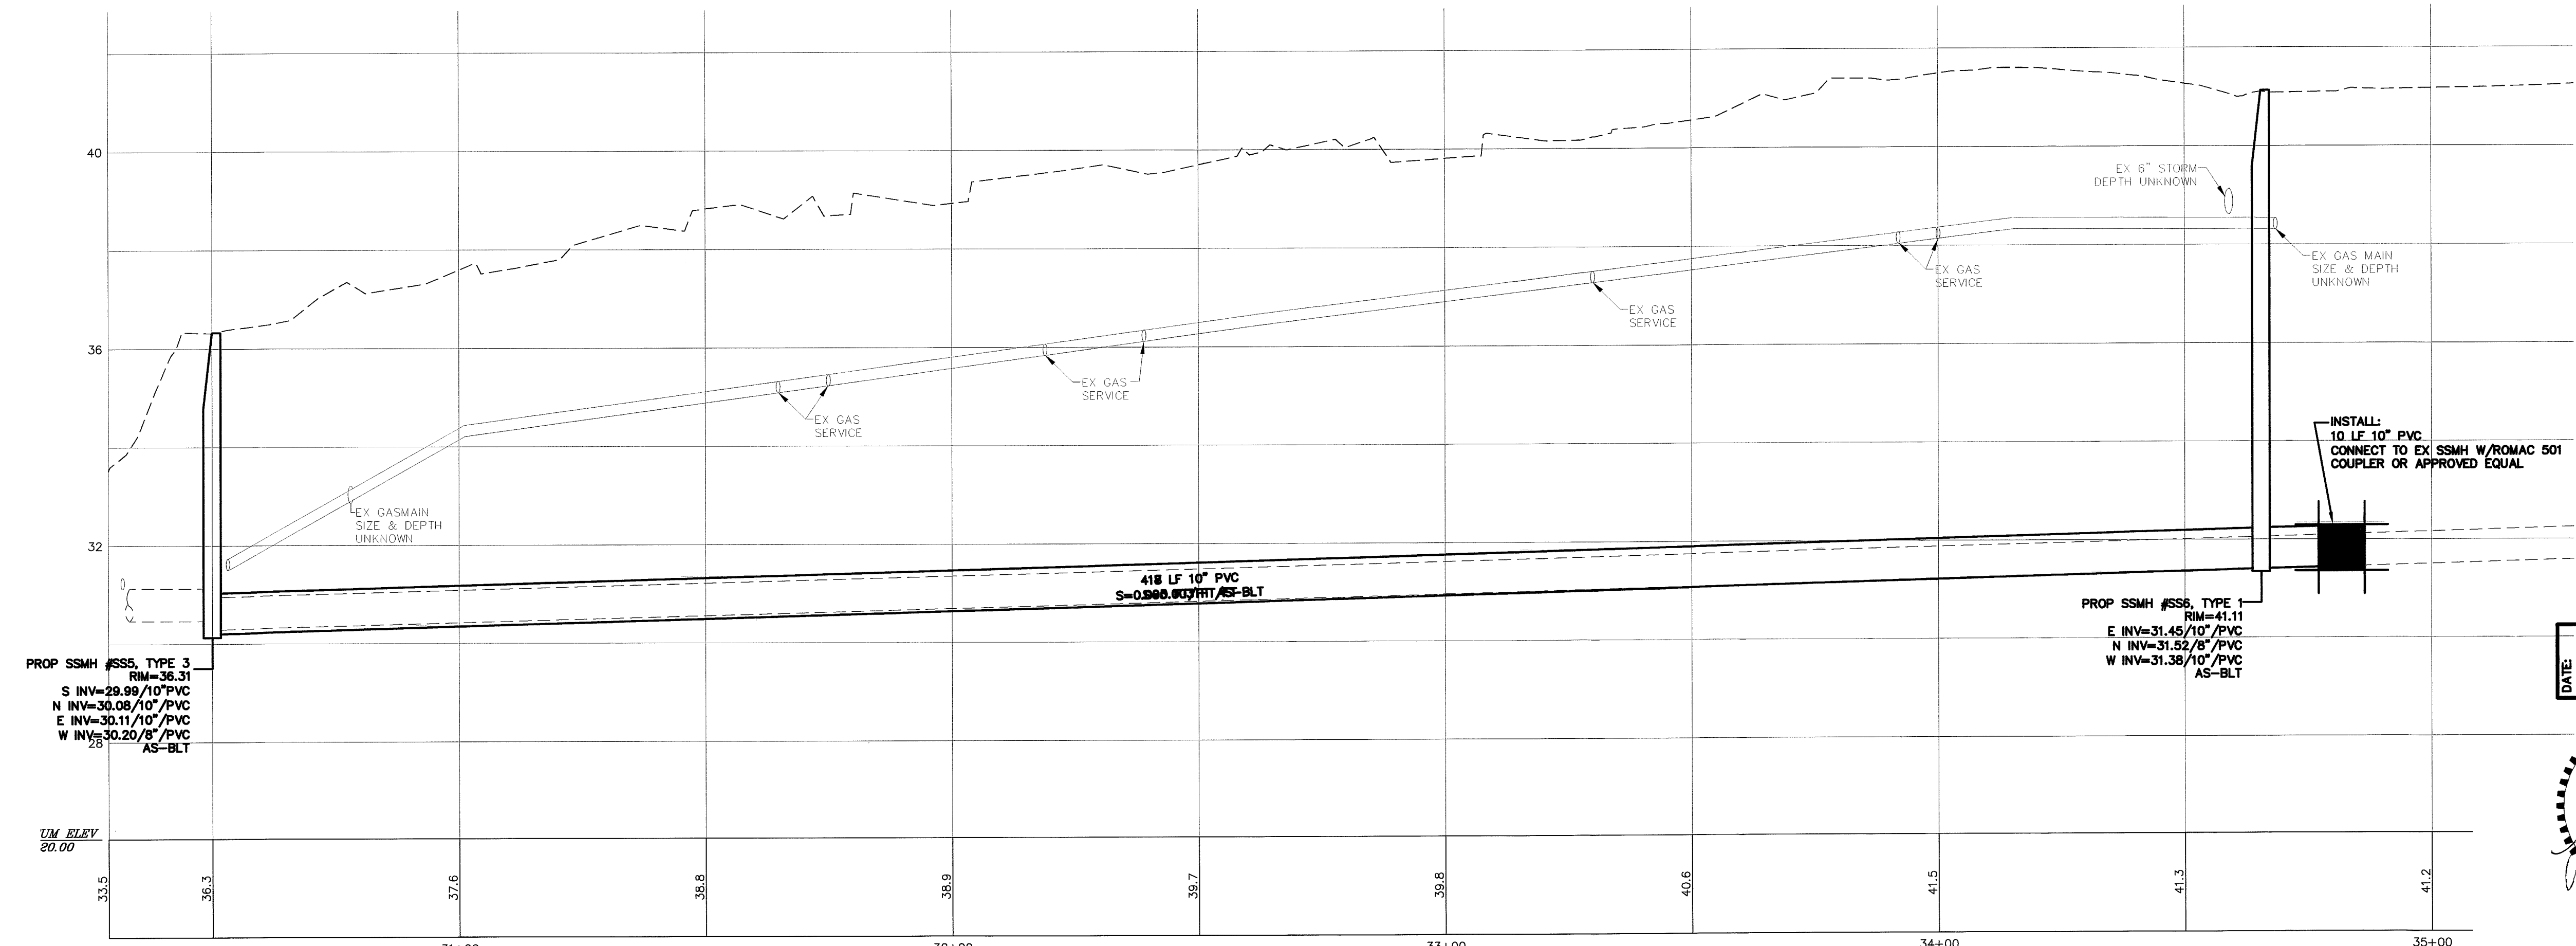

APPROVED
MAR 22 2013
BY *[Signature]* P.E.
CITY OF FERDALE

DATE 1-15-13
AS-BUILT

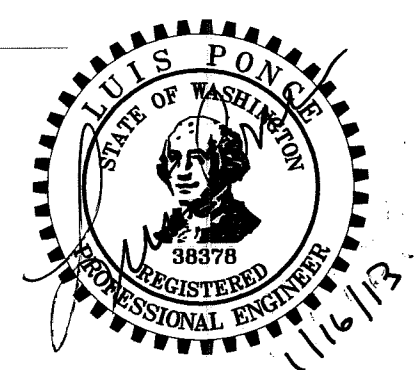


DESIGNED BY LP		REICHARDT & EBE ENGINEERING, INC. CONSULTING ENGINEERS PO Box 978 423 Front St., Ste 201 Lynden, Washington 98284 Ph (360) 354-3687 Fax (360) 354-0407	NO.	DATE	REVISION	BY	CITY OF FERDALE 2095 MAIN ST FERDALE, WA 98248	EATON, SOMERSET, WILLARD AND WASHINGTON SEWER PROJECT PROPOSED SANITARY SEWER ALTERNATE A1	JOB# / DWG 11007.1 AD1 SP2.AB	DATE 9-26-11
DRAWN BY LMC									SCALE H:1"=20' V:1"=2'	SHEET 10 of 12
CHECKED BY LP										

11007.dwg\\ADDENDUM 1 9-6-11\\SP2.AB.dwg, N. ALLEY, 1/15/2013 10:13:41 AM



TYPICAL TRENCH SECTION ASPHALT CONCRETE PAVEMENT

NTS

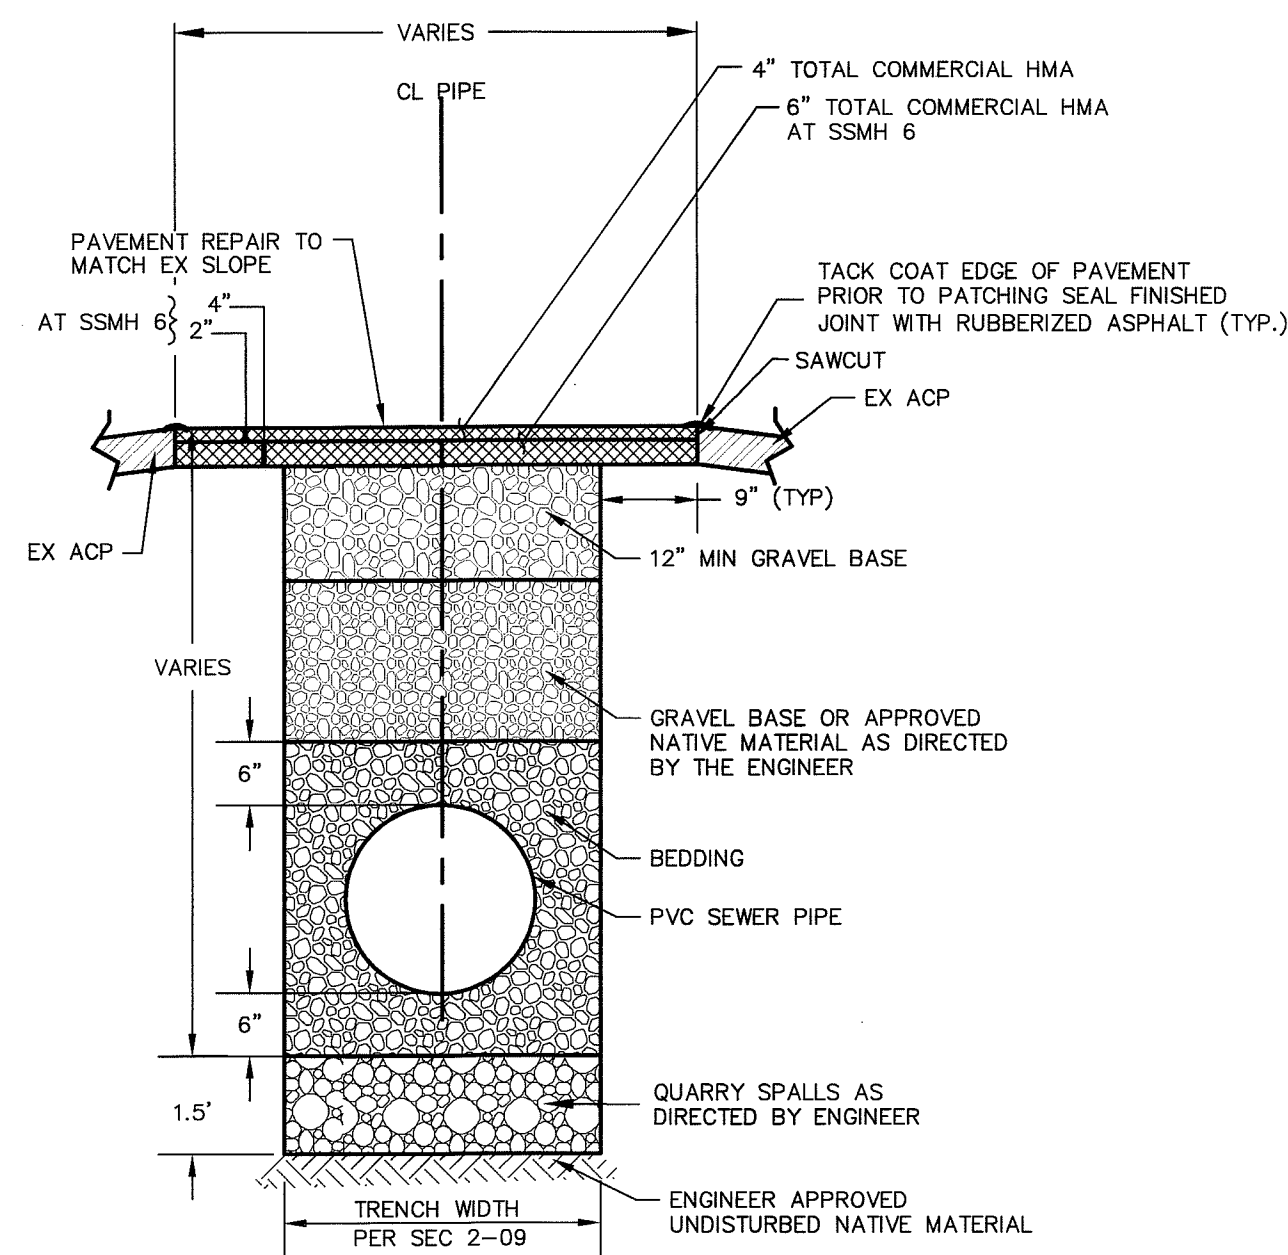


TYPICAL TRENCH SECTION GRAVEL ROADWAY

NTS

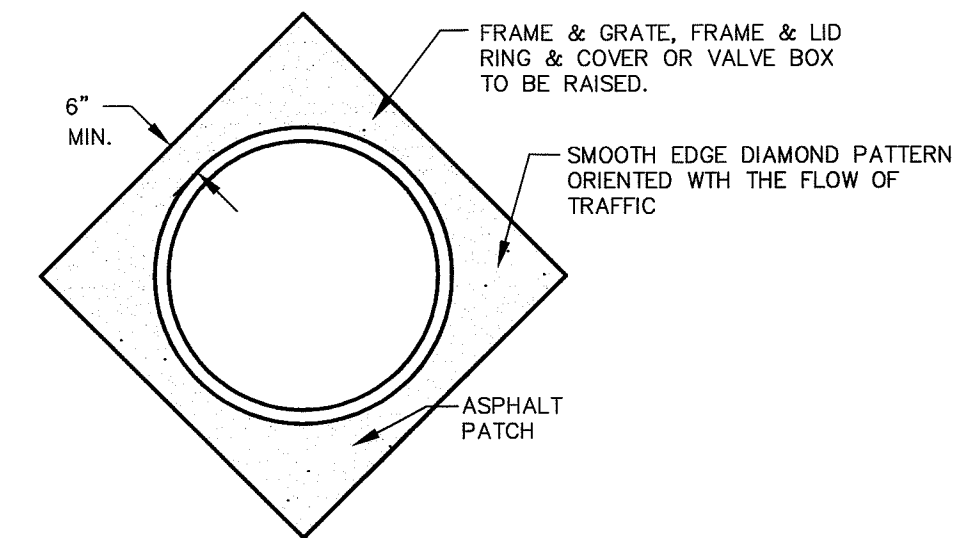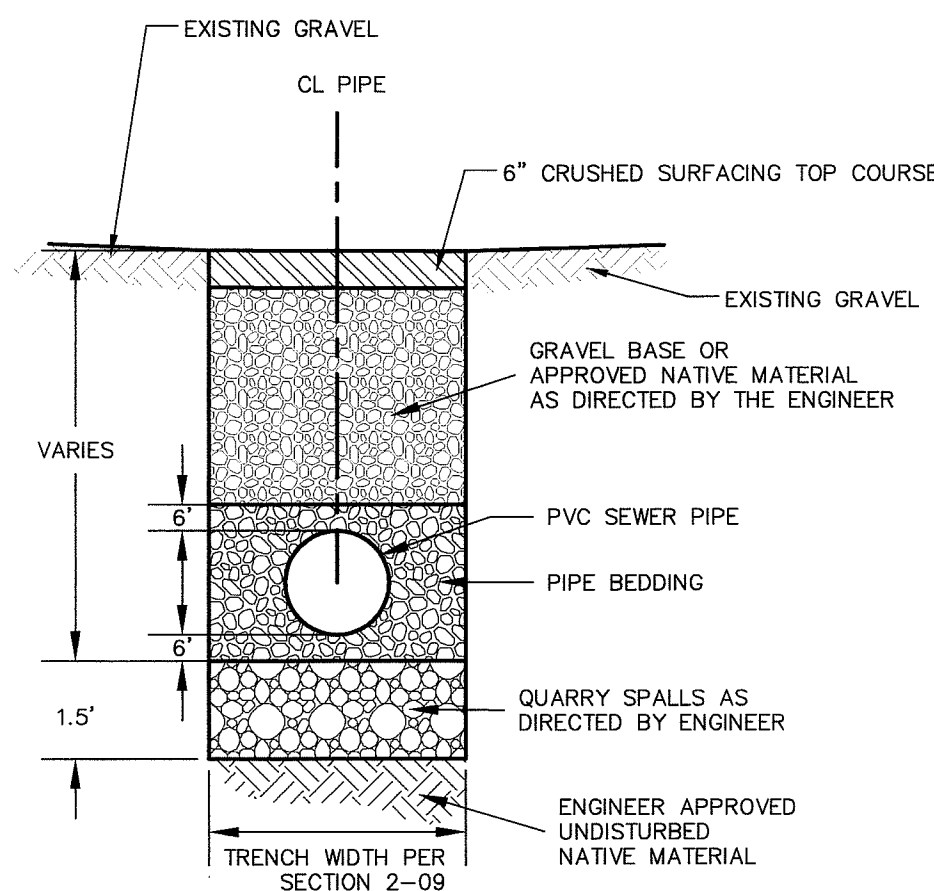

NOTES:

- ALL FRAMES, COVERS AND VALVE BOXES SHALL BE ADJUSTED TO FINISHED GRADE AFTER THE FINAL LIFT OF PAVING HAS BEEN COMPLETED. THE FOLLOWING PROCEDURE SHALL BE USED:
1. CUT THE ASPHALT IN A DIAMOND AROUND THE STRUCTURE CASTING TO BE ADJUSTED.
2. REMOVE THE FILL MATERIAL WITHIN THE CUT PAVEMENT AREA TO 8 INCHES MIN. BELOW FINISH GRADE.
3. PLACE THE CASTING AT FINISH GRADE.
4. PLACE PORTLAND CEMENT CONCRETE TO WITHIN THE TOP 2 INCHES OF FINISH GRADE.
5. APPLY TACK TO THE STRUCTURE CASTING, CUT PAVEMENT, AND PC CONCRETE.
6. PLACE AND COMPACT 2 INCHES OF COMMERCIAL HMA TO FINISH GRADE.
7. SEAL PAVEMENT JOINTS WITH HOT AR4000 AND TOP WITH SAND.

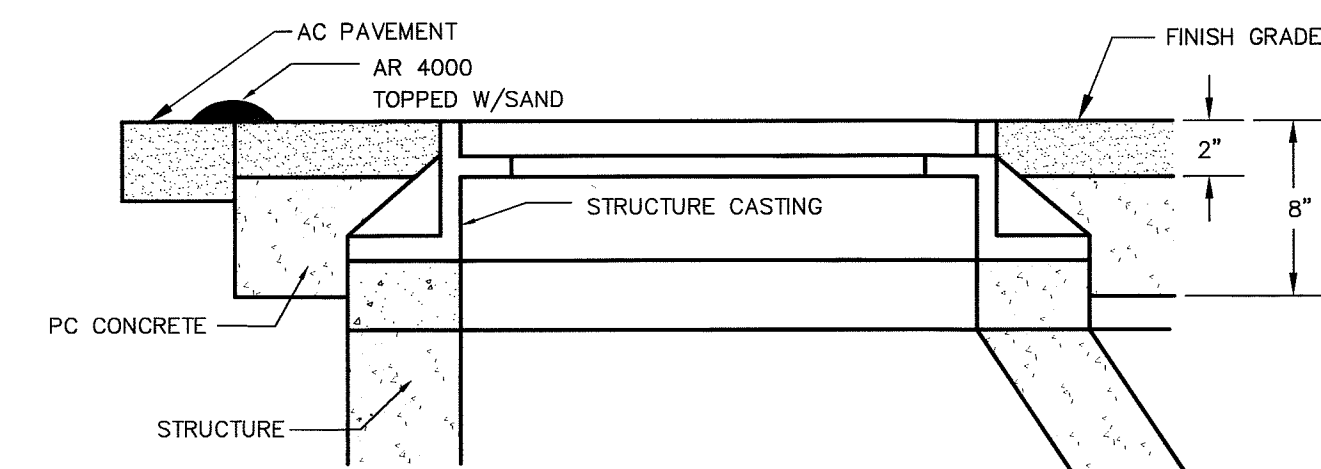

ADJUSTING CASTINGS TO FINISHED GRADE


NTS

APPROVED

MAR 22 2013

BY *J. M. L.*, P.E.
CITY OF FERNDALE

SUBMITTED WITH
DESIGN PLAN

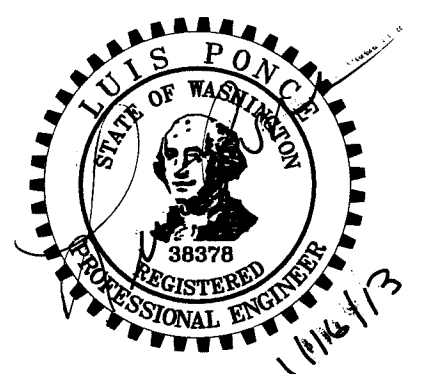

DESIGNED BY
LP
DRAWN BY
LMC
CHECKED BY
LP



REICHHARDT & EBE
ENGINEERING, INC.
CONSULTING ENGINEERS
PO Box 978 423 Front St., Ste 201 Ph (360) 354-3687
Lynden, Washington 98264 Fax (360) 354-0407


NO. DATE REVISION BY

CITY OF FERNDALE
2095 MAIN STREET
FERNDALE, WA 98248

EATON, SOMERSET, WILLARD AND
WASHINGTON SEWER PROJECT
DETAIL SHEET


JOB# / DWG
11007.1 AD1 DET2
SCALE
H: n/a V: n/a
DATE
9-19-11
SHEET
11 of 12

20552-D11 3/24/13 ST

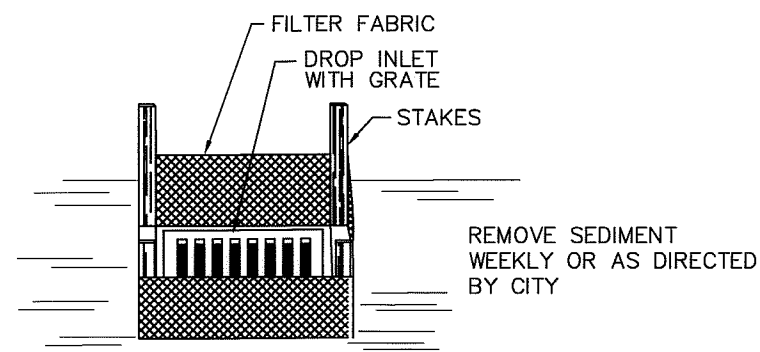

INLET PROTECTION DETAIL

NTS

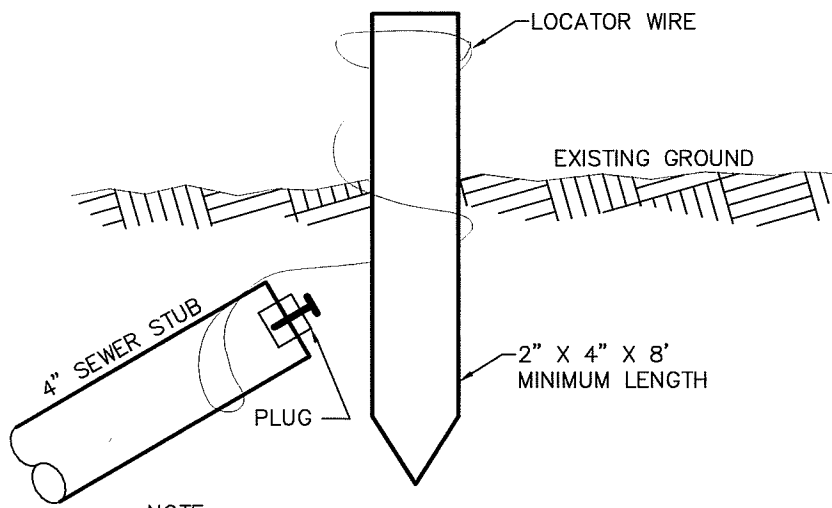


NOTE: STAKE SHALL BE PAINTED GREEN WITH DEPTH TO INVERT LABELED IN WHITE PAINT.

SEWER SERVICE STAKE

NTS

GENERAL EROSION CONTROL NOTES

1. ALL WORK AND MATERIALS SHALL BE IN ACCORDANCE WITH THE CONTRACT DOCUMENTS.
2. ALL CUT AND FILL SLOPES SHALL BE SEEDED AND FERTILIZED FOR EROSION CONTROL. CONTRACTOR SHALL BE RESPONSIBLE FOR SLOPE EROSION UNTIL VEGETATION IS FIRMLY ESTABLISHED.
3. CONTRACTOR SHALL INFORM THE ENGINEER AND OBTAIN APPROVAL FROM THE ENGINEER OF ANY PROPOSED CHANGES IN PLAN PRIOR TO CONSTRUCTION OF THAT CHANGE. CONTRACTOR SHALL KEEP RECORD OF DEVIATIONS AND FORWARD TO THE ENGINEER.
4. CONTRACTOR WILL HAVE A WATER TRUCK AVAILABLE ON SITE AT ALL TIMES. CONTRACTOR WILL WATER SURFACES OFTEN ENOUGH TO ABATE DUST AS APPROVED BY THE ENGINEER. WATERING WILL INCLUDE WEEKENDS AND HOLIDAYS.
5. THE CONTRACTOR SHALL BE RESPONSIBLE FOR IMPLEMENTATION OF THE SEDIMENTATION AND EROSION CONTROL MEASURES AS SHOWN.
6. THE CONSTRUCTED EROSION CONTROL AND SEDIMENTATION PLAN SHALL BE APPROVED BY THE ENGINEER PRIOR TO PERFORMING ANY SITE GRADING OR CLEARING.
7. MAINTENANCE AND OPERATION OF THE EROSION CONTROL AND SEDIMENTATION SYSTEM SHALL BE THE RESPONSIBILITY OF THE CONTRACTOR. THE CONTRACTOR SHALL BE RESPONSIBLE FOR IMPLEMENTATION OF THE SEDIMENTATION AND EROSION CONTROL MEASURES.
8. ANY VEGETATION NOT IN THE CONSTRUCTION AREA SHALL BE LEFT UNDISTURBED.
9. ALL CLEARING LIMITS SHALL BE VISIBLY MARKED PRIOR TO CLEARING.
10. ALL STORM DRAIN FACILITIES WITHIN THE PROJECT BOUNDARY, OR WHICH ARE IMPACTED BY THE PROJECT ARE TO BE CLEARED OF SEDIMENT AND DEBRIS PRIOR TO FINAL ACCEPTANCE OF THE PROJECT.
11. THIS PLAN REPRESENTS THE MINIMUM REQUIREMENTS FOR THIS PROJECT. ADDITIONAL EROSION CONTROL MAY BE REQUIRED BY THE ENGINEER AS ARE FOUND NECESSARY.
12. THE TEMPORARY EROSION CONTROL SYSTEMS SHALL BE INSTALLED PRIOR TO ALL OTHER SITE CONSTRUCTION.
13. REFERENCE WSDOT STANDARD SPECIFICATIONS FOR ROAD, BRIDGE & MUNICIPAL CONSTRUCTION, 2008 FOR STREET SWEEPING REQUIREMENTS.

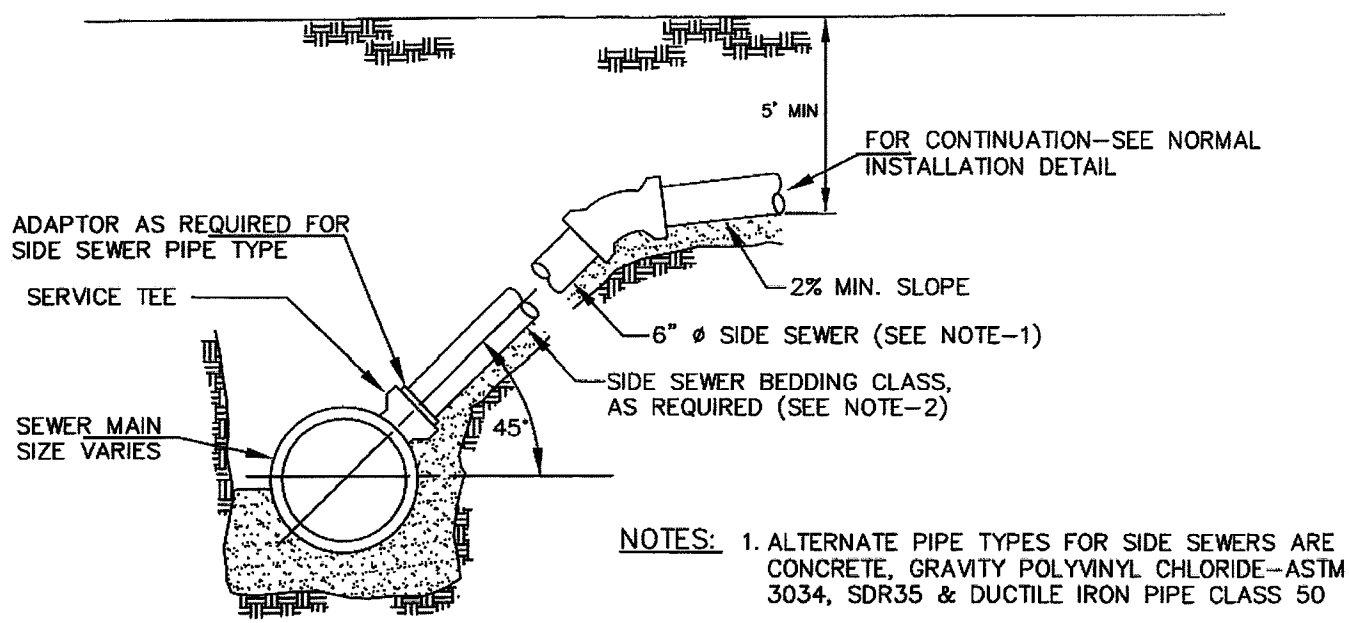


NORMAL INSTALLATION
18" AND LARGER MAINS

NOT TO SCALE

SIDE SEWER

APPROVED	CITY OF FERNDALE NORMAL SANITARY SEWER SERVICE INSTALLATION 18" AND LARGER MAINS	DRAWING SS-7
Public Works Director	Date	

JUNE 1995

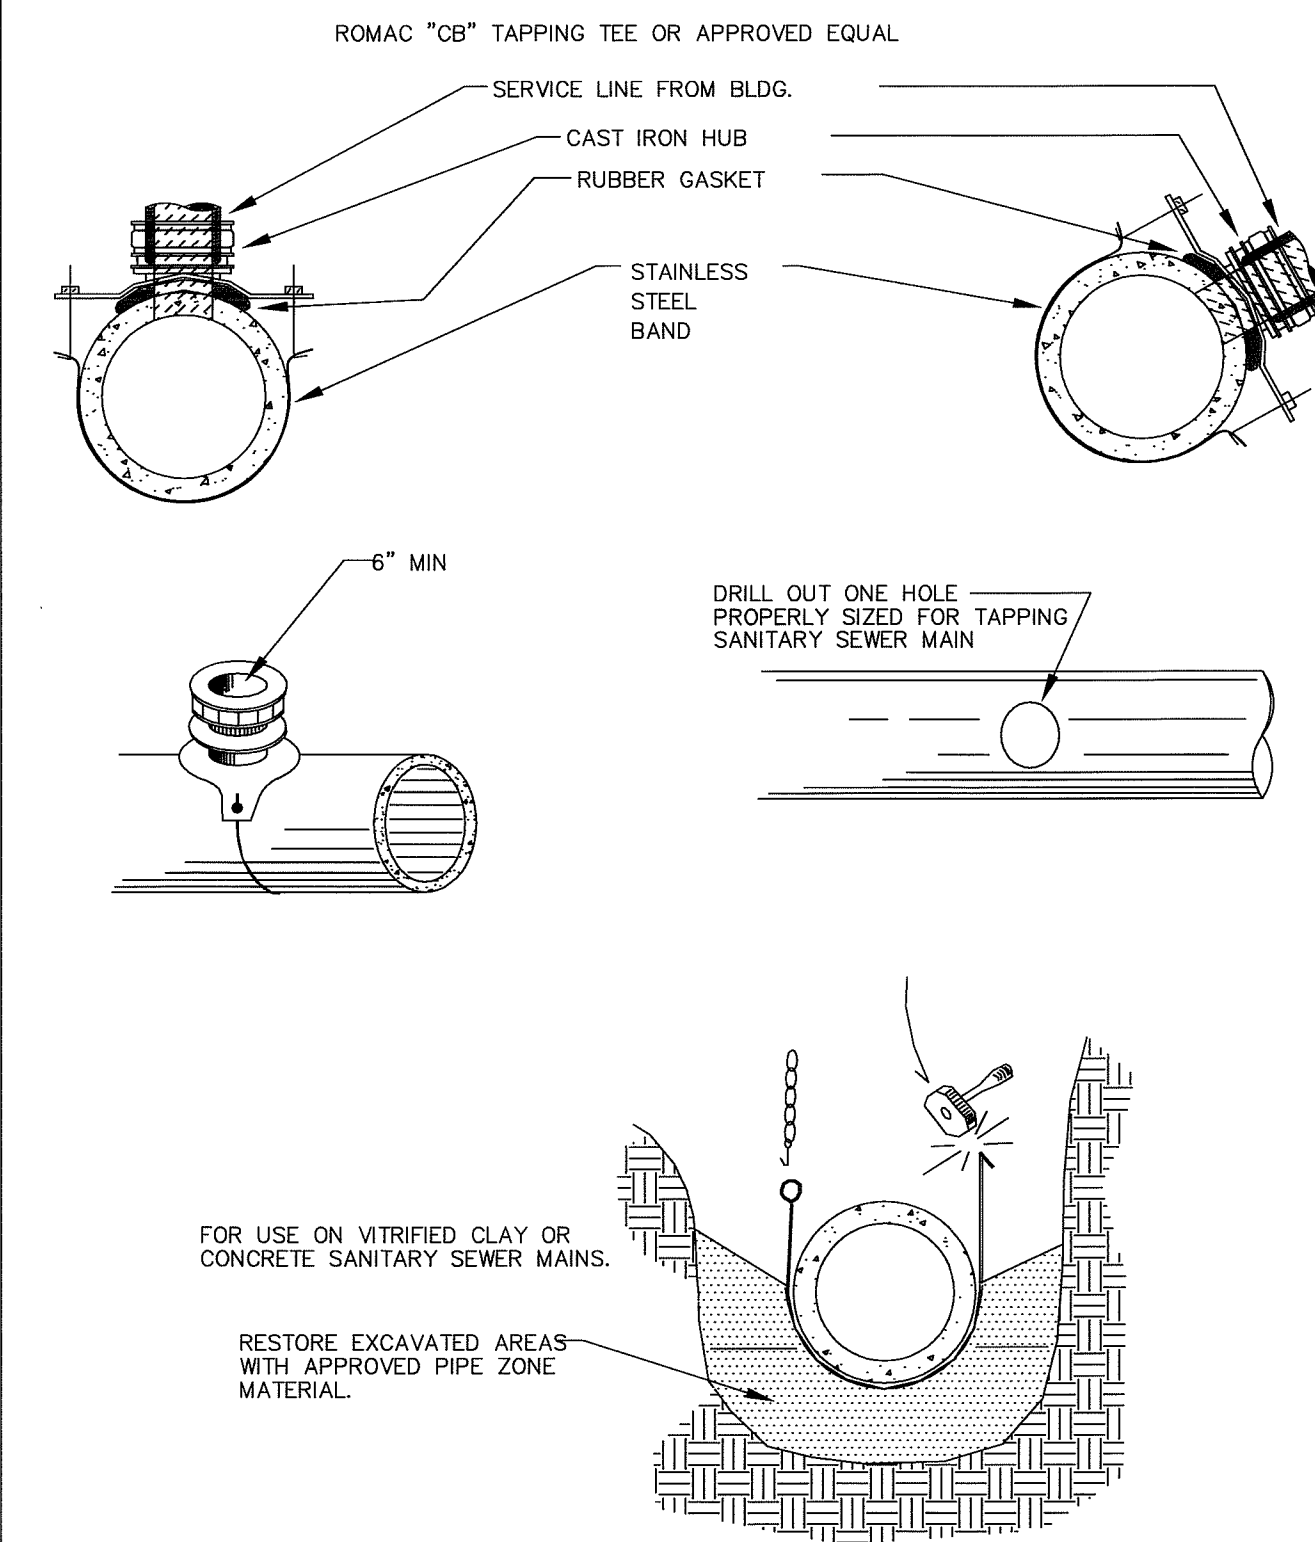


NOT TO SCALE

APPROVED	CITY OF FERNDALE SANITARY SEWER BANDED TAPPING TEE	DRAWING SS-12
Public Works Director	Date	

JULY 2001

2" SQUARE CONCRETE BLOCK TO ENCASE CLEAN-OUT. IN AREAS WHERE CLEAN-OUT OCCURS IN ASPHALT, THIS BLOCK IS TO BE LEFT APPROX. 1 1/2" LOW TO ALLOW FOR AN ASPHALT TOPPING OF LIKE MIXTURE AS THE SURROUNDING AREA. IF CLEAN-OUT OCCURS IN CONCRETE OR IN SOME TYPE OF SOIL, THE BLOCK IS TO BE MADE THE FULL 1' DEPTH AND FLUSH WITH THE SURROUNDING SURFACE.

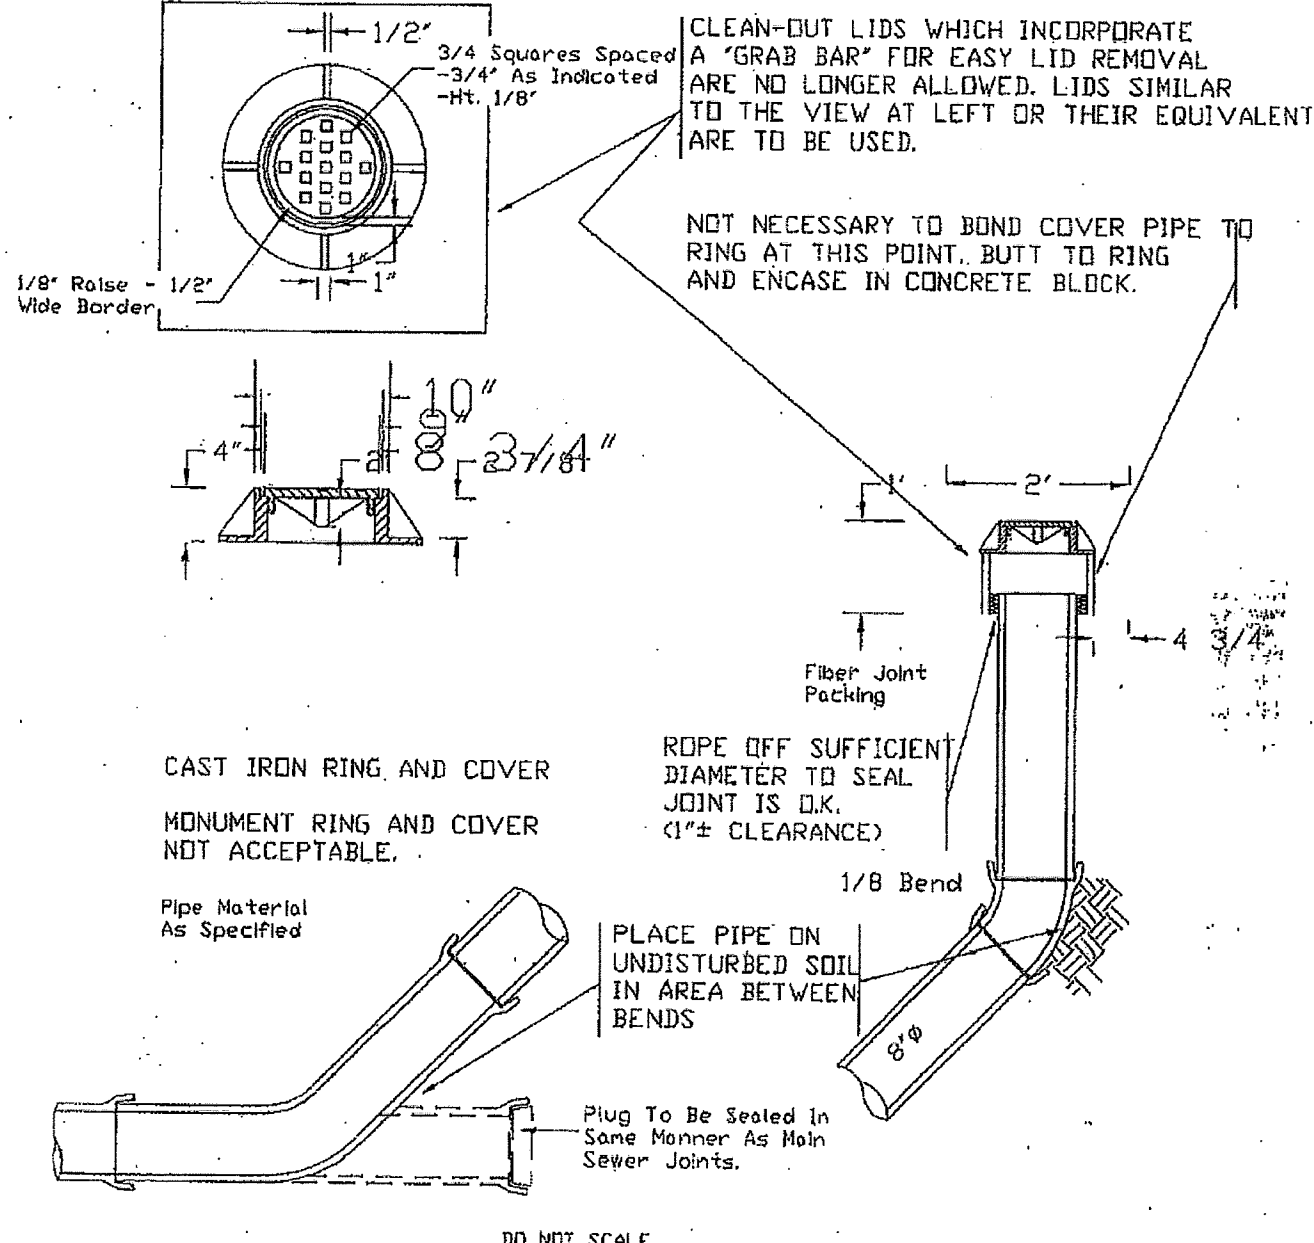

SSCD 04/30/92 16:17


NOT TO SCALE

APPROVED	CITY OF FERNDALE 8" CLEAN OUT	DRAWING SS-5
Public Works Director	Date	

JANUARY 1993

APPROVED
MAR 22 2013
BY *J. J. J.* P.E.
CITY OF FERNDALE

SUBMITTED WITH
DESIGN PLAN

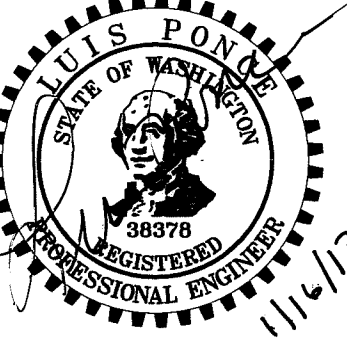

DESIGNED BY
LP
DRAWN BY
LMC
CHECKED BY
LP



REICHHARDT & EBE
ENGINEERING, INC.
CONSULTING ENGINEERS
PO Box 978 423 Front St., Ste 201
Lynden, Washington 98264
Ph (360) 354-3687
Fax (360) 354-0407

NO.	DATE	REVISION	BY

CITY OF FERNDALE
2095 MAIN STREET
FERNDALE, WA 98248

EATON, SOMERSET, WILLARD AND
WASHINGTON SEWER PROJECT
DETAIL SHEET

JOB# / DWG 11007.1 AD1 DET2	DATE 9-19-11
SCALE H:n/a V:n/a	SHEET 12 of 12