


1964 SOMERSET ST DEVELOPMENT

CIVIL CONSTRUCTION PLANS

CITY OF FERNDALE, WASHINGTON

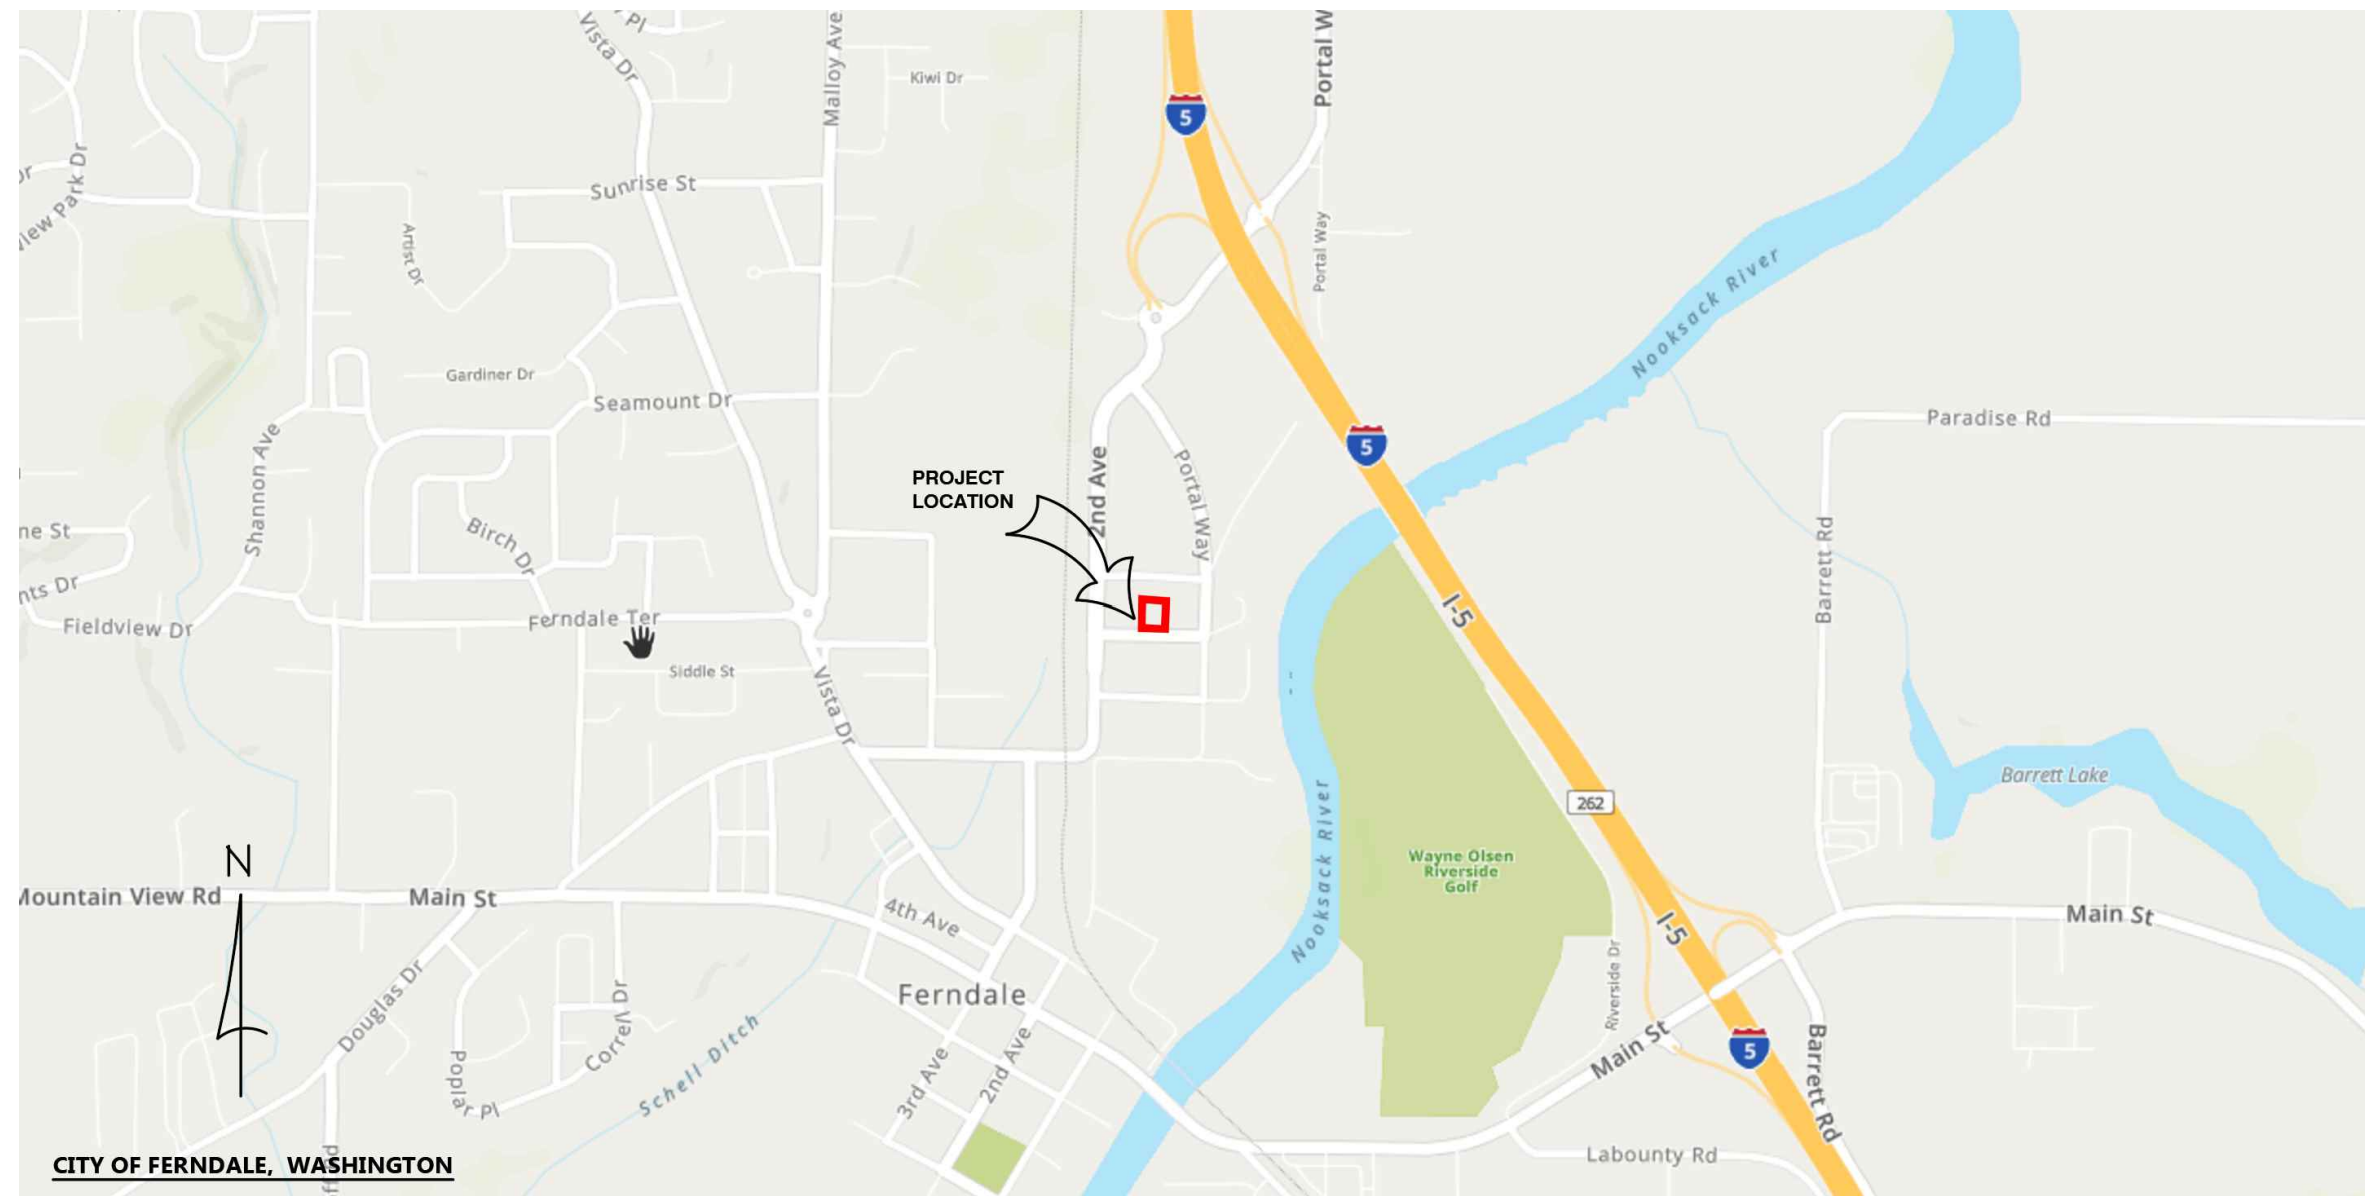

VICINITY MAP

PARCEL # 390220 202169
A PORTION OF SECTION 20, TOWNSHIP 39
NORTH, RANGE 2 EAST, W.M.

CITY OF FERNDALE, WASHINGTON

CONTRACT DRAWINGS FOR:
DJ & DJ CONTRACTING INC.

2010 HARKSELL ROAD
FERNDALE, WASHINGTON 98248

CONSULTING ENGINEER:
AXE ENGINEERING SERVICES, LLC
KARIS VAN DIEST, PE
851 COHO WAY #306
BELLINGHAM, WASHINGTON 98225
Tel. 360.922.0549

I HEREBY CERTIFY THAT THE CONSTRUCTION OF SOMERSET STREET DEVELOPMENT HAS BEEN INSPECTED BY AXE ENGINEERING SERVICES, LLC AND TO THE BEST OF MY KNOWLEDGE, HAVE BEEN CONSTRUCTED IN CONFORMANCE WITH THE CITY OF FERNDALE DEVELOPMENT STANDARDS, THE CITY OF FERNDALE MUNICIPAL CODE, SUBSEQUENT STANDARDS ADOPTED BY REFERENCE THEREIN, AND STANDARD ENGINEERING PRACTICE



CALL BEFORE YOU DIG
Call: TOLL FREE
1-800-424-5555

ABBREVIATIONS

CBI	CATCH BASIN INSERT
EG	EXISTING GROUND
ELEV	ELEVATION
EXST	EXISTING
FDC	FIRE DEPARTMENT CONNECTION
FG	FINISHED GRADE
FT	FEET
IE	INVERT ELEVATION
LF	LENGTH FEET
MAX	MAXIMUM
MIN	MINIMUM
PIV	POST INDICATOR VALVE
RPBA	REDUCED PRESSURE BACKFLOW ASSEMBLY
SDCB	STORM DRAIN CATCH BASIN
SDCO	STORM DRAIN CLEAN OUT
TYP	TYPICAL

SHEET INDEX

C1	COVER, VICINITY MAP & INDEX
C2	EXISTING CONDITIONS
C3	SWPP NOTES
C4	SWPP & DEMOLITION PLAN
C5	SWPP DETAILS
C6	GRADING & DRAINAGE PLAN
C7	GRADING & DRAINAGE DETAILS
C8	WATER & SEWER PLAN
C9	WATER DETAILS
C10	SEWER DETAILS

APPROVED
03/19/2025

BY: *Karis Van Diest*
CITY OF FERNDALE
PUBLIC WORKS DEPARTMENT

LEGEND

EXISTING	PROPOSED	
		MAJOR CONTOUR
		MINOR CONTOUR
		PROPERTY LINE
		CENTER LINE
		RIGHT OF WAY
		EASEMENT
		STORM LINE
		STORM DRAIN CATCH BASIN
		WATER LINE
		FIRE LINE
		FIRE HYDRANT
		WATER VALVE
		WATER METER
		SEWER LINE
		SEWER MANHOLE
		SEWER CLEANOUT
		CONCRETE
		ASPHALT
		GRAVEL
		PERMEABLE PAVEMENT
		DETAIL NUMBER DETAIL SHEET NUMBER
		SECTION LETTER SECTION SHEET NUMBER

RECORD DRAWING - 02/24/2025

AXE ENGINEERING SERVICES, LLC
"CUTTING THROUGH PROJECT BARRIERS"
851 COHO WAY #306
BELLINGHAM, WA 98225
360 - 922 - 0549
www.axeengineering.com



CITY OF FERNDALE, WA
1964 SOMERSET ST DEVELOPMENT
CIVIL CONSTRUCTION PLANS
COVER, VICINITY MAP & INDEX

DATE: 02/24/2025
DESIGN: KVD
DRAWN: MDS
SCALE: AS SHOWN

PROJECT # 22037

SHEET # OF
C1 10
REV # REC

- NOTES:**
- EXISTING CONDITIONS AS PER SURVEY CONDUCTED BY CHRISTIE & CHRISTIE LAND SURVEYING IN JUNE, 2022.
 - PRIOR TO PROJECT COMPLETION, AS-BUILT PLANS WILL BE REQUIRED AND ADDED TO THE CITY GIS DATA BASE. THE CITY WILL REQUIRE A MINIMUM OF TWO TIES (MONUMENT 6 & 8) TO THE CITY'S PREFERRED MONUMENT SYSTEM FOR ENHANCED ACCURACY.

LEGAL DESCRIPTION
LOTS 17, 18 AND 19, BLOCK 3, PLAT OF NEW FERNDAL, ACCORDING TO THE PLAT THEREOF, RECORDED IN VOLUME 5 OF PLATS, PAGE 4, RECORDS OF WHATCOM COUNTY, WASHINGTON.

SITUATE IN WHATCOM COUNTY, WASHINGTON.

ELEVATION DATUM
NGVD 29; USED CITY OF FERNDAL MONUMENT I.D. NO. 353 LOCATED AT THE INTERSECTION OF SOMERSET AVE. & PORTAL WAY, EL. 40.73'.


SURVEYOR'S NOTES
BASIS OF BEARINGS: CITY OF FERNDAL MONUMENT CONTROL NETWORK; HELD SOMERSET AVENUE N87°24'24" WAS PER RECORD OF SURVEY A.F. NO. 2016-1203150.

THIS SURVEY WAS PERFORMED FEBRUARY 2 AND JUNE 13, 2022. ALL MONUMENTS SHOWN HEREON WERE VISITED DURING THE COURSE OF THIS SURVEY, UNLESS OTHERWISE NOTED.

ANGULAR AND LINEAR MEASUREMENTS WERE PERFORMED USING A 5-SECOND PENTAX PTS-V5 TOTAL STATION AND A 2-SECOND GEOMAX ZOOM 10 TOTAL STATION.

PROCEDURES USED IN THIS SURVEY MEET OR EXCEED STANDARDS SET FORTH BY W.A.C. 332-130-090.

THIS SURVEY WAS COMPLETED WITHOUT THE BENEFIT OF A CURRENT TITLE REPORT AND DOES NOT PURPORT TO SHOW ANY OR ALL EASEMENTS, COVENANTS, RESTRICTIONS AND/OR AGREEMENTS THAT A CURRENT TITLE REPORT MIGHT REVEAL.

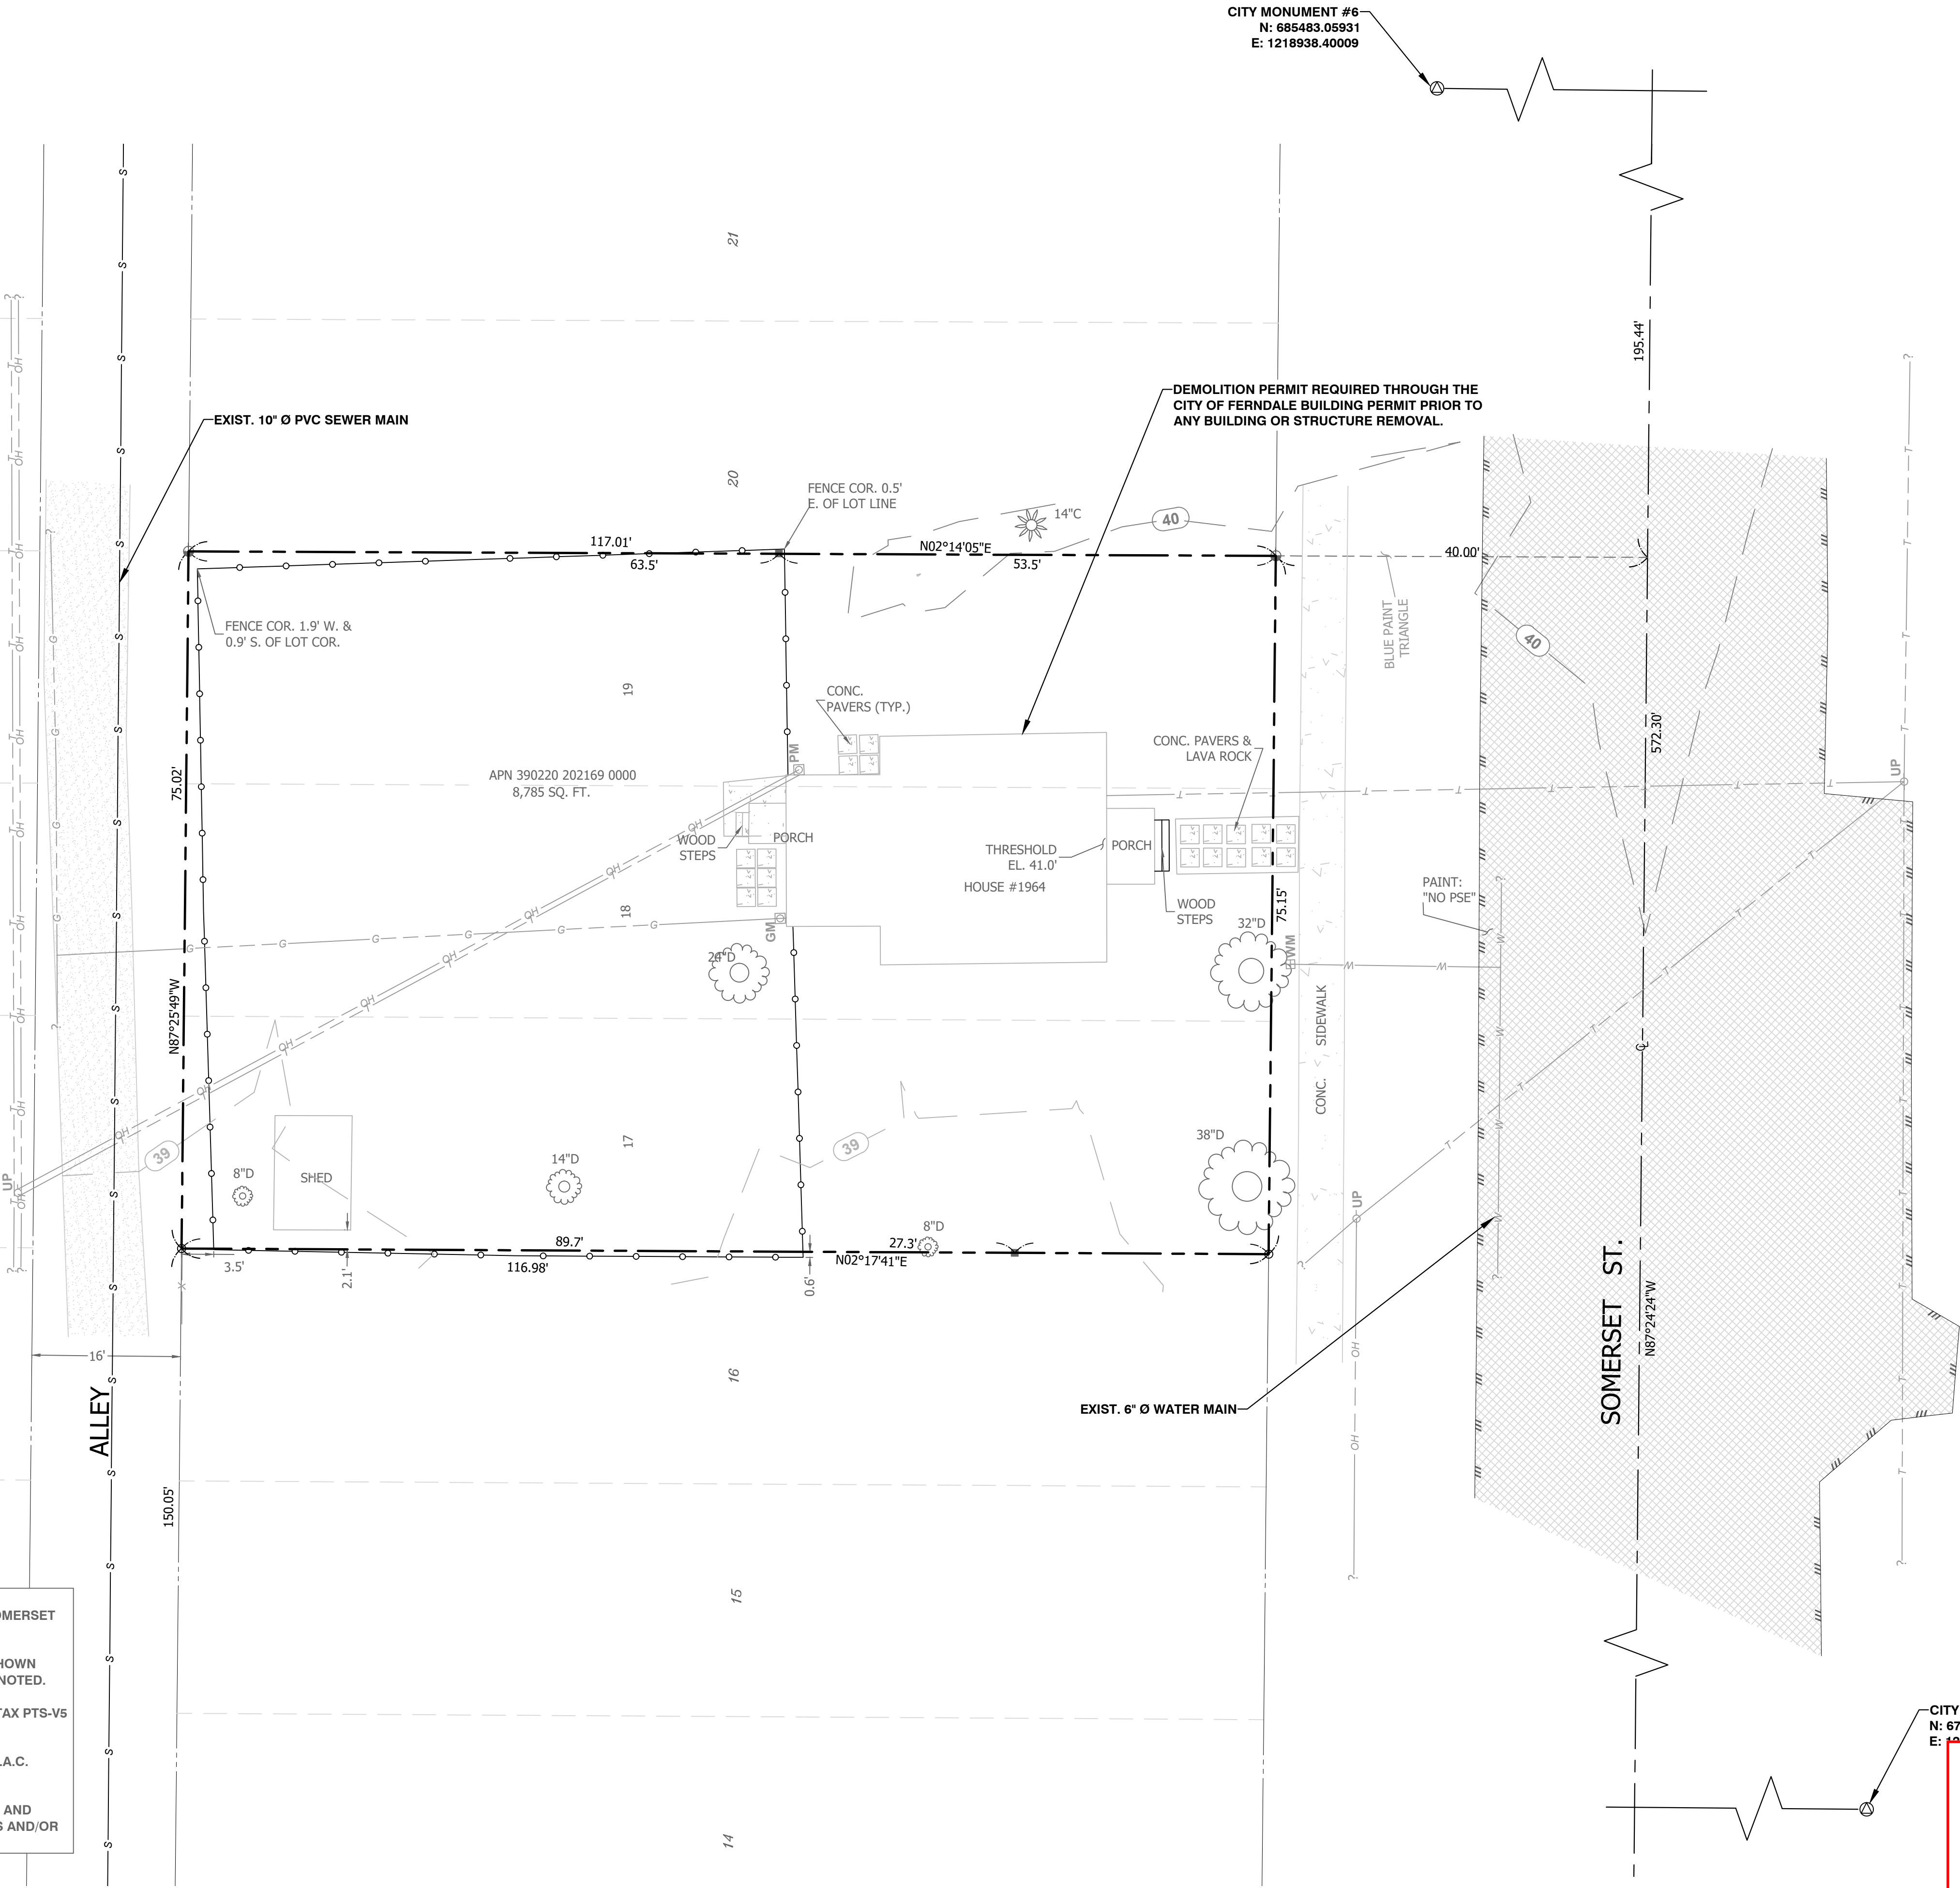

RECORD DRAWING - 02/24/2025

AXE ENGINEERING SERVICES, LLC
"CUTTING THROUGH PROJECT BARRIERS"
851 COHO WAY #306
BELLINGHAM, WA 98225
360 - 922 - 0549
www.axeengineering.com



CITY OF FERNDAL, WA
1964 SOMERSET ST DEVELOPMENT
CIVIL CONSTRUCTION PLANS
EXISTING CONDITIONS

DATE: 02/24/2025
DESIGN: KVD
DRAWN: MDS
SCALE: AS SHOWN

PROJECT # 22037

SHEET # OF
C2 10
REV # REC

APPROVED
03/19/2025
BY: *[Signature]*
CITY OF FERNDAL
PUBLIC WORKS DEPARTMENT

REVISIONS
DATE
BY

STORMWATER POLLUTION PREVENTION (SWPP) NOTES:

THIS STORMWATER POLLUTION PREVENTION PLAN IS PROVIDED IN GENERAL ACCORDANCE WITH THE TERMS OF THE NATIONAL POLLUTANT DISCHARGE ELIMINATION SYSTEM (NPDES) PERMIT FOR CONSTRUCTION ACTIVITIES. THE CONTRACTOR IS ADVISED THAT THE PROJECT AREA MAY DRAIN TO WETLANDS AND/OR STATE WATERS AND THAT THE CONTRACTOR IS RESPONSIBLE TO PROTECT THE RECEIVING WATERS FROM DELETERIOUS EFFECTS OF CONSTRUCTION.

THE CONTRACTOR IS REQUIRED TO HAVE A COPY OF THE SWPP PLAN ONSITE AT ALL TIMES.

THE CONTRACTOR IS RESPONSIBLE FOR IMPLEMENTING THE EROSION AND SEDIMENT CONTROL BMPs SHOWN OR DESCRIBED IN THE CONTRACT DOCUMENTS.

THE FOLLOWING DESCRIBES HOW THE CONSTRUCTION SWPP PLAN MAY ADDRESS EACH OF THE 13 REQUIRED ELEMENTS. REFER TO THE PROJECT CONSTRUCTION PLANS FOR A VICINITY MAP, SWPP SITE PLAN, CONVEYANCE SYSTEMS, EROSION AND SEDIMENT CONTROL MEASURES, AND EROSION AND SEDIMENT CONTROL DETAILS. THE BMPs SHOWN ON THE SWPP SITE PLAN ARE THE MINIMUM REQUIREMENTS FOR THE ANTICIPATED SITE CONDITIONS. THE SWPP PLAN SHALL BE MODIFIED BY THE CONTRACTOR USING THE FOLLOWING SUGGESTED BMPs AS REQUIRED TO MEET THE ACTUAL SITE CONDITIONS ENCOUNTERED DURING CONSTRUCTION AND TO PREVENT VIOLATION OF SURFACE WATER QUALITY, GROUND WATER QUALITY, OR SEDIMENT MANAGEMENT STANDARDS. THE CONTRACTOR SHALL MAINTAIN THESE BMPs UNTIL ALL CONSTRUCTION IS APPROVED AND/OR THE SITE HAS BEEN PERMANENTLY STABILIZED.

THE BMPs NOTED ON THIS SHEET MAY BE FOUND IN THE WASHINGTON STATE DEPARTMENT OF ECOLOGY STORMWATER MANAGEMENT MANUAL FOR WESTERN WASHINGTON VOLUME II, CONSTRUCTION STORMWATER POLLUTION PREVENTION.

ELEMENT #1: PRESERVE VEGETATION/MARK CLEARING LIMITS

- 1. BEFORE BEGINNING LAND DISTURBING ACTIVITIES, INCLUDING CLEARING AND GRADING, CLEARLY MARK ALL CLEARING LIMITS, SENSITIVE AREAS AND THEIR BUFFERS, AND TREES THAT ARE TO BE PRESERVED WITHIN THE CONSTRUCTION AREA
 - PLASTIC, METAL, OR FABRIC FENCE MAY BE USED TO MARK THE CLEARING LIMITS.

- 2. RETAIN THE DUFF LAYER, NATIVE TOPSOIL, AND NATURAL VEGETATION IN AN UNDISTURBED STATE TO THE MAXIMUM DEGREE PRACTICABLE.
 - IF IT IS NOT PRACTICAL TO RETAIN THE DUFF LAYER IN PLACE, THEN STOCKPILE IT ON-SITE, COVER IT TO PREVENT EROSION, AND REPLACE IT IMMEDIATELY WHEN YOU FINISH DISTURBING THE SITE.

SUGGESTED BMPs:

BMP C101: PRESERVING NATURAL VEGETATION

BMP C102: BUFFER ZONES

BMP C103: HIGH VISIBILITY PLASTIC OR METAL FENCE

BMP C233: SILT FENCE

ELEMENT #2: ESTABLISH CONSTRUCTION ACCESS

- 1. LIMIT CONSTRUCTION VEHICLE ACCESS AND EXIT TO ONE ROUTE, IF POSSIBLE.
 - MINIMIZE CONSTRUCTION SITE ACCESS POINTS ALONG LINEAR PROJECTS, SUCH AS ROADWAYS. STREET WASHING MAY REQUIRE LOCAL JURISDICTION APPROVAL.

- 2. STABILIZE ACCESS POINTS WITH A PAD OF QUARRY SPALLS, CRUSHED ROCK, OR OTHER EQUIVALENT BMPs, TO MINIMIZE TRACKING OF SEDIMENT ONTO PUBLIC ROADS.

- 3. LOCATE WHEEL WASH OR TIRE BATHS ON SITE, IF THE STABILIZED CONSTRUCTION ENTRANCE IS NOT EFFECTIVE IN PREVENTING TRACKING SEDIMENT ONTO ROADS.

- 4. IF SEDIMENT IS TRACKED OFF SITE, CLEAN THE AFFECTED ROADWAY THOROUGHLY AT THE END OF EACH DAY, OR MORE FREQUENTLY AS NECESSARY (FOR EXAMPLE, DURING WET WEATHER). REMOVE SEDIMENT FROM ROADS BY SHOVELING, SWEEPING, OR PICKUP AND TRANSPORT THE SEDIMENT TO A CONTROLLED SEDIMENT DISPOSAL AREA.

- 5. CONDUCT STREET WASHING ONLY AFTER SEDIMENT IS REMOVED IN ACCORDANCE WITH THE ABOVE.

- 6. CONTROL STREET WASH WASTEWATER BY PUMPING BACK ON-SITE, OR OTHERWISE PREVENT IT FROM DISCHARGING INTO SYSTEMS TRIBUTARY TO WATERS OF THE STATE.

SUGGESTED BMPs:

BMP C105: STABILIZED CONSTRUCTION ENTRANCE/EXIT

BMP C106: WHEEL WASH

BMP C107: CONSTRUCTION ROAD / PARKING AREA STABILIZATION

ELEMENT #3: CONTROL FLOW RATES

- 1. PROTECT PROPERTIES AND WATERWAYS DOWNSTREAM OF DEVELOPMENT SITES FROM EROSION AND THE ASSOCIATED DISCHARGE OF TURBID WATERS DUE TO INCREASES IN THE VELOCITY AND PEAK VOLUMETRIC FLOW RATE OF STORMWATER RUNOFF FROM THE PROJECT SITE.

- 2. WHERE NECESSARY TO COMPLY WITH THE ABOVE, CONSTRUCT STORMWATER RETENTION OR DETENTION FACILITIES AS ONE OF THE FIRST STEPS IN GRADING. ASSURE THAT DETENTION FACILITIES FUNCTION PROPERLY BEFORE CONSTRUCTING SITE IMPROVEMENTS (E.G., IMPERVIOUS SURFACES).

IF PERMANENT INFILTRATION PONDS ARE USED FOR FLOW CONTROL DURING CONSTRUCTION, PROTECT THESE FACILITIES FROM SILTATION DURING THE CONSTRUCTION PHASE.

SUGGESTED BMPs:

BMP C203: WATER BARS

BMP C207: CHECK DAMS

BMP C209: OUTLET PROTECTION

BMP C235: WATTLES

BMP C240: SEDIMENT TRAP

BMP C241: TEMPORARY SEDIMENT POND

ELEMENT #4: INSTALL SEDIMENT CONTROLS

- 1. DESIGN, INSTALL, AND MAINTAIN EFFECTIVE EROSION CONTROLS AND SEDIMENT CONTROLS TO MINIMIZE THE DISCHARGE OF POLLUTANTS.

- 2. CONSTRUCT SEDIMENT CONTROL BMPs (SEDIMENT PONDS, TRAPS, FILTERS, ETC.) AS ONE OF THE FIRST STEPS IN GRADING. THESE BMPs SHALL BE FUNCTIONAL BEFORE OTHER LAND DISTURBING ACTIVITIES TAKE PLACE.

- 3. MINIMIZE SEDIMENT DISCHARGES FROM THE SITE. THE DESIGN, INSTALLATION AND MAINTENANCE OF EROSION AND SEDIMENT CONTROLS MUST ADDRESS FACTORS SUCH AS THE AMOUNT, FREQUENCY, INTENSITY AND DURATION OF PRECIPITATION, THE NATURE OF RESULTING STORMWATER RUNOFF, AND SOIL CHARACTERISTICS, INCLUDING THE RANGE OF SOIL PARTICLE SIZES EXPECTED TO BE PRESENT ON THE SITE.

- 4. DIRECT STORMWATER RUNOFF FROM DISTURBED AREAS THROUGH A SEDIMENT POND OR OTHER APPROPRIATE SEDIMENT REMOVAL BMP. BEFORE THE RUNOFF LEAVES A CONSTRUCTION SITE OR BEFORE DISCHARGE TO AN INFILTRATION FACILITY, RUNOFF FROM FULLY STABILIZED AREAS MAY BE DISCHARGED WITHOUT A SEDIMENT REMOVAL BMP, BUT MUST MEET THE FLOW CONTROL PERFORMANCE STANDARD IN ELEMENT #3, BULLET #1.

- 5. LOCATE BMPs INTENDED TO TRAP SEDIMENT ON-SITE IN A MANNER TO AVOID INTERFERENCE WITH THE MOVEMENT OF JUVENILE SALMONIDS ATTEMPTING TO ENTER OFF-CHANNEL AREAS OR DRAINAGES.

- 6. WHERE FEASIBLE, DESIGN OUTLET STRUCTURES THAT WITHDRAW IMPOUNDED STORMWATER FROM THE SURFACE TO AVOID DISCHARGING SEDIMENT THAT IS STILL SUSPENDED LOWER IN THE WATER COLUMN.

SUGGESTED BMPs:

BMP C231: BRUSH BARRIER

BMP C232: GRAVEL FILTER BERM

BMP C233: SILT FENCE

BMP C234: VEGETATED STRIP

BMP C235: WATTLES

BMP C240: SEDIMENT TRAP

ELEMENT #5: STABILIZE SOILS

- 1. STABILIZE EXPOSED AND UNWORKED SOILS BY APPLICATION OF EFFECTIVE BMPs THAT PREVENT EROSION. APPLICABLE BMPs INCLUDE, BUT ARE NOT LIMITED TO: TEMPORARY AND PERMANENT SEEDING, SODDING, MULCHING, PLASTIC COVERING, EROSION CONTROL FABRICS AND MATTING, SOIL APPLICATION OF POLYACRYLAMIDE (PAM), THE EARLY APPLICATION OF GRAVEL BASE ON AREAS TO BE PAVED, AND DUST CONTROL.

- 2. CONTROL STORMWATER VOLUME AND VELOCITY WITHIN THE SITE TO MINIMIZE SOIL EROSION.

- 3. CONTROL STORMWATER DISCHARGES, INCLUDING BOTH PEAK FLOW RATES AND TOTAL STORMWATER VOLUME, TO MINIMIZE EROSION AT OUTLETS AND TO MINIMIZE DOWNSTREAM CHANNEL AND STREAM BANK EROSION.

- 4. SOILS MUST NOT REMAIN EXPOSED AND UNWORKED FOR MORE THAN THE TIME PERIODS SET FORTH BELOW TO PREVENT EROSION:

- DURING THE DRY SEASON (MAY 1 - SEPT. 30): 7 DAYS
 - DURING THE WET SEASON (OCTOBER 1 - APRIL 30): 2 DAYS

- 5. STABILIZE SOILS AT THE END OF THE SHIFT BEFORE A HOLIDAY OR WEEKEND IF NEEDED BASED ON THE WEATHER FORECAST.

- 6. STABILIZE SOIL STOCKPILES FROM EROSION, PROTECTED WITH SEDIMENT TRAPPING MEASURES, AND WHERE POSSIBLE, BE LOCATED AWAY FROM STORM DRAIN INLETS, WATERWAYS AND DRAINAGE CHANNELS.

- 7. MINIMIZE THE AMOUNT OF SOIL EXPOSED DURING CONSTRUCTION ACTIVITY.

- 8. MINIMIZE THE DISTURBANCE OF STEEP SLOPES.

- 9. MINIMIZE SOIL COMPACTION AND, UNLESS INFEASIBLE, PRESERVE TOPSOIL.

SUGGESTED BMPs/BMPs TO BE USED:

BMP C120: TEMPORARY AND PERMANENT SEEDING

BMP C121: MULCHING

BMP C122: NETS AND BLANKETS

BMP C123: PLASTIC COVERING

BMP C124: SODDING

BMP C125: TOPSOILING/COMPOSTING

BMP C126: POLYACRYLAMIDE FOR SOIL EROSION PROTECTION

BMP C130: SURFACE ROUGHENING

BMP C131: GRADIENT TERRACES

BMP C140: DUST CONTROL

ELEMENT #6: PROTECT SLOPES

- 1. DESIGN AND CONSTRUCT CUT-AND-FILL SLOPES IN A MANNER TO MINIMIZE EROSION. APPLICABLE PRACTICES INCLUDE, BUT ARE NOT LIMITED TO, REDUCING CONTINUOUS LENGTH OF SLOPE WITH TERRACING AND DIVERSIONS, REDUCING SLOPE STEEPNESS, AND ROUGHENING SLOPE SURFACES (FOR EXAMPLE, TRACK WALKING).

- 2. DIVERT OFF-SITE STORMWATER (RUN-ON) OR GROUND WATER AWAY FROM SLOPES AND DISTURBED AREAS WITH INTERCEPTOR DIKES, PIPES AND/OR SWALES. OFF-SITE STORMWATER SHOULD BE MANAGED SEPARATELY FROM STORMWATER GENERATED ON THE SITE.

- 3. AT THE TOP OF SLOPES, COLLECT DRAINAGE IN PIPE SLOPE DRAINS OR PROTECTED CHANNELS TO PREVENT EROSION.

- TEMPORARY PIPE SLOPE DRAINS MUST HANDLE THE PEAK VOLUMETRIC FLOW RATE CALCULATED USING A 10 MINUTE TIME STEP FROM A TYPE 1A, 10-YEAR, 24-HOUR FREQUENCY STORM FOR THE DEVELOPED CONDITION. ALTERNATIVELY, THE 10-YEAR, 1-HOUR FLOW RATE PREDICTED BY AN APPROVED CONTINUOUS RUNOFF MODEL, INCREASED BY A FACTOR OF 1.6, MAY BE USED. THE HYDROLOGIC ANALYSIS MUST USE THE EXISTING LAND COVER CONDITION FOR PREDICTING FLOW RATES FROM TRIBUTARY AREAS OUTSIDE THE PROJECT LIMITS. FOR TRIBUTARY AREAS ON THE PROJECT SITE, THE ANALYSIS MUST USE THE TEMPORARY OR PERMANENT PROJECT LAND COVER CONDITION, WHICHEVER WILL PRODUCE THE HIGHEST FLOW RATES. IF USING THE WESTERN WASHINGTON HYDROLOGY MODEL (WWHM) TO PREDICT FLOWS, BARE SOIL AREAS SHOULD BE MODELED AS "LANDSCAPED" AREA.

- 4. PLACE EXCAVATED MATERIAL ON THE UPHILL SIDE OF TRENCHES, CONSISTENT WITH SAFETY AND SPACE CONSIDERATIONS.

- 5. PLACE CHECK DAMS AT REGULAR INTERVALS WITHIN CONSTRUCTED CHANNELS THAT ARE CUT DOWN A SLOPE.

SUGGESTED BMPs:

BMP C120: TEMPORARY AND PERMANENT SEEDING

BMP C121: MULCHING

BMP C122: NETS AND BLANKETS

BMP C123: PLASTIC COVERING

BMP C124: SODDING

BMP C130: SURFACE ROUGHENING

BMP C131: GRADIENT TERRACES

BMP C200: INTERCEPTOR DIKE AND SWALE

BMP C201: GRASS-LINED CHANNELS

BMP C203: WATER BARS

BMP C204: PIPE SLOPE DRAINS

BMP C205: SUBSURFACE DRAINS

BMP C206: LEVEL SPREADER

BMP C207: CHECK DAMS

BMP C208: TRIANGULAR SILT DIKE (GEOTEXTILE-ENCASED

CHECK DAM)

ELEMENT #7: PROTECT DRAIN INLETS

- 1. PROTECT ALL STORM DRAIN INLETS MADE OPERABLE DURING CONSTRUCTION SO THAT STORMWATER RUNOFF SHALL NOT ENTER THE CONVEYANCE SYSTEM WITHOUT FIRST BEING FILTERED OR TREATED TO REMOVE SEDIMENT.

- 2. CLEAN OR REMOVE AND REPLACE INLET PROTECTION DEVICES WHEN SEDIMENT HAS FILLED ONE-THIRD OF THE AVAILABLE STORAGE (UNLESS A DIFFERENT STANDARD IS SPECIFIED BY THE PRODUCT MANUFACTURER).

SUGGESTED BMPs:

BMP C220: STORM DRAIN INLET PROTECTION

ELEMENT #8: STABILIZE CHANNELS AND OUTLETS

- 1. DESIGN, CONSTRUCT, AND STABILIZE ALL ON-SITE CONVEYANCE CHANNELS TO PREVENT EROSION FROM THE FOLLOWING EXPECTED PEAK FLOWS:

- CHANNELS MUST HANDLE THE PEAK VOLUMETRIC FLOW RATE CALCULATED USING A 10 MINUTE TIME STEP FROM A TYPE 1A, 10-YEAR, 24-HOUR FREQUENCY STORM FOR THE DEVELOPED CONDITION. ALTERNATIVELY, THE 10-YEAR, 1-HOUR FLOW RATE INDICATED BY AN APPROVED CONTINUOUS RUNOFF MODEL, INCREASED BY A FACTOR OF 1.6, MAY BE USED. THE HYDROLOGIC ANALYSIS MUST USE THE EXISTING LAND COVER CONDITION FOR PREDICTING FLOW RATES FROM TRIBUTARY AREAS OUTSIDE THE PROJECT LIMITS. FOR TRIBUTARY AREAS ON THE PROJECT SITE, THE ANALYSIS MUST USE THE TEMPORARY OR PERMANENT PROJECT LAND COVER CONDITION, WHICHEVER WILL PRODUCE THE HIGHEST FLOW RATES. IF USING THE WESTERN WASHINGTON HYDROLOGY MODEL (WWHM) TO PREDICT FLOWS, BARE SOIL AREAS SHOULD BE MODELED AS "LANDSCAPED" AREA.

- 2. PROVIDE STABILIZATION, INCLUDING ARMORING MATERIAL, ADEQUATE TO PREVENT EROSION OF OUTLETS, ADJACENT STREAM BANKS, SLOPES AND DOWNSTREAM REACHES AT THE OUTLETS OF ALL CONVEYANCE SYSTEMS.

SUGGESTED BMPs:

BMP C202: CHANNEL LINING

BMP C122: NETS AND BLANKETS

BMP C207: CHECK DAMS

BMP C209: OUTLET PROTECTION

ELEMENT #9: CONTROL POLLUTANTS

- 1. DESIGN, INSTALL, IMPLEMENT AND MAINTAIN EFFECTIVE POLLUTION PREVENTION MEASURES TO MINIMIZE THE DISCHARGE OF POLLUTANTS.

- 2. HANDLE AND DISPOSE OF ALL POLLUTANTS, INCLUDING WASTE MATERIALS AND DEMOLITION DEBRIS THAT OCCUR ON-SITE IN A MANNER THAT DOES NOT CAUSE CONTAMINATION OF STORMWATER.

- 3. PROVIDE COVER, CONTAINMENT, AND PROTECTION FROM VANDALISM FOR ALL CHEMICALS, LIQUID PRODUCTS, PETROLEUM PRODUCTS, AND OTHER MATERIALS THAT HAVE THE POTENTIAL TO POSE A THREAT TO HUMAN HEALTH OR THE ENVIRONMENT. ONSITE FUELING TANKS MUST INCLUDE SECONDARY CONTAINMENT. SECONDARY CONTAINMENT MEANS PLACING TANKS OR CONTAINERS WITHIN AN IMPERVIOUS STRUCTURE CAPABLE OF CONTAINING 110% OF THE VOLUME CONTAINED IN THE LARGEST TAKE WITHIN THE CONTAINMENT STRUCTURE. DOUBLE-WALLED TANKS DO NOT REQUIRE ADDITIONAL SECONDARY CONTAINMENT.

- 4. CONDUCT MAINTENANCE, FUELING, AND REPAIR OF HEAVY EQUIPMENT AND VEHICLES USING SPILL PREVENTION AND CONTROL MEASURES. CLEAN CONTAMINATED SURFACES IMMEDIATELY FOLLOWING ANY SPILL INCIDENT.

- 5. DISCHARGE WHEEL WASH OR TIRE BATH WASTEWATER TO A SEPARATE ON-SITE TREATMENT SYSTEM THAT PREVENTS DISCHARGE TO SURFACE WATER, SUCH AS CLOSED-LOOP RECIRCULATION OR UPLAND APPLICATION, OR TO THE SANITARY SEWER, WITH LOCAL SEWER DISTRICT APPROVAL.

- 6. APPLY FERTILIZERS AND PESTICIDES IN A MANNER AND AT APPLICATION RATES THAT WILL NOT RESULT IN LOSS OF CHEMICAL TO STORMWATER RUNOFF. FOLLOW MANUFACTURERS' LABEL REQUIREMENTS FOR APPLICATION RATES AND PROCEDURES.

- 7. USE BMPs TO PREVENT CONTAMINATION OF STORMWATER RUNOFF BY pH MODIFYING SOURCES. THE SOURCES FOR THIS CONTAMINATION INCLUDE, BUT ARE NOT LIMITED TO: BULK CEMENT, CEMENT KILN DUST, FLY ASH, NEW CONCRETE WASHING AND CURING WATERS, WASTE STREAMS GENERATED FROM CONCRETE GRINDING AND SAWING, EXPOSED AGGREGATE PROCESSES, DEWATERING CONCRETE VAULTS, CONCRETE PUMPING AND MIXER WASHOUT WATERS.

- 8. ADJUST THE pH OF STORMWATER IF NECESSARY TO PREVENT VIOLATIONS OF WATER QUALITY STANDARDS.

- 9. ASSURE THAT WASHOUT OF CONCRETE TRUCKS IS PERFORMED OFF-SITE OR IN DESIGNATED CONCRETE WASHOUT AREAS ONLY. DO NOT WASH OUT CONCRETE TRUCKS ONTO THE GROUND, OR INTO STORM DRAINS, OPEN DITCHES, STREETS, OR STREAMS. DO NOT DUMP EXCESS CONCRETE ON-SITE, EXCEPT IN DESIGNATED CONCRETE WASHOUT AREAS. CONCRETE SPILLAGE OR CONCRETE DISCHARGE TO SURFACE WATERS OF THE STATE IS PROHIBITED.

- 10. ADJUST THE pH OF STORMWATER BEFORE USING CHEMICAL TREATMENT OTHER THAN CO2 OR DRY ICE TO ADJUST pH.

SUGGESTED BMPs:

BMP C151: CONCRETE HANDLING

BMP C152: SAWCUTTING AND SURFACING POLLUTION PREVENTION

BMP C153: MATERIAL DELIVERY, STORAGE AND CONTAINMENT

BMP C154: CONCRETE WASHOUT AREA

BMP C250: CONSTRUCTION STORMWATER CHEMICAL TREATMENT

BMP C251: CONSTRUCTION STORMWATER FILTRATION

BMP C252: HIGH pH NEUTRALIZATION USING CO2

BMP C253: pH CONTROL FOR HIGH pH WATER

ELEMENT #10: CONTROL DE-WATERING

- 1. DISCHARGE FOUNDATION, VAULT, AND TRENCH DE-WATERING WATER, WHICH HAS SIMILAR CHARACTERISTICS TO STORMWATER RUNOFF AT THE SITE, INTO A CONTROLLED CONVEYANCE SYSTEM BEFORE DISCHARGE TO A SEDIMENT TRAP OR SEDIMENT POND.

- 2. DISCHARGE CLEAN, NON-TURBID DE-WATERING WATER, SUCH AS WELL-POINT GROUND WATER, TO SYSTEMS TRIBUTARY TO, OR DIRECTLY INTO SURFACE WATERS OF THE STATE, AS SPECIFIED IN ELEMENT #8, PROVIDED THE DE-WATERING FLOW DOES NOT CAUSE EROSION OR FLOODING OF RECEIVING WATERS. DO NOT ROUTE CLEAN DEWATERING WATER THROUGH STORMWATER SEDIMENT PONDS. NOTE THAT "SURFACE WATERS OF THE STATE" MAY EXIST ON A CONSTRUCTION SITE AS WELL AS OFF SITE; FOR EXAMPLE, A CREEK RUNNING THROUGH A SITE.

- 3. HANDLE HIGHLY TURBID OR OTHERWISE CONTAMINATED DEWATERING WATER SEPARATELY FROM STORMWATER.

- 4. OTHER TREATMENT OR DISPOSAL OPTIONS MAY INCLUDE:
 - a) INFILTRATION.
 - b) TRANSPORT OFF-SITE IN A VEHICLE, SUCH AS A VACUUM FLUSH TRUCK, FOR LEGAL DISPOSAL IN A MANNER THAT DOES NOT POLLUTE STATE WATERS.
 - c) ECOLOGY-APPROVED ON-SITE CHEMICAL TREATMENT OR OTHER SUITABLE TREATMENT TECHNOLOGIES.
 - d) SANITARY OR COMBINED SEWER DISCHARGE WITH LOCAL SEWER DISTRICT APPROVAL, IF THERE IS NO OTHER OPTION.
 - e) USE OF A SEDIMENTATION BAG THAT DISCHARGES TO A DITCH OR SWALE FOR SMALL VOLUMES OF LOCALIZED DEWATERING.

SUGGESTED BMPs:

BMP C203: WATER BARS

BMP C236: VEGETATIVE FILTRATION

ELEMENT #11: MAINTAIN BMPs

- 1. MAINTAIN AND REPAIR ALL TEMPORARY AND PERMANENT EROSION AND SEDIMENT CONTROL BMPs AS NEEDED TO ASSURE CONTINUED PERFORMANCE OF THEIR INTENDED FUNCTION IN ACCORDANCE WITH BMP SPECIFICATIONS.

- 2. REMOVE ALL TEMPORARY EROSION AND SEDIMENT CONTROL BMPs WITHIN 30 DAYS AFTER ACHIEVING FINAL SITE STABILIZATION OR AFTER THE TEMPORARY BMPs ARE NO LONGER NEEDED.

SUGGESTED BMPs:

BMP C150: MATERIALS ON HAND

BMP C160: CERTIFIED EROSION AND SEDIMENT CONTROL LEAD

ELEMENT #12: MANAGE THE PROJECT

- 1. PHASE DEVELOPMENT PROJECTS TO THE MAXIMUM DEGREE PRACTICABLE AND TAKE INTO ACCOUNT SEASONAL WORK LIMITATIONS.

- 2. INSPECTION AND MONITORING - INSPECT, MAINTAIN AND REPAIR ALL BMPs AS NEEDED TO ASSURE CONTINUED PERFORMANCE OF THEIR INTENDED FUNCTION. PROJECTS REGULATED UNDER THE CONSTRUCTION STORMWATER GENERAL PERMIT MUST CONDUCT SITE INSPECTIONS AND MONITORING IN ACCORDANCE WITH SPECIAL CONDITION S4 OF THE CONSTRUCTION STORMWATER GENERAL PERMIT.

- 3. MAINTAINING AN UPDATED CONSTRUCTION SWPPP - MAINTAIN, UPDATE, AND IMPLEMENT THE SWPPP.

- 4. PROJECTS THAT DISTURB ONE OR MORE ACRES MUST HAVE SITE INSPECTIONS CONDUCTED BY A CERTIFIED EROSION AND SEDIMENT CONTROL LEAD (CESCL). PROJECT SITES DISTURBING LESS THAN ONE ACRE MAY HAVE A CESCL OR A PERSON WITHOUT CESCL CERTIFICATION CONDUCT INSPECTIONS. BY THE INITIATION OF CONSTRUCTION, THE SWPPP MUST IDENTIFY THE CESCL OR INSPECTOR, WHO MUST BE PRESENT ON-SITE OR ON-CALL AT ALL TIMES.

- 5. THE CESCL OR INSPECTOR (PROJECTS SITES LESS THAN ONE ACRE) MUST HAVE THE SKILLS TO ASSESS THE:
 - SITE CONDITIONS AND CONSTRUCTION ACTIVITIES THAT COULD IMPACT THE QUALITY OF STORMWATER.
 - EFFECTIVENESS OF EROSION AND SEDIMENT CONTROL MEASURES USED TO CONTROL THE QUALITY OF STORMWATER DISCHARGES.

- 6. THE CESCL OR INSPECTOR MUST EXAMINE STORMWATER VISUALLY FOR THE PRESENCE OF SUSPENDED SEDIMENT, TURBIDITY, DISCOLORATION, AND OIL SHEEN. THEY MUST EVALUATE THE EFFECTIVENESS OF BMPs AND DETERMINE IF IT IS NECESSARY TO INSTALL, MAINTAIN, OR REPAIR BMPs TO IMPROVE THE QUALITY OF STORMWATER DISCHARGES.

BASED ON THE RESULTS OF INSPECTION, CONSTRUCTION SITE OPERATORS MUST CORRECT THE PROBLEMS IDENTIFIED BY:

- REVIEWING THE SWPPP FOR COMPLIANCE WITH THE 13 CONSTRUCTION SWPPP ELEMENTS AND MAKING APPROPRIATE REVISIONS WITHIN 7 DAYS OF THE INSPECTION.

- IMMEDIATELY BEGINNING THE PROCESS OF FULLY IMPLEMENTING AND MAINTAINING APPROPRIATE SOURCE CONTROL AND/OR TREATMENT BMPs AS SOON AS POSSIBLE, ADDRESSING THE PROBLEMS NOT LATER THAN WITHIN 10 DAYS OF THE INSPECTION. IF INSTALLATION OF NECESSARY TREATMENT BMPs IS NOT FEASIBLE WITHIN 10 DAYS, THE CONSTRUCTION SITE OPERATOR MAY REQUEST AN EXTENSION WITHIN THE 10-DAY RESPONSE PERIOD.

- DOCUMENTING BMP IMPLEMENTATION AND MAINTENANCE IN THE SITE LOG BOOK (SITES LARGER THAN 1 ACRE)

- 7. THE CESCL OR INSPECTOR MUST INSPECT ALL AREAS DISTURBED BY CONSTRUCTION ACTIVITIES, ALL BMPs, AND ALL STORMWATER DISCHARGE POINTS AT LEAST ONCE EVERY CALENDAR WEEK AND WITHIN 24 HOURS OF ANY DISCHARGE FROM THE SITE. (FOR PURPOSES OF THIS CONDITION, INDIVIDUAL DISCHARGE EVENTS THAT LAST MORE THAN ONE DAY DO NOT REQUIRE DAILY INSPECTIONS. FOR EXAMPLE, IF A STORMWATER POND DISCHARGES CONTINUOUSLY OVER THE COURSE OF A WEEK, ONLY ONE INSPECTION IS REQUIRED THAT WEEK.) THE CESCL OR INSPECTOR MAY REDUCE THE INSPECTION FREQUENCY FOR TEMPORARILY STABILIZED, INACTIVE SITES TO ONCE EVERY CALENDAR MONTH.

SUGGESTED BMPs:

BMP C150: MATERIALS ON HAND

BMP C160: CERTIFIED EROSION AND SEDIMENT CONTROL LEAD

BMP C162: SCHEDULING

ELEMENT #13: PROTECT LOW IMPACT DEVELOPMENT BMPs

- 1. PROTECT ALL BIORETENTION AND RAIN GARDEN BMPs FROM SEDIMENTATION THROUGH INSTALLATION AND MAINTENANCE OF EROSION AND SEDIMENT CONTROL BMPs ON PORTIONS OF THE SITE THAT DRAIN INTO THE BIORETENTION AND/OR RAIN GARDEN BMPs. RESTORE THE BMPs TO THEIR FULLY FUNCTIONING CONDITION IF THEY ACCUMULATE SEDIMENT DURING CONSTRUCTION. RESTORING THE BMP MUST INCLUDE REMOVAL OF SEDIMENT AND ANY SEDIMENT-LADEN BIORETENTION/RAIN GARDEN SOILS, AND REPLACING THE REMOVED SOILS WITH SOILS MEETING THE DESIGN SPECIFICATIONS.

- 2. PREVENT COMPACTING BIORETENTION AND RAIN GARDEN BMPs BY EXCLUDING CONSTRUCTION EQUIPMENT AND FOOT TRAFFIC. PROTECT COMPLETED LAWN AND LANDSCAPED AREAS FROM COMPACTION DUE TO CONSTRUCTION EQUIPMENT.

- 3. CONTROL EROSION AND AVOID INTRODUCING SEDIMENT FROM SURROUNDING LAND USES ONTO PERMEABLE PAVEMENTS. DO NOT ALLOW MUDDY CONSTRUCTION EQUIPMENT ON THE BASE MATERIAL OR PAVEMENT. DO NOT ALLOW SEDIMENT-LADEN RUNOFF ONTO PERMEABLE PAVEMENTS OR BASE MATERIALS.

- 4. PAVEMENT FOULED WITH SEDIMENTS OR NO LONGER PASSING AN INITIAL INFILTRATION TEST MUST BE CLEANED USING PROCEDURES IN ACCORDANCE WITH THIS MANUAL OR THE MANUFACTURER'S PROCEDURES.

- 5. KEEP ALL HEAVY EQUIPMENT OFF EXISTING SOILS UNDER LID FACILITIES THAT HAVE BEEN EXCAVATED TO FINAL GRADE TO RETAIN THE INFILTRATION RATE OF THE SOILS.

SUGGESTED BMPs:

BMP C102: BUFFER ZONE

BMP C103: HIGH VISIBILITY FENCE

BMP C200: INTERCEPTOR DIKE AND SWALE


BMP C201: GRASS-LINED CHANNELS

BMP C207: CHECK DAMS

BMP C208: TRIANGULAR SILT DIKE (GEOTEXTILE-ENCASED


<

SWPP LEGEND

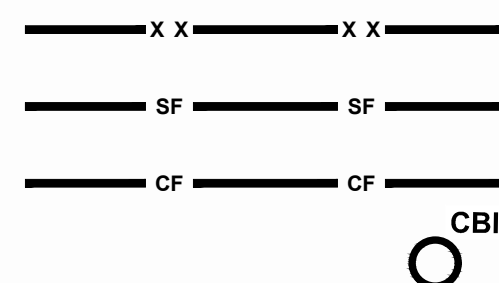

NOTES:

- | | |
|---------------------------------------------------------------------------------------------------------------------------------------------------------------------------------------------------------------------------------------------------------------------------------------------------------------------------------------------------------------------------------------------------------------------------------------------------------------------------------------------------------------------------------------------------------------------------------------------------------------------------------------------------------------------------------------------------------------------------------------------------------------------------------------------------------------------------------------------------------------------------------------------------------------------------------------------------------------|---------------------------------------------------------------------------------------------------------------------------------------------------------------------------------------------------------------------------------------------------------------------------------------------------------------------------------------------------------------------------------------------------------------------------------------------------------------------------------------------------------------------------------------------------------------------------------------------------------------------------------------------------------------------------------------------------------------------------------------------------------------------------------------------------------------------------------------------------------------------------------------------------------------------------------------------------------------------------------------------------------------------------------------------------------------------------------------------------------------------------------------------------------------------------------------------------------------------------------------------------------------------------------|
| <p>1. USE <i>BMP C150: MATERIALS ON HAND & BMP C162: SCHEDULING</i> DURING CONSTRUCTION AS NEEDED
*SWPP ELEMENTS #11 & #12</p> <p>2. USE <i>BMP C123: PLASTIC COVERING & BMP C140: DUST CONTROL</i> TO STABILIZE SOILS & PROTECT SLOPES DURING CONSTRUCTION AS NEEDED
*SWPP ELEMENTS #5 & #6</p> <p>3. USE <i>BMP C151: CONCRETE HANDLING & BMP C152: SAWCUTTING AND SURFACING POLLUTION PREVENTION</i> DURING CONSTRUCTION AS NEEDED
*SWPP ELEMENT #9</p> <p>4. USE <i>BMP C154: CONCRETE WASHOUT AREA</i> DURING CONSTRUCTION AS NEEDED
*SWPP ELEMENT #9</p> <p>5. NATIVE SOIL'S INFILTRATIVE CAPACITY IS TO BE PROTECTED FROM OVERCOMPACTION DURING CONSTRUCTION. IT IS NOT RECOMMENDED THAT THE NATIVE SOIL IS EXCAVATED UNTIL IMMEDIATELY PRIOR TO INSTALLATION OF THE PERMEABLE PAVEMENT SECTION. PROTECT PERMEABLE PAVEMENT FROM CLOGGING UNTIL AFTER CONSTRUCTION IS COMPLETE AND THE SITE IS STABILIZED.</p> | <p>6. SUBGRADE MUST BE INSPECTED AND COMPACTION SHALL BE TESTED BY A SOILS PROFESSIONAL PRIOR TO BMP INSTALLATION TO VERIFY SOIL CONDITIONS</p> <p>7. PRIOR TO AND POST INSTALLATION OF PERMEABLE PAVEMENT, INFILTRATION TESTING IS TO BE PERFORMED BY A GEOTECHNICAL PROFESSIONAL AFTER THE COMPACTION IS COMPLETE.</p> <p>8. COMPACT THE SUBGRADE TO THE MINIMUM COMPACTION NECESSARY FOR STRUCTURAL STABILITY. TWO GUIDELINES CURRENTLY USED TO SPECIFY SUBGRADE COMPACTION ARE "FIRM AND UNYIELDING" (QUALITATIVE), AND 90- 92% STANDARD PROCTOR (QUANTITATIVE). SUBGRADE SHOULD NOT BE SUBJECT TO COMPACTION BEYOND THE QUALITATIVE AND QUANTITATIVE LEVELS IDENTIFIED HEREIN. DO NOT ALLOW CONSTRUCTION TRAFFIC AND EQUIPMENT ONTO THE SUBGRADE EXCEPT WHEN CONSTRUCTION ACCESS ON SUBGRADE IS REQUIRED FOR THE PAVEMENT SECTION INSTALLATION. FOLLOW BACK DUMPING APPROACH AS NOTED BELOW.</p> <p>9. TO PREVENT COMPACTION WHEN INSTALLING THE AGGREGATE BASE, THE FOLLOWING STEPS (BACK-DUMPING) SHOULD BE FOLLOWED: 1) THE AGGREGATE BASE IS DUMPED ONTO THE SUBGRADE FROM THE EDGE OF THE INSTALLATION AND AGGREGATE IS THEN PUSHED OUT ONTO THE SUBGRADE; 2) TRUCKS THEN DUMP SUBSEQUENT LOADS FROM ON TOP OF THE AGGREGATE BASE AS THE INSTALLATION PROGRESSES.</p> |
|---------------------------------------------------------------------------------------------------------------------------------------------------------------------------------------------------------------------------------------------------------------------------------------------------------------------------------------------------------------------------------------------------------------------------------------------------------------------------------------------------------------------------------------------------------------------------------------------------------------------------------------------------------------------------------------------------------------------------------------------------------------------------------------------------------------------------------------------------------------------------------------------------------------------------------------------------------------|---------------------------------------------------------------------------------------------------------------------------------------------------------------------------------------------------------------------------------------------------------------------------------------------------------------------------------------------------------------------------------------------------------------------------------------------------------------------------------------------------------------------------------------------------------------------------------------------------------------------------------------------------------------------------------------------------------------------------------------------------------------------------------------------------------------------------------------------------------------------------------------------------------------------------------------------------------------------------------------------------------------------------------------------------------------------------------------------------------------------------------------------------------------------------------------------------------------------------------------------------------------------------------|

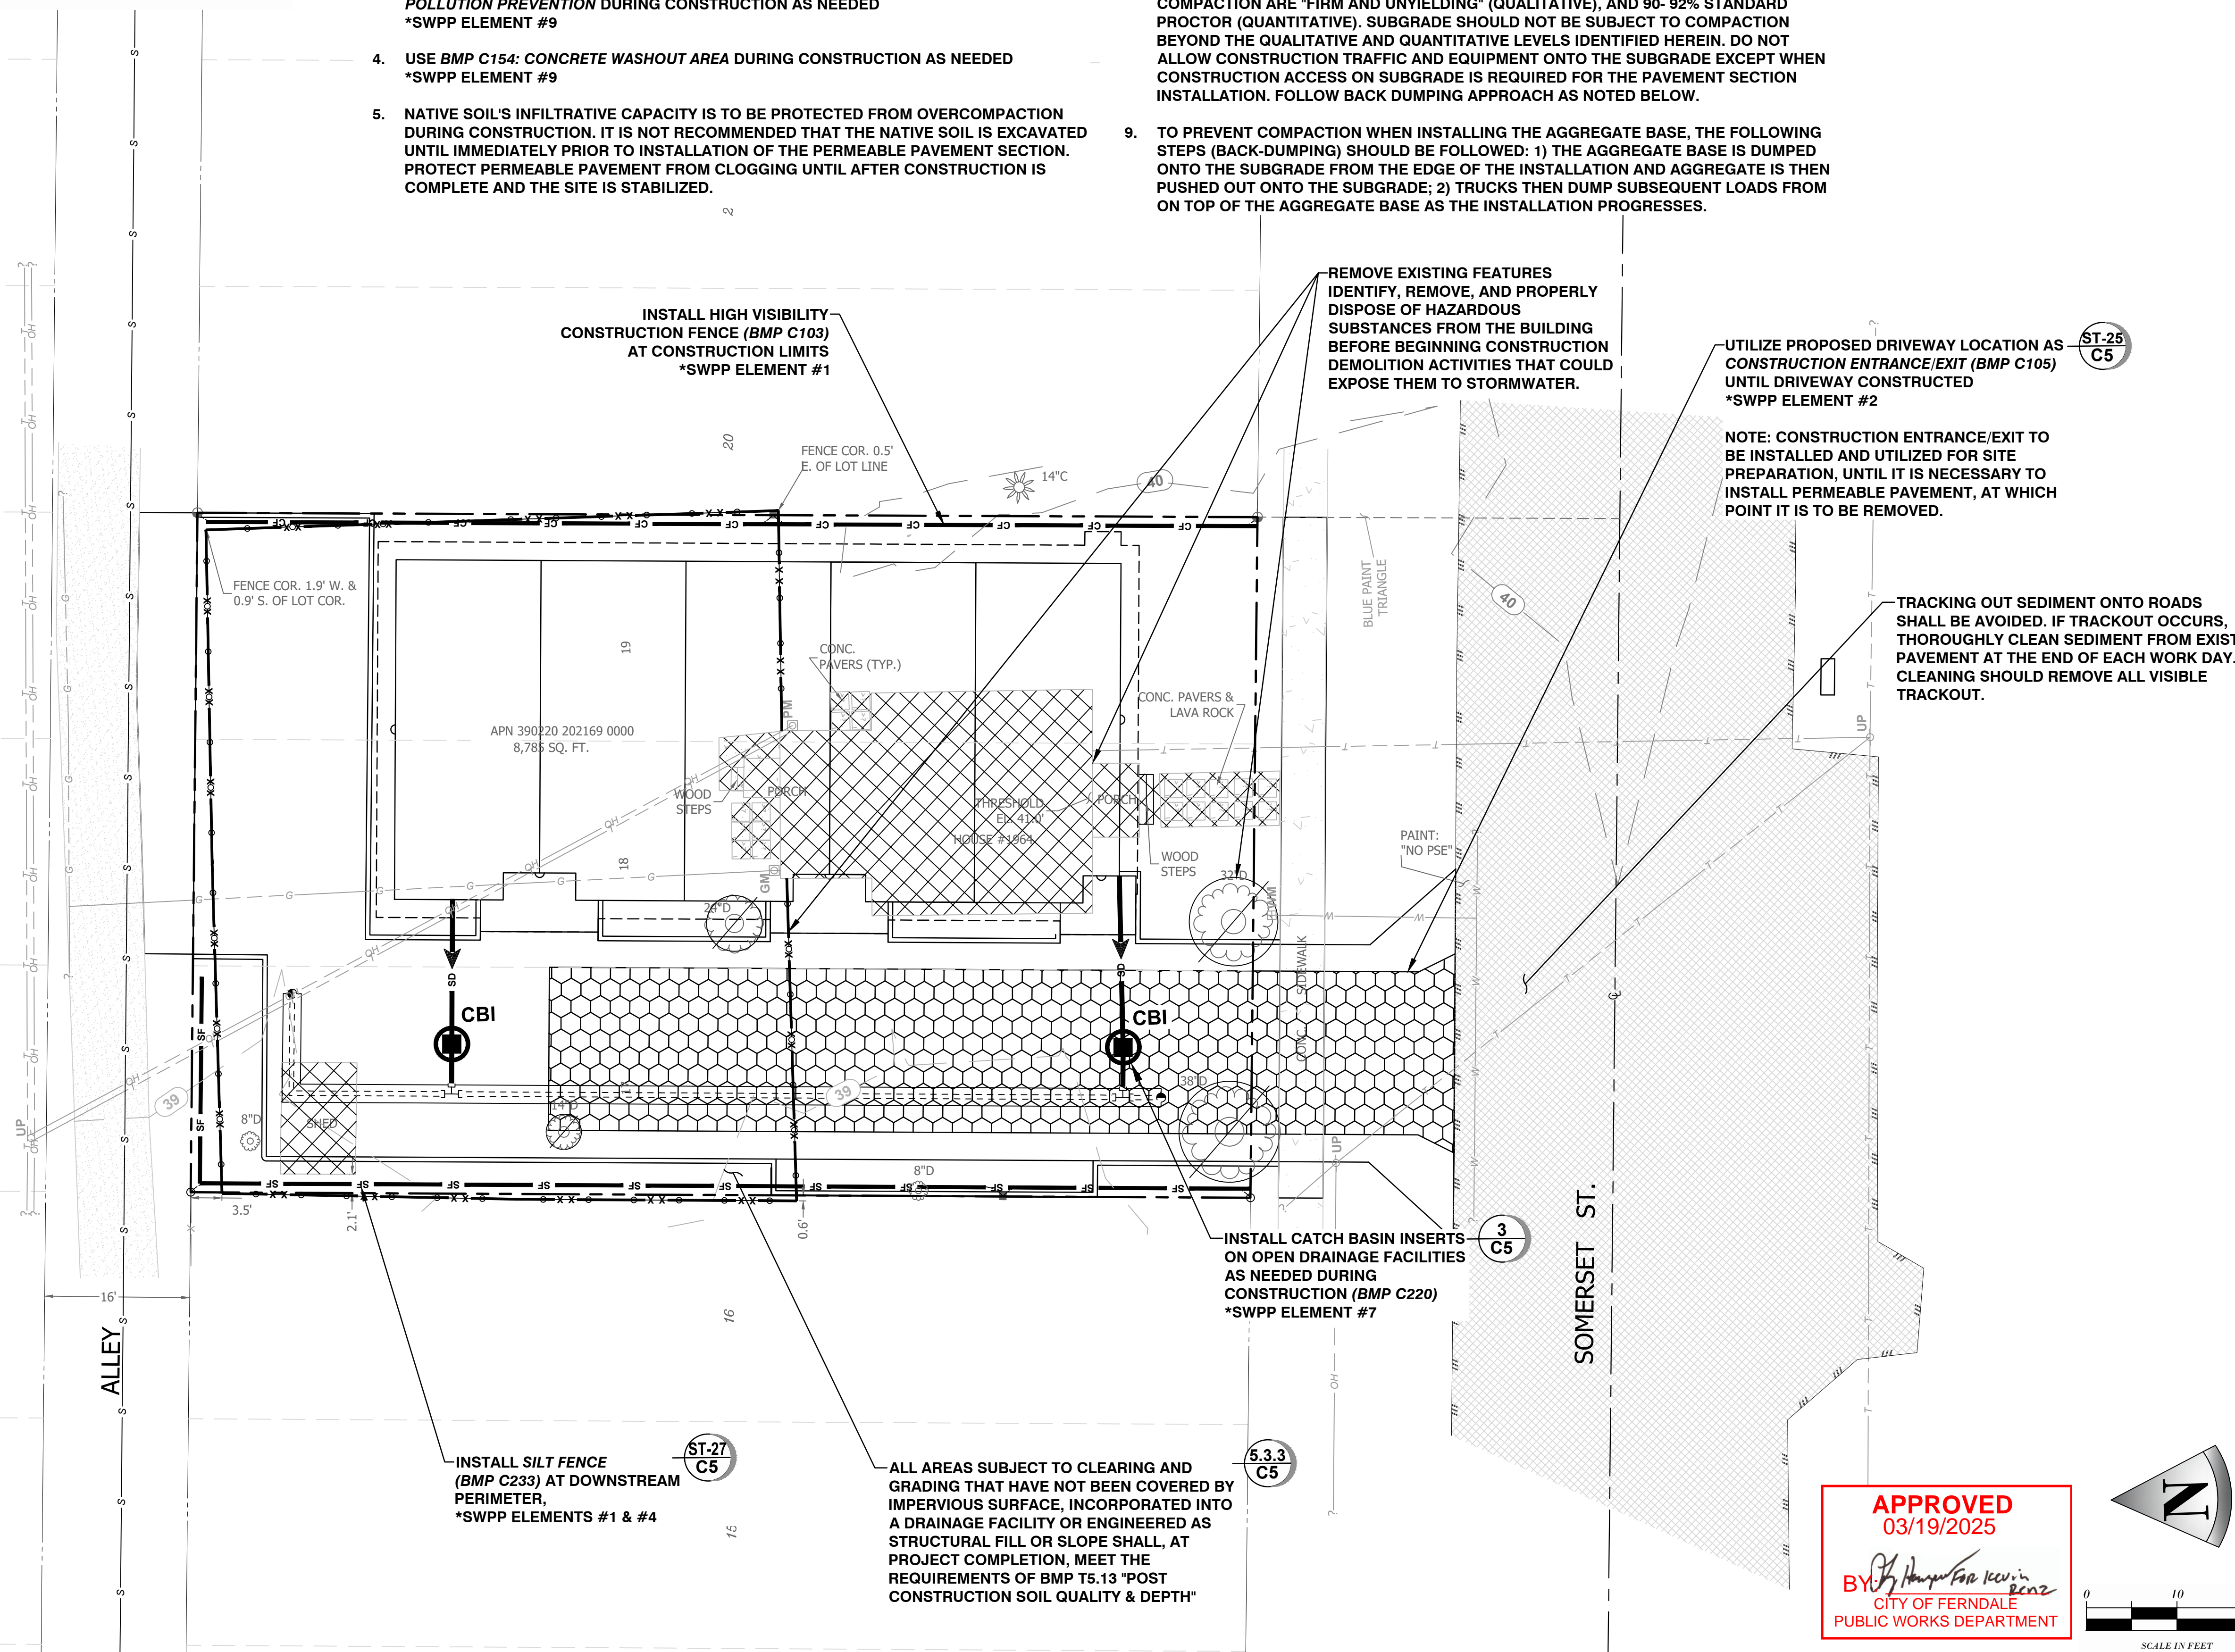

RECORD DRAWING - 02/24/2025

**AXE ENGINEERING
SERVICES, LLC**
*"CUTTING THROUGH
PROJECT BARRIERS"*
851 COHO WAY #306
BELLINGHAM, WA 98225
360 - 922 - 0549
www.axengineering.com



CITY OF FERNDALE, WA
1964 SOMERSET ST DEVELOPMENT
CIVIL CONSTRUCTION PLANS
SWPP & DEMOLITION PLAN


DATE: 02/24/2025
DESIGN: KVD
DRAWN: MDS
SCALE: AS SHOWN



PROJECT # 22037

SHEET #
C4



APPROVED
03/19/2025
BY: *[Signature]*
CITY OF FERDALE
PUBLIC WORKS DEPARTMENT

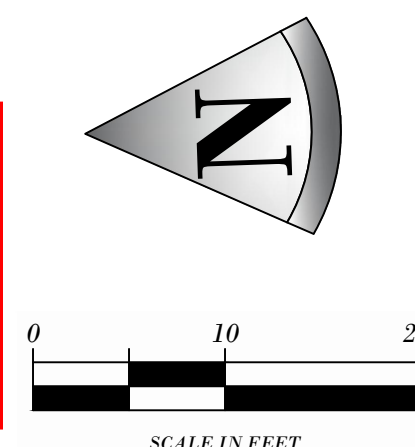

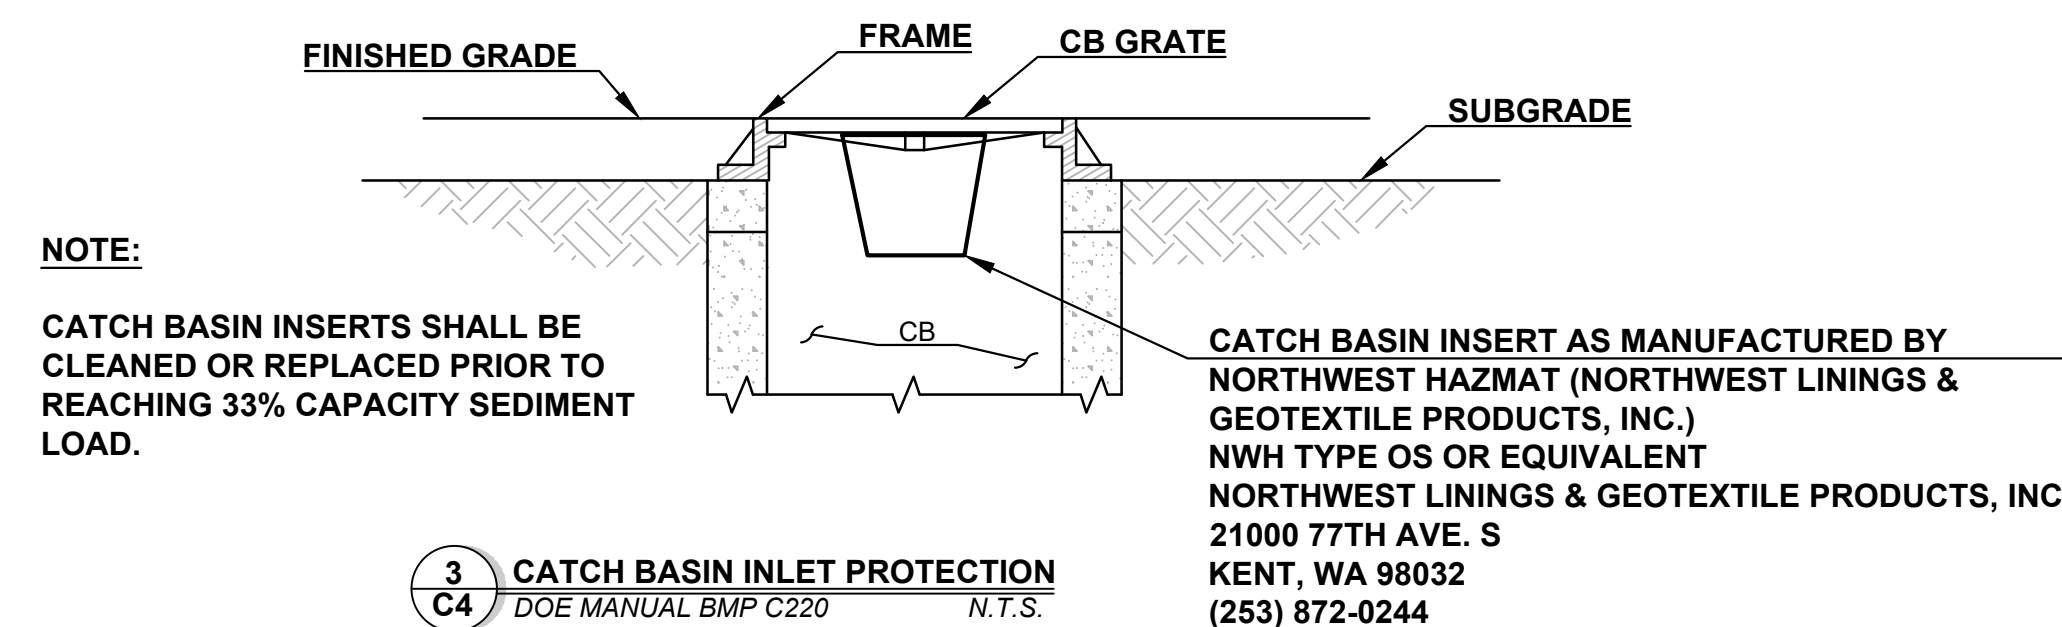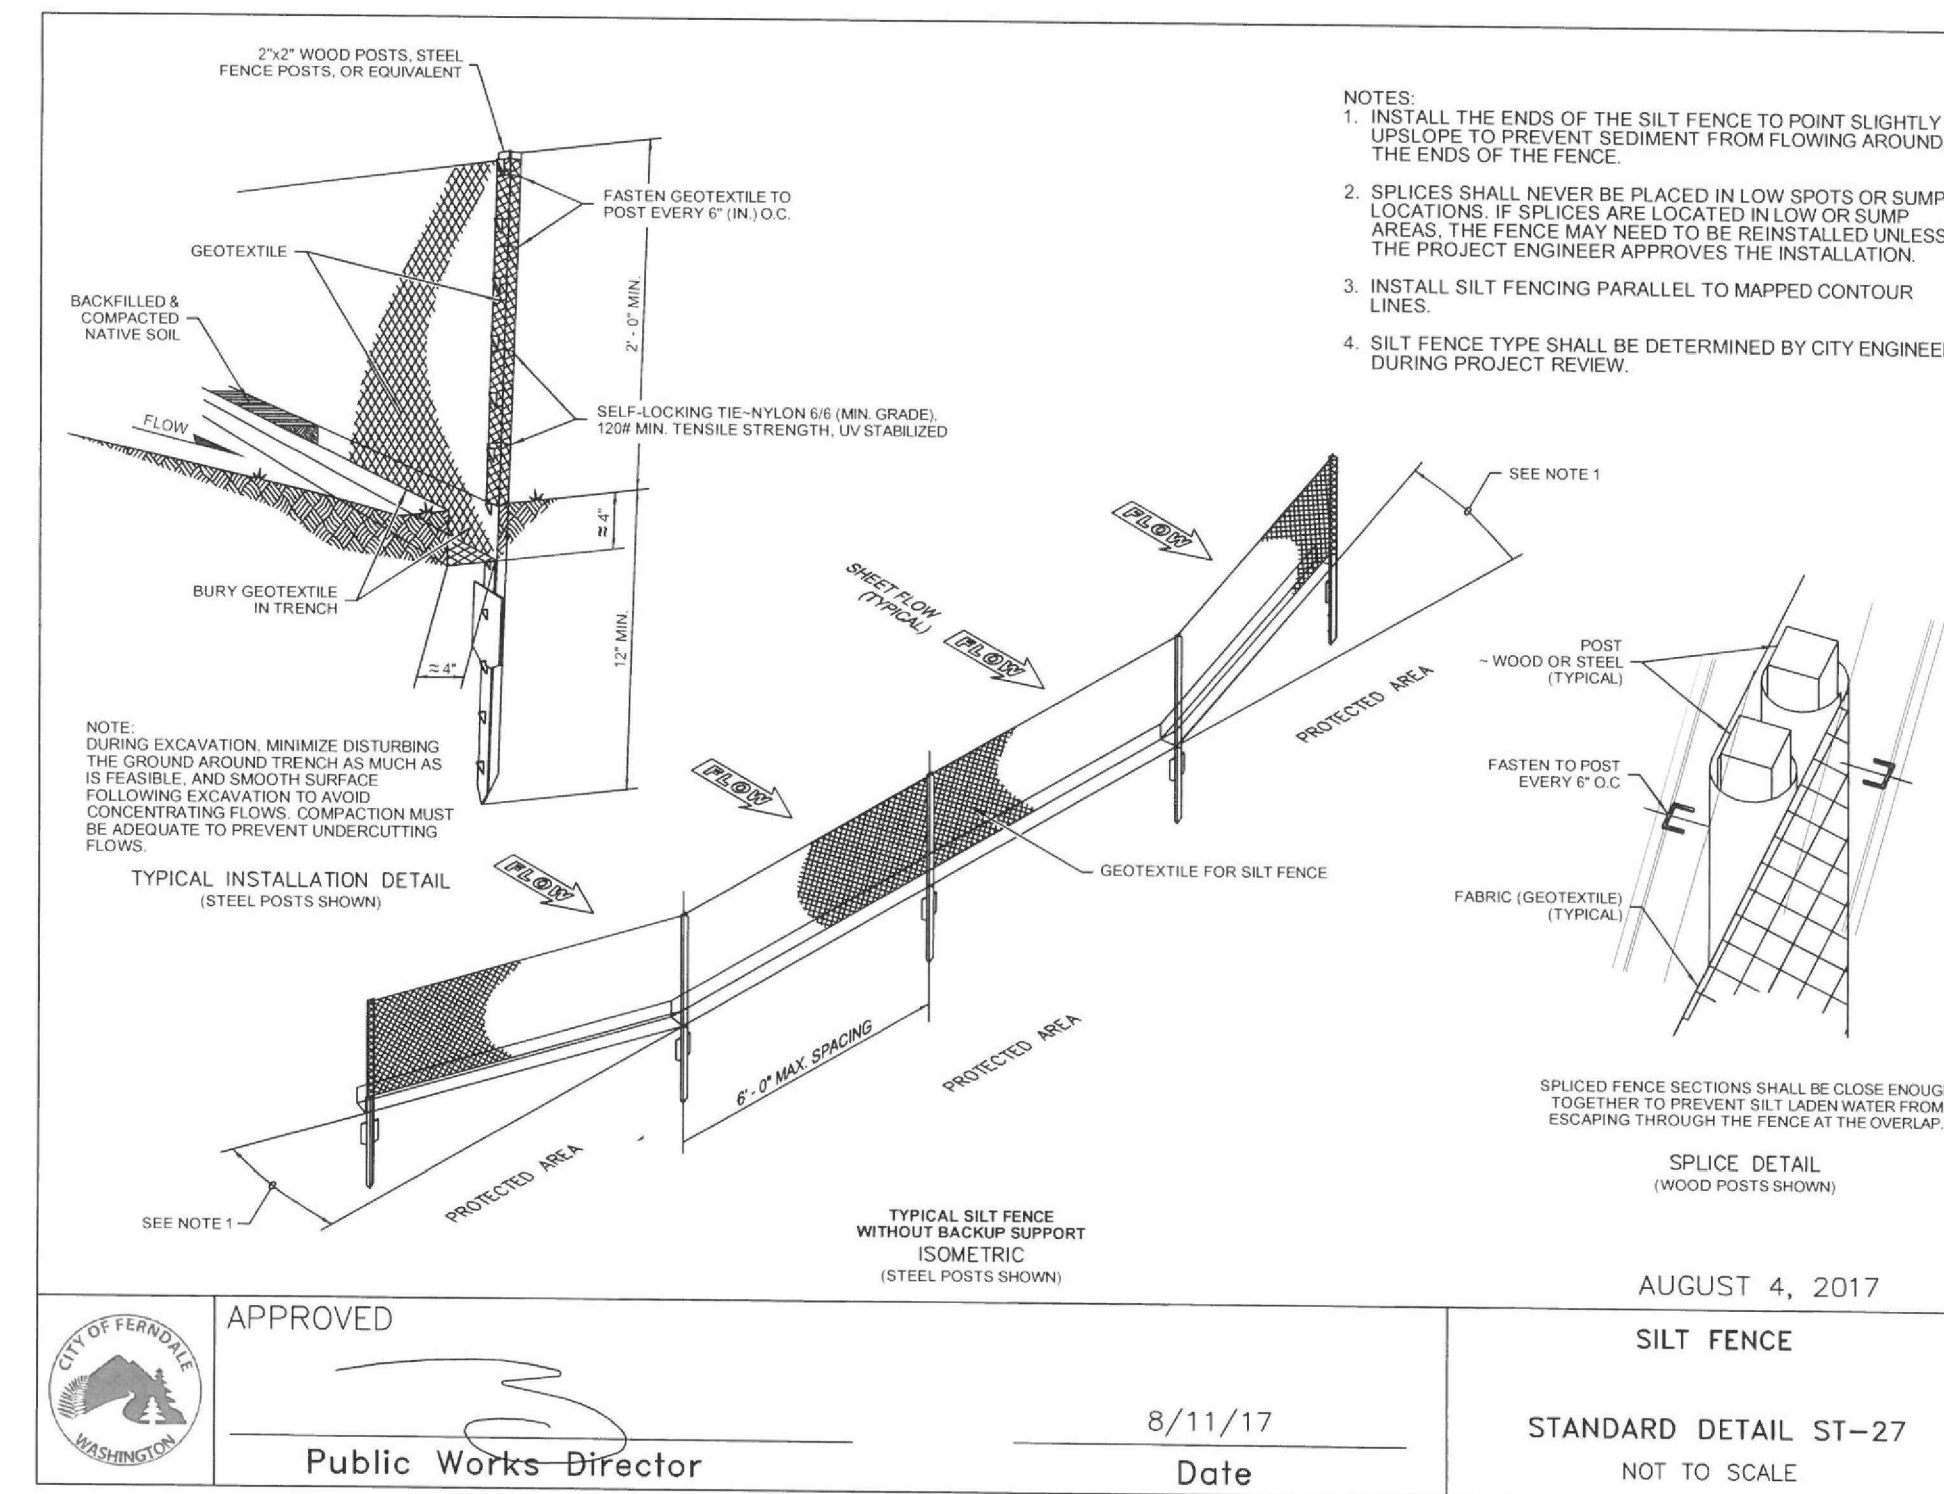

APPROVED
03/19/2025
BY: *[Signature]*
CITY OF FERDALE
PUBLIC WORKS DEPARTMENT

RECORD DRAWING - 02/24/2025

**AXE ENGINEERING
SERVICES, LLC**
*"CUTTING THROUGH
PROJECT BARRIERS"*
851 COHO WAY #306
BELLINGHAM, WA 98225
360-922-0549
www.axeengineering.com



CITY OF FERNDALE, WA
1964 SOMERSET ST DEVELOPMENT
CIVIL CONSTRUCTION PLANS
SWPP DETAILS

DATE: 02/24/2025
DESIGN: KVD
DRAWN: MDS
SCALE: AS SHOWN

PROJECT # 22037

SHEET #
C5

DATE	BY
------	----

VISIONS

300 322 0343
www.axeengineering.com

axeengineering.com

202


SWAPP DETAILS

DATE: 02/24/2025
DESIGN: KVD
DRAWN: MDS
SCALE: AS SHOWN

PROJECT # 22037

SHEET #
C5

00756.005 03/19/25 RH

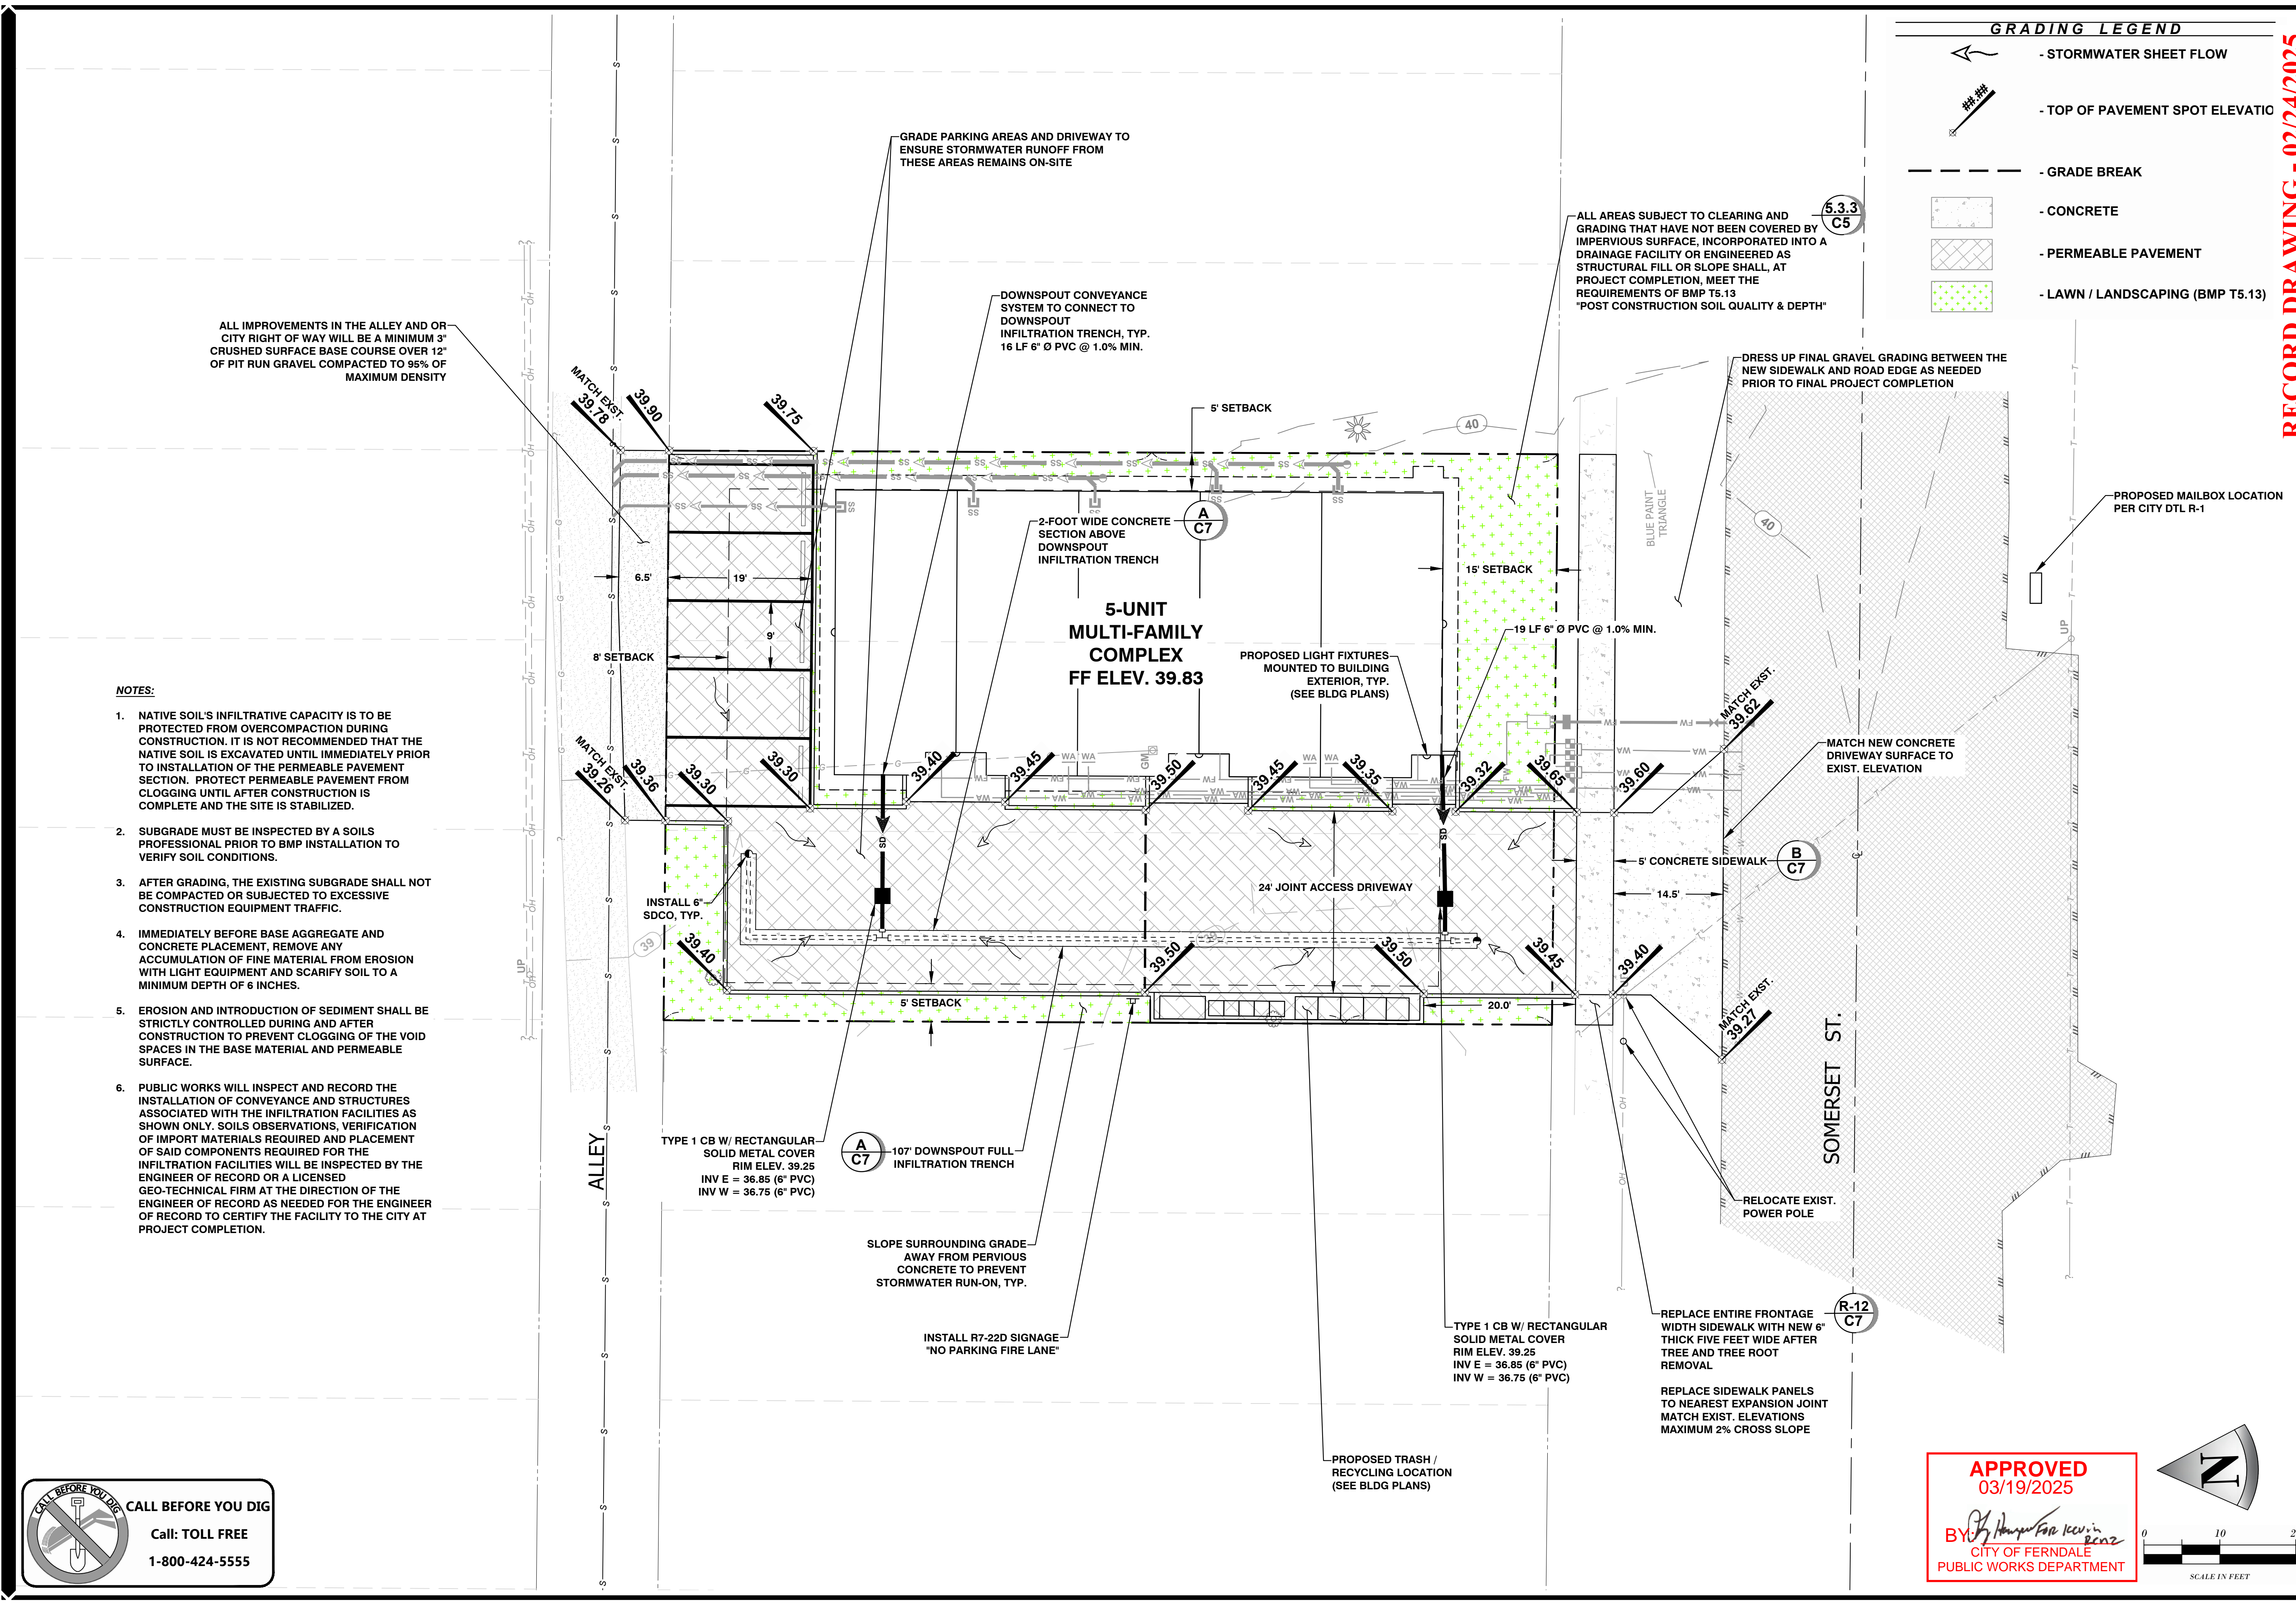

NOTES:

1. NATIVE SOIL'S INFILTRATIVE CAPACITY IS TO BE PROTECTED FROM OVERCOMPACTION DURING CONSTRUCTION. IT IS NOT RECOMMENDED THAT THE NATIVE SOIL IS EXCAVATED UNTIL IMMEDIATELY PRIOR TO INSTALLATION OF THE PERMEABLE PAVEMENT SECTION. PROTECT PERMEABLE PAVEMENT FROM CLOGGING UNTIL AFTER CONSTRUCTION IS COMPLETE AND THE SITE IS STABILIZED.
2. SUBGRADE MUST BE INSPECTED BY A SOILS PROFESSIONAL PRIOR TO BMP INSTALLATION TO VERIFY SOIL CONDITIONS.
3. AFTER GRADING, THE EXISTING SUBGRADE SHALL NOT BE COMPACTED OR SUBJECTED TO EXCESSIVE CONSTRUCTION EQUIPMENT TRAFFIC.
4. IMMEDIATELY BEFORE BASE AGGREGATE AND CONCRETE PLACEMENT, REMOVE ANY ACCUMULATION OF FINE MATERIAL FROM EROSION WITH LIGHT EQUIPMENT AND SCARIFY SOIL TO A MINIMUM DEPTH OF 6 INCHES.
5. EROSION AND INTRODUCTION OF SEDIMENT SHALL BE STRICTLY CONTROLLED DURING AND AFTER CONSTRUCTION TO PREVENT CLOGGING OF THE VOID SPACES IN THE BASE MATERIAL AND PERMEABLE SURFACE.
6. PUBLIC WORKS WILL INSPECT AND RECORD THE INSTALLATION OF CONVEYANCE AND STRUCTURES ASSOCIATED WITH THE INFILTRATION FACILITIES AS SHOWN ONLY. SOILS OBSERVATIONS, VERIFICATION OF IMPORT MATERIALS REQUIRED AND PLACEMENT OF SAID COMPONENTS REQUIRED FOR THE INFILTRATION FACILITIES WILL BE INSPECTED BY THE ENGINEER OF RECORD OR A LICENSED GEO-TECHNICAL FIRM AT THE DIRECTION OF THE ENGINEER OF RECORD AS NEEDED FOR THE ENGINEER OF RECORD TO CERTIFY THE FACILITY TO THE CITY AT PROJECT COMPLETION.

GRADING LEGEND

- STORMWATER SHEET FLOW
- TOP OF PAVEMENT SPOT ELEVATIO
- GRADE BREAK
- CONCRETE
- PERMEABLE PAVEMENT
- LAWN / LANDSCAPING (BMP T5.13)

RECORD DRAWING - 02/24/2025


AXE ENGINEERING SERVICES, LLC
"CUTTING THROUGH PROJECT BARRIERS"
851 COHO WAY #306
BELLINGHAM, WA 98225
360 - 922 - 0549
www.axeengineering.com




CITY OF FERNDALE, WA
1964 SOMERSET ST DEVELOPMENT
CIVIL CONSTRUCTION PLANS
GRADING & DRAINAGE PLAN

DATE: 02/24/2025
DESIGN: KVD
DRAWN: MDS
SCALE: AS SHOWN
PROJECT # 22037
SHEET # OF
C6 10
REV #
REC

APPROVED
03/19/2025
BY: *K. Van der BEEK*
CITY OF FERNDALE
PUBLIC WORKS DEPARTMENT

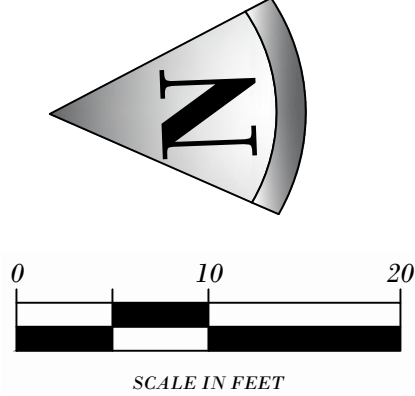

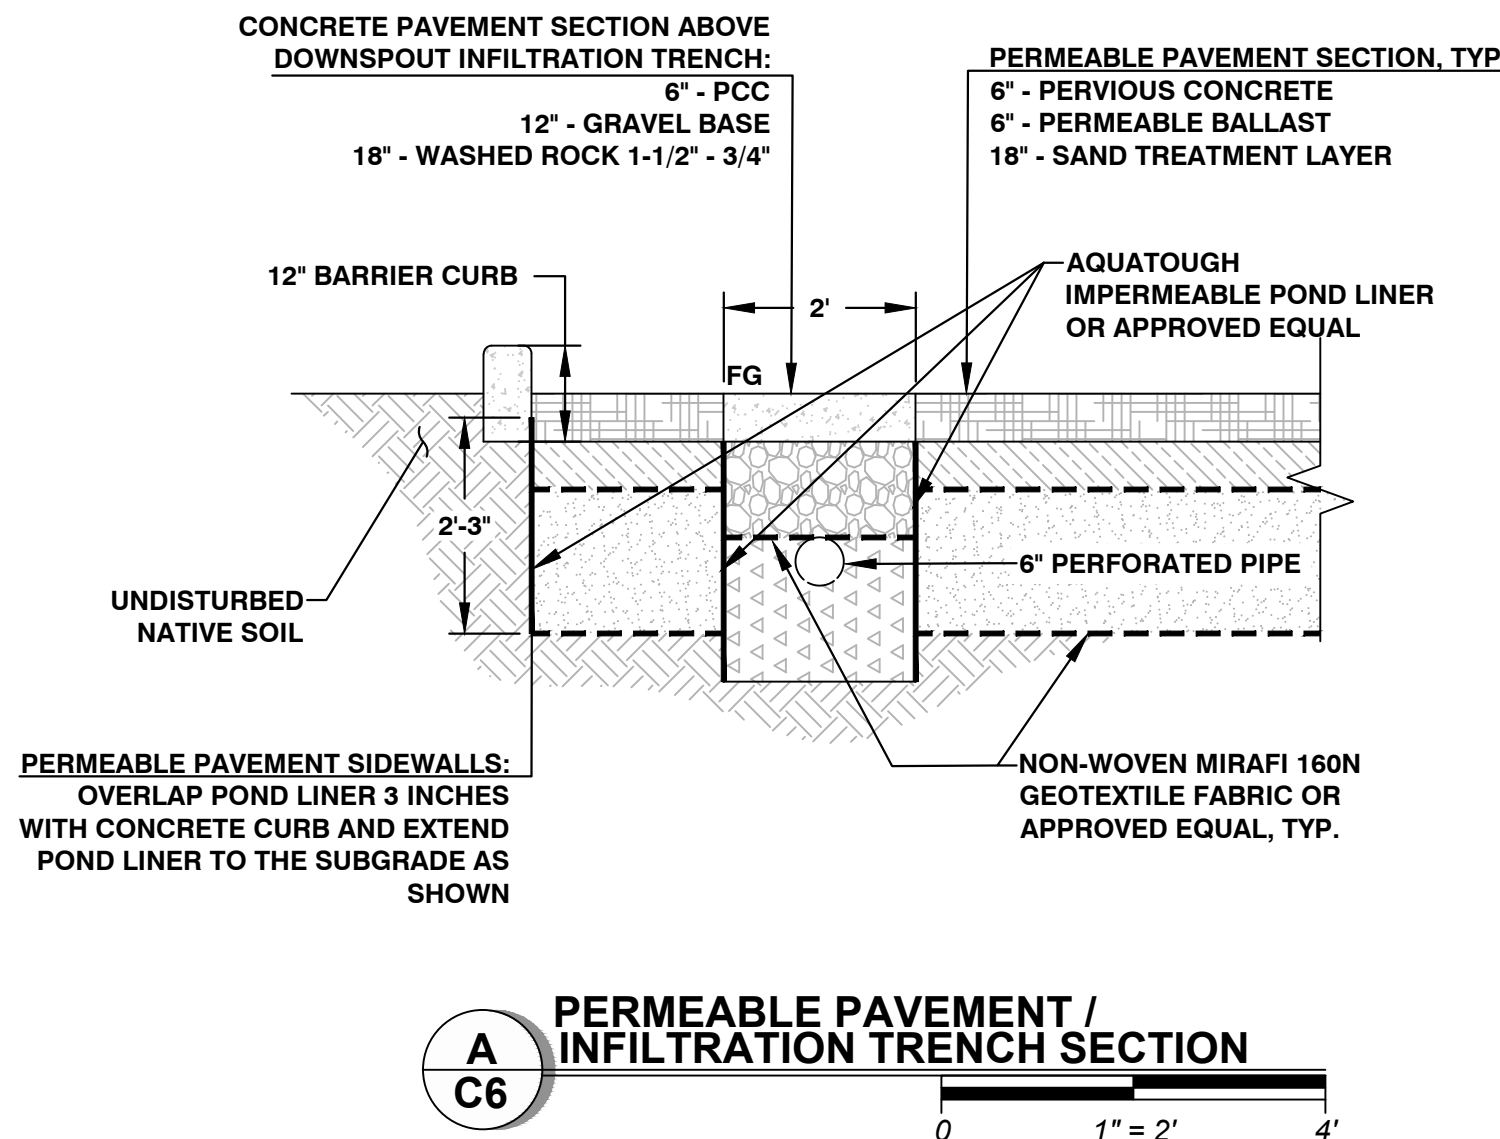


NOTES:

1. INSTALL NON-WOVEN MIRAFI 160N GEOTEXTILE FABRIC OR APPROVED EQUAL ABOVE AND BELOW SAND TREATMENT LAYER.
2. 18" SAND TREATMENT LAYER: INSTALL 18-INCH SAND MEDIUM LAYER PER THE FOLLOWING SAND MEDIUM SPECIFICATIONS LISTED IN BMP 78.10, IN VOLUME V-CHAPTER 6-PAGES 810-811 OF THE DOE MANUAL: THE SAND MEDIUM MUST CONSIST OF SAND MEETING THE SIZE GRADATION (BY WEIGHT) GIVEN IN TABLE V-6.1 BELOW. THE CONTRACTOR MUST OBTAIN A GRAIN SIZE ANALYSIS FROM THE SUPPLIER TO CERTIFY THAT THE SAND MEETS THE NO. 100 AND NO. 200 SIEVE REQUIREMENTS.

Table V-6.1: Sand Medium Specification

Sieve Number	Percent Passing
4	95-100
8	70-100
16	40-90
30	25-75
50	2-25
100	<4
200	<2

Source: (King County Department of Natural Resources, 1998)

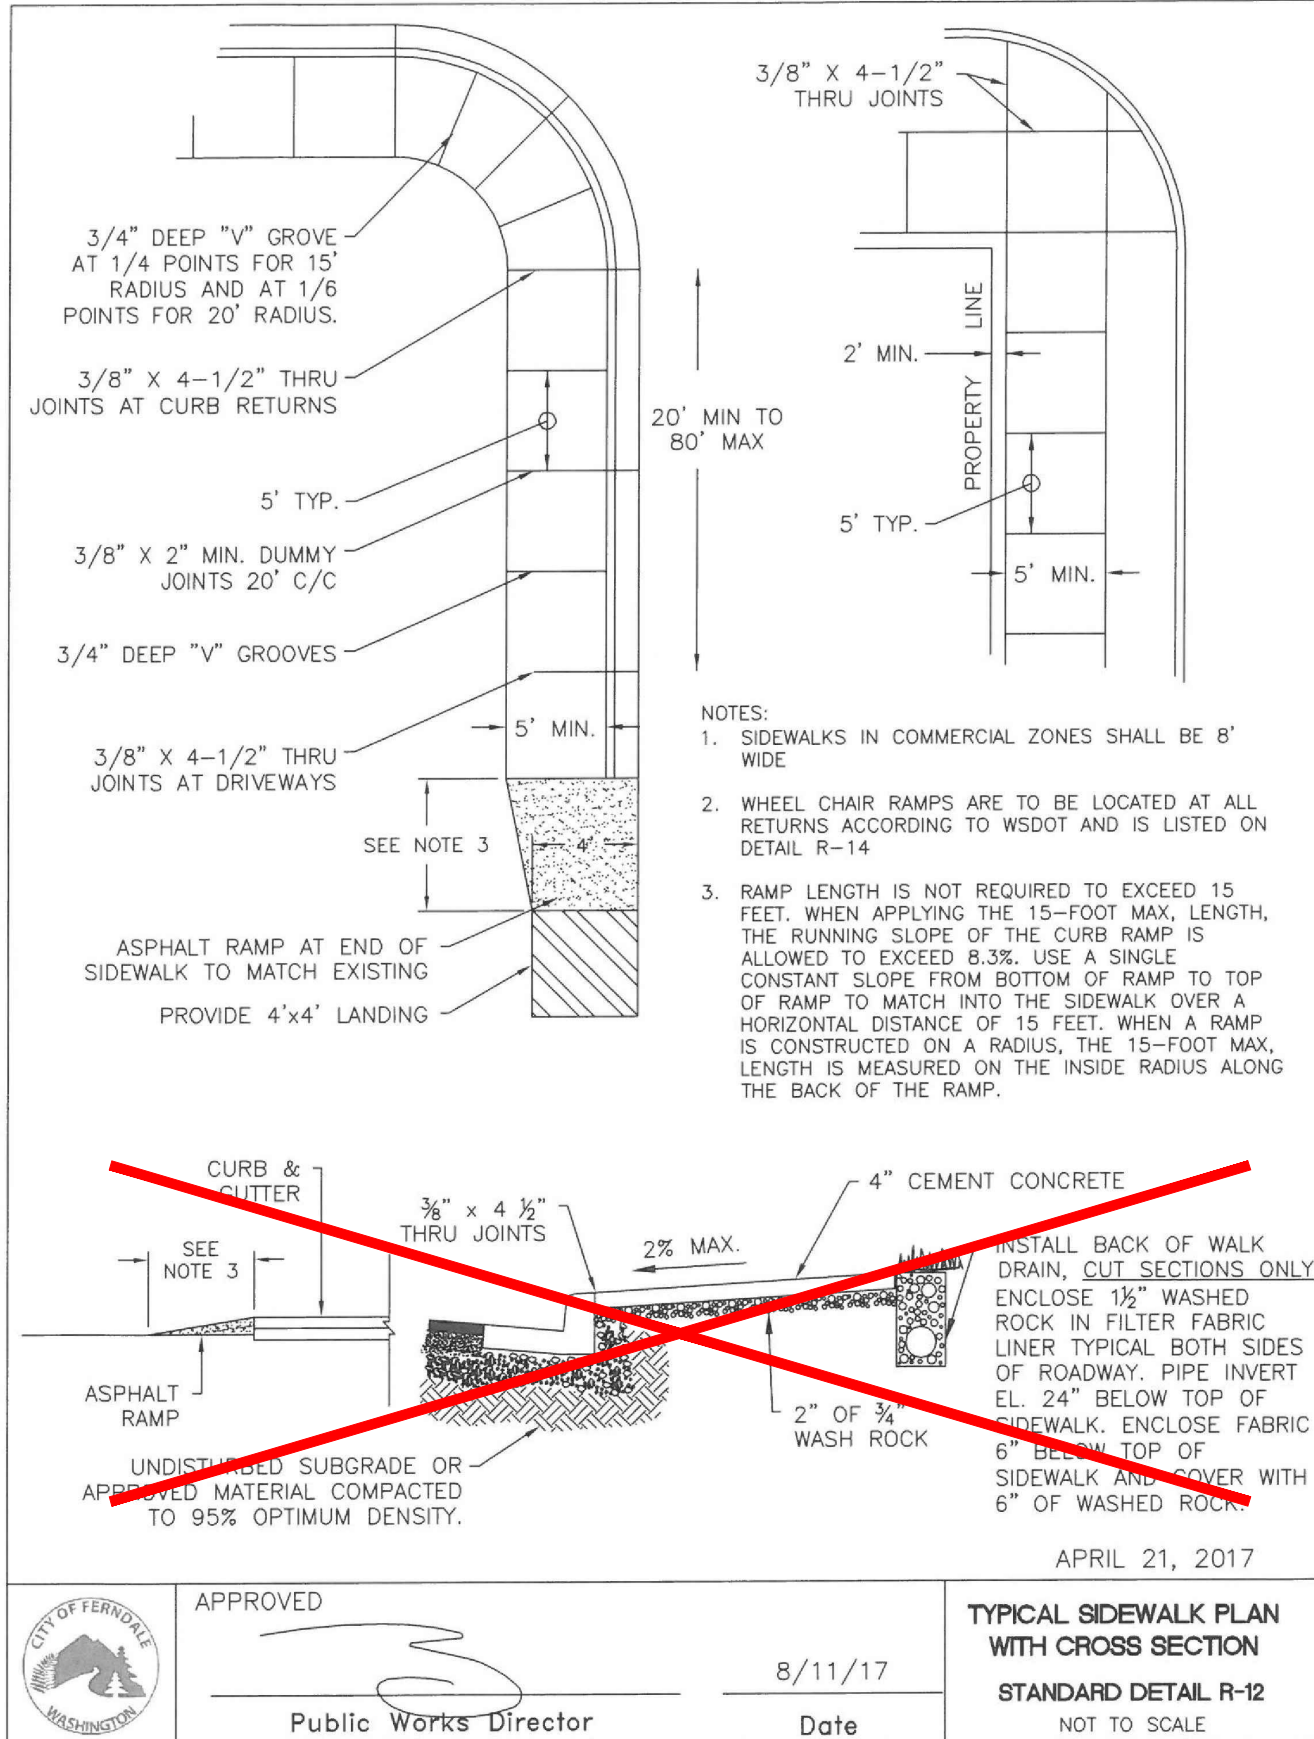

TENCATE
Mirafi

TENCATE GEOSYNTHETICS
Americas

Mirafi® 160N



Mirafi® 160N is a nonwoven geotextile composed of polypropylene fibers, which are formed into a stable network such that the fibers retain their relative position. Mirafi® 160N is inert to biological degradation and resists naturally encountered chemicals, alkalis, and acids. Mirafi® 160N meets AASHTO M288 Class 2 for Elongation > 50%.

TenCate Geosynthetics Americas Laboratories are accredited by Geosynthetic Accreditation Institute – Laboratory Accreditation Program (GAI-LAP), NTPEP Listed

Mechanical Properties	Test Method	Unit	Minimum Average Roll Value	
			MD	CD
Grab Tensile Strength	ASTM D4632	lbs (N)	160 (712)	160 (712)
Grab Tensile Elongation	ASTM D4632	%	50	50
Trapezoid Tear Strength	ASTM D4533	lbs (N)	60 (267)	60 (267)
CBR Puncture Strength	ASTM D6241	lbs (N)	410 (1825)	410 (1825)
Apparent Opening Size (AOS)	ASTM D4751	U.S. Sieve (mm)	70 (0.212)	
Permittivity	ASTM D4491	sec ⁻¹	1.5	
Flow Rate	ASTM D4491	gal/min/ft ² (l/min/m ²)	110 (4481)	
UV Resistance (at 500 hours)	ASTM D4355	% strength retained	70	
Physical Properties		Unit	Roll Size	
			Roll Dimensions (width x length)	Roll Area
		ft (m)	15 x 300 (4.5 x 91)	500 (418)
		yd ² (m ²)	500 (418)	

Disclaimer: TenCate assumes no liability for the accuracy or completeness of this information or for the ultimate use by the purchaser. TenCate disclaims any and all express, implied, or statutory standards, warranties or guarantees, including without limitation any implied warranty as to merchantability or fitness for a particular purpose or arising from a course of dealing or usage of trade as to any equipment, materials, or information furnished herewith. This document should not be construed as engineering advice.

Mirafi® is a registered trademark of Nicolon Corporation.

Copyright © 2015 Nicolon Corporation. All Rights Reserved.


365 South Holland Drive
Pendergrass, GA 30067
FSG00061
EYD999

Tel 706 693 2226
Tel 888 795 0808

Fax 706 693 4400
www.tencate.com



GAI-LAP 05-97

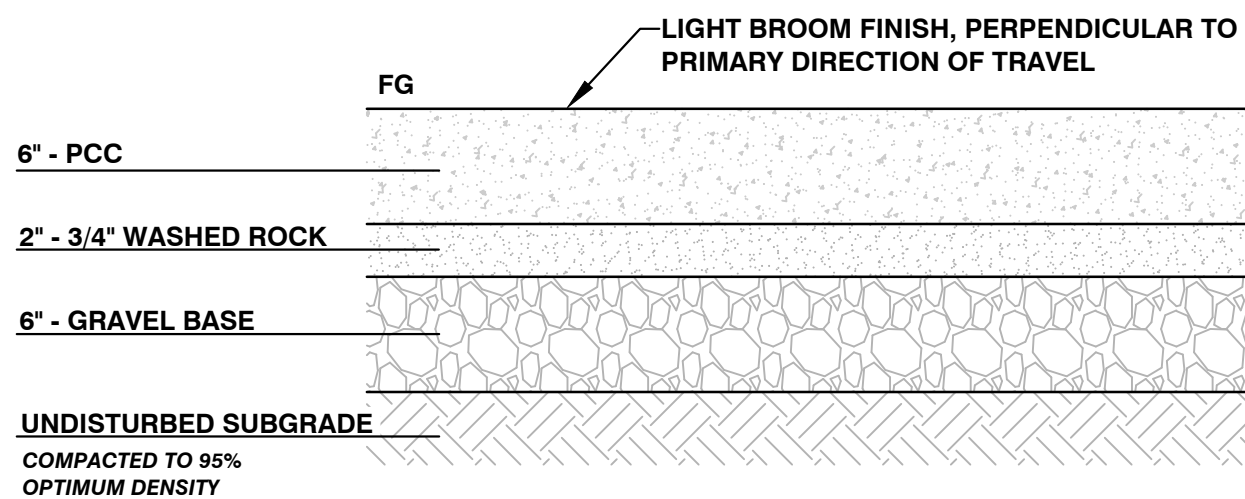

B
C6 CONCRETE SIDEWALK SECTION
NTS

HD Fowler Company Submittal - PULINER30 67732

EXPERIENCE THE CARLISLE DIFFERENCE

CARLISLE
SYNTEC SYSTEMS



Installation

Installation procedures vary as to the type of application employed and the specific job requirements. When installed correctly, it is difficult to find a more efficient water barrier. Surfaces on or against where the AquaTough membrane is to be applied must be smooth, free of fire, sharp edges, loose and foreign materials, oil and grease. AquaTough can be easily repaired in the field by the owner without specialized tools or training. Consult current specifications and details for complete installation information.

J-Tear Protection:

Amongst top competitors, Carlisle's AquaTough membranes are the only brand that will give you the added benefit of consistent J-Tear protection. When the J-Tear test is successful the sheet will tear in the direction of the cut for a short distance and then it will change direction and attempt to curve back on itself—as it does with Carlisle's AquaTough membrane.

This direction change is important during the membrane installation process. As the installer works around protrusions, the J-Tear stops the membrane from tearing as they install the sheet.

Review Carlisle specifications and details for complete installation information.

Sizes Available

45-mil	
Width	5–50 feet (1.5–15.2 meters)
Length	50–200 feet (15.2–61 meters)
Weight	6.28 lbs/sq' (1.37 kg/m ²)
Specific Gravity	1.19 g/cc



SCAN HERE TO VIEW THE J-TEAR TEST COMPARISON VIDEO




Features and Benefits

- Superb elongation and lay flat characteristics
- Excellent low temperature impact resistance
- Exceptional resistance to odor, UV, ozone, and oxidation
- Low water vapor permeance and water absorption
- Quick seaming process - no specialized or expensive tools required
- Limited Lifetime warranty available
- Large prefabricated panels available in custom sizing
- Unmatched J-Tear protection

800-479-5832 | P.O. Box 70000 | Carlisle, PA 17013 | Fax: 717-245-7053 | www.carlislegeotec.com

APPROVED
03/19/2025

BY: *[Signature]*
CITY OF FERNDALE
PUBLIC WORKS DEPARTMENT

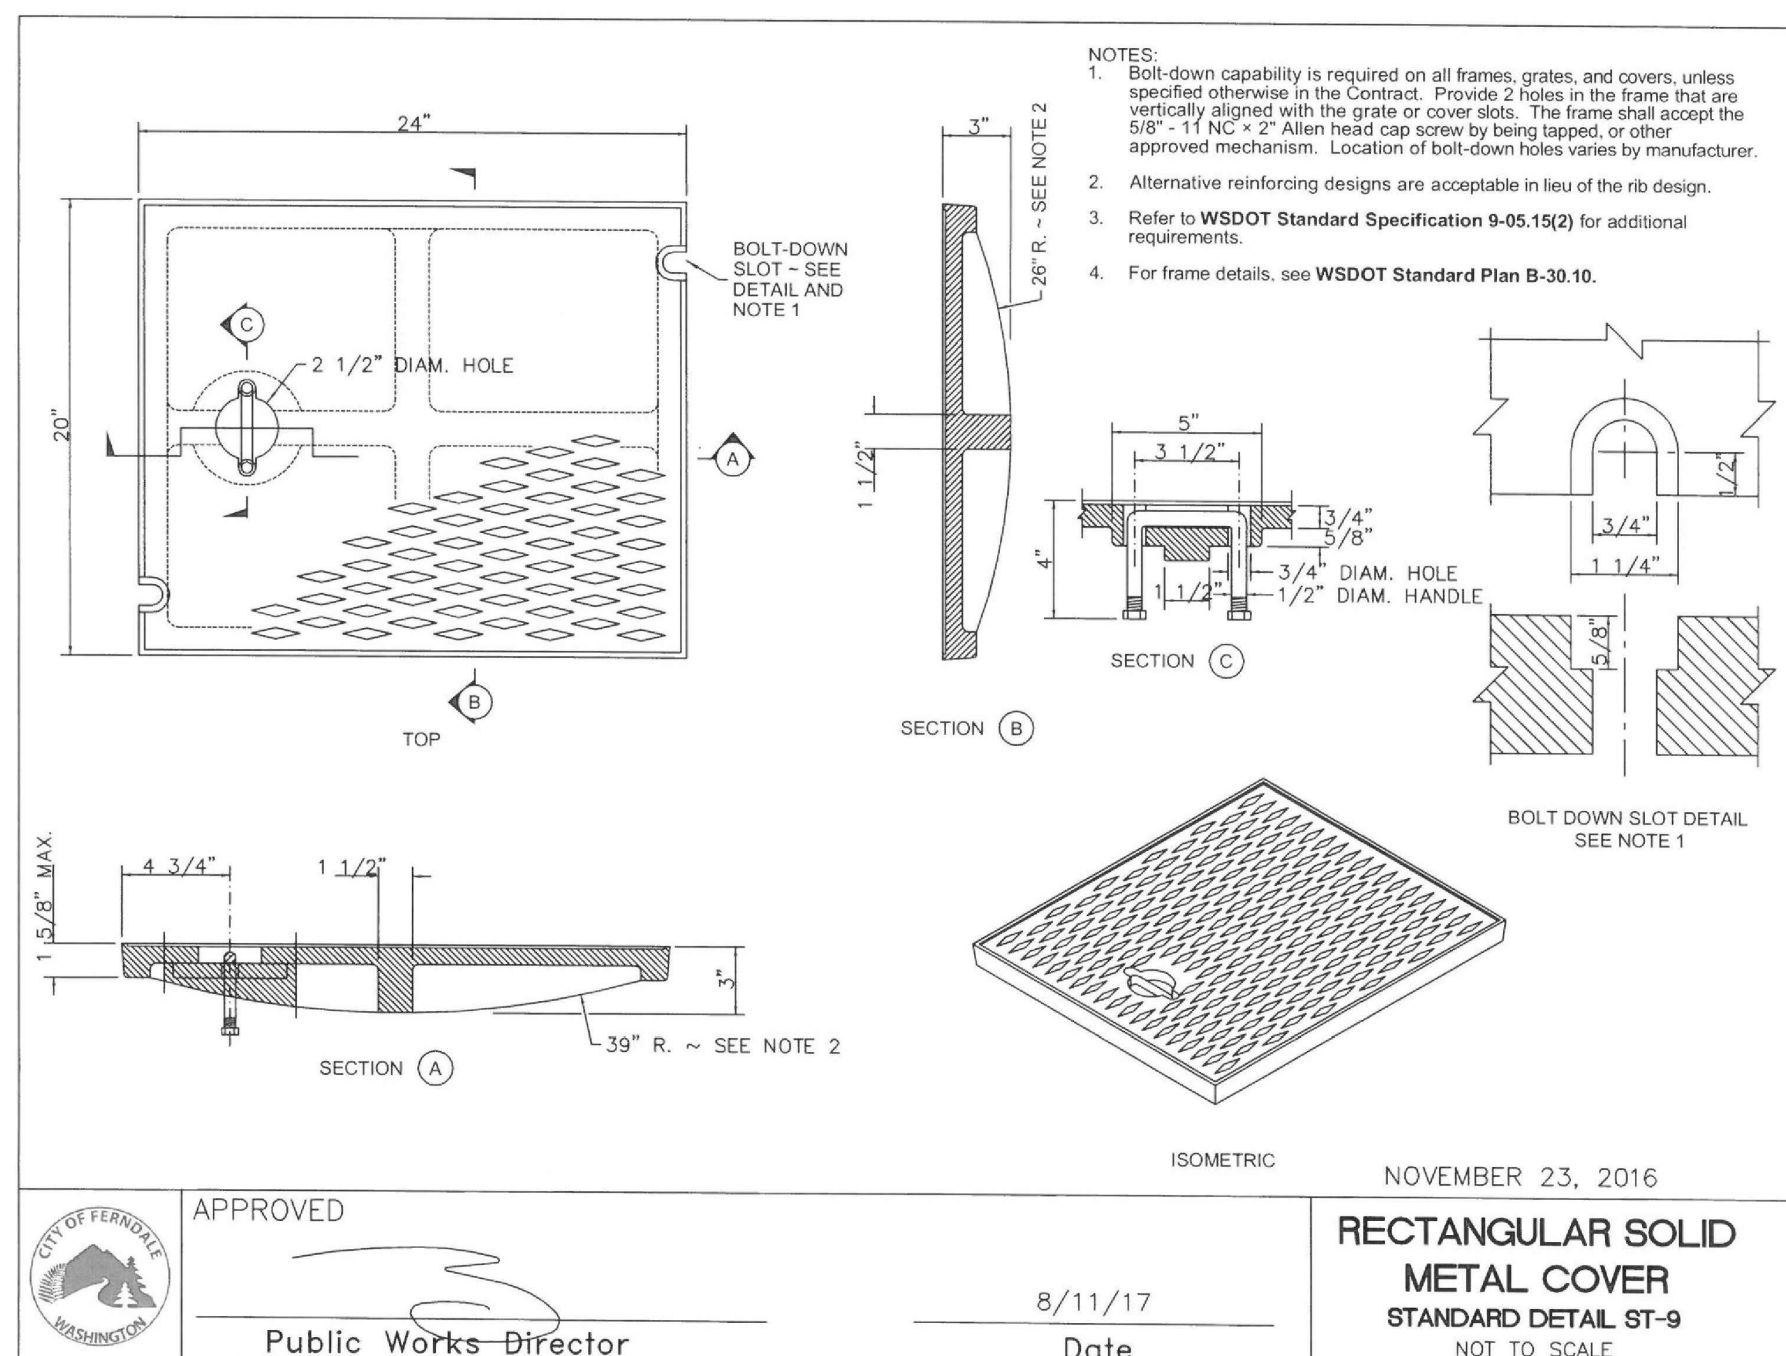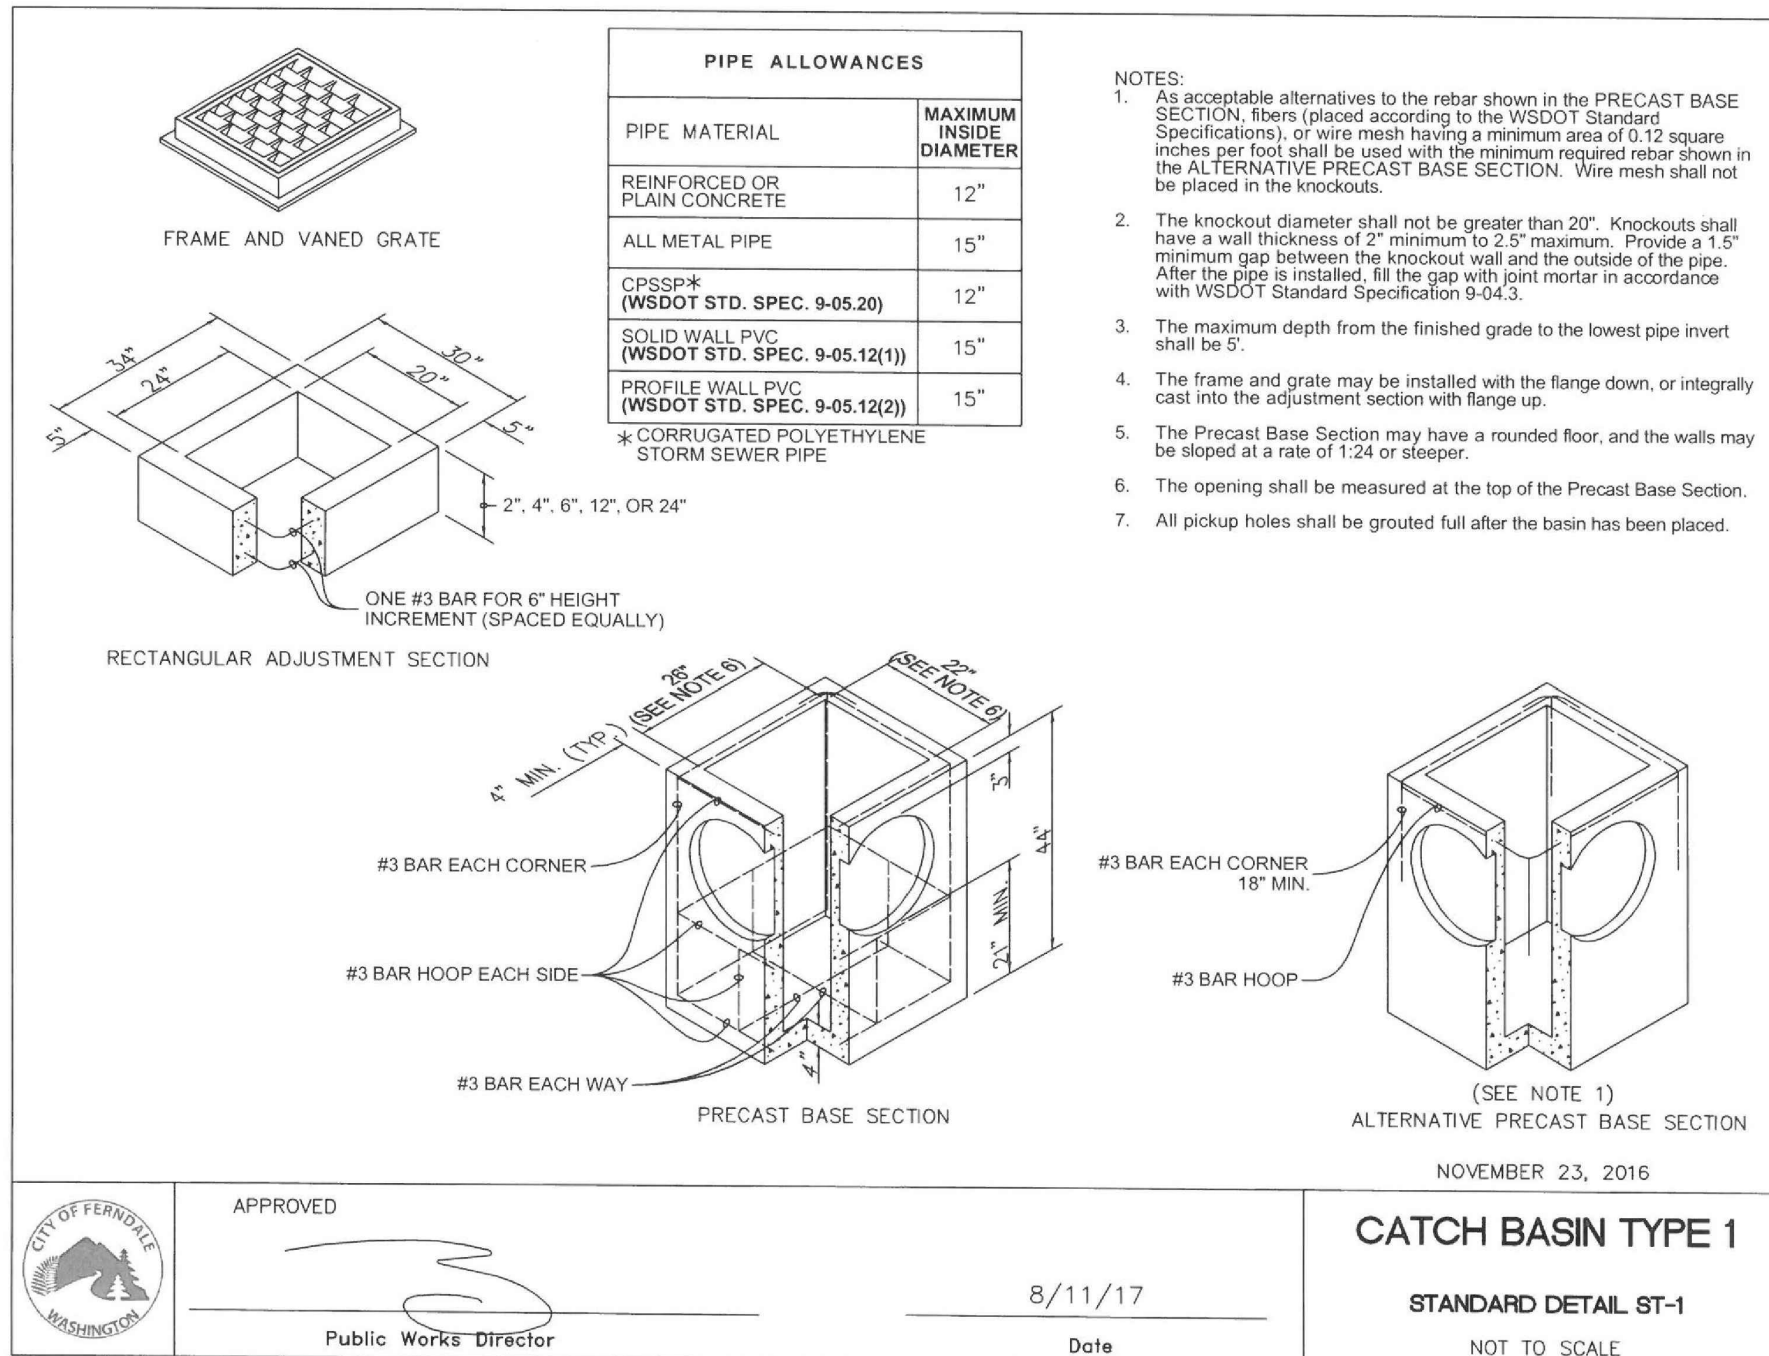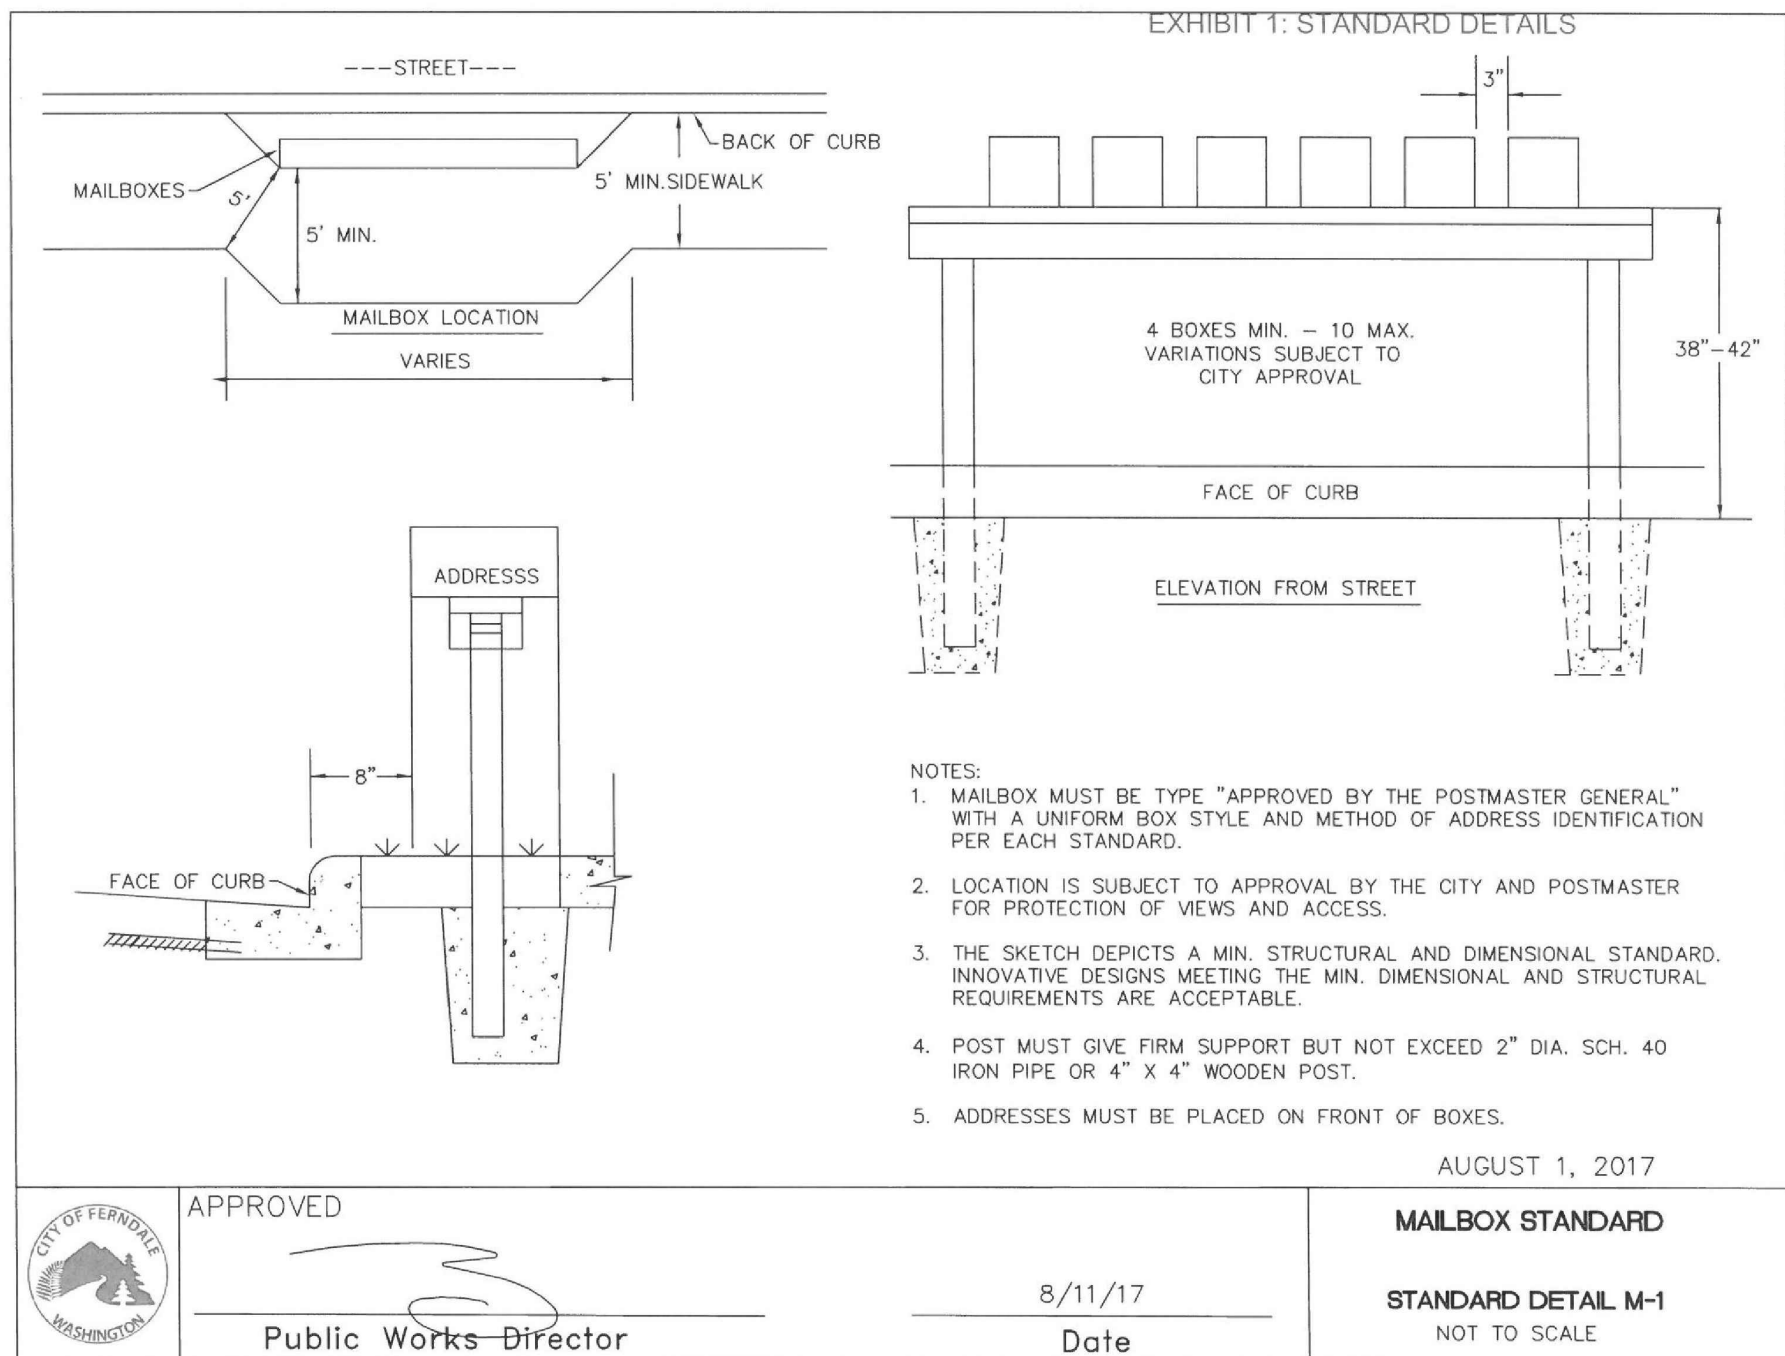

CITY OF FERNDALE, WA

1964 SOMERSET ST DEVELOPMENT
CIVIL CONSTRUCTION PLANS
GRADING & DRAINAGE DETAILS

DATE: 02/24/2025
DESIGN: KVD
DRAWN: MDS
SCALE: AS SHOWN

PROJECT # 22037

SHEET # OF
C7 10
REV # REC


AXE ENGINEERING
SERVICES, LLC

"CUTTING THROUGH PROJECT BARRIERS"
851 COHO WAY #306
BELLINGHAM, WA 98225
360 - 922 - 0549
www.axeengineering.com

ENGINEERING
SERVICES
CIVIL - STORMWATER - STRUCTURAL
axeengineering.com




02/24/2025

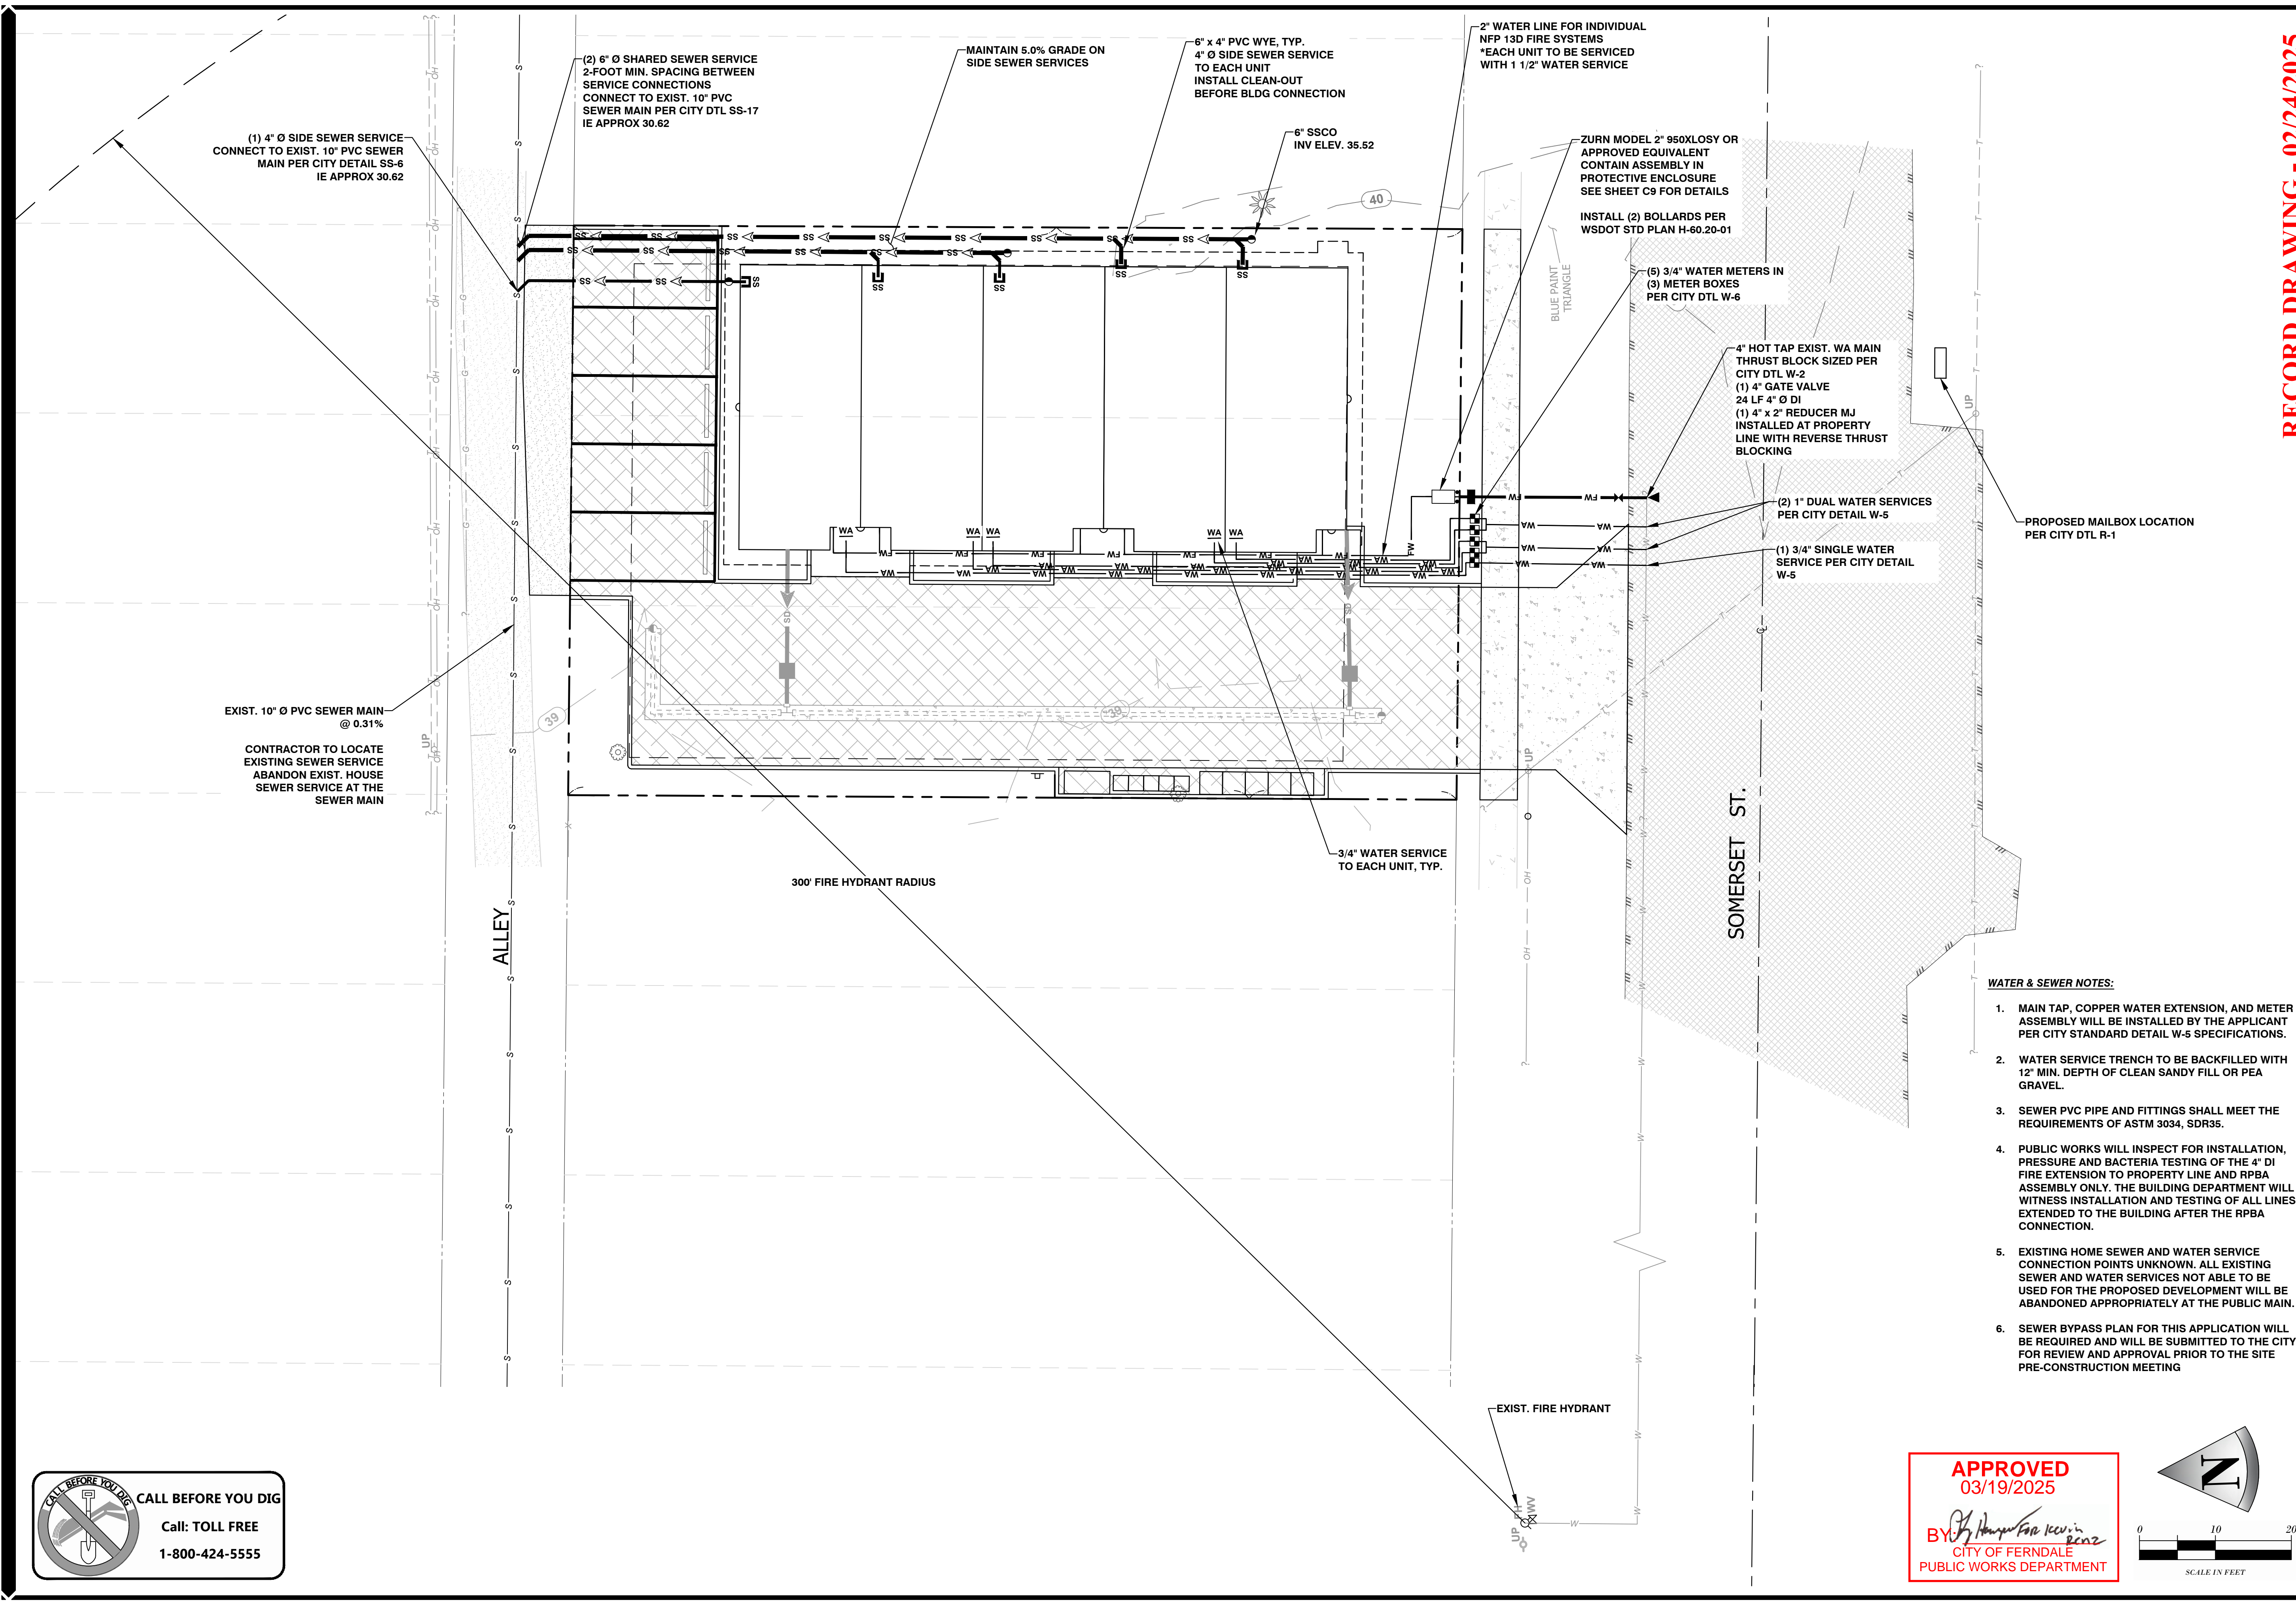

RECORD DRAWING - 02/24/2025

CALL BEFORE YOU DIG
CALL: TOLL FREE
1-800-424-5555

APPROVED
03/19/2025
BY: [Signature]
CITY OF FERDALE
PUBLIC WORKS DEPARTMENT

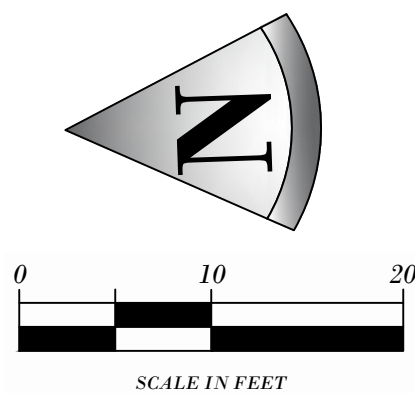

- WATER & SEWER NOTES:**
1. MAIN TAP, COPPER WATER EXTENSION, AND METER ASSEMBLY WILL BE INSTALLED BY THE APPLICANT PER CITY STANDARD DETAIL W-5 SPECIFICATIONS.
 2. WATER SERVICE TRENCH TO BE BACKFILLED WITH 12" MIN. DEPTH OF CLEAN SANDY FILL OR PEA GRAVEL.
 3. SEWER PVC PIPE AND FITTINGS SHALL MEET THE REQUIREMENTS OF ASTM 3034, SDR35.
 4. PUBLIC WORKS WILL INSPECT FOR INSTALLATION, PRESSURE AND BACTERIA TESTING OF THE 4" DI FIRE EXTENSION TO PROPERTY LINE AND RPBA ASSEMBLY ONLY. THE BUILDING DEPARTMENT WILL WITNESS INSTALLATION AND TESTING OF ALL LINES EXTENDED TO THE BUILDING AFTER THE RPBA CONNECTION.
 5. EXISTING HOME SEWER AND WATER SERVICE CONNECTION POINTS UNKNOWN. ALL EXISTING SEWER AND WATER SERVICES NOT ABLE TO BE USED FOR THE PROPOSED DEVELOPMENT WILL BE ABANDONED APPROPRIATELY AT THE PUBLIC MAIN.
 6. SEWER BYPASS PLAN FOR THIS APPLICATION WILL BE REQUIRED AND WILL BE SUBMITTED TO THE CITY FOR REVIEW AND APPROVAL PRIOR TO THE SITE PRE-CONSTRUCTION MEETING



AXE ENGINEERING
SERVICES, LLC
"CUTTING THROUGH
PROJECT BARRIERS"
851 COHO WAY #306
BELLINGHAM, WA 98225
360 - 922 - 0549
www.axeengineering.com



CITY OF FERDALE, WA
1964 SOMERSET ST DEVELOPMENT
CIVIL CONSTRUCTION PLANS
WATER & SEWER PLAN

DATE: 02/24/2025
DESIGN: KVD
DRAWN: MDS
SCALE: AS SHOWN
PROJECT # 22037
SHEET # OF
C8 10
REV # REC

REVISIONS	DATE	BY

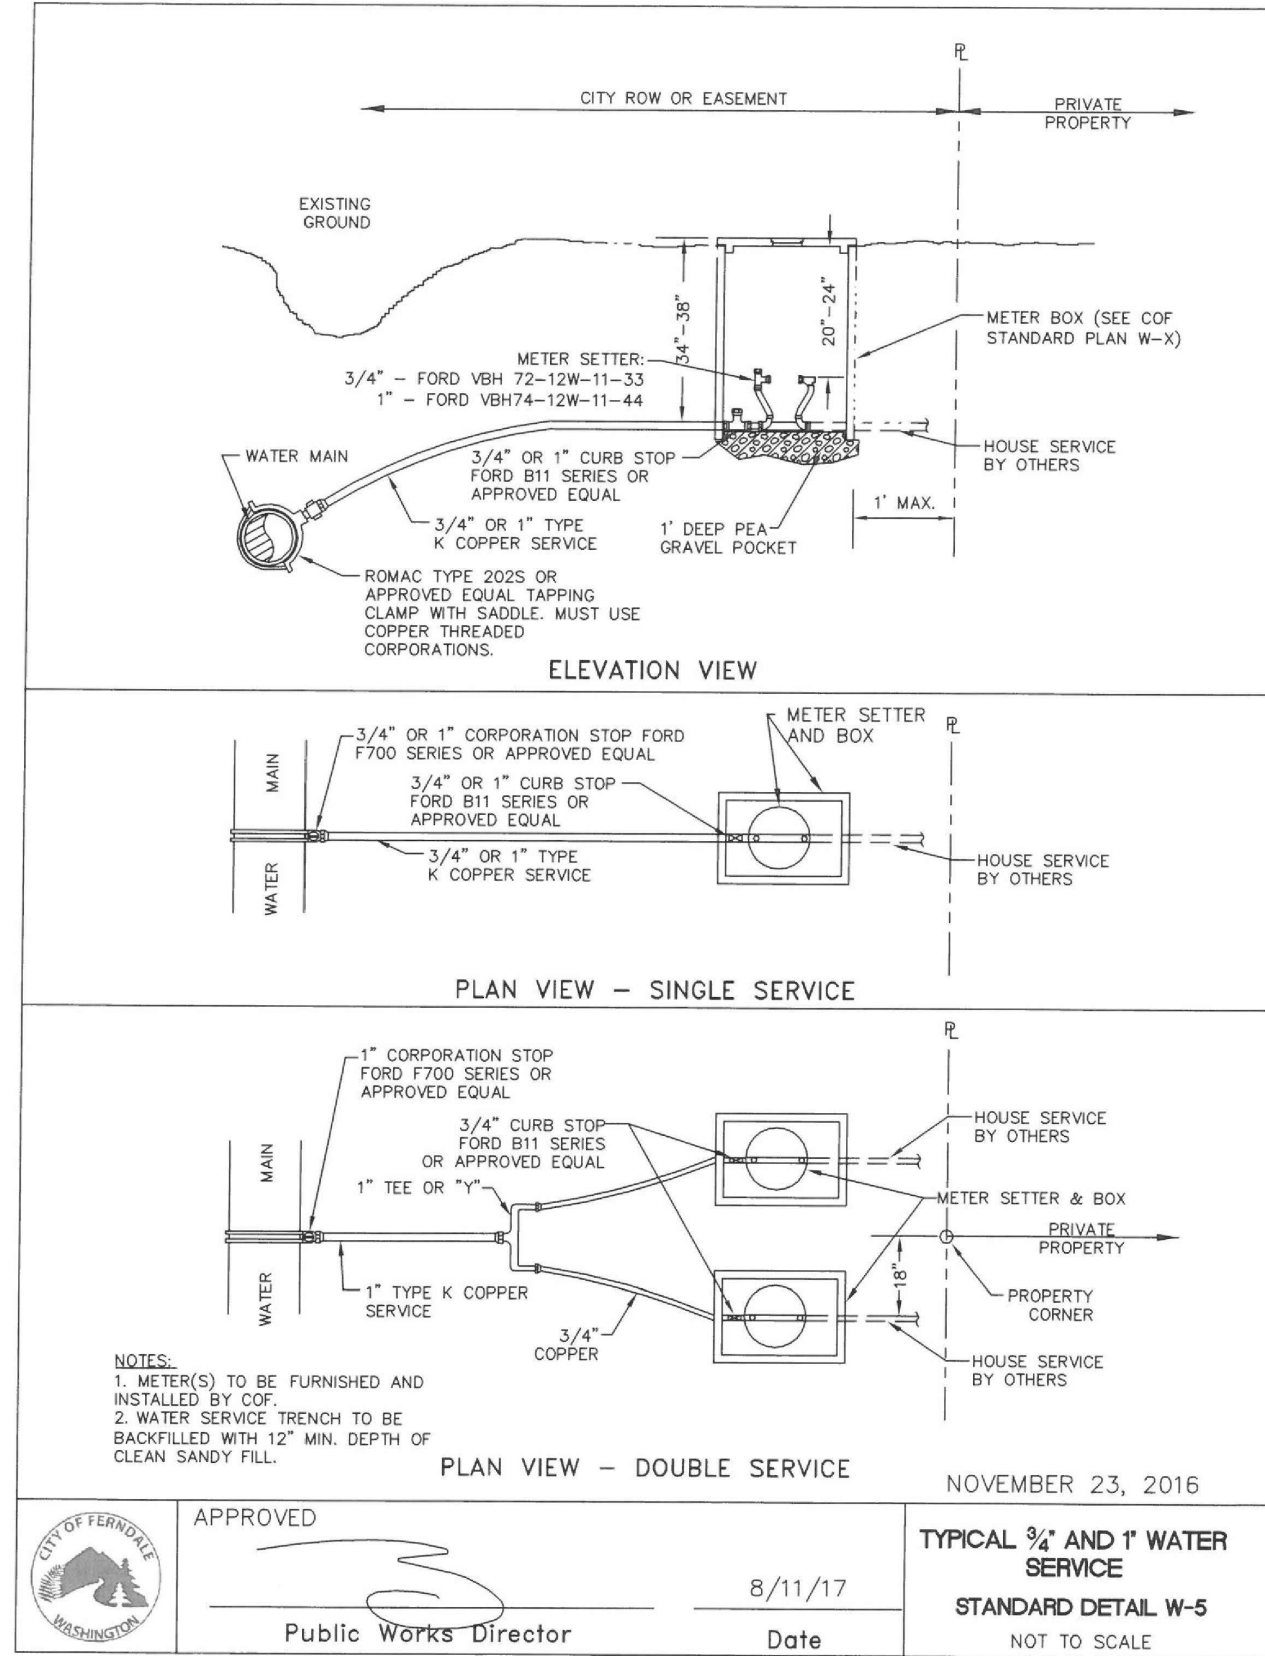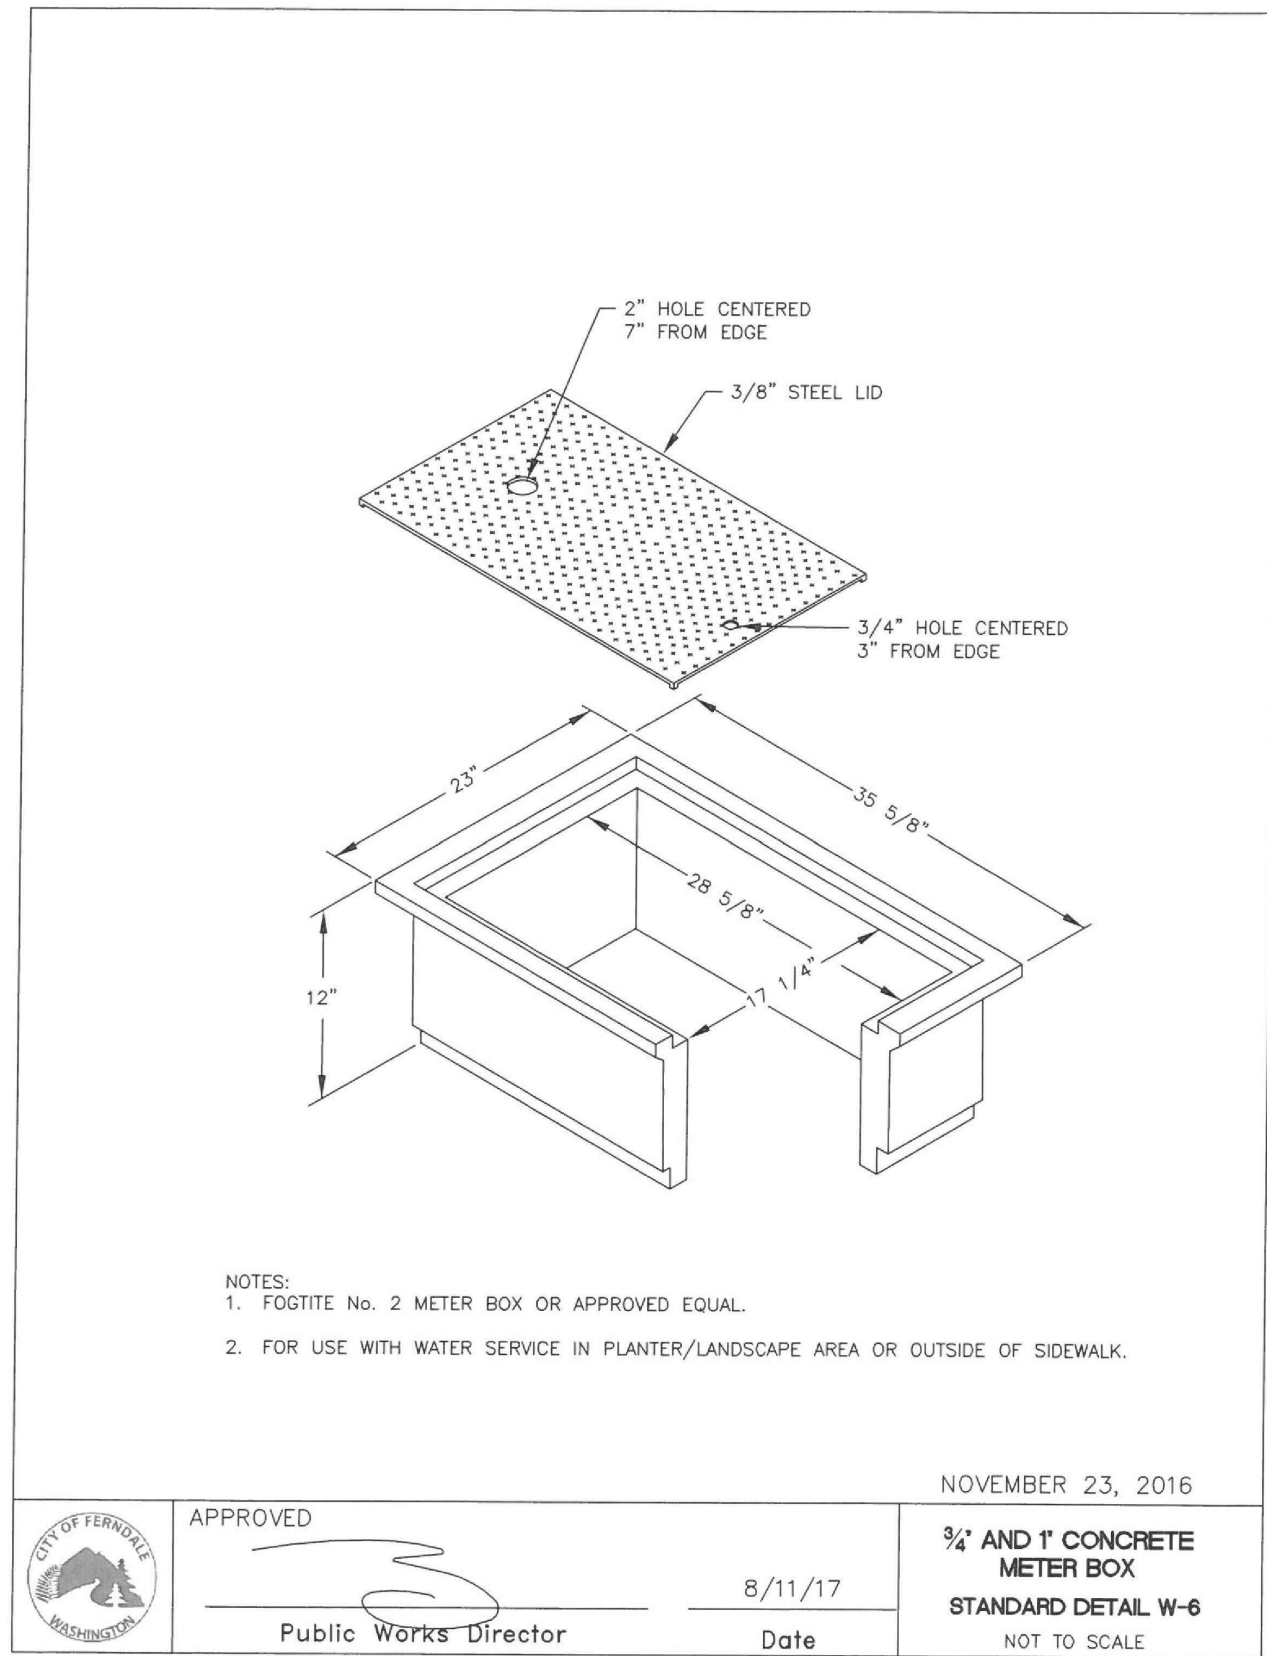

ZURN Model 950XLOS
Double Check Valve Assembly with OS&Y Gate Valves

Application
Designed for installation on fire protection water lines to protect against both backflow and backpressure of polluted water into the potable water supply. Assembly shall provide protection where a potential health hazard does not exist.

Standards Compliance
• UL® Classified

Materials
Main valve body: Cast Bronze ASTM B 584
Access covers: Cast Bronze ASTM B 584
Internals: Stainless Steel, 300 Series
Elastomers: Silicone (FDA approved)
Polymers: Buna Nitrile (FDA approved)
Springs: Noryl™, NSF Listed
Stainless steel, 300 series

Features
Sizes: 3/4, 1, 1 1/2, 2"
Maximum working water pressure: 175 PSI
Maximum working water temperature: 180°F
Hydrostatic test pressure: 350 PSI
End connections Threaded: ANSI B1.20.1

Accessories
☐ Repair kit (rubber only)
☐ Relief valve (P1000A)
☐ QT-SET Quick Test Fitting Set




Dimensions & Weights (do not include pkg.)

MODEL 950XLOS SIZE	DIMENSIONS (approximate)						WEIGHT												
	A	B LESS GATE VALVES	C	D	E OPEN	E CLOSED	F	WITH GATE VALVES lbs. kg.	LESS GATE VALVES lbs. kg.										
3/4	20	11 3/4	299	7	178	11 1/2	38	3	76	7 1/2	191	6 1/4	159	3	76	12	5.5	5	2.3
1	25	12	305	7	178	11 1/2	38	3	76	8	203	6 1/2	165	3	76	13	5.9	8	3.6
1 1/2	40	16 3/8	416	10 9/16	268	2	51	3 1/2	89	9 3/4	248	7 13/16	198	4 1/2	114	31	14.1	16	7.3
2	50	16 3/4	416	10 9/16	268	2	51	3 1/2	89	11 3/16	300	8 15/16	227	4 1/2	114	38	17.3	16	7.3

Zurn Industries, LLC | Wilkins
1747 Commerce Way, Paso Robles, CA U.S.A. 93446 Ph. 855-663-9876, Fax 805-238-5766
In Canada | Zurn Industries Limited
7900 Goreway Drive, Unit 10, Brampton, Ontario L6T 5W6, 877-892-5216
www.zurn.com

Rev. D
Date: 12/19
Document No. BF-950XLOS
Product No. Model 950XLOS

Page 1 of 2

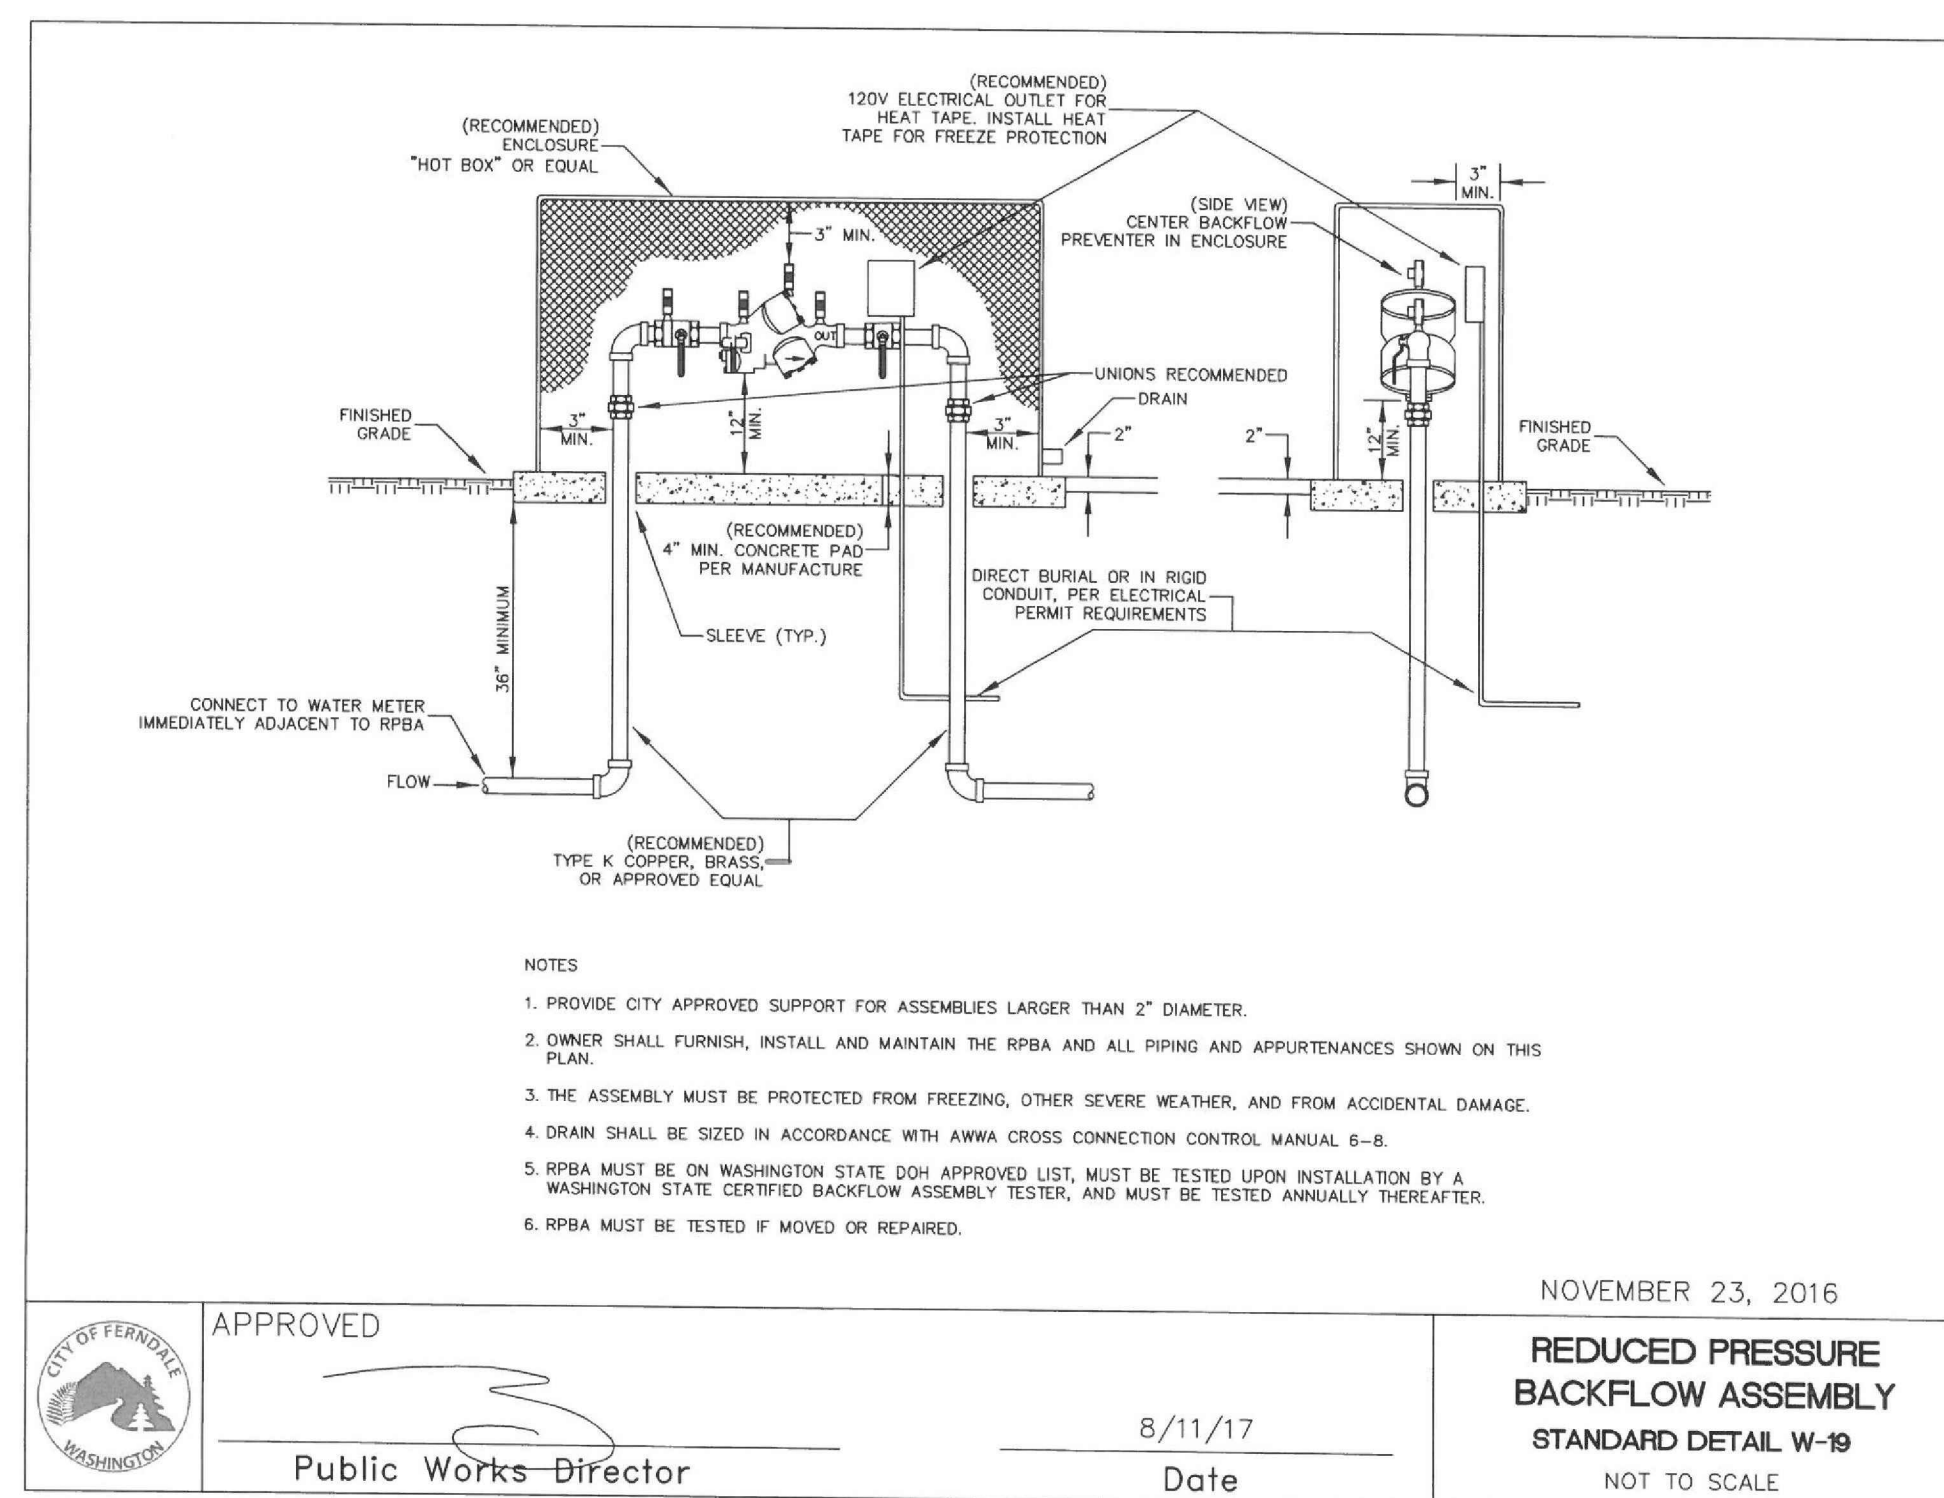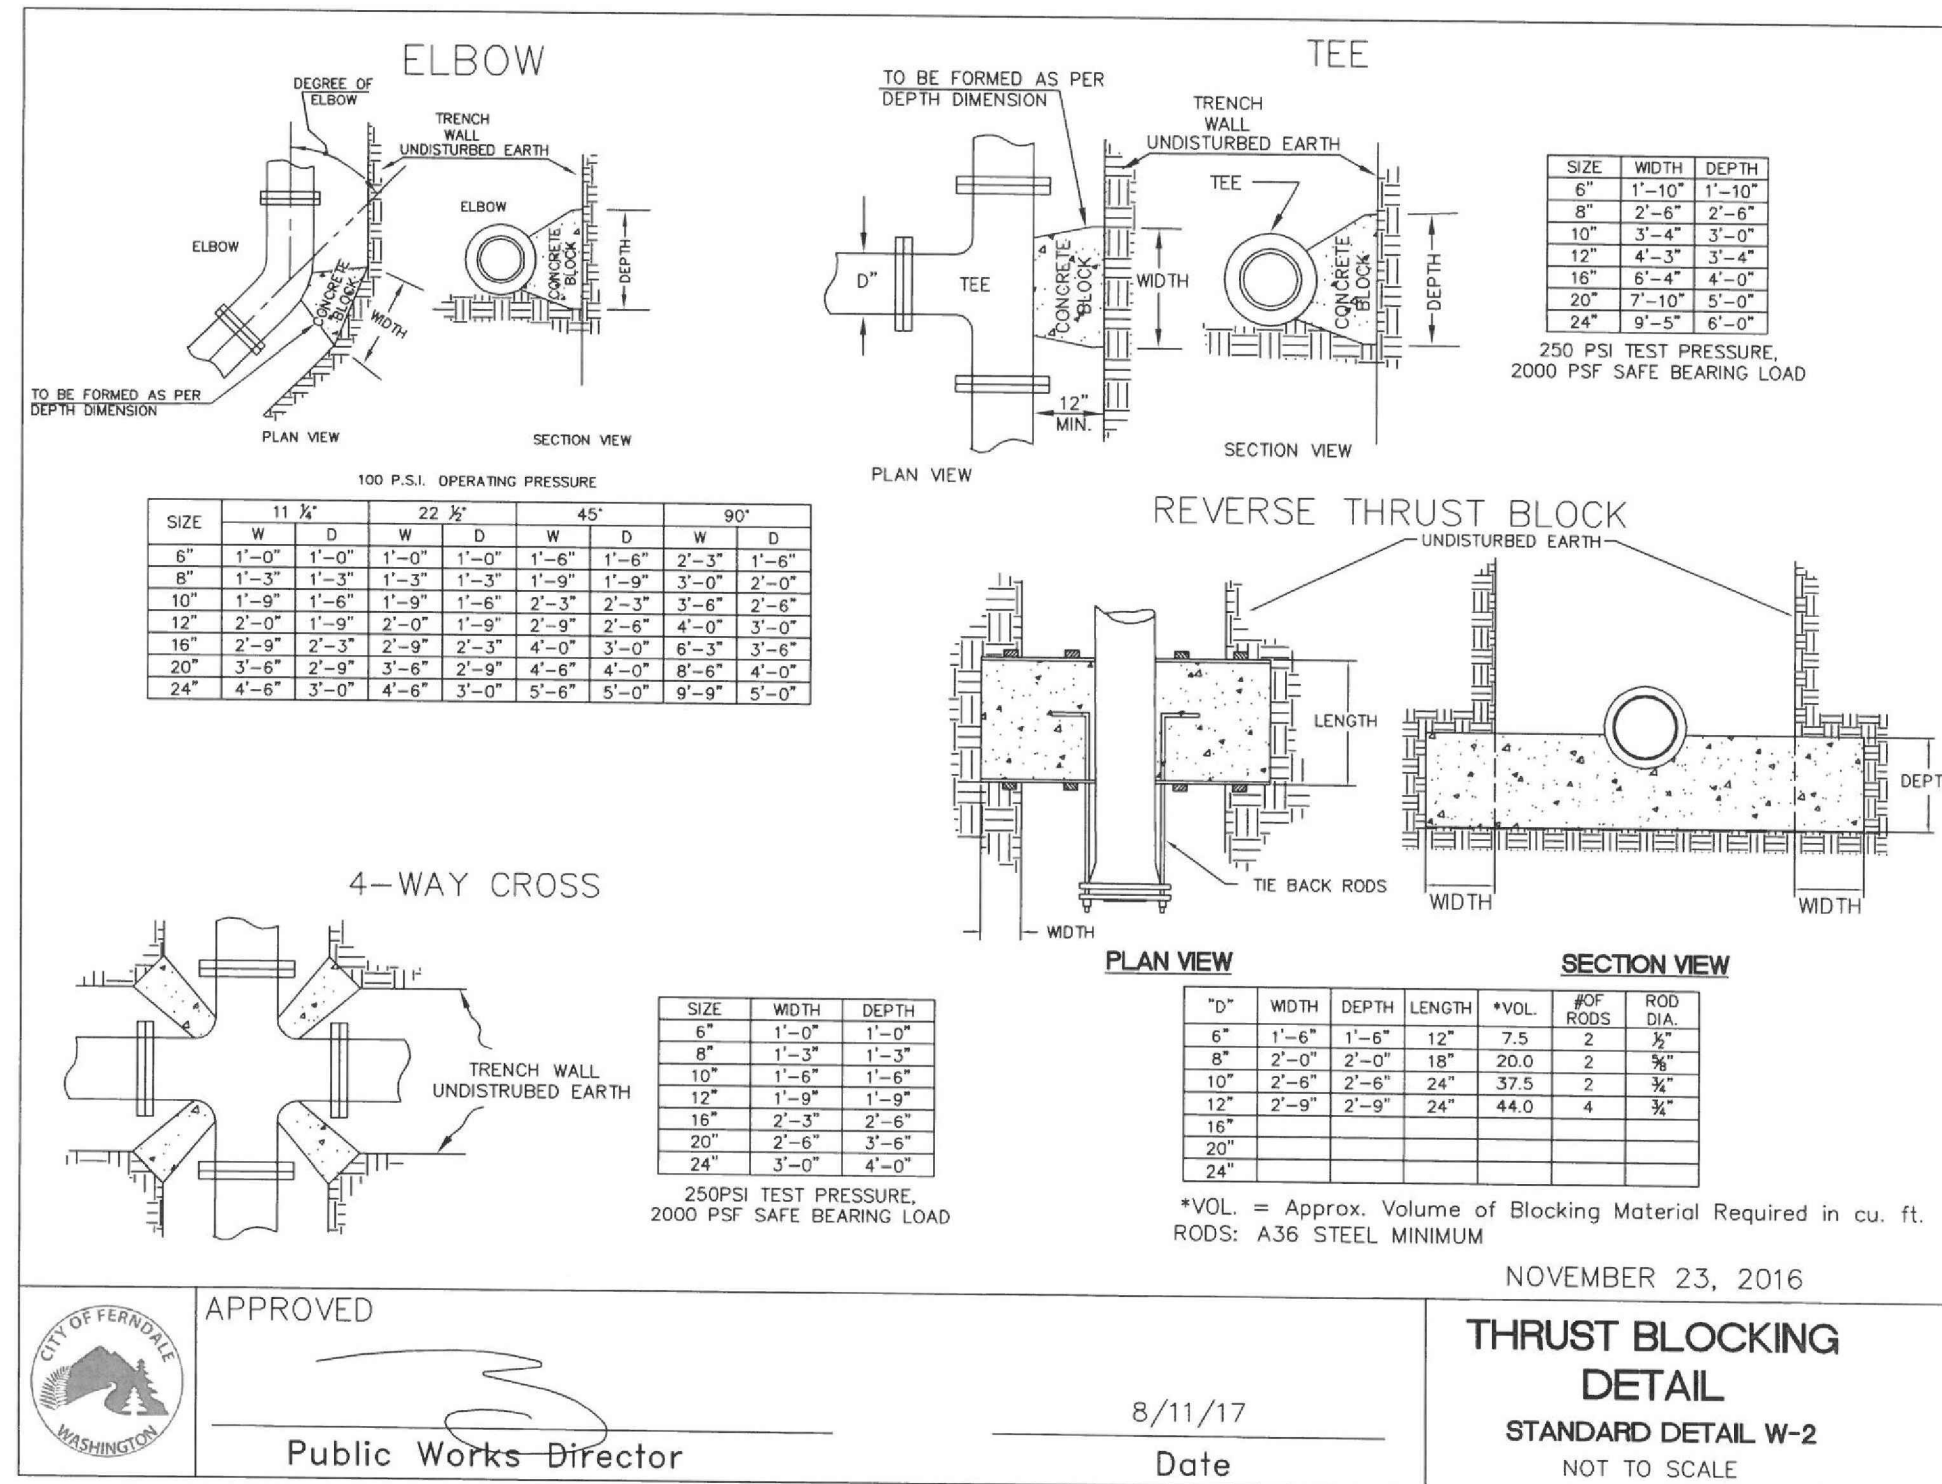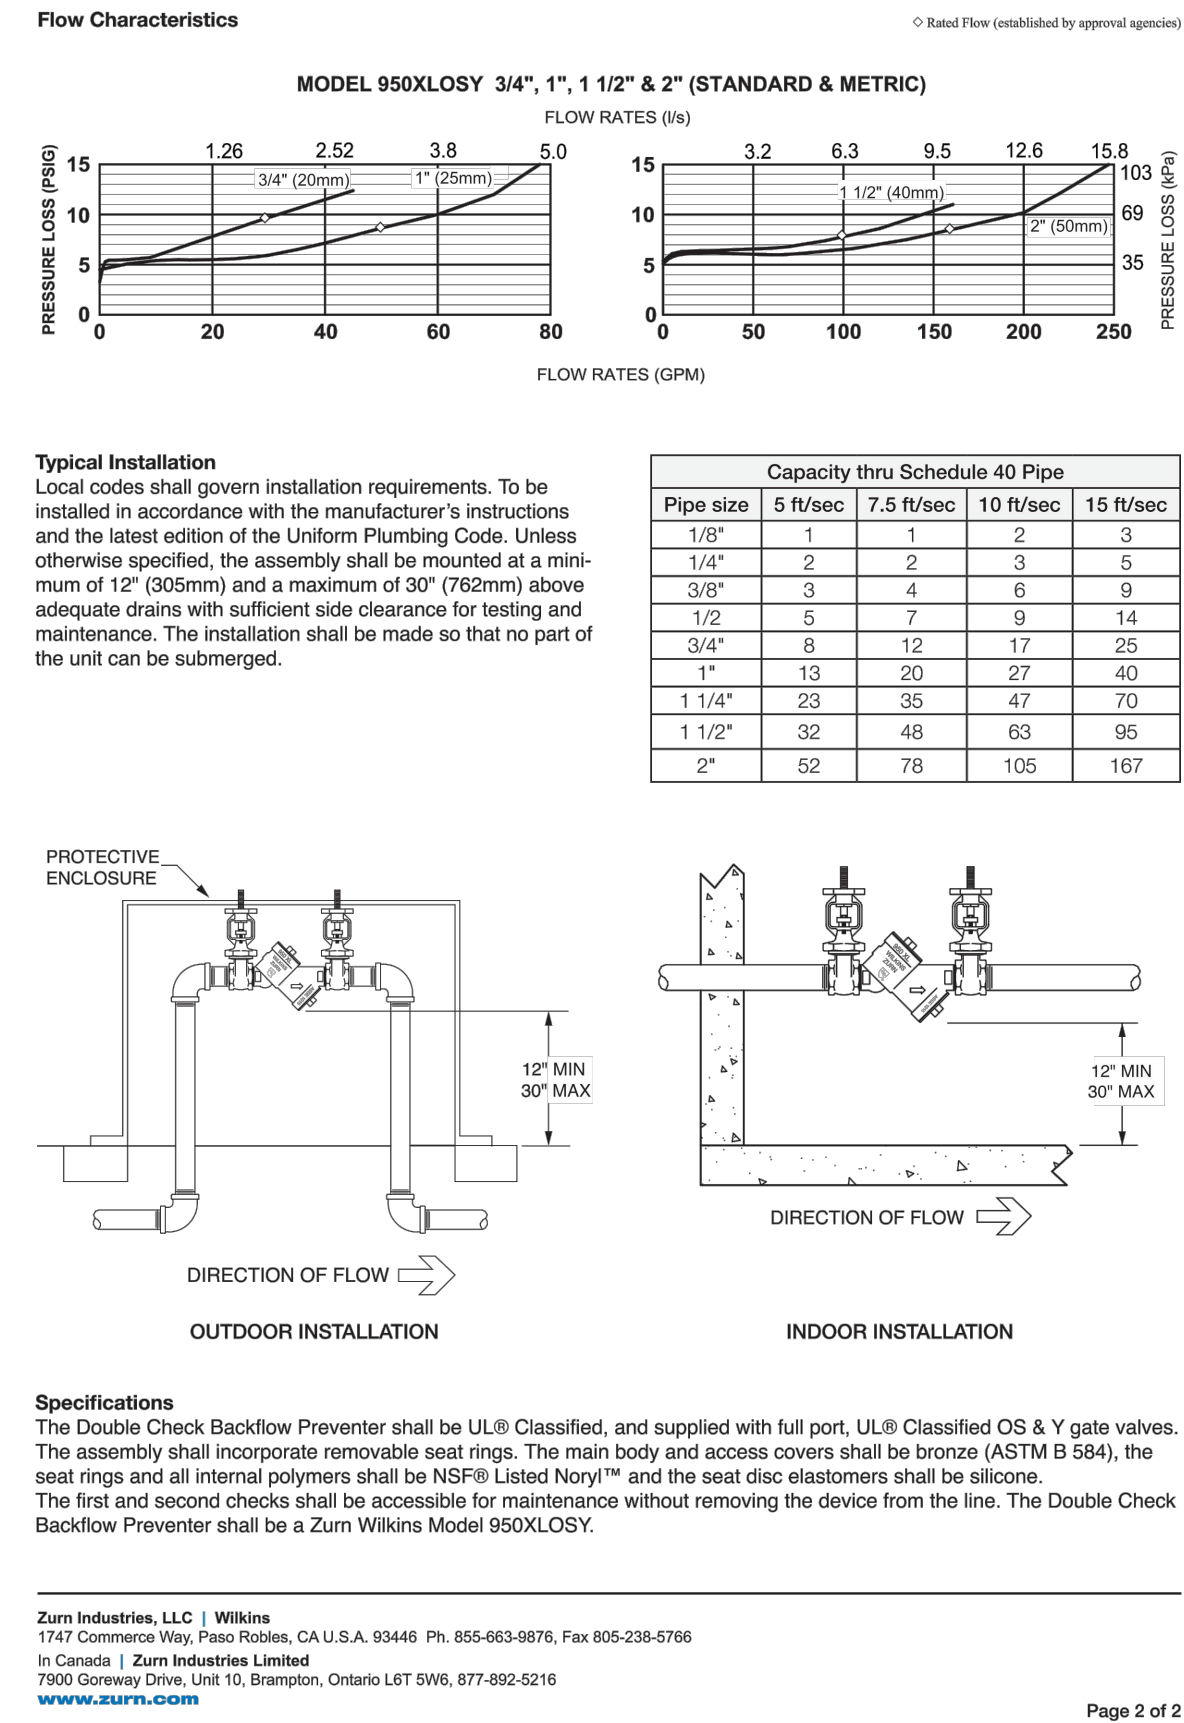

APPROVED
03/19/2025
BY: Public Works Director
CITY OF FERDALE
PUBLIC WORKS DEPARTMENT



CALL BEFORE YOU DIG
Call: TOLL FREE
1-800-424-5555

CITY OF FERDALE, WA
1964 SOMERSET ST DEVELOPMENT
CIVIL CONSTRUCTION PLANS
WATER DETAILS


DATE: 02/24/2025
DESIGN: KVD
DRAWN: MDS
SCALE: AS SHOWN

PROJECT # 22037

SHEET # OF
C9 10
REV #
REC

AXE ENGINEERING SERVICES, LLC
"CUTTING THROUGH PROJECT BARRIERS"
851 COHO WAY #306
BELLINGHAM, WA 98225
360 - 922 - 0549
www.axeengineering.com

ENGINEERING Services
CIVIL - STORMWATER - STRUCTURAL
axeengineering.com

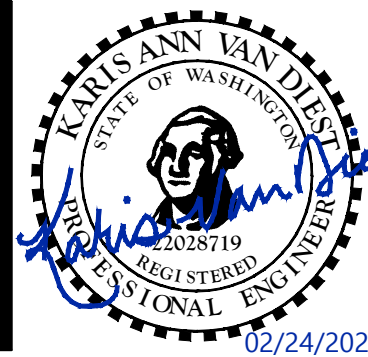

BY

DATE

REVISIONS

00755.009 03/19/25 RH

BEDDING SPECIFICATIONS FOR PVC PIPE

THE FOLLOWING SUPPLEMENTAL SPECIFICATIONS ARE TO BE USED IN CONJUNCTION WITH THE WSDOT STANDARD SPECIFICATIONS FOR ROAD, BRIDGE AND MUNICIPAL CONSTRUCTION, CURRENT EDITION:

BEDDING FOR SEWERS, DRAINS AND CULVERTS FOR PVC PIPE--

BEDDING MATERIAL FOR PVC PIPE SHALL BE PEA GRAVEL CONFORMING TO THE FOLLOWING SPECIFICATIONS:

PEA GRAVEL -- PEA GRAVEL BEDDING SHALL BE A CLEAN MIXTURE FREE FROM ORGANIC MATTER AND CONFORMING TO THE FOLLOWING GRADATION WHEN TESTED IN ACCORDANCE WITH ASTM D422:

U.S. STANDARD SIEVE SIZE	PERCENTAGE PASSING, BY WT.
3/4"	100
3/8"	95-100
#8	0-10
#200	0-5

BACKFILL -- WHENEVER A TRENCH IS EXCAVATED IN THE EXISTING OR PROPOSED ROADWAY, SIDEWALK OR OTHER AREAS WHERE SETTLEMENT WOULD BE DETRIMENTAL, THE ENTIRE TRENCH ABOVE THE PIPE ZONE SHALL BE BACKFILLED WITH BANK RUN GRAVEL BACKFILL TO 95% OF MAXIMUM DENSITY.

NOVEMBER 23, 2016

APPROVED: [Signature] Public Works Director Date: 8/11/17

PVC PIPE ZONE BEDDING
STANDARD DETAIL SS-1
NOT TO SCALE

NOTES

1. PVC PIPE AND FITTINGS SHALL MEET THE REQUIREMENTS OF ASTM 3034, SDR35.

APRIL 18, 2017

APPROVED: [Signature] Public Works Director Date: 8/11/17

PROPOSED SEWER SERVICE PVC CUT-IN TEE
STANDARD DETAIL SS-17
NOT TO SCALE

NOVEMBER 25, 2016

APPROVED: [Signature] Public Works Director Date: 8/11/17

SANITARY SEWER SERVICE CONNECTION 15" OR LESS
STANDARD DETAIL SS-6
NOT TO SCALE

DRAWN BY: BILL BERENS

NOTE

This bollard does not have an effective breakaway design feature and cannot be installed within the Design Clear Zone.

BOLLARD TYPE 2
STANDARD PLAN H-60.20-01
SHEET 1 OF 1 SHEET
APPROVED FOR PUBLICATION
Pasco Bakotich III 07-03-08
STATE DESIGN ENGINEER
Washington State Department of Transportation

APPROVED
03/19/2025

BY: [Signature]
CITY OF FERDALE
PUBLIC WORKS DEPARTMENT

CALL BEFORE YOU DIG

Call: TOLL FREE
1-800-424-5555

CITY OF FERDALE, WA
1964 SOMERSET ST DEVELOPMENT
CIVIL CONSTRUCTION PLANS
SEWER DETAILS

DATE: 02/24/2025
DESIGN: KVD
DRAWN: MDS
SCALE: AS SHOWN

PROJECT # 22037

SHEET # OF
C10 10
REV #
REC

AXE ENGINEERING SERVICES, LLC
"CUTTING THROUGH PROJECT BARRIERS"
851 COHO WAY #306
BELLINGHAM, WA 98225
360 - 922 - 0549
www.axeengineering.com

ENGINEERING
Services
CIVIL - STORMWATER - STRUCTURAL
axeengineering.com

KARLANN VAN DYKE
STATE OF WASHINGTON
REGISTERED PROFESSIONAL ENGINEER
02/24/2025

DATE BY

REVISIONS