

T.39N.R.2E.W.M.

SE 1/4 NW 1/4 Sec. 20

FED. ROAD DIV. NO.	STATE	FED. AID PROJ. NO.	SCALE	SHEET NO.	TOTAL SHEETS
10	WASH.	1-5-56	1" = 100'	1	1

NE 1/4 NW 1/4 Sec. 20

FRONTAGE SERVICE ROAD
Walter Curran
(22569)



SR 5
PRIMARY STATE HIGHWAY NO.
FERNDALE TO BLAINE
WHATCOM COUNTY
WASHINGTON STATE DEPARTMENT OF HIGHWAYS
OLYMPIA, WASHINGTON
E. J. KETTERHAM, Chairman
H. E. MORGAN, Member
O. E. SWAN, Member
SCALE: HORIZ. 1" = 100' FEET
SCALE: VERT. 1" = 10' FEET
APPROVED: March 31, 1955
ASST. DIRECTOR
FOR R. OF W. SHEET 1 OF 18
CONTRACT NUMBER

NOTE: For Right of Way back see P.S.H. 1, Nooksack River to Bellingham, approved Nov. 24, 1953.
For R/W & L/A back see SRS Smith Road to Ferndale, dated 3-8-66


BEGINNING OF PLAN
STATION 10+40

NOTE: Sta. 10+40 to Sta. 6+00
Supersedes Sta. 0+00 to Sta. 10+40 Sheets 1 & 2 of 12 Sheets, P.S.H. 1 Nooksack River to Bellingham, approved Nov. 24, 1953.

AUTHORITY	DATE	SUBSEQUENT APPROVAL	BY
Letter 1-28-60	2-9-60	Block 3 of New Ferndale Addition & ownerships added	OLL
Letter 4-28-60	4-28-60	House location key on Lt. Sta. E 7+01.4	OLL
Revised 10-24-60	10-24-60	Frontage Service Road extended, L/A & R/W revised Sta. 21+30 to Sta. 24+50 on Left	OLL
Letter 3-21-63	4-18-63	Revised Ferndale Corp. Limits; added turnbacks & relinquishments to city & county	RLS
Letter 4-28-65	5-23-65	Revised Ferndale Corp. Limits & relinquishments to city & county	RLS
Letter 8-22-63	9-19-63	Added turnback line & relinquishment to city on Lt. Sta. H15 to 2+85	RLS

EQUATION


Sta. 6+06.8 P.O.T. 5+00.0
Sta. 10+40 P.O.T. 10+40.0

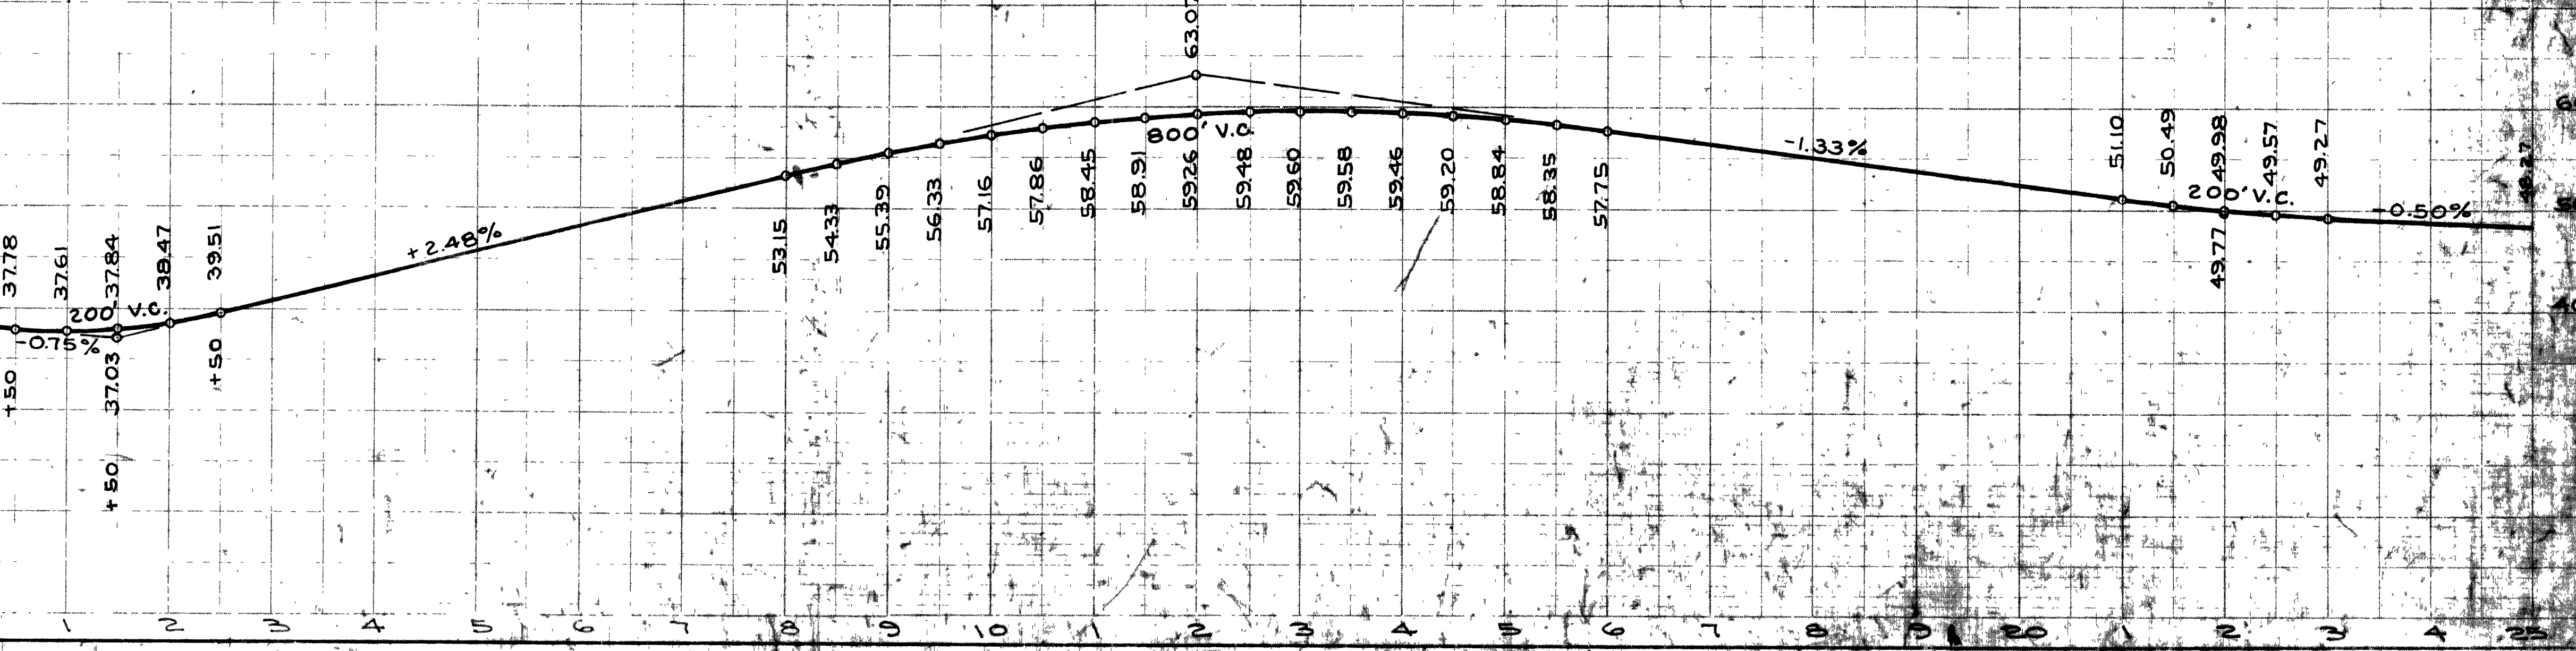


T. 39N. R. 2E. W. M.

FED. ROAD DIV. NO.	STATE	FED. AID PROJ. NO.	FISCAL YEAR	SHEET NO.	TOTAL SHEETS
10	WASH.	I-5-5(1)			

ALIGNMENT CHECKED	BY	DATE
RIGHT OF WAY		
GRADES		
STRUCTURE NOTATIONS		

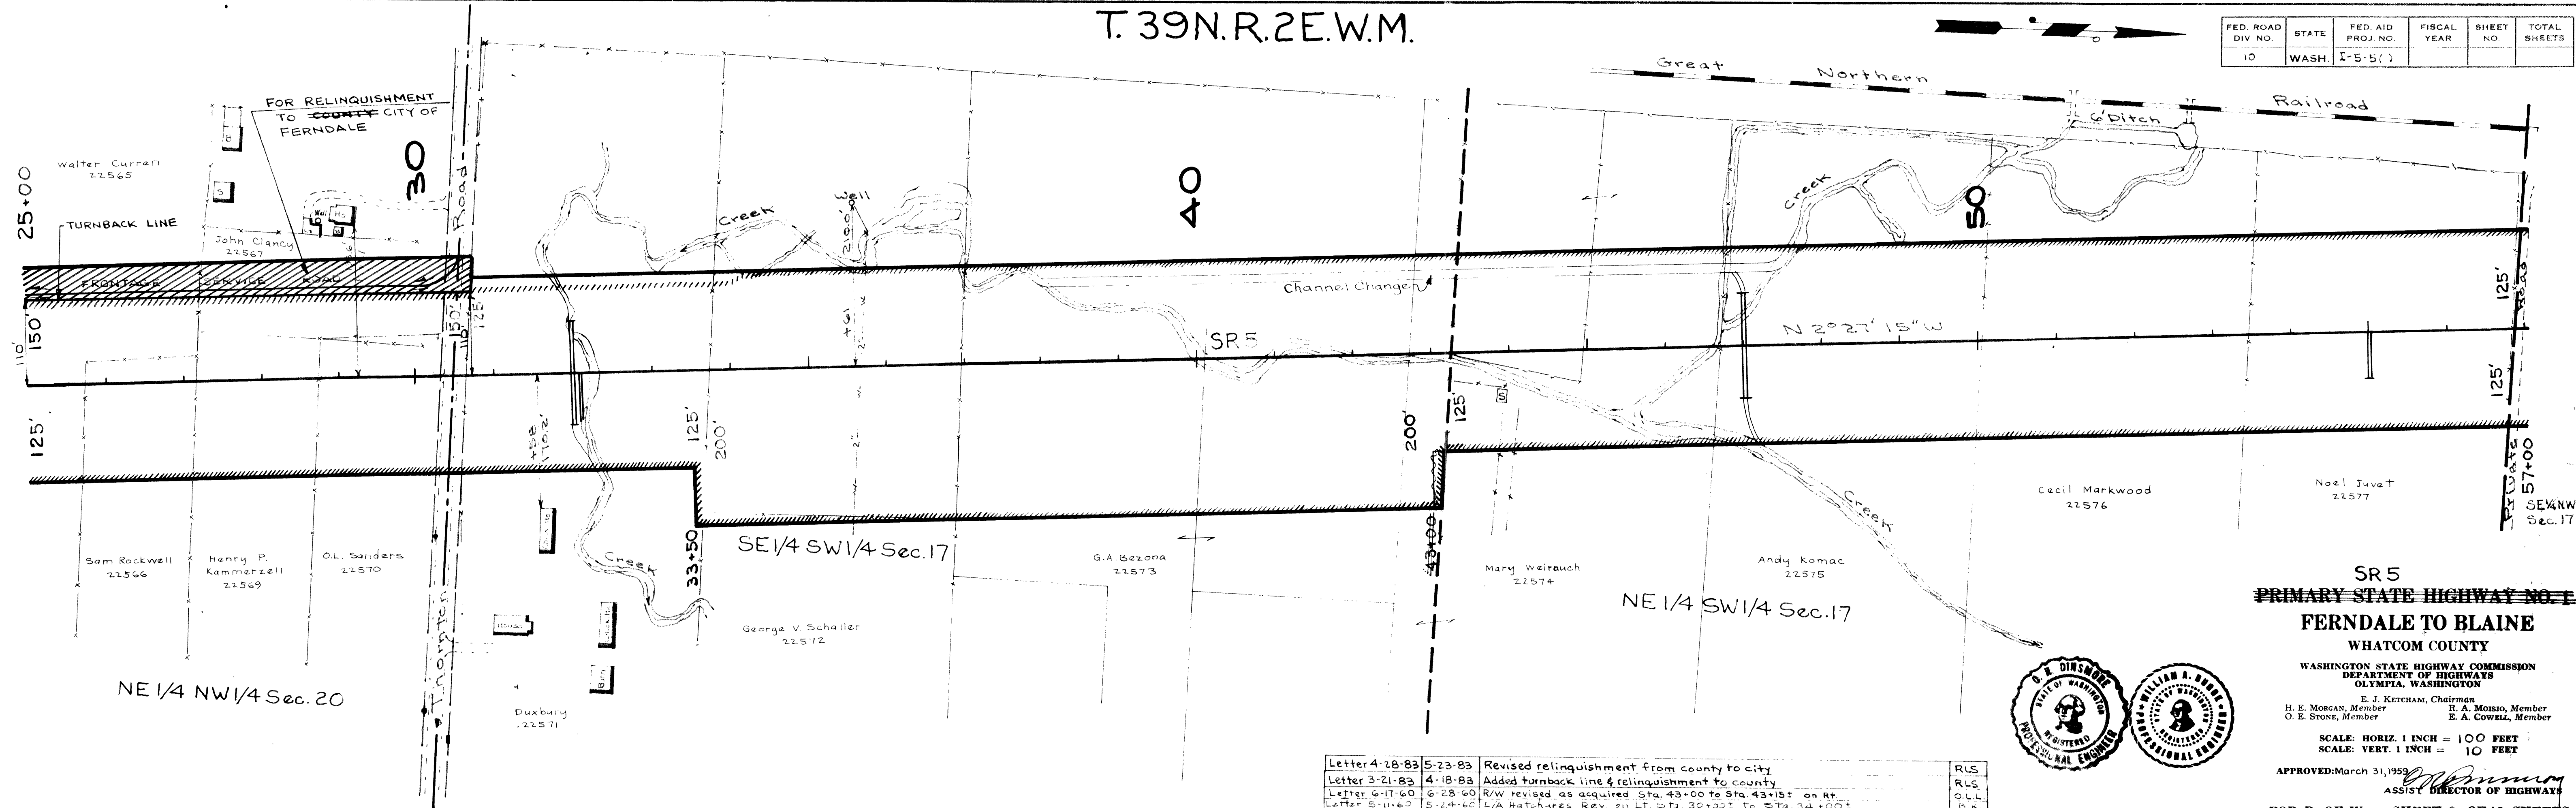

Letter	DATE	DESCRIPTION	BY
Letter 4-28-83	5-23-83	Revised relinquishment from county to city	RLS
Letter 3-21-83	4-18-83	Added turnback line & relinquishment to county	RLS
Letter 6-17-60	6-28-60	R/W revised as acquired Sta. 43+00 to Sta. 43+15 on Rt.	O.L.B.
Letter 5-11-60	5-24-60	L/A Hatches Rev. on LT Sta. 30+00 to Sta. 34+00	O.L.B.
Letter 10-8-59	10-10-59	Ownership Revised	B.K.
Letter 10-8-59	10-10-59	Section line location Revised Sta. 30+50 & Ownerships Added	B.K.
		SUBSEQUENT APPROVAL	

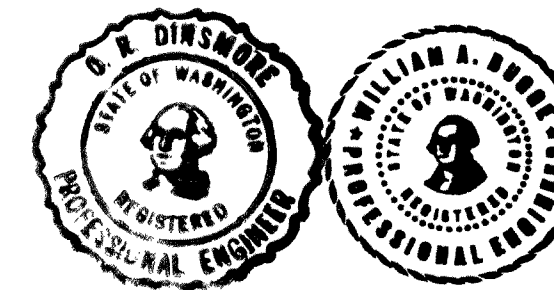

SR 5
PRIMARY STATE HIGHWAY NO. 1
FERNDAL TO BLAINE
WHATCOM COUNTY
WASHINGTON STATE HIGHWAY COMMISSION
DEPARTMENT OF HIGHWAYS
OLYMPIA, WASHINGTON
E. J. KETCHAM, Chairman
H. E. MORGAN, Member
O. E. STONE, Member
R. A. MOISO, Member
E. A. COWELL, Member
SCALE: HORIZ. 1 INCH = 100 FEET
SCALE: VERT. 1 INCH = 10 FEET
APPROVED: March 31, 1959
ASSIST. DIRECTOR OF HIGHWAYS
FOR R. OF W. SHEET 2 OF 18 SHEETS
CONTRACT NUMBER

DRAWN	BY	DATE
F.W.P.		1958
TRACED		1958
LOC. ENGR.		1958
DEPT. ENGR.		1958

