


PORTAL WAY / I-5 ROUNDAABOUT IMPROVEMENTS

FERNDALE, WA

PROJECT No. ST2016-03

VICINITY MAP

PROJECT LOCATED IN SECTION 20, TOWNSHIP 39N, RANGE 2E, W.M.

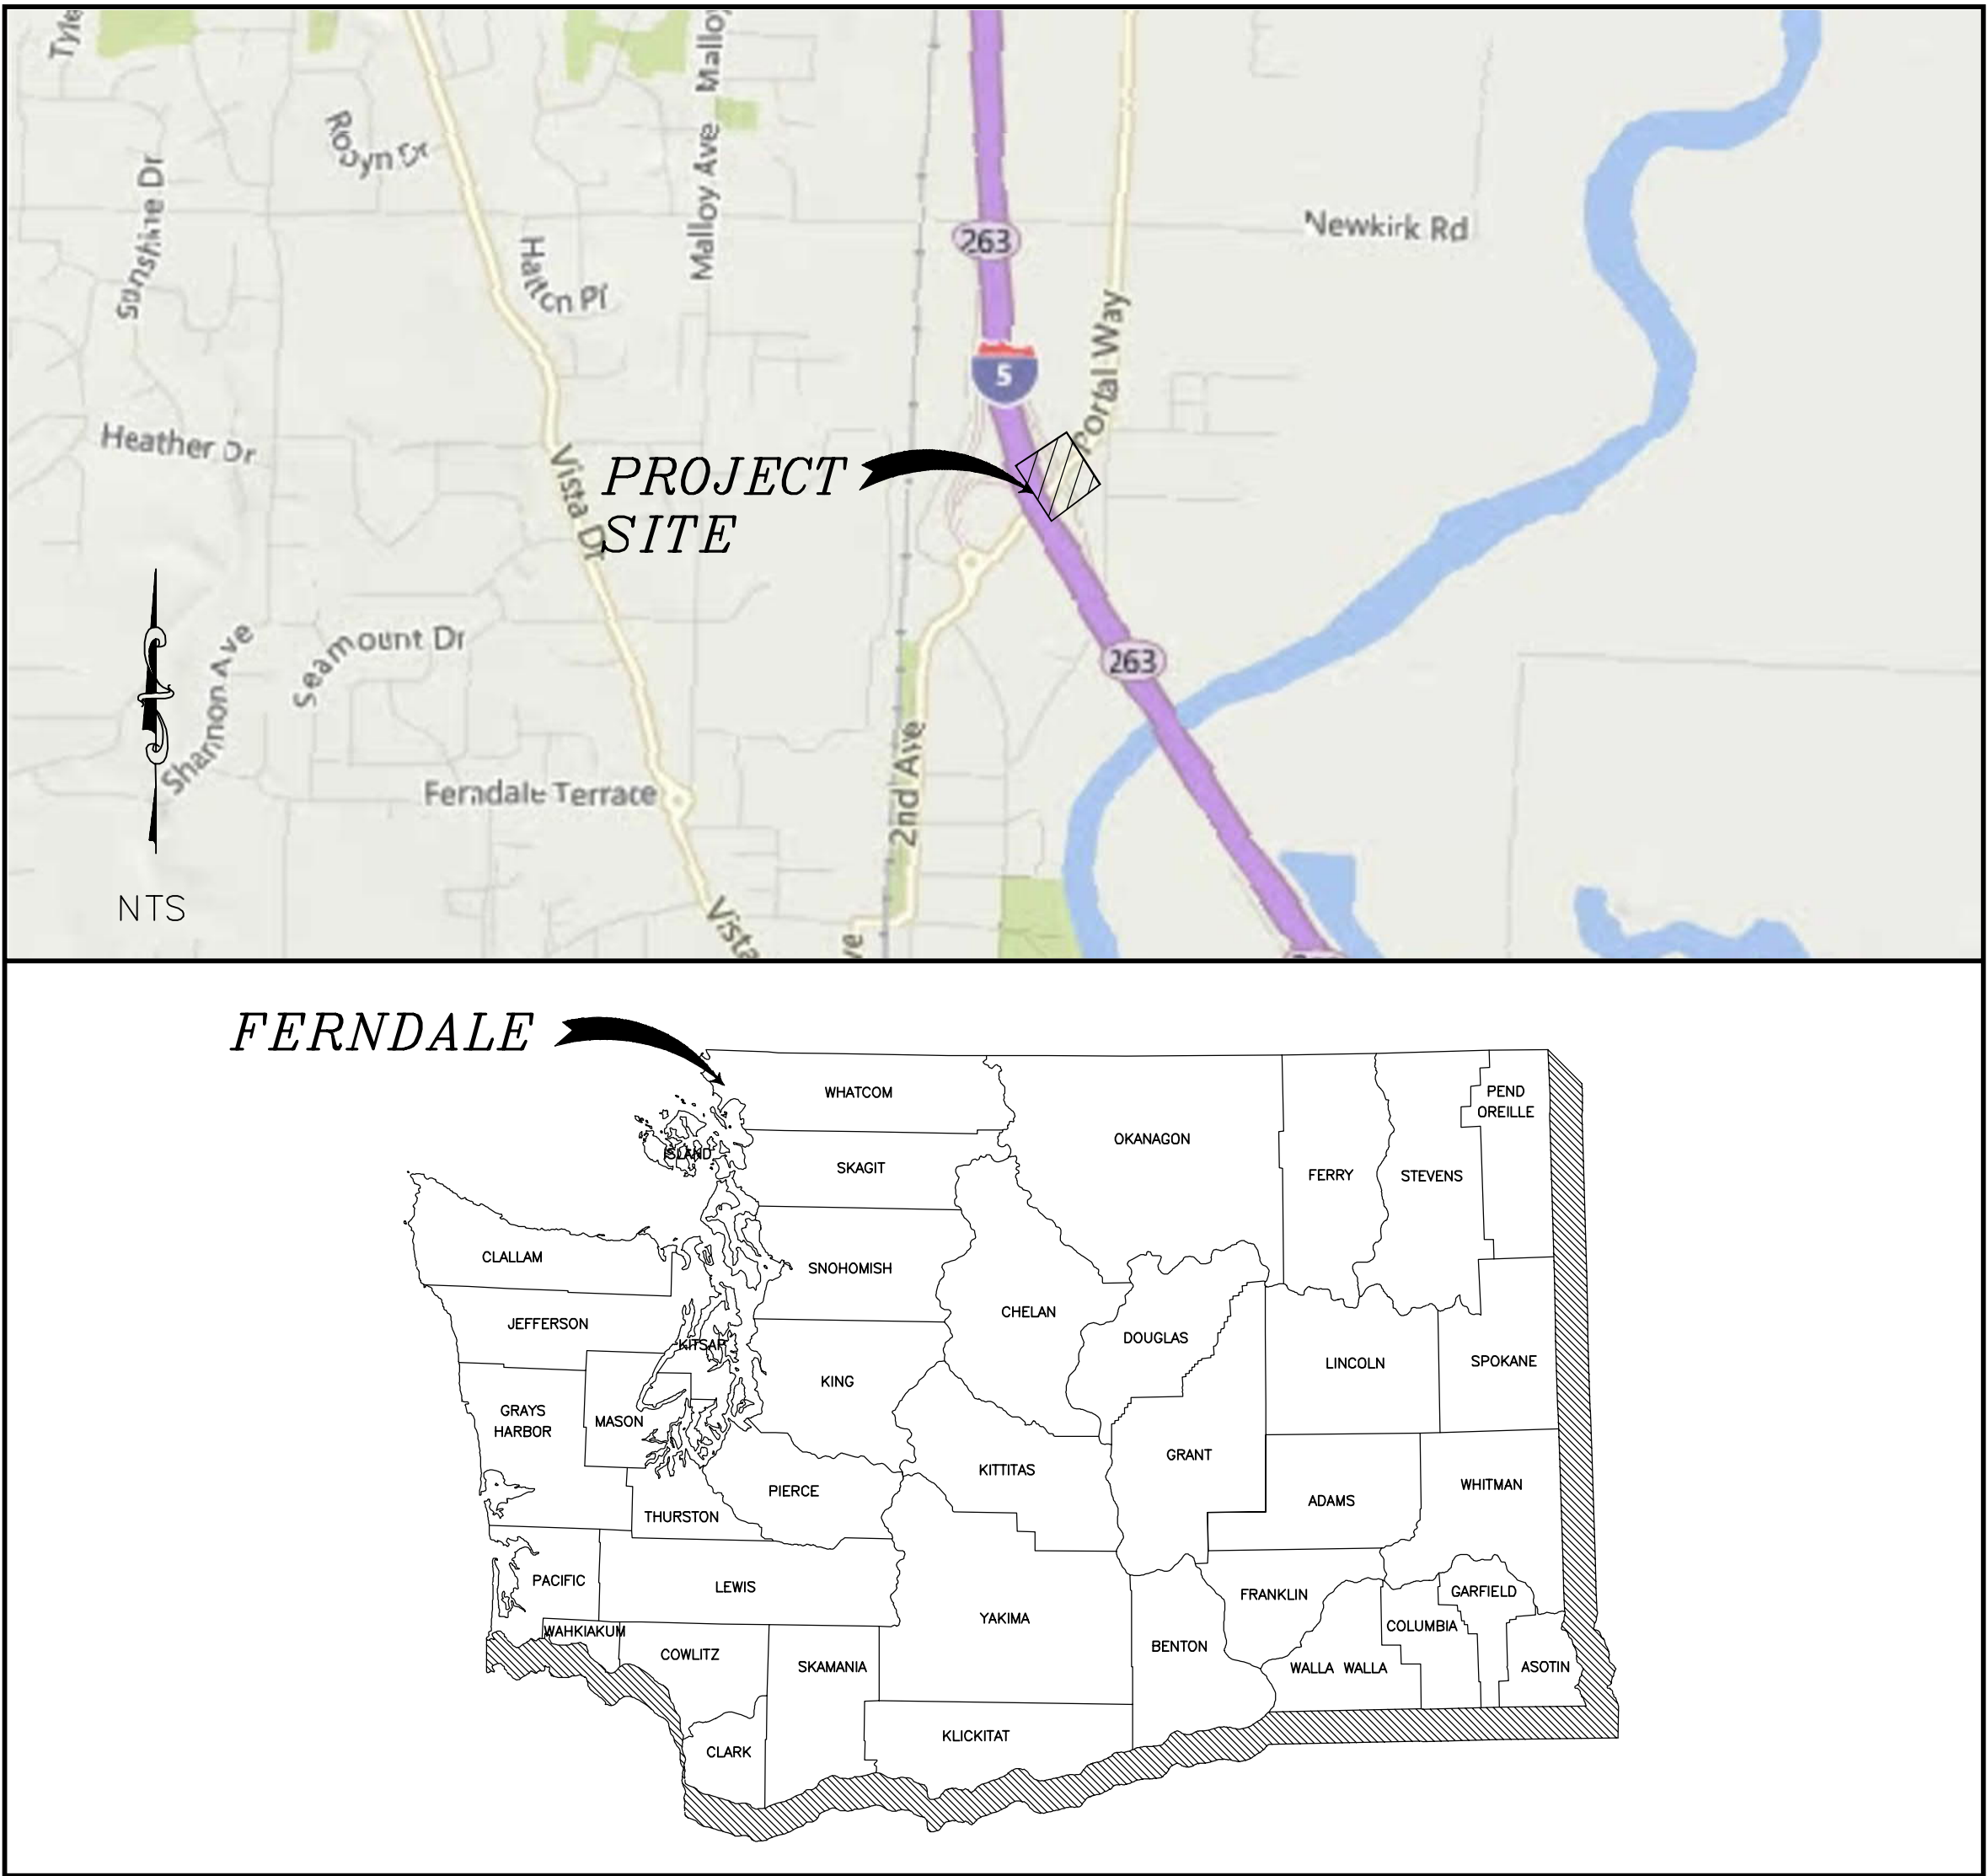

SHEET SERIES INDEX	
SHEET	DESCRIPTION
1	COVER
2	LEGEND AND ABBREVIATIONS
3	WSDOT TYPICAL SHOULDER CLOSURE
4	I-5 EXIT 263 - NB RAMPS - S. SHOULDER CLOSURE
5	I-5 EXIT 263 - NB RAMPS - N. SHOULDER CLOSURE
6	I-5 EXIT 263 - NB RAMPS - ON RAMP CLOSURE
7	I-5 EXIT 263 - NB RAMPS - OFF RAMP CLOSURE
8	I-5 EXIT 263 - NB RAMPS - OFF-RAMP SIGNAGE
9	WSDOT TYPICAL LANE CLOSURE
10	I-5 EXIT 263 - NB RAMPS - LANE CLOSURE SIGNAGE
11	I-5 EXIT 263 - NB RAMPS - NON-WORKING HOURS
12	EXISTING CONDITIONS
13	DEMO AND TESC PLAN - PHASE 1
14	PLAN AND PROFILE - PORTAL WAY - PHASE 1
15	GRADING PLAN - PHASE 1
16	DEMO AND TESC PLAN - PHASE 2
17	PAVING PLAN - PHASE 2
18	TRAFFIC ISLAND CURB DETAIL - PHASE 2
19	RESTORATION PLAN - PHASE 2
20	DETAILS
MK1	PAVEMENT MARKING PLAN
MK2	PAVEMENT MARKING PLAN
SS1	SIGN SPECIFICATIONS
SS2	SIGN SPECIFICATIONS
SN1	SIGNING PLAN
SN2	SIGNING PLAN
IL1	ILLUMINATION PLAN
IT1	ITS RELOCATION PLAN



SUBMITTED WITH
DESIGN PLAN

DESIGNED BY
LP
DRAWN BY
RWG
CHECKED BY
LP

R&E Reichhardt & Ebe
ENGINEERING INC
P.O. Box 978 | 423 Front Street, Lynden, WA 98264 (360) 354-3687
813 Metcalf Street, Sedro-Woolley, WA 98284 (360) 855-1713

NO.	DATE	DESCRIPTION	BY	

CITY OF FERNDALE
2095 MAIN ST
FERNDALE, WA 98248

PORTAL WAY / I-5
ROUNDAABOUT IMPROVEMENTS
COVER

DWG 16033 COVER
JOB# 16033

SCALE
H: N/A V: N/A

DATE
12/17/2018
SHEET
1
of 20


Ø	= DIAMETER	EVCS	= END VERTICAL CURVE STATION	MOD	= MODIFIED	S	= SOUTH
AC	= ASBESTOS CEMENT	EX, EXIST	= EXISTING	MON	= MONUMENT	SH	= SCHEDULE
AD	= ALGEBRAIC DIFFERENCE	IR	= EXISTING IRRIGATION	MPOC	= MID-POINT ON CURVE	SD	= STORM DRAIN
ASPH	= ASPHALT	F&C	= FRAME AND COVER	MTR	= METER	SDCB	= STORM DRAIN CATCH BASIN
BLDG	= BUILDING	F&G	= FRAME AND GRATE	MW	= MONITORING WELL	SDM	= STORM DRAIN MANHOLE
BVCE	= BEGIN VERTICAL CURVE ELEVATION	FF	= FINISHED FLOOR	N	= NORTH	SE	= SOUTHEAST
BVCS	= BEGIN VERTICAL CURVE STATION	FG	= FINISHED GRADE	NE	= NORTHEAST	SN	= EXISTING SIGN
C&G	= CURB & GUTTER	FL	= FLOW LINE	NW	= NORTHWEST	SP	= STANDARD PLAN
CATV	= CABLE TELEVISION	FT	= FEET	OC	= ON CENTER	SSMH	= SANITARY SEWER MANHOLE
CDF	= CONTROLLED DENSITY FILL	FT/FT	= FEET PER FOOT	PWMT	= PAVEMENT	STA	= STATION
℄	= CLASS, CENTERLINE	GALV	= GALVANIZED	PC	= POINT OF CURVATURE	STD	= STANDARD
CMP	= CORRUGATED METAL PIPE	GRVL	= GRAVEL	PCC	= POINT OF COMPOUND CURVATURE, SW	SW	= SOUTHWEST
CMU	= CONCRETE MASONRY UNIT	GV	= GATE VALVE		= PORTLAND CEMENT CONCRETE	TEL	= TELEPHONE
COMP	= COMPLETED	COMP	= HIGH DENSITY POLYETHYLENE	PED	= PEDESTAL	TL	= TRAFFIC LOOP
CON	= CONIFER	HMA	= HOT MIX ASPHALT	POC	= POINT ON CURVE	TP	= TYPICAL
CONC	= CONCRETE	HP	= HIGH POINT	POSS	= POSSIBLE	UTL	= UTILITY POLE
CONT	= CONTOUR	HYD	= HYDRANT	PRC	= POINT OF REVERSE CURVE	UTL	= UTILITY
CPSSP	= CORRUGATED POLYETHYLENE STORM SEWER PIPE	IE, INV	= INVERT ELEVATION	PROP	= PROPOSED	VC	= VERTICAL CURVE
		IW	= INJECTION WELL	PT	= POINT OF TANGENCY	VLT	= VAULT
CULV	= CULVERT	L	= LENGTH	PVC	= POLYVINYL CHLORIDE	VPC	= VERTICAL POINT OF CURVATURE
D/W	= DRIVEWAY	LDCS	= LANDSCAPING	PVI	= POINT OF VERTICAL INTERSECTION	VPI	= VERTICAL POINT OF INTERSECTION
DEC	= DECIDUOUS	LF	= LINEAR FEET	PWR	= LOCATION	VPT	= VERTICAL POINT OF TANGENCY
DI	= DIAPHRAGM	R	= RADIUS	R	= RADIUS	W	= WEST
E	= EAST	LP	= LOW POINT	R&C	= RING AND COVER	WM	= WATER METER
EOP, EP	= EDGE OF PAVEMENT	LT	= LEFT	RET	= RETAINING	WSDOT	= WASHINGTON STATE DEPARTMENT OF TRANSPORTATION
EQUIV	= EQUIVALENT	MAX	= MAXIMUM	ROW	= RIGHT OF WAY		
EVCE	= END VERTICAL CURVE ELEVATION	MIN	= MINIMUM	RT	= RIGHT	XEOA	= EXISTING EDGE OF ASPHALT

1. FIELD WORK PERFORMED BY LARRY STEELE AND ASSOCIATES, INC., BELLINGHAM, WA. TOPOGRAPHIC SURVEY PERFORMED IN JULY, 2016.
2. HORIZONTAL DATUM: BASIS OF BEARING IS NAD 83/11, WASHINGTON STATE PLANE NORTH ZONE, DERIVED FROM CONVENTIONAL SURVEY METHOD TIED TO WSDOT SURVEY CONTROL POINTS GP29020--55 AND W327, VERTICAL DATUM: NAVD 88 HOLDING THE PUBLISHED ELEVATION FROM WSDOT SURVEY CONTROL POINT GP29020--55

EXISTING

— TB ———— TB ————	= EXISTING TOP OF BANK
— BB ———— BB ————	= EXISTING BOTTOM OF BANK
— ———— ————	= EXISTING DITCH ☿
— ———— ————	= EXISTING GRADE BREAK
— 95 ———— 95 ————	= EXISTING MAJOR CONTOUR
— 95 ———— 95 ————	= EXISTING MINOR CONTOUR
— [] ———— [] ————	= EXISTING GUARDRAIL
— X ———— X ————	= EXISTING FENCE
— ———— ————	= EXISTING GRAVEL
— ———— ————	= EXISTING WALL
— ———— ————	= EXISTING BUILDING
— ———— ————	= EXISTING PROPERTY BOUNDARY
— ———— ————	= EXISTING RIGHT OF WAY
— ———— ————	= EXISTING RIGHT OF WAY ☿
— ———— ————	= EXISTING EASEMENT
— ———— ————	= EXISTING ROAD ☿
— ———— ————	= EXISTING WETLANDS BOUNDARY
— ———— ————	= EXISTING TRAFFIC STRIPING
— ———— ————	= EXISTING EDGE OF PAVEMENT
— ———— ————	= EXISTING FLOWLINE
— ———— ————	= EXISTING TOP BACK OF CURB
— ———— ————	= EXISTING SIDEWALK
— UGP ———— UGP ————	= EXISTING POWER BURIED
— OHP ———— OHP ————	= EXISTING OVERHEAD POWER
— UGC ———— UGC ————	= EXISTING COMMUNICATIONS BURIED
— OHC ———— OHC ————	= EXISTING OVERHEAD COMMUNICATIONS
— FO ———— FO ————	= EXISTING FIBER OPTICS BURIED
— TV ———— TV ————	= EXISTING TV BURIED
— T ———— T ————	= EXISTING TELEPHONE BURIED
— C ———— C ————	= EXISTING CONDUIT
— G ———— G ————	= EXISTING GAS MAIN
— W ———— W ————	= EXISTING WATER MAIN
— IRR ———— IRR ————	= EXISTING IRRIGATION LINE
— FM ———— FM ————	= EXISTING SANITARY SEWER FORCE MAIN
— SS ———— SS ————	= EXISTING SANITARY SEWER
— SD ———— SD ————	= EXISTING STORM DRAIN
— OHW ———— OHW ————	= EXISTING ORDINARY HIGH WATER
— ———— ————	= EXISTING CULVERT
— ———— ————	= EXISTING TREE LINE
— ———— ————	= EXISTING CONCRETE
— ———— ————	= EXISTING RR TRACKS
— ———— ————	= EXISTING SIGNAL POLE
— ———— ————	= EXISTING SIGNAL POLE W/ LUMINAIRE
— ———— ————	= EXISTING STREET LIGHT ASSEMBLY
— ———— ————	= EXISTING YARD LIGHT
— ———— ————	= EXISTING GUY WIRE
— ———— ————	= EXISTING GAS METER
— ———— ————	= EXISTING GAS VALVE
— ———— ————	= EXISTING TRANSFORMER PAD
— ———— ————	= EXISTING POWER VAULT
— ———— ————	= EXISTING JBOX
— ———— ————	= EXISTING SOIL BORING LOCATION
— ———— ————	= EXISTING MAIL BOX
— ———— ————	= EXISTING WATER SPIGOT
— ———— ————	= EXISTING WATER BLOW OFF
— ———— ————	= EXISTING WATER METER
— ———— ————	= EXISTING WATER VALVE
— ———— ————	= EXISTING FIRE HYDRANT
— ———— ————	= EXISTING TRAFFIC SIGNAL VAULT
— ———— ————	= EXISTING SEWER MANHOLE
— ———— ————	= EXISTING STORM DRAIN CATCH BASIN TYPE I
— ———— ————	= EXISTING STORM DRAIN CATCH BASIN TYPE II
— ———— ————	= EXISTING UTILITY POLE
— ———— ————	= EXISTING MONITORING WELL
— ———— ————	= EXISTING STORM CLEANOUT
— ———— ————	= EXISTING SEWER CLEANOUT
— ———— ————	= EXISTING SIGN
— ———— ————	= EXISTING TELEPHONE PEDESTAL
— ———— ————	= EXISTING COMMUNICATIONS VAULT
— ———— ————	= EXISTING BENCH MARK
— ———— ————	= EXISTING NAIL AND SHINER
— ———— ————	= EXISTING IRON PIPE
— ———— ————	= EXISTING MONUMENT (IN CASE)
— ———— ————	= EXISTING MONUMENT (SURFACE)
— ———— ————	= EXISTING ANGLE POINT
— ———— ————	= EXISTING TREE STUMP
— ———— ————	= EXISTING TREE
— ———— ————	= EXISTING VEGETATION

— TB ——— TB ———	= PROPOSED TOP OF BANK
— BB ——— BB ———	= PROPOSED TOE OF BANK
_____	= PROPOSED DITCH ☿
_____	= PROPOSED GRADE BREAK
95 _____	= PROPOSED MAJOR CONTOUR
95 _____	= PROPOSED MINOR CONTOUR
□ □ □	= PROPOSED GUARDRAIL
— X — X — X —	= PROPOSED FENCE
_____	= PROPOSED GRAVEL
_____	= PROPOSED WALL
//// //// ////	= PROPOSED BUILDING
_____	= PROPOSED PAVEMENT VALLEY
=====	= PROPOSED RIGHT OF WAY
_____	= PROPOSED AUTOTURN
_____	= PROPOSED CONSTRUCTION EASEMENT
_____	= PROPOSED ROAD ☿
_____	= PROPOSED SAWCUT
_____	= PROPOSED TRAFFIC STRIPE
_____	= PROPOSED ROAD EDGE OF PAVEMENT
_____	= PROPOSED CURB AND GUTTER
_____	= PROPOSED PATH
_____	= PROPOSED SIDEWALK
— PR ———	= PROPOSED POWER LINE
◇ ◇ ◇ ◇ ◇ ◇ ◇ ◇	= PROPOSED ROCK WALL
_____	= PROPOSED PARKING STRIPE
— TS ———	= PROPOSED TRAFFIC SIGNAL CONDUCTOR
— FO ———	= PROPOSED FIBER OPTICS
— X — X — X —	= PROPOSED SILT FENCE
— C ———	= PROPOSED CONDUIT
_____	= PROPOSED HANDRAIL
_____	= PROPOSED IRRIGATION LINE
— W ———	= PROPOSED WATER MAIN
— FM ———	= PROPOSED SANITARY SEWER FORCE MAIN
— SS ———	= PROPOSED SANITARY SEWER
— SD ———	= PROPOSED STORM DRAIN
— X ——— X —	= PROPOSED CULVERT
~~~~~	= PROPOSED TREE LINE
_____	= PROPOSED CONC. SIDEWALK/DRIVEWAY
_____	= PROPOSED INFILTRATION TRENCH
_____	= PROPOSED INFILTRATION FILTER MEDIA
_____	= PROPOSED GRIND
_____	= PROPOSED DEMOLITION AREA
_____	= PROPOSED ASPHALT
_____	= PROPOSED RIGHT OF WAY TAKE
■	= PROPOSED STORM DRAIN INLET
⊕	= PROPOSED COUPLER
⊗	= PROPOSED WATER METER
⊕	= PROPOSED WATER VALVE
⊗	= PROPOSED STORM DRAIN CATCH BASIN TYPE
⊕	= PROPOSED SANITARY SEWER MANHOLE
⊗	= PROPOSED STORM DRAIN CATCH BASIN TYPE
⊕	= PROPOSED HYDRANT
⊗	= PROPOSED UTILITY POLE
⊕	= PROPOSED J.BOX (TYPE I, II, III)
⊗	= PROPOSED MONITORING WELL
⊕	= PROP STORM CLEANOUT
⊗	= PROPOSED SANITARY SEWER CLEAN OUT
⊕	= PROPOSED SIGN
→	= FLOW ARROW
⊕	= PROPOSED TREE

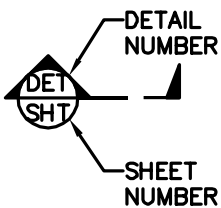

DESIGNED BY	LP
DRAWN BY	RWG
CHECKED BY	LP

P.O. Box 978 | 423 Front Street, Lynden, WA 98264 (360) 354-3687  
813 Metcalf Street, Sedro-Woolley, WA 98284 (360) 855-1713

NO.	DATE	DESCRIPTION	BY

## PORTAL WAY / I-5 ROUNDBABOUT IMPROVEMENTS LEGEND AND ABBREVIATIONS

JOB#  
**16033**

SCALE

H: **N/A**      V: **N/A**

SHEET **2**  
of 20


SIGN SPACING = X (1)		
RURAL ROADS & URBAN ARTERIALS	35 / 40 MPH	350' ±
RURAL ROADS, URBAN ARTERIALS, RESIDENTIAL & BUSINESS DISTRICTS	25 / 30 MPH	200' ± (2)
URBAN STREETS	25 MPH OR LESS	100' ± (2)
(1) ALL SPACING MAY BE ADJUSTED TO ACCOMMODATE INTERSECTIONS AND DRIVEWAYS. (2) THIS SPACING MAY BE REDUCED IN URBAN AREAS TO FIT ROADWAY CONDITIONS.		

MINIMUM SHOULDER TAPER LENGTH = L/3 (feet)										
SHOULDER WIDTH (feet)	Posted Speed (mph)									
	25	30	35	40	45	50	55	60	65	70
8'	40	40	60	90	-	-	-	-	-	-
10'	40	60	90	90	-	-	-	-	-	-
USE A 3 DEVICES TAPER FOR SHOULDERS LESS THEN 8'										

CHANNELIZATION DEVICE SPACING (feet)		
MPH	TAPER	TANGENT
35/40	30	60
25/30	20	40

BUFFER DATA										
LONGITUDINAL BUFFER SPACE = B										
SPEED (MPH)	25	30	35	40	45	50	55	60	65	70
LENGTH (feet)	155	200	250	305	360	425	495	570	645	730
TRANSPORTABLE ATTENUATOR ROLL AHEAD DISTANCE = R										
HOST VEHICLE WEIGHT 9,900 TO 22,000 lbs.					HOST VEHICLE WEIGHT > 22,000 lbs.					
< 45 MPH	45-55 MPH	> 55 MPH		< 45 MPH	45-55 MPH	> 55 MPH				
100'	123'	172'		74'	100'	150'				
PROTECTIVE VEHICLE (WORK VEHICLE) = R										
NO SPECIFIED DISTANCE REQUIRED										

NOT TO SCALE

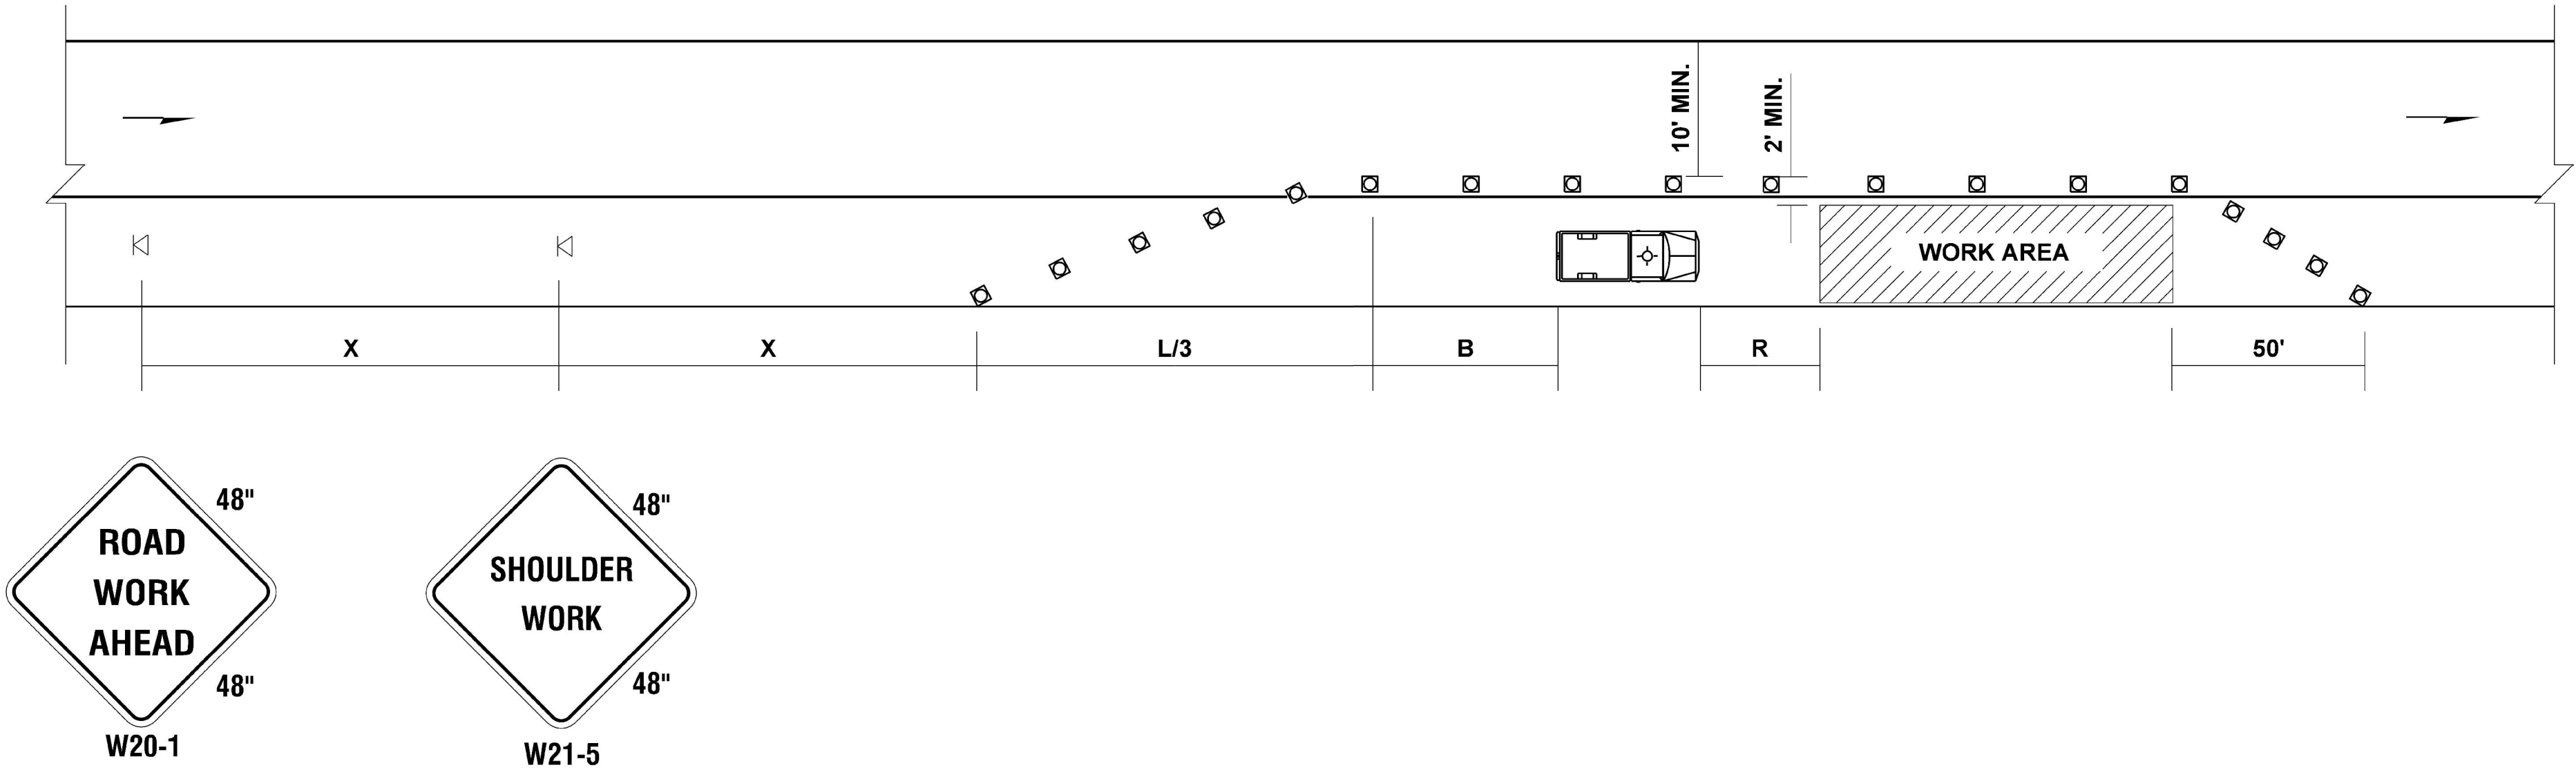

LEGEND

✕

SIGN LOCATION

▣

CHANNELIZING DEVICES — TRAFFIC SAFETY DRUMS.  
TYPE C STEADY BURN WARNING LIGHTS REQUIRED  
DURING HOURS OF DARKNESS.

PROTECTIVE VEHICLE

PHASE 1  
SHOULDER WIDENING  
SHOULDER CLOSURE - LOW SPEED  
(40 MPH OR LESS)

NOT TO SCALE

- NOTES:
- 1. DEVICE SPACING FOR THE DOWNSTREAM TAPER SHALL BE 20' (FT).
  - 2. ALL SIGNS ARE BLACK ON ORANGE.



SUBMITTED WITH  
DESIGN PLAN

DESIGNED BY

DRAWN BY  
RWG

CHECKED BY  
LP

**Reichhardt & Ebe**  
ENGINEERING INC  
P.O. Box 978 | 423 Front Street, Lynden, WA 98264 (360) 354-3687  
813 Metcalf Street, Sedro-Woolley, WA 98284 (360) 855-1713


NO.	DATE	DESCRIPTION	BY

CITY OF FERNDALE  
2095 MAIN ST  
FERNDALE, WA 98248

PORTAL WAY / I-5  
ROUNDAABOUT IMPROVEMENTS  
WSDOT TYPICAL SHOULDER CLOSURE

DWG 16033 TC PLAN		DATE	12/17/2018
JOB#	SCALE	SHEET	3
16033	H: N/A V: N/A		of 20



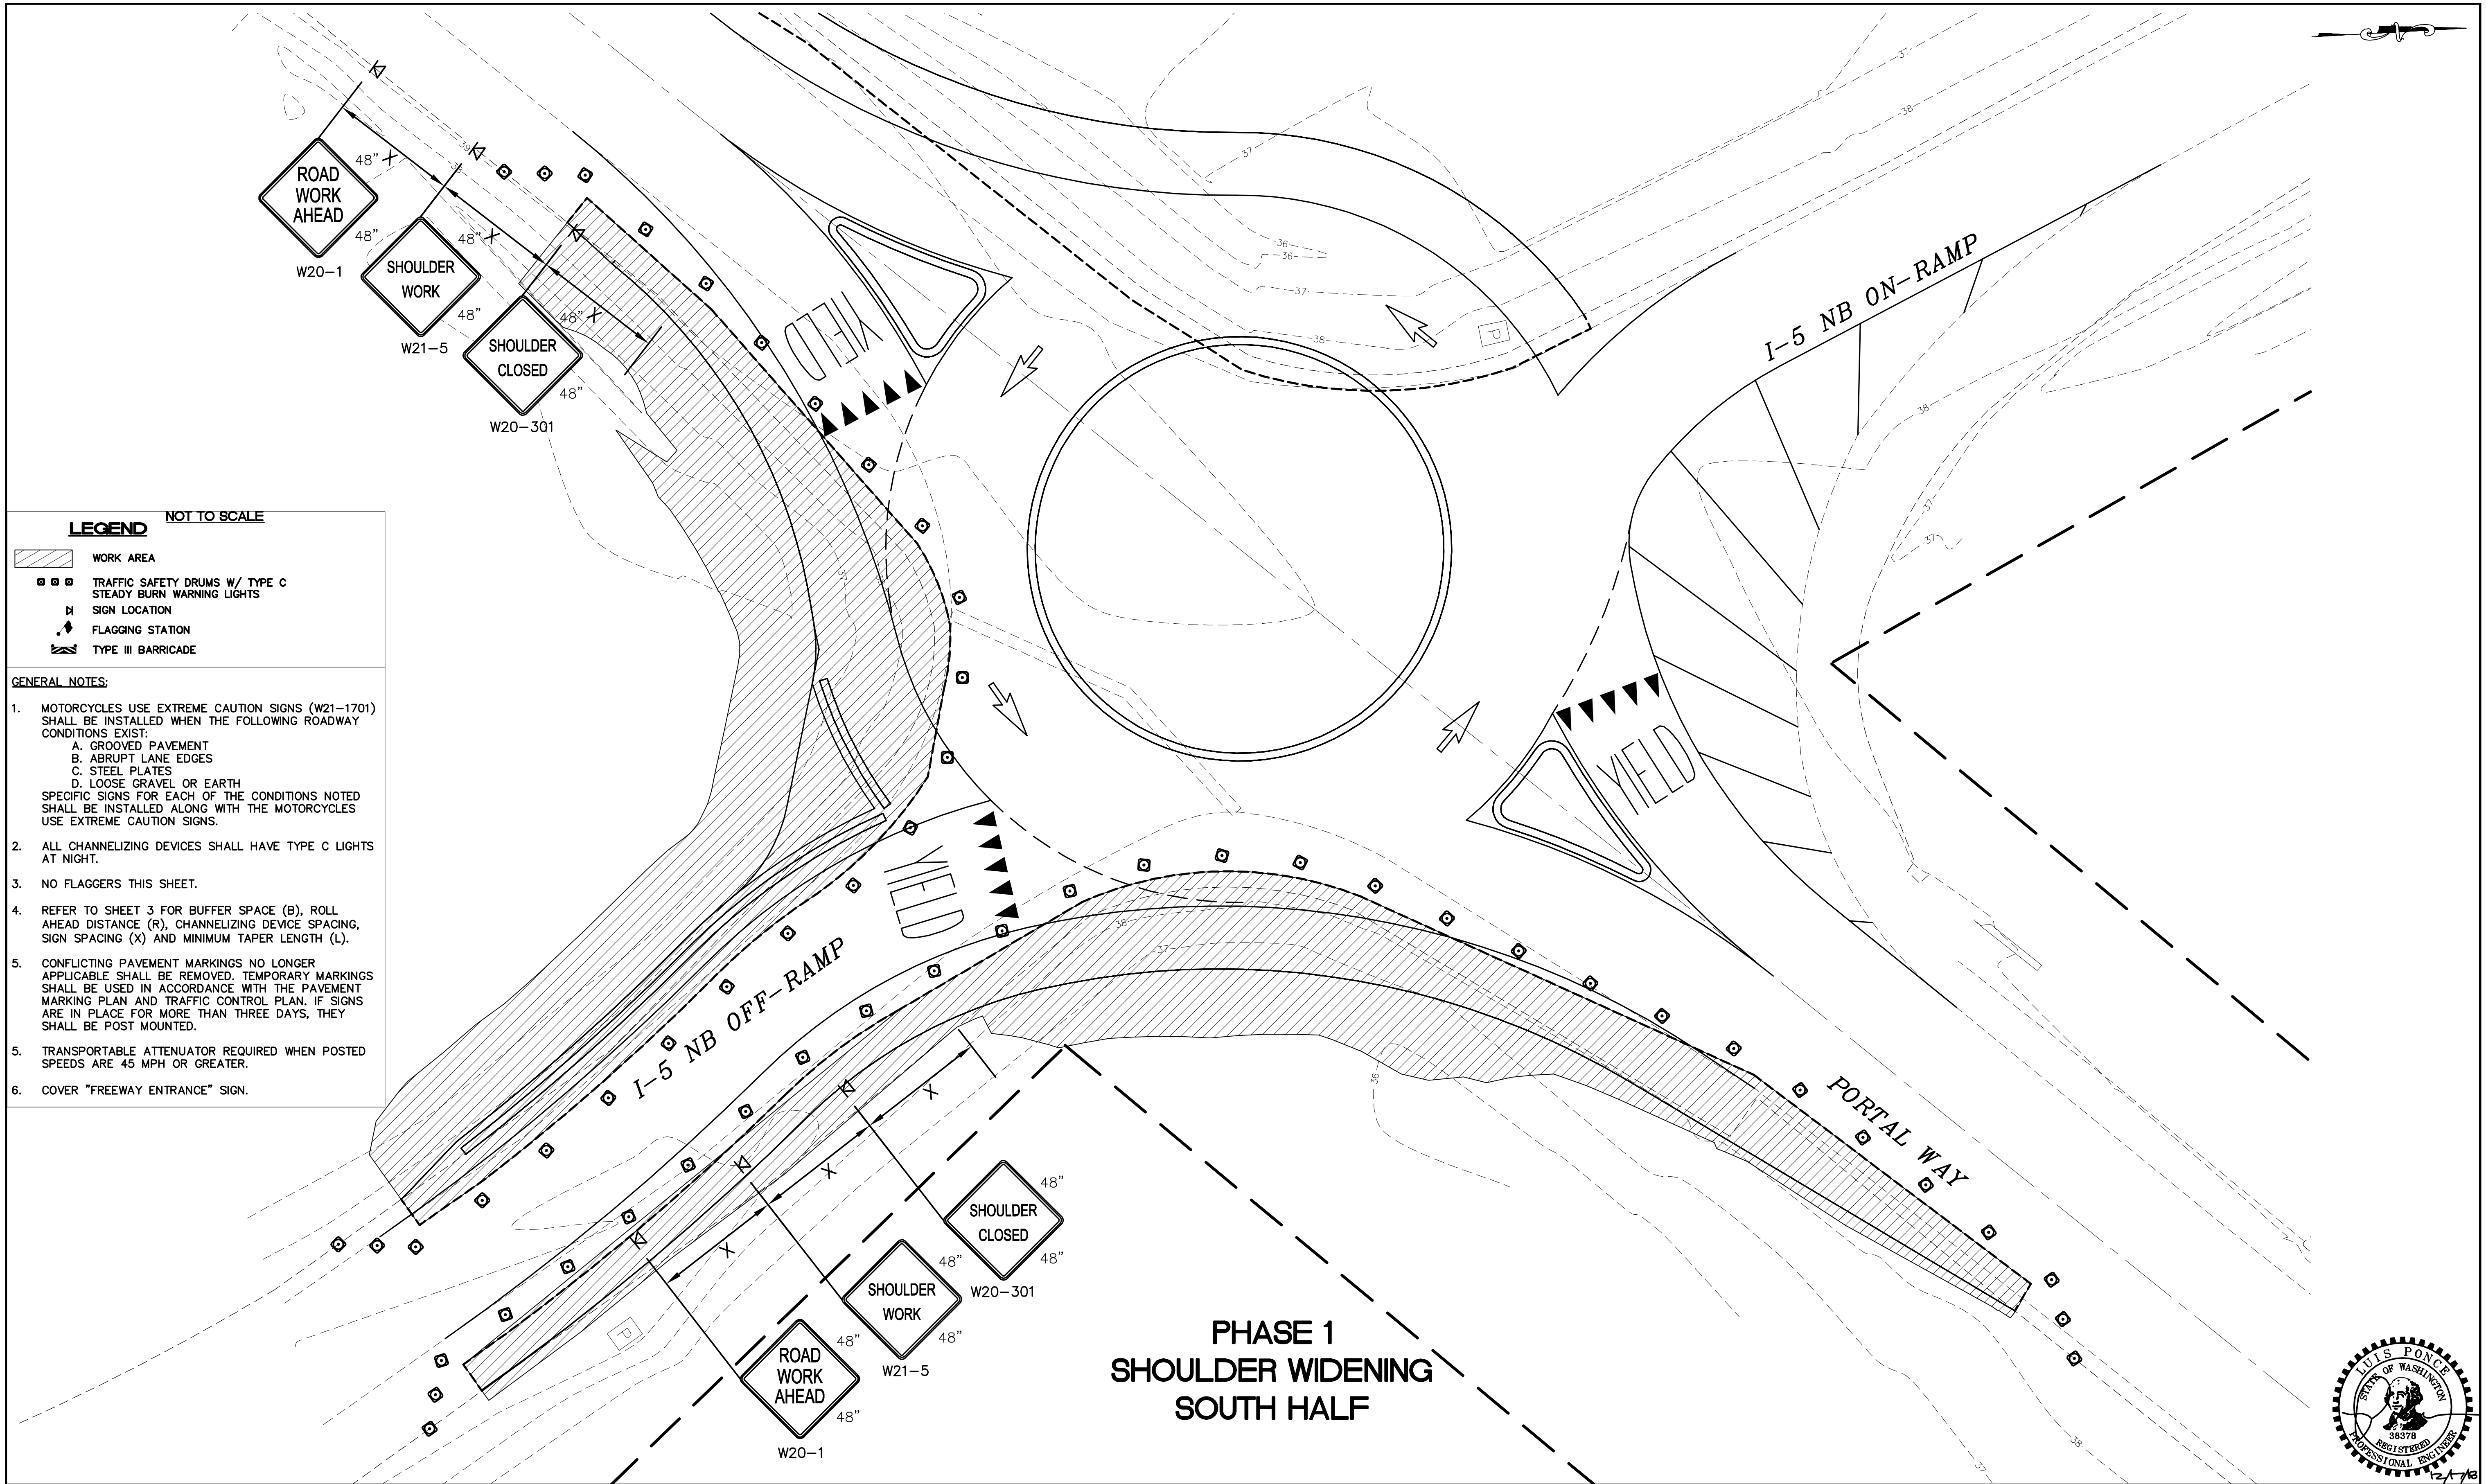

**LEGEND** NOT TO SCALE

WORK AREA

TRAFFIC SAFETY DRUMS W/ TYPE C STEADY BURN WARNING LIGHTS

SIGN LOCATION

FLAGGING STATION

TYPE III BARRICADE

**GENERAL NOTES:**

1. MOTORCYCLES USE EXTREME CAUTION SIGNS (W21-1701) SHALL BE INSTALLED WHEN THE FOLLOWING ROADWAY CONDITIONS EXIST:

A. GROOVED PAVEMENT

B. ABRUPT LANE EDGES

C. STEEL PLATES

D. LOOSE GRAVEL OR EARTH

SPECIFIC SIGNS FOR EACH OF THE CONDITIONS NOTED SHALL BE INSTALLED ALONG WITH THE MOTORCYCLES USE EXTREME CAUTION SIGNS.

2. ALL CHANNELIZING DEVICES SHALL HAVE TYPE C LIGHTS AT NIGHT.


3. NO FLAGGERS THIS SHEET.


4. REFER TO SHEET 3 FOR BUFFER SPACE (B), ROLL AHEAD DISTANCE (R), CHANNELIZING DEVICE SPACING, SIGN SPACING (X) AND MINIMUM TAPER LENGTH (L).

5. CONFLICTING PAVEMENT MARKINGS NO LONGER APPLICABLE SHALL BE REMOVED. TEMPORARY MARKINGS SHALL BE USED IN ACCORDANCE WITH THE PAVEMENT MARKING PLAN AND TRAFFIC CONTROL PLAN. IF SIGNS ARE IN PLACE FOR MORE THAN THREE DAYS, THEY SHALL BE POST MOUNTED.


5. TRANSPORTABLE ATTENUATOR REQUIRED WHEN POSTED SPEEDS ARE 45 MPH OR GREATER.

6. COVER "FREEWAY ENTRANCE" SIGN.

SUBMITTED WITH DESIGN PLAN	DESIGNED BY	<div><div>Reichhardt &amp; Ebe ENGINEERING INC</div><div>P.O. Box 978   423 Front Street, Lynden, WA 98264 (360) 354-3687 813 Metcalf Street, Sedro-Woolley, WA 98284 (360) 855-1713</div></div>						CITY OF FERNDAL 2095 MAIN ST FERNDAL, WA 98248	PORTAL WAY / I-5 ROUNDAOUT IMPROVEMENTS I-5 EXIT 263 - NB RAMPS - S. SHOULDER CLOSURE	DWG 16033 TC PLAN		DATE	
	DRAWN BY RWG										JOB#	SCALE	SHEET
	CHECKED BY LP										16033	H: N/A V: N/A	4
			NO.	DATE	DESCRIPTION	BY						of 20	

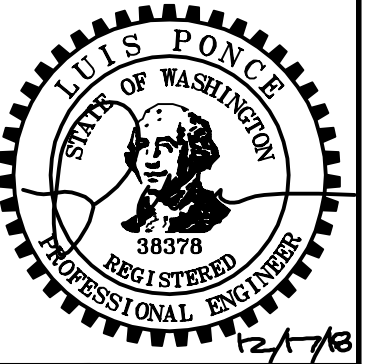



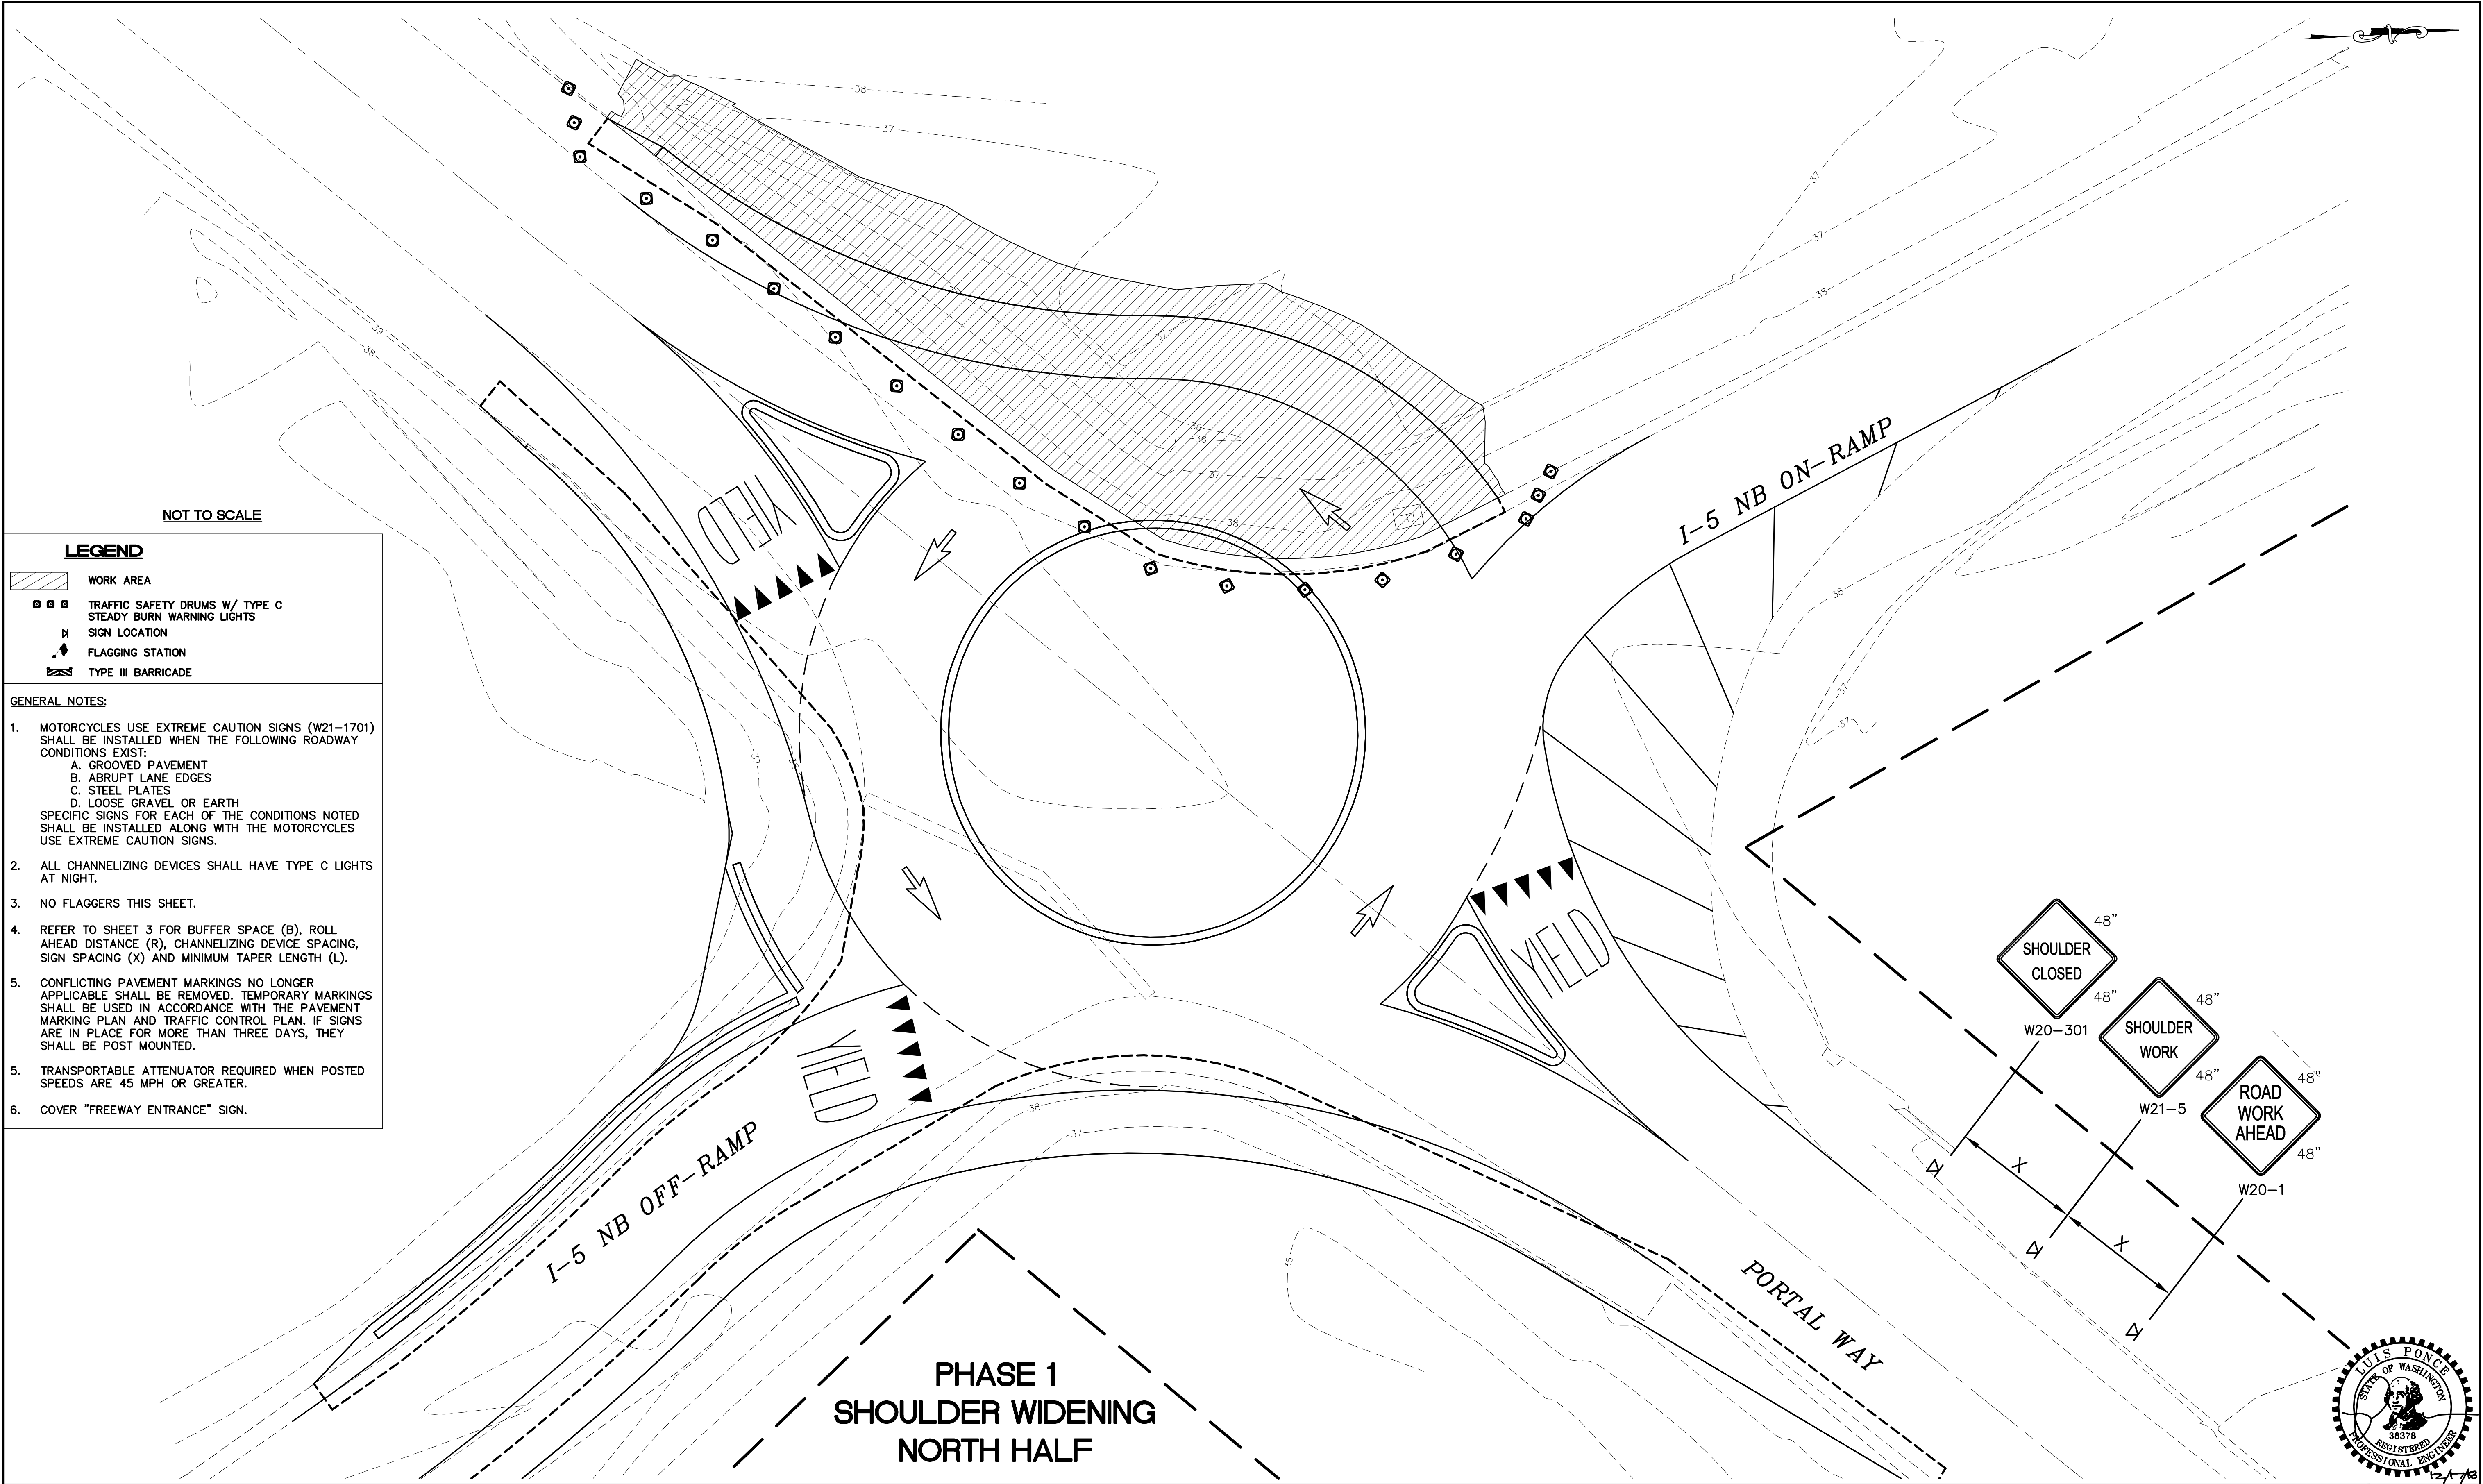

NOT TO SCALE

LEGEND

- WORK AREA
- TRAFFIC SAFETY DRUMS W/ TYPE C STEADY BURN WARNING LIGHTS
- SIGN LOCATION
- FLAGGING STATION
- TYPE III BARRICADE

GENERAL NOTES:

- MOTORCYCLES USE EXTREME CAUTION SIGNS (W21-1701) SHALL BE INSTALLED WHEN THE FOLLOWING ROADWAY CONDITIONS EXIST:
  - A. GROOVED PAVEMENT
  - B. ABRUPT LANE EDGES
  - C. STEEL PLATES
  - D. LOOSE GRAVEL OR EARTHSPECIFIC SIGNS FOR EACH OF THE CONDITIONS NOTED SHALL BE INSTALLED ALONG WITH THE MOTORCYCLES USE EXTREME CAUTION SIGNS.
- ALL CHANNELIZING DEVICES SHALL HAVE TYPE C LIGHTS AT NIGHT.
- NO FLAGGERS THIS SHEET.
- REFER TO SHEET 3 FOR BUFFER SPACE (B), ROLL AHEAD DISTANCE (R), CHANNELIZING DEVICE SPACING, SIGN SPACING (X) AND MINIMUM TAPER LENGTH (L).
- CONFLICTING PAVEMENT MARKINGS NO LONGER APPLICABLE SHALL BE REMOVED. TEMPORARY MARKINGS SHALL BE USED IN ACCORDANCE WITH THE PAVEMENT MARKING PLAN AND TRAFFIC CONTROL PLAN. IF SIGNS ARE IN PLACE FOR MORE THAN THREE DAYS, THEY SHALL BE POST MOUNTED.
- TRANSPORTABLE ATTENUATOR REQUIRED WHEN POSTED SPEEDS ARE 45 MPH OR GREATER.
- COVER "FREEWAY ENTRANCE" SIGN.

SUBMITTED WITH  
DESIGN PLAN

DESIGNED BY  
DRAWN BY  
CHECKED BY  
LP



Reichhardt & Ebe  
ENGINEERING INC

P.O. Box 978 | 423 Front Street, Lynden, WA 98264 (360) 354-3687  
813 Metcalf Street, Sedro-Woolley, WA 98284 (360) 855-1713

NO.	DATE	DESCRIPTION	BY

CITY OF FERNDAL  
2095 MAIN ST  
FERNDAL, WA 98248

PORTAL WAY / I-5  
ROUNDBOUT IMPROVEMENTS  
I-5 EXIT 263 - NB RAMPS - N. SHOULDER CLOSURE


DWG 16033 TC PLAN  
JOB# 16033

SCALE  
H: N/A V: N/A

DATE 12/17/2018  
SHEET 5 of 20





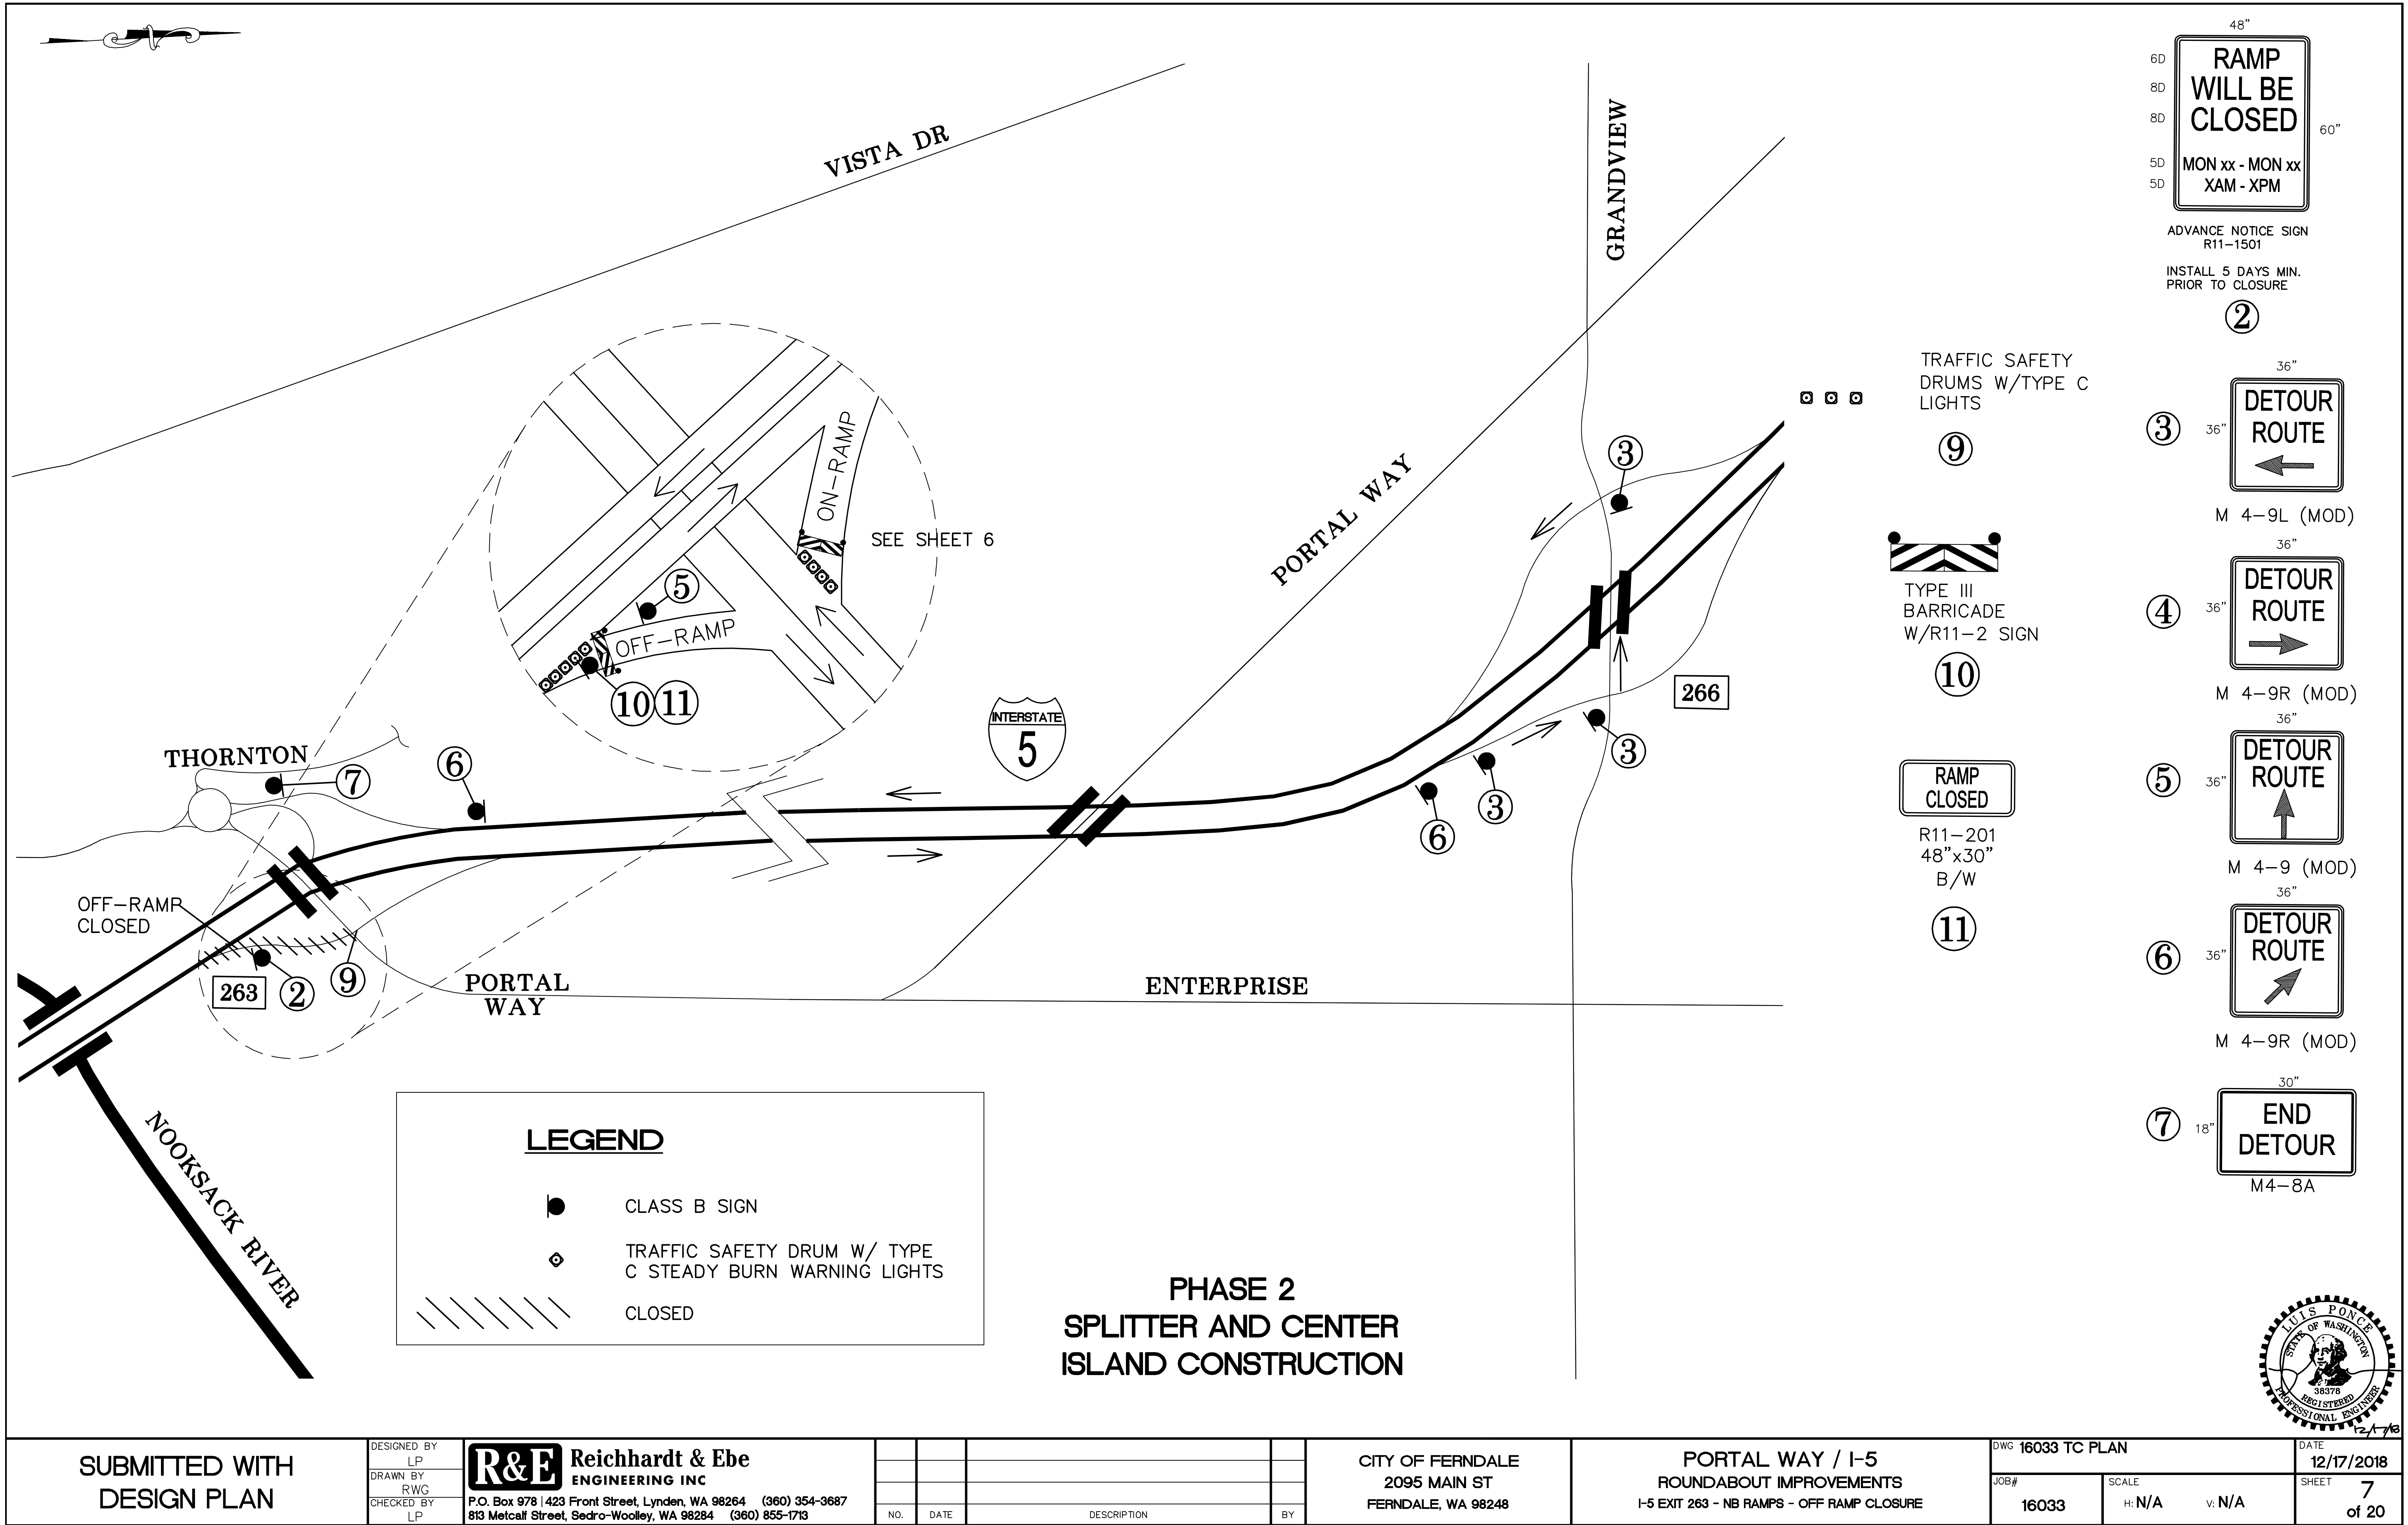



LEGEND


- ☒ SIGN LOCATION (CLASS B)  
● SIGN LOCATION (CLASS A)  
☒ SIGN LOCATION - TRIPOD MOUNTED  
🚧 FLAGGING STATION  
OR 🚧 TRAFFIC SAFETY DRUMS WITH TYPE C LIGHTS  
🚧 TYPE III R AND TYPE III L BARRICADE  
PCMS PORTABLE CHANGEABLE MESSAGE SIGN

CHANNELIZING DEVICE SPACING (FEET)		
MPH	TAPER	TANGENT
50/65	40	80
35/45	30	60
25/30	20	40


PCMS	
1	2
EXIT XXX CLOSED	USE EXIT XXX
2 SEC	2 SEC
FIELD LOCATE 1 MILE ± PRIOR TO CLOSURE	

LANE WIDTH (FEET)	MINIMUM TAPER LENGTH IN FEET (L)									
	POSTED SPEED LIMIT (MPH)									
	25	30	35	40	45	50	55	60	65	70
6	63	90	123	165	270	300	330	360	390	420
8	84	120	162	210	360	405	450	480	520	560
10	105	150	204	270	450	500	550	600	650	700
11	115	165	225	295	495	550	605	660	715	770
12	125	180	245	320	540	600	660	720	780	840
3 DEVICES MINIMUM SPACED 10' O.C. IN TAPERS FOR SHOULDER WIDTHS LESS THAN 6 FEET										

NO FLAGGERS OR SPOTTERS

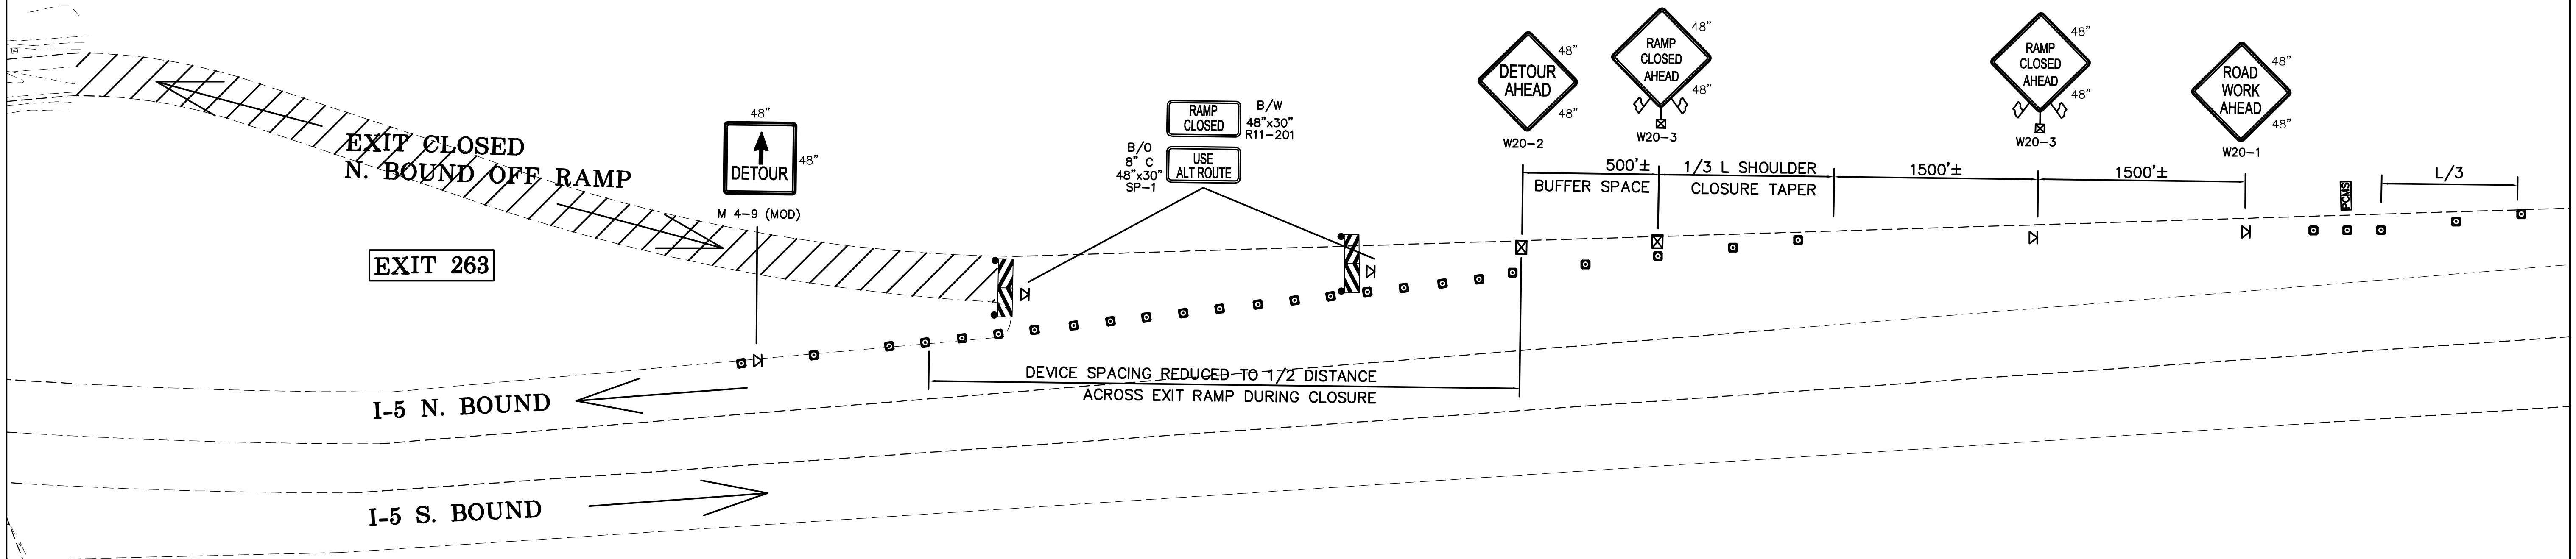

PHASE 2  
SPLITTER AND CENTER  
ISLAND CONSTRUCTION

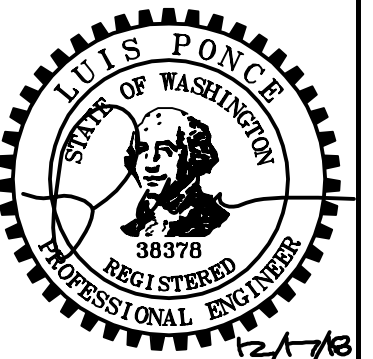

SUBMITTED WITH  
DESIGN PLAN

DESIGNED BY LP  
DRAWN BY RWG  
CHECKED BY LP

**R&E** Reichhardt & Ebe  
ENGINEERING INC  
P.O. Box 978 | 423 Front Street, Lynden, WA 98264 (360) 354-3687  
813 Metcalf Street, Sedro-Woolley, WA 98284 (360) 855-1713

NO.	DATE	DESCRIPTION	BY

CITY OF FERNDALE  
2095 MAIN ST  
FERNDALE, WA 98248


PORTAL WAY / I-5  
ROUNDAABOUT IMPROVEMENTS  
I-5 EXIT 263 - NB RAMPS - OFF-RAMP SIGNAGE

DWG 16033 TC PLAN		DATE 12/17/2018	
JOB# 16033	SCALE H: N/A V: N/A	SHEET 8 of 20	

BUFFER DATA										
LONGITUDINAL BUFFER SPACE = B										
SPEED (MPH)	25	30	35	40	45	50	55	60	65	70
LENGTH (feet)	155	200	250	305	360	425	495	570	645	730
TRANSPORTABLE ATTENUATOR ROLL AHEAD DISTANCE = R										
HOST VEHICLE WEIGHT 9,900 TO 22,000 lbs.				HOST VEHICLE WEIGHT > 22,000 lbs.						
< 45 MPH	45-55 MPH	> 55 MPH		< 45 MPH	45-55 MPH		> 55 MPH			
100'	123'	172'		74'	100'		150'			
PROTECTIVE VEHICLE (WORK VEHICLE) = R										
NO SPECIFIED DISTANCE REQUIRED										


SIGN SPACING = X (1)		
RURAL HIGHWAYS	60 / 65 MPH	800' ±
RURAL ROADS	45 / 55 MPH	500' ±
RURAL ROADS & URBAN ARTERIALS	35 / 40 MPH	350' ±
RURAL ROADS, URBAN ARTERIALS, RESIDENTIAL & BUSINESS DISTRICTS	25 / 30 MPH	200' ± (2)
URBAN STREETS	25 MPH OR LESS	100' ± (2)
(1) ALL SPACING MAY BE ADJUSTED TO ACCOMMODATE INTERSECTIONS AND DRIVEWAYS. (2) THIS SPACING MAY BE REDUCED IN URBAN AREAS TO FIT ROADWAY CONDITIONS.		

NOT TO SCALE

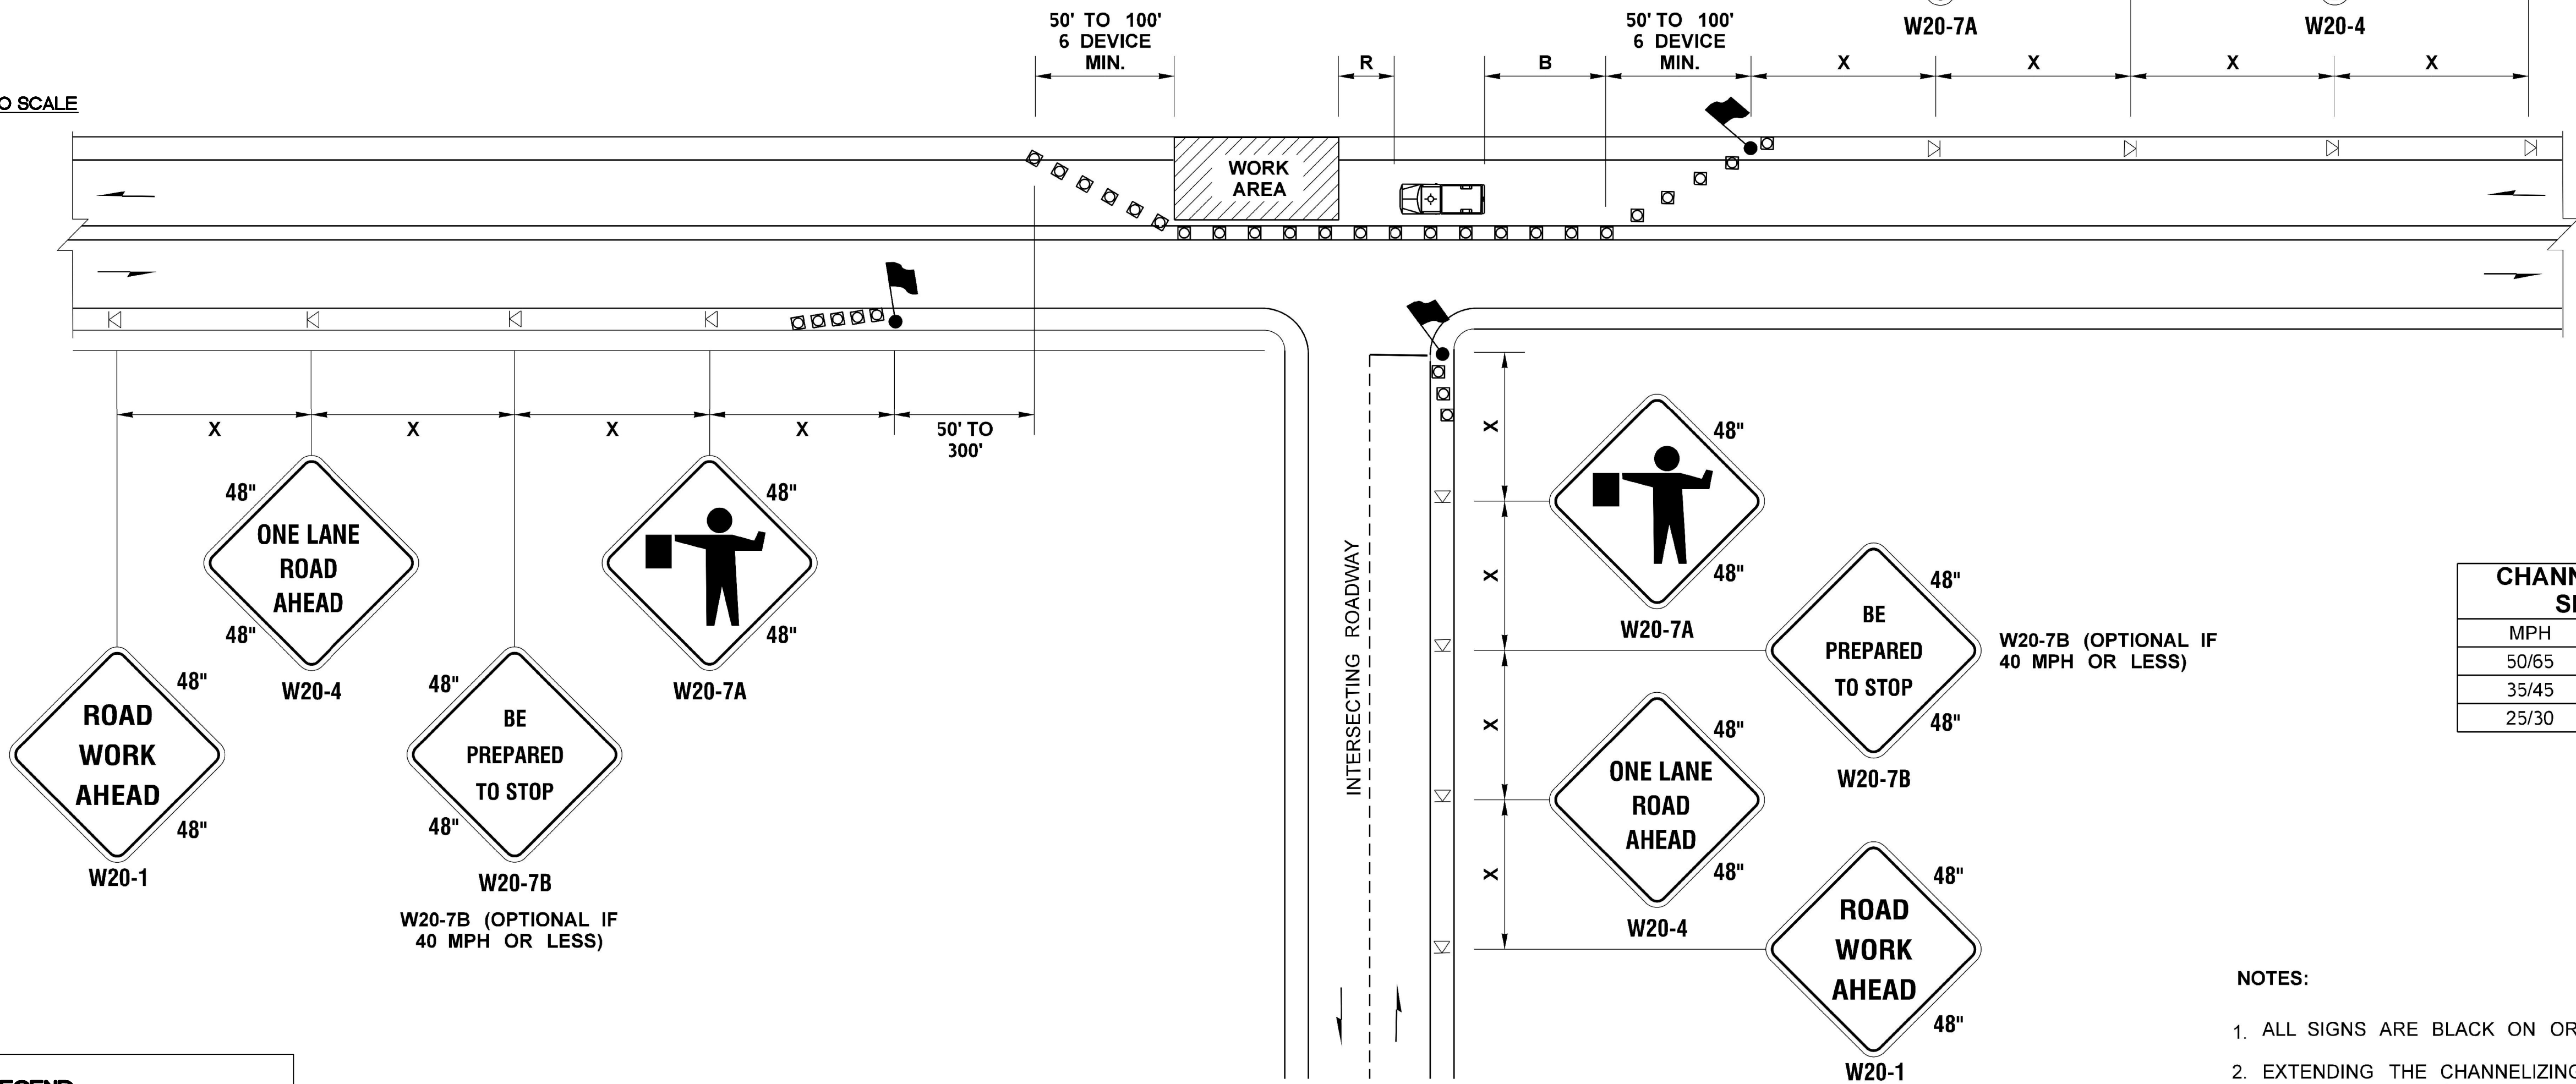

CHANNELIZATION DEVICE SPACING (FEET)		
MPH	TAPER	TANGENT
50/65	10 TO 20	80
35/45	10 TO 20	60
25/30	10 TO 20	40

- NOTES:
- ALL SIGNS ARE BLACK ON ORANGE.
  - EXTENDING THE CHANNELIZING DEVICE TAPER ACROSS SHOULDER IS RECOMMENDED.
  - NIGHT WORK REQUIRES ADDITIONAL ROADWAY LIGHTING AT FLAGGING STATIONS. SEE THE STANDARD SPECIFICATIONS FOR ADDITIONAL DETAILS.
  - SEE SPECIAL PROVISIONS FOR WORK HOUR RESTRICTIONS.

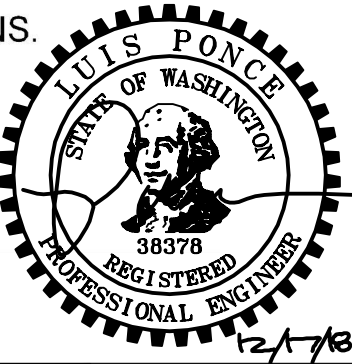

SUBMITTED WITH  
DESIGN PLAN


DESIGNED BY  
DRAWN BY  
CHECKED BY  
LP  
**R&E** Reichhardt & Ebe  
ENGINEERING INC  
P.O. Box 978 | 423 Front Street, Lynden, WA 98264 (360) 354-3687  
813 Metcalf Street, Sedro-Woolley, WA 98284 (360) 855-1713

NO.	DATE	DESCRIPTION	BY


CITY OF FERNDALE  
2095 MAIN ST  
FERNDALE, WA 98248

PORTAL WAY / I-5  
ROUNDBOUT IMPROVEMENTS  
WSDOT TYPICAL LANE CLOSURE

DWG 16033 TC PLAN		DATE	12/17/2018
JOB#	SCALE	SHEET	9
16033	H: N/A V: N/A	of 20	

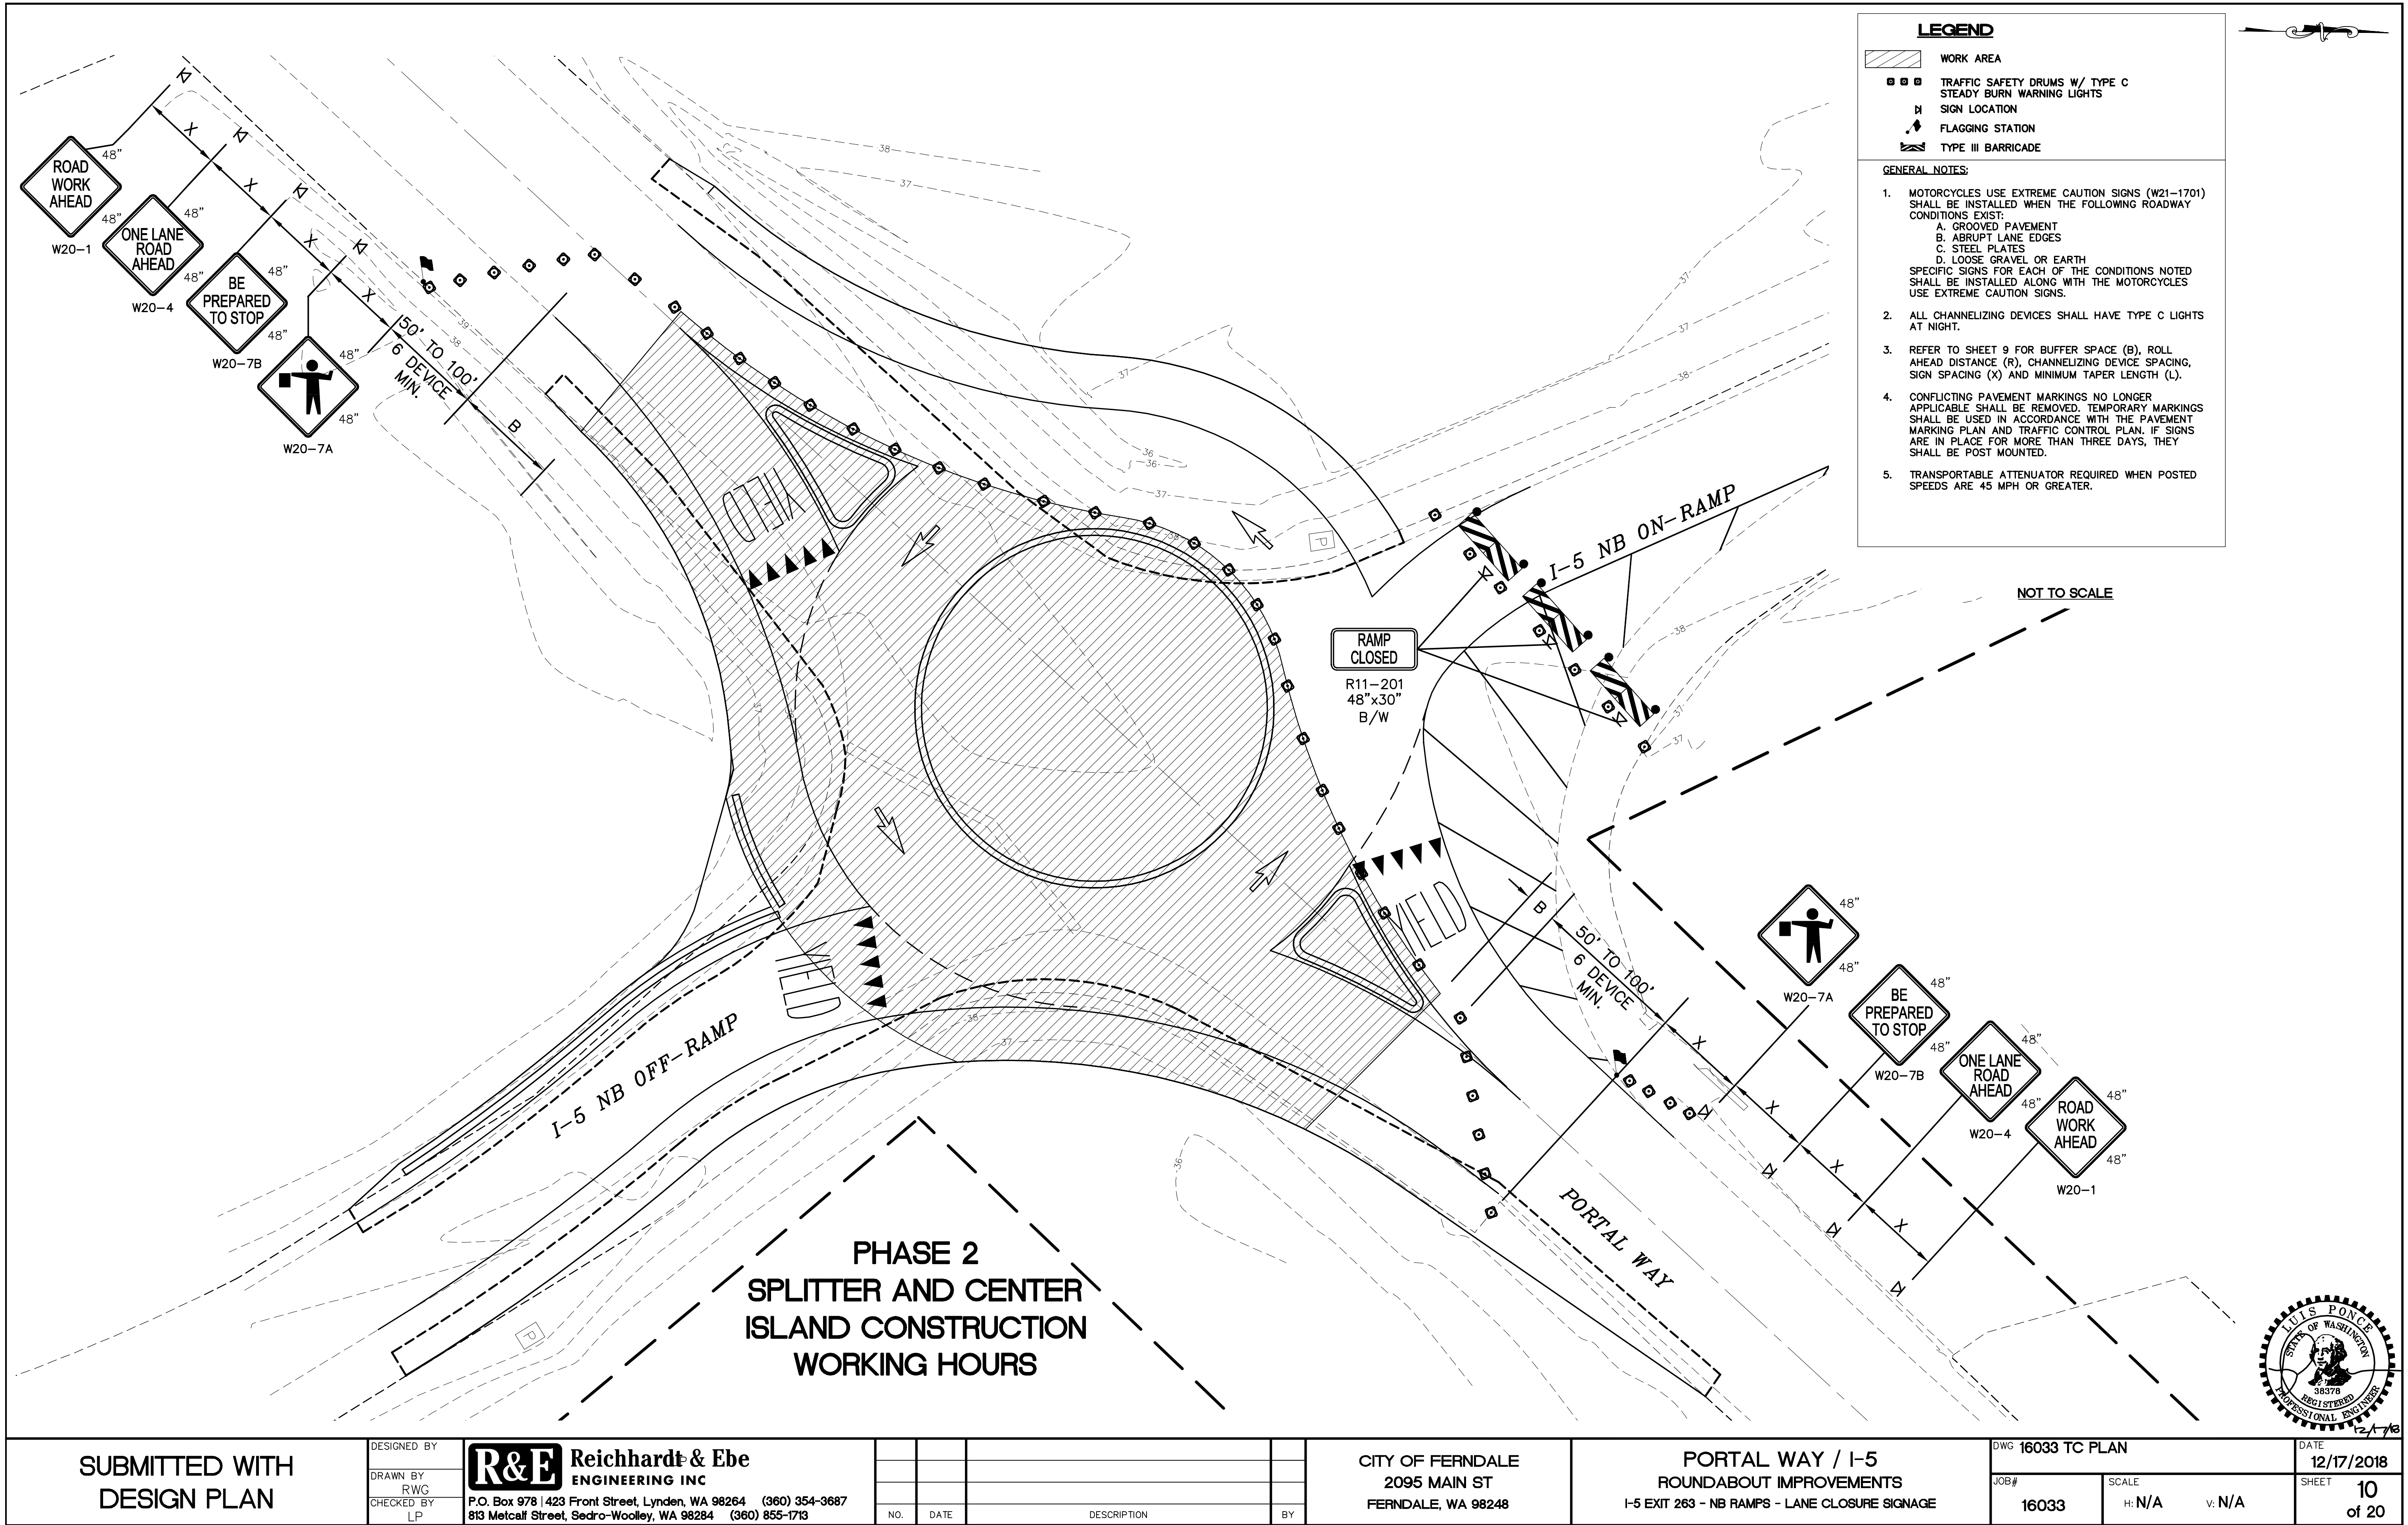



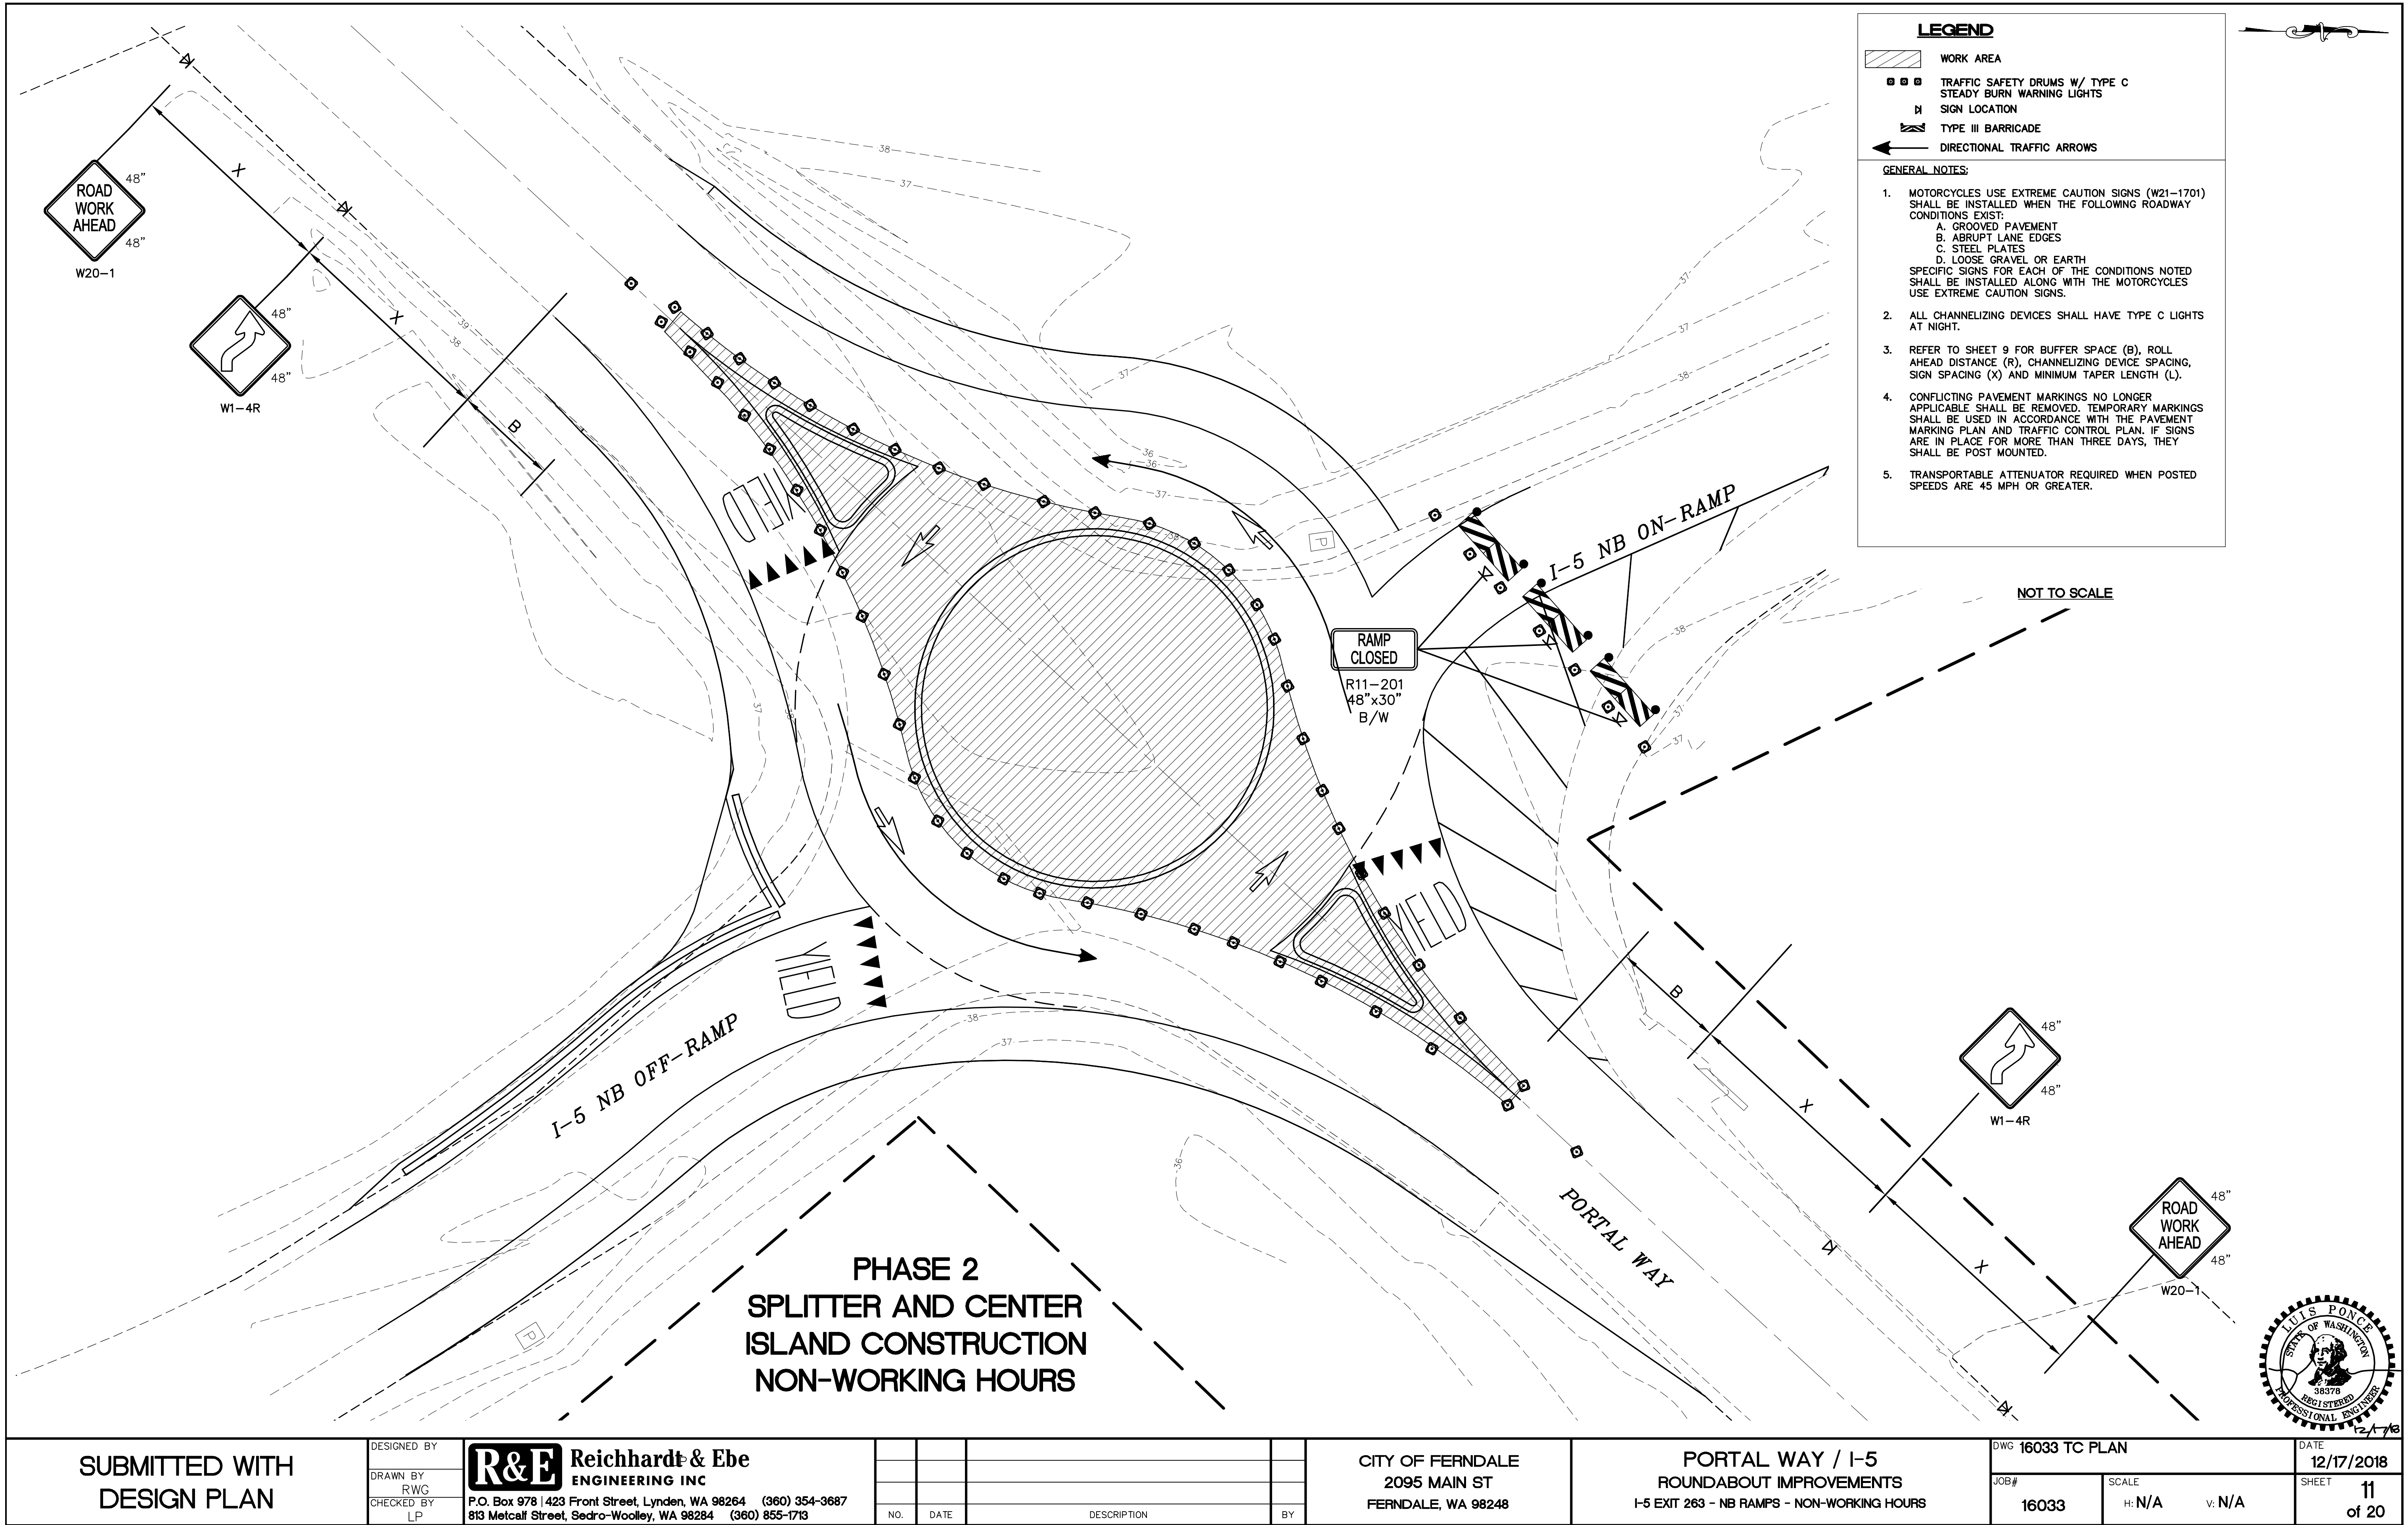

SUBMITTED WITH  
DESIGN PLAN

DESIGNED BY  
DRAWN BY  
CHECKED BY  
LP

**R&E** Reichhardt & Ebe  
ENGINEERING INC  
P.O. Box 978 | 423 Front Street, Lynden, WA 98264 (360) 354-3687  
813 Metcalf Street, Sedro-Woolley, WA 98284 (360) 855-1713

NO.	DATE	DESCRIPTION	BY

CITY OF FERNDALE  
2095 MAIN ST  
FERNDALE, WA 98248


PORTAL WAY / I-5  
ROUNDBOUT IMPROVEMENTS  
I-5 EXIT 263 - NB RAMPS - NON-WORKING HOURS

DWG 16033 TC PLAN  
JOB# 16033

SCALE  
H: N/A V: N/A

DATE 12/17/2018  
SHEET 11 of 20



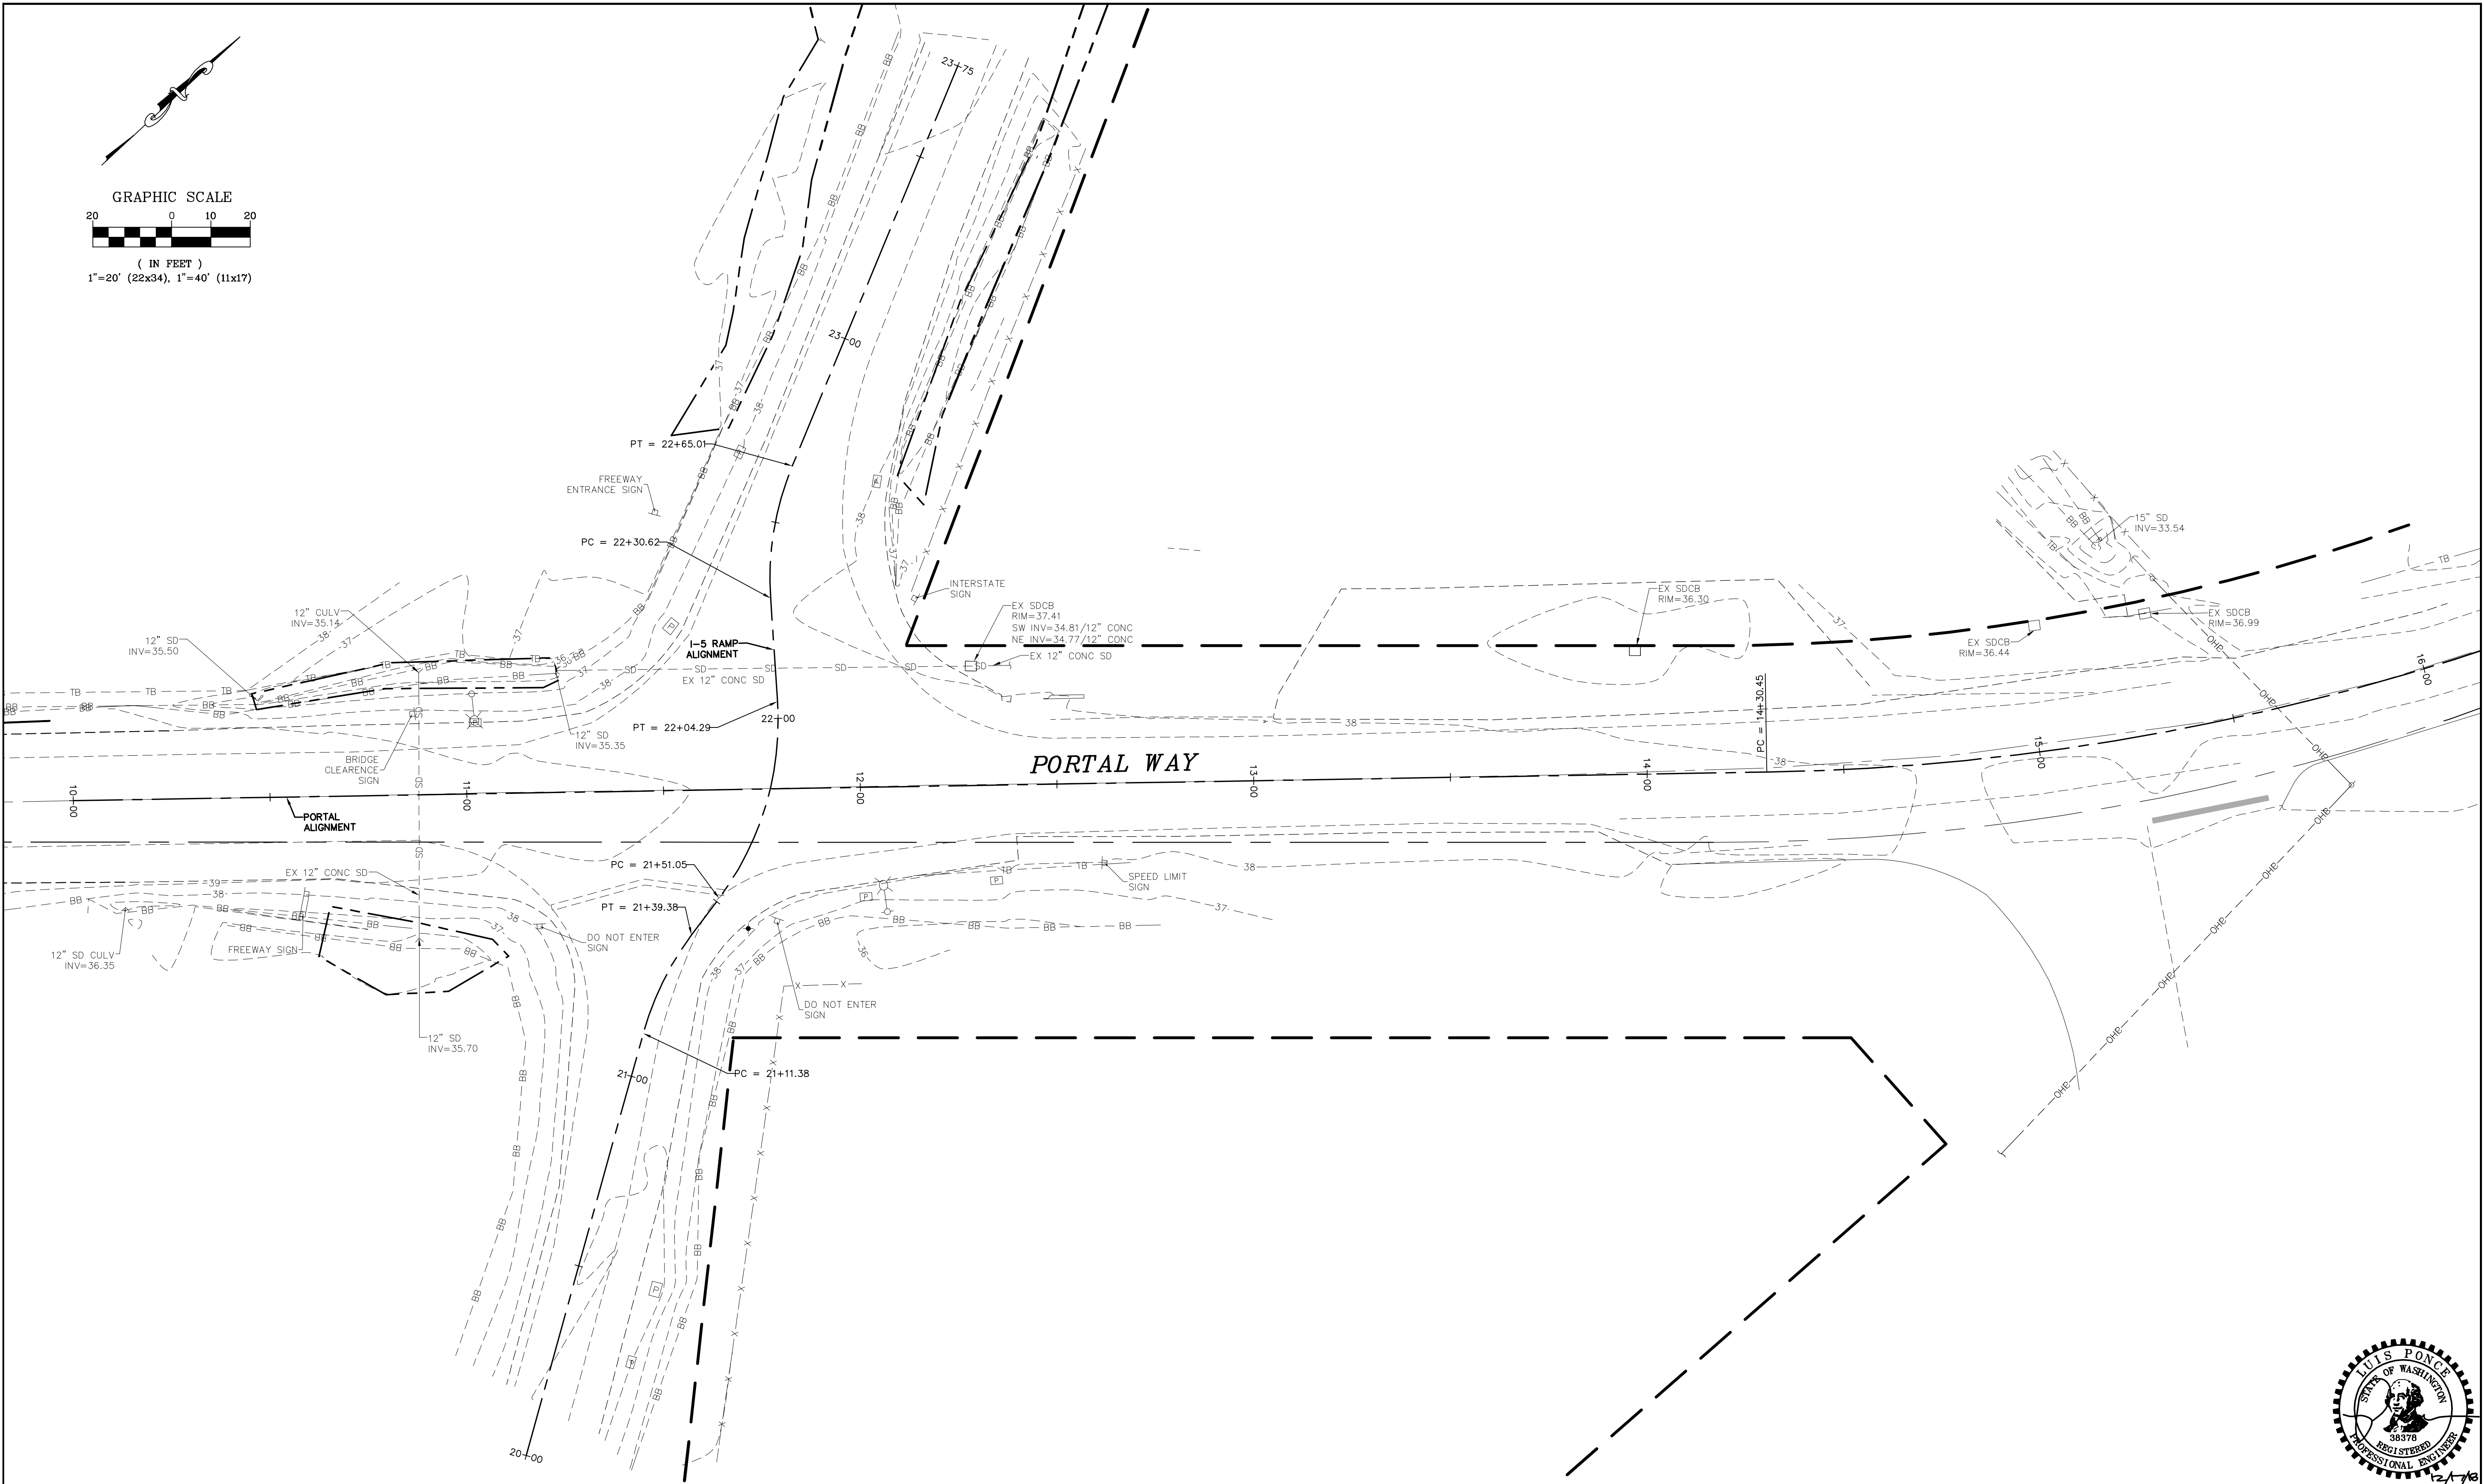

SUBMITTED WITH  
DESIGN PLAN

DESIGNED BY  
LP/OAM  
DRAWN BY  
OAM/LMH  
CHECKED BY  
LP

**R&E** Reichhardt & Ebe  
ENGINEERING INC  
P.O. Box 978 | 423 Front Street, Lynden, WA 98264 (360) 354-3687  
813 Metcalf Street, Sedro-Woolley, WA 98284 (360) 855-1713


NO.	DATE	DESCRIPTION	BY



CITY OF FERNDALE  
2095 MAIN ST  
FERNDALE, WA 98248

PORTAL WAY / I-5  
ROUNDAOUT IMPROVEMENTS  
EXISTING CONDITIONS

DWG	16033 EXCOND,TESC,DEMO
JOB#	16033
SCALE	H: 1"=20' V: N/A

DATE	12/17/2018
SHEET	12 of 20

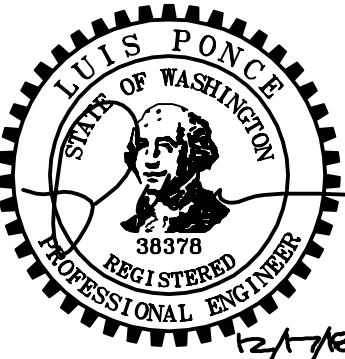

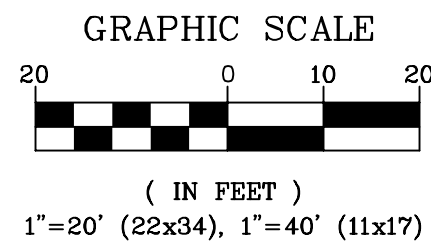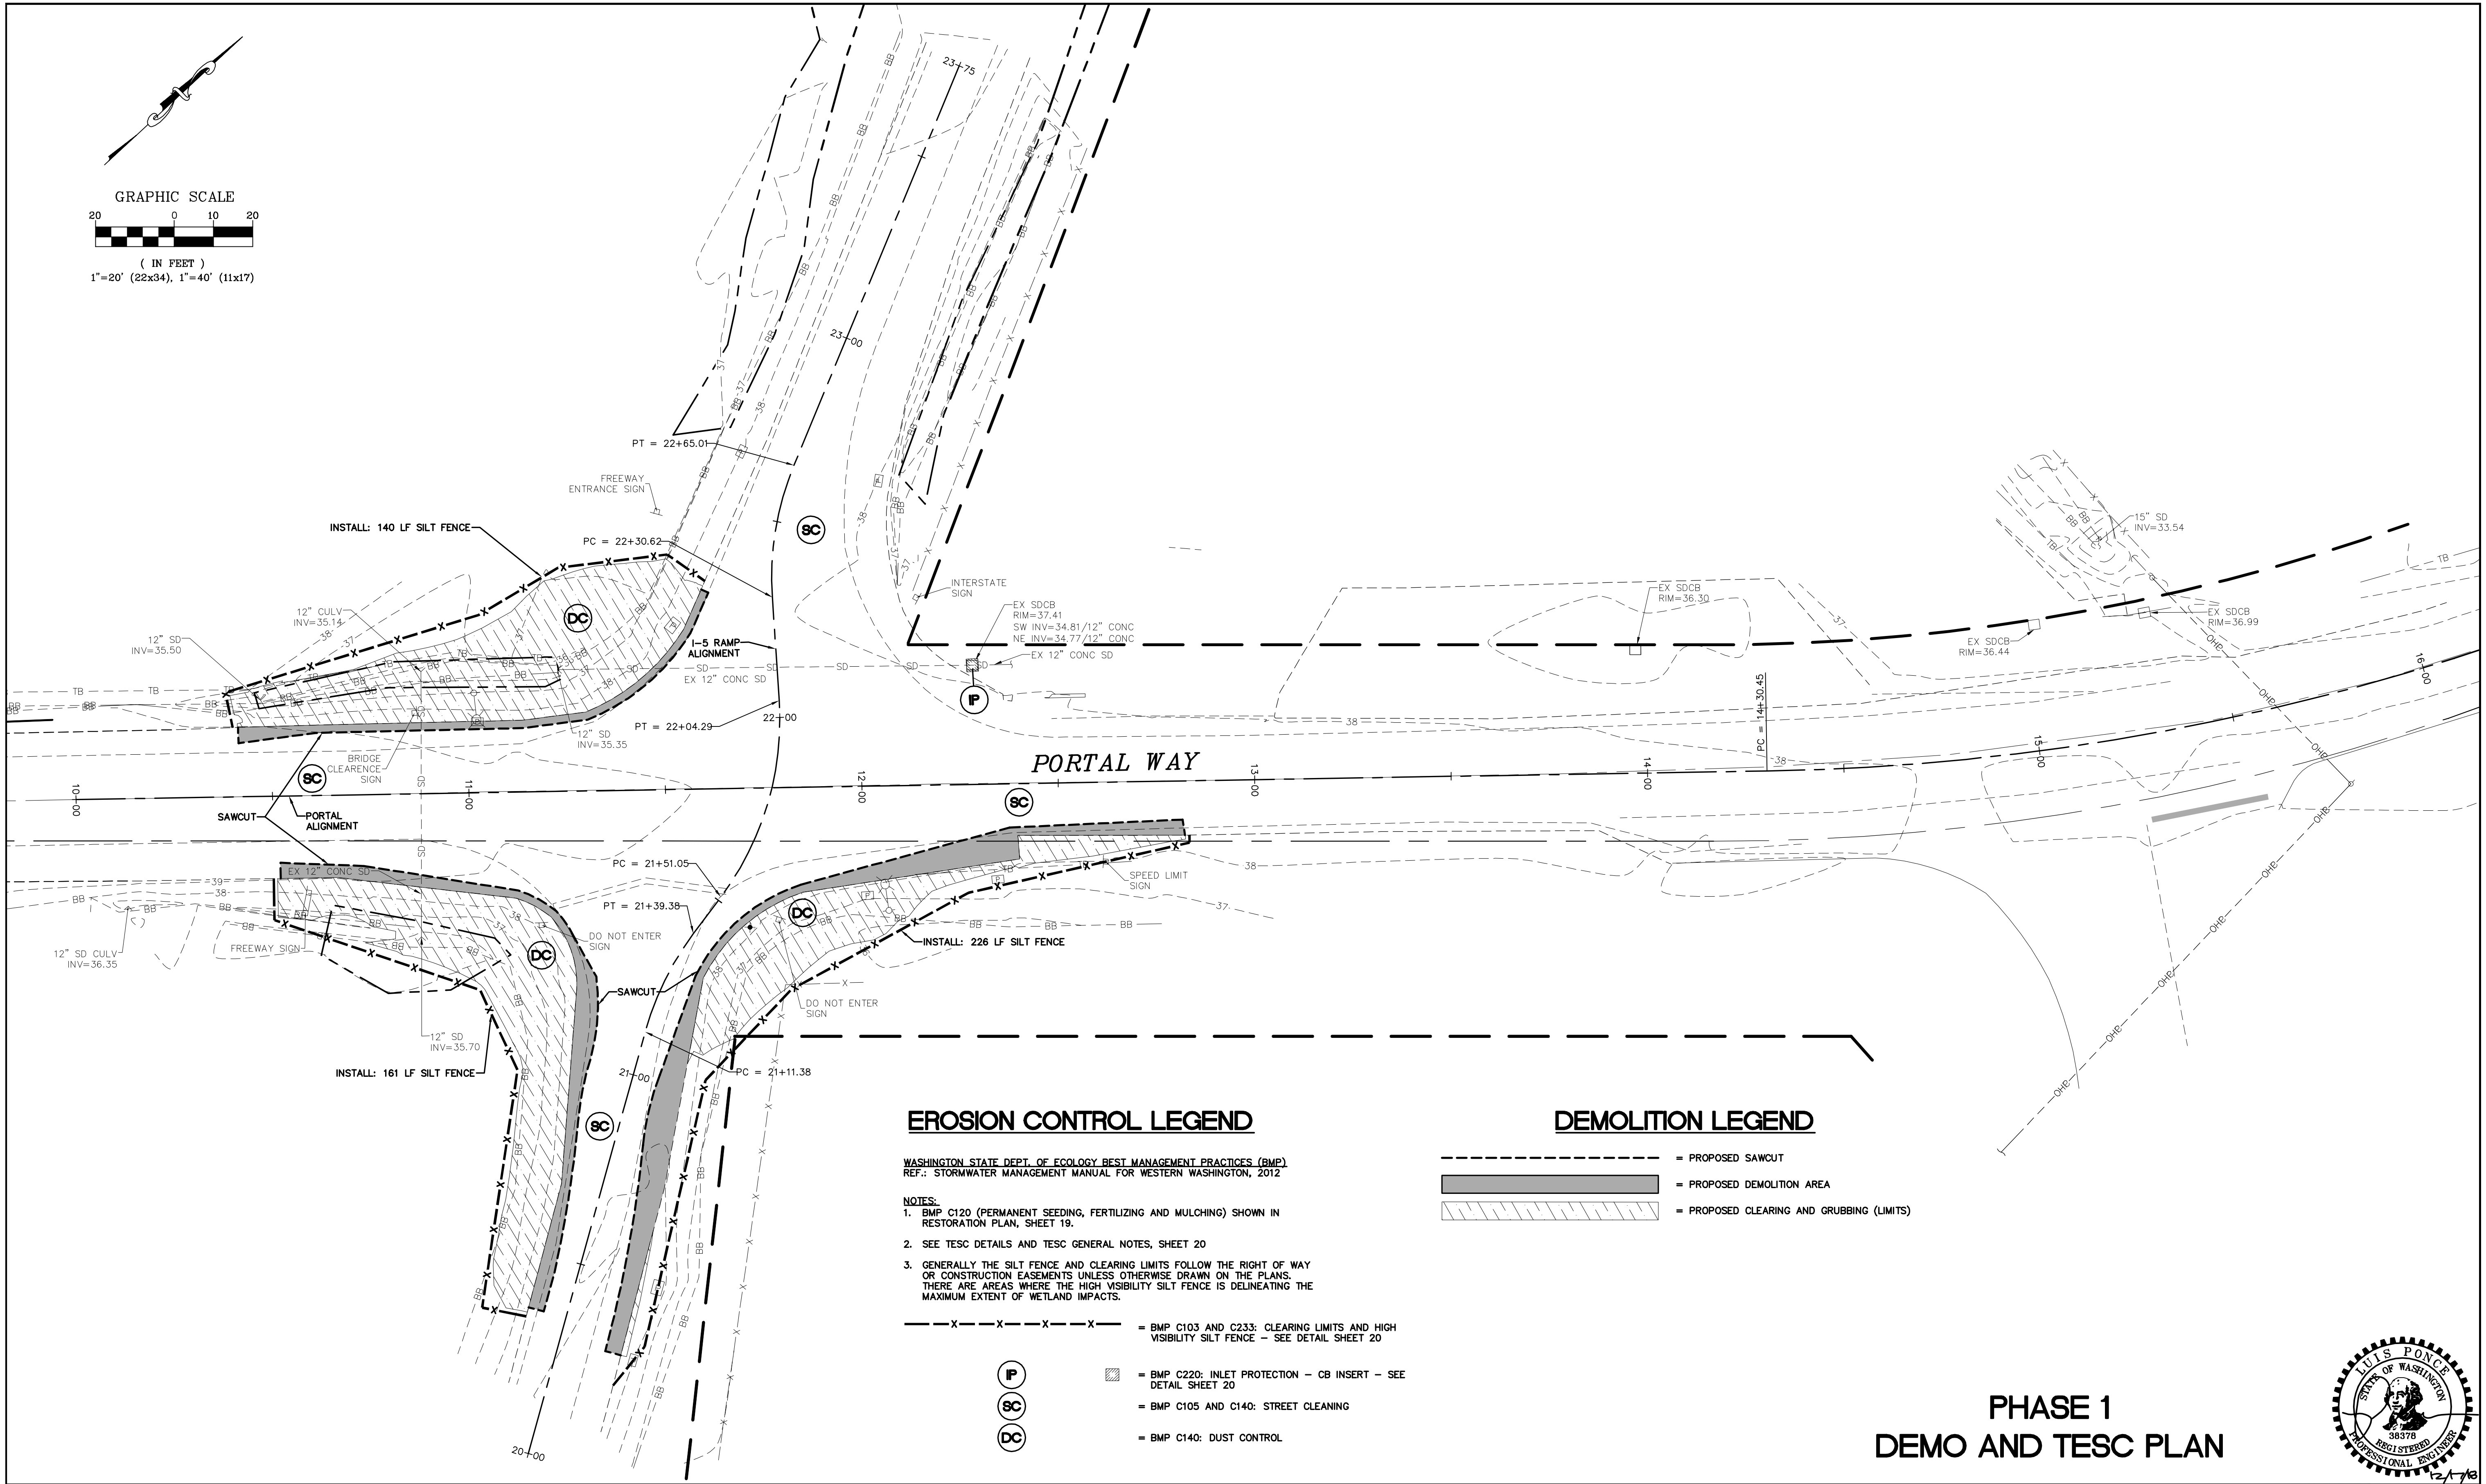

EROSION CONTROL LEGEND

WASHINGTON STATE DEPT. OF ECOLOGY BEST MANAGEMENT PRACTICES (BMP)  
REF.: STORMWATER MANAGEMENT MANUAL FOR WESTERN WASHINGTON, 2012


- NOTES:
- BMP C120 (PERMANENT SEEDING, FERTILIZING AND MULCHING) SHOWN IN RESTORATION PLAN, SHEET 19.
  - SEE TESC DETAILS AND TESC GENERAL NOTES, SHEET 20
  - GENERALLY THE SILT FENCE AND CLEARING LIMITS FOLLOW THE RIGHT OF WAY OR CONSTRUCTION EASEMENTS UNLESS OTHERWISE DRAWN ON THE PLANS. THERE ARE AREAS WHERE THE HIGH VISIBILITY SILT FENCE IS DELINEATING THE MAXIMUM EXTENT OF WETLAND IMPACTS.

- X --- X --- X --- X --- = BMP C103 AND C233: CLEARING LIMITS AND HIGH VISIBILITY SILT FENCE - SEE DETAIL SHEET 20
- (P) = BMP C220: INLET PROTECTION - CB INSERT - SEE DETAIL SHEET 20
- (SC) = BMP C105 AND C140: STREET CLEANING
- (DC) = BMP C140: DUST CONTROL

DEMOLITION LEGEND

- = PROPOSED SAWCUT
- [Solid Gray] = PROPOSED DEMOLITION AREA
- [Hatched] = PROPOSED CLEARING AND GRUBBING (LIMITS)

PHASE 1  
DEMO AND TESC PLAN

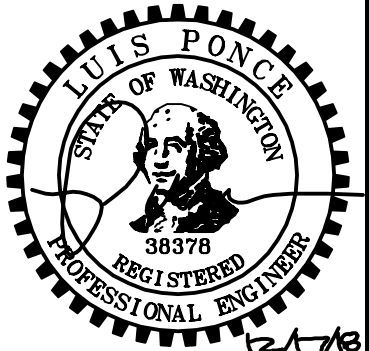

SUBMITTED WITH  
DESIGN PLAN

DESIGNED BY  
LP/OAM  
DRAWN BY  
OAM/LMH  
CHECKED BY  
LP

**R&E** Reichhardt & Ebe  
ENGINEERING INC  
P.O. Box 978 | 423 Front Street, Lynden, WA 98264 (360) 354-3687  
813 Metcalf Street, Sedro-Woolley, WA 98284 (360) 855-1713




NO.	DATE	DESCRIPTION	BY

CITY OF FERNDAL  
2095 MAIN ST  
FERNDAL, WA 98248

PORTAL WAY / I-5  
ROUNABOUT IMPROVEMENTS  
DEMO AND TESC PLAN - PHASE 1




DWG	16033 EXCOND, TESC, DEMO	DATE	12/17/2018
JOB#	16033	SCALE	H: 1"=20' V: N/A
SHEET	13	of 20	



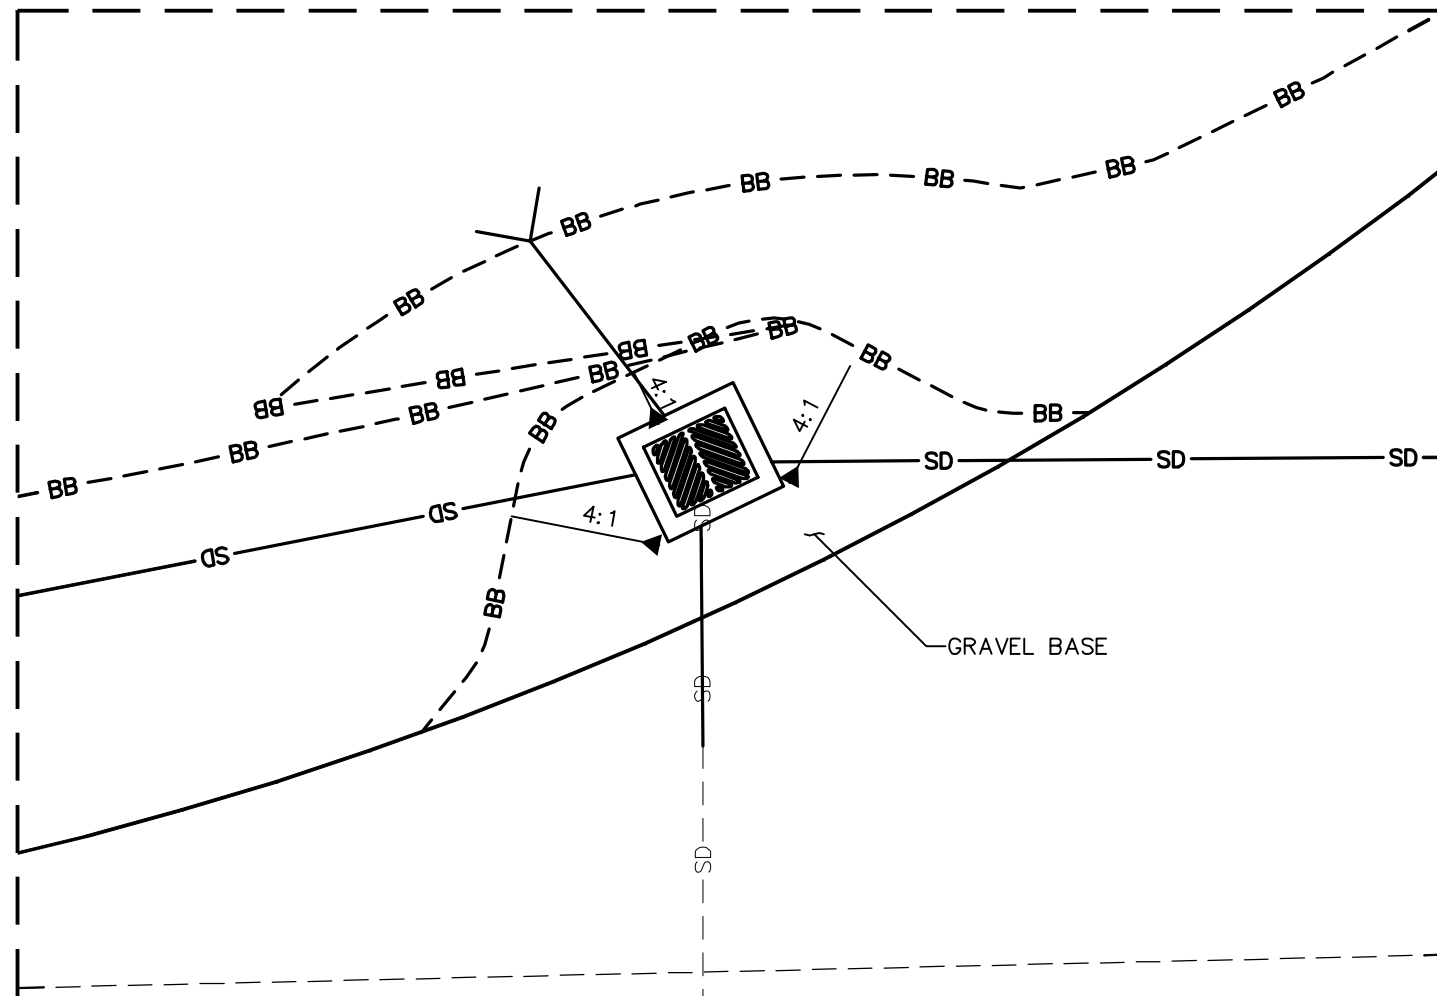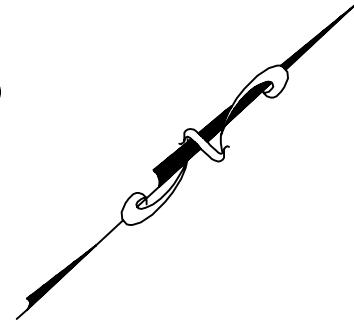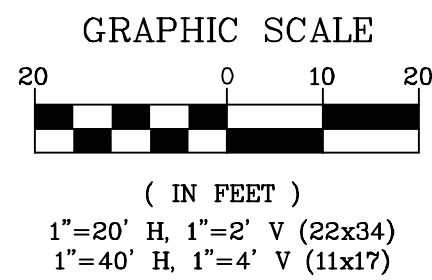


CATCH BASIN GRADING

NTS

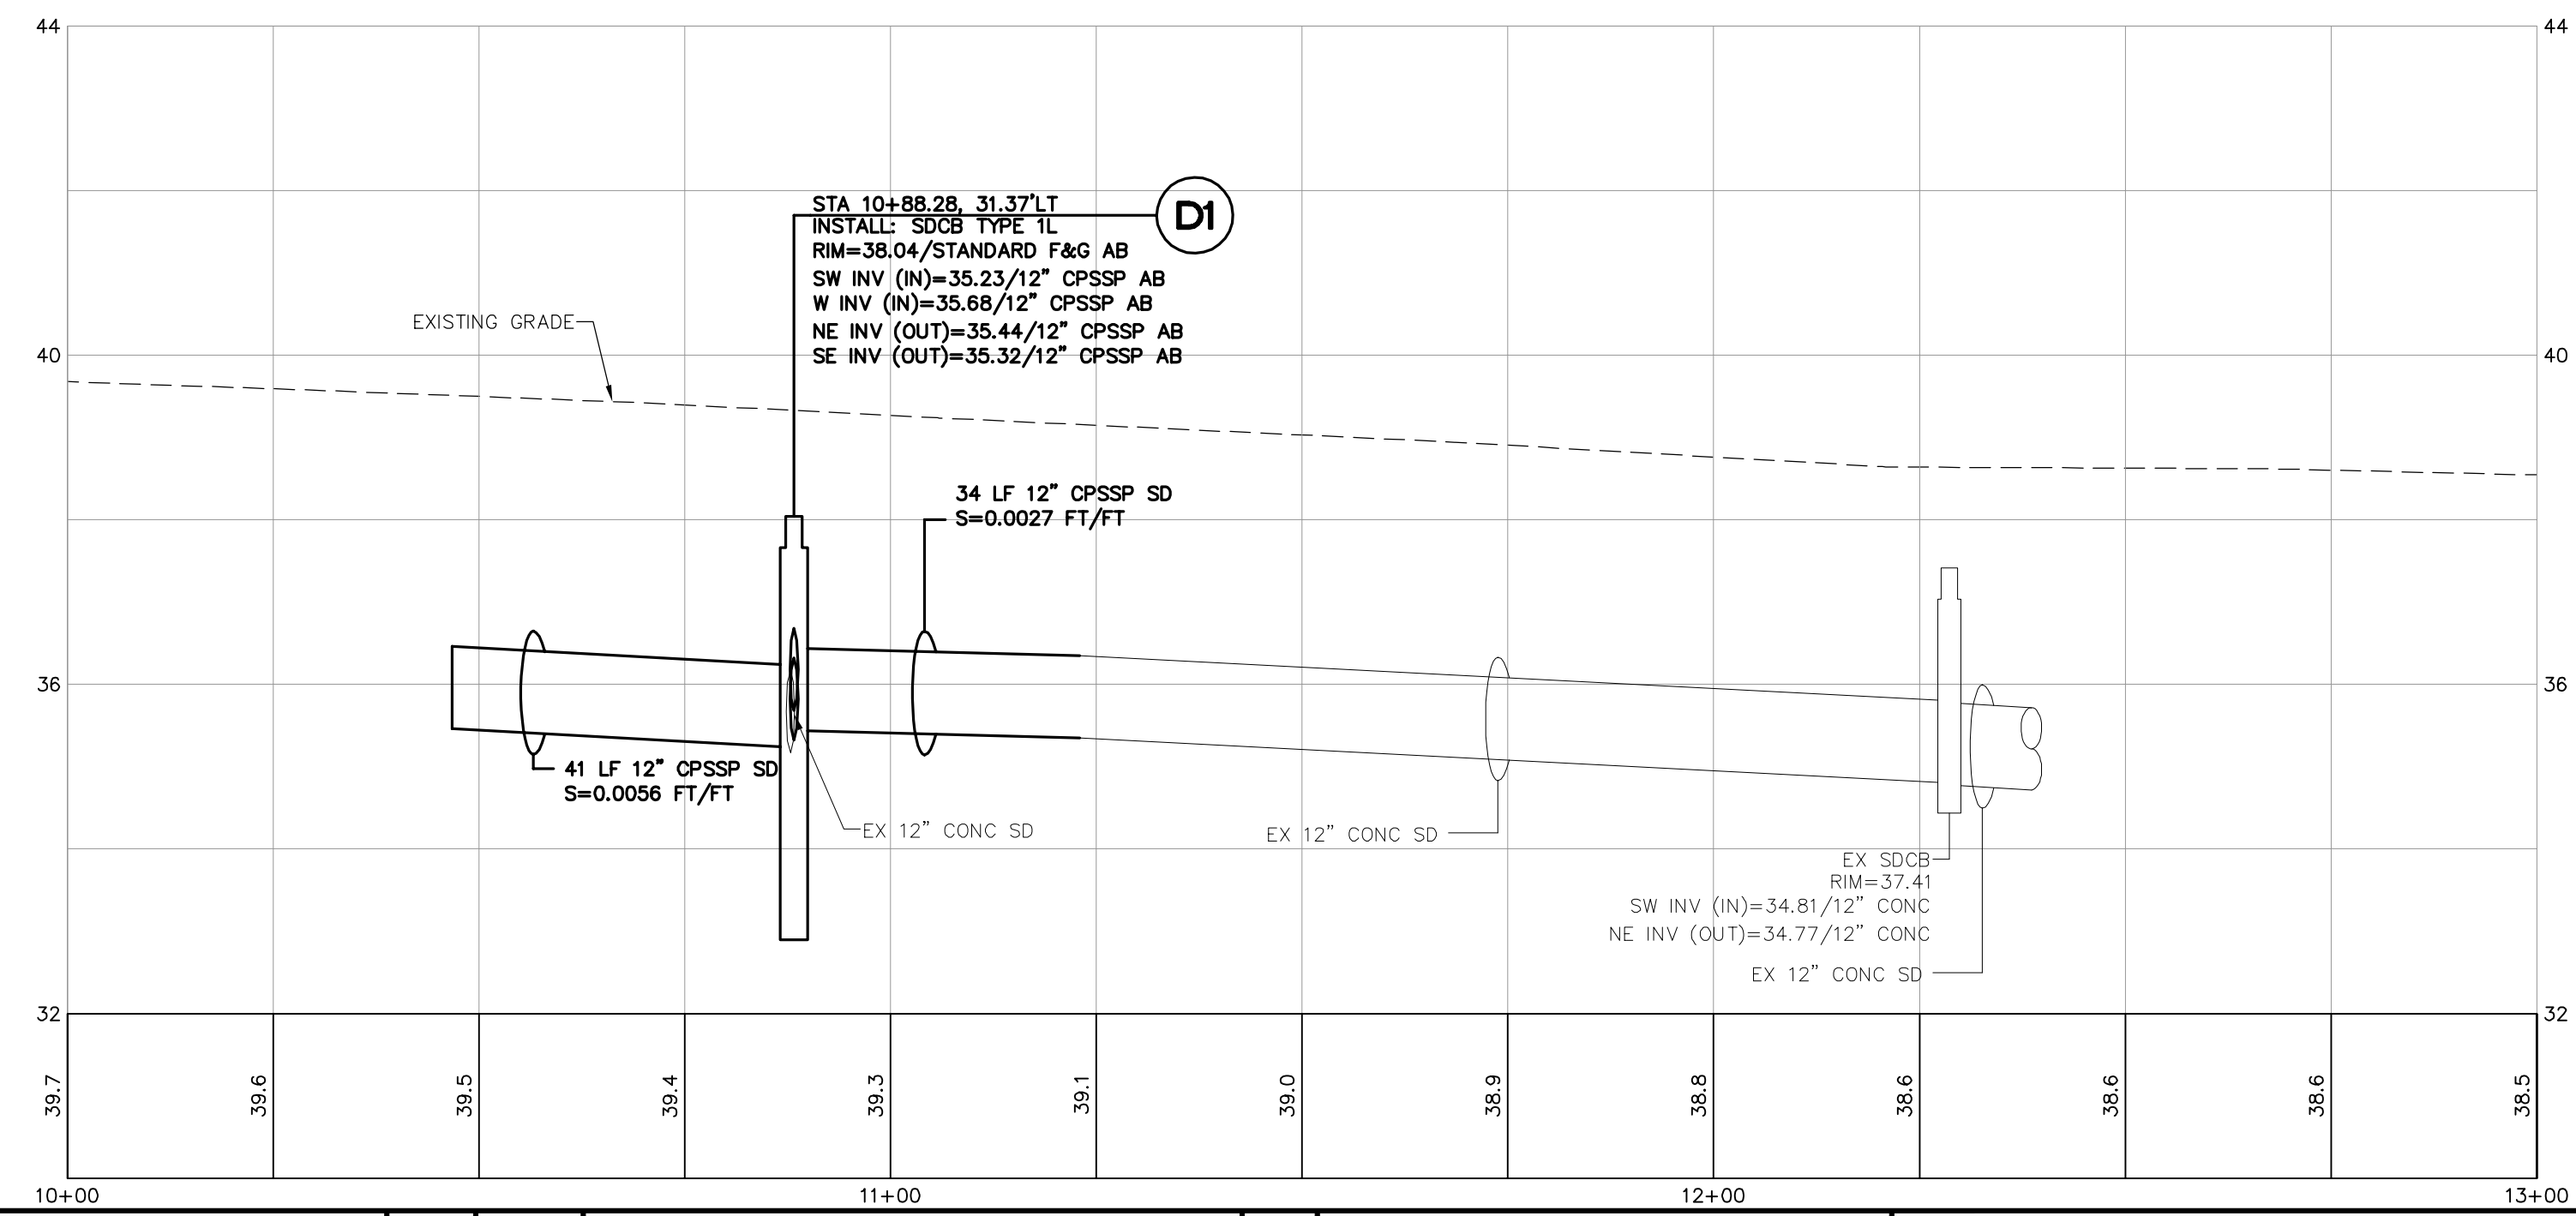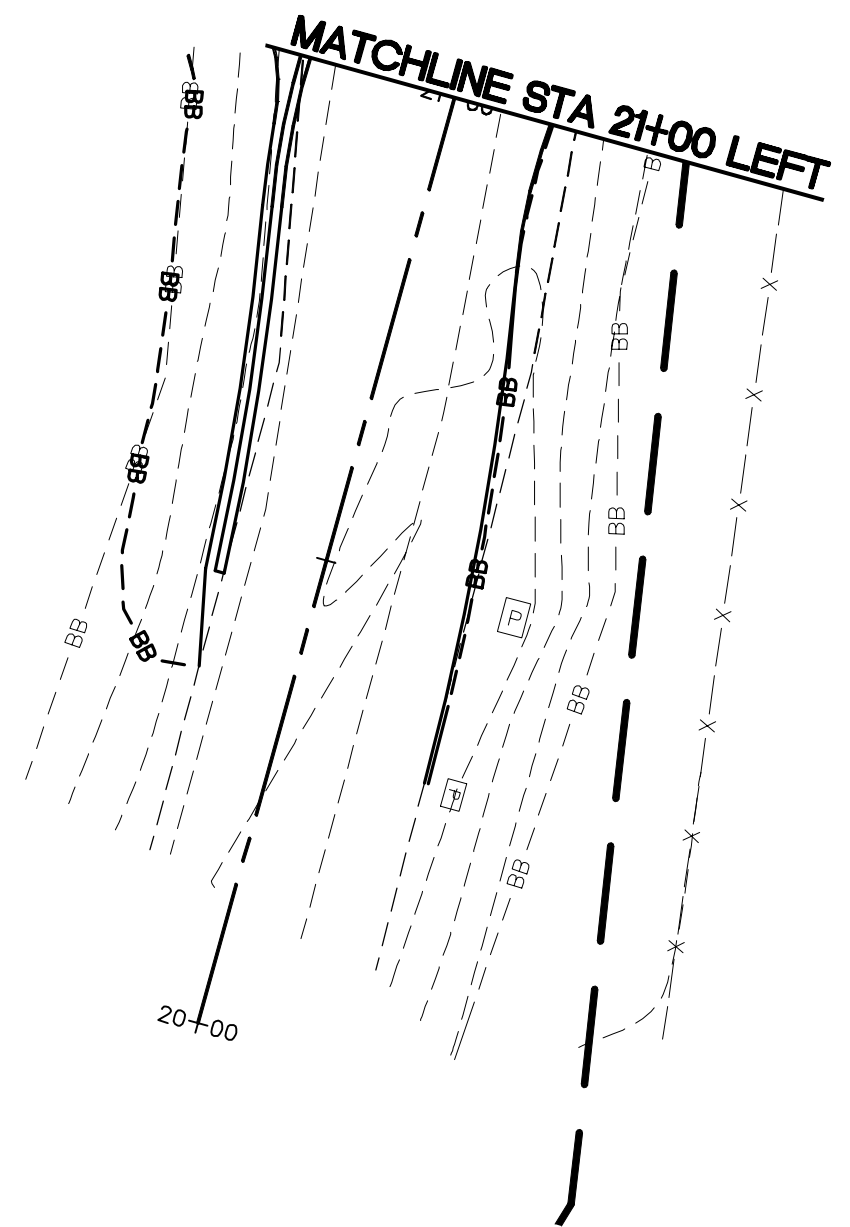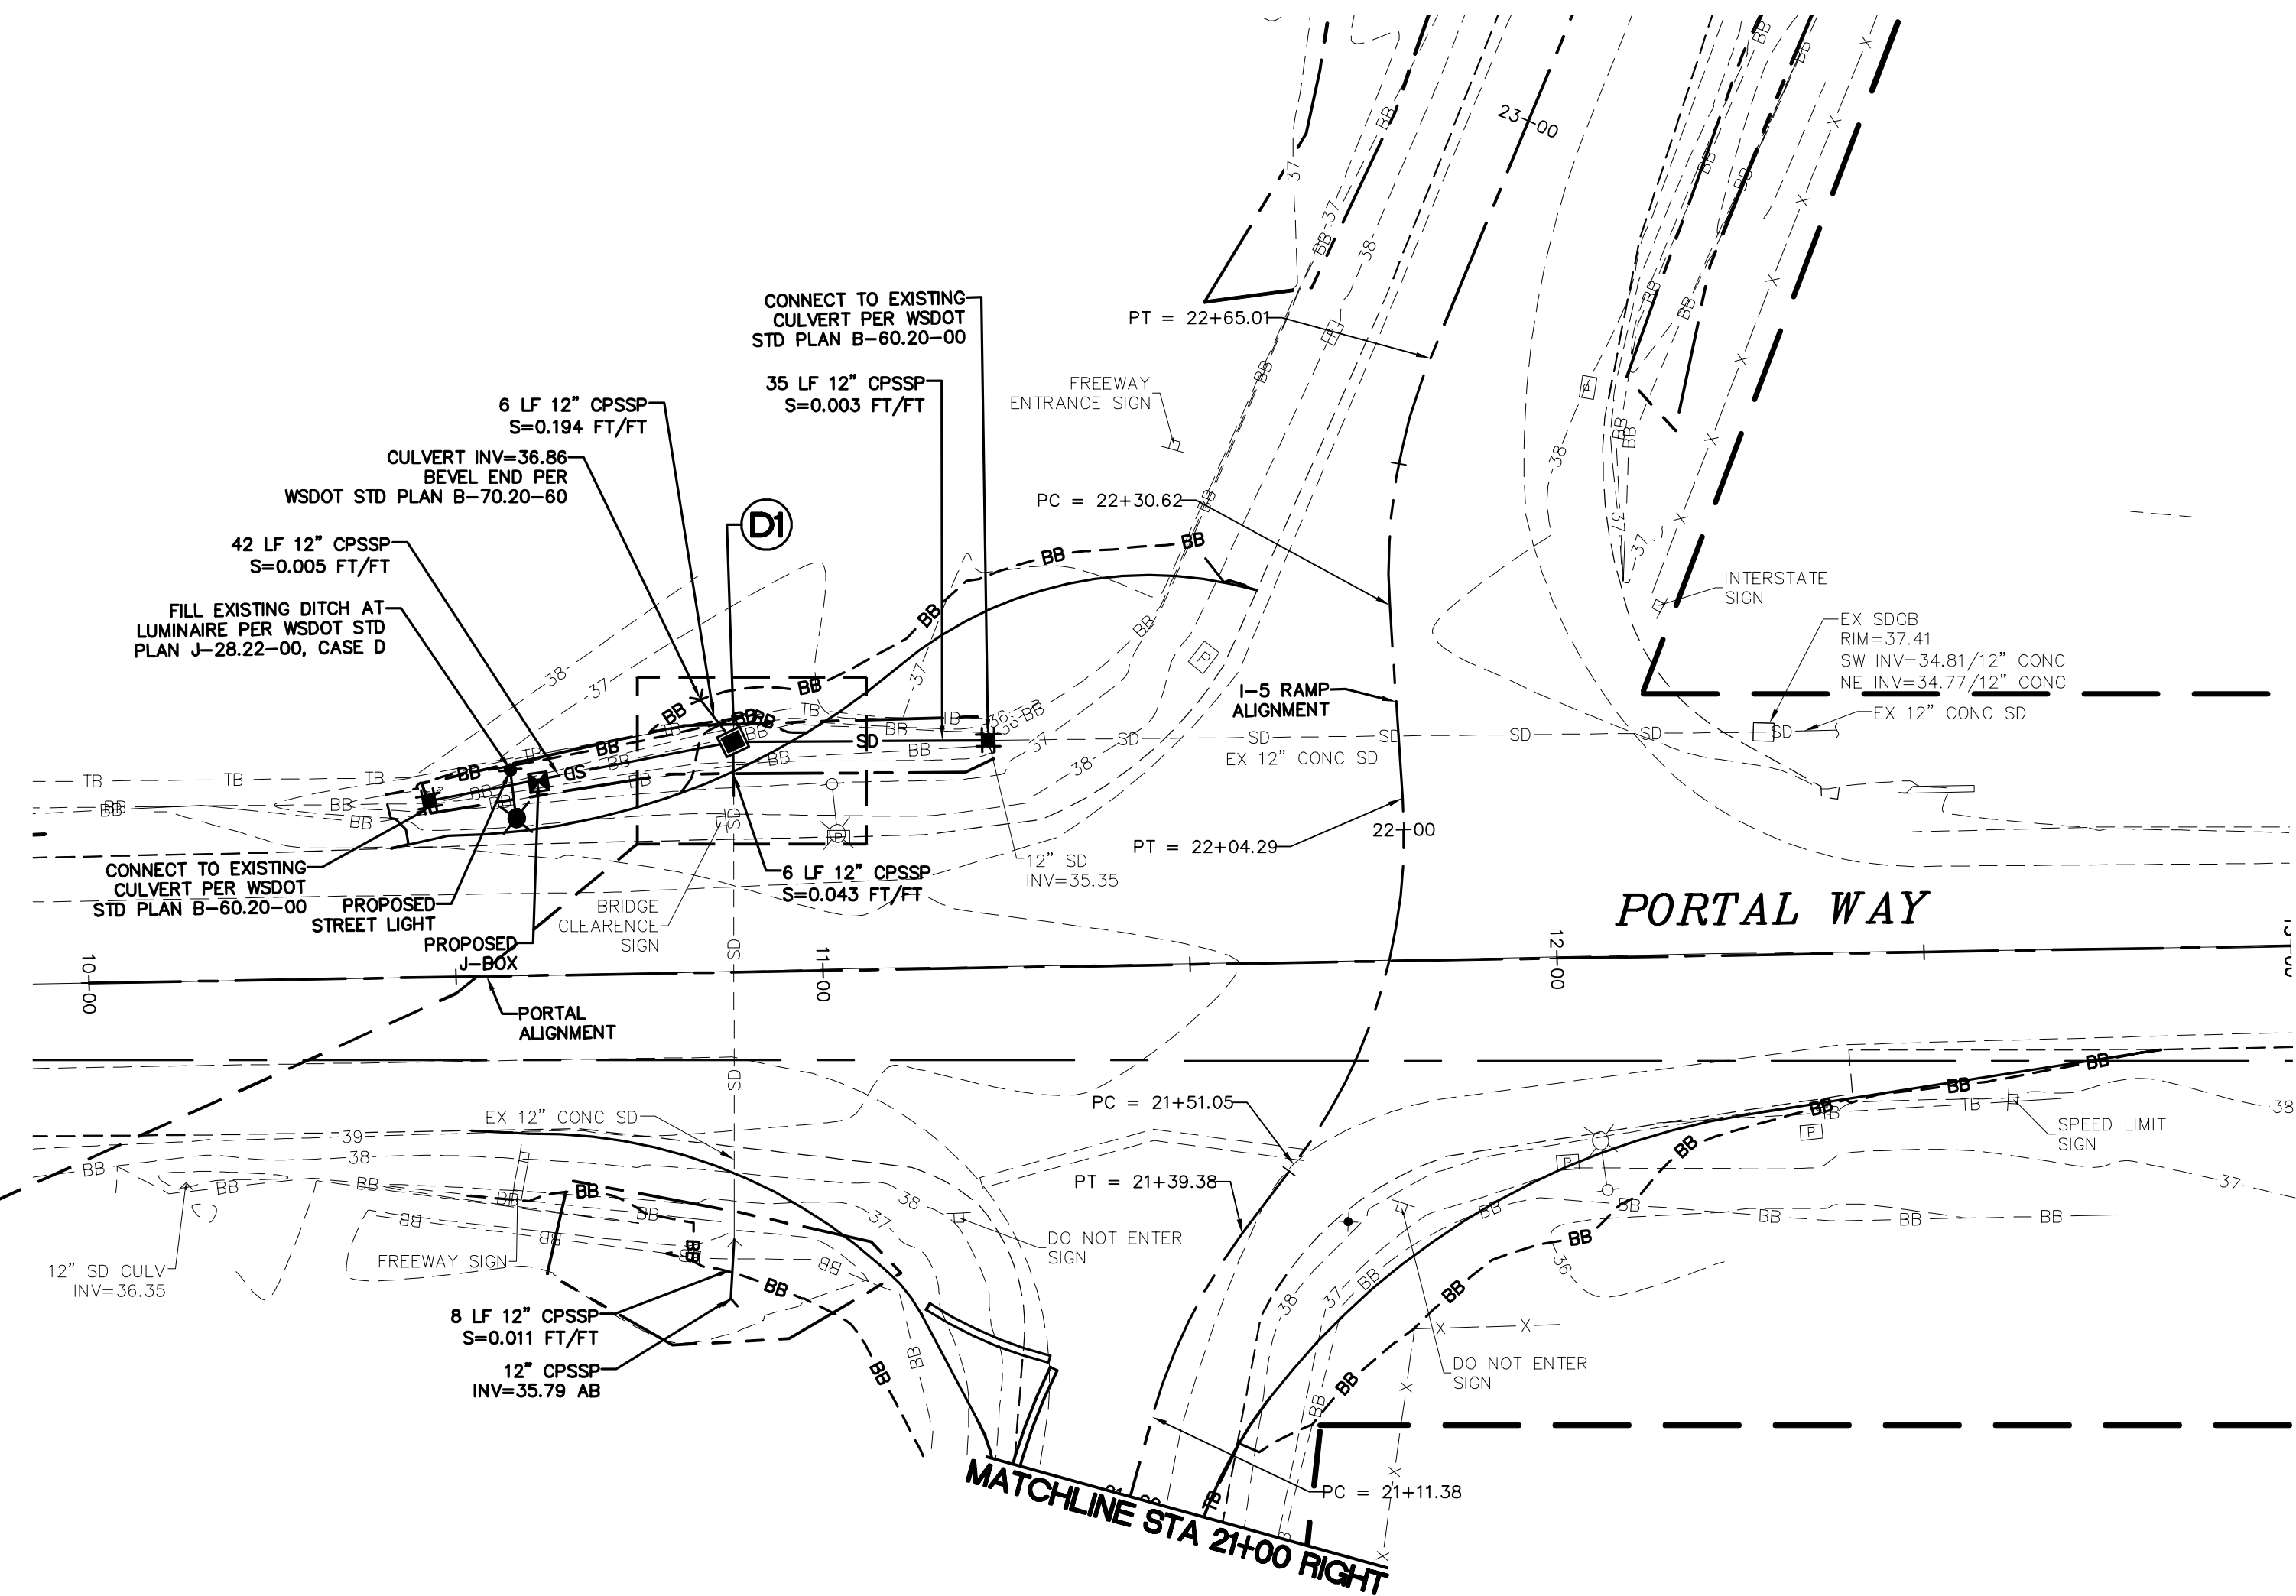

PHASE 1  
PLAN AND PROFILE

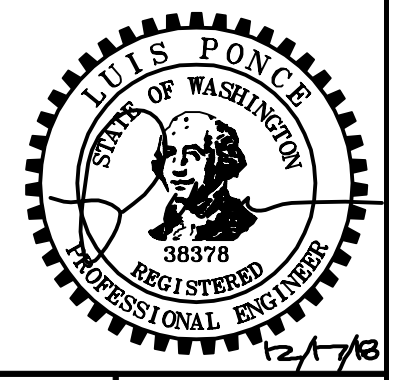

12/17/18  
AS-BUILT

DESIGNED BY  
LP  
DRAWN BY  
RWG  
CHECKED BY  
LP



**R&E** Reichhardt & Ebe  
ENGINEERING INC  
P.O. Box 978 | 423 Front Street, Lynden, WA 98264 (360) 354-3687  
813 Metcalf Street, Sedro-Woolley, WA 98284 (360) 855-1713

NO.	DATE	DESCRIPTION	BY

CITY OF FERNDAL  
2095 MAIN ST  
FERNDAL, WA 98248

PORTAL WAY / I-5  
ROUNDAUT IMPROVEMENTS  
PLAN AND PROFILE - PORTAL WAY - PHASE 1

DWG 16033 PLAN AND PROFILE	DATE 12/17/2018
JOB# 16033	SHEET 14 of 20
SCALE H: 1"=20' V: 1"=2'	

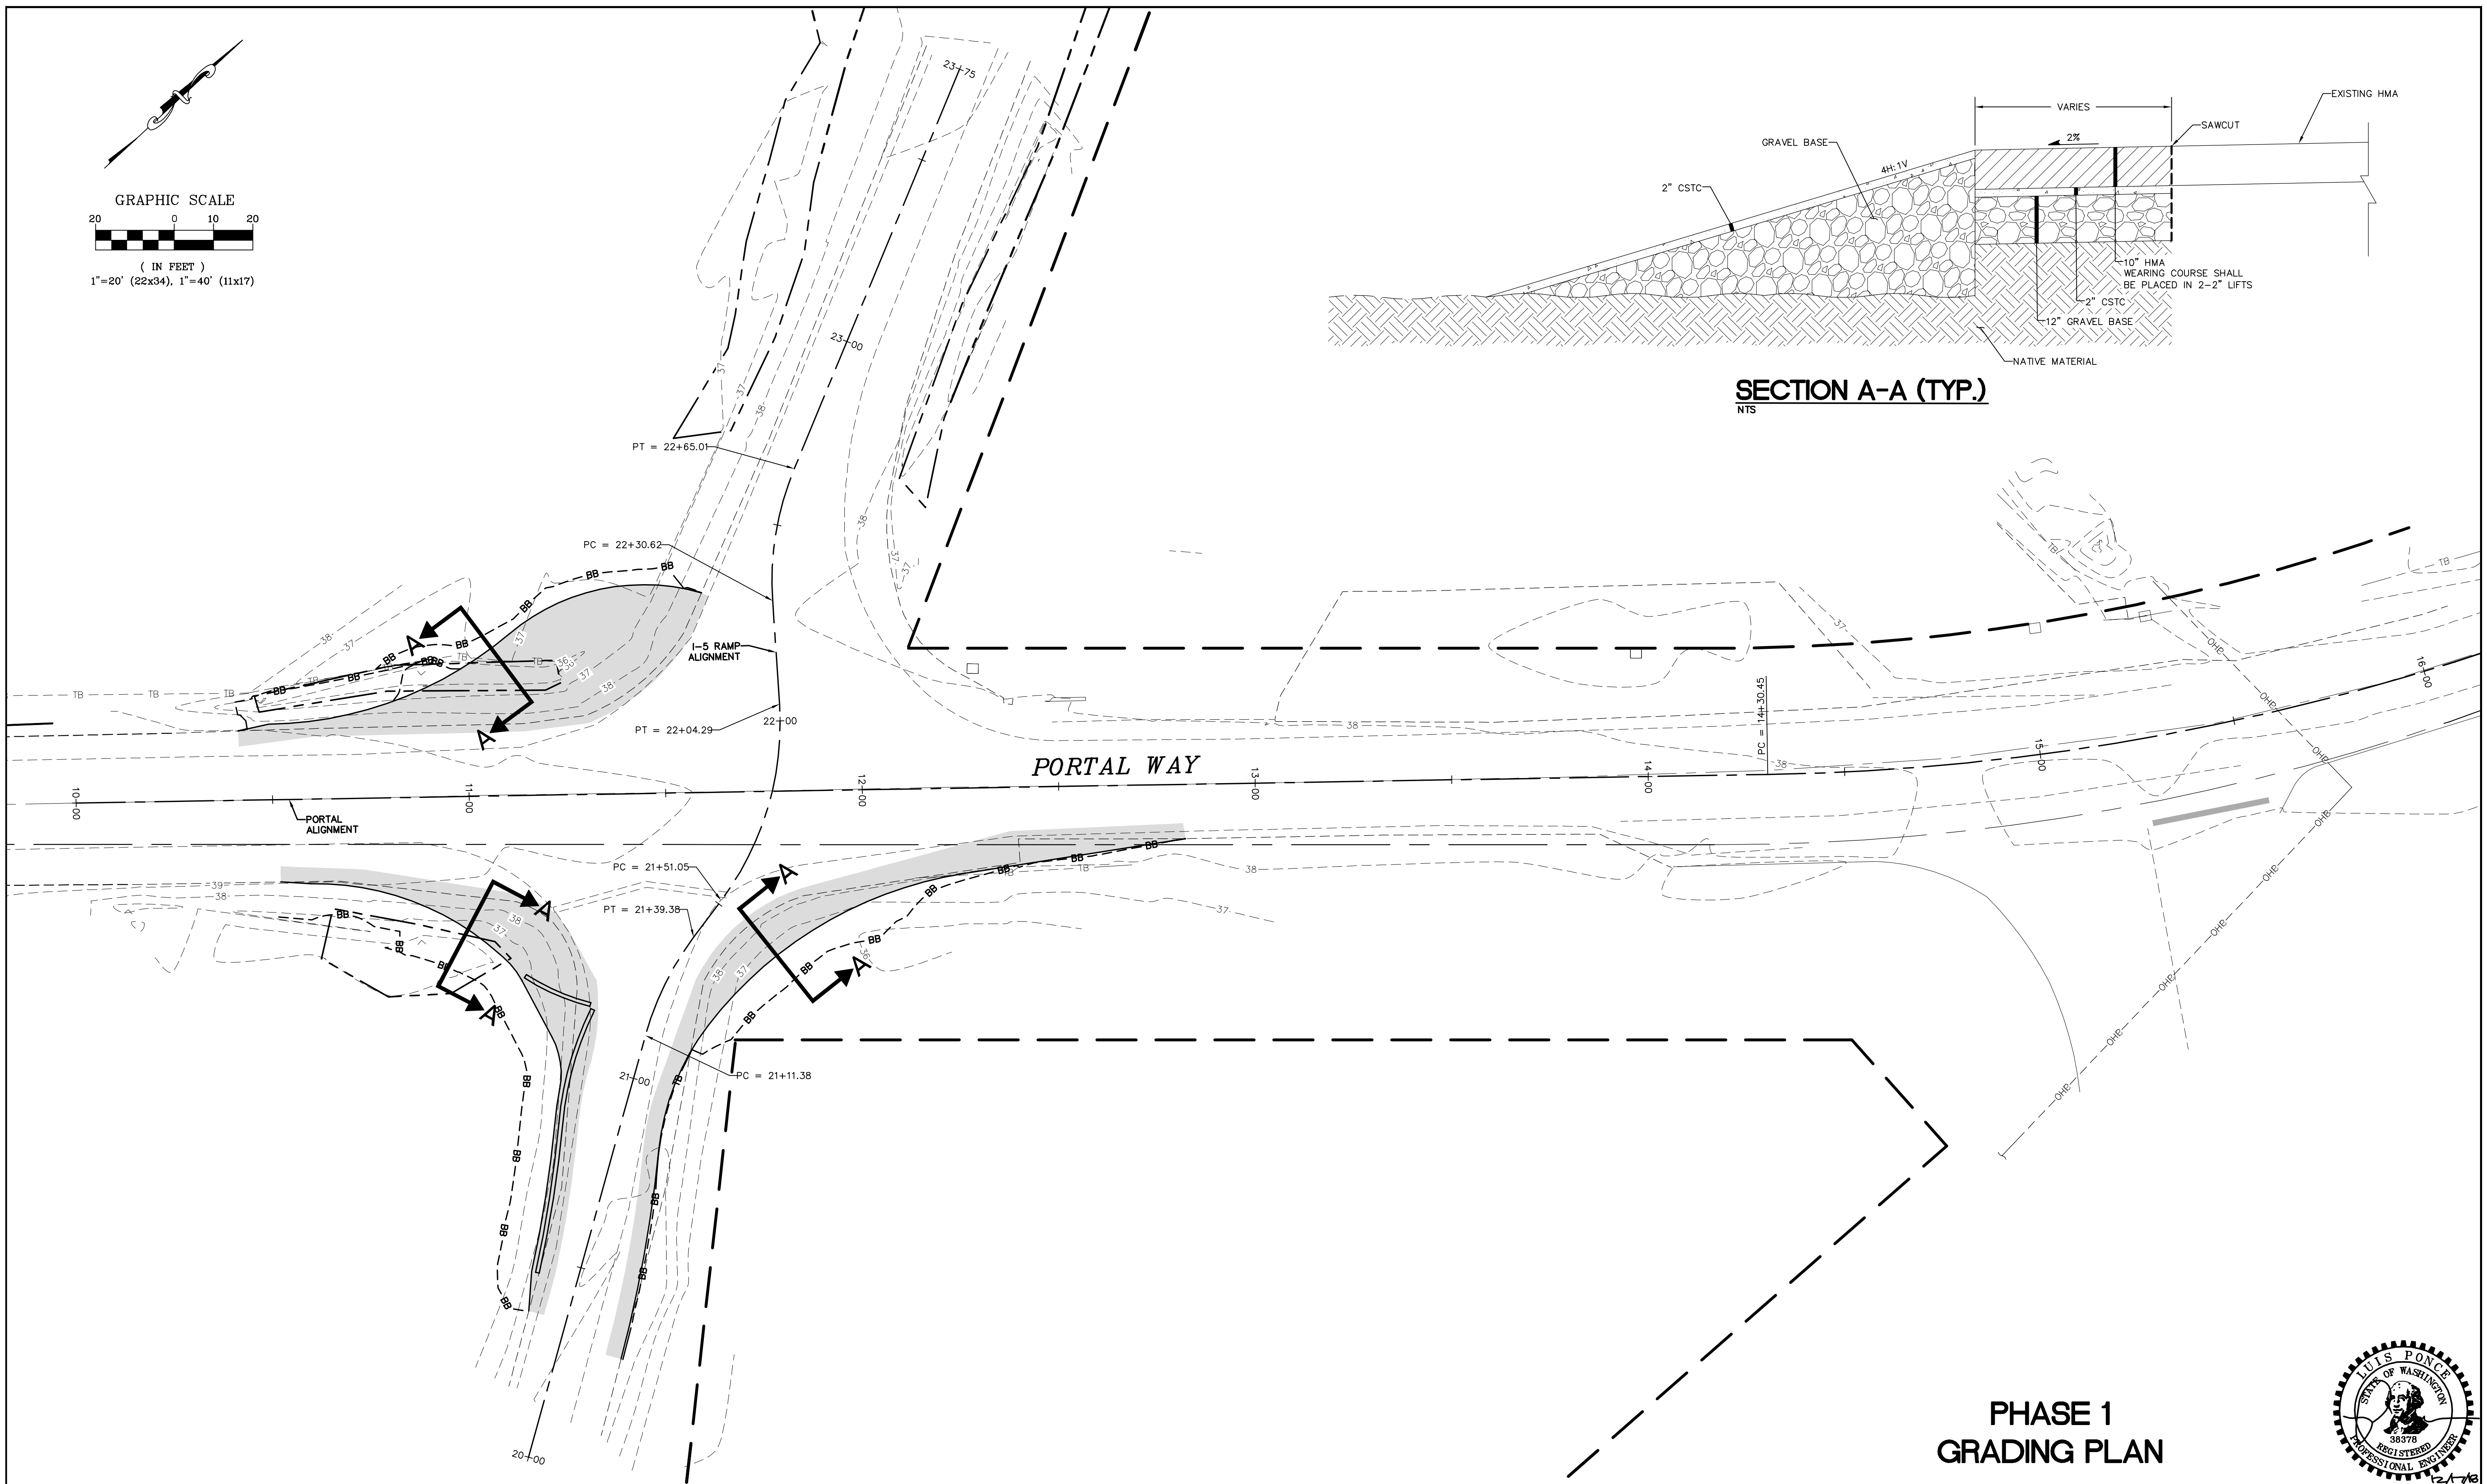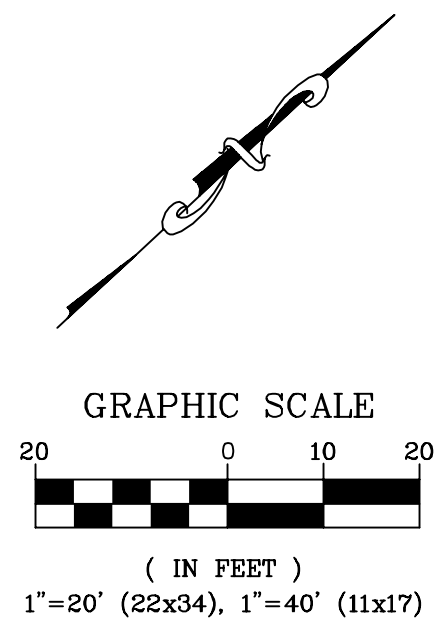

SECTION A-A (TYP.)  
NTS

PHASE 1  
GRADING PLAN



SUBMITTED WITH  
DESIGN PLAN

DESIGNED BY  
LP  
DRAWN BY  
RWG/LMH  
CHECKED BY  
LP



**R&E** Reichhardt & Ebe  
ENGINEERING INC  
P.O. Box 978 | 423 Front Street, Lynden, WA 98264 (360) 354-3687  
813 Metcalf Street, Sedro-Woolley, WA 98284 (360) 855-1713

NO.	DATE	DESCRIPTION	BY

CITY OF FERNDAL  
2095 MAIN ST  
FERNDAL, WA 98248

PORTAL WAY / I-5  
ROUNABOUT IMPROVEMENTS  
GRADING PLAN - PHASE 1

DWG 16033 GRADING		DATE 12/17/2018
JOB# 16033	SCALE H: 1"=20' V: N/A	SHEET 15 of 20

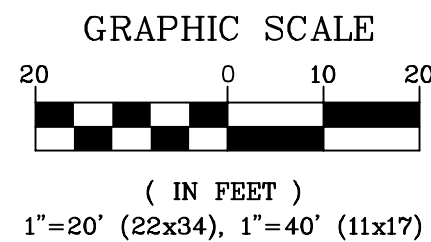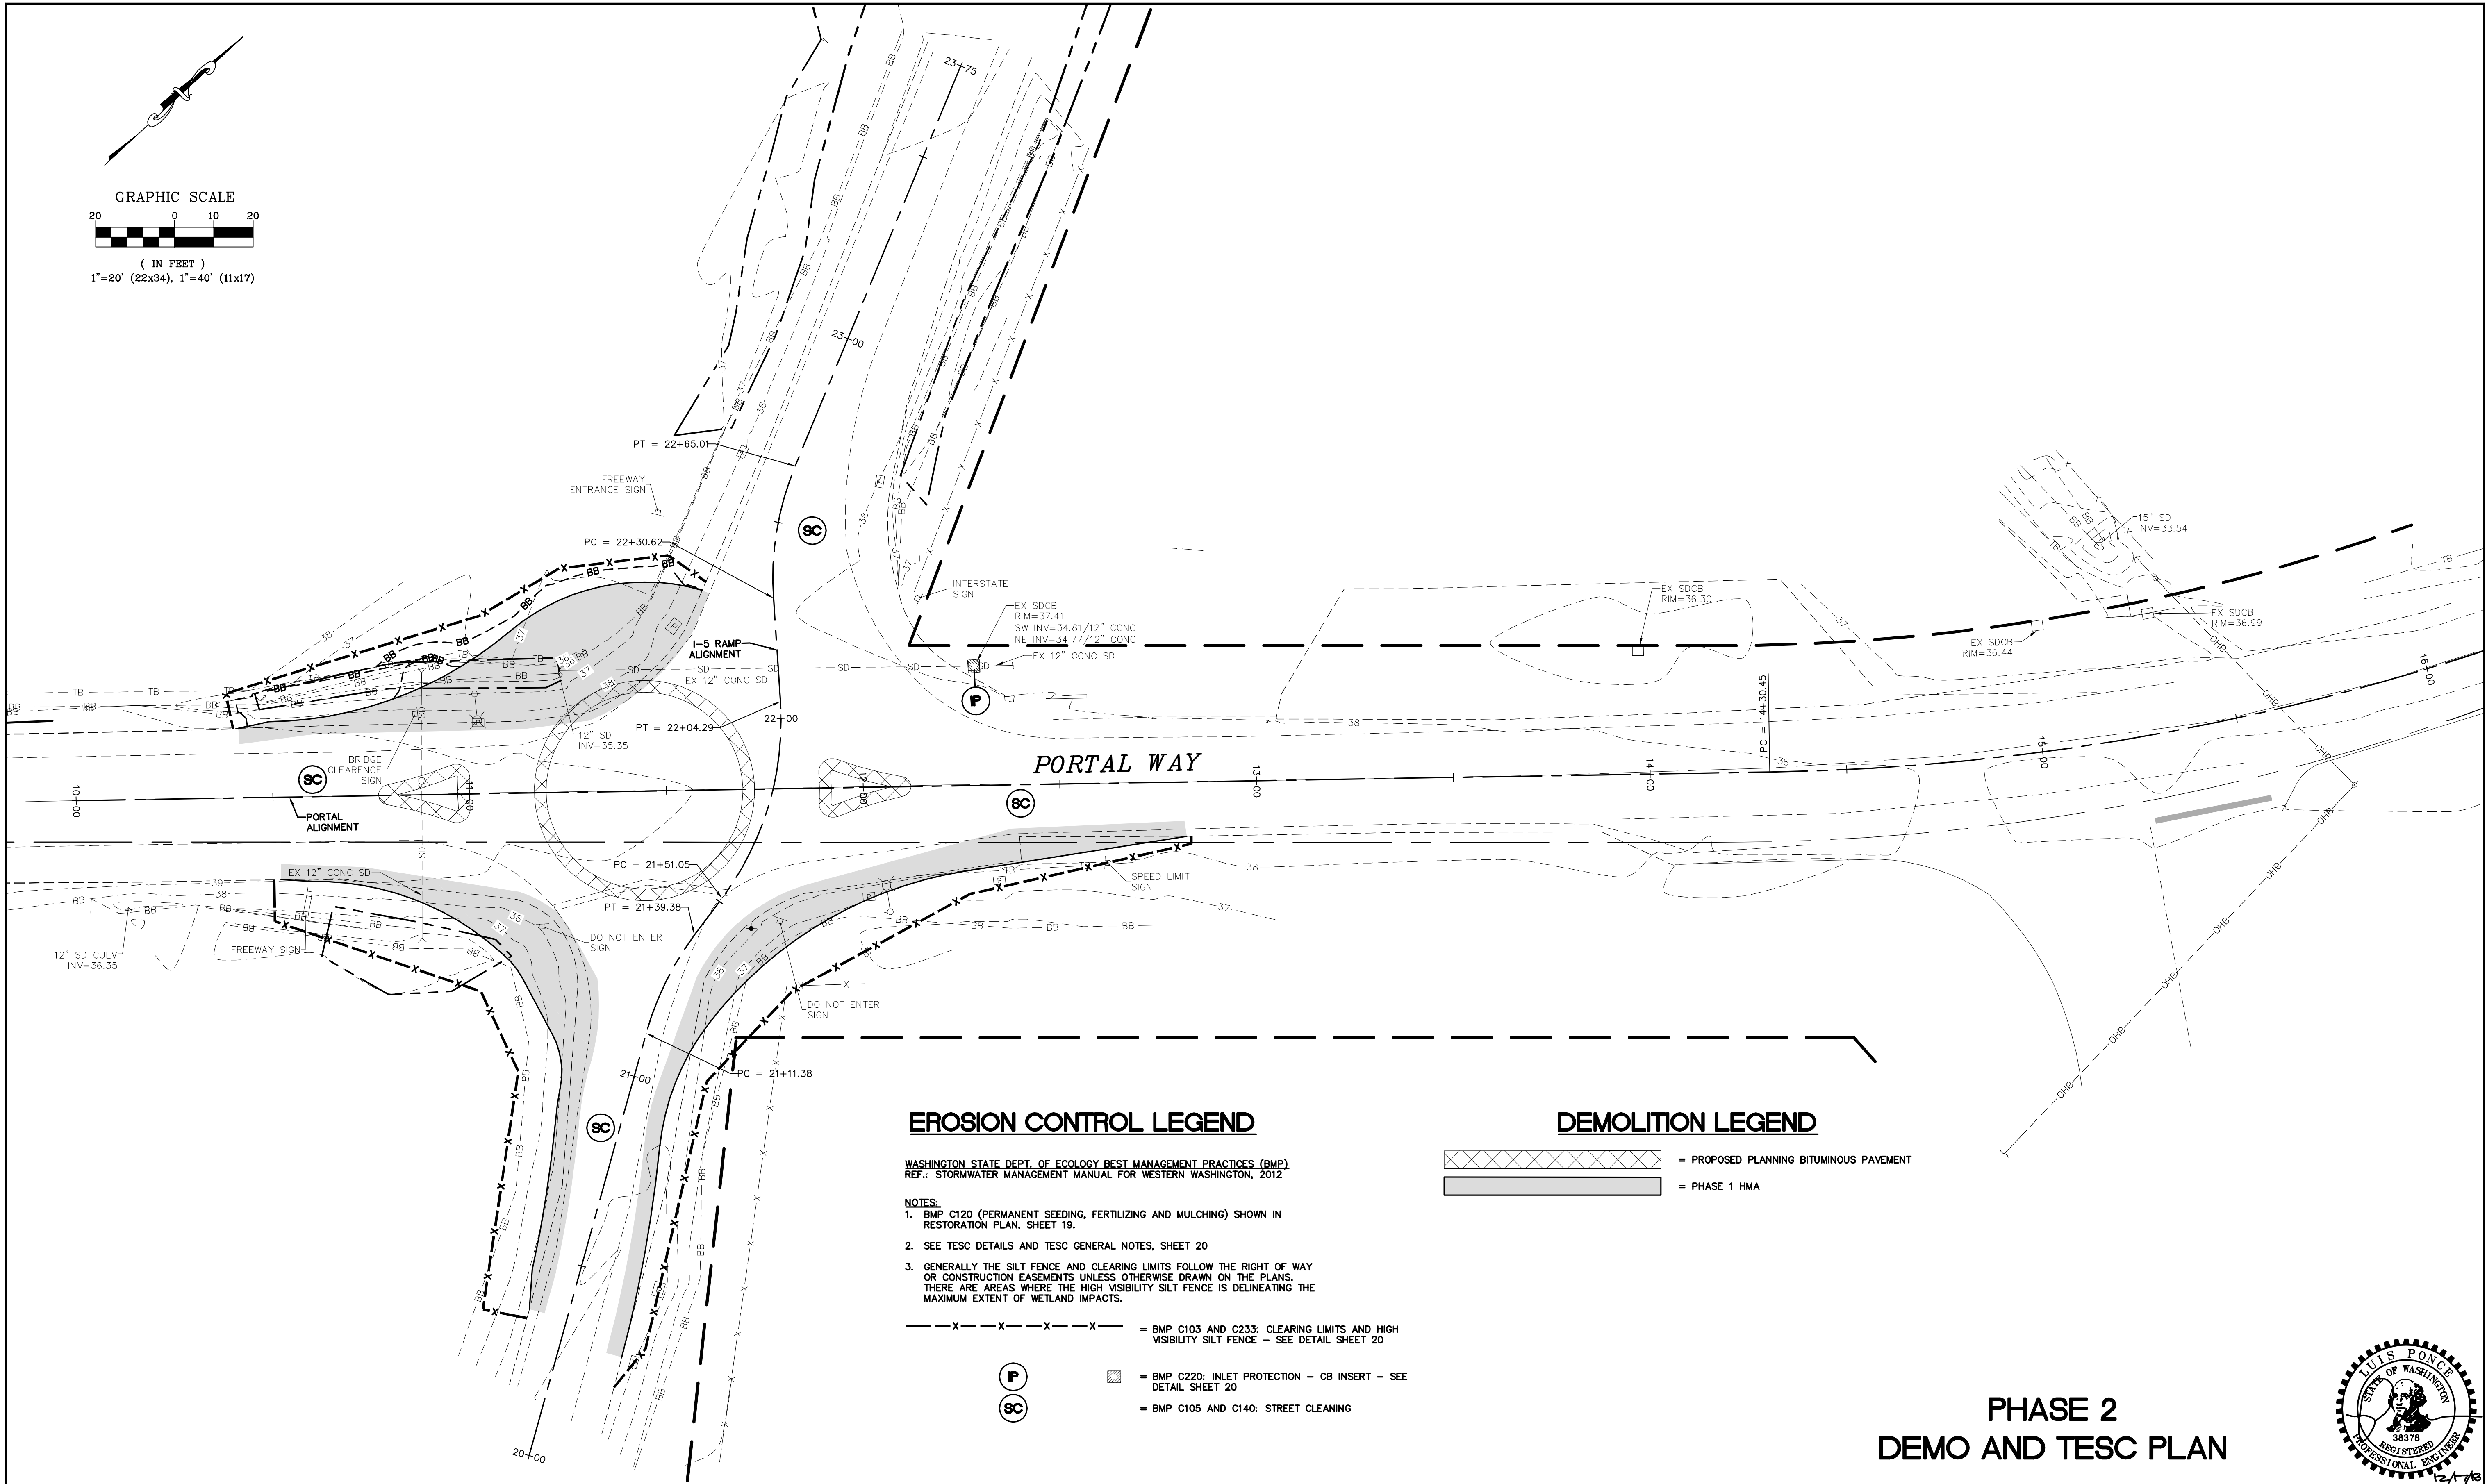

EROSION CONTROL LEGEND

WASHINGTON STATE DEPT. OF ECOLOGY BEST MANAGEMENT PRACTICES (BMP)  
REF.: STORMWATER MANAGEMENT MANUAL FOR WESTERN WASHINGTON, 2012


- NOTES:
- BMP C120 (PERMANENT SEEDING, FERTILIZING AND MULCHING) SHOWN IN RESTORATION PLAN, SHEET 19.
  - SEE TESC DETAILS AND TESC GENERAL NOTES, SHEET 20
  - GENERALLY THE SILT FENCE AND CLEARING LIMITS FOLLOW THE RIGHT OF WAY OR CONSTRUCTION EASEMENTS UNLESS OTHERWISE DRAWN ON THE PLANS. THERE ARE AREAS WHERE THE HIGH VISIBILITY SILT FENCE IS DELINEATING THE MAXIMUM EXTENT OF WETLAND IMPACTS.

- X --- X --- X --- X --- = BMP C103 AND C233: CLEARING LIMITS AND HIGH VISIBILITY SILT FENCE -- SEE DETAIL SHEET 20
- (P) = BMP C220: INLET PROTECTION -- CB INSERT -- SEE DETAIL SHEET 20
- (SC) = BMP C105 AND C140: STREET CLEANING

DEMOLITION LEGEND

- [Pattern] = PROPOSED PLANNING BITUMINOUS PAVEMENT
- [Pattern] = PHASE 1 HMA

PHASE 2  
DEMO AND TESC PLAN

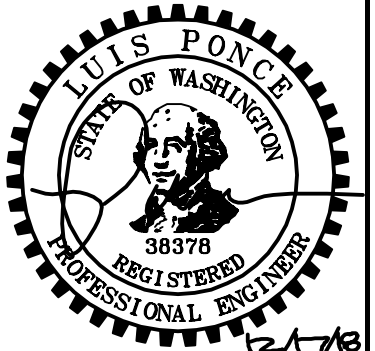

SUBMITTED WITH  
DESIGN PLAN

DESIGNED BY  
LP/OAM  
DRAWN BY  
OAM/LMH  
CHECKED BY  
LP

**R&E** Reichhardt & Ebe  
ENGINEERING INC  
P.O. Box 978 | 423 Front Street, Lynden, WA 98264 (360) 354-3687  
813 Metcalf Street, Sedro-Woolley, WA 98284 (360) 855-1713


NO.	DATE	DESCRIPTION	BY

CITY OF FERNDAL  
2095 MAIN ST  
FERNDAL, WA 98248



PORTAL WAY / I-5  
ROUNABOUT IMPROVEMENTS  
DEMO AND TESC PLAN - PHASE 2

DWG 16033 EXCOND, TESC, DEMO	DATE 12/17/2018
JOB# 16033	SHEET 16 of 20
SCALE H: 1"=20' V: N/A	




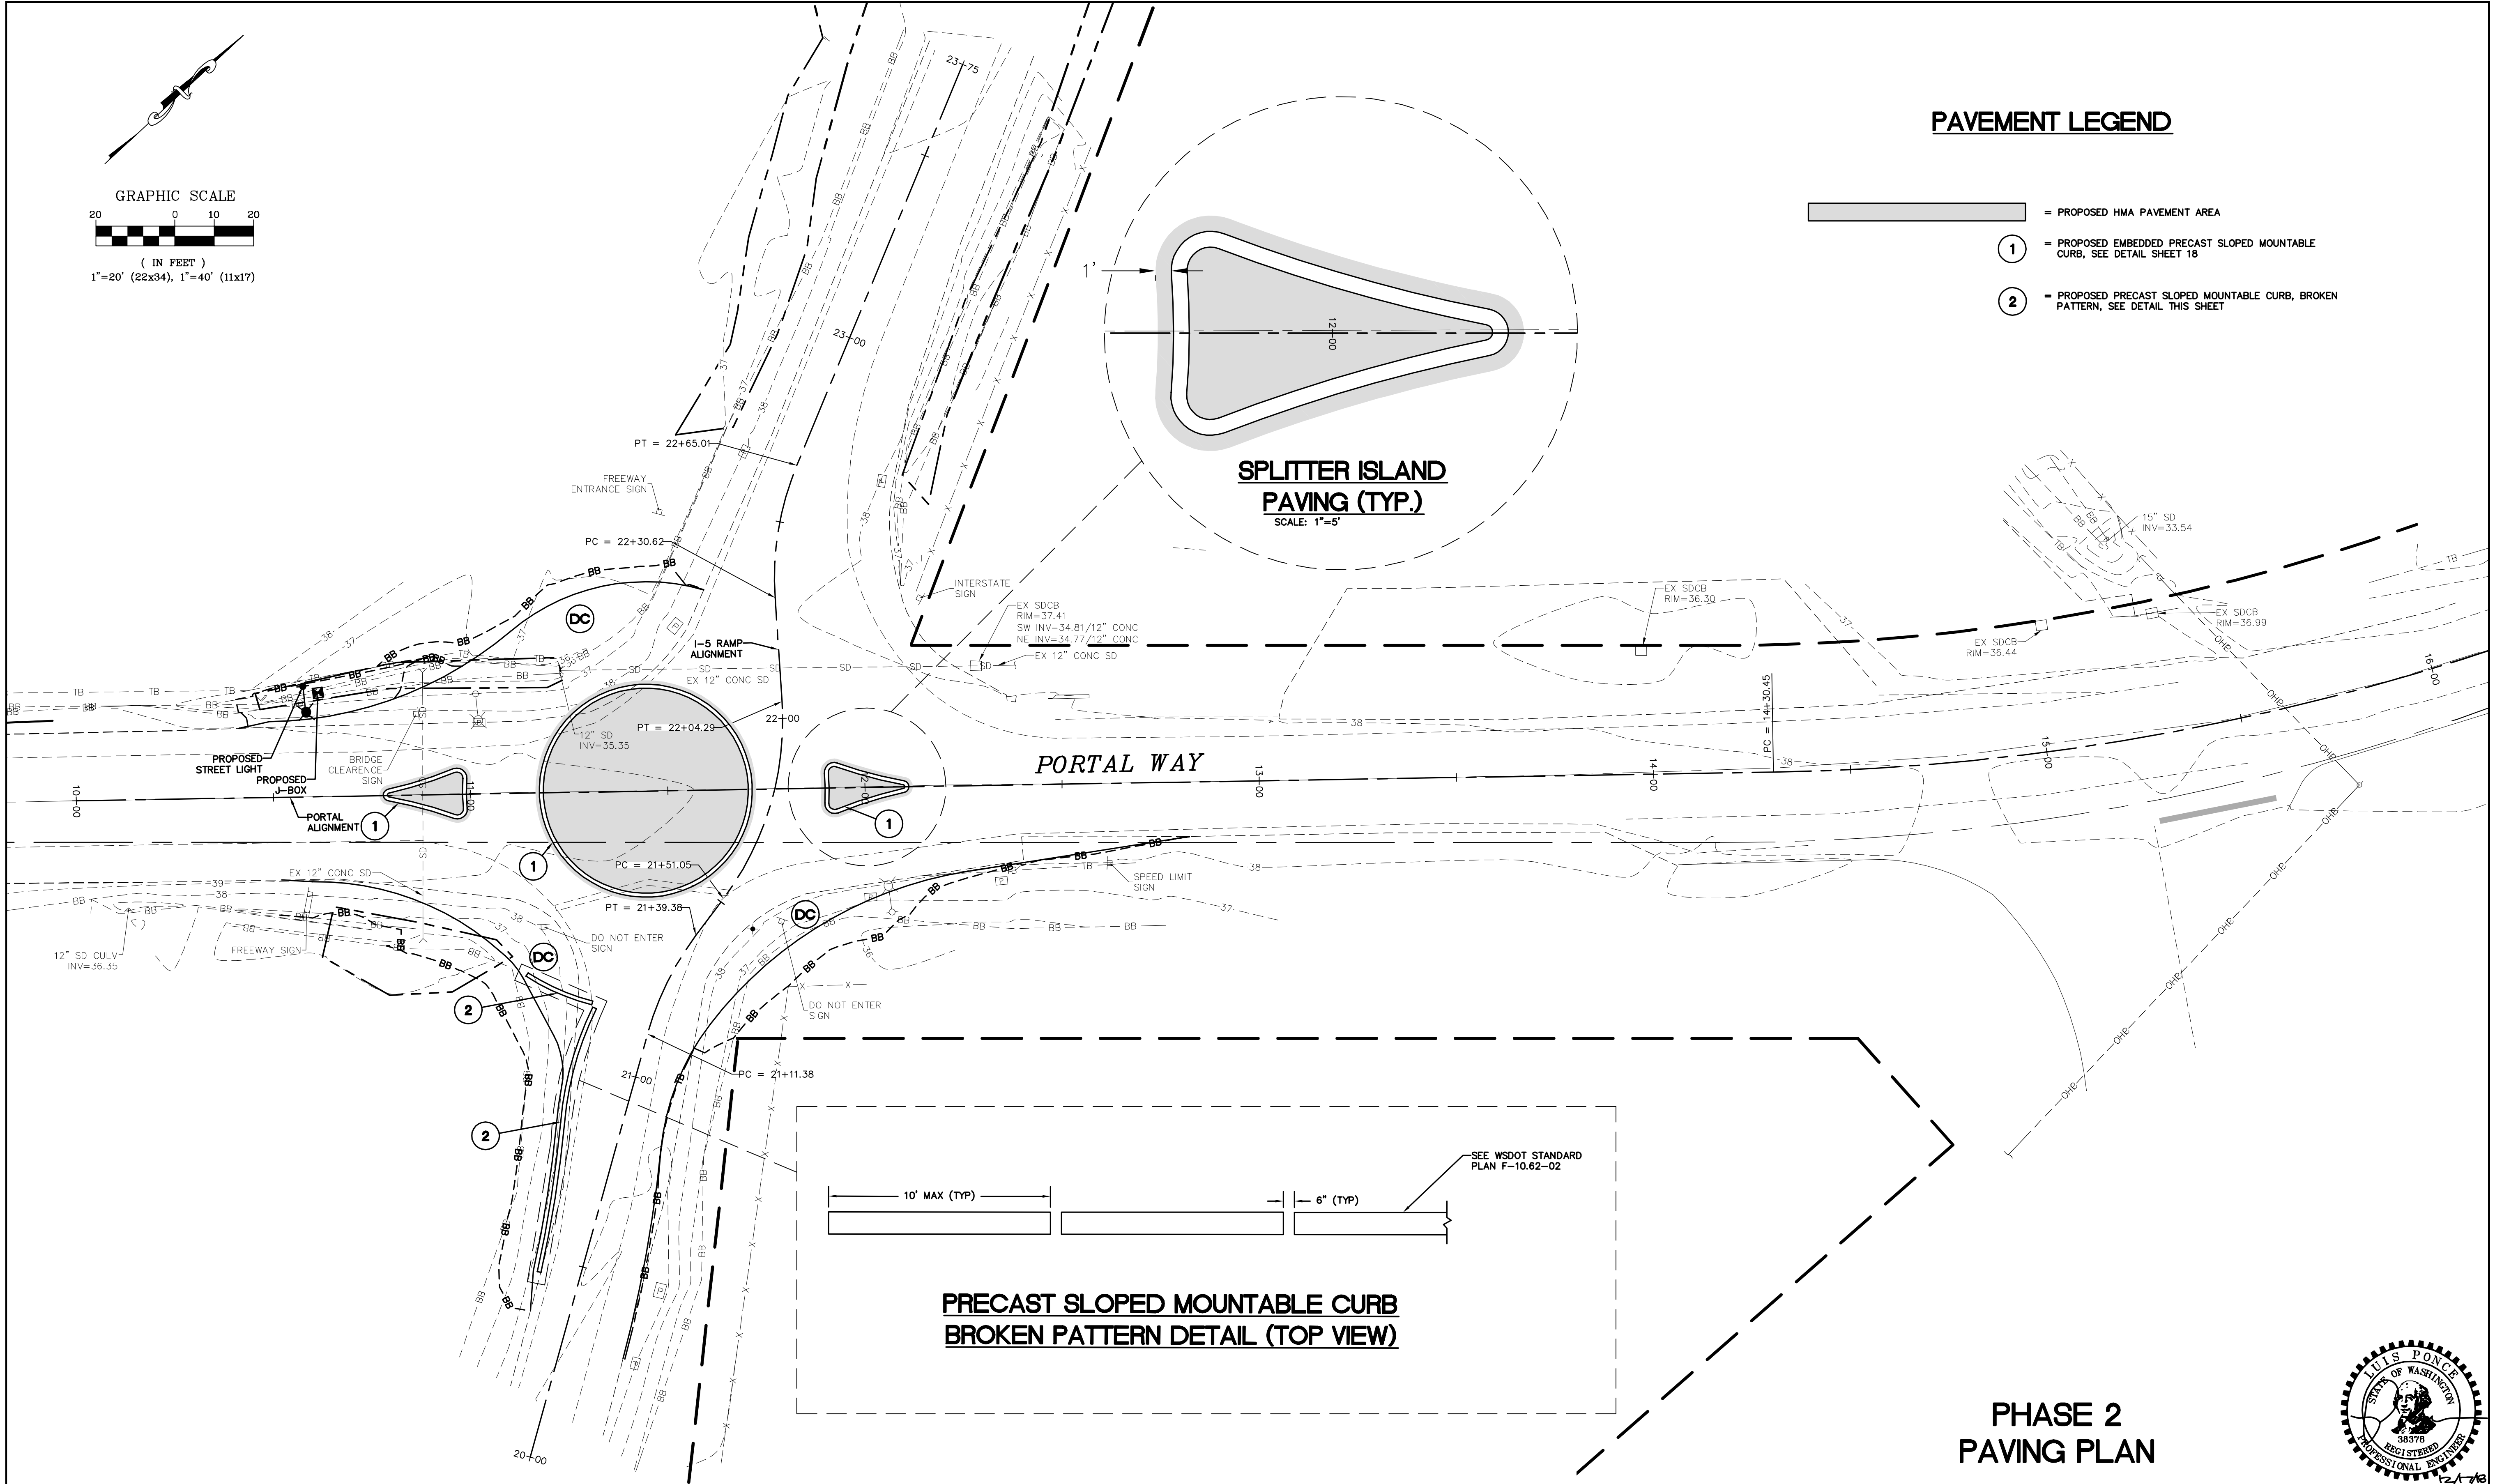


<div>12/17/18</div> <div>AS-BUILT</div>	DESIGNED BY LP/OAM	<div><div>R&amp;E</div><div>Reichhardt &amp; Ebe</div><div>ENGINEERING INC</div><div>P.O. Box 978   423 Front Street, Lynden, WA 98264 (360) 354-3687</div><div>813 Metcalf Street, Sedro-Woolley, WA 98284 (360) 855-1713</div></div>						CITY OF FERNDALE 2095 MAIN ST FERNDALE, WA 98248	PORTAL WAY / I-5 ROUNDAABOUT IMPROVEMENTS PAVING PLAN - PHASE 2	DWG 16033 EXCOND, TESC, DEMO		DATE 12/17/2018		
	DRAWN BY OAM/LMH											JOB#	SCALE	SHEET
	CHECKED BY LP											16033	H: 1"=20' V: N/A	17
														of 20
			NO.	DATE	DESCRIPTION		BY							

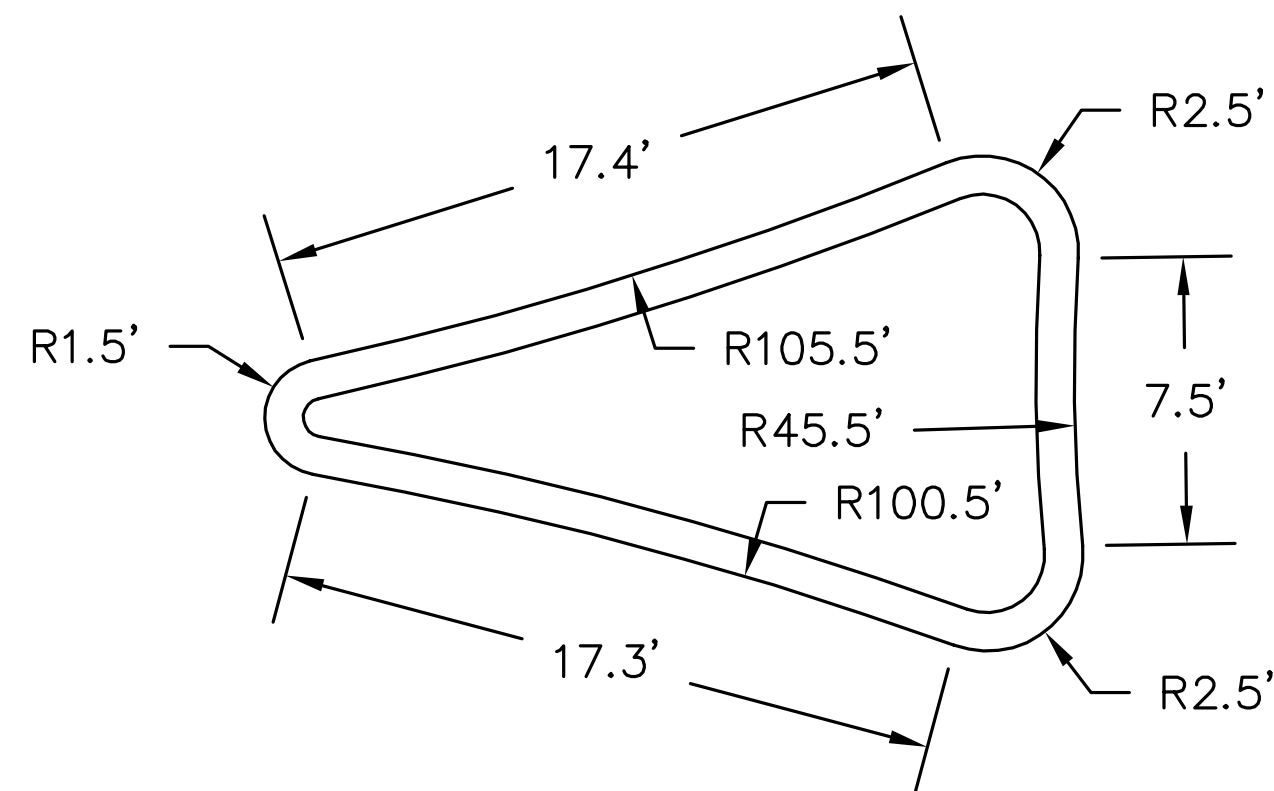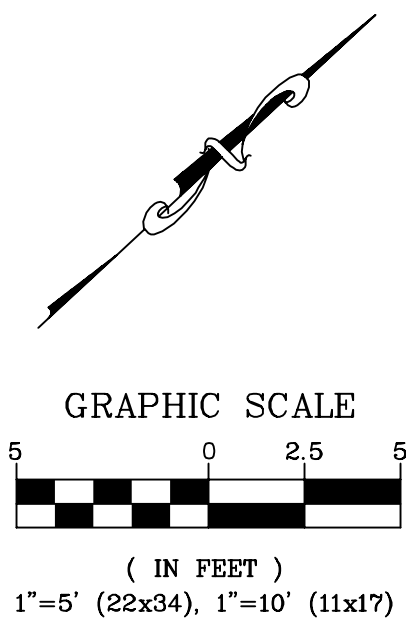

SPLITTER ISLAND DETAIL  
WEST LEG  
AREA=163.5 SQ. FT.

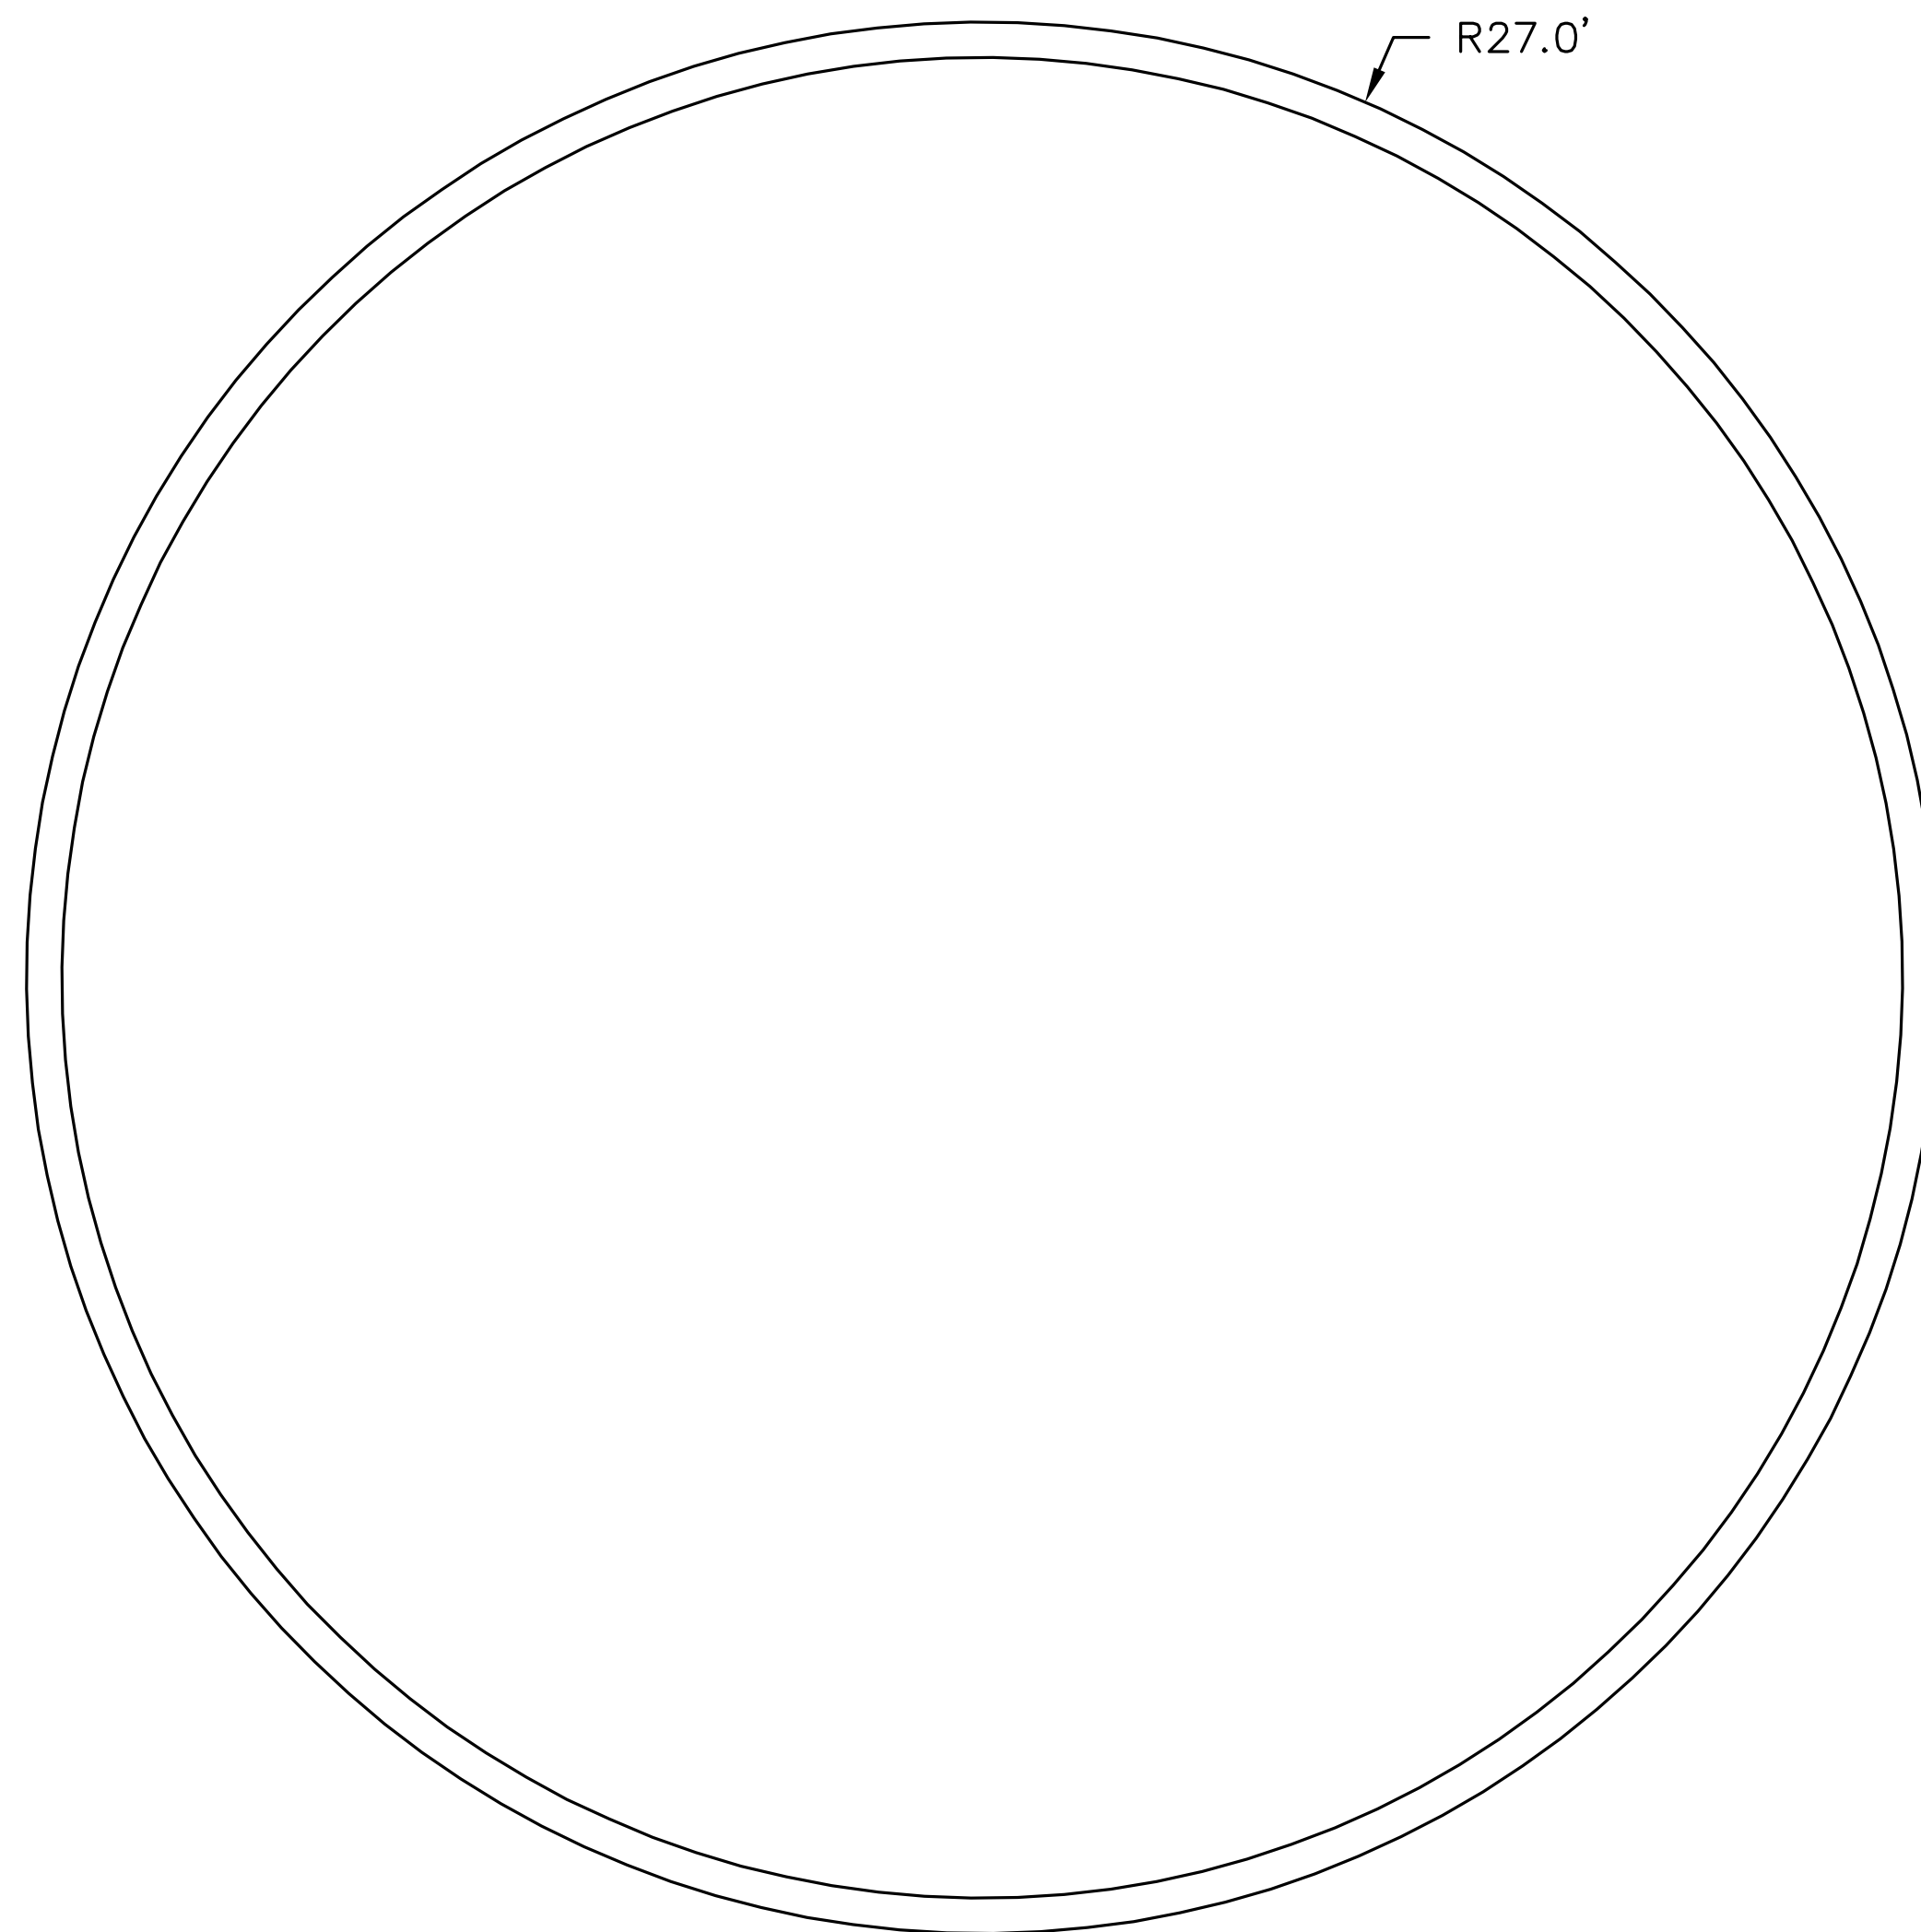


CENTER ISLAND DETAIL  
AREA=2,290.2 SQ. FT.

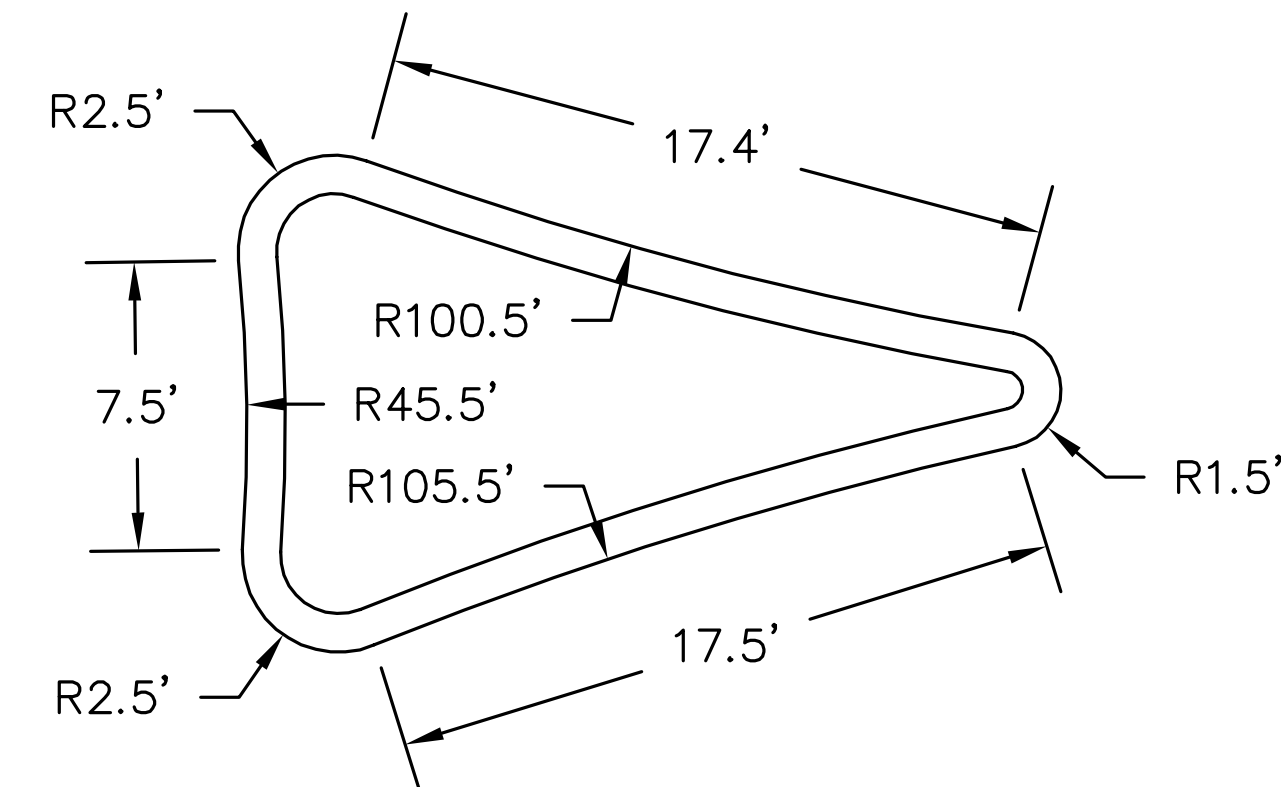


SPLITTER ISLAND DETAIL  
EAST LEG  
AREA=164.7 SQ. FT.

- GENERAL NOTES:
1. ALL DIMENSIONS ARE IN FEET UNLESS OTHERWISE NOTED.
  2. HMA IN SPLITTER & CENTER ISLANDS TO BE PAINTED YELLOW.

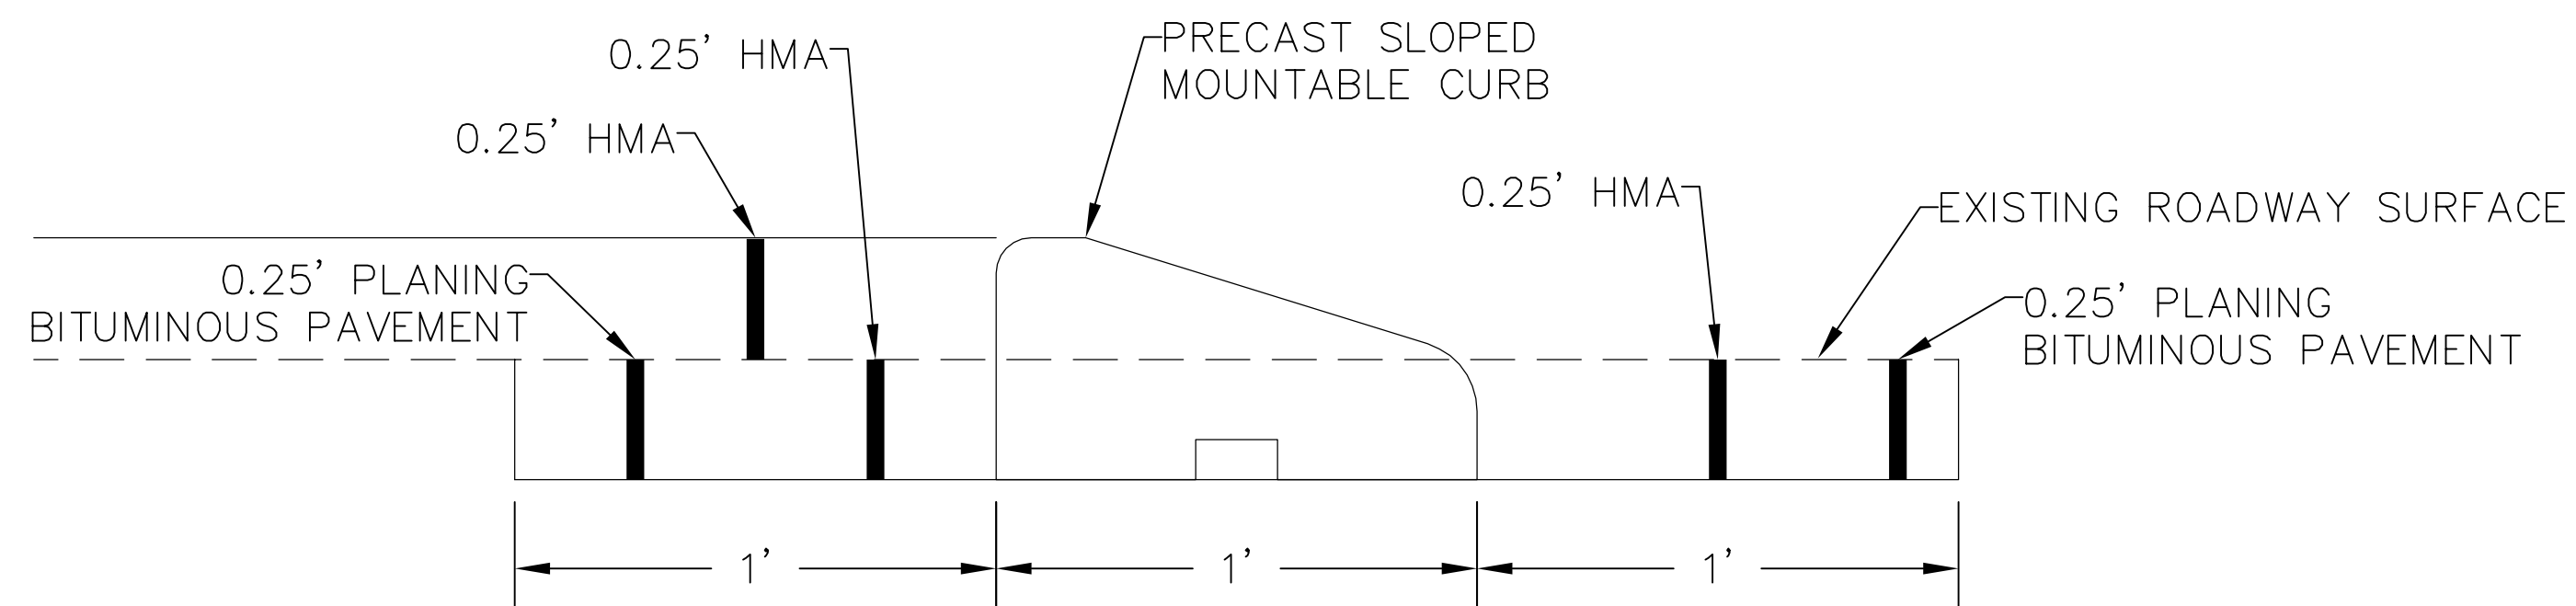

EMBEDDED CURB DETAIL  
NTS

## PHASE 2 TRAFFIC ISLAND

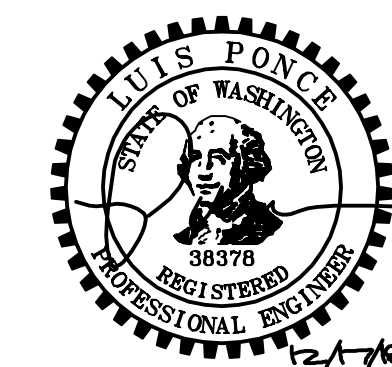

SUBMITTED WITH  
DESIGN PLAN

DESIGNED BY  
LP/OAM  
DRAWN BY  
OAM/LMH  
CHECKED BY  
LP


**R&E** Reichhardt & Ebe  
ENGINEERING INC  
P.O. Box 978 | 423 Front Street, Lynden, WA 98264 (360) 354-3687  
813 Metcalf Street, Sedro-Woolley, WA 98284 (360) 855-1713

NO.	DATE	DESCRIPTION	BY

CITY OF FERNDAL  
2095 MAIN ST  
FERNDAL, WA 98248

PORTAL WAY / I-5  
ROUNDAABOUT IMPROVEMENTS  
TRAFFIC ISLAND CURB DETAIL - PHASE 2

DWG 16033 EXCOND, TESC, DEMO	DATE 12/17/2018
JOB# 16033	SCALE H: 1"=5' V: N/A
SHEET 18 of 20	

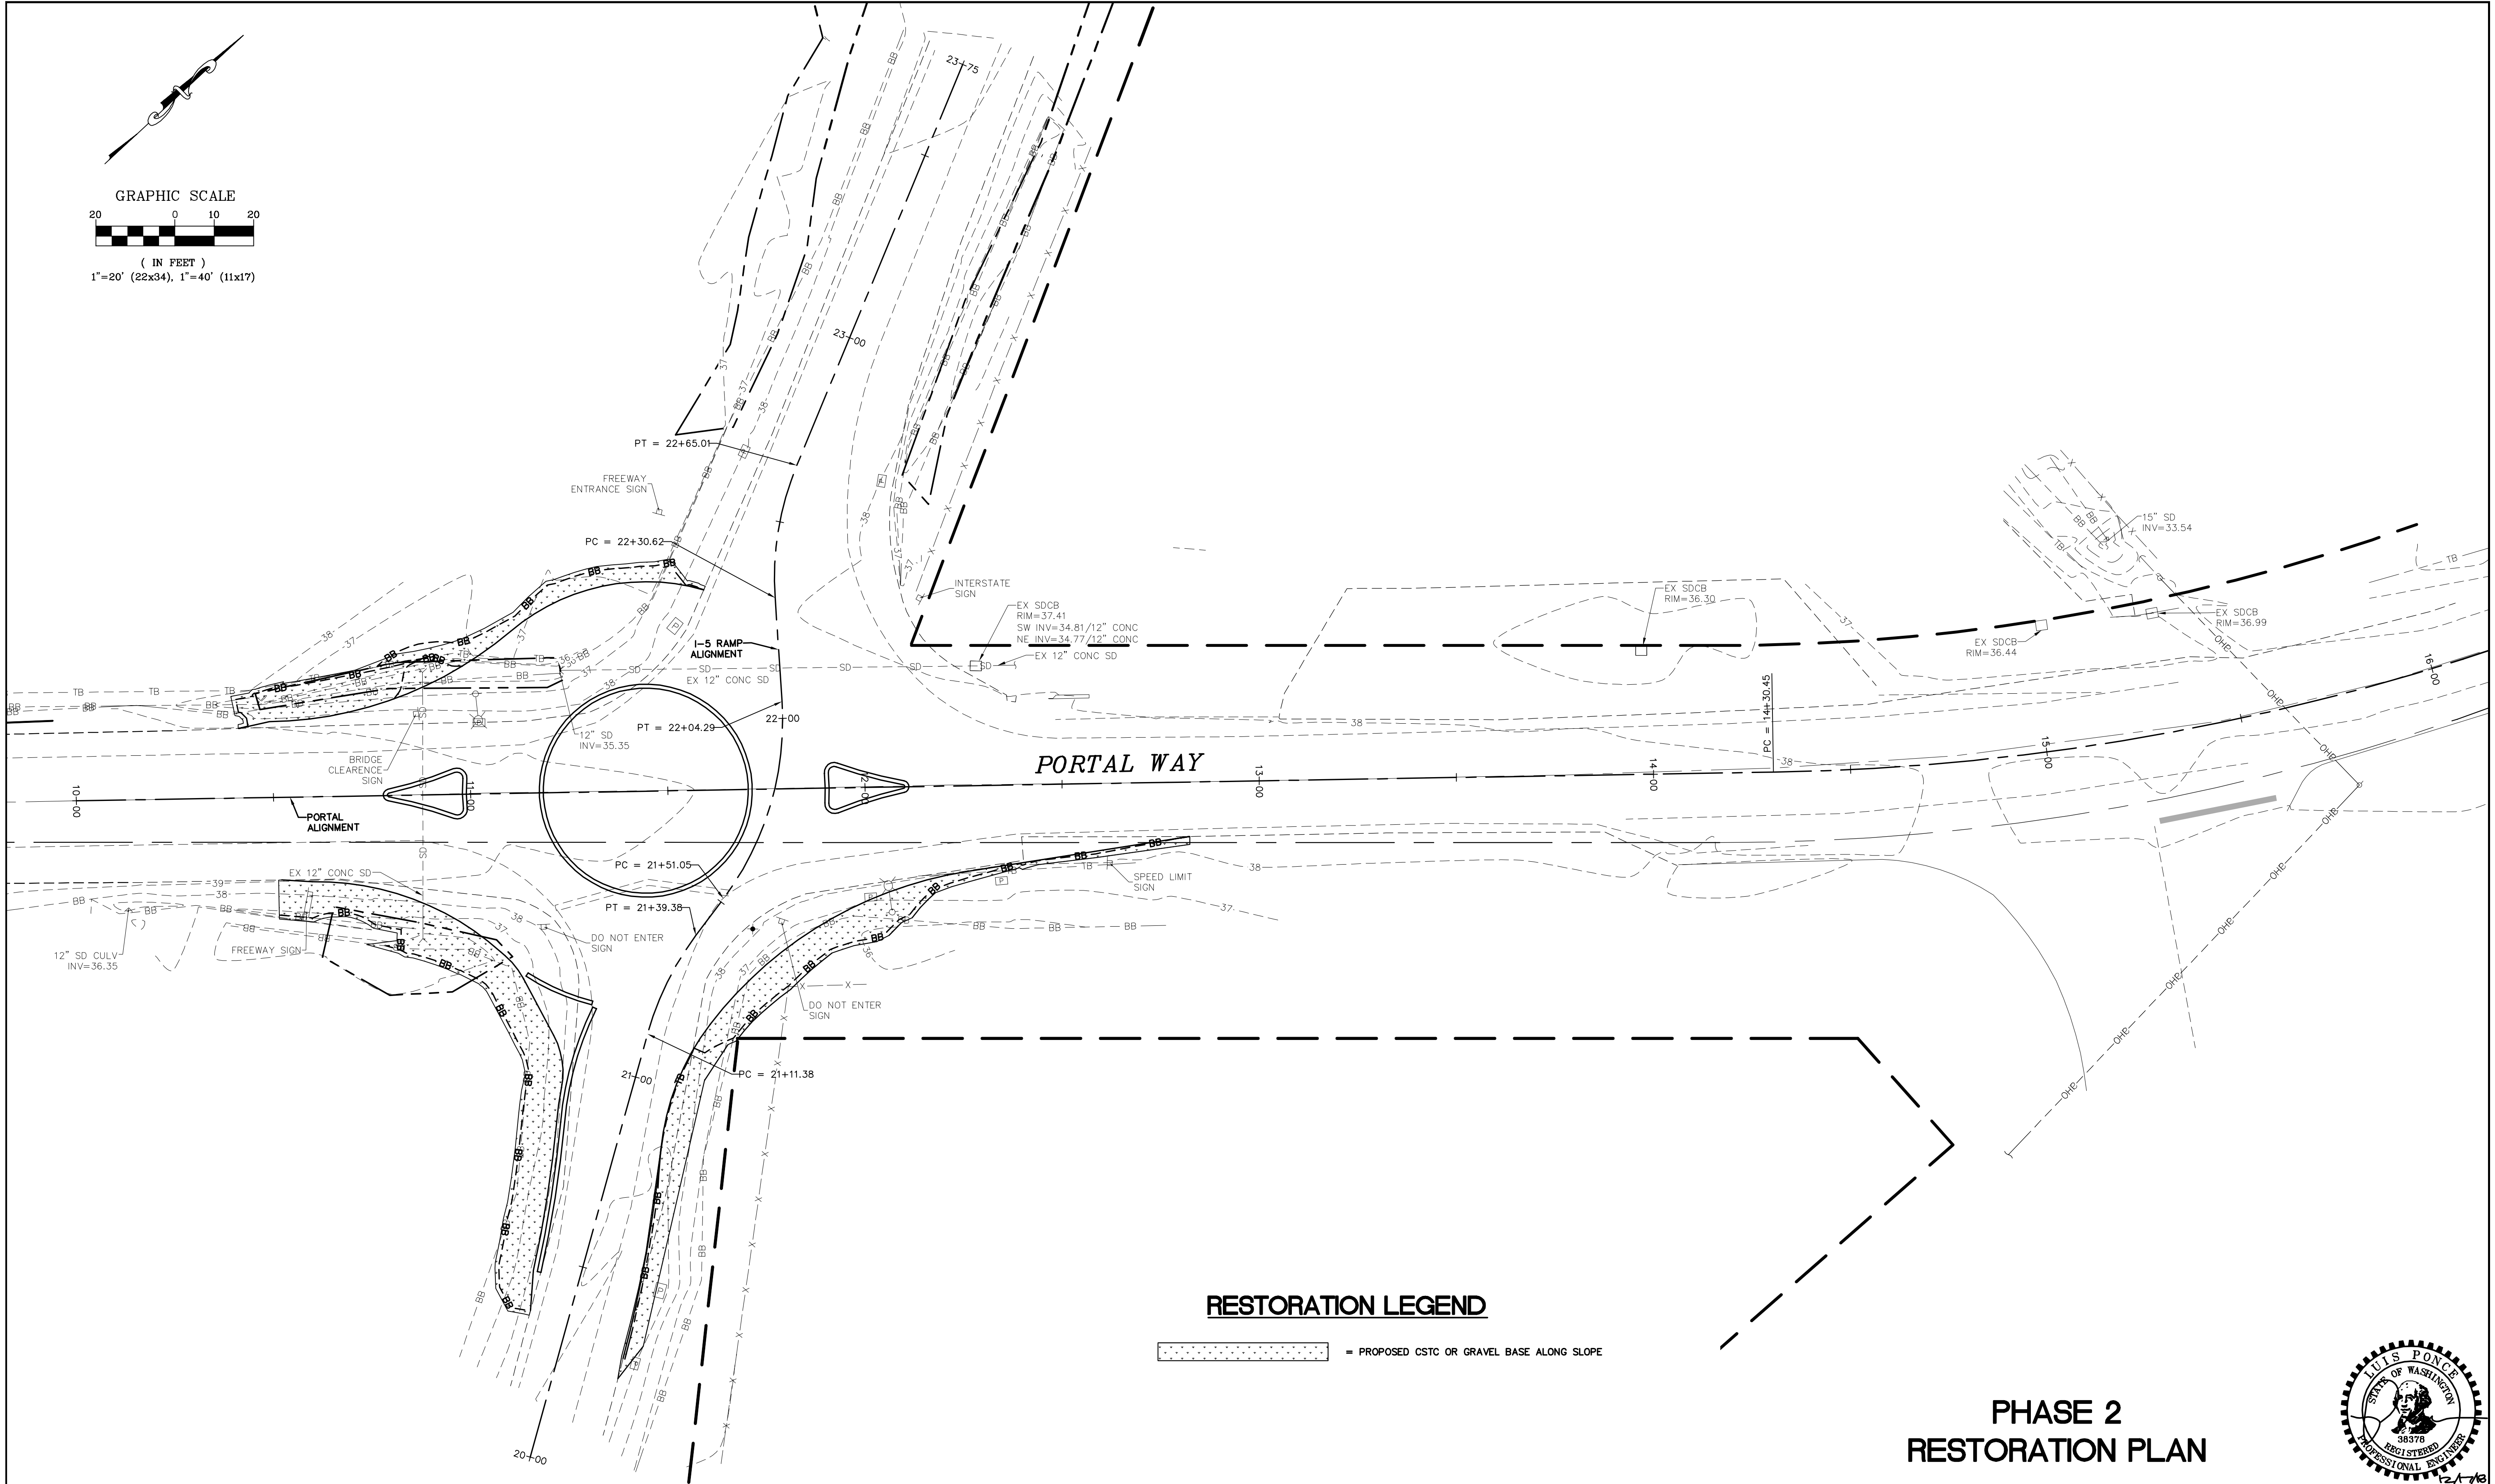

RESTORATION LEGEND

[Dotted Pattern] = PROPOSED CSTC OR GRAVEL BASE ALONG SLOPE

PHASE 2  
RESTORATION PLAN



12/17/18  
**AS-BUILT**

DESIGNED BY  
LP/OAM  
DRAWN BY  
OAM/LMH  
CHECKED BY  
LP

**R&E** Reichhardt & Ebe  
ENGINEERING INC  
P.O. Box 978 | 423 Front Street, Lynden, WA 98264 (360) 354-3687  
813 Metcalf Street, Sedro-Woolley, WA 98284 (360) 855-1713

NO.	DATE	DESCRIPTION	BY	

CITY OF FERNDALE  
2095 MAIN ST  
FERNDALE, WA 98248

PORTAL WAY / I-5  
ROUNDAABOUT IMPROVEMENTS  
RESTORATION PLAN - PHASE 2

DWG 16033 EXCOND,TESC,DEMO		DATE 12/17/2018	
JOB# 16033	SCALE H: 1"=20' V: N/A	SHEET 19	of 20




TESC GENERAL NOTES

- 1. THIS PLAN REPRESENTS THE MINIMUM REQUIREMENTS FOR THIS PROJECT. ADDITIONAL EROSION CONTROL MAY BE REQUIRED BY THE ENGINEER AS ARE FOUND NECESSARY.
- 2. THE TEMPORARY EROSION CONTROL SYSTEMS SHALL BE INSTALLED PRIOR TO ALL OTHER SITE CONSTRUCTION.
- 3. ALL CLEARING LIMITS SHALL BE VISIBLY MARKED PRIOR TO CLEARING.
- 4. ANY VEGETATION NOT IN THE CONSTRUCTION AREA SHALL BE LEFT UNDISTURBED.
- 5. CONTRACTOR SHALL INFORM THE ENGINEER AND OBTAIN APPROVAL FROM THE ENGINEER OF ANY PROPOSED CHANGES IN PLAN PRIOR TO CONSTRUCTION OF THAT CHANGE. CONTRACTOR SHALL KEEP RECORD OF DEVIATIONS AND FORWARD TO THE ENGINEER.
- 6. MAINTENANCE AND OPERATION OF THE EROSION CONTROL AND SEDIMENTATION SYSTEM SHALL BE THE RESPONSIBILITY OF THE CONTRACTOR. THE CONTRACTOR SHALL BE RESPONSIBLE FOR IMPLEMENTATION OF THE SEDIMENTATION AND EROSION CONTROL MEASURES, AS SHOWN AND AS INSTALLED ON AN AS NEEDED BASIS.
- 7. THE CONSTRUCTED EROSION CONTROL AND SEDIMENTATION PLAN SHALL BE APPROVED BY THE ENGINEER PRIOR TO PERFORMING ANY SITE GRADING OR CLEARING.
- 8. CONTRACTOR WILL HAVE A WATER TRUCK AVAILABLE ON SITE AT ALL TIMES. CONTRACTOR WILL WATER SURFACES OFTEN ENOUGH TO ABATE DUST AS APPROVED BY THE ENGINEER. WATERING WILL INCLUDE WEEKENDS AND HOLIDAYS.
- 9. THE CONTRACTOR SHALL PERFORM ALL STREET CLEANING BY HAND OR WITH A SELF-PROPELLED PICKUP STREET SWEEPER. A STANDARD SELF-PROPELLED STREET SWEEPER WILL NOT BE ALLOWED.
- 10. ALL DISTURBED AREAS SHALL BE HYDROSEEDDED. GRASS SEEDING SHALL BE BROADCAST IN ACCORDANCE WITH THE CONTRACT DOCUMENTS.
- 11. ALL CUT AND FILL SLOPES SHALL BE SEEDDED AND FERTILIZED FOR EROSION CONTROL. CONTRACTOR SHALL BE RESPONSIBLE FOR SLOPE EROSION UNTIL VEGETATION IS FIRMLY ESTABLISHED.
- 12. ALL STORM DRAIN FACILITIES WITHIN THE PROJECT BOUNDARY, OR WHICH ARE IMPACTED BY THE PROJECT ARE TO BE CLEARED OF SEDIMENT AND DEBRIS PRIOR TO FINAL ACCEPTANCE OF THE PROJECT.
- 13. ALL WORK AND MATERIALS SHALL BE IN ACCORDANCE WITH THE CONTRACT DOCUMENTS.



**DUST CONTROL:**  
CONTRACTOR SHALL LIMIT DUST GENERATION BY CLEARING ONLY THOSE AREAS WHERE IMMEDIATE EXCAVATION AND GRADING SHALL TAKE PLACE MAINTAINING THE ORIGINAL GROUND COVER AS LONG AS PRACTICAL. DUST CONTROL METHODS SHALL BE PERFORMED BY METHODS LISTED IN NOTE NUMBER EIGHT OF THE TESC GENERAL NOTES. SURFACES SHALL BE SPRAYED WITH WATER AS NEEDED IN ORDER TO ABATE DUST AS APPROVED BY THE ENGINEER.

**STREET CLEANING:**  
CONTRACTOR SHALL PERFORM ALL STREET CLEANING AT A MINIMUM OF AT LEAST ONCE AT THE END OF EVERY DAY WORKED AND ON AN AS NEEDED BASIS BASED ON VEHICLE TRACK OUT. STREET CLEANING SHALL BE PERFORMED BY THE METHODS LISTED IN NOTE NUMBER 10 OF THE TESC GENERAL NOTES AND SHALL NOT ALLOW SEDIMENT INTO STORMWATER CONVEYANCE DITCHES OR STRUCTURES. STREET CLEANING METHODS SHALL BE APPROVED BY THE ENGINEER PRIOR TO THE BEGINNING OF CONSTRUCTION.

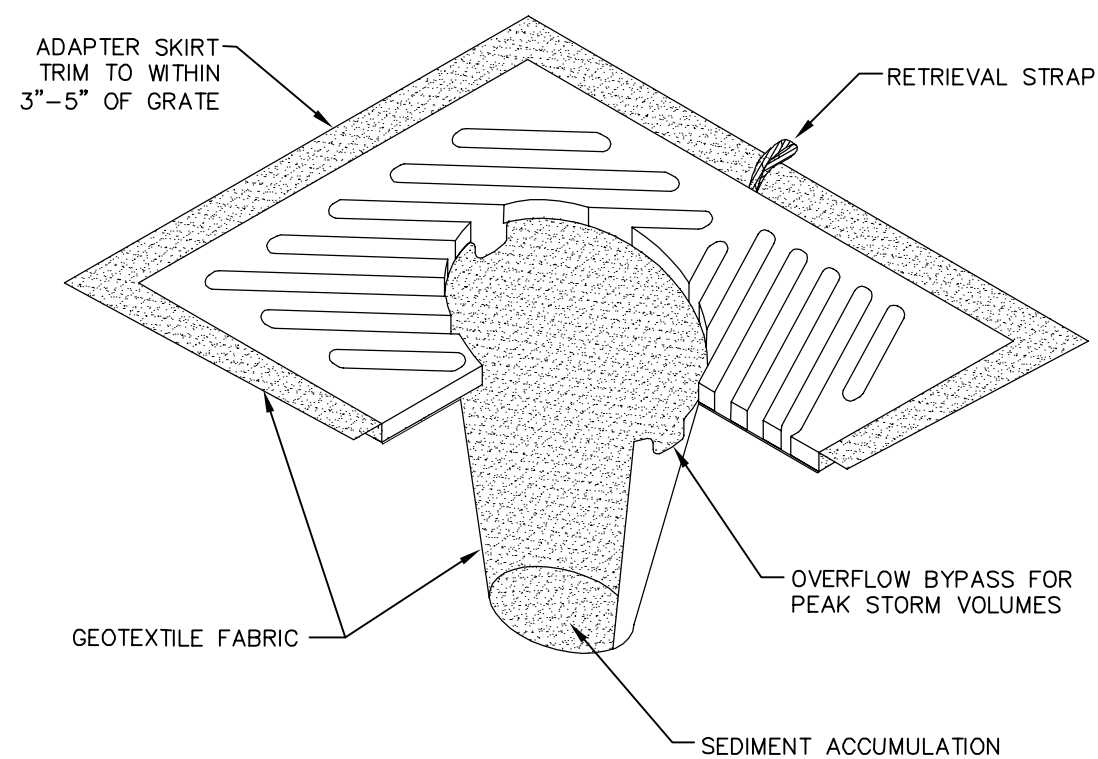

**INLET PROTECTION**  
NTS

- NOTES:
- 1. INSERT SHALL BE INSTALLED PRIOR TO CLEARING & GRADING ACTIVITY, OR UPON PLACEMENT OF A NEW CATCH BASIN.
  - 2. SEDIMENT SHALL BE REMOVED FROM THE UNIT WHEN IT BECOMES HALF FULL.
  - 3. SEDIMENT REMOVAL SHALL BE ACCOMPLISHED BY REMOVING THE INSERT, EMPTYING, & RE-INSERTING IT INTO THE CATCH BASIN.

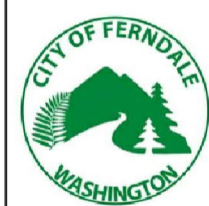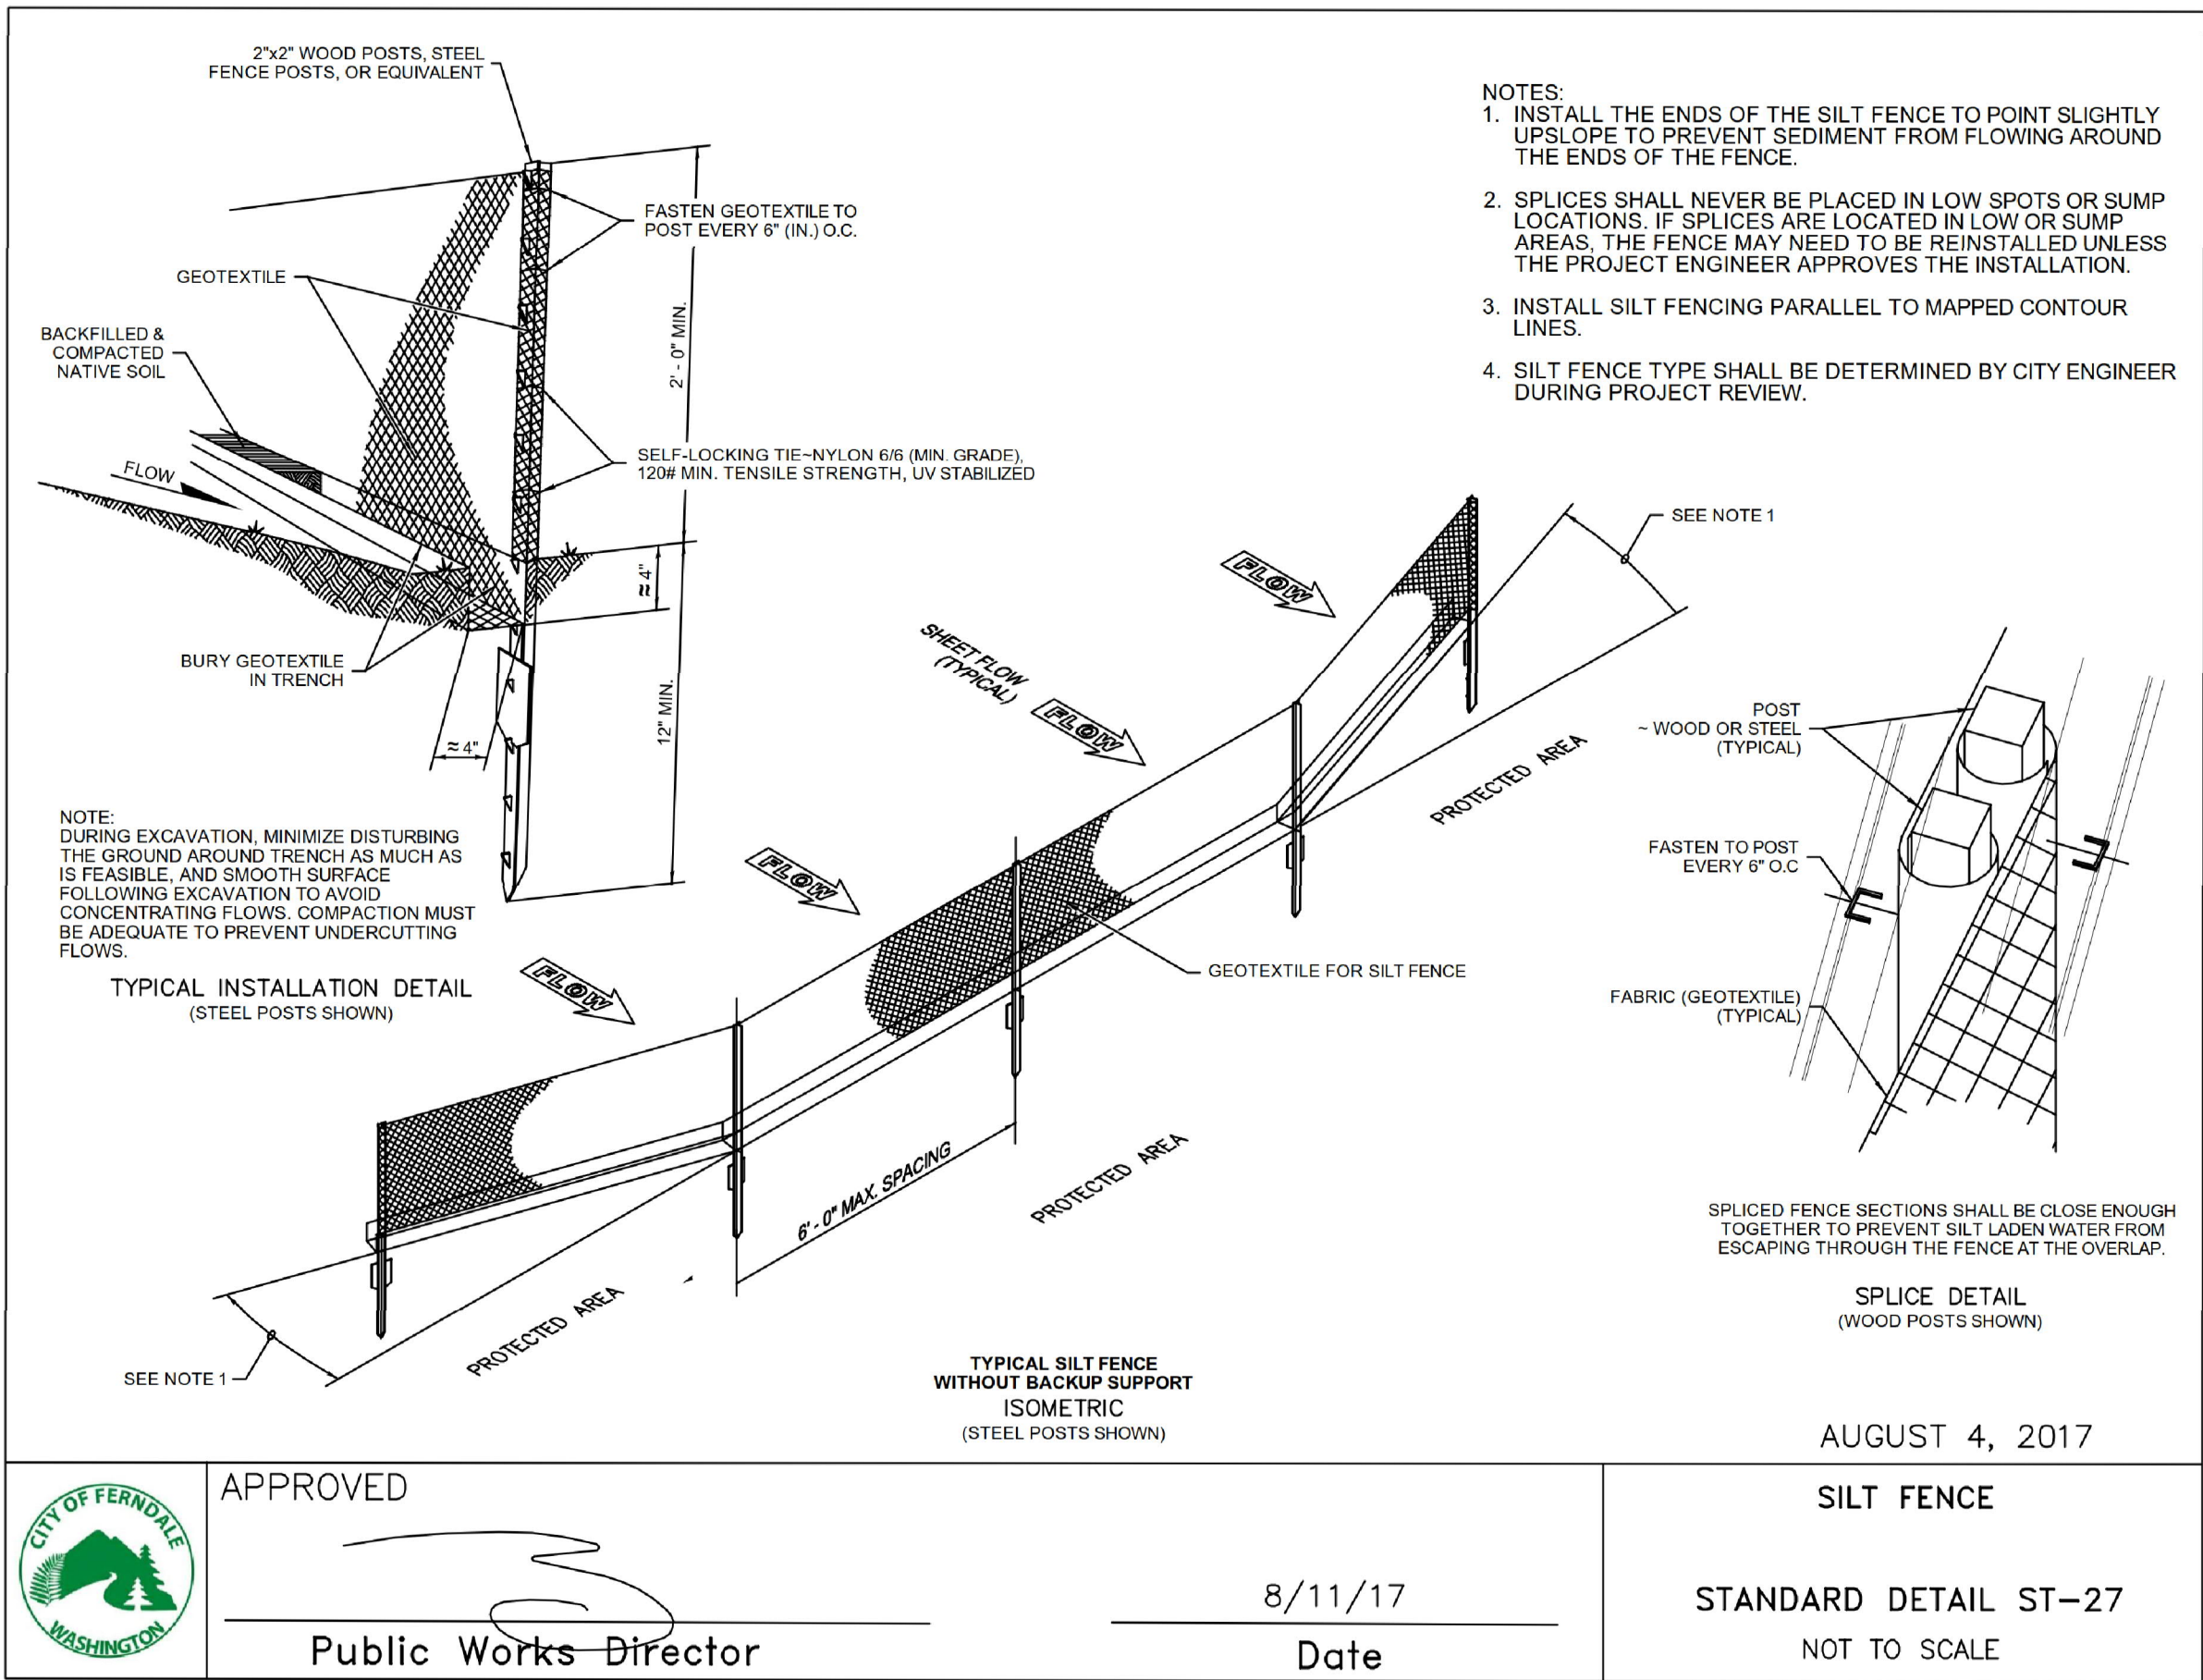


APPROVED  
  
Public Works Director

8/11/17  
Date

AUGUST 4, 2017

SILT FENCE

STANDARD DETAIL ST-27  
NOT TO SCALE

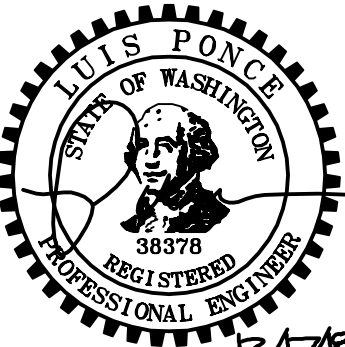

SUBMITTED WITH  
DESIGN PLAN

DESIGNED BY  
LP  
DRAWN BY  
RWG/LMH  
CHECKED BY  
LP

**R&E** Reichhardt & Ebe  
ENGINEERING INC  
P.O. Box 978 | 423 Front Street, Lynden, WA 98264 (360) 354-3687  
813 Metcalf Street, Sedro-Woolley, WA 98284 (360) 855-1713

NO.	DATE	DESCRIPTION	BY

CITY OF FERNDAL  
2095 MAIN ST  
FERNDAL, WA 98248

PORTAL WAY / I-5  
ROUNDAOUT IMPROVEMENTS  
DETAILS

DWG 16033 DETAILS		DATE
12/17/2018		
JOB#	SCALE	SHEET
16033	H: N/A V: N/A	20 of 20

SEC. 20, T. 39N. R. 2E., W.M.

CURVE DATA						
P.I. STATION	DELTA	RADIUS	TANGENT	LENGTH	S	DESIGN SPEED
A 21+25.38	21°23'17"	75.00'	14.16'	28.00'	—	25 MPH
A 21+77.67	40°40'14"	75.00'	27.80'	53.24'	—	25 MPH
A 22+47.82	26°16'20"	75.00'	17.50'	34.39'	—	25 MPH
P 16+39.90	39°20'51"	610.00'	218.10'	418.91'	—	35 MPH

GENERAL NOTES

1. ALL DIMENSIONS ARE IN FEET UNLESS OTHERWISE NOTED.
2. REMOVE EXISTING PLASTIC STOP LINE AND ALL CONFLICTING PAINTED EDGE LINES AND DOUBLE CENTERLINES.

PAVEMENT MARKING TYPE



- 1 PLASTIC EDGE LINE – WHITE
- 2 PLASTIC EDGE LINE – YELLOW
- 3 PLASTIC DOTTED EXTENSION LINE – WHITE
- 4 PLASTIC YIELD LINE SYMBOL – TYPE 2
- 5 PLASTIC TRAFFIC LETTER
- 6 PLASTIC TRAFFIC ARROW – TYPE 1S
- 7 PLASTIC CROSSHATCH – 8" WHITE

FLEXIBLE GUIDE POST

LOCATION	TYPE
A 20+45.75, 12.87 LT	Y
A 20+50.74, 13.16 LT	Y
A 20+55.73, 13.54 LT	Y
A 20+60.70, 14.00 LT	Y
A 20+65.67, 14.55 LT	Y
A 20+70.63, 15.18 LT	Y
A 20+80.52, 16.70 LT	Y
A 20+85.44, 17.55 LT	Y
A 20+90.40, 18.19 LT	Y
A 20+95.39, 18.54 LT	Y
A 21+00.39, 18.60 LT	Y
A 21+05.38, 18.36 LT	Y
A 21+10.35, 17.82 LT	Y
TOTAL	14


PAVEMENT MARKING CURVE RADII

CURVE	RADIUS	CURVE	RADIUS
1	100.00'	11	NOT USED
2	120.00'	12	110.00'
3	NOT USED	13	NOT USED
4	NOT USED	14	105.00'
5	NOT USED	15	15.00'
6	80.00'	16	50.00'
7	NOT USED	17	75.00'
8	300.00'	18	45.00'
9	NOT USED	19	NOT USED
10	315.00'	20	NOT USED

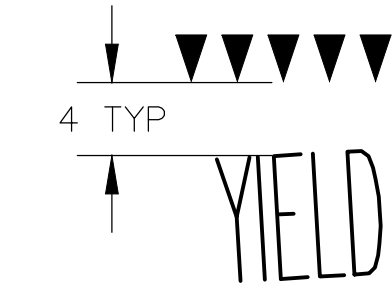
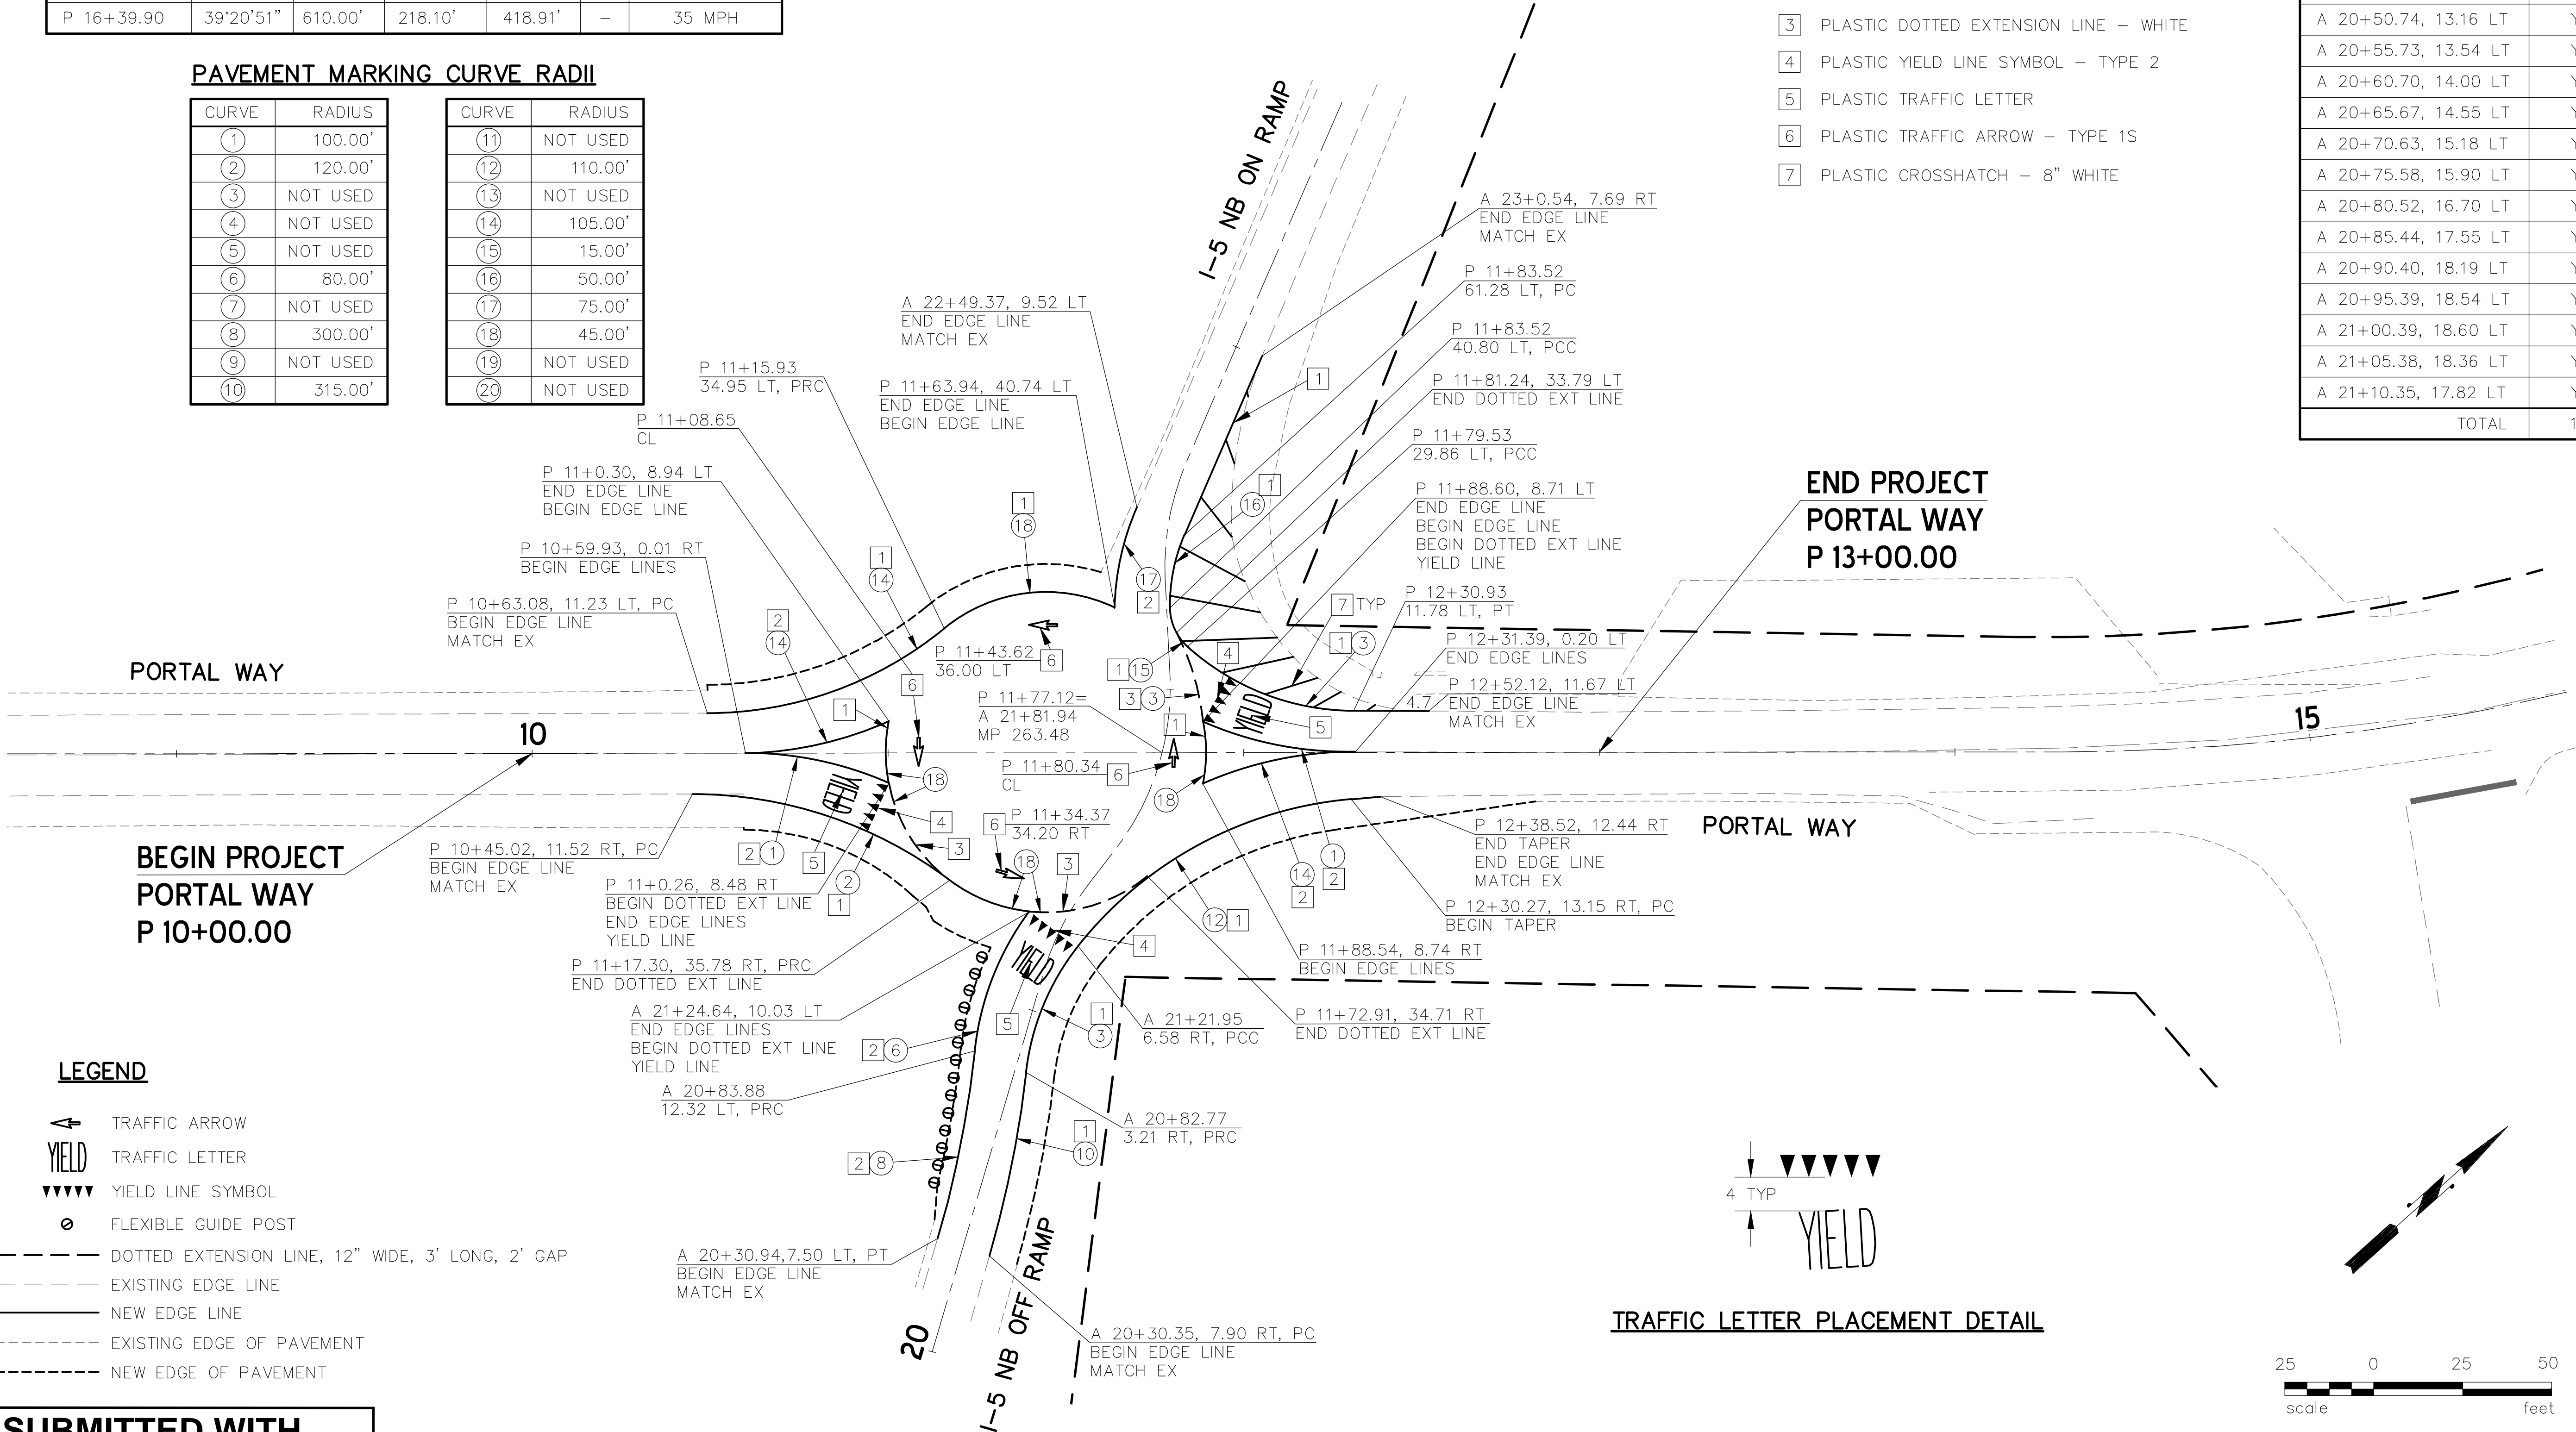


TRAFFIC LETTER PLACEMENT DETAIL

SUBMITTED WITH  
DESIGN PLAN

						REICHHARDT & EBE ENGINEERING, INC. P.O. Box 978 Lynden, Washington 98264				HTE HERMAN TRAFFIC ENGINEERING 11215 Southeast 220th Place, Kent, Washington 98031 253-236-4941 tel. hte@comcast.net		I-5 MP 263.48		MK1	
DRAWN RMH												I-5 NB RAMPS/PORTAL WAY			
DESIGNED RMH												FERNDALE, WHATCOM COUNTY		SHEET	
CHECKED 3/29/18 RMH												MARCH, 2018		OF	
PROJ. ENGR.						CITY OF FERNDAL P.O. Box 936 Ferndale, Washington 98248						PAVEMENT MARKING PLAN		SHEETS	
DRAWING FILE MK_rev2.DWG															
		DATE		REVISION		BY		APP'D							



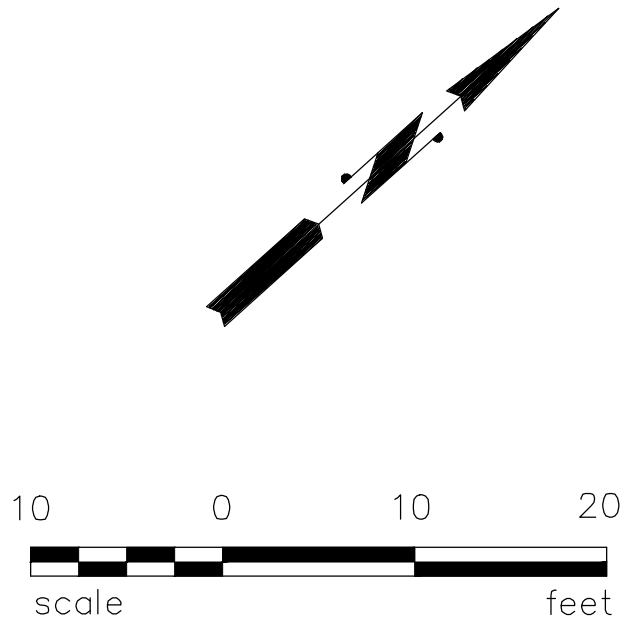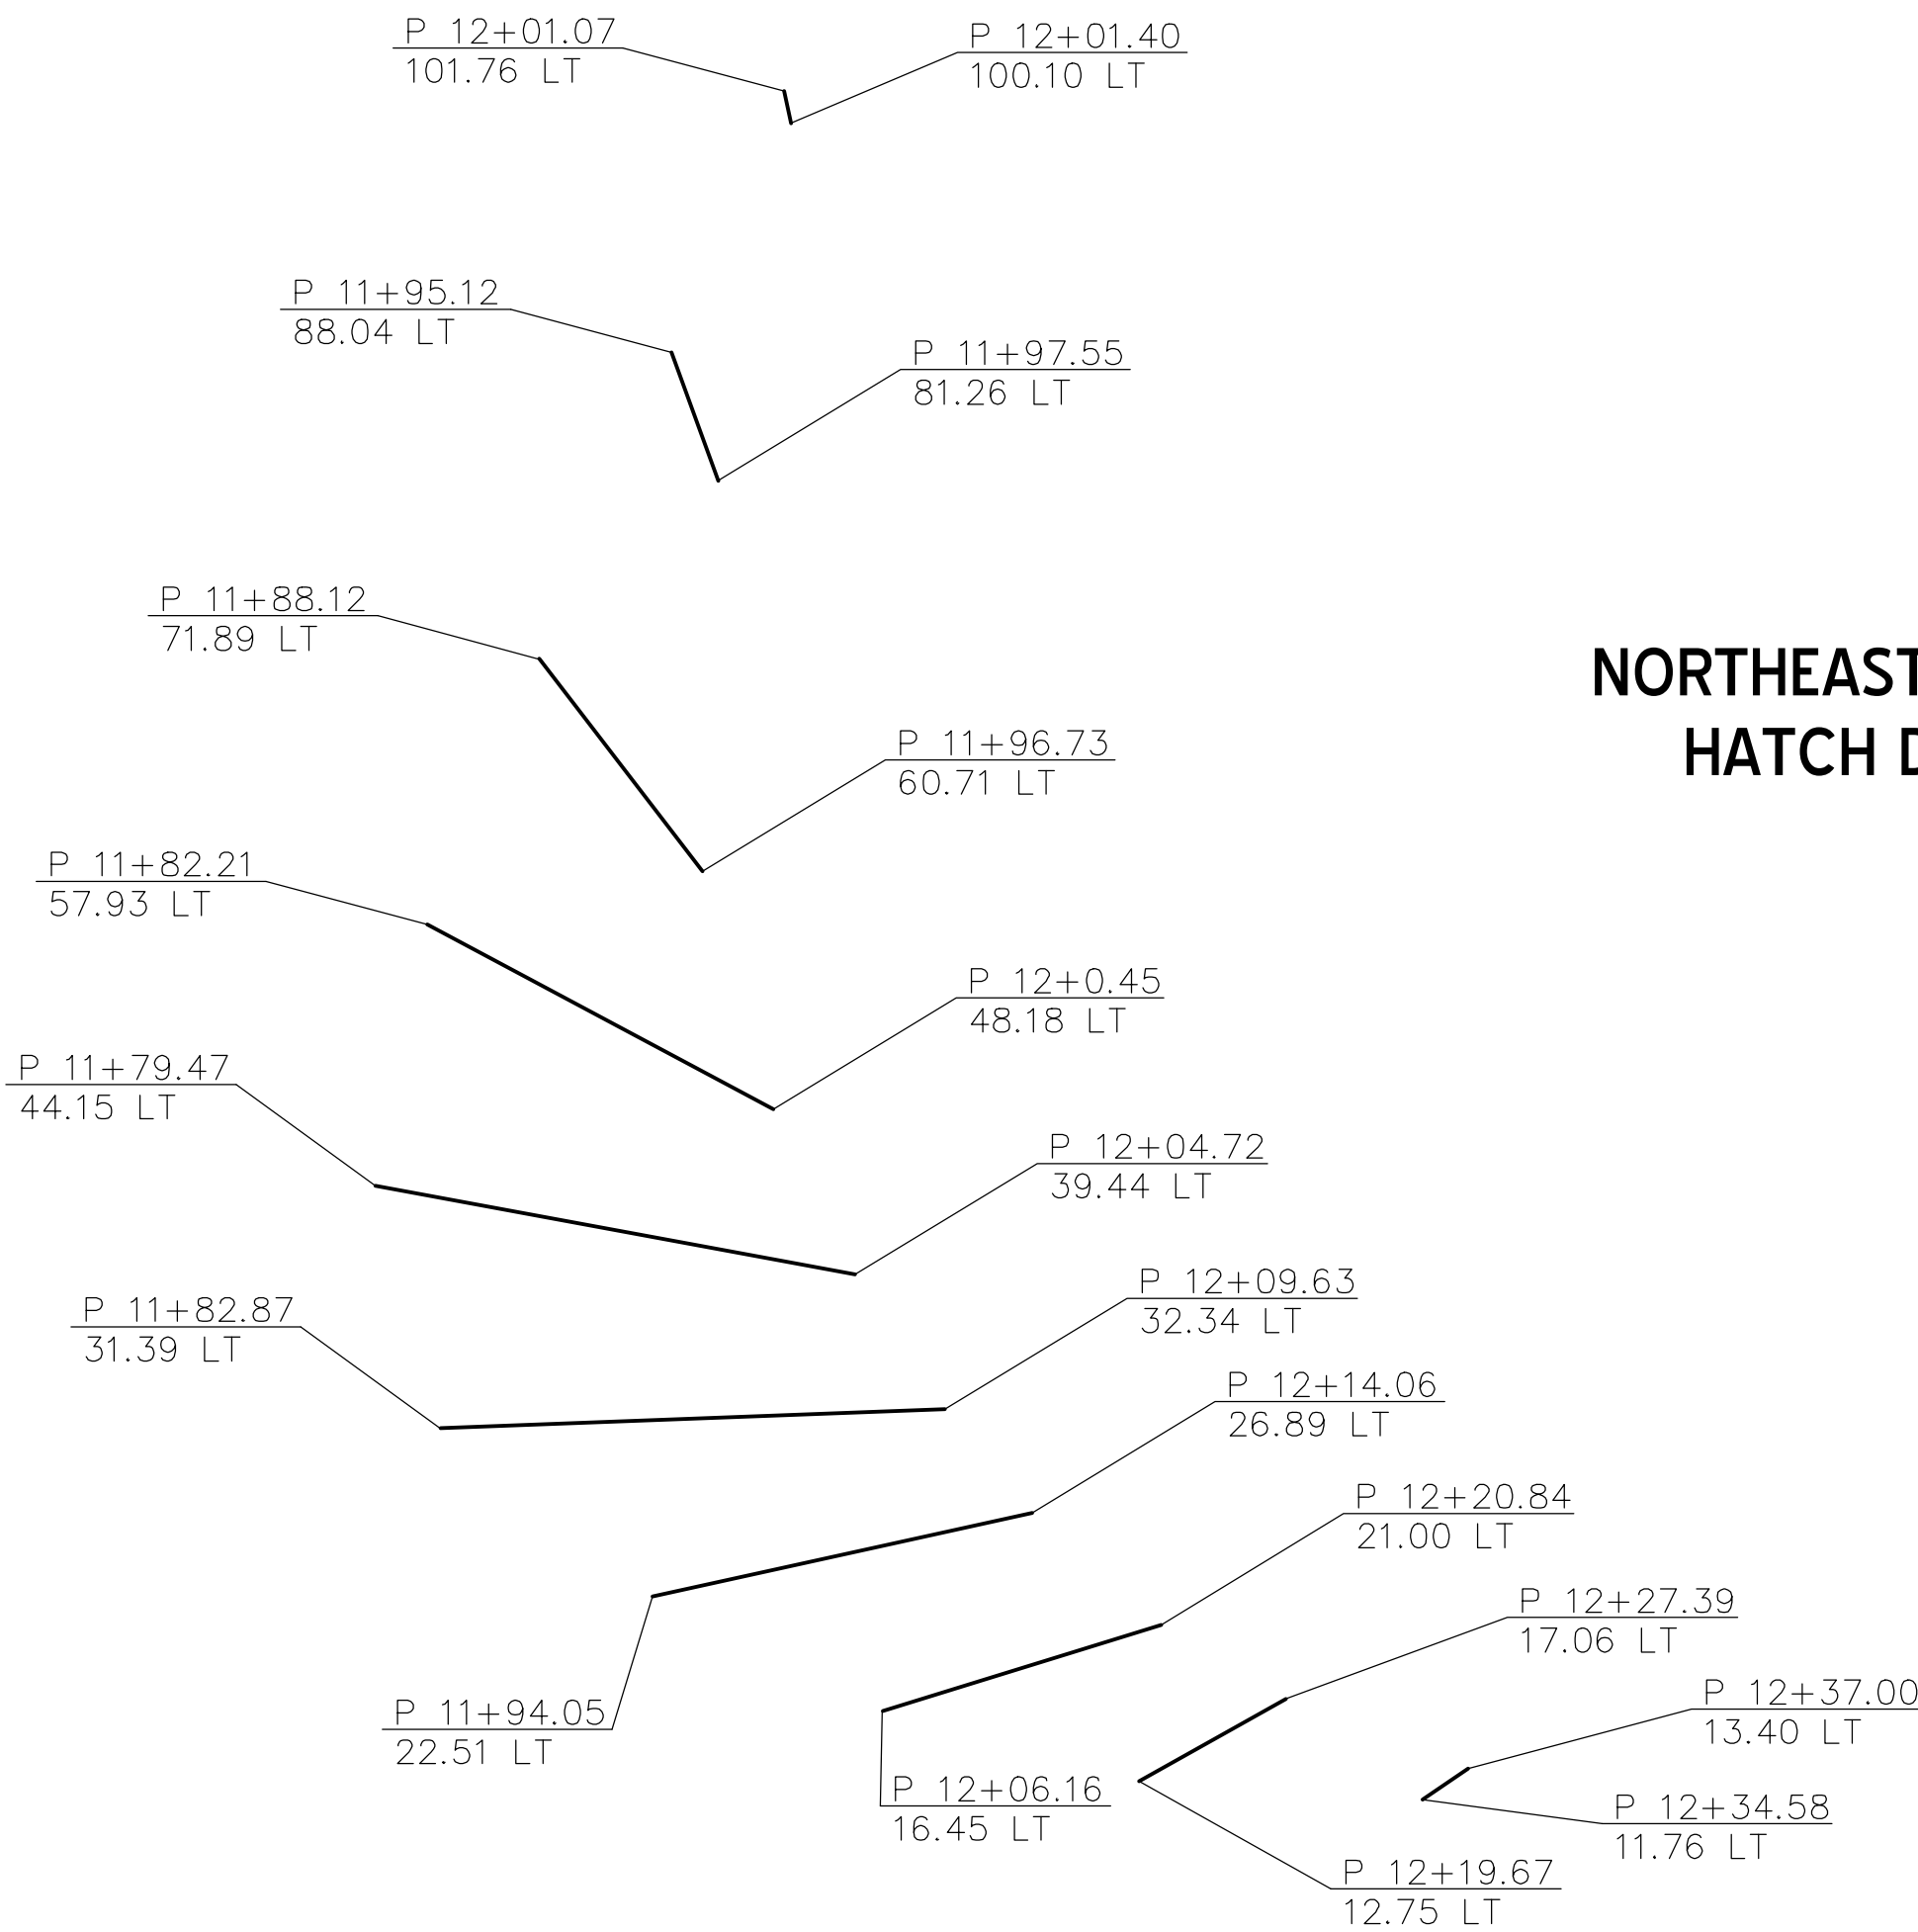



**GENERAL NOTES**

1. ALL DIMENSIONS ARE IN FEET UNLESS OTHERWISE NOTED.

**SUBMITTED WITH  
DESIGN PLAN**

						REICHHARDT & EBE ENGINEERING, INC. P.O. Box 978 Lynden, Washington 98264						1-5 MP 263.48		MK2	
DRAWN	RMH											I-5 NB RAMPS/PORTAL WAY		SHEET	
DESIGNED	RMH											FERNDAL, WHATCOM COUNTY		OF	
CHECKED	3/29/18 RMH											MARCH, 2018		SHEETS	
PROJ. ENGR.															
DRAWING FILE	MK_rev2.DWG														
		DATE		REVISION		BY	APP'D								



GENERAL NOTES (GN):

- A) POST LENGTHS AND "W" VALUES SHOWN ARE APPROXIMATE. FINAL VALUES SHALL BE DETERMINED IN THE FIELD BY THE CONTRACTOR PRIOR TO FABRICATION AND INSTALLATION.
- B) FOR STRUCTURE AND MOUNTING DETAILS SEE STANDARD PLAN SERIES "G".
- C) FOR CODE REFERENCES AND STANDARD DETAILS SEE WASHINGTON STATE SIGN FABRICATION MANUAL.
- D) ALL 2.5" PERFORATED SQUARE STEEL TUBE (PSST) POSTS SHALL BE 12 GAGE.
- E) 2.5" SQ (SB) AND 2.5" SQ (5) PSST POSTS SHALL HAVE A 12 GAGE 2 1/4" PSST INSERT OF THE SAME LENGTH.
- F) ALL WIDE FLANGE STEEL POSTS SHALL BE ASTM A36.
- G) ALL ROUND STEEL POSTS ARE MEASURED TO OUTSIDE DIAMETER AND SHALL HAVE TYPE AP SIGN SUPPORTS.
- H) ALL SIGNS 36" OR WIDER SHALL BE BRACED IN ACCORDANCE WITH STANDARD PLAN G-50.10.
- I) 5", 6", 7" AND 8" SQUARE STEEL TUBE SIGN POSTS SHALL HAVE TYPE TP-B BASES. ASTM A36 W6x12 FOUNDATION SPECIFICATIONS SHALL BE USED UNLESS OTHERWISE NOTED IN THE PLANS .
- J) NOT USED.
- K) 3" SOLID SQUARE STEEL TUBE POSTS SHALL BE 7 GAGE AND SHALL HAVE A 10" TRIANGULAR SLIP BASE UNLESS OTHERWISE NOTED. SEE STANDARD PLAN G-24.40, TYPE SB-1 AND SB-3 SLIP BASE ASSEMBLY.
- L) NOT USED.
- M) NOT USED.
- N) ALL OVERHEAD SIGN MOUNTING HARDWARE SHALL BE NEW UNLESS OTHERWISE SHOWN ON THE PLANS OR SIGN SPECIFICATION SHEETS.

UNLESS OTHERWISE NOTED IN THE SHEETING TYPE COLUMN, ALL OVERHEAD REFLECTIVE SHEETING TYPE SHALL BE AS FOLLOWS:		
TYPE OF SIGN	SHEETING TYPE	
	BACKGROUND	LEGEND / BORDER
GUIDE - LIT	II*	III OR IV
GUIDE - UNLIT	III OR IV*	VIII OR IX
STREET NAME	III OR IV	IV
REGULATORY	IV	N/A
WARNING	*	N/A



* FOR YELLOW BACKGROUND USE TYPE VIII OR IX FLUORESCENT SHEETING.

ABBREVIATIONS LEGEND	
AAH	ADOPT A HIGHWAY
AHD	AHEAD
BR MOUNT	BRIDGE MOUNTED SIGN BRACKET
BTWN	BETWEEN
CANT	CANTILEVER
CL	CENTER LINE
CN	CONSTRUCTION NOTE
CONT	CONTINUED
EX OR EXIST	EXISTING
HAR	HIGHWAY ADVISORY RADIO
I/C	INTERCHANGE
I/S	INTERSECTION
LT	LEFT
LT STD	LIGHT STANDARD
MOD	MODIFIED
MP	MILE POST
MTG HDWR	MOUNTING HARDWARE
N/A	NOT APPLICABLE
NO.	NUMBER
PED	PEDESTRIAN
PERP	PERPENDICULAR
PSST	PERFORATED SQUARE STEEL TUBE
R-	REMOVAL
RT	RIGHT
SIG POLE	SIGNAL POLE
SIGN BR	SIGN BRIDGE
SB	SLIP BASE
SQ	SQUARE
STA	STATION
TYP	TYPICAL
W/	WITH
XING OR X-ING	CROSSING

2 1/2" PERFORATED & 3" SQUARE STEEL TUBE SIGN POST SUPPORTS			
POST SIZE (#)	CALL OUT IN THE POST SIZE COLUMN	SIGN SUPPORT TYPE	GENERAL NOTE
2 1/2"	2.5" SQ (1)	ST-1	D
2 1/2"	2.5" SQ (4)	ST-4	D
2 1/2"	2.5" SQ (SB)	SB-1, SB-2 OR SB-3	D, E
2 1/2"	2.5" SQ (5)	ST-4	E
3"	3" SQ (SB)	SEE NOTE K	K
3"	3" SQ (5)	ST-4	K

SEE STANDARD PLANS G-24.40 AND G-24.50

SUBMITTED WITH  
DESIGN PLAN

												1-5 MP 263.48		SS1
DRAWN RMH						REICHHARDT & EBE ENGINEERING, INC. P.O. Box 978 Lynden, Washington 98264			 HERMAN TRAFFIC ENGINEERING		I-5 NB RAMPS/PORTAL WAY			
DESIGNED RMH						CITY OF FERNDAL P.O. Box 936 Ferndale, Washington 98248			11215 Southeast 220th Place, Kent, Washington 98031 253-236-4941 tel. hte@comcast.net		FERNDAL, WHATCOM COUNTY MARCH, 2018			
CHECKED 3/29/18 RMH											SIGN SPECIFICATIONS			
PROJ. ENGR.														
DRAWING FILE SN_rev2.DWG														
	DATE		REVISION		BY	APP'D								



## SIGN SPECIFICATIONS


SIGN NO.	SIGN CODE	SIGN DESCRIPTION	LOCATION	SIGN SIZE		SHEETING TYPE	LETTER SIZE OR CODE	POST MATERIAL	POST SIZE	POST LENGTH				CLEARANCE		REMARKS
				X	Y					H1	H2	H3	H4	V	W	
1A	W2-6P	ROUNDAABOUT AHEAD	P 6+71, RT	36"	18"	III OR IV	STANDARD	STEEL	2.5" SQ (5)	15'				11.25'	14'	SEE CN 1
1B	W2-6	ROUNDAABOUT SYMBOL		36"	36"	III OR IV	STANDARD							7'		MOUNT BELOW SIGN NO. 1A
1C	W13-1 (10)	10 MPH		24"	24"	III OR IV	STANDARD							5'		MOUNT BELOW SIGN NO. 1B
2	D1-901 MOD.	I-5 NORTH VANCOUVER B.C.	P 10+45, RT	9.5'	6.5'	II	SEE DETAIL	STEEL	3" SQ (SB)	14'	16'			7'	16'	SEE CN 2
		WITH LEFT FISHHOOK ARROW														
R-3		I-5 NORTH VANCOUVER B.C.	P 10+54, RT													REMOVE SIGN AND WOOD POSTS (2)
		WITH LEFT ARROW														
4		14'-0"	P 10+43, LT					STEEL	2.5" SQ (5)	14'				7'	13'	RELOCATE SIGN FROM P 10+87 LT, SEE CN 1
R-5		WOOD POST	P 10+87, LT													REMOVE WOOD POST
6		VISITOR INFORMATION	P 10+59, LT					LIGHT STANDARD						7'	15'	RELOCATE WITH LIGHT STANDARD
7A	R1-2	YIELD	P 10+88, RT	36"	36"	III OR IV	STANDARD	STEEL	2.5" SQ (5)	13'				7.5'	16'	SEE CN 1
7B	R6-5P	ROUNDAABOUT DIRECTIONAL		30"	30"	III OR IV	SEE DETAIL							5'		MOUNT BELOW SIGN NO. 7A
R-8		STOP	P 11+16, RT													REMOVE SIGN AND WOOD POST
9		DO NOT ENTER	P 11+22, RT						3" SQ (SB)	14'				7'	10'	RELOCATE SIGN FROM P 11+16 RT, SEE CN3
10		ONE WAY>	P 11+22, RT											11'		RELOCATE SIGNS (2) FROM P 11+16 RT TO ABOVE
		<ONE WAY												11'		AND PERPENDICULAR TO SIGN NO. 9
R-11		STOP	P 11+70, RT													REMOVE SIGN AND WOOD POST
12		DO NOT ENTER	P 11+74, RT						3" SQ (SB)	14'				7'	16'	RELOCATE SIGN FROM P 11+70 RT, SEE CN 2
13		ONE WAY>	P 11+74, RT											11'		RELOCATE SIGNS (2) FROM P 11+70 RT TO ABOVE
		<ONE WAY												11'		AND PERPENDICULAR TO SIGN NO. 12
14A	R1-2	YIELD	P 11+66, RT	36"	36"	III OR IV	STANDARD	STEEL	2.5" SQ (SB)	13'				7.5'	16'	SEE CN 2
14B	R6-5P	ROUNDAABOUT DIRECTIONAL		30"	30"	III OR IV	SEE DETAIL							5'		MOUNT BELOW SIGN NO. 14A
15A	R1-2	YIELD	P 12+08, LT	36"	36"	III OR IV	STANDARD	STEEL	2.5" SQ (5)	13'				7.5'	23'	SEE CN 2
15B	R6-5P	ROUNDAABOUT DIRECTIONAL		30"	30"	III OR IV	SEE DETAIL							5'		MOUNT BELOW SIGN NO. 15A
16		I-5 SOUTH^ NORTH>	P 13+94, LT					STEEL	2.5" SQ (5)	15'				7'	17'	SEE CN 2
R-17		WOOD POST	P 12+15, LT													REMOVE WOOD POST
18A	W2-6P	ROUNDAABOUT AHEAD	P 17+26, LT	36"	18"	III OR IV	STANDARD	STEEL	2.5" SQ (5)	15'				11.25'	14'	SEE CN 2
18B	W2-6	ROUNDAABOUT SYMBOL		36"	36"	III OR IV	STANDARD							7'		MOUNT BELOW SIGN NO. 18A
18C	W13-1 (10)	10 MPH		24"	24"	III OR IV	STANDARD							5'		MOUNT BELOW SIGN NO. 18B
R-19		STOP AHEAD	SEE PLAN DIMENSION													REMOVE SIGN AND TRIM POST
20A	W2-6P	ROUNDAABOUT AHEAD	SEE PLAN DIMENSION	36"	18"	III OR IV	STANDARD	STEEL	2.5" SQ (SB)	15'				11.25'	14'	SEE CN 2
20B	W2-6	ROUNDAABOUT SYMBOL		36"	36"	III OR IV	STANDARD							7'		MOUNT BELOW SIGN NO. 20A
20C	W13-1 (10)	10 MPH		24"	24"	III OR IV	STANDARD							5'		MOUNT BELOW SIGN NO. 20B

CONSTRUCTION NOTES (CN):

1. EDGE OF SIGN SHALL BE MINIMUM 2' BEHIND BACK OF SIDEWALK.
2. EDGE OF SIGN SHALL BE MINIMUM 6' BEHIND EDGE OF PAVEMENT.
3. EDGE OF SIGN SHALL BE MINIMUM 2' BEHIND FACE OF CURB.

**SUBMITTED WITH  
DESIGN PLAN**

DRAWN RMH						REICHARDT & EBE ENGINEERING, INC.				1-5 MP 263.48		SS2	
DESIGNED RMH						P.O. Box 978 Lynden, Washington 98264				I-5 NB RAMPS/PORTAL WAY		SHEET	
CHECKED 3/29/18 RMH						CITY OF FERDALE				FERDALE, WHATCOM COUNTY		OF	
PROJ. ENGR.						P.O. Box 936 Ferndale, Washington 98248				SIGN SPECIFICATIONS		SHEETS	
DRAWING FILE SN_rev2.DWG													
		DATE		REVISION		BY		APP'D					

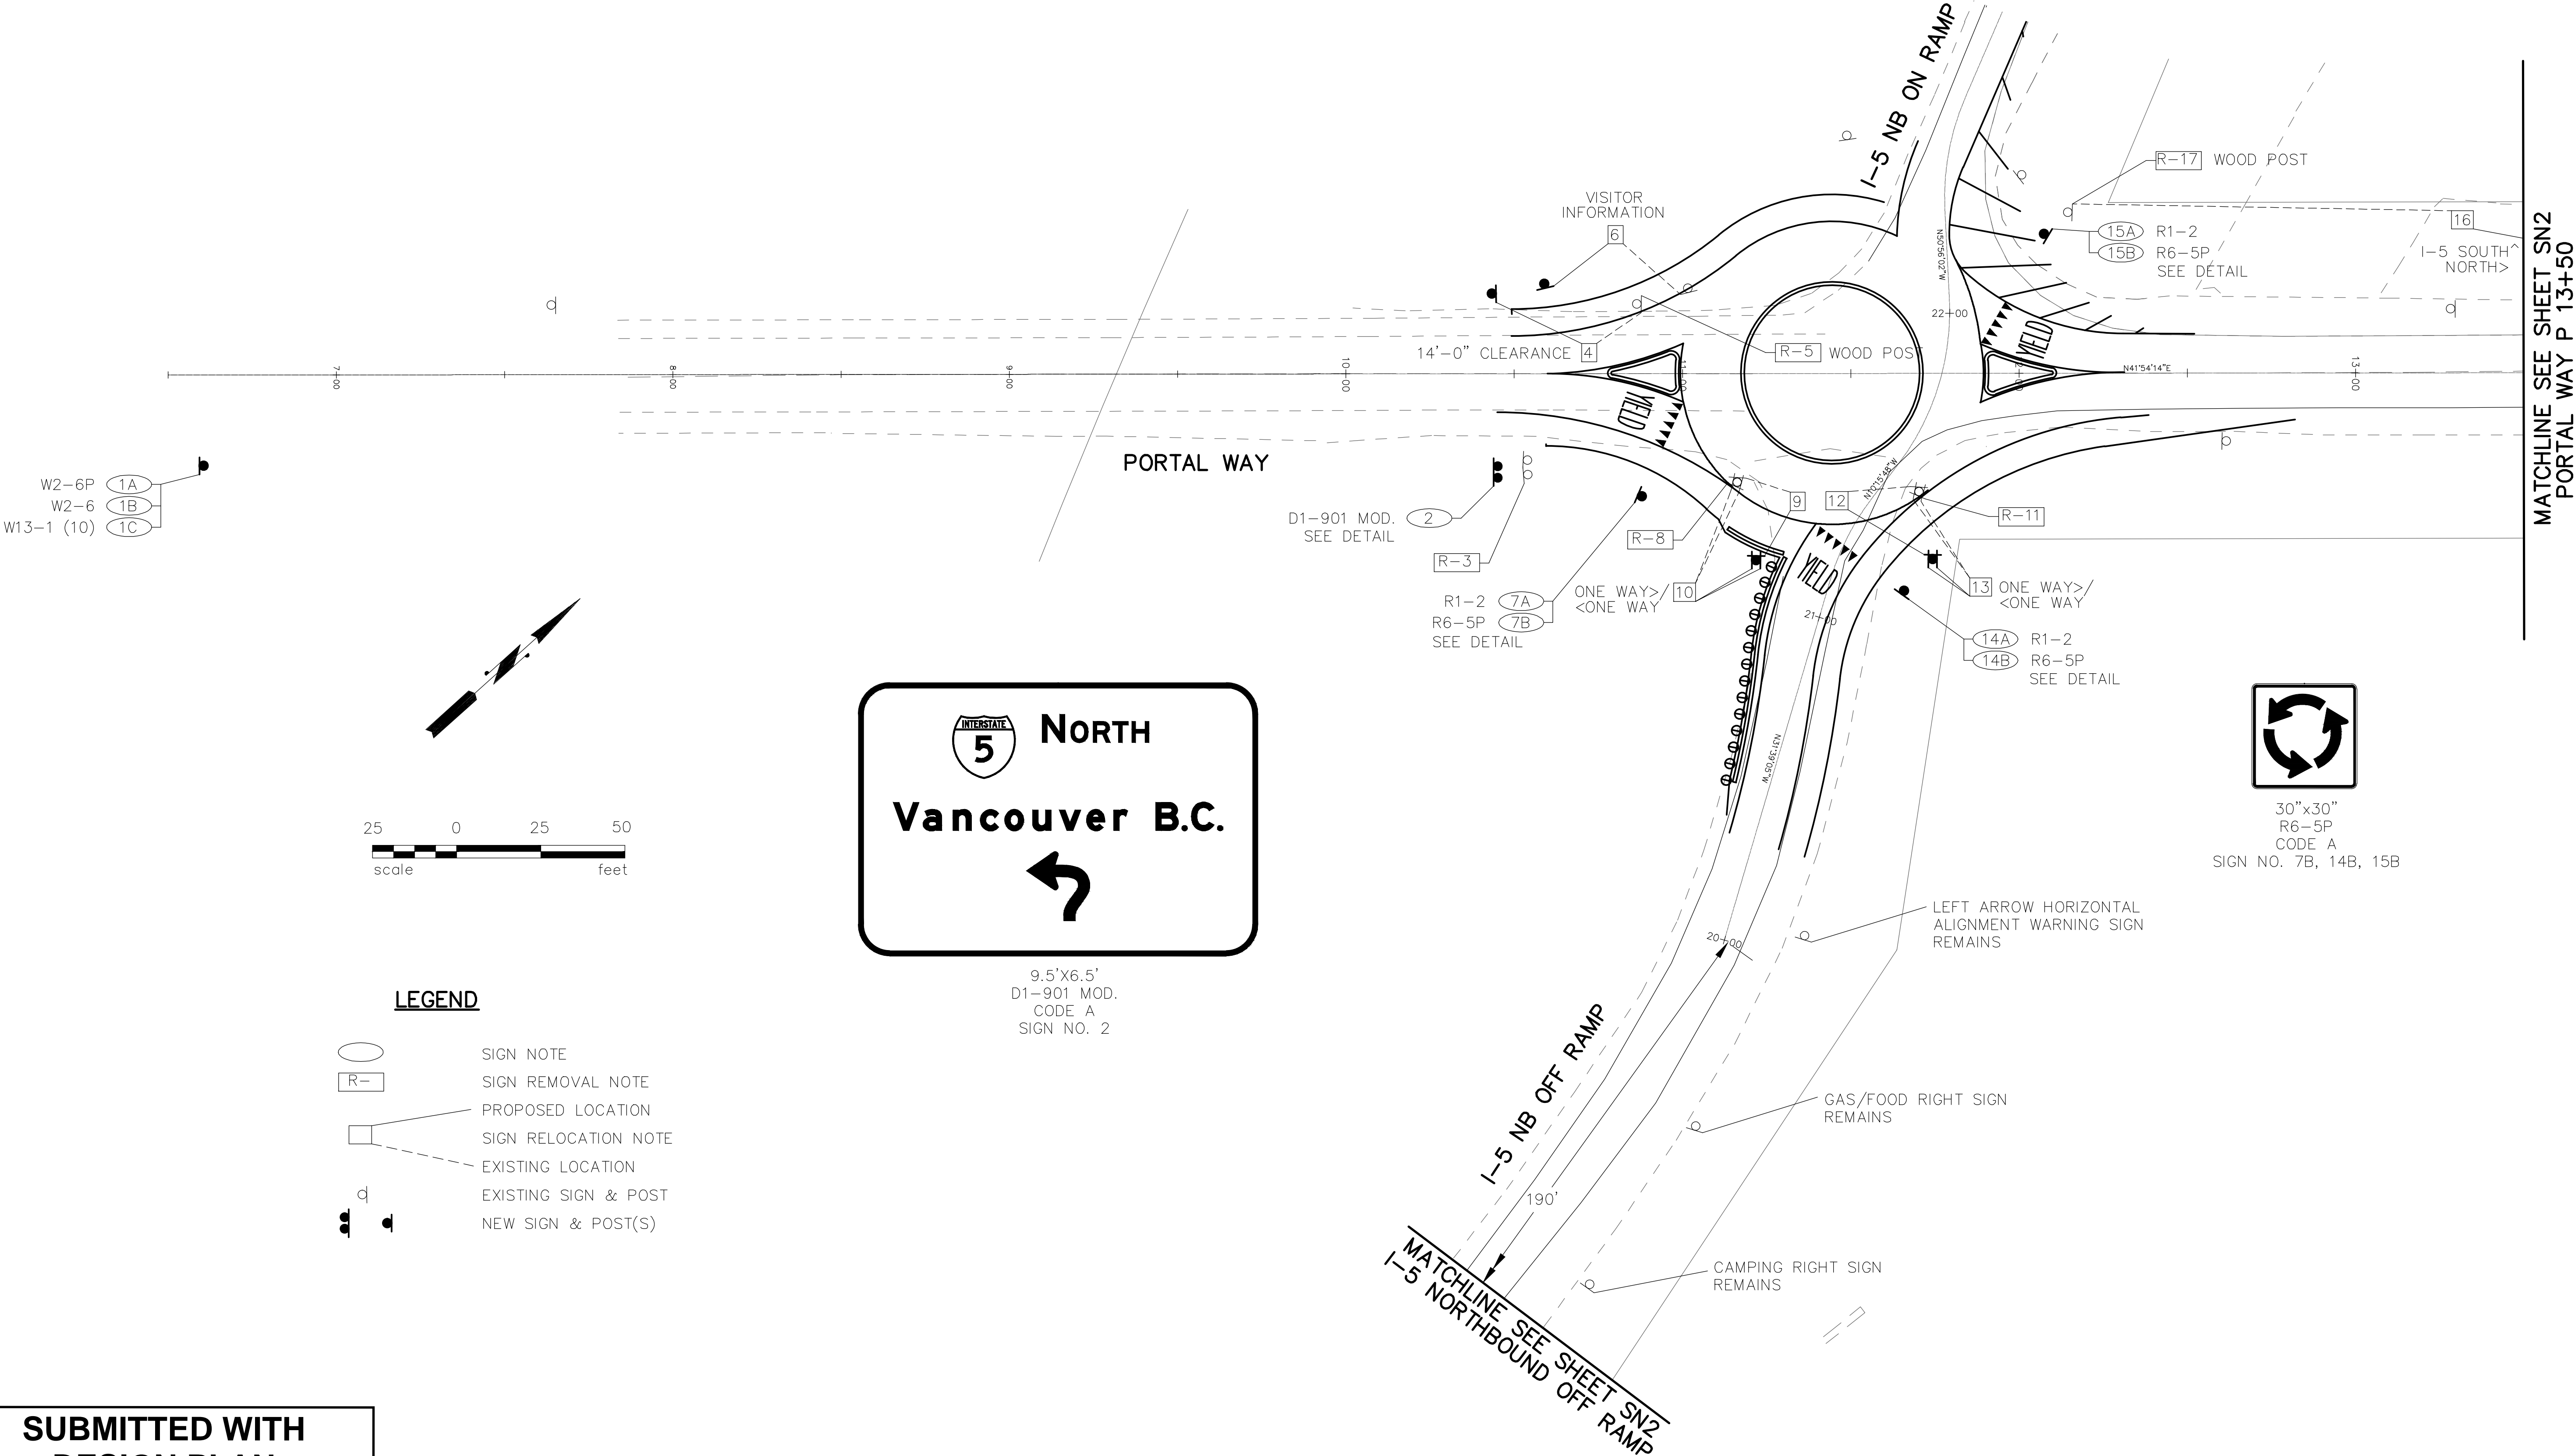

SUBMITTED WITH  
DESIGN PLAN

DRAWN	RMH				
DESIGNED	RMH				
CHECKED	3/29/18 RMH				
PROJ. ENGR.					
DRAWING FILE	SN_rev2.DWG				
DATE	REVISION	BY	APP'D		

REICHHARDT & EBE ENGINEERING, INC.  
P.O. Box 978  
Lynden, Washington 98264

CITY OF FERDALE  
P.O. Box 936  
Ferndale, Washington 98248




**HTE** HERMAN TRAFFIC ENGINEERING

11215 Southeast 220th Place, Kent, Washington 98031  
253-236-4941 tel. hte@comcast.net

I-5	MP 263.48	SN1
I-5 NB RAMPS/PORTAL WAY		SHEET
FERDALE, WHATCOM COUNTY		OF
SIGNING PLAN		SHEETS



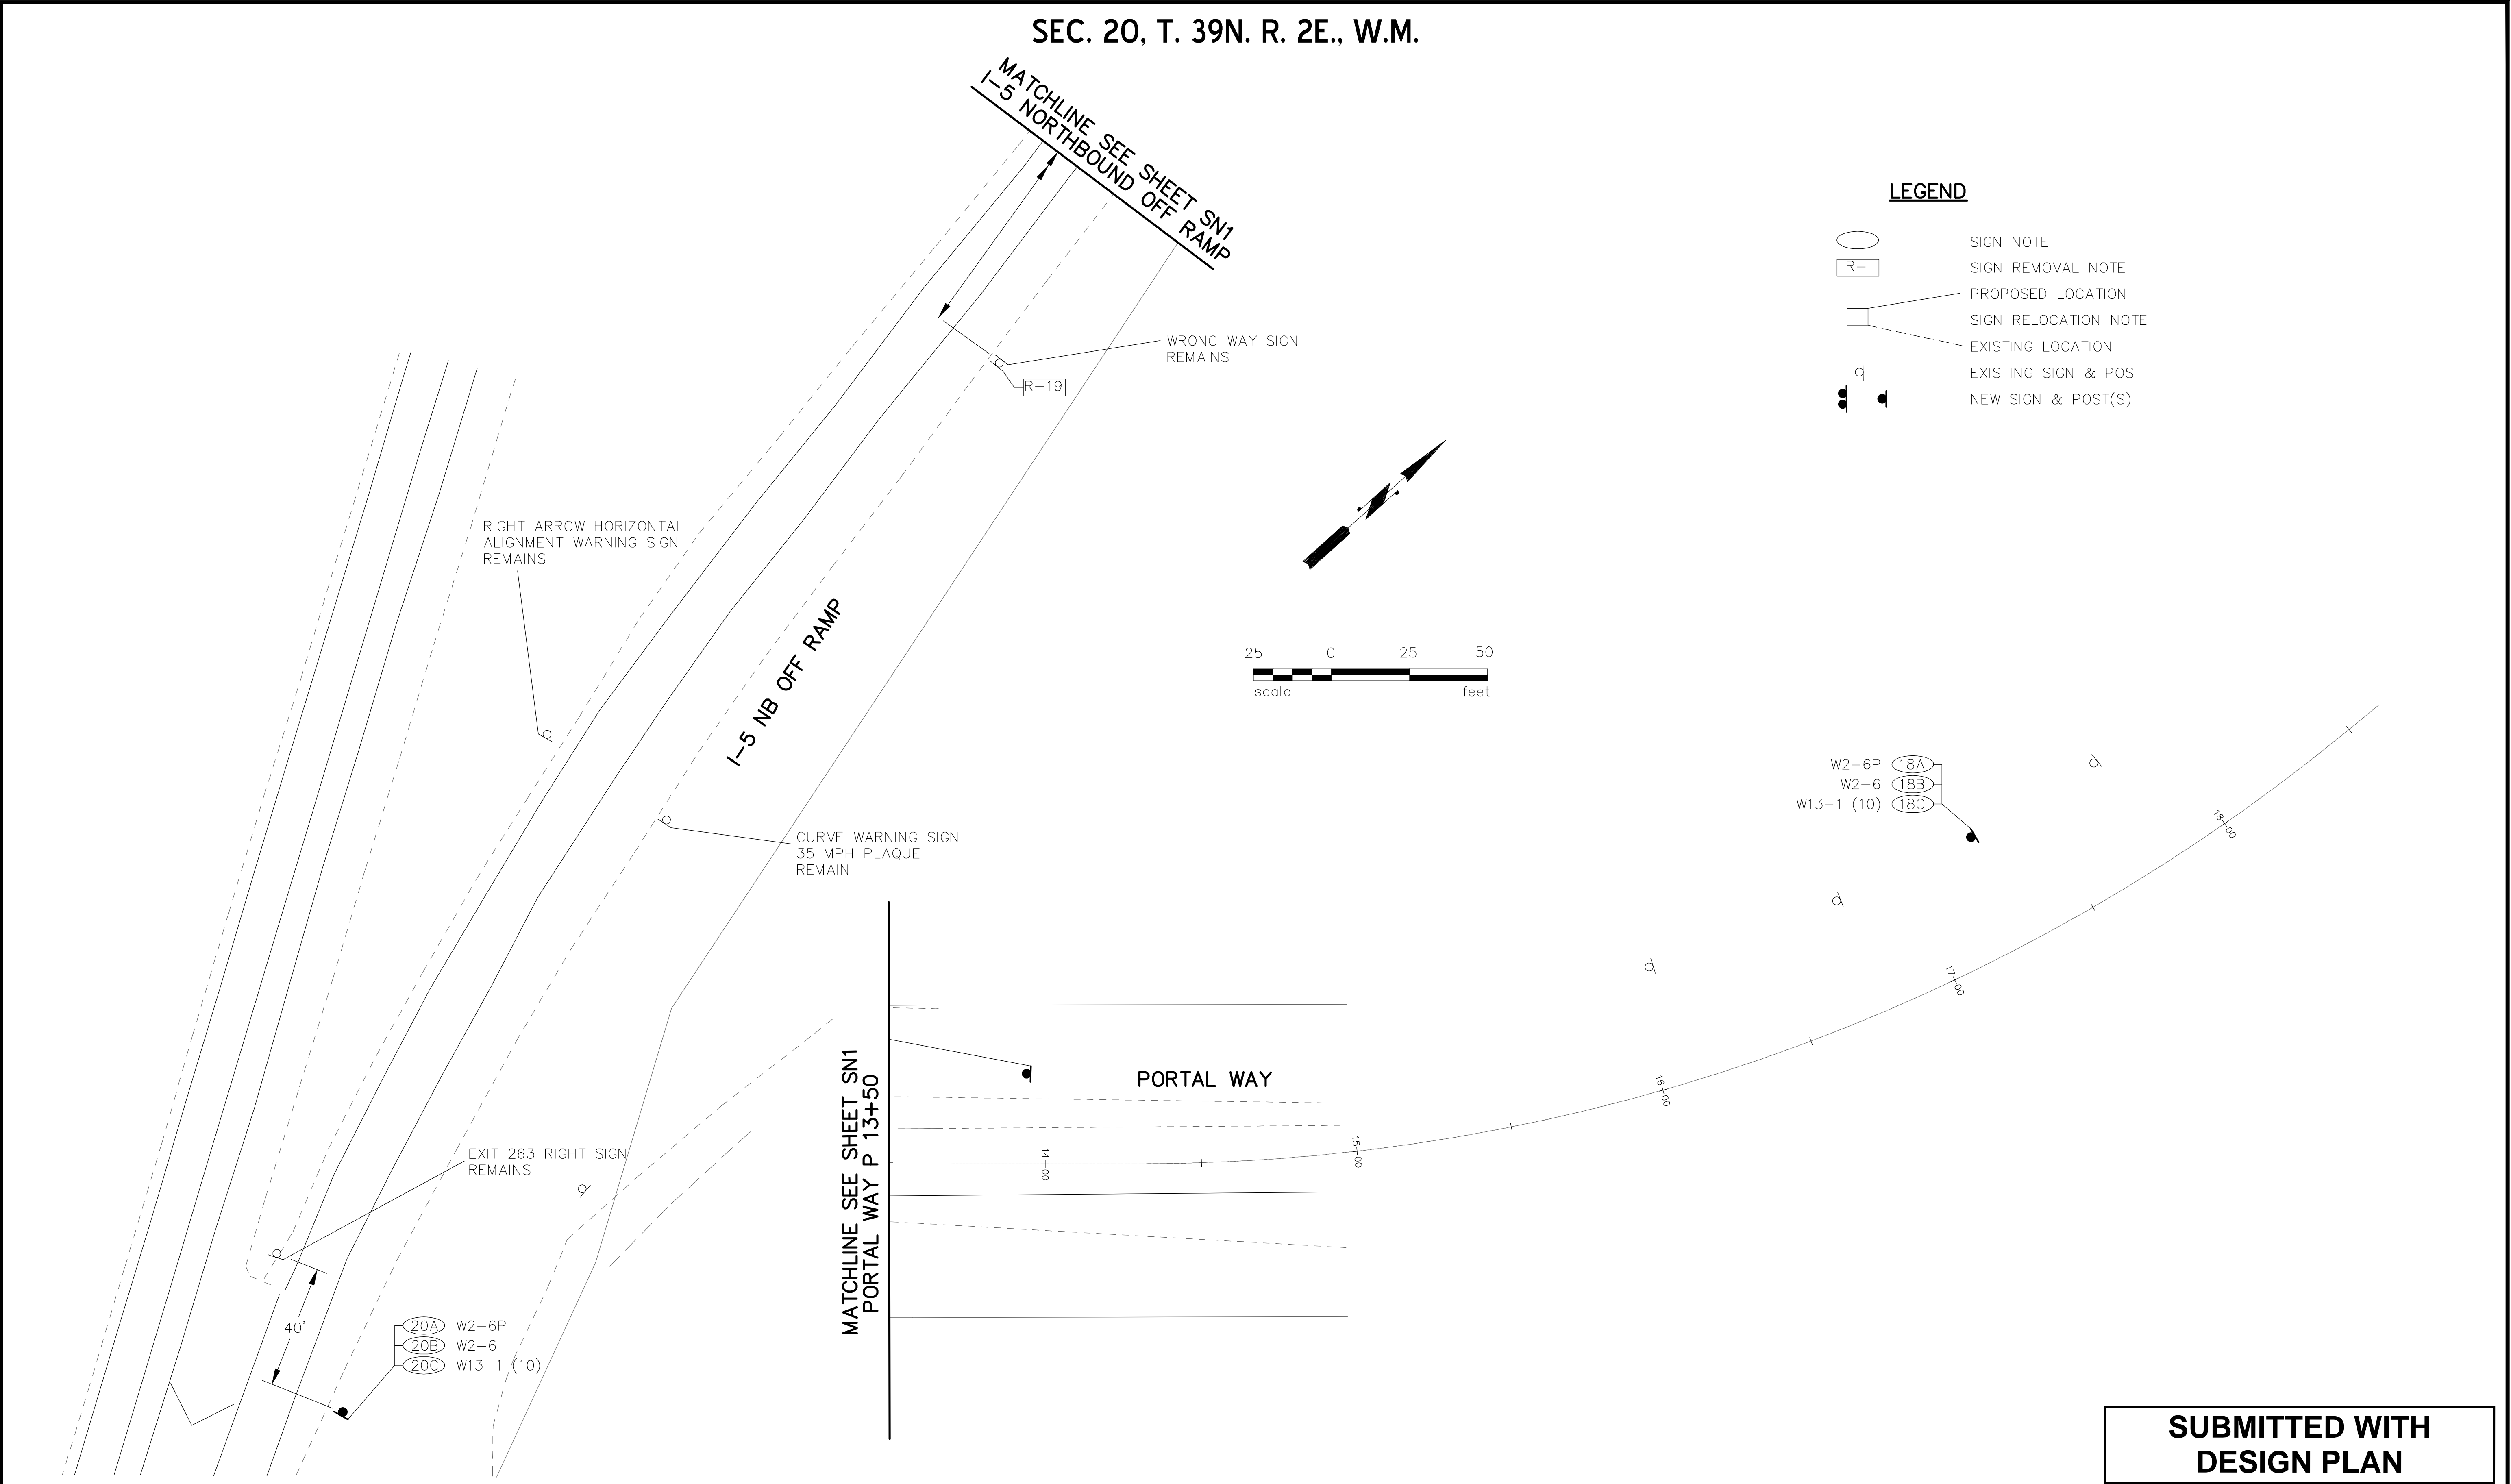

DRAWN	RMH				
DESIGNED	RMH				
CHECKED	3/29/18 RMH				
PROJ. ENGR.					
DRAWING FILE	SN_rev2.DWG				
DATE		REVISION		BY	APP'D

REICHHARDT & EBE ENGINEERING, INC.  
P.O. Box 978  
Lynden, Washington 98264



CITY OF FERDALE  
P.O. Box 936  
Ferndale, Washington 98248



**HTE** HERMAN TRAFFIC ENGINEERING

11215 Southeast 220th Place, Kent, Washington 98031  
253-236-4941 tel. hte@comcast.net

I-5	MP 263.48	SN2
I-5 NB RAMPS/PORTAL WAY		
FERDALE, WHATCOM COUNTY		MARCH, 2018
SIGNING PLAN		SHEET
		OF
		SHEETS

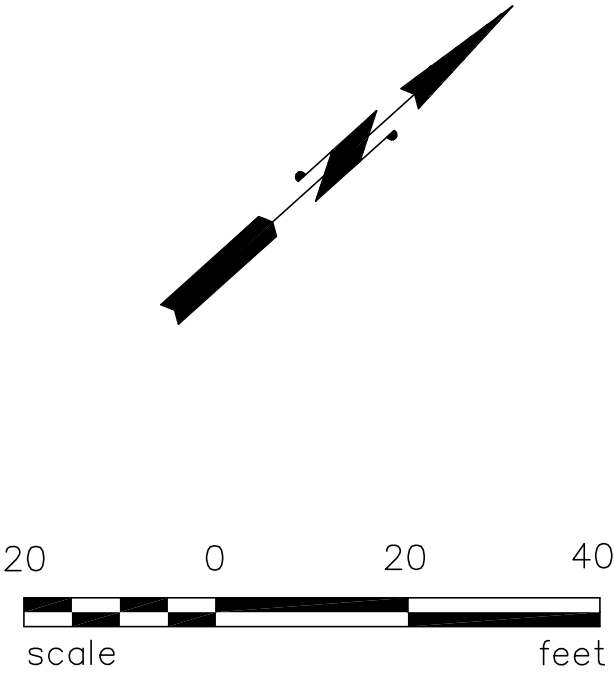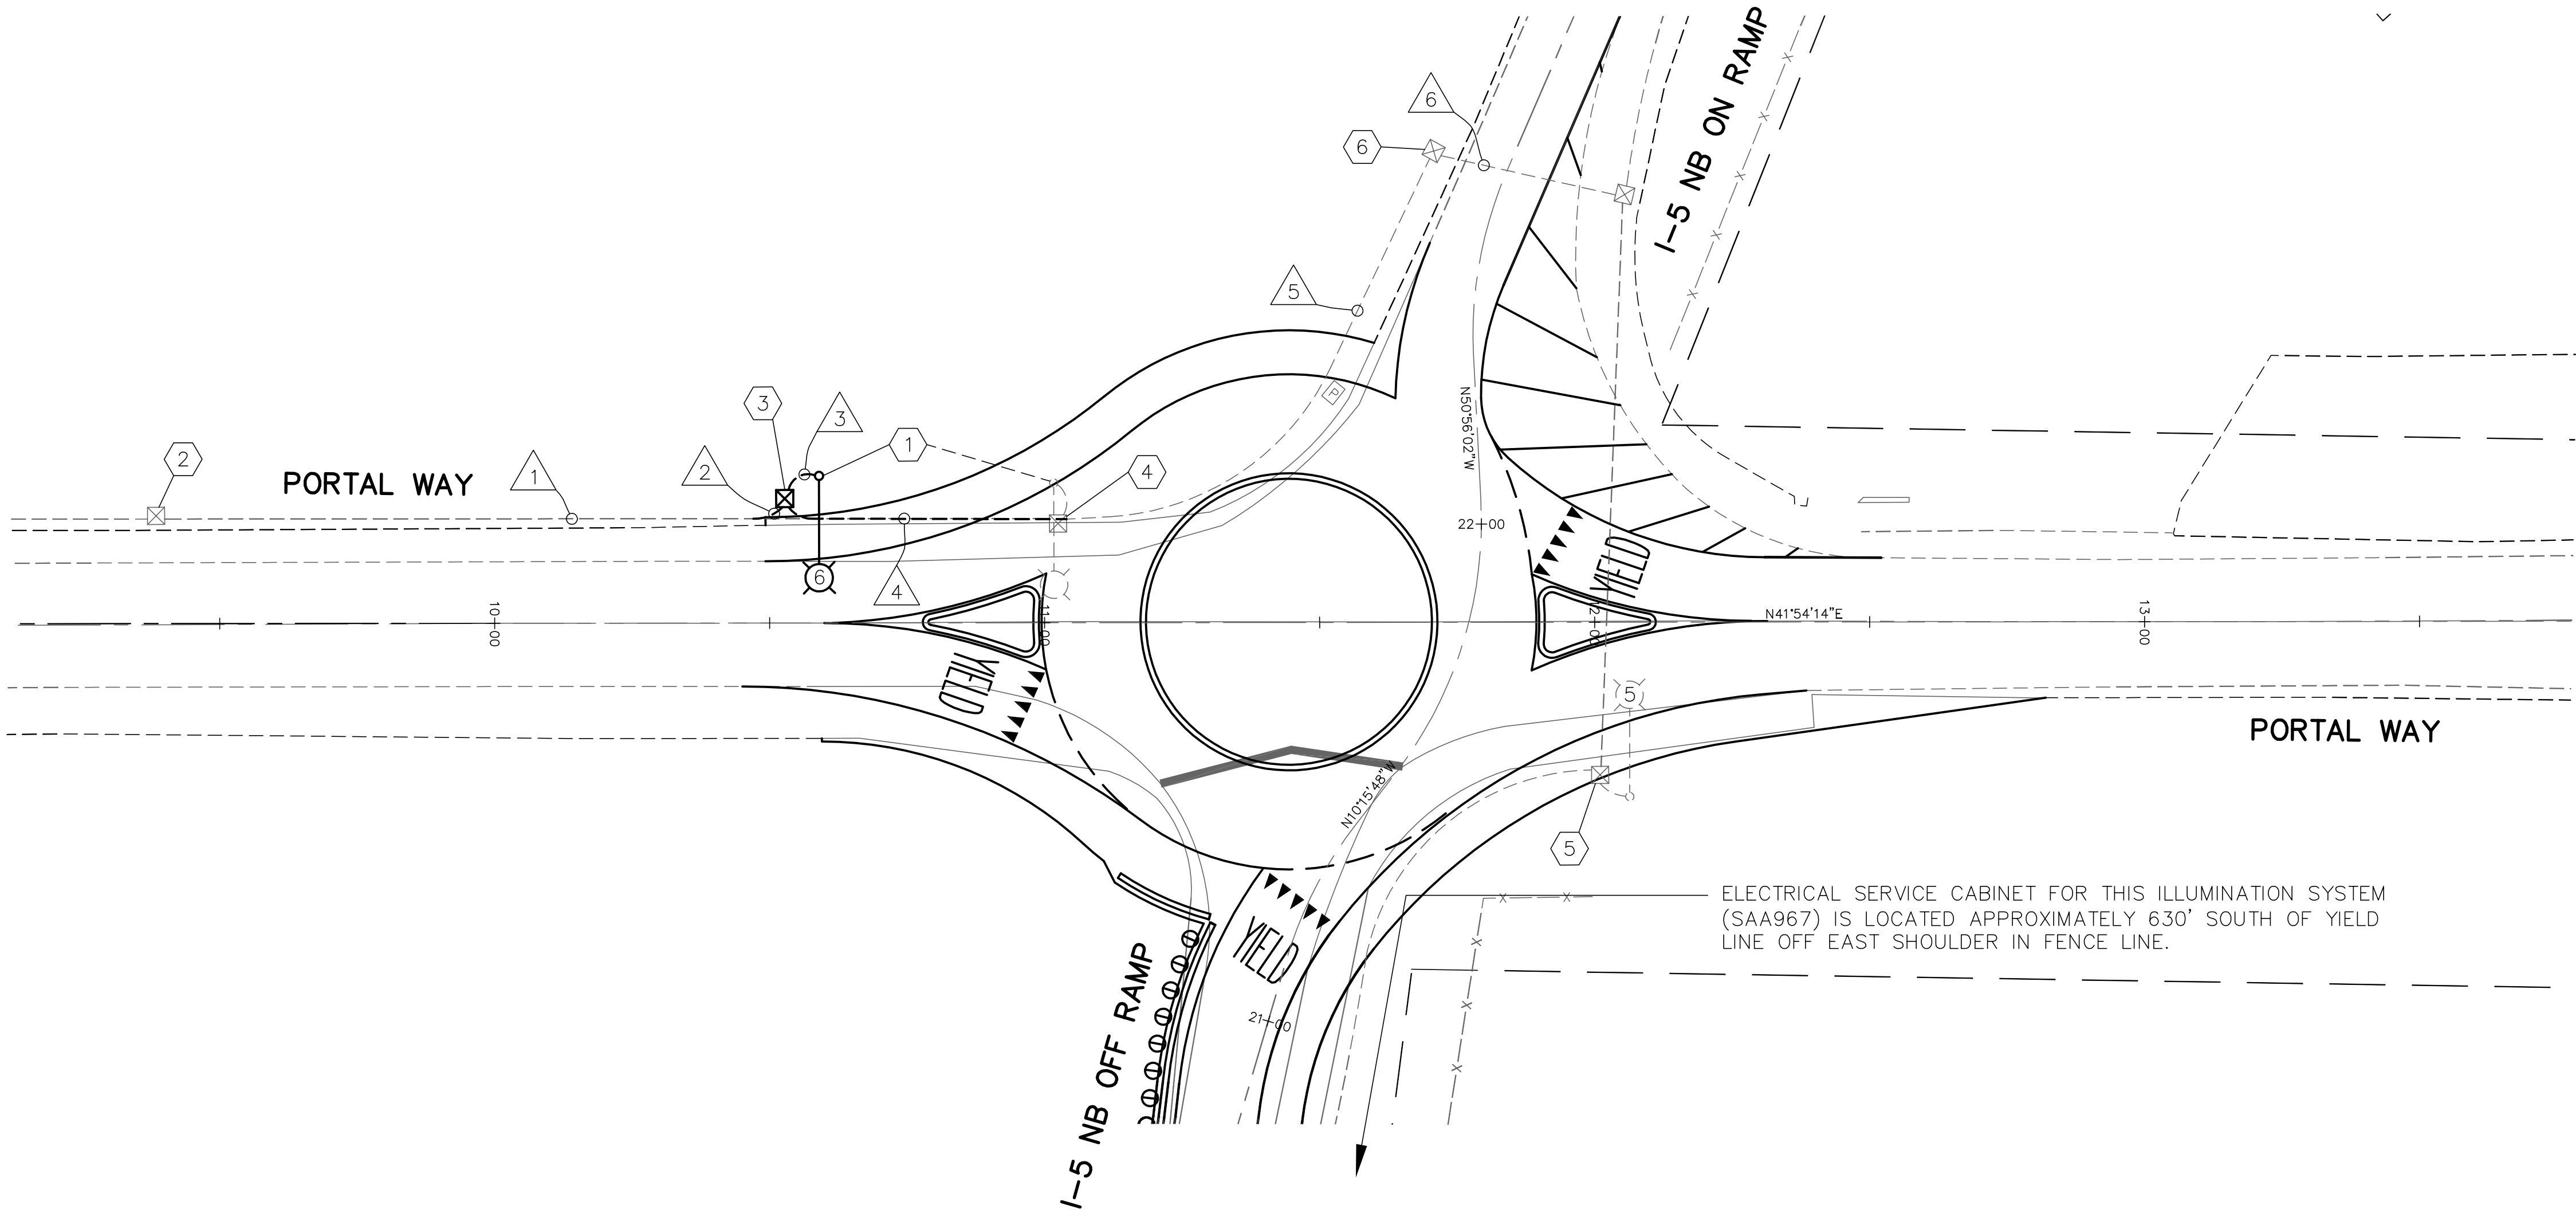

LEGEND

EXISTING	PROPOSED	
		LIGHT STANDARD AND LUMINAIRE
		TYPE 1 JUNCTION BOX
		CONDUIT
		CONSTRUCTION NOTE
		WIRE NOTE

GENERAL NOTES

- ALL WORK SHALL BE PERFORMED IN ACCORDANCE WITH THE 2016 WSDOT STANDARD SPECIFICATIONS FOR ROAD, BRIDGE AND MUNICIPAL CONSTRUCTION AND ITS AMENDMENTS, SPECIAL PROVISIONS, WSDOT STANDARD PLANS AND NATIONAL ELECTRICAL CODE (ALL CURRENT VERSIONS).
- WORK SHALL BE STAGED SO NO PORTION OF EXISTING STREET LIGHTING SYSTEM IS INOPERABLE DURING HOURS OF DARKNESS.
- INSTALL A ONE FOOT WIDE AND ONE FOOT DEEP RECTANGULAR CONCRETE COLLAR AROUND THE PERIMETER OF EACH NEW TYPE 1 AND TYPE 2 JUNCTION BOX INSTALLED IN GRADE. THE EXPOSED PORTIONS SHALL BE FORMED TO HAVE A NEAT APPEARANCE. THE TOP EDGES SHALL HAVE A 3/4-INCH CHAMFER ON THE TOP EDGE OF THE FOUNDATION. THE CONCRETE MIX DESIGN SHALL BE COMMERCIAL CONCRETE PER STANDARD SPECIFICATION 6-02.3(2)B.

CONSTRUCTION NOTES

- CONSTRUCT FOUNDATION AND RELOCATE EXISTING LIGHT STANDARD AND LUMINAIRE TO NEW FOUNDATION. REMOVE EXISTING FOUNDATION IN ITS ENTIRETY. SEE LUMINAIRE SCHEDULE. USE WSDOT STANDARD PLAN J-28.30-03.
- DISCONNECT EXISTING CONDUCTORS AT JUNCTION BOX TO EAST AND PULL BACK TO JUNCTION BOX. REPULL EXISTING CONDUCTORS THROUGH NEW CONDUIT TO NEW JUNCTION BOX TO EAST.
- INTERCEPT EXISTING CONDUIT AND SWEEP INTO NEW JUNCTION BOX (WEST RUN ONLY). INSTALL OTHER CONDUIT AND CONDUCTORS PER WIRING SCHEDULE.
- REMOVE EXISTING JUNCTION BOX, CONDUIT SWEEPS AND CONDUCTORS. EXTEND EXISTING CONDUIT WEST TO JUNCTION BOX AT NEW LIGHT STANDARD LOCATION. ABANDON EXISTING CONDUIT TO WEST.
- ADJUST EXISTING JUNCTION BOX TO GRADE.
- SPLICE EXISTING CONDUCTORS TO NEW CONDUCTORS IN EXISTING JUNCTION BOX.

SUBMITTED WITH  
DESIGN PLAN

LUMINAIRE SCHEDULE

LUM. NO.	POLE LOCATION	CIRCUITS	TYPE-DISTRIBUTION-WATTAGE	MAST ARM LENGTH	H1	FOUNDATION TYPE	BASE TYPE
6	STA 10+59.00, 26.73' LT.	EX A	EX	EX	EX	B	EX

WIRING SCHEDULE

CONDUIT RUN 	CONDUIT SIZE	CONDUCTORS		CIRCUIT	REMARKS
		ILLUM #8	GROUND #8		
1	EX 1.25"	EX 2	EX 1	B	REMOVE AND REPULL EX CONDUCTORS
2	1.25"	EX 2	EX 1	B	REROUTE EX CONDUCTORS THRU NEW CONDUIT
3	1"	2	1	A	
4	1.25"	4	1	A,B	EXTEND EX CONDUIT TO NEW JUNCTION BOX
5	EX 1.25"	4	1	A,B	REPLACE EX CONDUCTORS
6	EX 2"	EX 4	EX 1	A,B	EX CONDUIT AND CONDUCTORS REMAIN

NOTE: WHERE EXISTING CONDUITS WILL BE EXTENDED, CONTRACTOR SHALL VERIFY EXISTING CONDUIT TYPE AND SIZE PRIOR TO PROCURING MATERIALS.

--	--	


GENERAL NOTES

1.
- ALL WORK SHALL BE PERFORMED IN ACCORDANCE WITH THE 2016 WSDOT STANDARD SPECIFICATIONS FOR ROAD, BRIDGE AND MUNICIPAL CONSTRUCTION AND ITS AMENDMENTS, SPECIAL PROVISIONS, WSDOT STANDARD PLANS AND NATIONAL ELECTRICAL CODE (ALL CURRENT VERSIONS).


2.
- A SINGLE CONTINUOUS SHUTDOWN OF THE WSDOT FIBER NETWORK SHALL ONLY BE ALLOWED FROM MONDAY NIGHT 9:00 PM TO FOLLOWING THURSDAY MORNING 6:00 AM. WEEKS WHEN SHUTDOWN WILL NOT BE ALLOWED ARE:

- SEPTEMBER 1–11
- OCTOBER 5–16
- NOVEMBER 16–27
- DECEMBER 21–JANUARY 8

SHUTDOWN OF ITS DETECTOR LOOPS SHALL BE LIMITED TO FIVE DAYS.

CONSTRUCTION NOTES

- 1
- DISCONNECT AND REMOVE EXISTING LOOP LEAD-IN CABLE(S) IN EXISTING JUNCTION BOX. RE-INSTALL EXISTING CABLE(S) AND SPLICE TO EXISTING LOOP WIRES PER EXISTING CONDITION.
- 2
- DISCONNECT AND REMOVE EXISTING 48 SMFO CABLE (SOUTH) IN EXISTING CABLE VAULT. RE-INSTALL EXISTING CABLE AND SPLICE TO 48 SMFO CABLE (NORTH) AND 24 PPP PER EXISTING CONDITION.
- 3
- PULL EXISTING LOOP LEAD-IN CABLES (TOTAL OF SIX) BACK TO EXISTING JUNCTION BOX. PROTECT CABLES FOR RE-INSTALLATION.
- 4
- PULL EXISTING 48 SMFO CABLE BACK TO EXISTING PULL BOX. PROTECT CABLE FOR RE-INSTALLATION.
- 5
- REMOVE EXISTING 48 SMFO CABLE AND LOOP LEAD-IN CABLES (TOTAL OF SIX) FROM EXISTING PULL BOX. RELOCATE PULL BOX TO STA. A 23+00, 15' LT. ADJUST ALL CONDUIT ENTERING PULL BOX. RE-INSTALL EXISTING CABLES PER WIRING SCHEDULE.

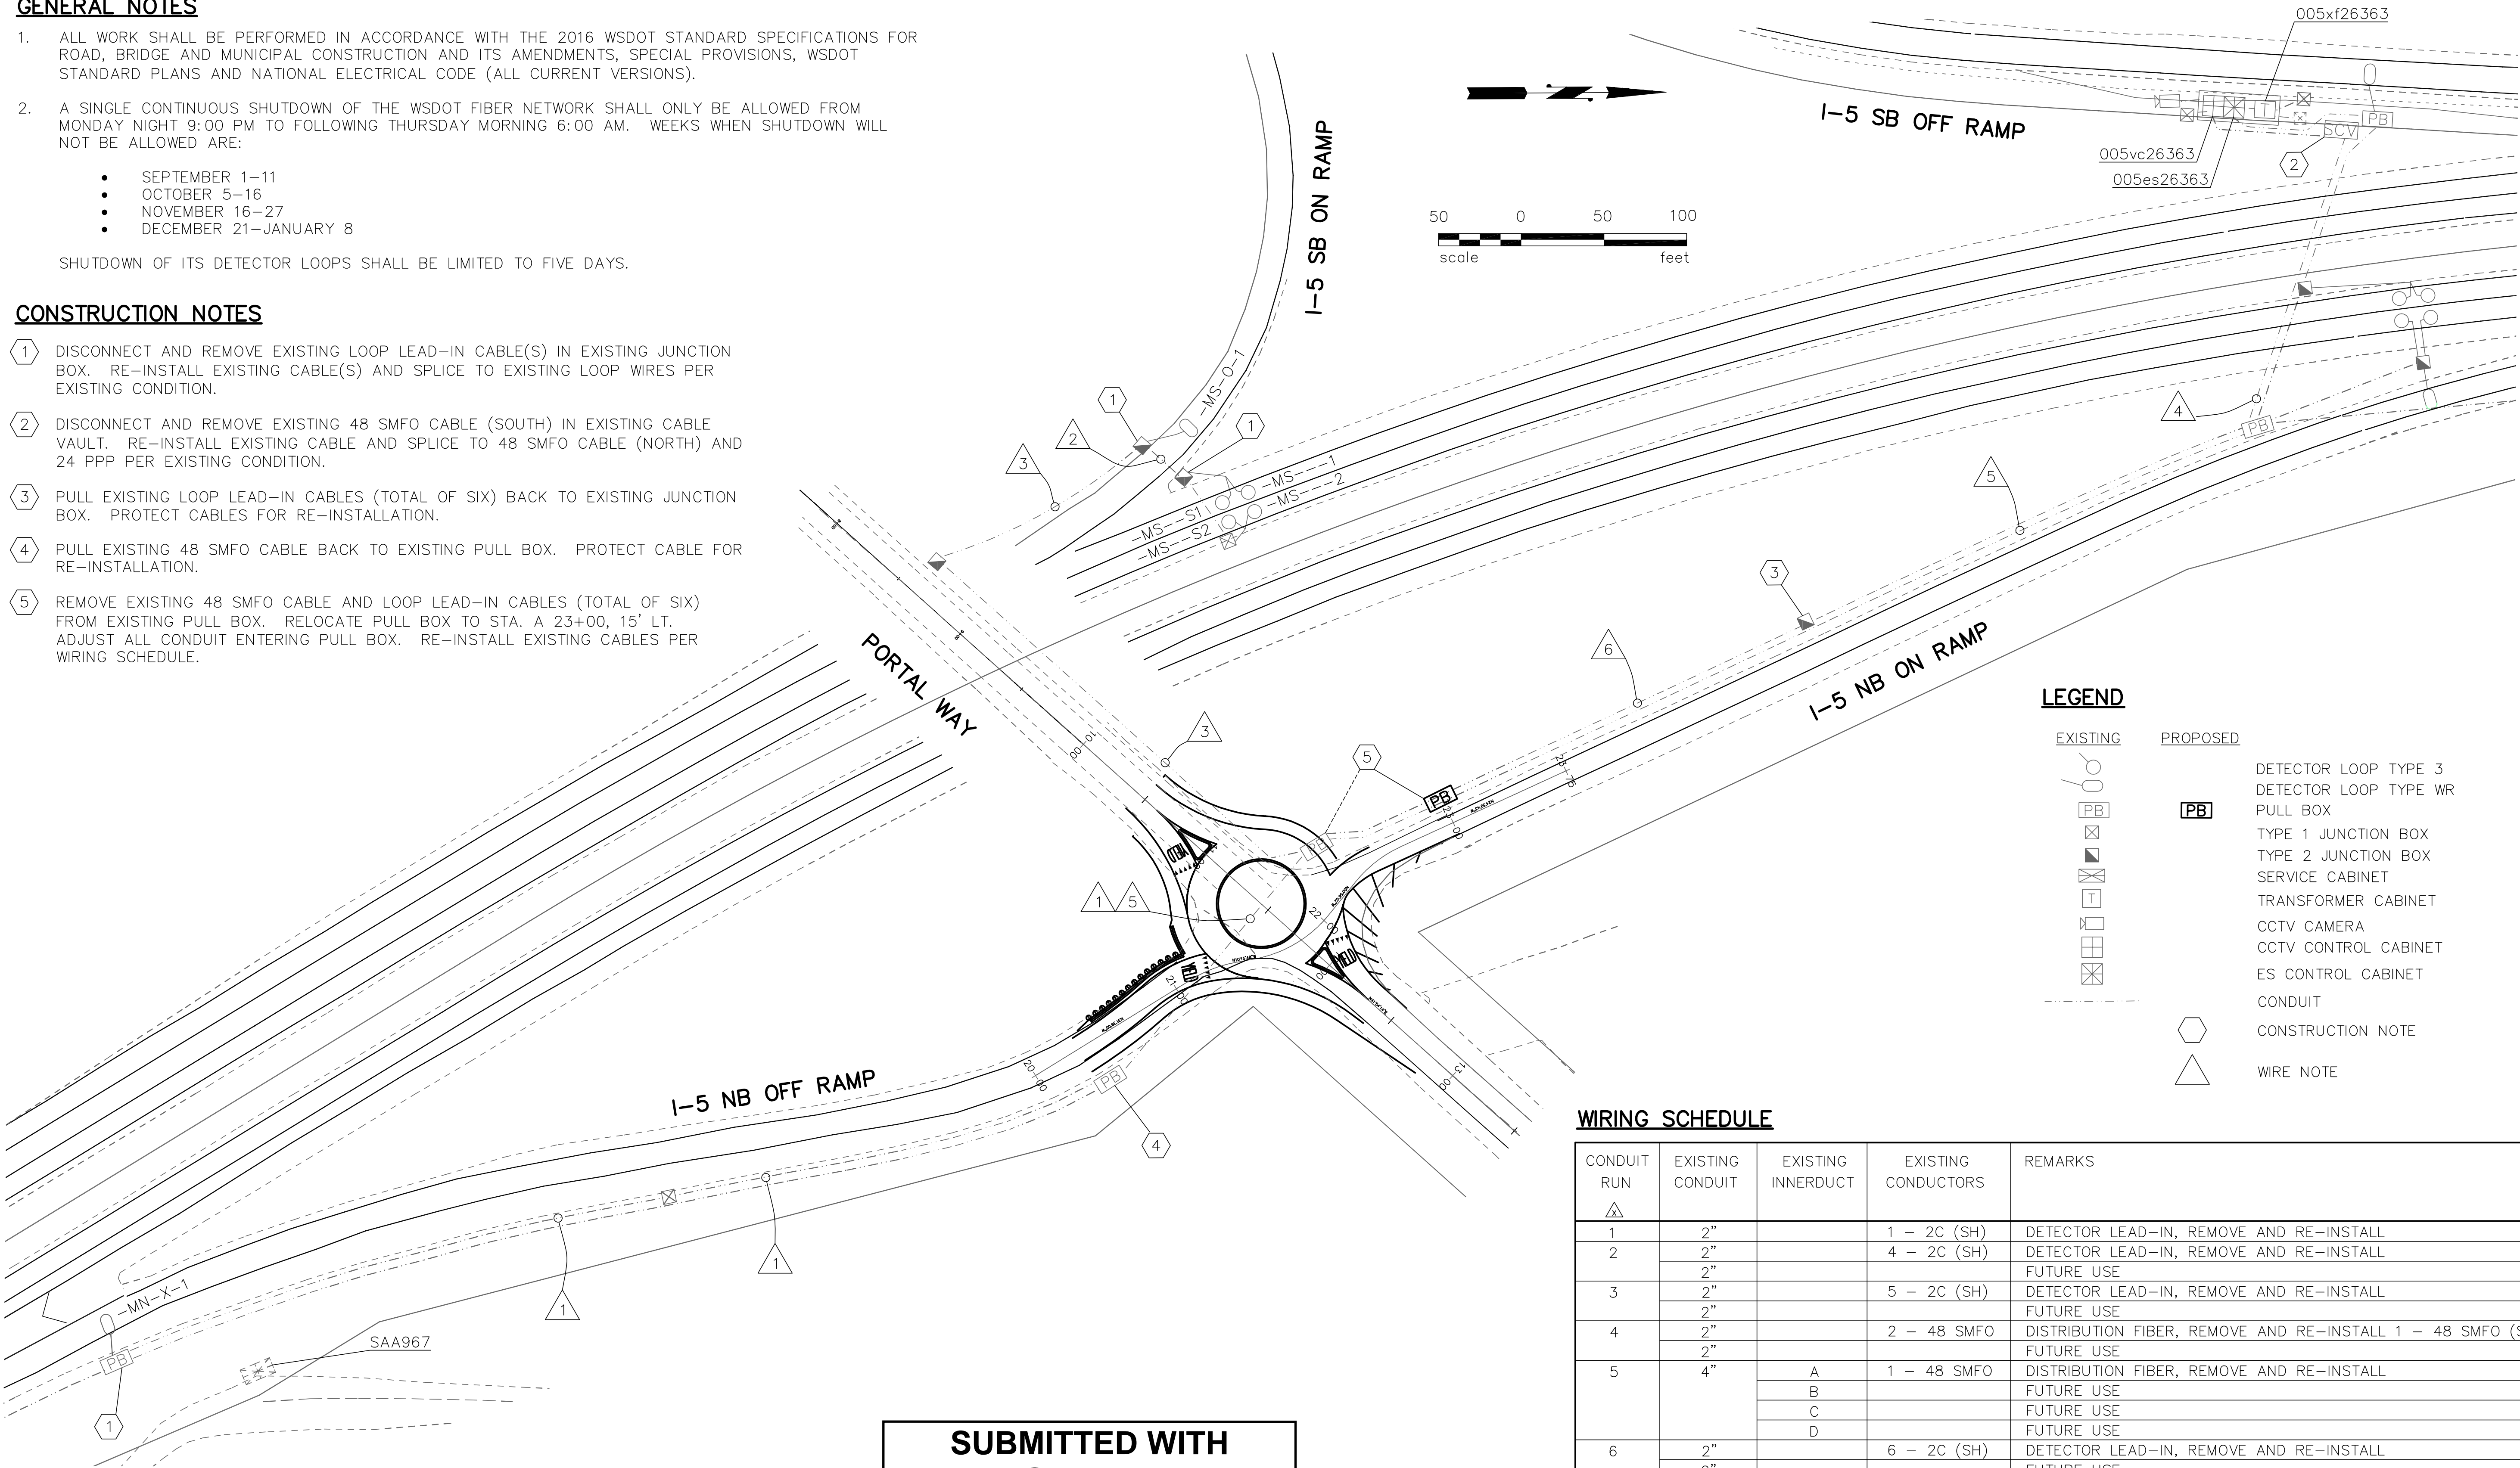

LEGEND

EXISTING

PROPOSED

CONSTRUCTION NOTE

WIRE NOTE

WIRING SCHEDULE

CONDUIT RUN	EXISTING CONDUIT	EXISTING INNERDUCT	EXISTING CONDUCTORS	REMARKS
1	2"		1 – 2C (SH)	DETECTOR LEAD-IN, REMOVE AND RE-INSTALL
2	2"		4 – 2C (SH)	DETECTOR LEAD-IN, REMOVE AND RE-INSTALL
3	2"			FUTURE USE
	2"		5 – 2C (SH)	DETECTOR LEAD-IN, REMOVE AND RE-INSTALL
4	2"			FUTURE USE
	2"		2 – 48 SMFO	DISTRIBUTION FIBER, REMOVE AND RE-INSTALL 1 – 48 SMFO (S)
5	4"			FUTURE USE
		A	1 – 48 SMFO	DISTRIBUTION FIBER, REMOVE AND RE-INSTALL
		B		FUTURE USE
		C		FUTURE USE
6	2"			FUTURE USE
	2"		6 – 2C (SH)	DETECTOR LEAD-IN, REMOVE AND RE-INSTALL
				FUTURE USE

SUBMITTED WITH  
DESIGN PLAN

DRAWN	RMH				
DESIGNED	RMH				
CHECKED	3/29/18 RMH				
PROJ. ENGR.					
DRAWING FILE	IT_rev2.DWG				
DATE	REVISION	BY	APP'D		

REICHHARDT & EBE ENGINEERING, INC.  
P.O. Box 978  
Lynden, Washington 98264

CITY OF FERDALE  
P.O. Box 936  
Ferndale, Washington 98248



HTE HERMAN TRAFFIC ENGINEERING

11215 Southeast 220th Place, Kent, Washington 98031  
253-236-4941 tel. hte@comcast.net

I-5 MP 263.48

I-5 NB RAMPS/PORTAL WAY

FERDALE, WHATCOM COUNTY

MARCH, 2018

ITS RELOCATION PLAN

IT1

SHEET

OF

SHEETS