


220 West Champion Street, Suite 200
Bellingham, WA 98225
t: 360.650.1408
f: 360.650.1401

FREELAND & ASSOCIATES


BY:		DESCRIPTION:	
REV:		DATE:	
PROJECT LOCATION:		CLIENT:	
INNOVATIVE FREEZE-DRIED FOOD		INNOVATIVE FREEZE-DRIED FOOD	
6025 PORTAL WAY FERDALE, WA 98248		6025 PORTAL WAY FERDALE, WA 98248	
DRAWING #: 24048ASB1.DWG		CALL BEFORE YOU DIG FOR BURIED UTILITY LOCATIONS 1-800-424-5655	
DESIGNED BY:		DRAWN BY:	CHECKED BY:
TF		TF	TF
SHEET CONTENTS:			
GREASE INTERCEPTOR			
			
JOB #: 24048		DATE: 03-21-2025	
SHEET:		C1	

APPROVED
03/26/2025

BY: *[Signature]*
CITY OF FERDALE
PUBLIC WORKS DEPARTMENT

AS-BUILT DRAWING


AS-BUILT NOTE:
ONLY INFORMATION NOTED AS AS-BUILT "(AB)"
HAS BEEN PROVIDED BY CONTRACTOR

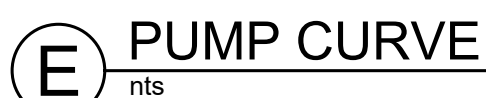[illegible]



1. A COPY OF THE APPROVED TESC PLAN MUST BE ON THE JOB SITE WHENEVER CONSTRUCTION IS IN PROGRESS.
2. APPROVAL OF THIS TEMPORARY EROSION & SEDIMENTATION CONTROL (TESC) PLAN DOES NOT CONSTITUTE AN APPROVAL OF PERMANENT STRUCTURES, DRIVEWAYS OR DRAINAGE DESIGN (E.G., SIZE AND LOCATION OF ROADS, PIPES, RESTRICTORS, CHANNELS, RETENTION FACILITIES, UTILITIES, ETC.).
3. THE IMPLEMENTATION OF THIS TESC PLAN AND THE CONSTRUCTION, MAINTENANCE, REPLACEMENT AND UPGRADING OF THESE TESC FACILITIES IS THE RESPONSIBILITY OF THE CONTRACTOR UNTIL ALL CONSTRUCTION IS APPROVED.
4. THE BOUNDARIES OF THE CLEARING LIMITS SHOWN ON THIS PLAN SHALL BE CLEARLY FLAGGED IN THE FIELD PRIOR TO CONSTRUCTION. DURING CONSTRUCTION, NO DISTURBANCE BEYOND THE FLAGGED CLEARING LIMIT SHALL BE PERMITTED. THE FLAGGING SHALL BE MAINTAINED BY THE CONTRACTOR FOR THE DURATION OF THE CONSTRUCTION.
5. TESC FACILITIES SHOWN ON THIS PLAN MUST BE CONSTRUCTED IN CONJUNCTION WITH ALL CLEARING AND GRADING ACTIVITIES, UNLESS REVISED BY A CERTIFIED EROSION AND SEDIMENT CONTROL LEAD. TESC FACILITIES SHALL BE INSTALLED IN SUCH A MANNER AS TO ENSURE THAT SEDIMENT LAIDEN WATER DOES NOT ENTER DRAINAGE SYSTEM OR VIOLATE APPLICABLE WATER STANDARDS.
6. THE TESC FACILITIES SHOWN ON THIS PLAN ARE THE MINIMUM REQUIREMENTS FOR ANTICIPATED SITE CONDITIONS. DURING THE CONSTRUCTION PERIOD, THESE TESC FACILITIES SHALL BE UPGRADED (E.G., ADDITIONAL PUMPS, RELOCATION OF DITCHES AND SILT FENCES, ETC.) AS NEEDED FOR UNEXPECTED STORM EVENTS.
7. THE TESC FACILITIES SHALL BE INSPECTED DAILY BY THE CESCL AND MAINTAINED AS NECESSARY TO ENSURE THEIR CONTINUED FUNCTION.
8. ANY AREA NEEDING TESC MEASURES, NOT REQUIRING IMMEDIATE ATTENTION, SHALL BE ADDRESSED WITHIN (15) DAYS.
9. THE TESC FACILITIES ON INACTIVE SITES SHALL BE INSPECTED AND MAINTAINED A MINIMUM OF ONCE A MONTH OR WITHIN 24 HOURS FOLLOWING A STORM EVENT THAT PRODUCES RUNOFF FROM THE SITE.
10. WASH PADS MAY BE NECESSARY TO ENSURE PAVED AREAS ARE KEPT CLEAN FOR THE DURATION OF THE PROJECT.
11. MULCHING OF ANY TYPE SHALL BE INSTALLED PER THE RATES AND STANDARDS PRESENTED IN VOL. II, TABLE 4.1.8 OF THE STORMWATER MANAGEMENT MANUAL FOR WESTERN WASHINGTON, 2014 EDITION BY DEPARTMENT OF ECOLOGY.
12. ALL WORK AND MATERIAL SHALL BE IN ACCORDANCE WITH WASHINGTON STATE DEPARTMENT OF TRANSPORTATION STANDARDS AND SPECIFICATIONS.
13. EROSION & SEDIMENTATION CONTROL FACILITIES SHALL BE CONSTRUCTED IN ACCORDANCE WITH THE DETAILS ON THIS PLAN. LOCATIONS MAY BE MOVED TO SUIT FIELD CONDITIONS, SUBJECT TO APPROVAL BY THE CONTRACTORS CESCL OR ENGINEER OF RECORD.
14. COVER ALL DIRT/TOPOSOIL PILES WITH PLASTIC SHEETING (BMP C12) DURING CONSTRUCTION WHEN NOT IN USE.
15. NETS AND/OR EROSION CONTROL BLANKETS (BMP C122) MAY BE USED IN LIEU OF TEMPORARY MULCHING.
16. CONSTRUCTION SCHEDULE – PENDING APPROVAL OF PLANS FROM THE CITY OF FERNDALE.
17. ADDITIONAL BMPs MAY BE USED OR REQUIRED AS CONDITIONS WARRANT. BMPs SHALL BE INSTALLED PER RECOMMENDATIONS IN THE DOE STORMWATER MANAGEMENT MANUAL FOR WESTERN WASHINGTON, CURRENT EDITION.

EROSION CONTROL NOTES

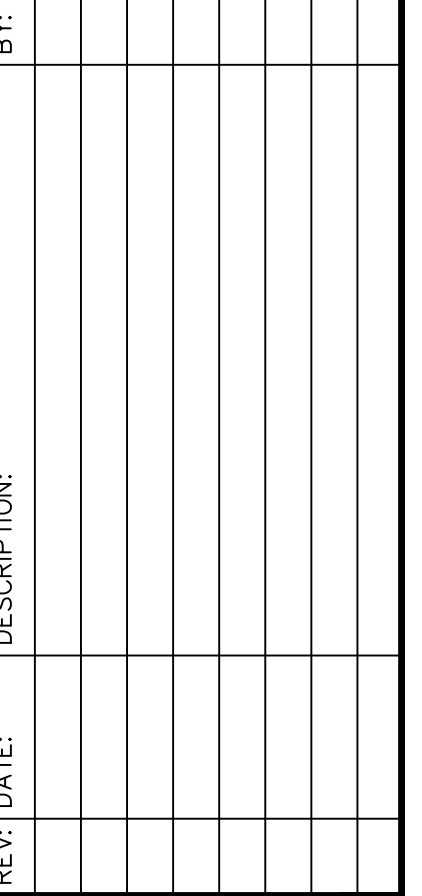

FOR BURIED UTILITY LOCATIONS
1-800-424-5555

DRAWN BY:

TF

TF

DETAILS



DOB #: 24048	DATE: 03-21-2025
-----------------	---------------------

C3

BY: By Hunter For Kevin
CITY OF FERNDALE
PUBLIC WORKS DEPARTMENT

AS-BUILT DRAWING

AS-BUILT NOTE:

ONLY INFORMATION NOTED AS AS-BUILT "(AB)"
HAS BEEN PROVIDED BY CONTRACTOR

