
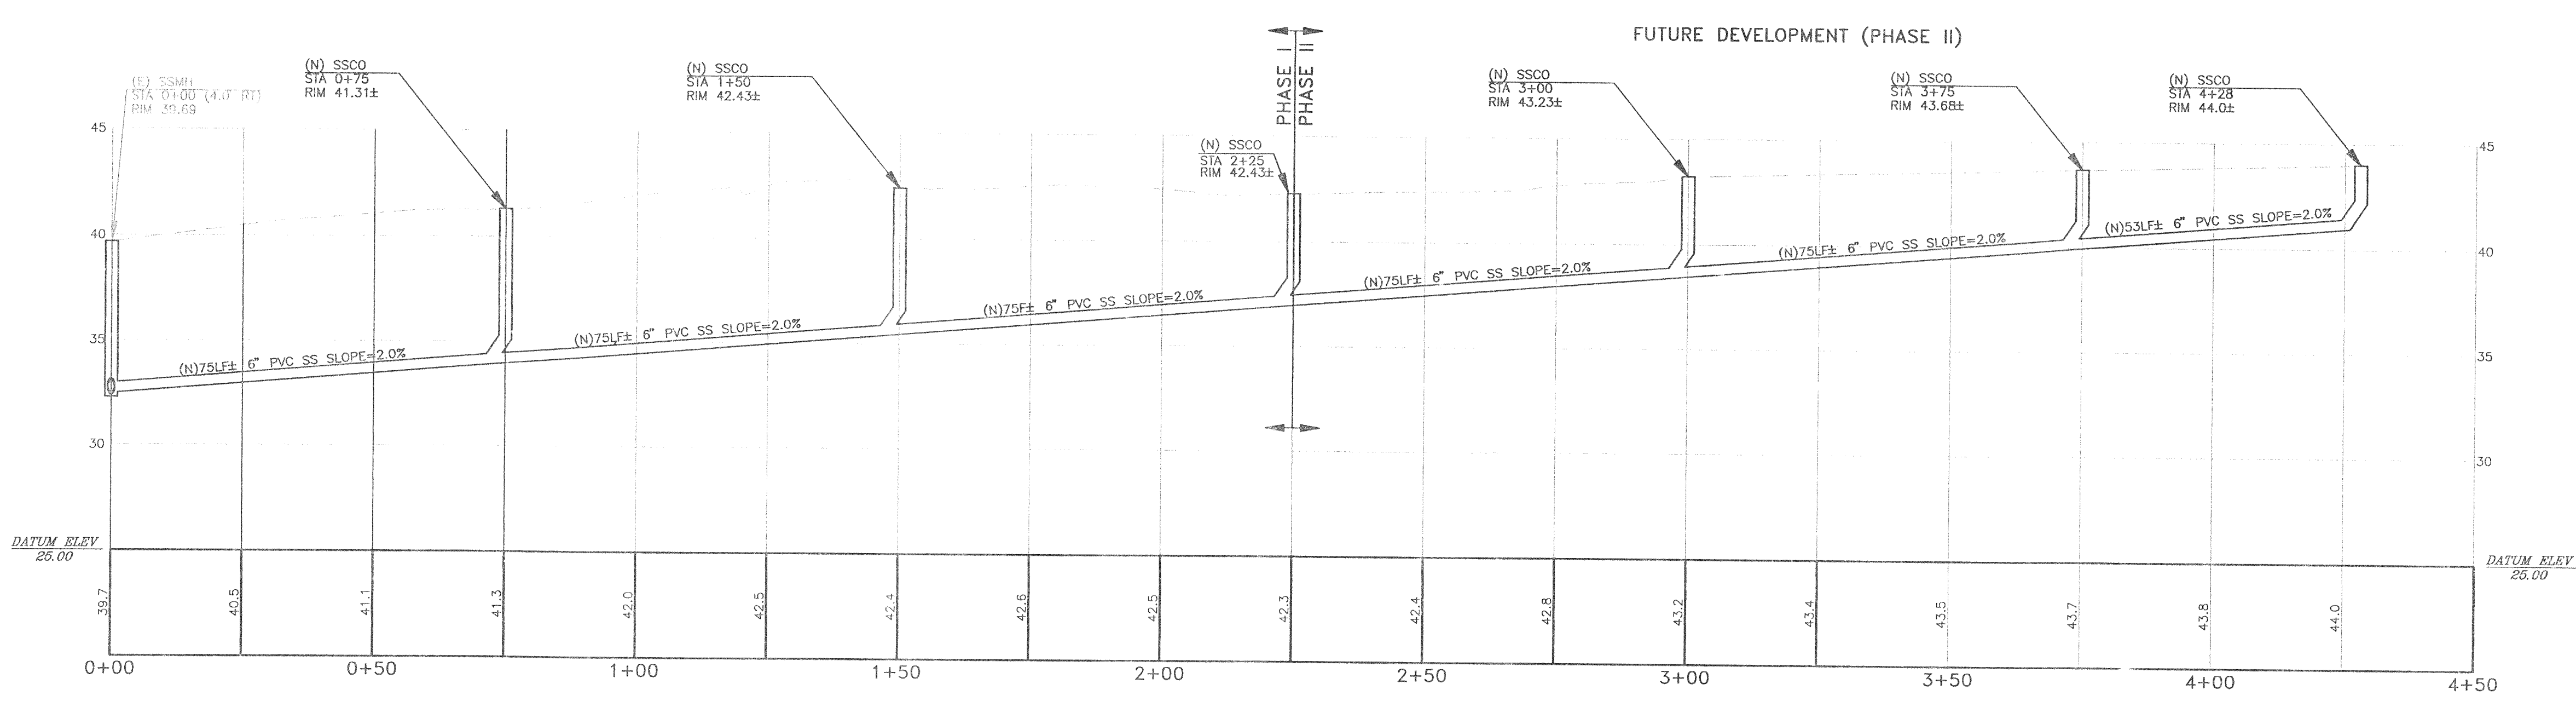
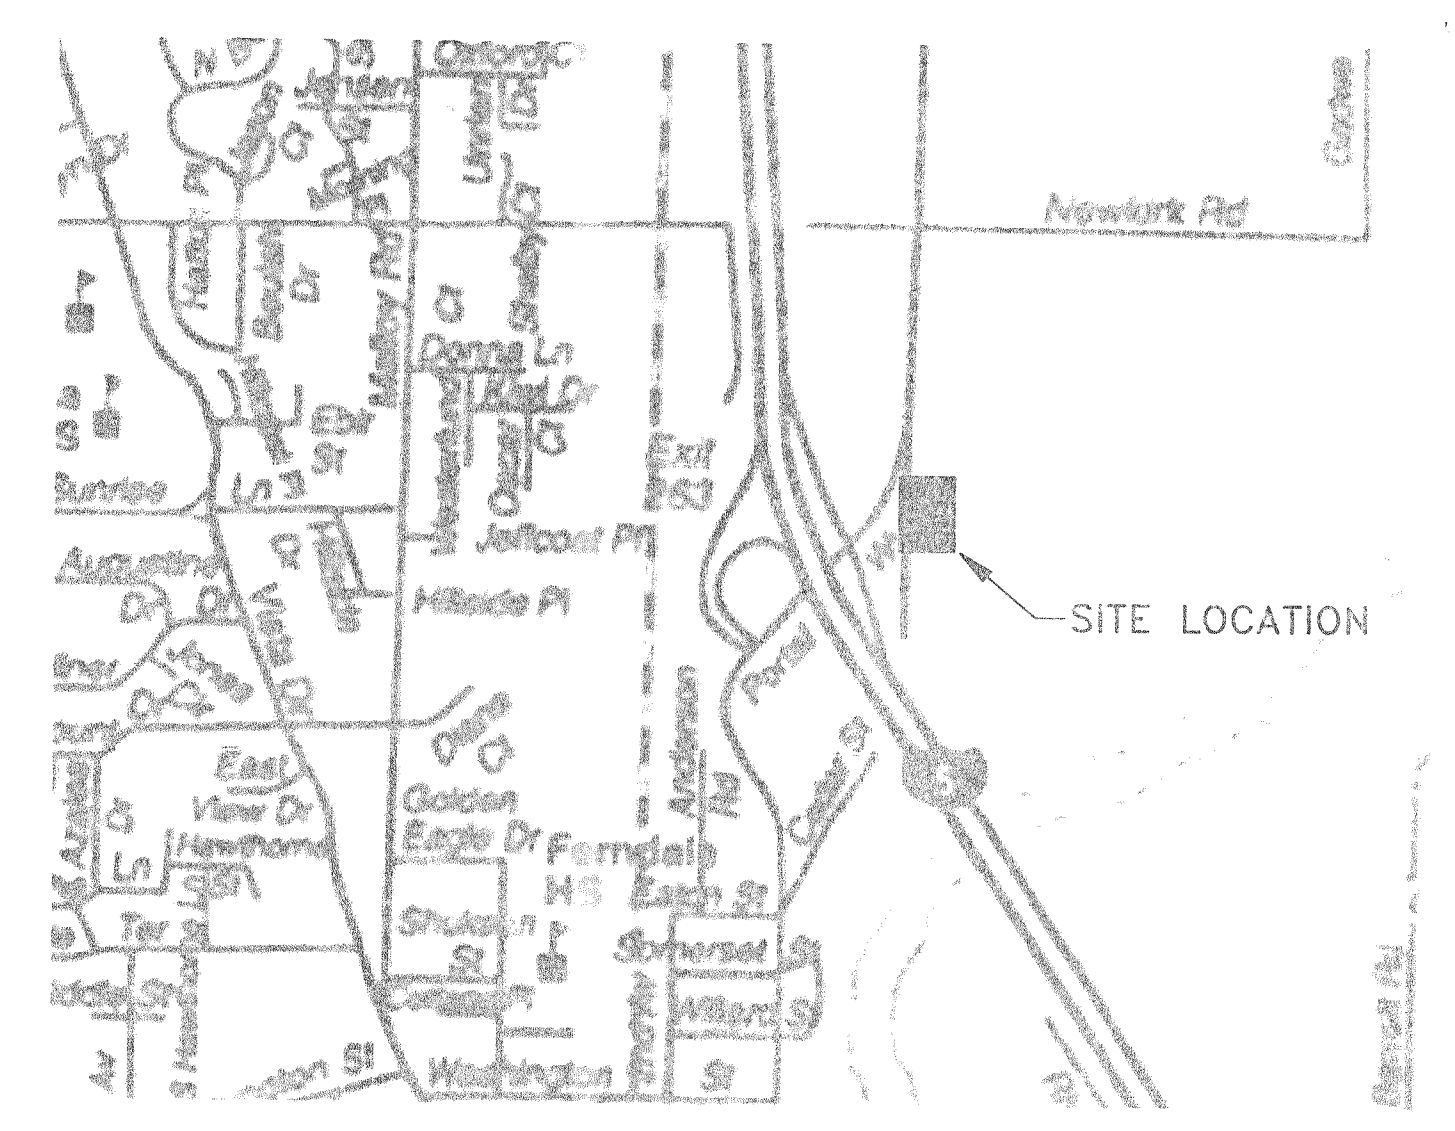


003+2.001 3.22.07 K2

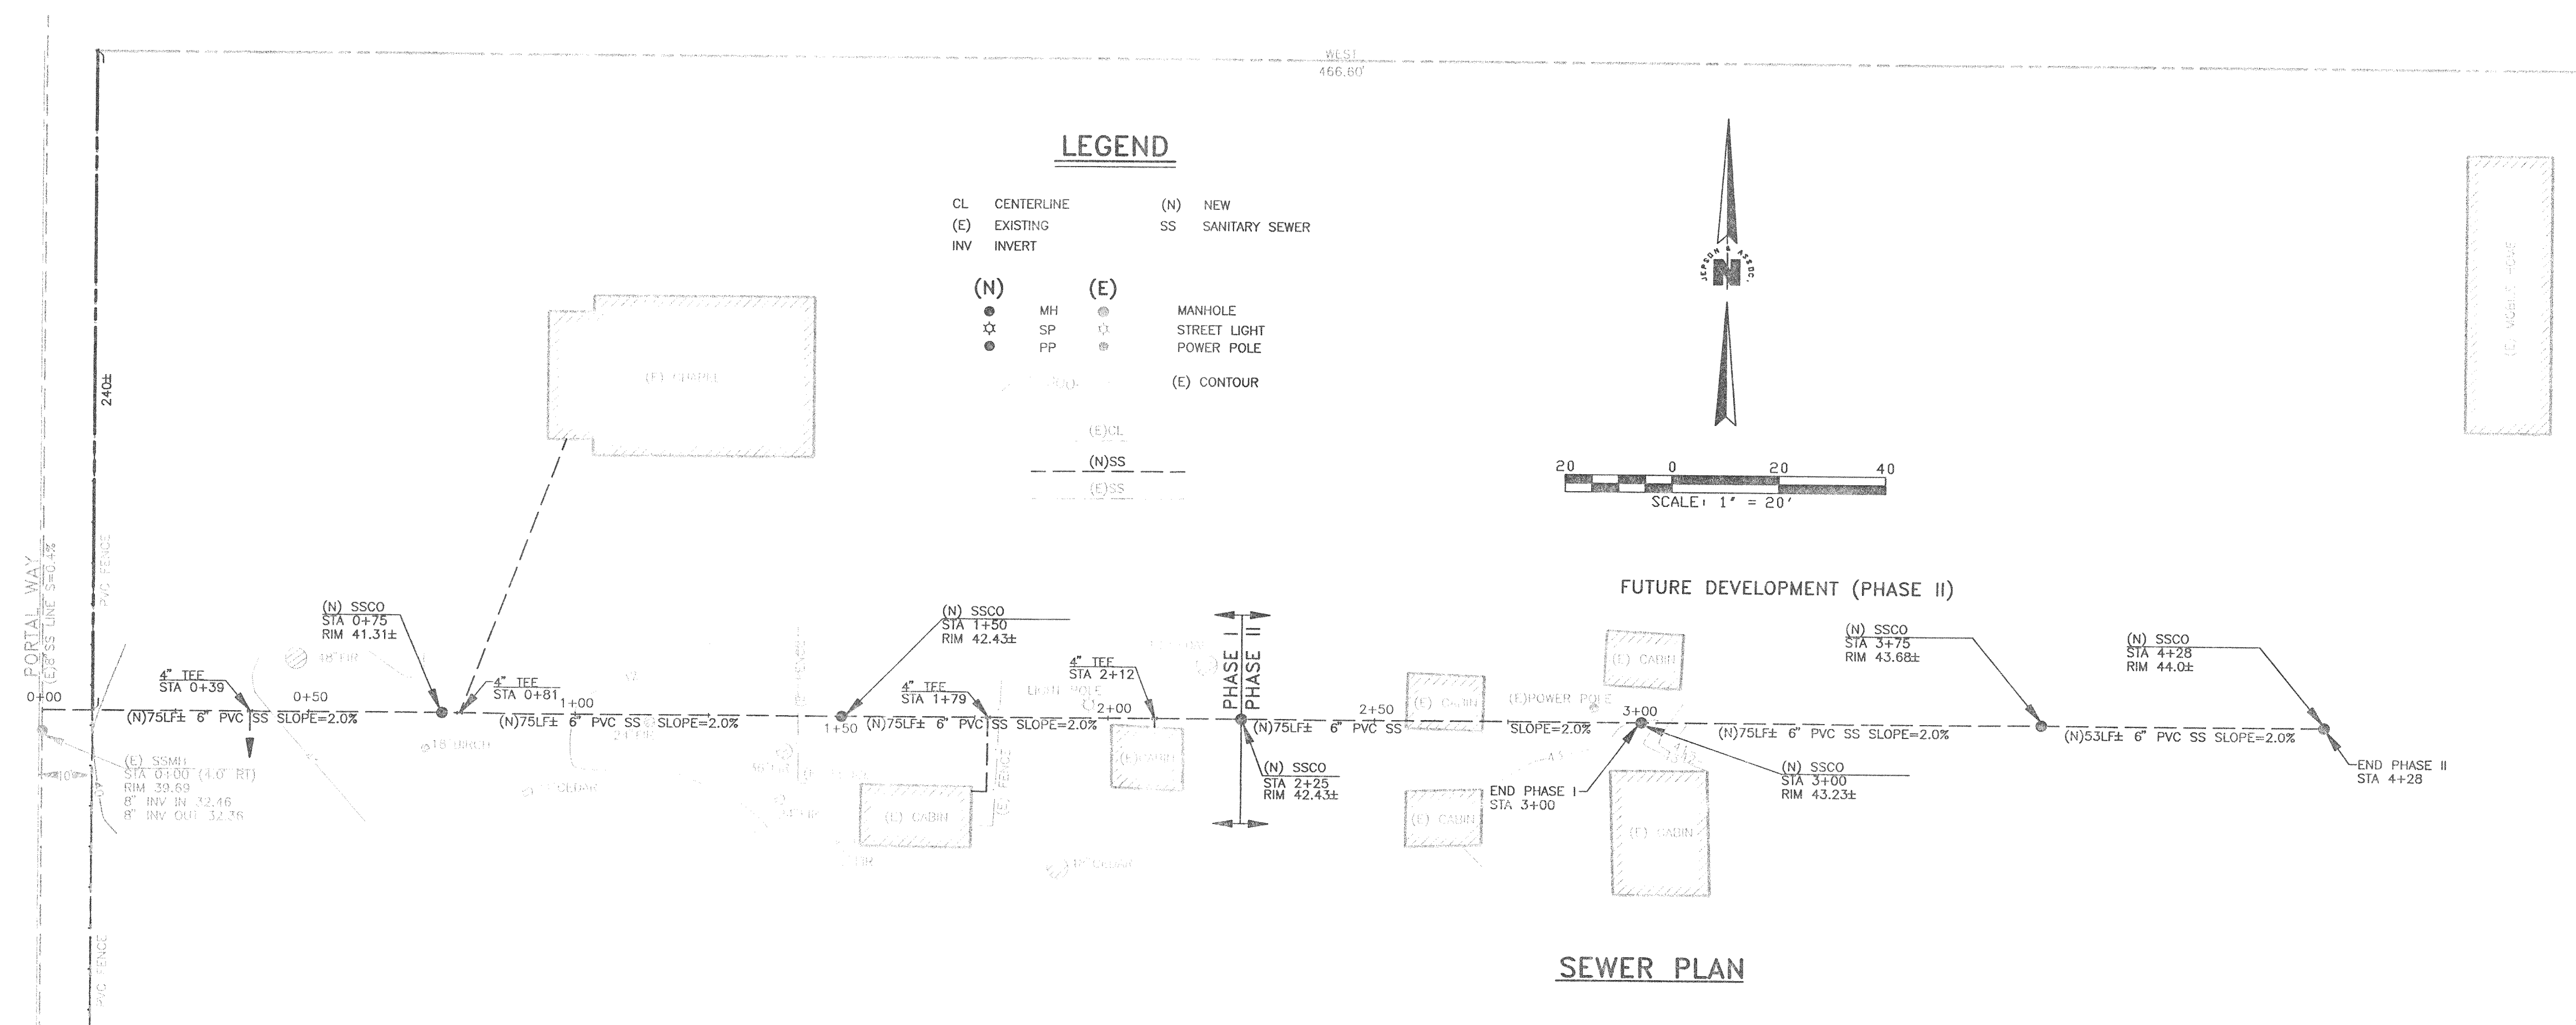

SEWER STA 0+00-STA 3+00
SCALE: HORIZ 1"=20'
VERT 1"=5'


RECORD DRAWING CERTIFICATION
THESE DRAWINGS REFLECT THE WORK AS CONSTRUCTED AND ALL MODIFICATIONS MEET THE PERFORMANCE STANDARDS OF THE ORIGINAL DESIGN.
DATE: 11.06

AS-BUILT

RONALD T. JEPSON & ASSOCIATES
REGISTERED PROFESSIONAL ENGINEERS AND LAND SURVEYORS
222 GRAND AVE., SUITE C, BELLINGHAM, WASHINGTON 98225 PH.(360)733-5760 FAX (360)647-8939

SCALE: AS SHOWN
DESIGNED BY: KDR
DRAWN BY: KDR
CHECKED BY: RTJ
DATE: 4/20/2006

REVISIONS:
8/3/06 ADD BLDGS T.A.U.

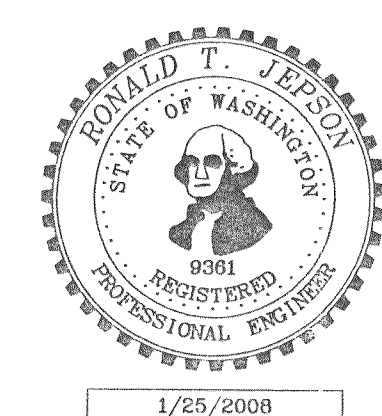

SEWER PLAN & PROFILE
N.W. HOLINESS SEWER DESIGN
WHATCOM COUNTY, WASHINGTON

SITE ADDRESS: 5942 PORTAL WAY
CLIENT:
N.W. HOLINESS ASSOCIATION

06011
SS-1
OF 2

LA:\proj\11-06\06011.dwg [B:\SS\SS\11-06\06011.dwg] BLDG.DWG - Juehler - SEPT 11, 2006 - 15:41:22

