
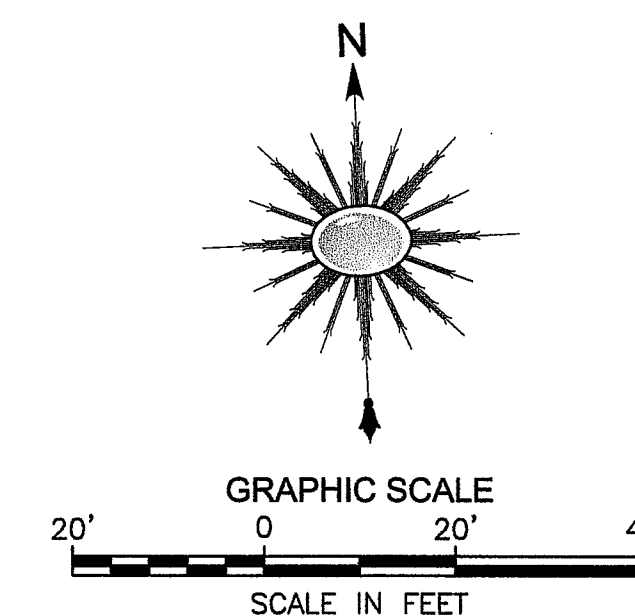


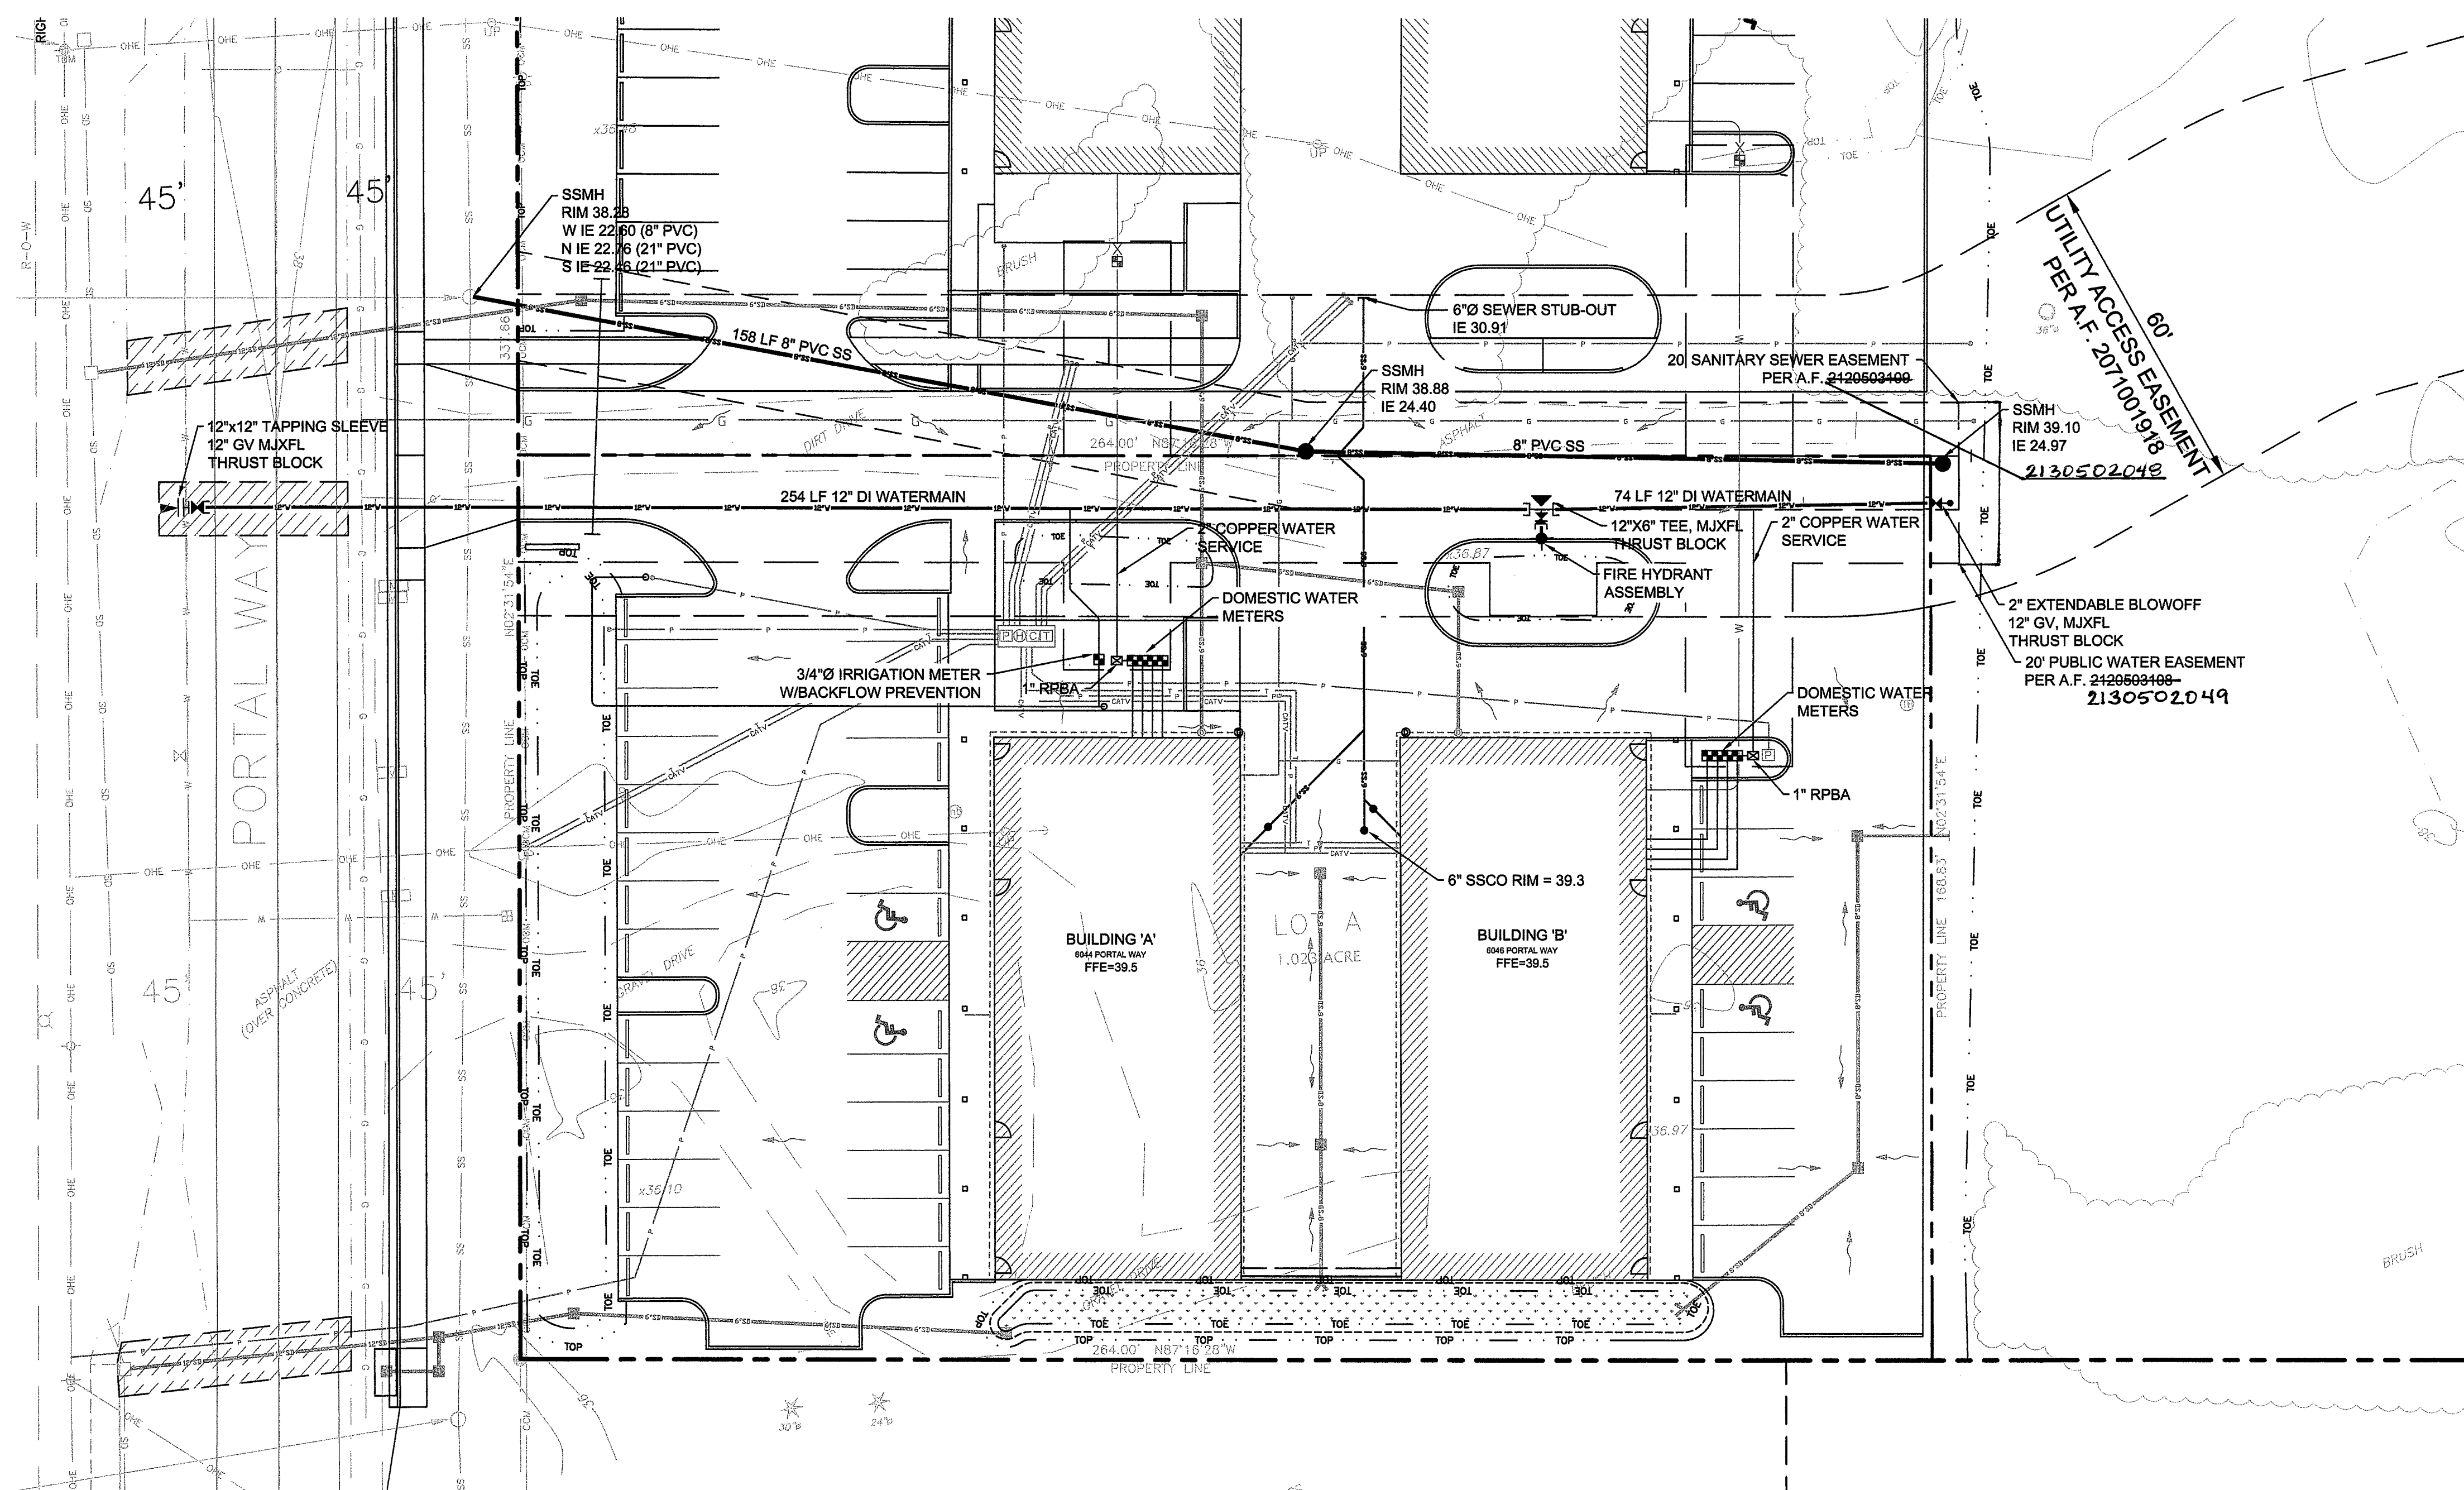


I HEREBY CERTIFY THAT THE IMPROVEMENTS IN PORTAL WAY MIXED USE DEVELOPMENT HAVE BEEN INSPECTED BY 2020 ENGINEERING INC. AND CONSTRUCTED IN CONFORMANCE WITH THE PLANS APPROVED BY THE PUBLIC WORKS DIRECTOR FOR SAID DEVELOPMENT AND THE GENERAL SPECIFICATIONS ADOPTED BY THE CITY OF FERNDALE DEPARTMENT OF PUBLIC WORKS.

APPROVED


JUN 01 2012

BY [Signature]
CITY OF FERNDALE

					ENGINEER:	M. BUEHRER		
					DESIGNED BY:	M. BUEHRER	DATE:	5-29-12
					DRAWN BY:	2020 CAD	DATE:	5-29-12
					CHECKED BY:		DATE:	
					PROJ. MNGR:	M. BUEHRER		
					PROJ. NO:	523por // Work		
					FILE NAME:	523_PD_AsBuiltUtilities.dwg		
NO.	DATE	BY	APPR.	REVISION	SCALE:	1"=20'		

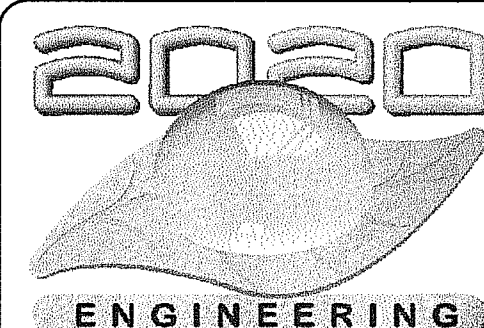

2020 ENGINEERING, INC.
814 DUPONT STREET
POST OFFICE BOX 1621
BELLINGHAM, WA. 98227-1621 USA
P: (360) 671-2020
F: (360) 671-0322
www.2020engineering.com


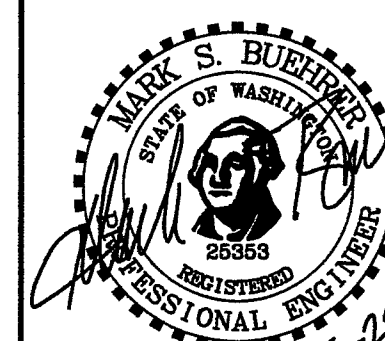


**CROWN POINT
HOLDINGS**
6540 NORTH STAR ROAD
FERNDALE, WA 98248

6046 PORTAL WAY
MIXED USE DEVELOPMENT
WATER & SEWER PLAN
PHASE 1 -- AS BUILT

SHEET:

1
OF
2

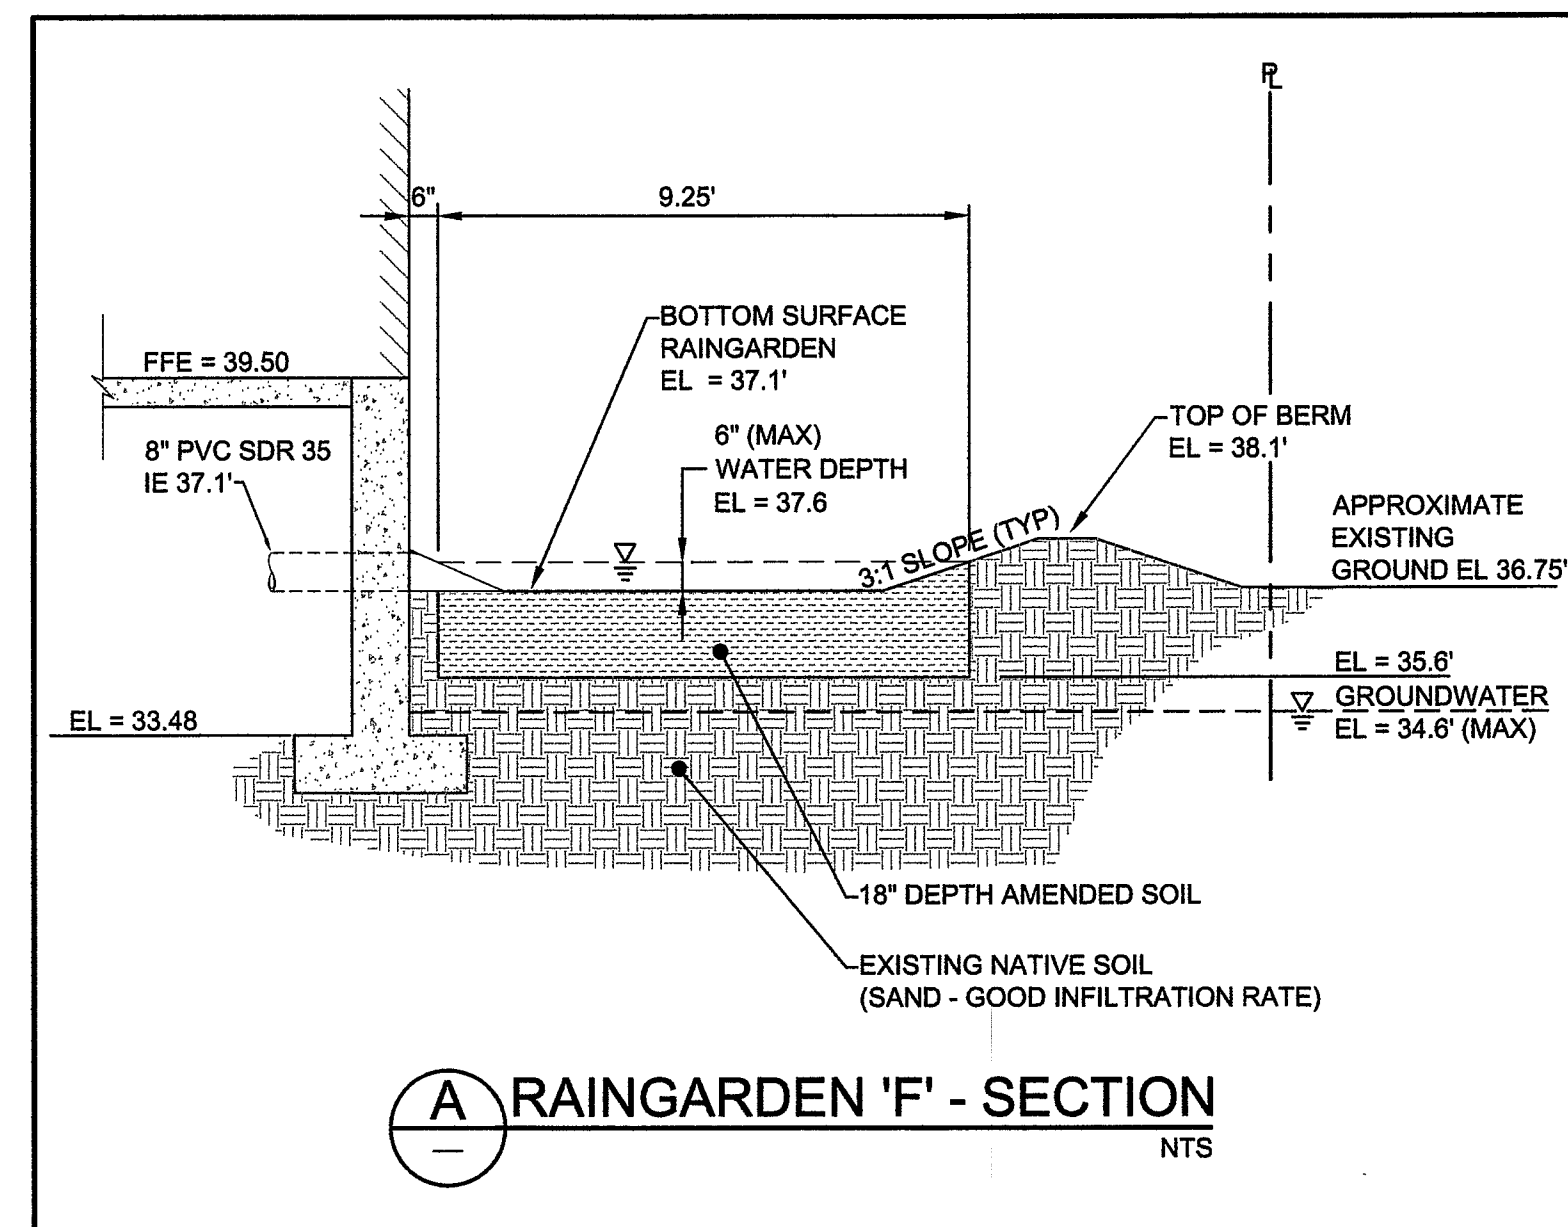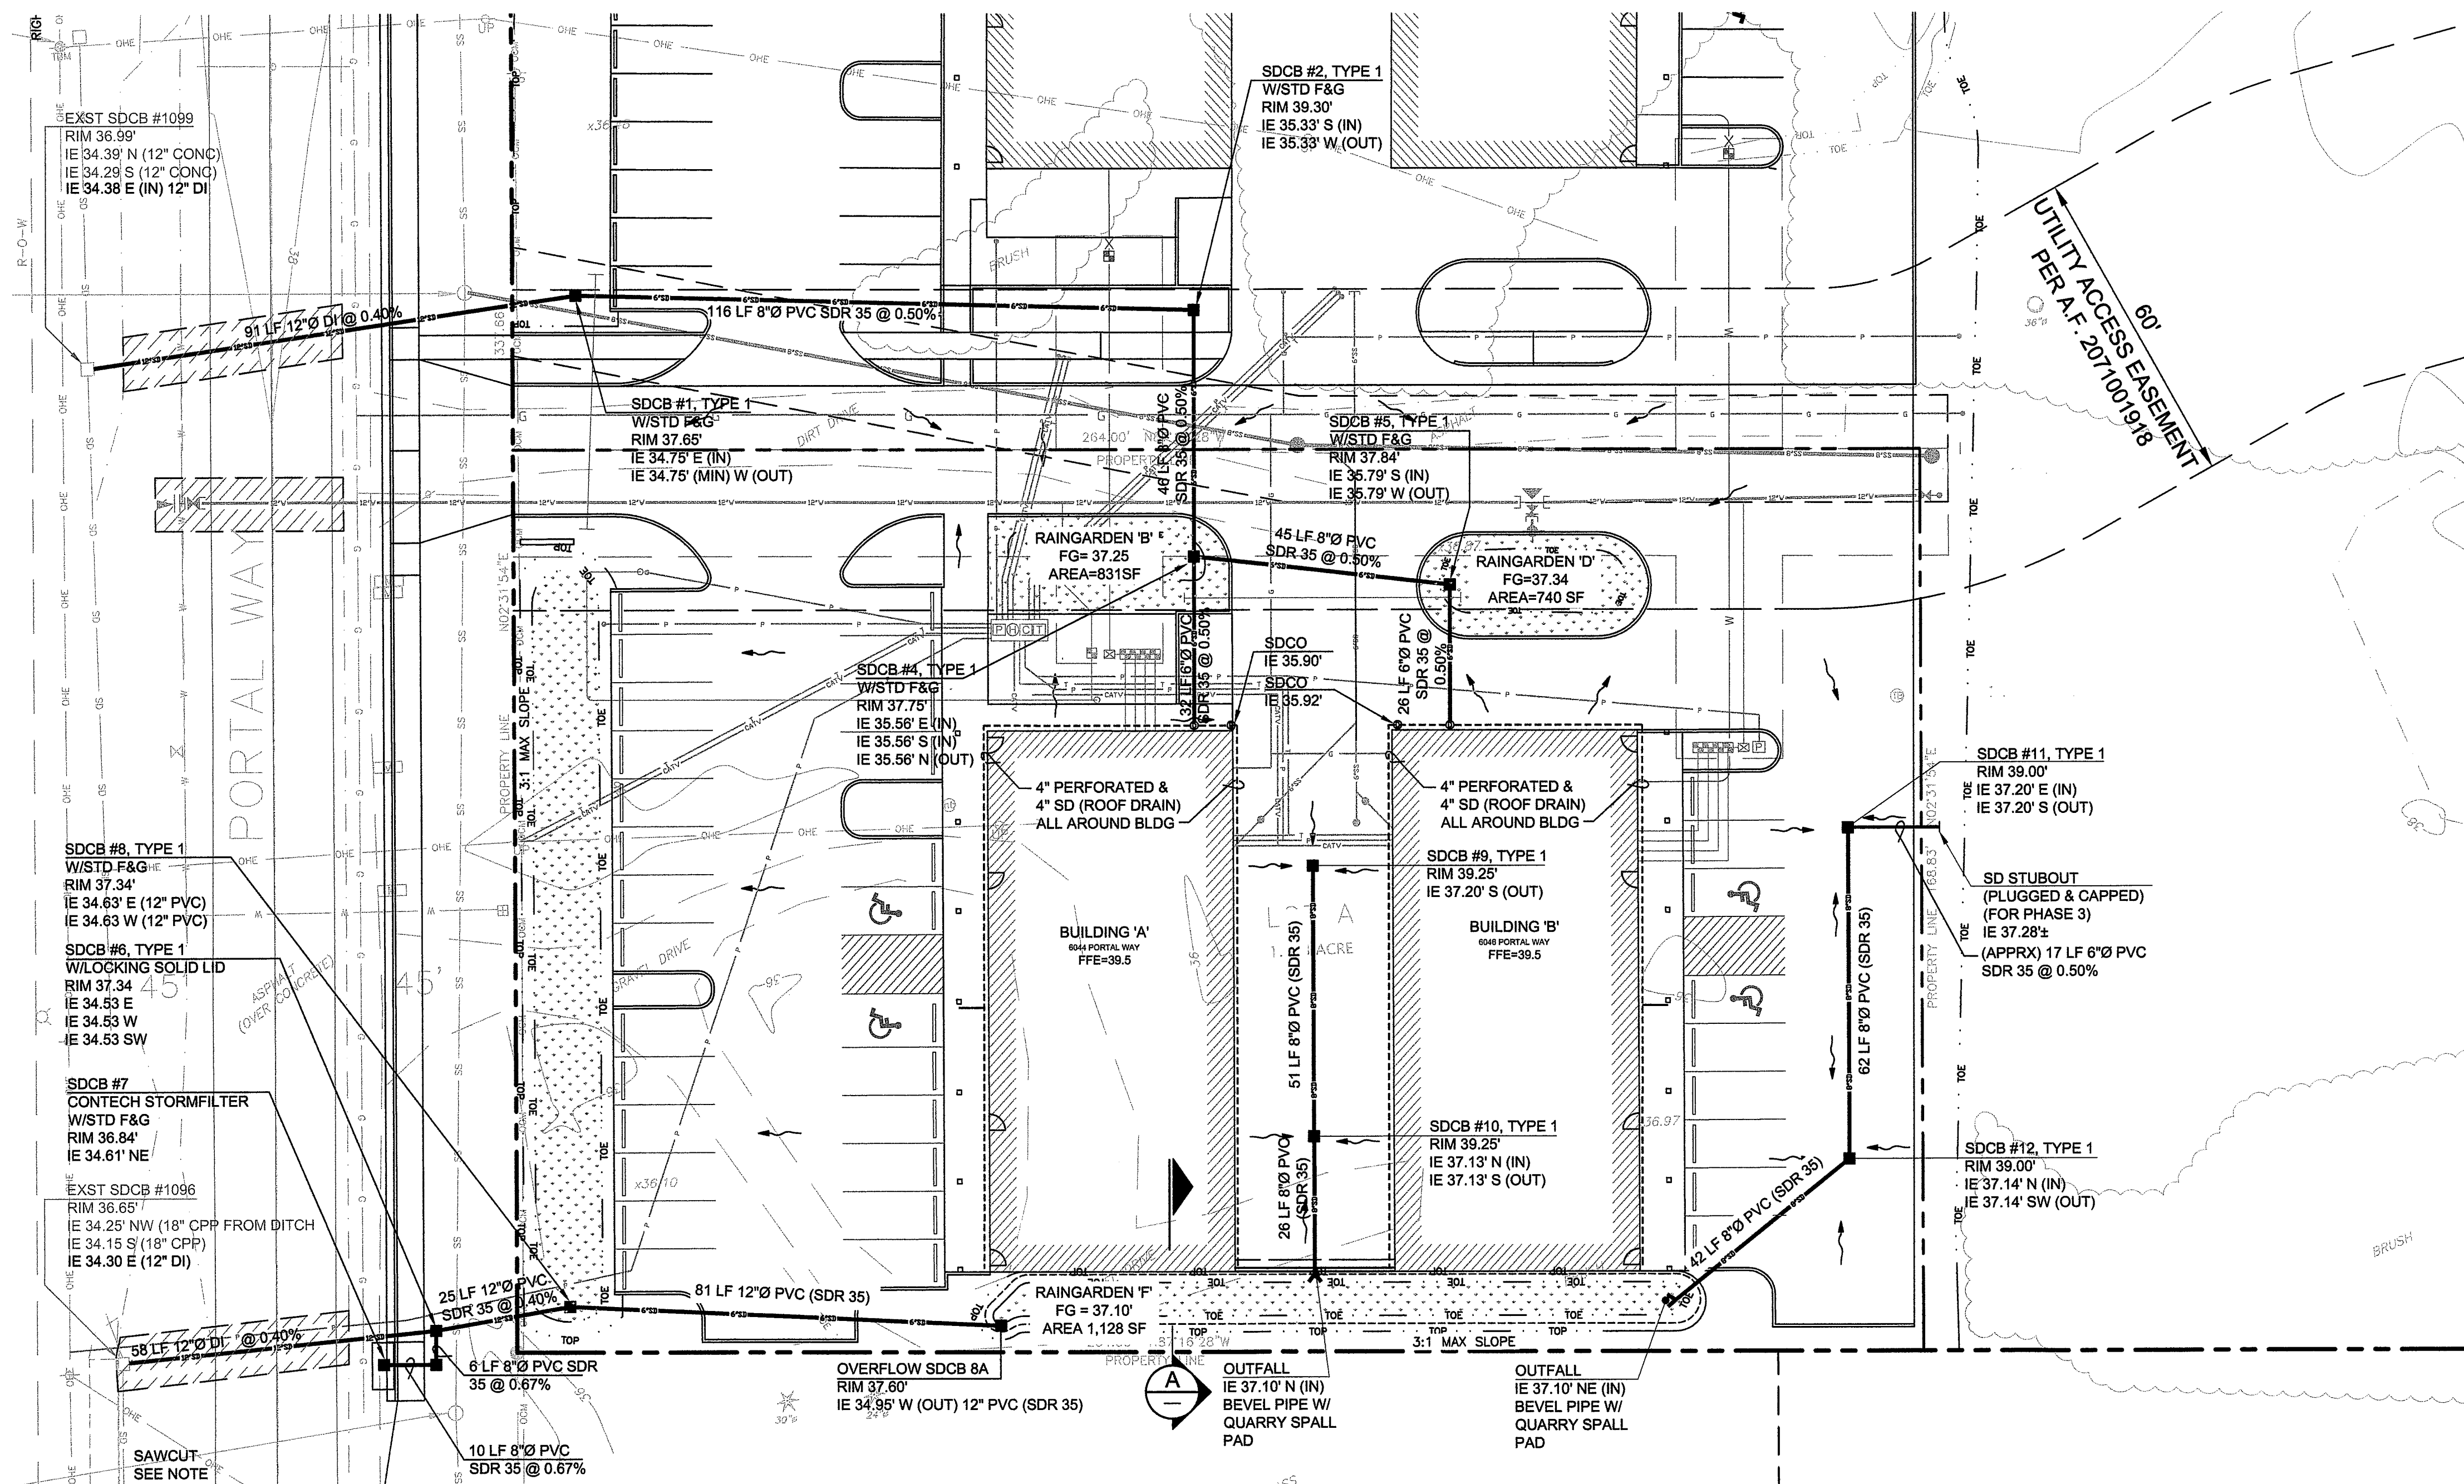

I HEREBY CERTIFY THAT THE IMPROVEMENTS IN PORTAL WAY MIXED USE DEVELOPMENT HAVE BEEN INSPECTED BY 2020 ENGINEERING INC. AND CONSTRUCTED IN CONFORMANCE WITH THE PLANS APPROVED BY THE PUBLIC WORKS DIRECTOR FOR SAID DEVELOPMENT AND THE GENERAL SPECIFICATIONS ADOPTED BY THE CITY OF FERNDAL DEPARTMENT OF PUBLIC WORKS.


APPROVED

JUN 01 2012


BY *[Signature]*
CITY OF FERNDAL

NO.	DATE	BY	APPR.	REVISION

ENGINEER:	M. BUEHRER
DESIGNED BY:	M. BUEHRER
DRAWN BY:	2020 CAD
CHECKED BY:	M. BUEHRER
PROJ. MNGR:	M. BUEHRER
PROJ. NO:	523por // Work
FILE NAME:	523_PD_AsBuiltUtilis.dwg
SCALE:	1"=20'

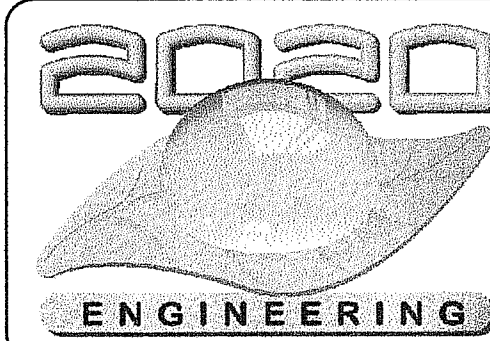

2020 ENGINEERING, INC.
814 DUPONT STREET
POST OFFICE BOX 1621
BELLINGHAM, WA. 98227-1621 USA
P: (360) 671-2020
F: (360) 671-0322
www.2020engineering.com

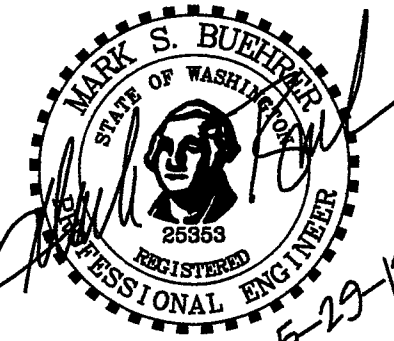

CROWN POINT HOLDINGS
6540 NORTH STAR ROAD
FERNDAL, WA 98248

**6046 PORTAL WAY
MIXED USE DEVELOPMENT
STORMWATER DRAINAGE PLAN
PHASE 1 -- AS BUILT**

SHEET:
2
OF
2

00554.002 5/24/13 ST