


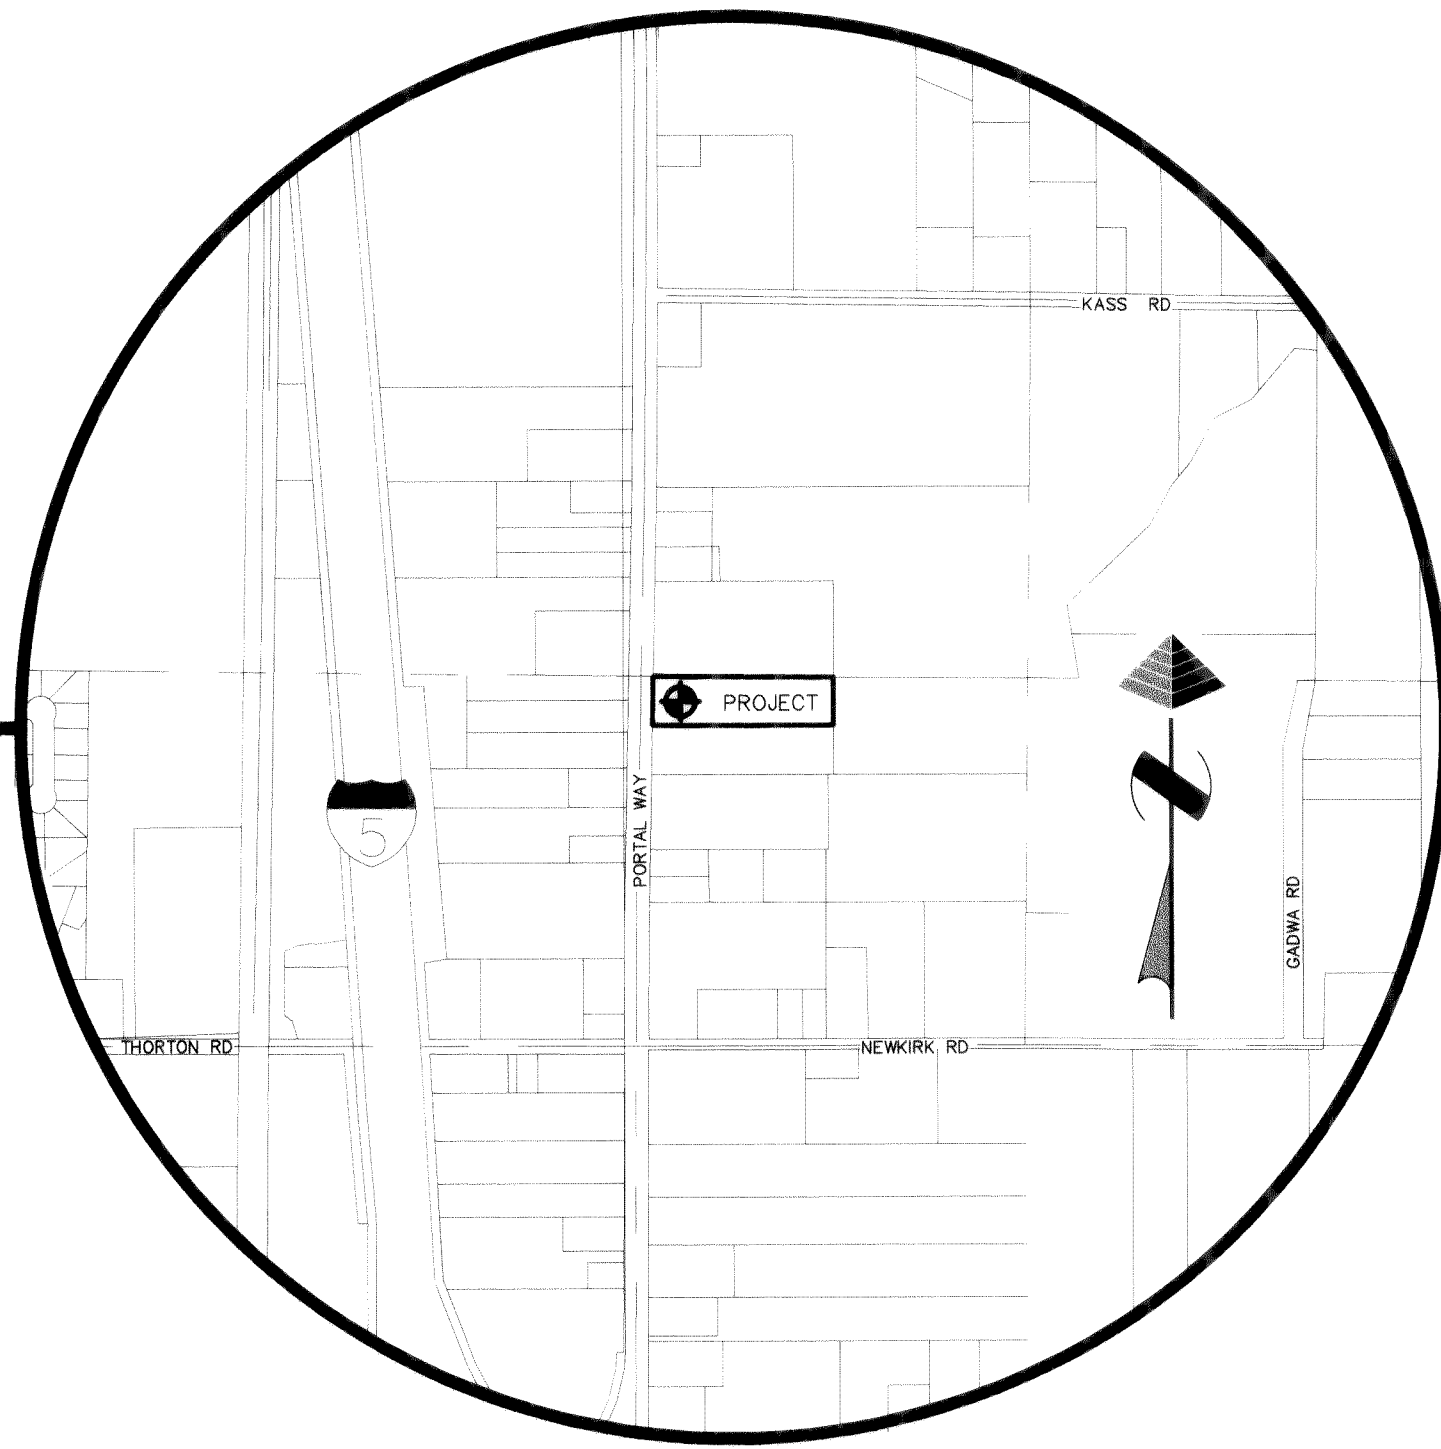

COAST CONSTRUCTION OFFICE SITE




PORTAL WAY FRONTAGE IMPROVEMENTS

SHT.

TITLE


1. COVER SHEET
2. WATER MAIN & FRONTAGE IMPROVEMENTS

APPROVAL STAMPS	
12-23-98 <i>[Signature]</i>	
DATUM VERTICAL T.B.M. ASSUMED 500.00 NWSAGPS TRAVERSE REBAR WITH RED CAP N 788.82 E 9795.07 HORIZONTAL ASSUMED COORDINATES AT SE PROPERTY CORNER N 455.85 E 10445.23 BASIS OF BEARINGS SOUTH PROPERTY LINE, SAID BEARING BEING S88°35'58"E	STATE OF WASHINGTON CITY OF FERNDAL ENGINEER 12/22/98
6186 PORTAL WAY FRONTAGE AS-BUILT COVER SHEET FOR COAST CONSTRUCTION	SCALE: N/A DATE: 12/22/98 DRAWN BY: CMAS REVISED: SHEET: 1 OF 2 JOB NUMBER: 98023B

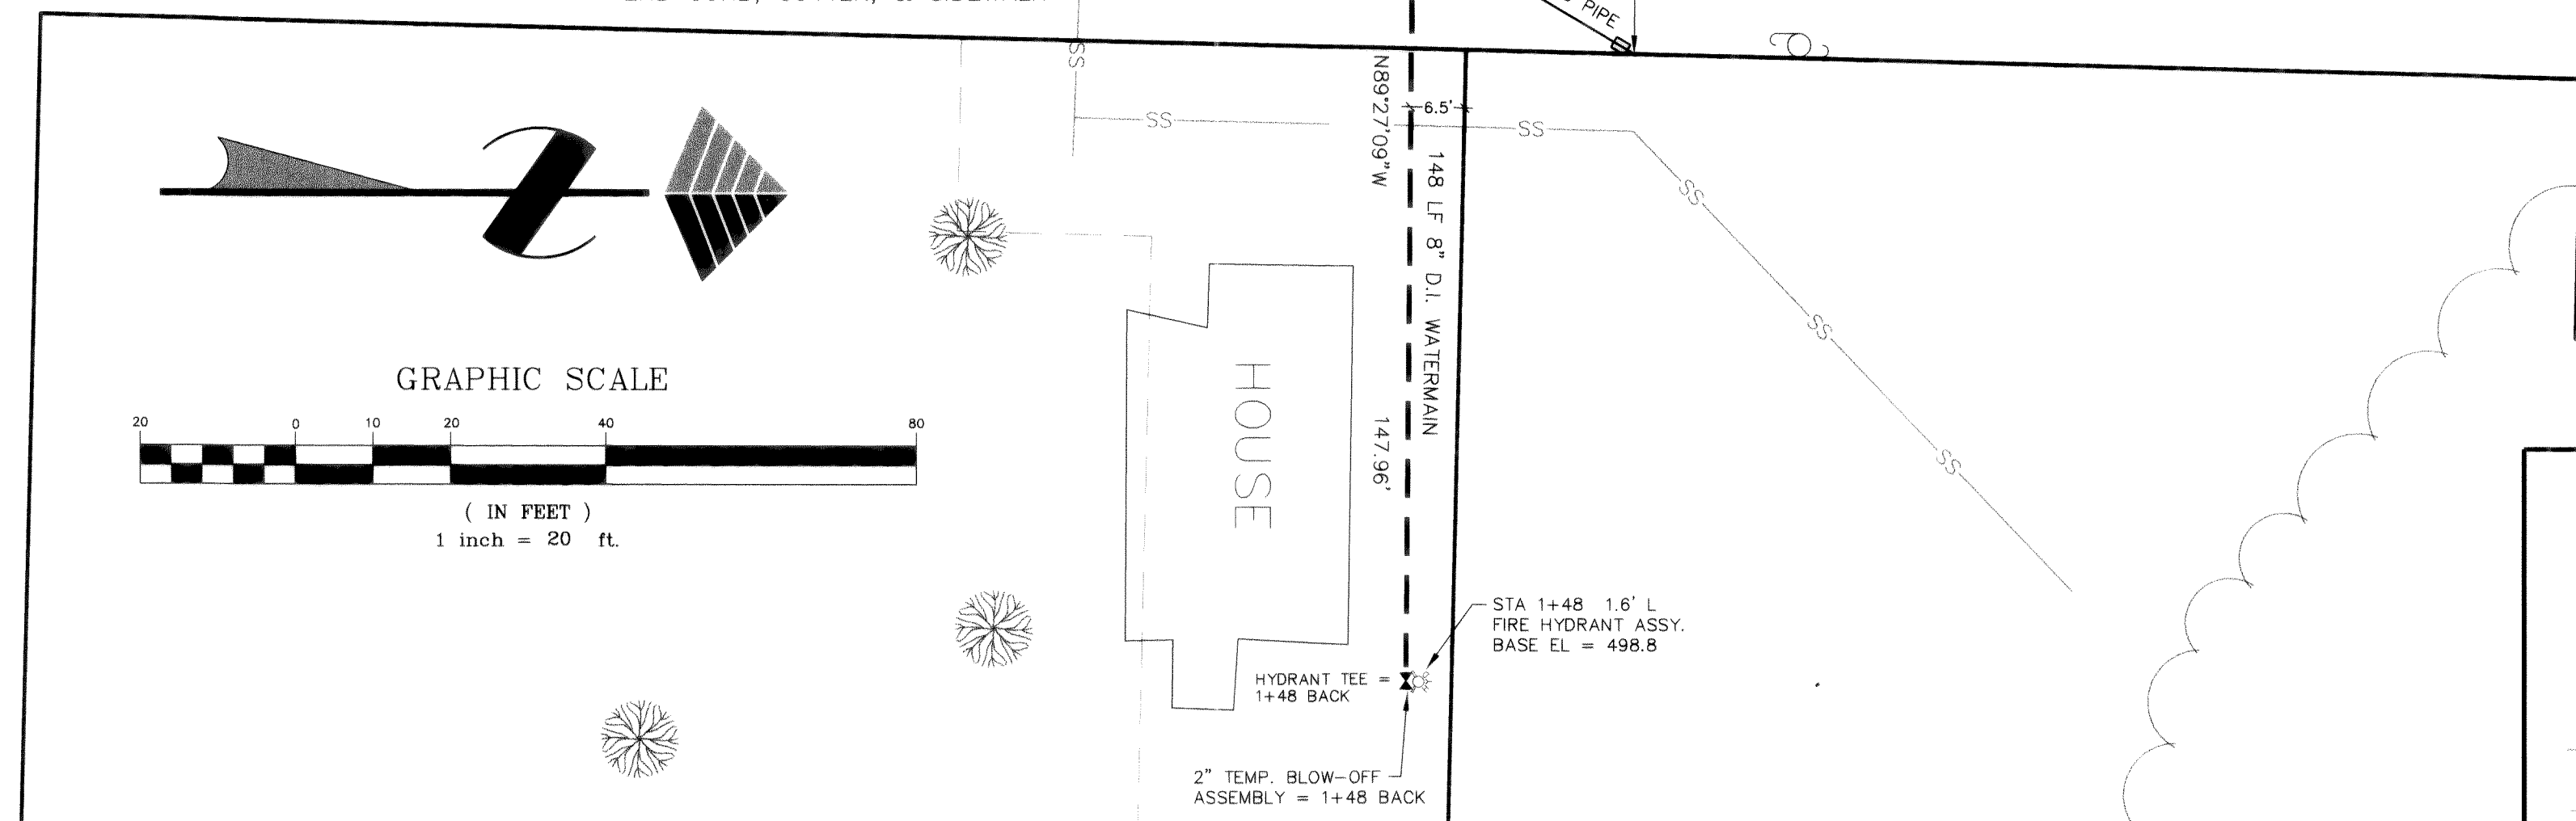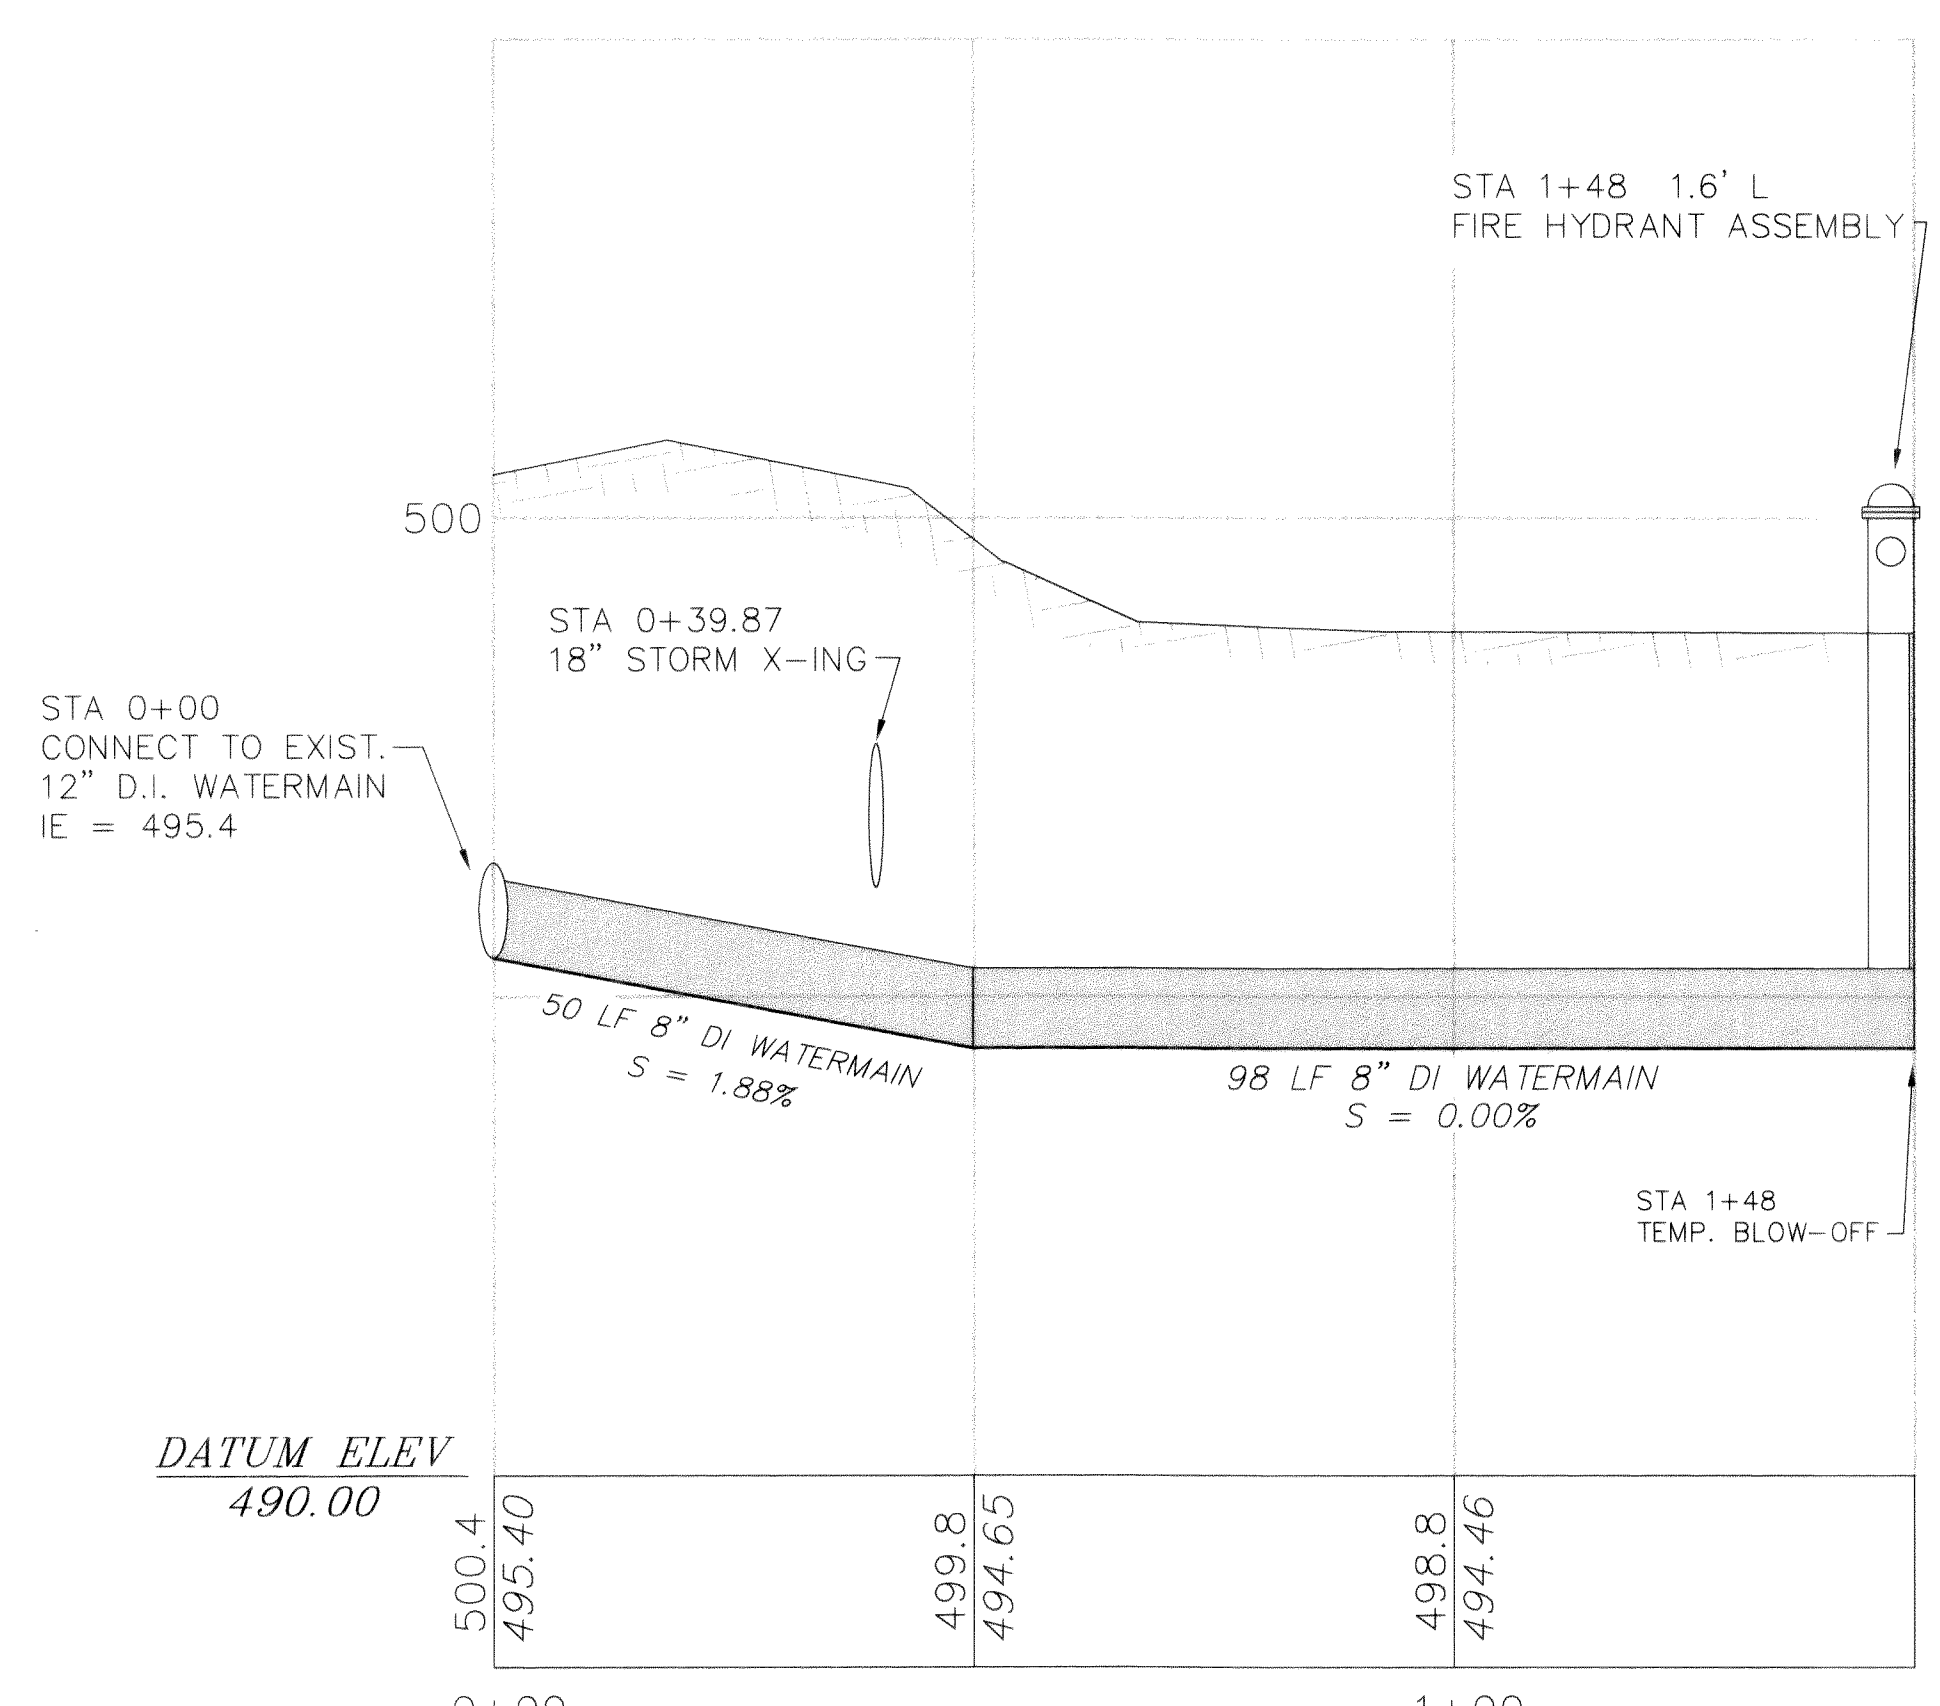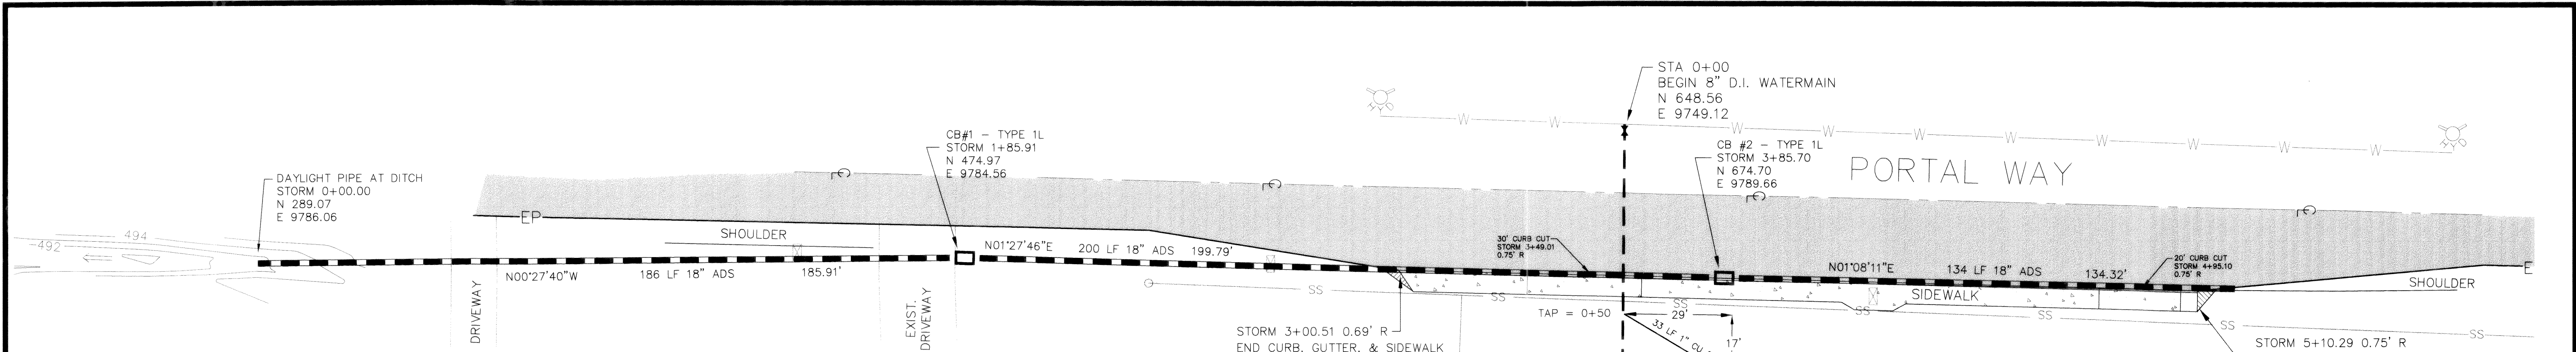

LEGEND	
	EXIST. FIRE HYDRANT
	PAVEMENT
	EXIST. MAILBOX
	EXIST. SANITARY SEWER
	ROADWAY CENTERLINE
	EXIST. EDGE OF PAVEMENT
	CATCH BASIN
	STORM MAIN
	PORTAL WAY R/W CENTERLINE

WATER MAIN PROFILE
 SCALE: 1" = 20' HORIZONTAL
 1" = 2' VERTICAL

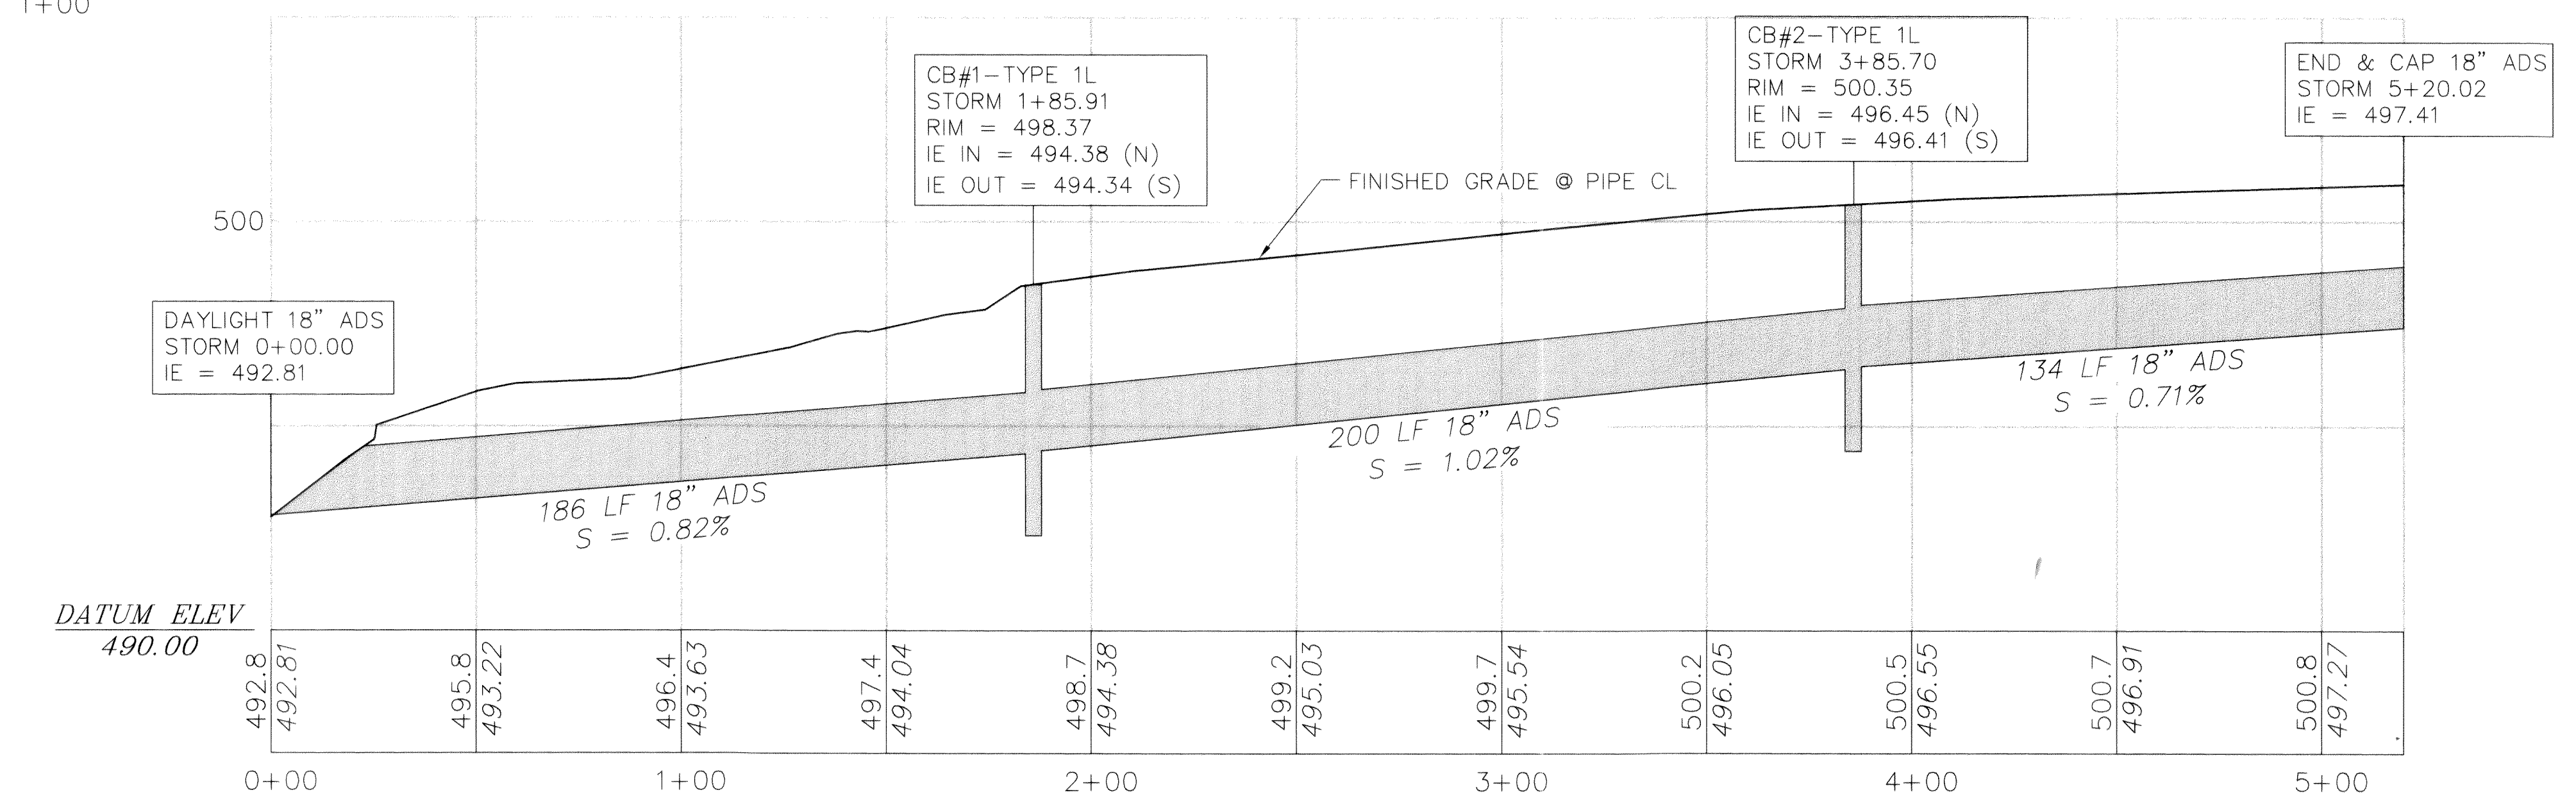

PORTAL WAY STORM MAIN PROFILE
 SCALE: 1" = 30' HORIZONTAL
 1" = 3' VERTICAL

NOTES
 1. EXISTING FIELD DATA PER NORTHWEST SURVEYING & GPS SURVEYS PERFORMED APRIL, 1998.

APPROVAL STAMPS

12-23-98 J. J. Eley

DATUM
 VERTICAL: T.B.M. ASSUMED 500.00
 NWS&GPS TRAVERSE REBAR WITH RED CAP
 N 788.82 E 9795.07
 HORIZONTAL: ASSUMED COORDINATES AT SE PROPERTY CORNER
 N 455.85 E 10445.23

BASIS OF BEARINGS
 SOUTH PROPERTY LINE, SAID BEARING BEING S88°35'58"E

Engineering Group, Inc.
 PO BOX 137, LYNDEN WA 98264 (360) 354-8141

6186 PORTAL WAY FRONTAGE AS-BUILT WATER MAIN AND PORTAL WAY FRONTAGE IMPROVEMENTS

FOR COAST CONSTRUCTION

PTN. SW1/4, SE1/4, SEC.17, T39N, R2E, W.M. CITY OF FERDALE, WHATCOM COUNTY, WASHINGTON

SCALE: VARIES
 DATE: 12/22/98
 DRAWN BY: CMAS
 REVISED:
 SHEET: 2 OF 2
 JOB NUMBER: 98023B

00032-002 2.10.06 KE