


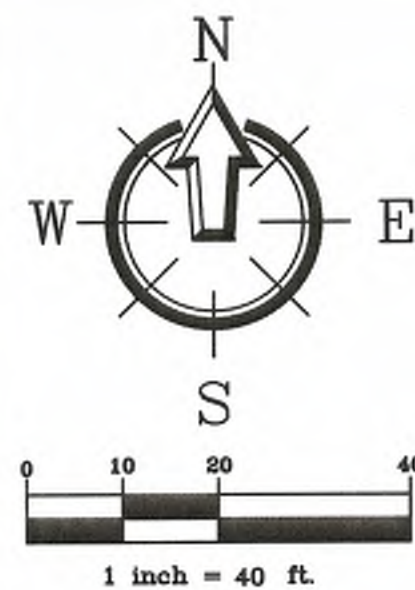

PHASE 1 CONSTRUCTION INCLUDES CONNECTION TO EXISTING 8" WATERMAIN AND INSTALLATION OF FIREMAIN AND 8" BACKFLOW PREVENTER (IN BELOW GRADE VAULT), PIV, AND FDC. FIREMAIN SHALL BE INSTALLED AS SHOWN AND SHALL END 5.0' EAST OF PHASE 1 CONCRETE DRIVEWAY PAVEMENT.

END PROPOSED SANITARY SEWER EXTENSION 10.0' WEST OF PROPOSED FIREMAIN DCVA VAULT.

TRANSFORMER AND POWER VAULT LOCATION(S). PSE HAS INSTALLED AND CORNERS SHOT BY SURVEYOR.

FIRE HYDRANT SHALL BE INSTALLED DURING PHASE 1 IN ORDER TO MEET FIRE PROTECTION COVERAGE REQUIREMENT.

TRANSFORMER AND POWER VAULT LOCATION(S). PSE HAS INSTALLED AND CORNERS SHOT BY SURVEYOR.

PHASE 1 CONSTRUCTION INCLUDES CONNECTION TO EXISTING WATERMAIN AND INSTALLATION OF 3" DOMESTIC WATER SERVICE, 3" WATER METER, AND 3" BACKFLOW PREVENTER (IN BELOW GRADE VAULT). WATER SERVICE SHALL BE INSTALLED AS SHOWN AND SHALL END 5.0' WEST OF PHASE 1 CONCRETE DRIVEWAY PAVEMENT.

PORTAL WAY (OLD U.S. 99)
S 02°31'55" W 1315.59'
328.90'

BALTIC WAY

PROPOSED STORAGE CONDO BUILDING G
FFE: 70.75
(PHASE #5)

PROPOSED STORAGE CONDO BUILDING F
FFE: 71.25
(PHASE #4)

PROPOSED STORAGE CONDO BUILDING E
FFE: 71.25
(PHASE #3)

PROPOSED STORAGE CONDO BUILDING D
FFE: 71.25
(PHASE #1)

PROPOSED STORAGE CONDO BUILDING C
FFE: 70.75
(PHASE #2)

PROPOSED STORAGE CONDO BUILDING B
FFE: 70.25
(PHASE #7)

PROPOSED STORAGE CONDO BUILDING A
FFE: 70.25
(PHASE #6)

THE LIGHT GREEN DASHED LINE SHOWN DENOTES THE EXTENT OF PHASE FIVE (PH 5), TYPICAL INCLUDES, BUILDING "G", CONNECTION TO STORMWATER INFILTRATION TRENCHES/GALLERY, CONNECTION TO 3" WATER SERVICE LINE, AND CONNECTION TO EXISTING SIDE SEWER STUB.

PROPOSED TRASH & RECYCLING ENCLOSURE (5'x15'L) APPROVED PER SSC MEMO DATED 10-2-2019

STORMWATER OVERFLOW PIPE AND OUTFALL AREA ARE REQUIRED TO BE CONSTRUCTED AS PART OF PHASE 1 PLAN APPROVAL PER CITY OF FERNDALE PUBLIC WORKS REVIEW COMMENT. IN ORDER TO SUPPORT THE STORMWATER OVERFLOW AND UTILITY LINES THE ENTIRE LENGTH OF THE PROPOSED WALL ALONG THE SOUTHERLY PROPERTY LINE SHALL BE IN STALLED.

THE POWDER BLUE DASHED LINE SHOWN DENOTES THE EXTENT OF PHASE FOUR (PH 4), TYPICAL INCLUDES, BUILDING "F", STORMWATER INFILTRATION TRENCHES/GALLERY, CONNECTION TO 3" WATER SERVICE LINE, AND CONNECTION TO EXISTING SIDE SEWER STUB.

THE BLUE DASHED LINE SHOWN DENOTES THE EXTENT OF PHASE ONE, TYPICAL INCLUDES "WALL, WATERMAIN, AND SANITARY SEWER FOR TO THE EAST FACE OF BUILDING "E" (PHASE 3).

END CONCRETE PAVEMENT (PHASE 1) 5.0' EAST OF BUILDING "E" IN ORDER TO INSTALL FUTURE CONCRETE PILINGS.

END PROPOSED WATER DISTRIBUTION LINE 5.0' WEST OF BUILDING "E". CAP. INSTALL TEMPORARY BLOW-OFF.

THE WINE RED DASHED LINE SHOWN DENOTES THE EXTENT OF PHASE TWO, TYPICAL INCLUDES, BUILDING "C", PAVEMENT, STORMWATER, CONNECTION TO 3" WATER SERVICE LINE, AND CONNECTION TO EXISTING SIDE SEWER STUB.

THE PURPLE DASHED LINE SHOWN DENOTES THE EXTENT OF PHASE 7, SEE DESCRIPTION BELOW.

THE ORANGE DASHED LINE SHOWN DENOTES THE EXTENT OF PHASE 6, SEE DESCRIPTION BELOW.

STORMWATER PIPE AND OVERFLOW STRUCTURES ARE REQUIRED TO BE CONSTRUCTED AS PART OF PHASE 1 PLAN APPROVAL PER CITY OF FERNDALE PUBLIC WORKS REVIEW COMMENT. IN ORDER TO SUPPORT THE STORMWATER OVERFLOW SYSTEM AND OTHER UTILITY LINES AND POWER VAULT/TRANSFORMER, THE ENTIRE LENGTH OF THE PROPOSED WALL ALONG THE SOUTHERLY PROPERTY LINE SHALL BE IN STALLED.

PHASE 1:
• RELOCATED EXISTING WATERMAIN TO WEST OF BUILDING "E" AND EXTEND PAST WALL 10.0' AND INSTALL BLOW-OFF ASSEMBLY.

• INSTALL 8" WATERMAIN SHOWN BETWEEN BUILDINGS "B" AND "C" IN ORDER TO AVOID CONFLICTS BY INSTALLING ALL THE INFRASTRUCTURE IN THAT AREA AT SAME TIME.

• INSTALL 8" FIREMAIN BACKFLOW PREVENTER IN VAULT AND PIV. INSTALL 8" FIREMAIN AND FDC. EXTEND 8" FIREMAIN TO BUILDINGS "A-G". INSTALL 8"x4" TEE AND GATE VALVE. CONNECT 4" FIREMAIN TO BUILDING "D". INSTALL BLIND FLANGE AT END OF THE REMAINING BUILDING'S 4" GATE VALVE FOR FUTURE CONNECTION.

• INSTALL 3" DOMESTIC WATER METER AND BACKFLOW PREVENTER IN VAULT. EXTENT WATER SERVICE PIPE SOUTH THEN WEST, PAST PHASE 1 CONCRETE DRIVEWAY PAVEMENT.

• INSTALL ALL STORMWATER OVERFLOW PIPE AND STRUCTURES ALONG THE SOUTHERLY PROPERTY LINE.

• INSTALL SANITARY SEWER EXTENSION FROM "EXISTING SSMH #3" TO PROPOSED SSMH #2. AND EXTEND 8" PVC SEWER MAIN 10.0' WEST OF PROPOSED FIREMAIN DCVA VAULT. CAP END FOR FUTURE CONNECTION.

• INSTALL FULL DRIVEWAY ON ALL SIDES OF BUILDING. MAINTAIN 5.0' SETBACK TO ADJACENT FUTURE BUILDINGS.

PHASE 2:
• INSTALL FULL DRIVEWAY ON ALL SIDES OF BUILDING "C". MAINTAIN 5.0' SETBACK TO ADJACENT FUTURE BUILDING TO EAST.

• INSTALL STORMWATER INFILTRATION TRENCHES AND GALLERY. CONNECT TO OVERFLOW CONVEYANCE SYSTEM (CONSTRUCTED DURING PHASE 1).

• CONNECT TO 8" FIREMAIN LINE AND INSTALL SPRINKLER SYSTEM.

• CONNECT TO 3" DOMESTIC WATER SERVICE INSTALLED DURING PHASE 1.

• CONNECT TO EXISTING SIDE SEWER STUB.

PHASE 3:
• INSTALL FULL DRIVEWAY ON ALL SIDES OF BUILDING "E". MAINTAIN 5.0' SETBACK TO ADJACENT FUTURE BUILDING TO WEST (BUILDING "F").

• INSTALL STORMWATER INFILTRATION TRENCHES AND PERMEABLE PAVEMENT. CONNECT TO OVERFLOW CONVEYANCE SYSTEM (CONSTRUCTED DURING PHASE 1).

• CONNECT TO 8" FIREMAIN LINE AND INSTALL SPRINKLER SYSTEM.

• CONNECT TO 3" DOMESTIC WATER SERVICE INSTALLED DURING PHASE 1.

• CONNECT TO EXISTING SANITARY SEWER MAIN WITH PROPOSED SIDE SEWER STUB.

PHASE 4:
• INSTALL FULL DRIVEWAY ON ALL SIDES OF BUILDING "F". MAINTAIN 5.0' SETBACK TO ADJACENT FUTURE BUILDING TO WEST (BUILDING "G").

• INSTALL STORMWATER INFILTRATION TRENCHES. CONNECT TO OVERFLOW CONVEYANCE SYSTEM (CONSTRUCTED DURING PHASE 1).

• CONNECT TO 8" FIREMAIN LINE AND INSTALL SPRINKLER SYSTEM.

• CONNECT TO 3" DOMESTIC WATER SERVICE INSTALLED DURING PHASE 1.

• CONNECT TO EXISTING SANITARY SEWER MAIN WITH PROPOSED SIDE SEWER STUB.

• COMPLETE WATER MAIN INSTALL TO WEST PROPERTY LINE.

PHASE 5:
• INSTALL REMAINING DRIVEWAY AROUND BUILDING "G".

• CONNECT TO STORMWATER INFILTRATION TRENCHES.

• CONNECT TO 8" FIREMAIN LINE AND INSTALL SPRINKLER SYSTEM.

• CONNECT TO 3" DOMESTIC WATER SERVICE INSTALLED DURING PHASE 1.

• CONNECT TO EXISTING SANITARY SEWER MAIN WITH PROPOSED SIDE SEWER STUB.

PHASE 6:
• INSTALL FULL DRIVEWAY ON ALL SIDES OF BUILDING "A". MAINTAIN 5.0' SETBACK TO ADJACENT FUTURE BUILDING TO WEST (BUILDING "B").

• INSTALL STORMWATER INFILTRATION TRENCHES. CONNECT TO OVERFLOW CONVEYANCE SYSTEM (CONSTRUCTED DURING PHASE 1).

• CONNECT TO 8" FIREMAIN LINE AND INSTALL SPRINKLER SYSTEM.

• CONNECT TO 3" DOMESTIC WATER SERVICE INSTALLED DURING PHASE 1.

• CONNECT TO EXISTING SANITARY SEWER MAIN WITH PROPOSED SIDE SEWER STUB.

PHASE 7:
• INSTALL REMAINING DRIVEWAY AROUND BUILDING "B".

• CONNECT TO STORMWATER INFILTRATION TRENCHES.

• CONNECT TO 8" FIREMAIN LINE AND INSTALL SPRINKLER SYSTEM.

• CONNECT TO 3" DOMESTIC WATER SERVICE INSTALLED DURING PHASE 1.

• CONNECT TO EXISTING SANITARY SEWER MAIN WITH PROPOSED SIDE SEWER STUB.

FUTURE PHASES:

• EACH BUILDING SITE SHALL BE FULLY SERVICED WITH SEWER SERVICE, POTABLE WATER SERVICE, AND FIRE SERVICE PRIOR TO ISSUANCE OF FUTURE BUILDING PERMIT(S). FULL DRIVEWAY AND ASSOCIATED INFILTRATION STORMWATER FACILITIES SHALL BE INSTALLED AND ACCEPTED PRIOR TO BUILDING OCCUPANCY.

FINAL OCCUPANCY OF PROPOSED BUILDING WILL NOT BE GRANTED UNTIL ALL PUBLIC WORKS REQUIREMENTS ARE MET.

APPROVED

AUG 31 2021

By: [Signature]

Public Works Department



220 West Champion Street, Suite 200
Bellingham, WA 98225
t: 360.650.1408
f: 360.650.1401

FREELAND
& ASSOCIATES

REV	DATE	DESCRIPTION
1	06/13/2019	PHASE 2 - BUILDING "C" SUBMITTAL
2	12/02/2019	PHASE 3 - BUILDING "E" SUBMITTAL
3	3/15/2020	PHASE 4 - BUILDING "B" SUBMITTAL
4	10/14/2020	PHASE 5 - BUILDING "G" SUBMITTAL
5	10/14/2020	PHASE 6&7 - BUILDING "A" & "B" SUBMITTAL

CLIENT: **PIONEER POST FRAME**
6208 PORTAL WAY
FERNDALE, WASHINGTON

CALL BEFORE YOU DIG
FOR BURIED UTILITY LOCATIONS
1-800-424-5555

PROJECT LOCATION: **PIONEER FLEXSPACE, LLC**
6407 PORTAL WAY
FERNDALE, WASHINGTON

DRAWN BY: C.L.
CHECKED BY: HAF

DRAWING #: 18084SP26 (PHS).DWG
DESIGNED BY: HAF


SHEET CONTENTS: **PHASING PLAN**



JOB #: 18084
SCALE: HORIZ: 1"=40'
VERT: N/A

DATE: 8-30-2021
SHEET: **C3**

00716.003 08/31/2021 RH

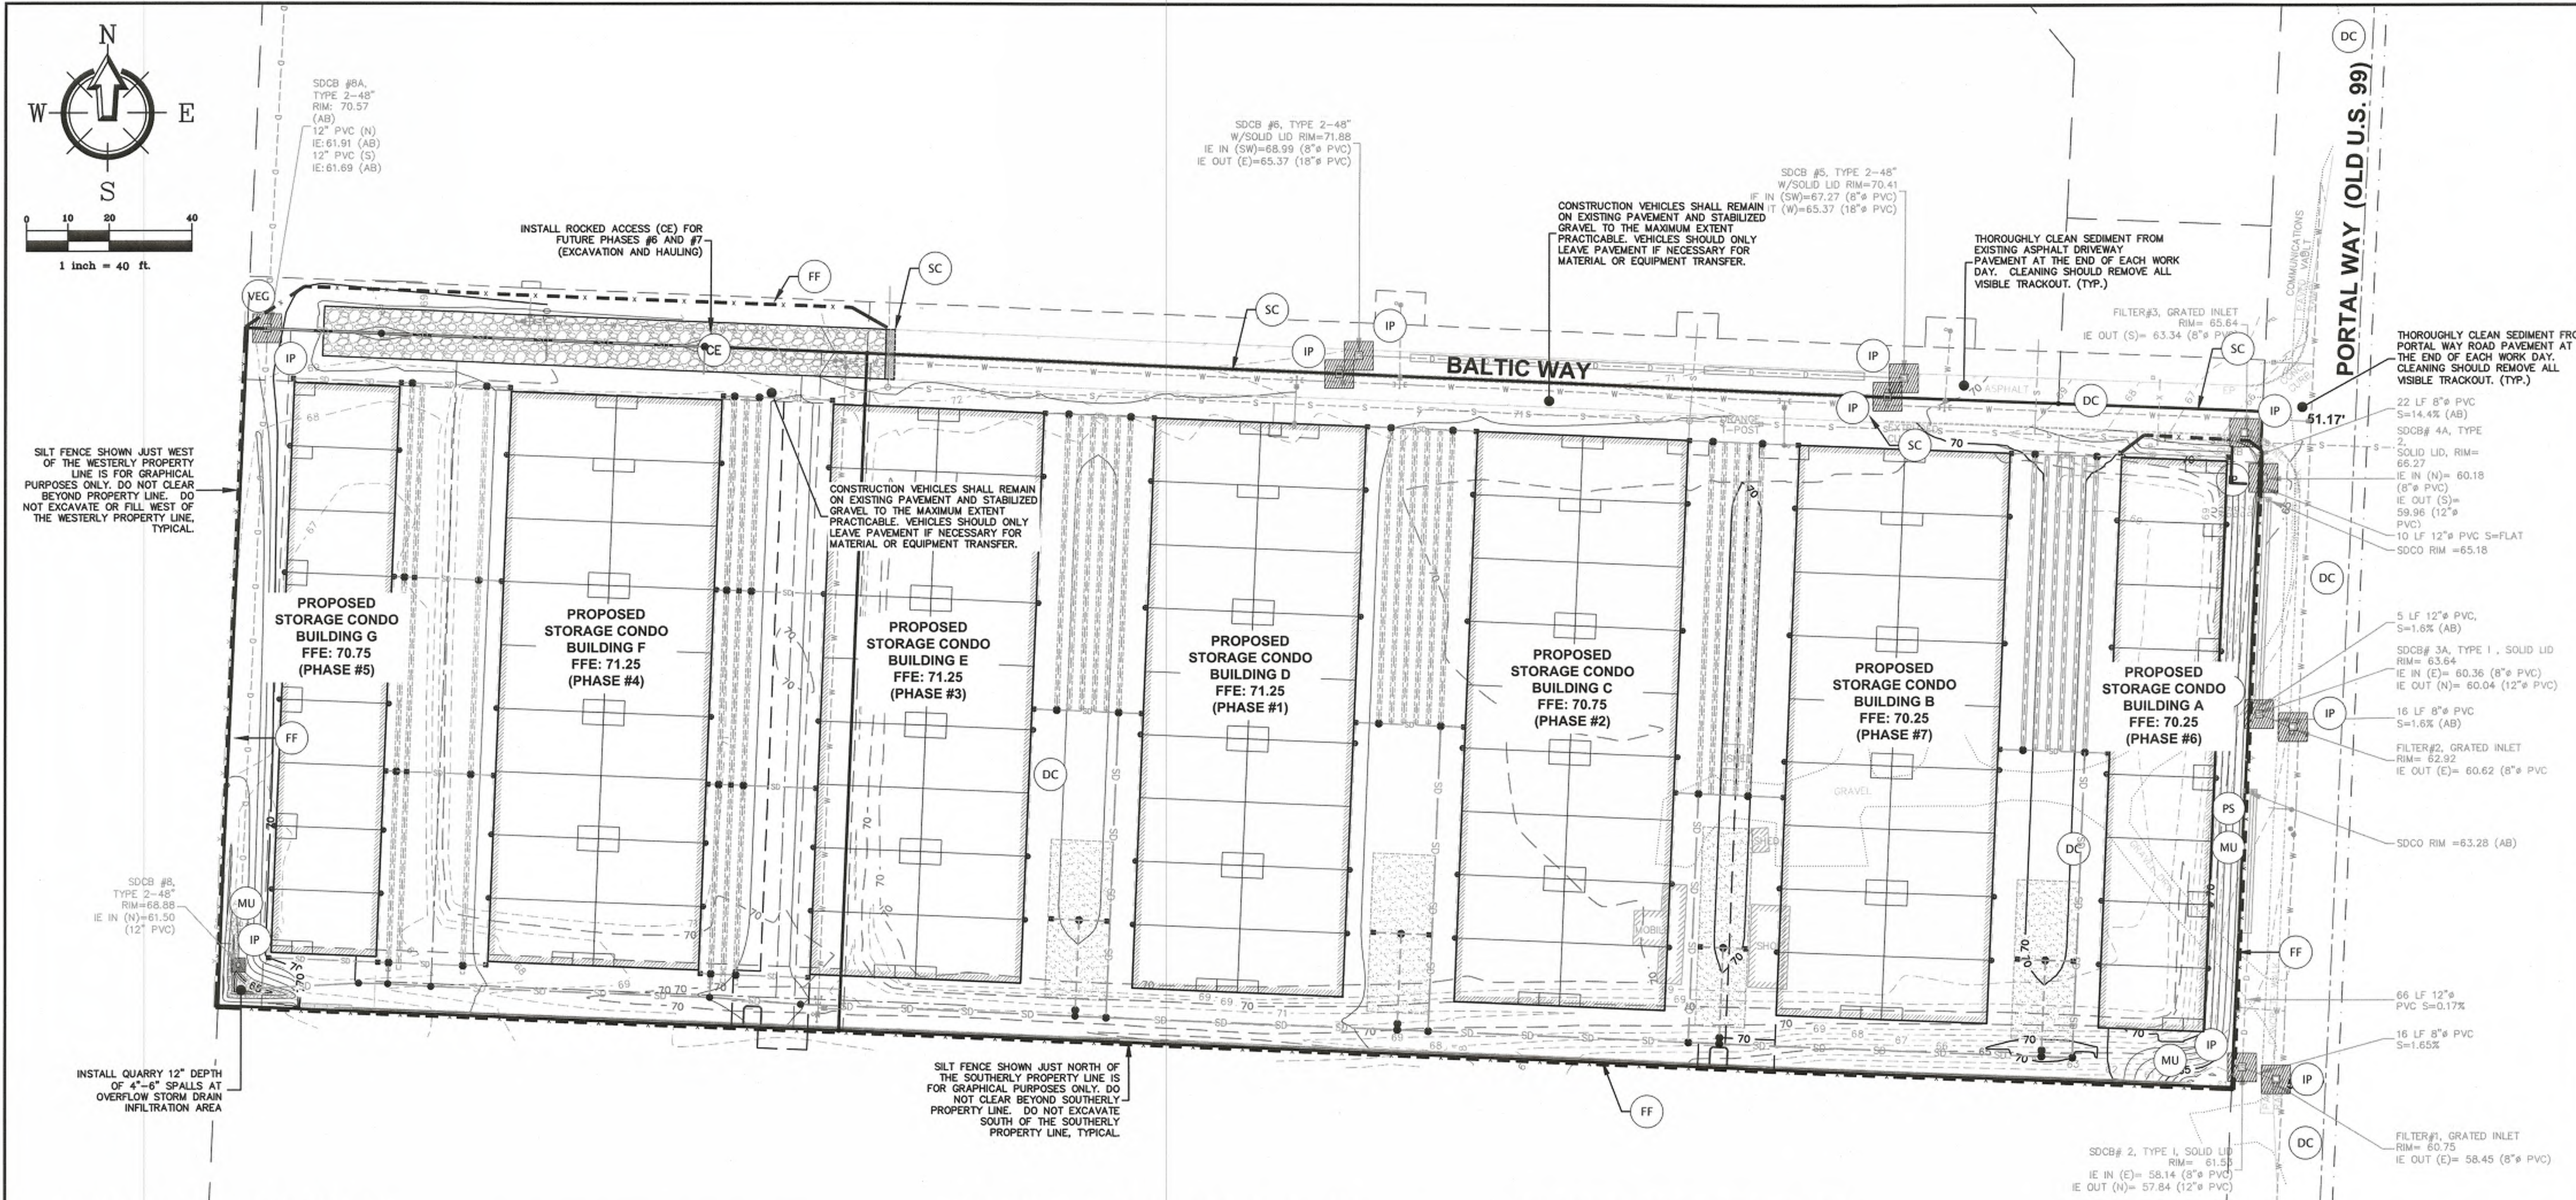

EROSION CONTROL NOTES:

- APPROVAL OF THE EROSION/SEDIMENTATION CONTROL (ESC) PLAN DOES NOT CONSTITUTE AN APPROVAL OF PERMANENT ROAD OR DRAINAGE DESIGN (E.G., SIZE AND LOCATION OF ROADS, PIPES, RESTRICTORS, CHANNELS, RETENTION FACILITIES, UTILITIES, ETC.).
- THE IMPLEMENTATION OF THE ESC PLANS AND THE CONSTRUCTION, MAINTENANCE, REPLACEMENT AND UPGRADING OF THESE ESC FACILITIES IS THE RESPONSIBILITY OF THE CONTRACTOR UNTIL ALL CONSTRUCTION IS APPROVED, AND LANDSCAPING IS ESTABLISHED.
- THE ESC FACILITIES SHOWN ON THE PLANS MUST BE CONSTRUCTED IN CONJUNCTION WITH ALL CLEARING AND GRADING ACTIVITIES, AND IN SUCH A MANNER AS TO ENSURE THAT SEDIMENT LADEN WATER DOES NOT ENTER THE DRAINAGE SYSTEM OR VIOLATE APPLICABLE WATER QUALITY STANDARDS.
- THE ESC FACILITIES SHOWN ON THE PLANS ARE THE MINIMUM REQUIREMENTS FOR ANTICIPATED SITE CONDITIONS. DURING THE CONSTRUCTION PERIOD, THESE ESC FACILITIES SHALL BE UPGRADED (E.G., ADDITIONAL SUMPS, RELOCATION OF DITCHES AND SILT FENCES, ETC.) AS NEEDED FOR UNEXPECTED STORM EVENTS, AND TO ENSURE THAT SEDIMENT AND SEDIMENT-LADEN WATER DO NOT LEAVE THE SITE.
- THE CONTRACTOR OR THE CERTIFIED EROSION AND SEDIMENTATION CONTROL LEAD (CESCL) SHALL INSPECT BMPs DAILY OR AS APPROPRIATE. IF NEEDED, THE CONTRACTOR SHALL MAINTAIN AND REPAIR BMPs IMMEDIATELY TO ENSURE THEIR CONTINUED PERFORMANCE.
- THE ESC FACILITIES ON INACTIVE SITES SHALL BE INSPECTED AND MAINTAINED A MINIMUM OF ONCE A MONTH OR WITHIN THE 24 HOURS FOLLOWING A MAJOR STORM EVENT.
- AT NO TIME SHALL MORE THAN 6 INCHES OF SEDIMENT BE ALLOWED TO ACCUMULATE WITHIN SUMPS. TRASH PUMPS SHALL PUMP TO GRASSY AREAS ON SITE.
- CONSTRUCTION ENTRANCE/EXIT IS REQUIRED. REPLACE OR RESTORE AS NECESSARY AND MAINTAINED FOR THE DURATION OF THE PROJECT. ADDITIONAL MEASURES SUCH AS WASH PADS MAY BE REQUIRED TO INSURE THAT ALL PAVED AREAS ARE KEPT CLEAN FOR THE DURATION OF THE PROJECT.
- COVER ALL DIRT/TOPSOIL PILES WITH PLASTIC COVERING (BMP C123) DURING CONSTRUCTION WHEN NOT IN USE.

CONSTRUCTION SCHEDULING NOTE:

- THE CESCL & CONTRACTOR SHALL MONITOR WEATHER CONDITIONS AND FORECASTS DURING CONSTRUCTION. THE AMOUNT OF SOIL THAT MAY BE EXPOSED AT ANY TIME DEPENDS ON THE CONTRACTOR'S AVAILABLE CREW, MATERIALS, AND EQUIPMENT.
- CONTRACTOR SHALL SCHEDULE WORK SO THAT ALL EXPOSED SOIL (INCLUDING TRENCHES AND STOCKPILES) CAN BE COMPLETELY COVERED AND STABILIZED PRIOR TO ANY SIGNIFICANT RAINFALL EVENT ON SITE.
- WET WEATHER WORK SHOULD BE AVOIDED IF POSSIBLE. CONSTRUCT ROAD IMPROVEMENTS IN MULTIPLE PHASES OR SEGMENTS IF NECESSARY.
- REMOVE TESC BMP(S) WITHIN 30 DAYS AFTER ALL DISTURBED AREAS HAVE BEEN STABILIZED.
- THE CONTRACTOR SHALL INSTALL, IMPLEMENT, AND MAINTAIN BMPs AS RECOMMENDED BY THE PROJECT ENGINEER OR CERTIFIED EROSION AND SEDIMENTATION CONTROL LEAD (CESCL) OR SHALL PROVIDE JUSTIFICATION WHY THE RECOMMENDATIONS MAY NOT APPLY.
- NO SOIL SHALL REMAIN EXPOSED AND UNWORKED FOR MORE THAN 7 DAYS BETWEEN MAY 1 AND SEPTEMBER 30. BETWEEN OCTOBER 1 AND APRIL 30, NO SOIL SHALL REMAIN EXPOSED AND UNWORKED FOR MORE THAN 2 DAYS. ALL EXPOSED SOILS SHALL BE COVERED WITH MULCH, NETS/BLANKETS, COARSE GRAVEL, SEEDING AND PLANTINGS, OR PLASTIC. WITHIN 48 HOURS OF INITIAL CLEARING, EXCAVATION PILES SHALL BE COVERED WITH SECURED PLASTIC COVERING (BMP C123) WHEN NOT BEING WORKED.
- ALL CONSTRUCTION TRAFFIC THAT WILL ROUTINELY LEAVE THE SITE (E.G. WORK TRUCKS, PERSONAL VEHICLES, ETC.) SHALL REMAIN ON PAVED OR STABILIZED SURFACES TO THE MAXIMUM EXTENT PRACTICABLE. OTHER VEHICLES THAT WILL REMAIN ON SITE, SUCH AS EXCAVATORS OR BACKHOES, MAY WORK WITHIN AREAS OF EXPOSED SOIL.
- THE TRACKING OF MUD AND DEBRIS ONTO CITY ROAD IS PROHIBITED. PORTAL WAY AND EXISTING ASPHALT DRIVEWAY SHALL BE CLEANED AT END OF EACH WORK DAY OR AS DIRECTED BY THE CONTRACTOR OR CERTIFIED EROSION AND SEDIMENTATION CONTROL LEAD (CESCL).

CONSTRUCTION SEQUENCE:

- HOLD THE PRE-CONSTRUCTION MEETING.
- FLAG, PAINT, OR FENCE CLEARING LIMITS.
- ALL DOWN GRADIENT PERIMETER SEDIMENT CONTROL BMPs (E.G. SEDIMENT POND, TEMPORARY OUTLET CONTROLS) MUST BE IN PLACE BEFORE ANY UP GRADIENT LAND-DISTURBING ACTIVITY BEGINS.
- TOPSOIL AND SUBGRADE FROM THE SITE IS OF HIGH QUALITY AND SHALL NOT BE USED IN LANDSCAPE BEDS. SUBGRADE SOIL CAN BE USED AS NATIVE BACKFILL IF APPROVED BY GEOTECHNICAL ENGINEER AT TIME OF TRENCH BACKFILL. COVER STOCKPILE WITH MULCH OR PLASTIC COVERING (BMP C123) IF THE STOCKPILE IS TO REMAIN IN PLACE FOR MORE THAN TWO DAYS.
- ROUGH GRADE THE SITE. COVER ALL AREAS THAT WILL BE UNWORKED FOR MORE THAN SEVEN DAYS DURING THE DRY SEASON (MAY 1 TO SEPTEMBER 30) OR TWO DAYS DURING THE WET SEASON (OCTOBER 1 TO APRIL 30) WITH STRAW, WOOD FIBER, COMPOST, PLASTIC COVERING, OR EQUIVALENT.
- RELOCATE EROSION CONTROL MEASURES, OR INSTALL NEW MEASURES SO THAT AS SITE CONDITIONS CHANGE, THE EROSION AND SEDIMENT CONTROL IS ALWAYS IN ACCORDANCE WITH THE CITY OF BELLINGHAM AND DOE EROSION AND SEDIMENT CONTROL STANDARDS.
- SEED, STABILIZE, OR COVER ANY AREAS TO REMAIN UNWORKED FOR MORE THAN 30 DAYS.
- PERFORM ALL OTHER SITE IMPROVEMENTS IN A MANNER THAT MINIMIZES ADVERSE IMPACTS TO THE LOCATION AND FUNCTION OF THE STORMWATER BMPs.
- INSTALL ANY REQUIRED EROSION CONTROL BLANKETS, DITCH CHECKS, AND OTHER SEMI-PERMANENT AND PERMANENT EROSION CONTROL MEASURES.
- REMOVE THE TEMPORARY EROSION AND SEDIMENT CONTROLS WITHIN 30 DAYS AFTER ALL DISTURBED AREAS HAVE BEEN STABILIZED.

ENGINEER'S CERTIFICATION:
"I HEREBY CERTIFY THAT THE IMPROVEMENTS OF PIONEER FLEXSPACE (PHASE 5) HAVE BEEN INSPECTED BY FREELAND & ASSOCIATES, INC. AND CONSTRUCTED IN GENERAL CONFORMANCE WITH THE PLANS APPROVED BY PUBLIC WORKS DIRECTOR FOR SAID DEVELOPMENT AND THE GENERAL SPECIFICATIONS ADOPTED BY THE CITY OF FERDALE DEPARTMENT OF PUBLIC WORKS."

BY: *[Signature]* DATE: 8-30-21

LEGEND:

- | | | | |
|-----|---|---|----|
| VEG | WSDOE BMP C101
PRESERVING NATURAL (OR CROP) VEGETATION | B | C5 |
| CE | WSDOE BMP C105
STABILIZED CONSTRUCTION EXIT | | |
| PS | WSDOE BMP C120
TEMPORARY AND PERMANENT SEEDING | | |
| MU | WSDOE BMP C121
MULCHING | | |
| DC | WSDOE BMP C140
DUST CONTROL | | |
| IP | WSDOE BMP C220
STORM DRAIN INLET PROTECTION | A | C5 |
| SC | WSDOE BMP C152
SAWCUTTING & SURFACE POLLUTION PREVENTION | D | C6 |
| FF | WSDOE BMP C233
SILT FENCE | C | C7 |

AS-BUILT DRAWING

ONLY INFORMATION NOTED AS AS-BUILT "AS" HAS BEEN PROVIDED BY PROJECT SURVEYOR. DATE OF POINT FILES 10/1/2019, 10/18/2019, 10/23/2020, 07/12/2021. CONTRACTOR PROVIDED ADDITIONAL MEASURE DOWNS 10/21/2019.



REV	DATE	DESCRIPTION


CLIENT: PIONEER POST FRAME
6208 PORTAL WAY
FERDALE, WASHINGTON
CALL BEFORE YOU DIG
FOR BURIED UTILITY LOCATIONS
1-800-424-5555

PROJECT LOCATION: PIONEER FLEXSPACE, LLC
6407 PORTAL WAY
FERDALE, WASHINGTON
DRAWN BY: C.J.
CHECKED BY: HAF
DESIGNED BY: HAF

SHEET CONTENTS: TEMPORARY EROSION AND SEDIMENTATION CONTROL PLAN



JOB #	18084	DATE	8-30-2021
SCALE	HORIZ: 1"=40'	SHEET	C4
VERT	N/A		

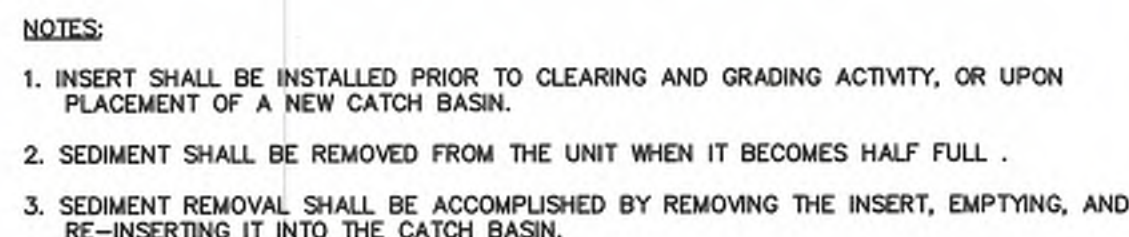

Volume II – Construction Stormwater Pollution Prevention - August 2012

D SAWCUTTING



CLIENT:

**CALL BEFORE YOU DIG
FOR BURIED UTILITY LOCATIONS**
1-800-424-5555


DRAWN BY:	
-----------	--

JOB #: 18084	DATE: 8-30-2021
SCALE: HORIZ: 1"=40' VERT: N/A	SHEET: C5

This project includes several Low Impact Development BMPs including Downspout Infiltration Trenches, Infiltration Basins, and Permeable Pavement. These facilities must be protected from sedimentation during construction. Excavate the stormwater management systems to within one foot of final bottom elevation of the facility during construction. Excavate to final depth only after all disturbed areas in the up gradient project drainage area have been permanently stabilized. After construction of the infiltration facilities, prevent sediment from entering the facilities by first conveying runoff through an appropriate pretreatment system (e.g. pre-settling basin, temporary sediment pond, or sand filter). Infiltration facilities should not be used as temporary sediment trapping structures. Sediment that accumulates within the infiltration facilities shall be removed before putting the facilities into service. Relatively light tracked equipment is recommended for this operation to avoid compaction to the basin floor. The use of draglines and track hoes should be considered for constructing infiltration basins if possible. The infiltration area shall be flagged or marked to keep heavy equipment away.


AUG 31 2021
 BY *[Signature]*
 CITY OF FERNDALE
 PUBLIC WORKS DEPARTMENT

AS-BUILT NOTE:
ONLY INFORMATION NOTED AS AS-BUILT "(AB)" HAS BEEN
PROVIDED BY PROJECT SURVEYOR. DATE OF POINT FILES
10/1/2019, 10/18/2019, 10/23/2020, 07/12/2021. CONTRACT
PROVIDED ADDITIONAL MEASURE DOWNS 10/21/2019.

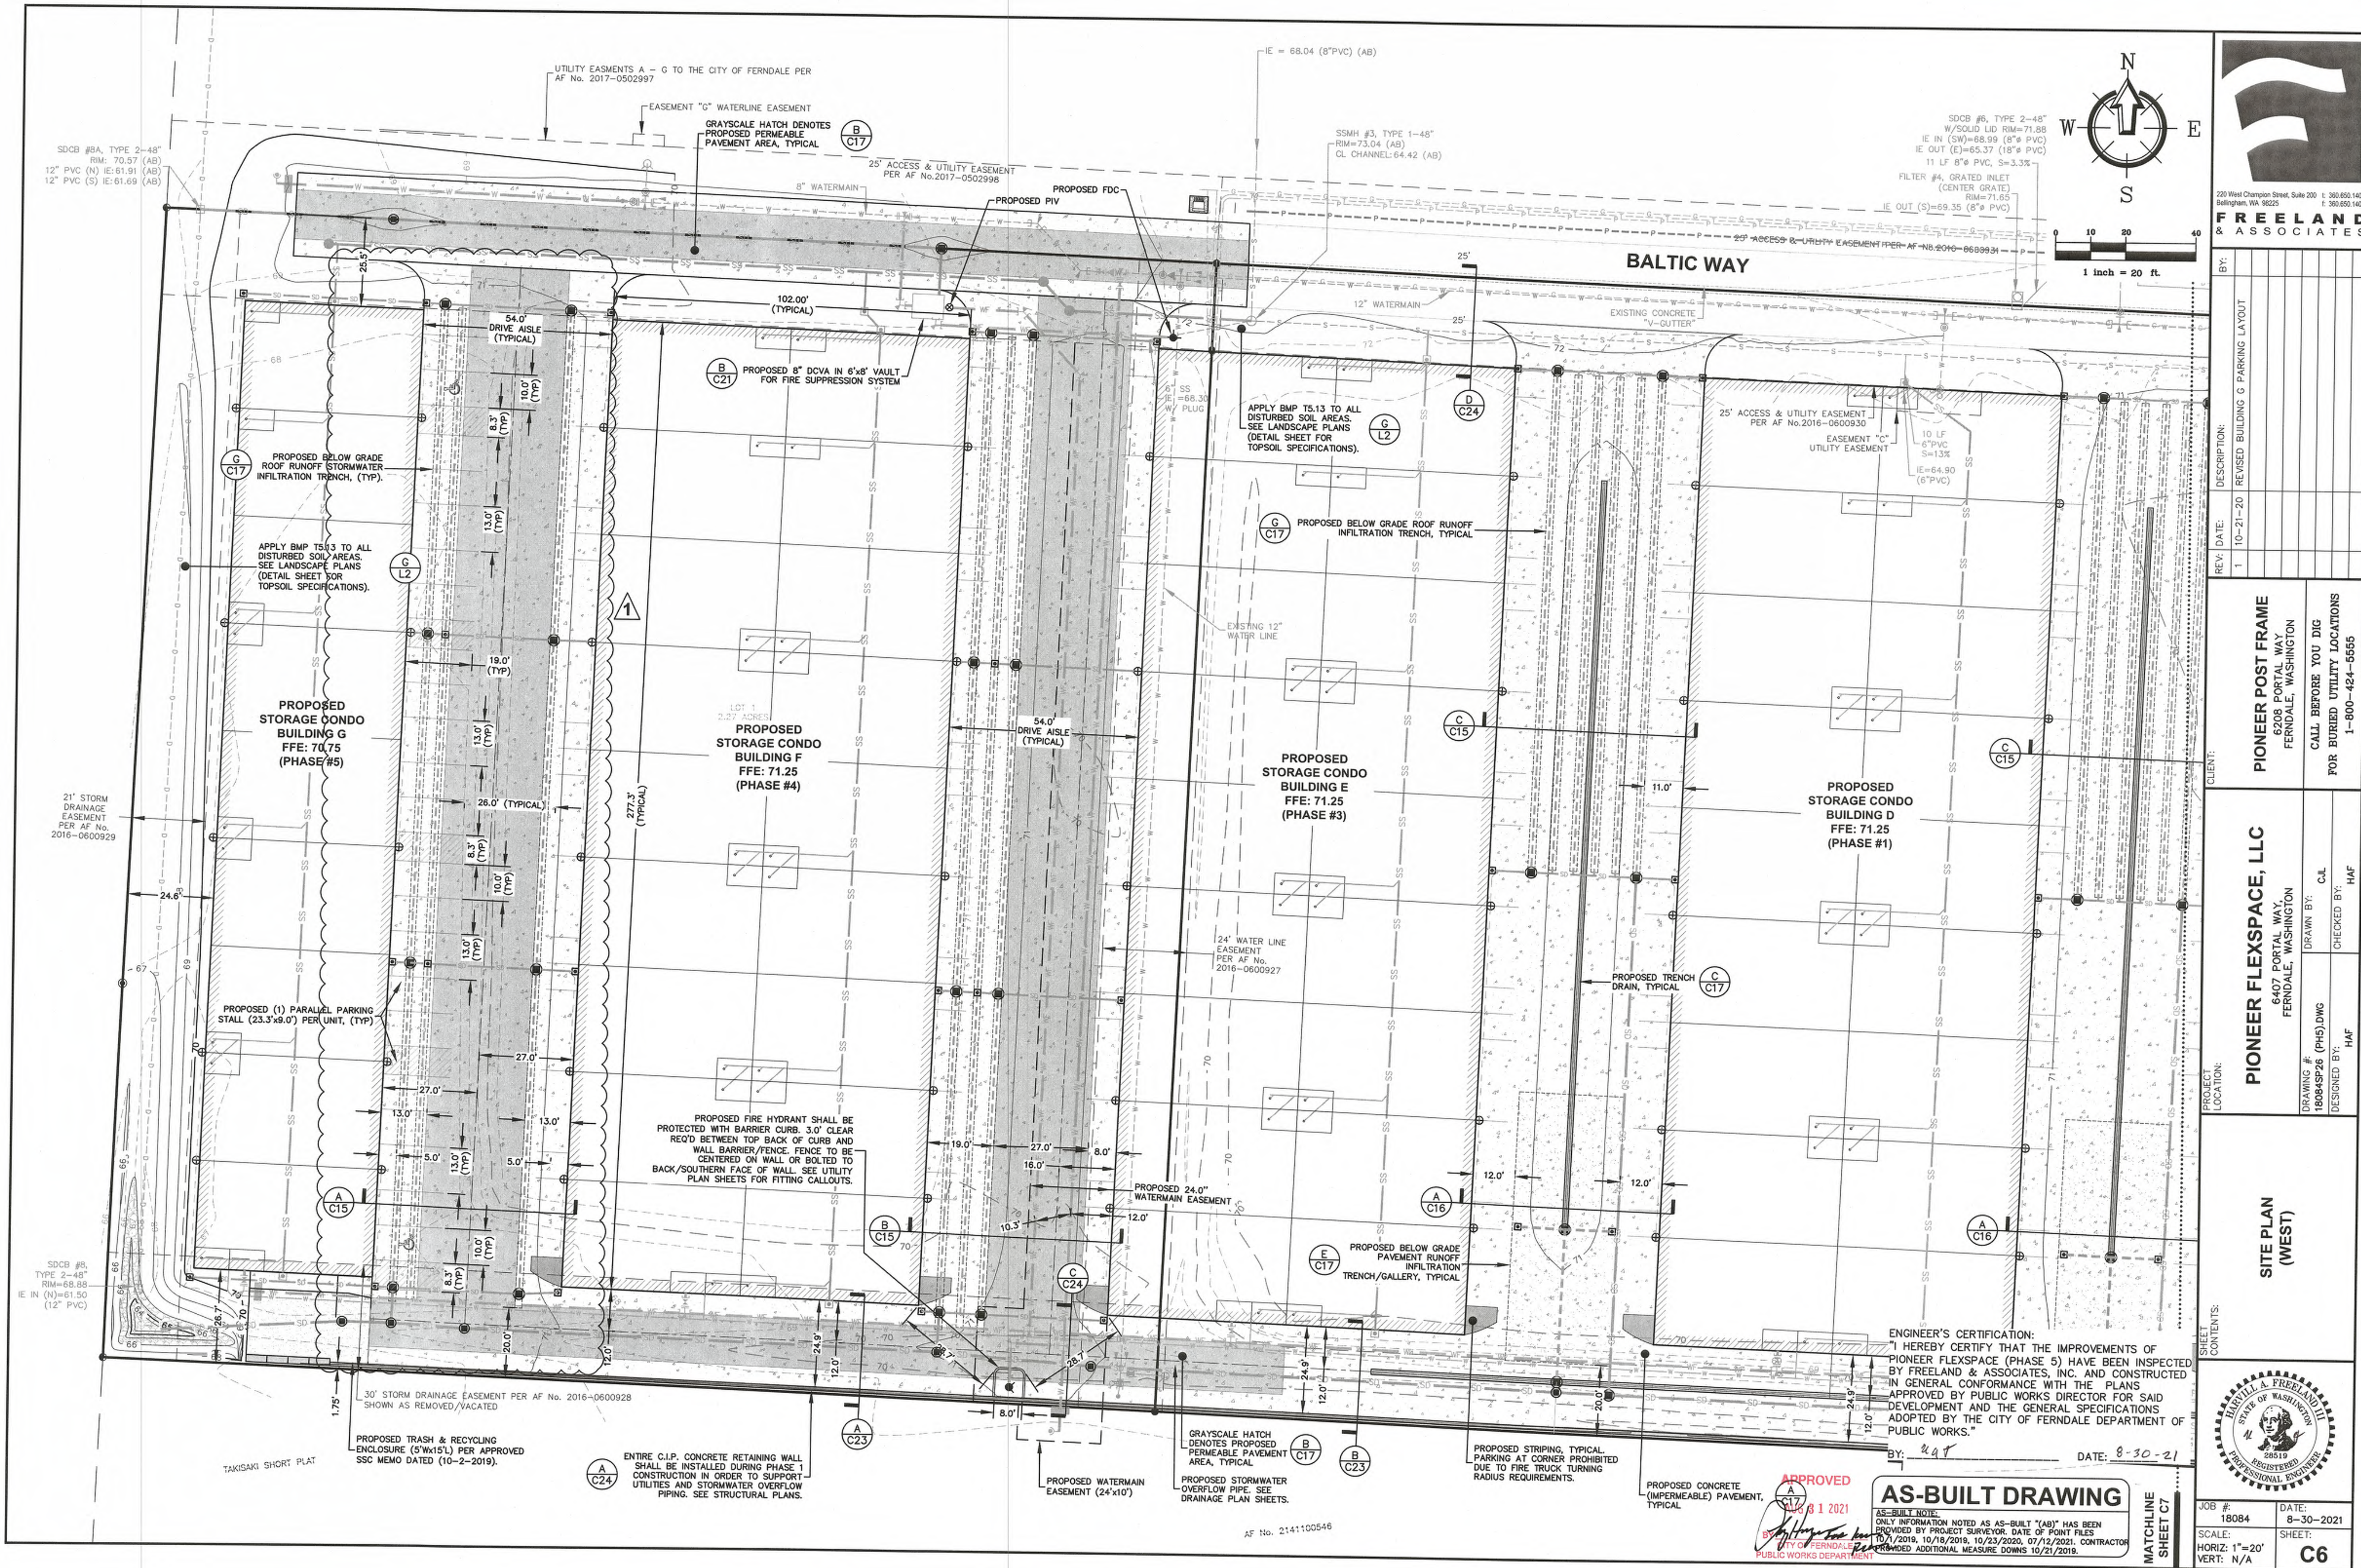

BY:	DESCRIPTION:	REV:	DATE:	1	10-21-20	REVISED BUILDING G PARKING LAYOUT
PROJECT LOCATION:	CLIENT:	DRAWING #:	DESIGNED BY:	18084SP26 (PH5)DWG	HAF	
SITE PLAN (WEST)	PIONEER FLEXSPACE, LLC 6407 PORTAL WAY, FERDALE, WASHINGTON	DRAWN BY:	CHECKED BY:	CAL	HAF	
	PIONEER POST FRAME 8208 PORTAL WAY FERDALE, WASHINGTON	CALL BEFORE YOU DIG FOR BURIED UTILITY LOCATIONS 1-800-424-5555				
JOB #:	DATE:	SCALE:	HORIZ:	VERT:	SHEET:	C6
18084	8-30-2021	1"=20'	N/A			



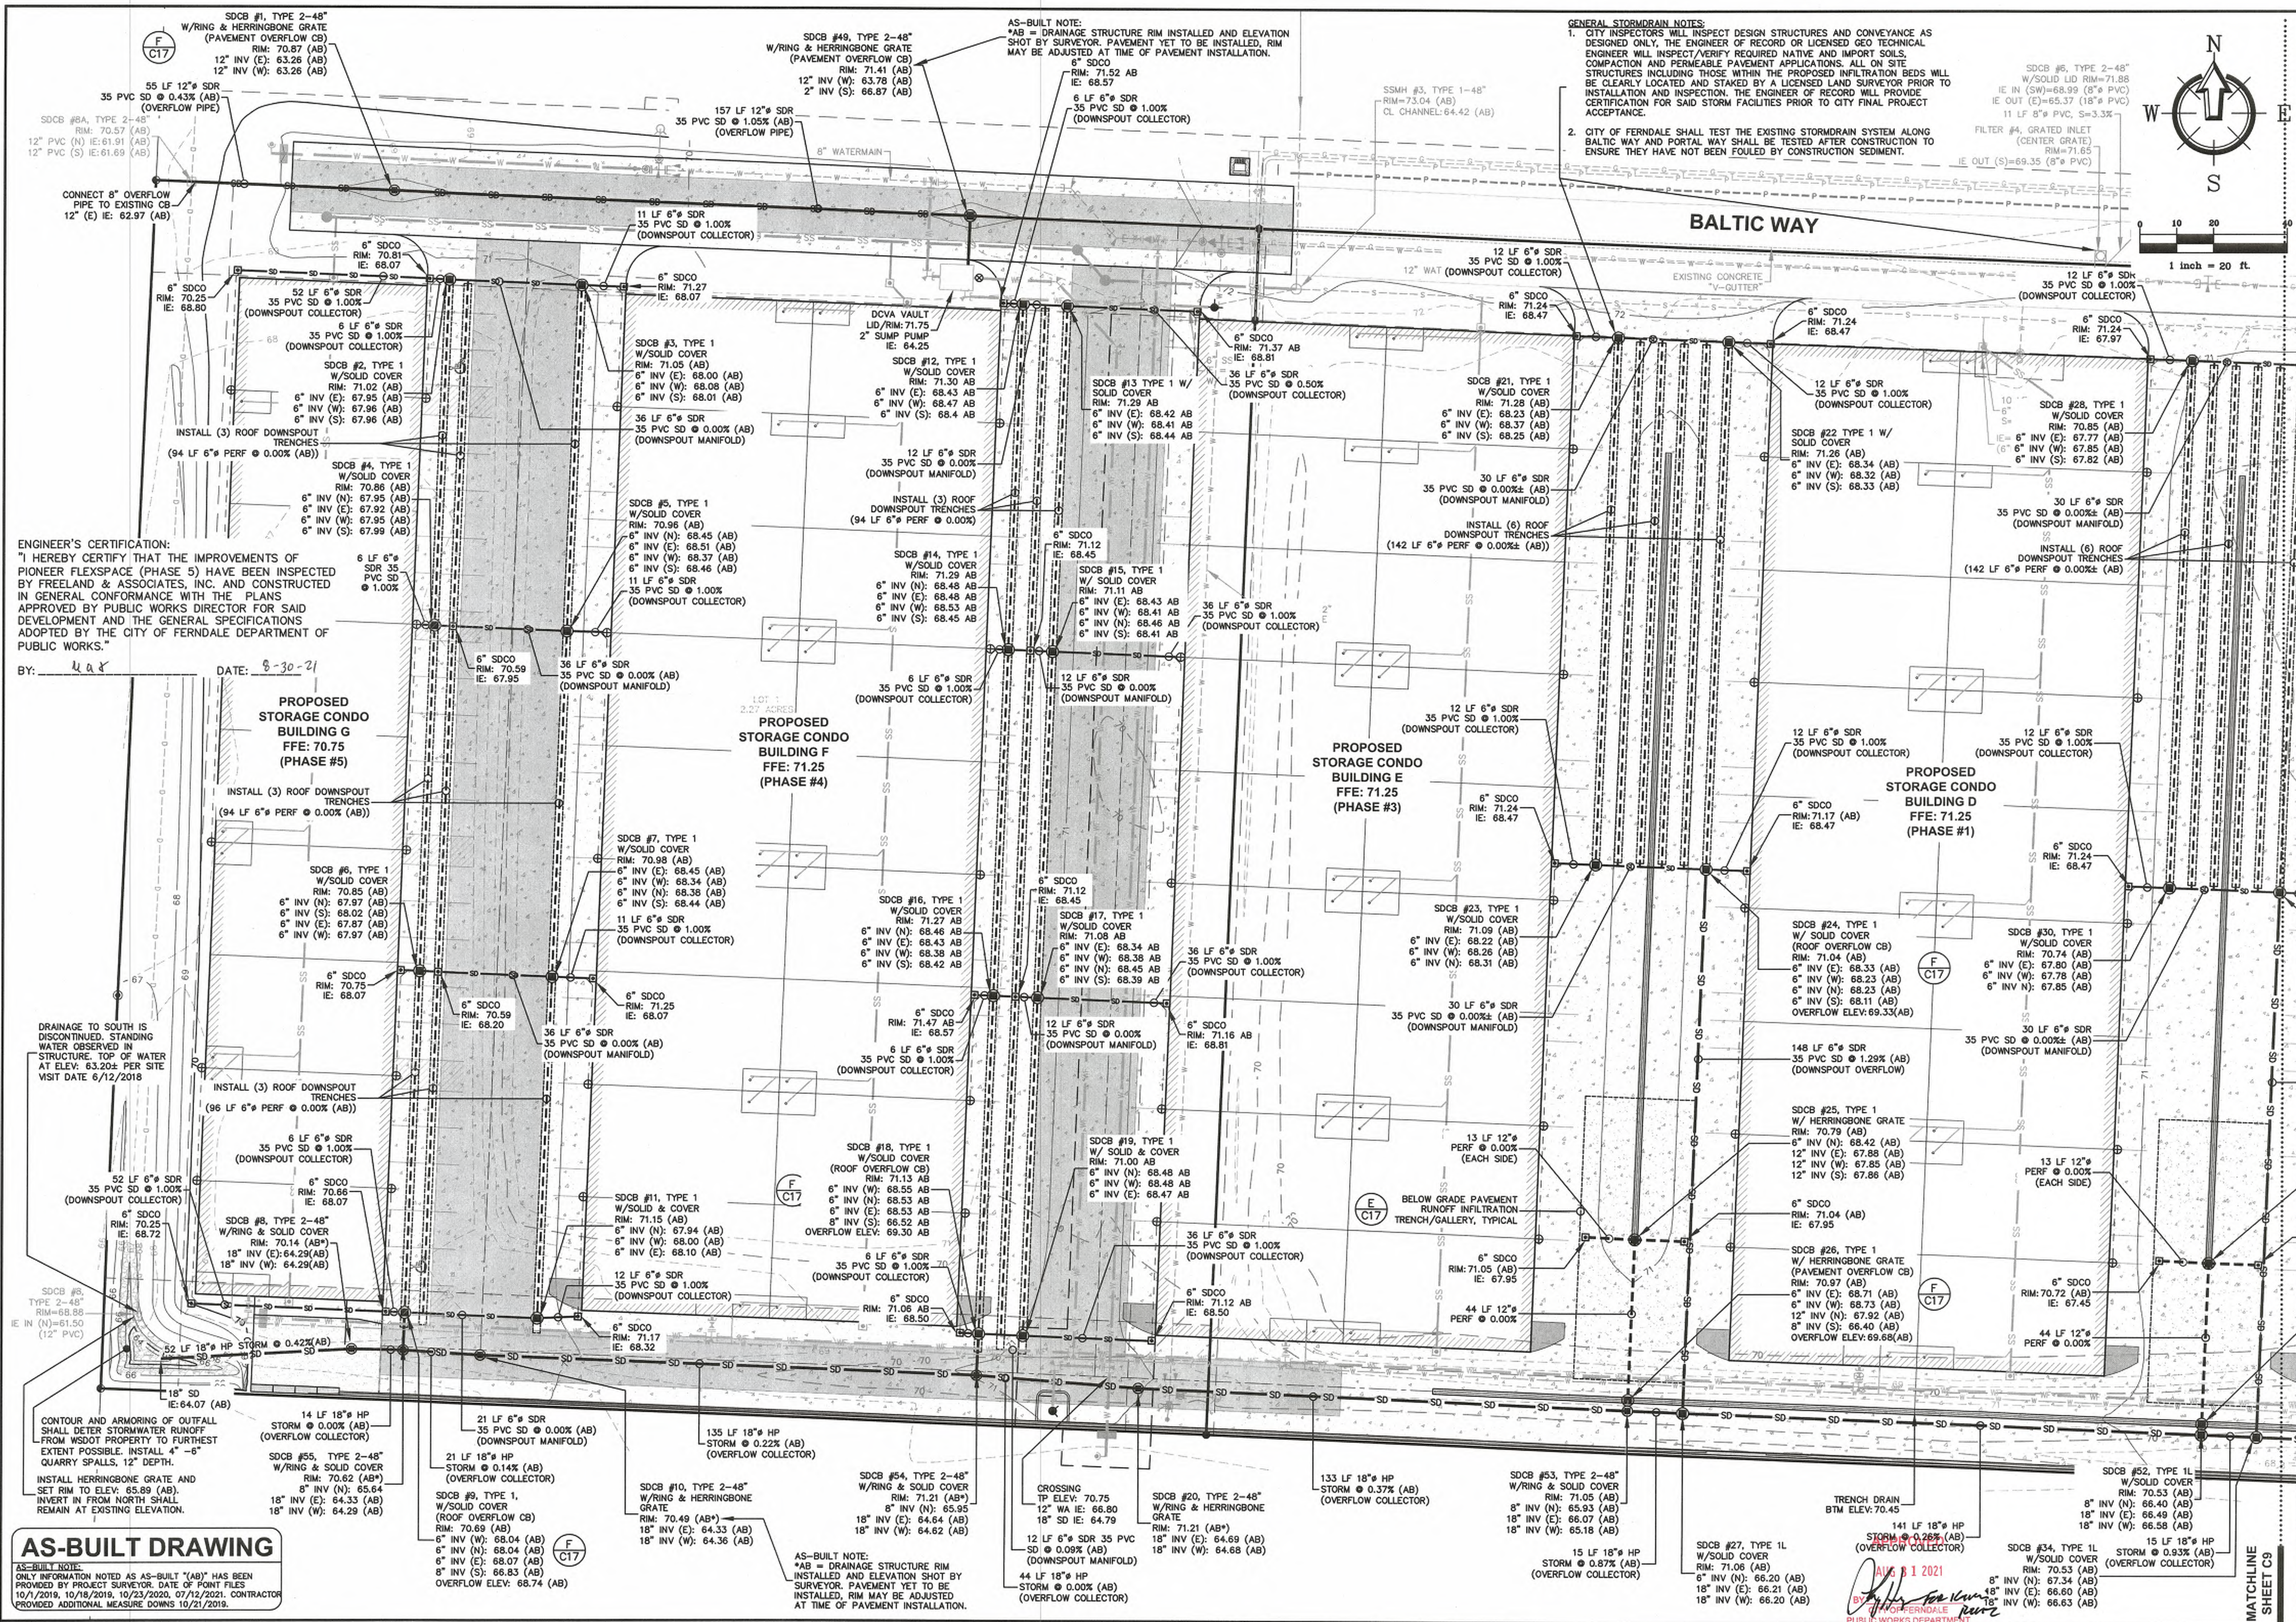

ENGINEER'S CERTIFICATION:
"I HEREBY CERTIFY THAT THE IMPROVEMENTS OF PIONEER FLEXSPACE (PHASE 5) HAVE BEEN INSPECTED BY FREELAND & ASSOCIATES, INC. AND CONSTRUCTED IN GENERAL CONFORMANCE WITH THE PLANS APPROVED BY PUBLIC WORKS DIRECTOR FOR SAID DEVELOPMENT AND THE GENERAL SPECIFICATIONS ADOPTED BY THE CITY OF FERNDALE DEPARTMENT OF PUBLIC WORKS."

BY: UAS DATE: 8-30-21


DRAINAGE TO SOUTH IS DISCONTINUED. STANDING WATER OBSERVED IN STRUCTURE. TOP OF WATER AT ELEV. 63.20± PER SITE VISIT DATE 6/12/2018

CONTOUR AND ARMORING OF OUTFALL SHALL DETERMINE STORMWATER RUNOFF FROM WSDOT PROPERTY TO FURTHEST EXTENT POSSIBLE. INSTALL 4" - 6" QUARRY SPALLS, 12" DEPTH.
INSTALL HERRINGBONE GRATE AND SET RIM TO ELEV. 65.89 (AB).
INVERT IN FROM NORTH SHALL REMAIN AT EXISTING ELEVATION.

AS-BUILT DRAWING
AS-BUILT NOTE:
ONLY INFORMATION NOTED AS AS-BUILT ("AB") HAS BEEN PROVIDED BY PROJECT SURVEYOR. DATE OF POINT FILES 10/1/2019, 10/18/2019, 10/23/2020, 07/12/2021. CONTRACTOR PROVIDED ADDITIONAL MEASURE DOWNS 10/21/2019.

AS-BUILT NOTE:
"AB" = DRAINAGE STRUCTURE RIM INSTALLED AND ELEVATION SHOT BY SURVEYOR. PAVEMENT YET TO BE INSTALLED, RIM MAY BE ADJUSTED AT TIME OF PAVEMENT INSTALLATION.

GENERAL STORMDRAIN NOTES:
1. CITY INSPECTORS WILL INSPECT DESIGN STRUCTURES AND CONVEYANCE AS DESIGNED ONLY. THE ENGINEER OF RECORD OR LICENSED GEO TECHNICAL ENGINEER WILL INSPECT/VERIFY REQUIRED NATIVE AND IMPORT SOILS, COMPACTION AND PERMEABLE PAVEMENT APPLICATIONS. ALL ON SITE STRUCTURES INCLUDING THOSE WITHIN THE PROPOSED INFILTRATION BEDS WILL BE CLEARLY LOCATED AND STAKED BY A LICENSED LAND SURVEYOR PRIOR TO INSTALLATION AND INSPECTION. THE ENGINEER OF RECORD WILL PROVIDE CERTIFICATION FOR SAID STORM FACILITIES PRIOR TO CITY FINAL PROJECT ACCEPTANCE.
2. CITY OF FERNDALE SHALL TEST THE EXISTING STORMDRAIN SYSTEM ALONG BALTIC WAY AND PORTAL WAY SHALL BE TESTED AFTER CONSTRUCTION TO ENSURE THEY HAVE NOT BEEN FOULED BY CONSTRUCTION SEDIMENT.

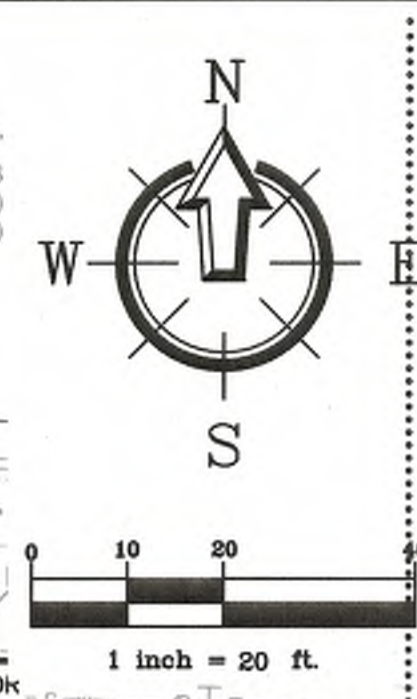

220 West Charleston Street, Suite 200 | 98050-1408
Bellingham, WA 98225
FREELAND & ASSOCIATES

REV.	DATE	DESCRIPTION
1	5/20/2018	STORM AND WATERMAN CROSSING REVISION

CLIENT: **PIONEER FLEXSPACE, LLC**
6208 PORTAL WAY
FERNDALE, WASHINGTON

PROJECT LOCATION: **PIONEER POST FRAME**
6208 PORTAL WAY
FERNDALE, WASHINGTON

DRAWN BY: CUL CHECKED BY: HAF

DESIGNED BY: HAF


SHEET CONTENTS: **DRAINAGE PLAN (WEST)**

AS-BUILT DRAWING


JOB #: 18084 DATE: 8-30-2021

SCALE: HORIZ: 1"=20' SHEET: **C8**

VERT: N/A

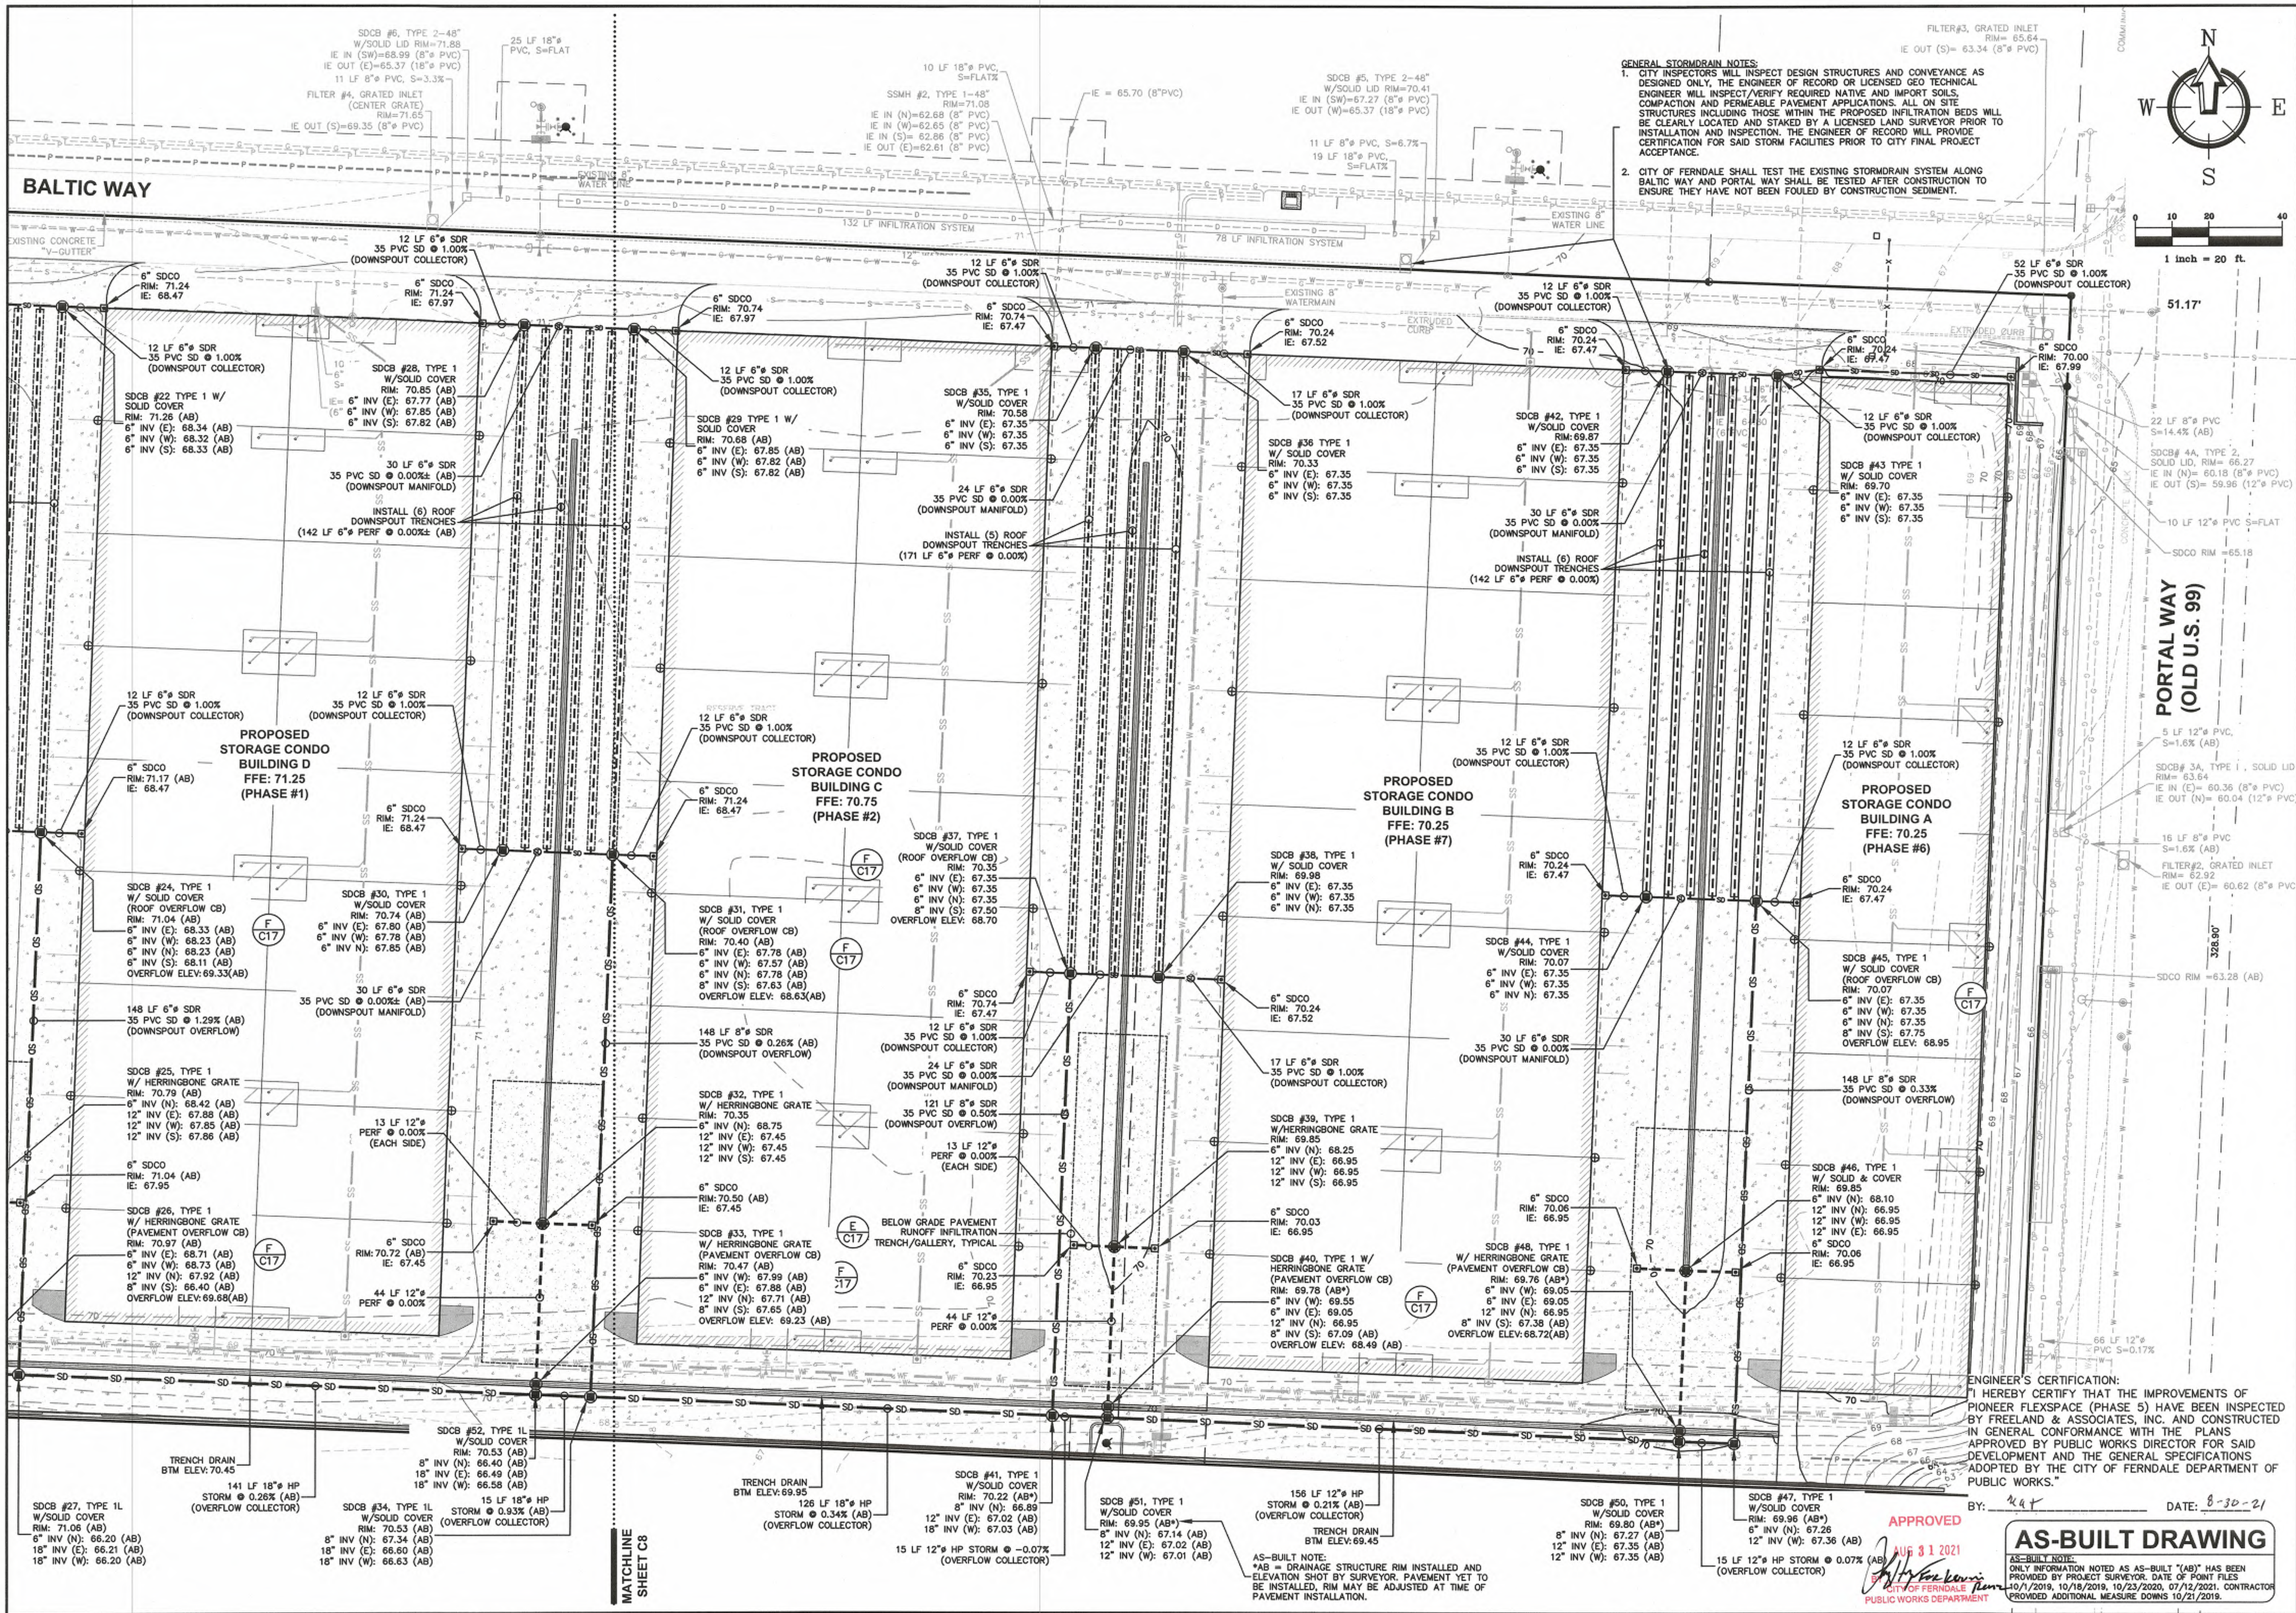

GENERAL STORMDRAIN NOTES:
1. CITY INSPECTORS WILL INSPECT DESIGN STRUCTURES AND CONVEYANCE AS DESIGNED ONLY. THE ENGINEER OF RECORD OR LICENSED GEO TECHNICAL ENGINEER WILL INSPECT/VERIFY REQUIRED NATIVE AND IMPORT SOILS, COMPACTION AND PERMEABLE PAVEMENT APPLICATIONS. ALL ON SITE STRUCTURES INCLUDING THOSE WITHIN THE PROPOSED INFILTRATION BEDS WILL BE CLEARLY LOCATED AND STAKED BY A LICENSED LAND SURVEYOR PRIOR TO INSTALLATION AND INSPECTION. THE ENGINEER OF RECORD WILL PROVIDE CERTIFICATION FOR SAID STORM FACILITIES PRIOR TO CITY FINAL PROJECT ACCEPTANCE.
2. CITY OF FERNDALE SHALL TEST THE EXISTING STORMDRAIN SYSTEM ALONG BALTIC WAY AND PORTAL WAY SHALL BE TESTED AFTER CONSTRUCTION TO ENSURE THEY HAVE NOT BEEN FOULED BY CONSTRUCTION SEDIMENT.

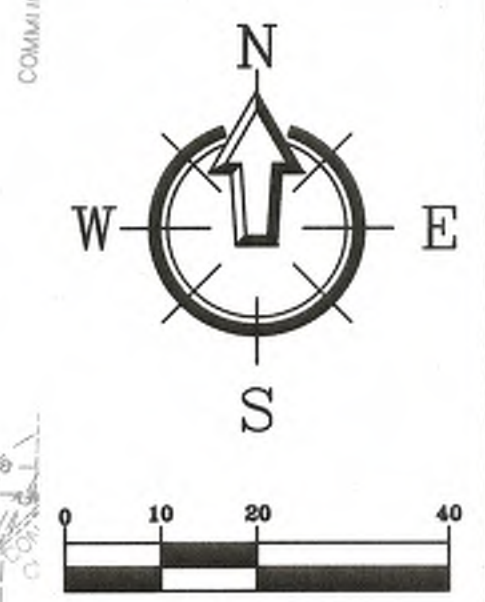

FREELAND & ASSOCIATES
200 West Champion Street, Suite 200
Bellingham, WA 98225
T: 360.650.1408
F: 360.650.1401

BY:	DATE:	DESCRIPTION:
REV:	DATE:	DESCRIPTION:
CLIENT:	PIONEER POST FRAME 6208 PORTAL WAY FERNDALE, WASHINGTON	
PROJECT LOCATION:	PIONEER FLEXSPACE, LLC 6407 PORTAL WAY FERNDALE, WASHINGTON	
SHEET CONTENTS:	DRAWING # 1808/SP25 (PH5) DWG DESIGNED BY: HAF CHECKED BY: HAF CITY OF FERNDALE PUBLIC WORKS DEPARTMENT	
JOB #:	18084	DATE: 8-30-2021
SCALE:	HORIZ: 1"=20'	SHEET: C9
VERT:	N/A	


ENGINEER'S CERTIFICATION:
I HEREBY CERTIFY THAT THE IMPROVEMENTS OF PIONEER FLEXSPACE (PHASE 5) HAVE BEEN INSPECTED BY FREELAND & ASSOCIATES, INC. AND CONSTRUCTED IN GENERAL CONFORMANCE WITH THE PLANS APPROVED BY PUBLIC WORKS DIRECTOR FOR SAID DEVELOPMENT AND THE GENERAL SPECIFICATIONS ADOPTED BY THE CITY OF FERNDALE DEPARTMENT OF PUBLIC WORKS.

APPROVED: *[Signature]* DATE: 8-30-21


AS-BUILT DRAWING

AS-BUILT NOTE:
ONLY INFORMATION NOTED AS AS-BUILT (AB) HAS BEEN PROVIDED BY PROJECT SURVEYOR. DATE OF POINT FILES: 10/1/2019, 10/18/2019, 10/23/2020, 07/12/2021. CONTRACTOR PROVIDED ADDITIONAL MEASURE DOWNS 10/21/2019.

00716.009 08/31/2021 RH

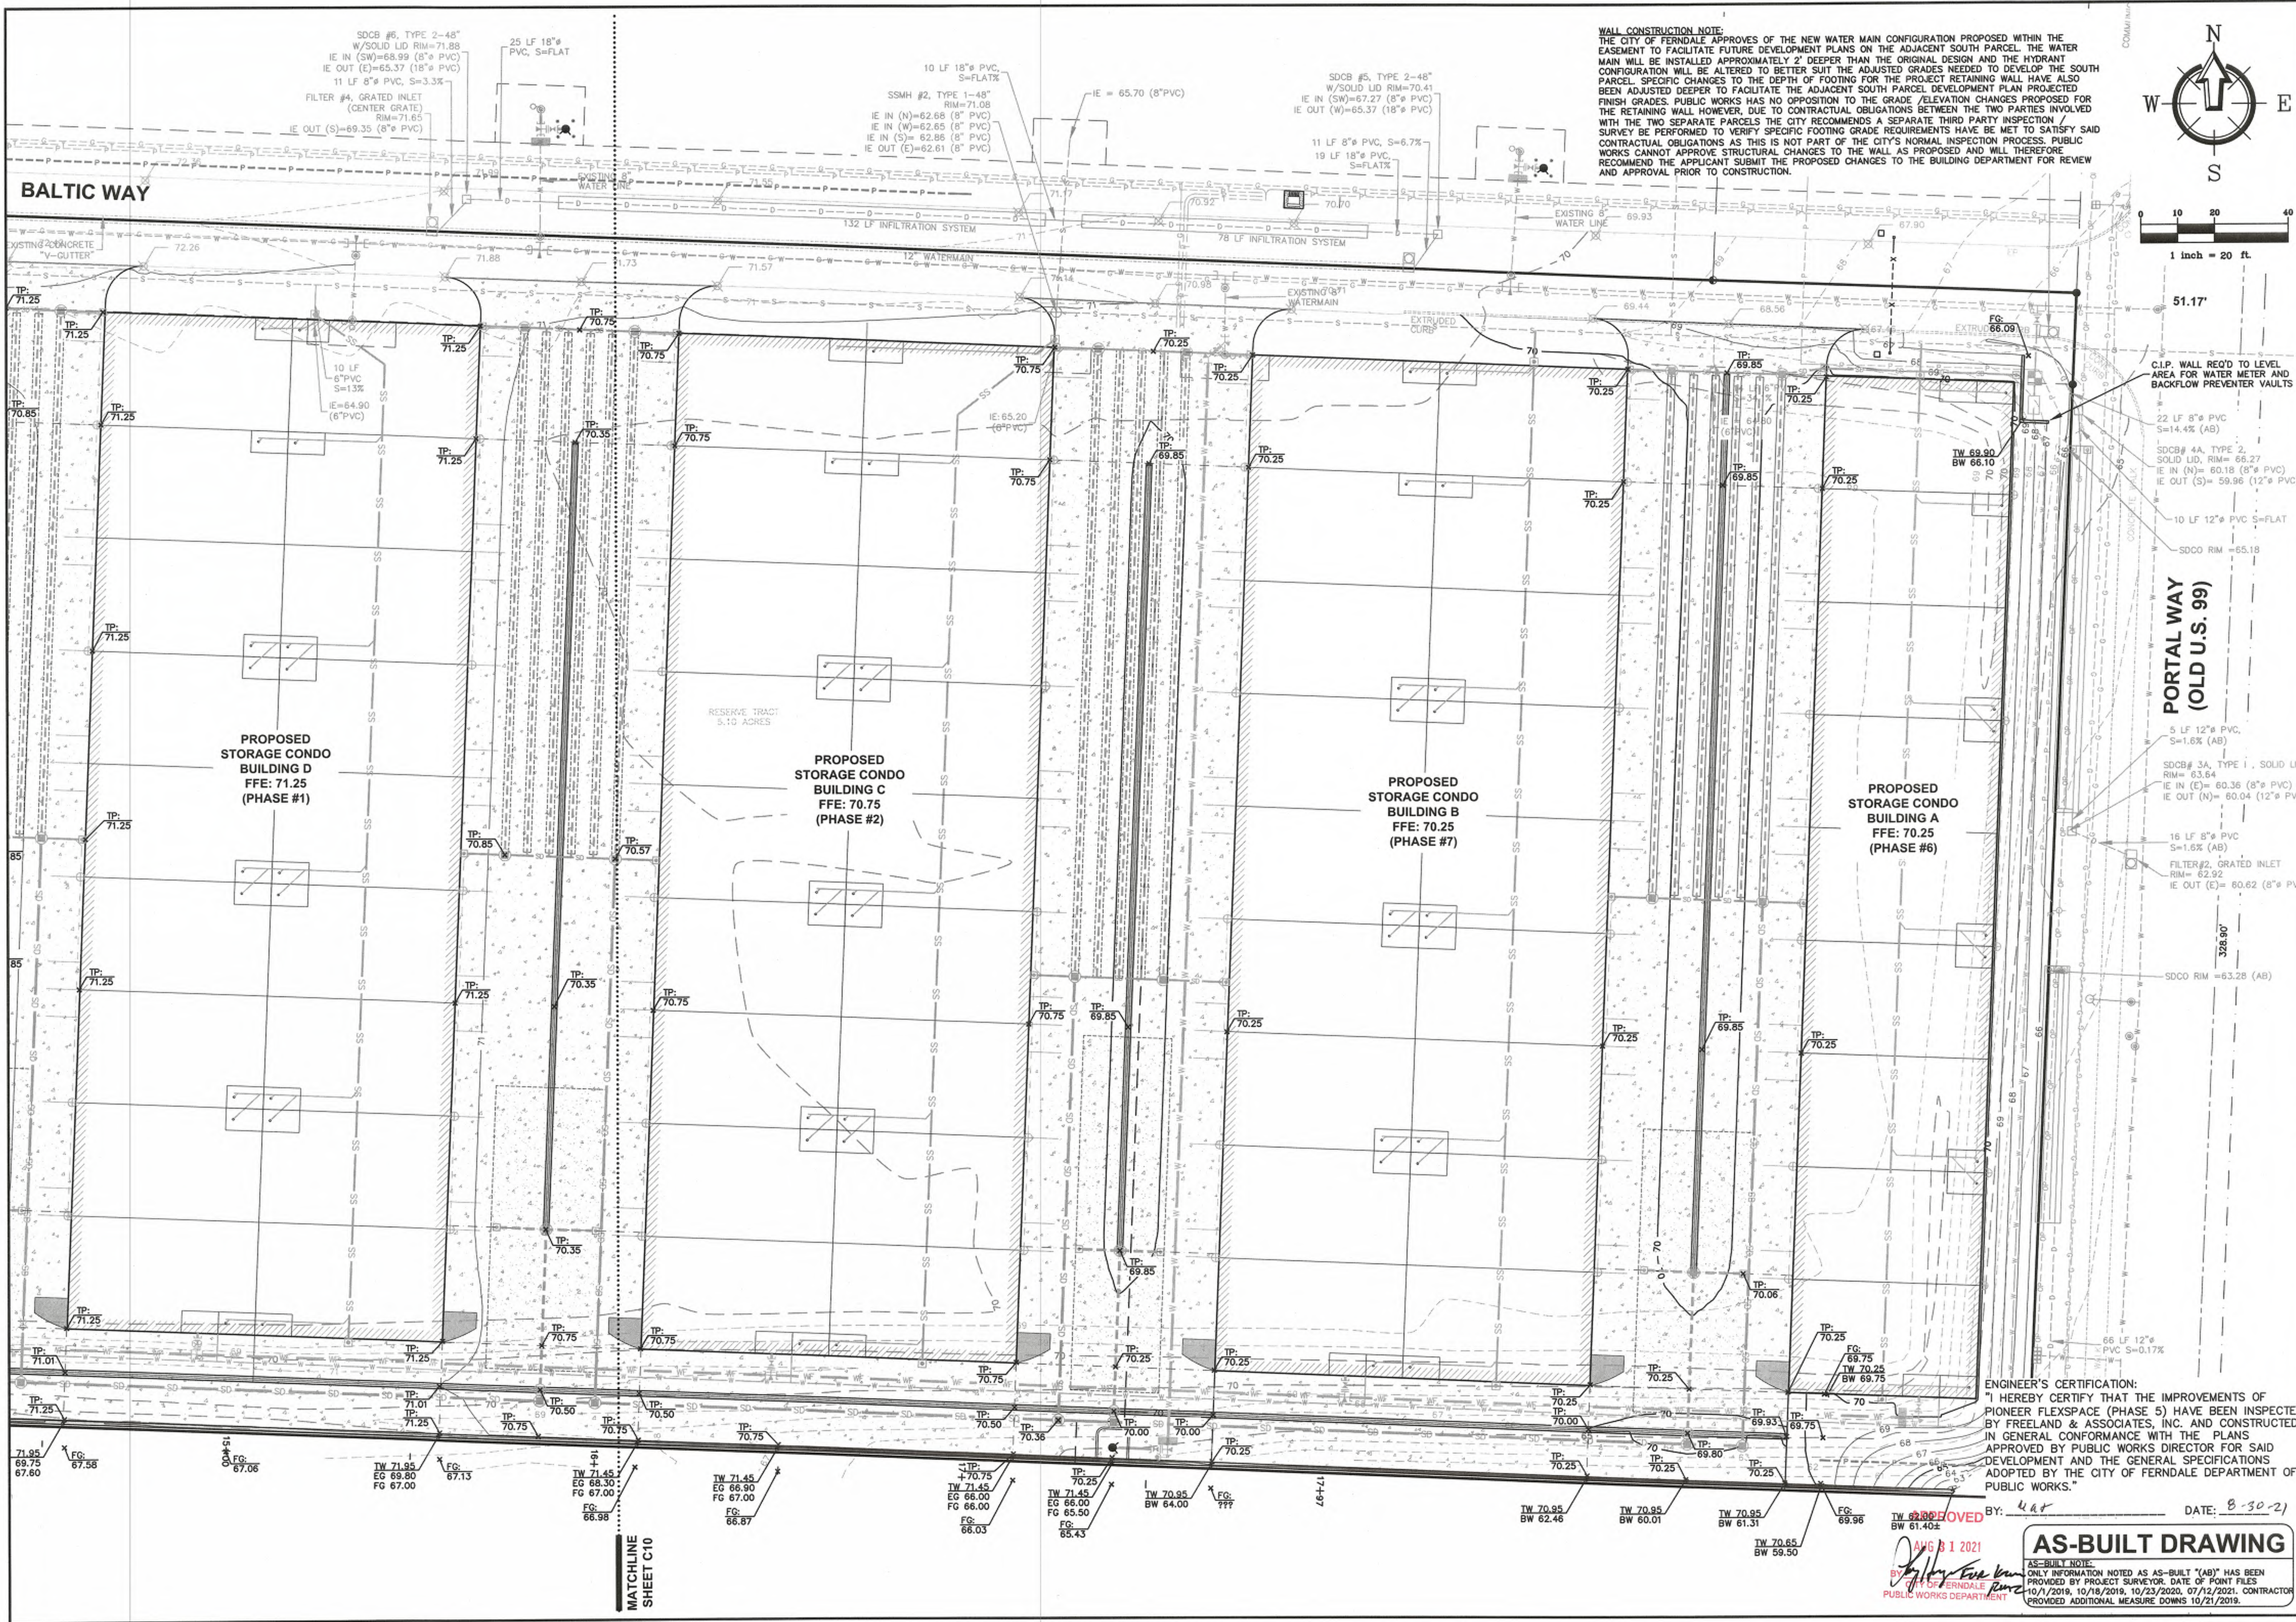


WALL CONSTRUCTION NOTE:
THE CITY OF FERNDALE APPROVES OF THE NEW WATER MAIN CONFIGURATION PROPOSED WITHIN THE EASEMENT TO FACILITATE FUTURE DEVELOPMENT PLANS ON THE ADJACENT SOUTH PARCEL. THE WATER MAIN WILL BE INSTALLED APPROXIMATELY 2' DEEPER THAN THE ORIGINAL DESIGN AND THE HYDRANT CONFIGURATION WILL BE ALTERED TO BETTER SUIT THE ADJUSTED GRADES NEEDED TO DEVELOP THE SOUTH PARCEL. SPECIFIC CHANGES TO THE DEPTH OF FOOTING FOR THE PROJECT RETAINING WALL HAVE ALSO BEEN ADJUSTED DEEPER TO FACILITATE THE ADJACENT SOUTH PARCEL DEVELOPMENT PLAN PROJECTED FINISH GRADES. PUBLIC WORKS HAS NO OPPOSITION TO THE GRADE / ELEVATION CHANGES PROPOSED FOR THE RETAINING WALL HOWEVER, DUE TO CONTRACTUAL OBLIGATIONS BETWEEN THE TWO PARTIES INVOLVED WITH THE TWO SEPARATE PARCELS THE CITY RECOMMENDS A SEPARATE THIRD PARTY INSPECTION / SURVEY BE PERFORMED TO VERIFY SPECIFIC FOOTING GRADE REQUIREMENTS HAVE BEEN MET TO SATISFY SAID CONTRACTUAL OBLIGATIONS AS THIS IS NOT PART OF THE CITY'S NORMAL INSPECTION PROCESS. PUBLIC WORKS CANNOT APPROVE STRUCTURAL CHANGES TO THE WALL AS PROPOSED AND WILL THEREFORE RECOMMEND THE APPLICANT SUBMIT THE PROPOSED CHANGES TO THE BUILDING DEPARTMENT FOR REVIEW AND APPROVAL PRIOR TO CONSTRUCTION.

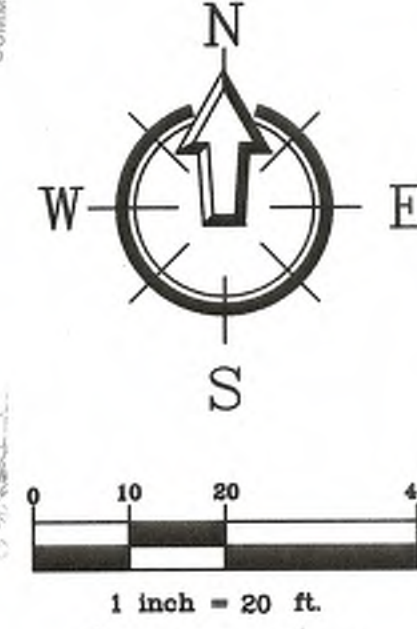

FREELAND & ASSOCIATES
220 West Champion Street, Suite 200
Bellevue, WA 98005
P: 360.650.1408
F: 360.650.1401

BY: HAF	DATE: 1/30/2019	DESCRIPTION: CROSS SECTION REVISION PER OWNER REQUEST
CLIENT: PIONEER FLEXSPACE, LLC 6407 PORTAL WAY FERNDALE, WASHINGTON	DRAWN BY: C.L.	CHECKED BY: HAF
PROJECT LOCATION: PIONEER POST FRAME 6208 PORTAL WAY FERNDALE, WASHINGTON	DRAWING #: 18004SP26 (PH5).DWG	DESIGNED BY: HAF
SHEET CONTENTS: GRADING PLAN (EAST)	JOB #: 18084	DATE: 8-30-2021
AS-BUILT DRAWING	SCALE: HORIZ: 1"=20' VERT: N/A	SHEET: C11

00716.011 08/31/2021 RH

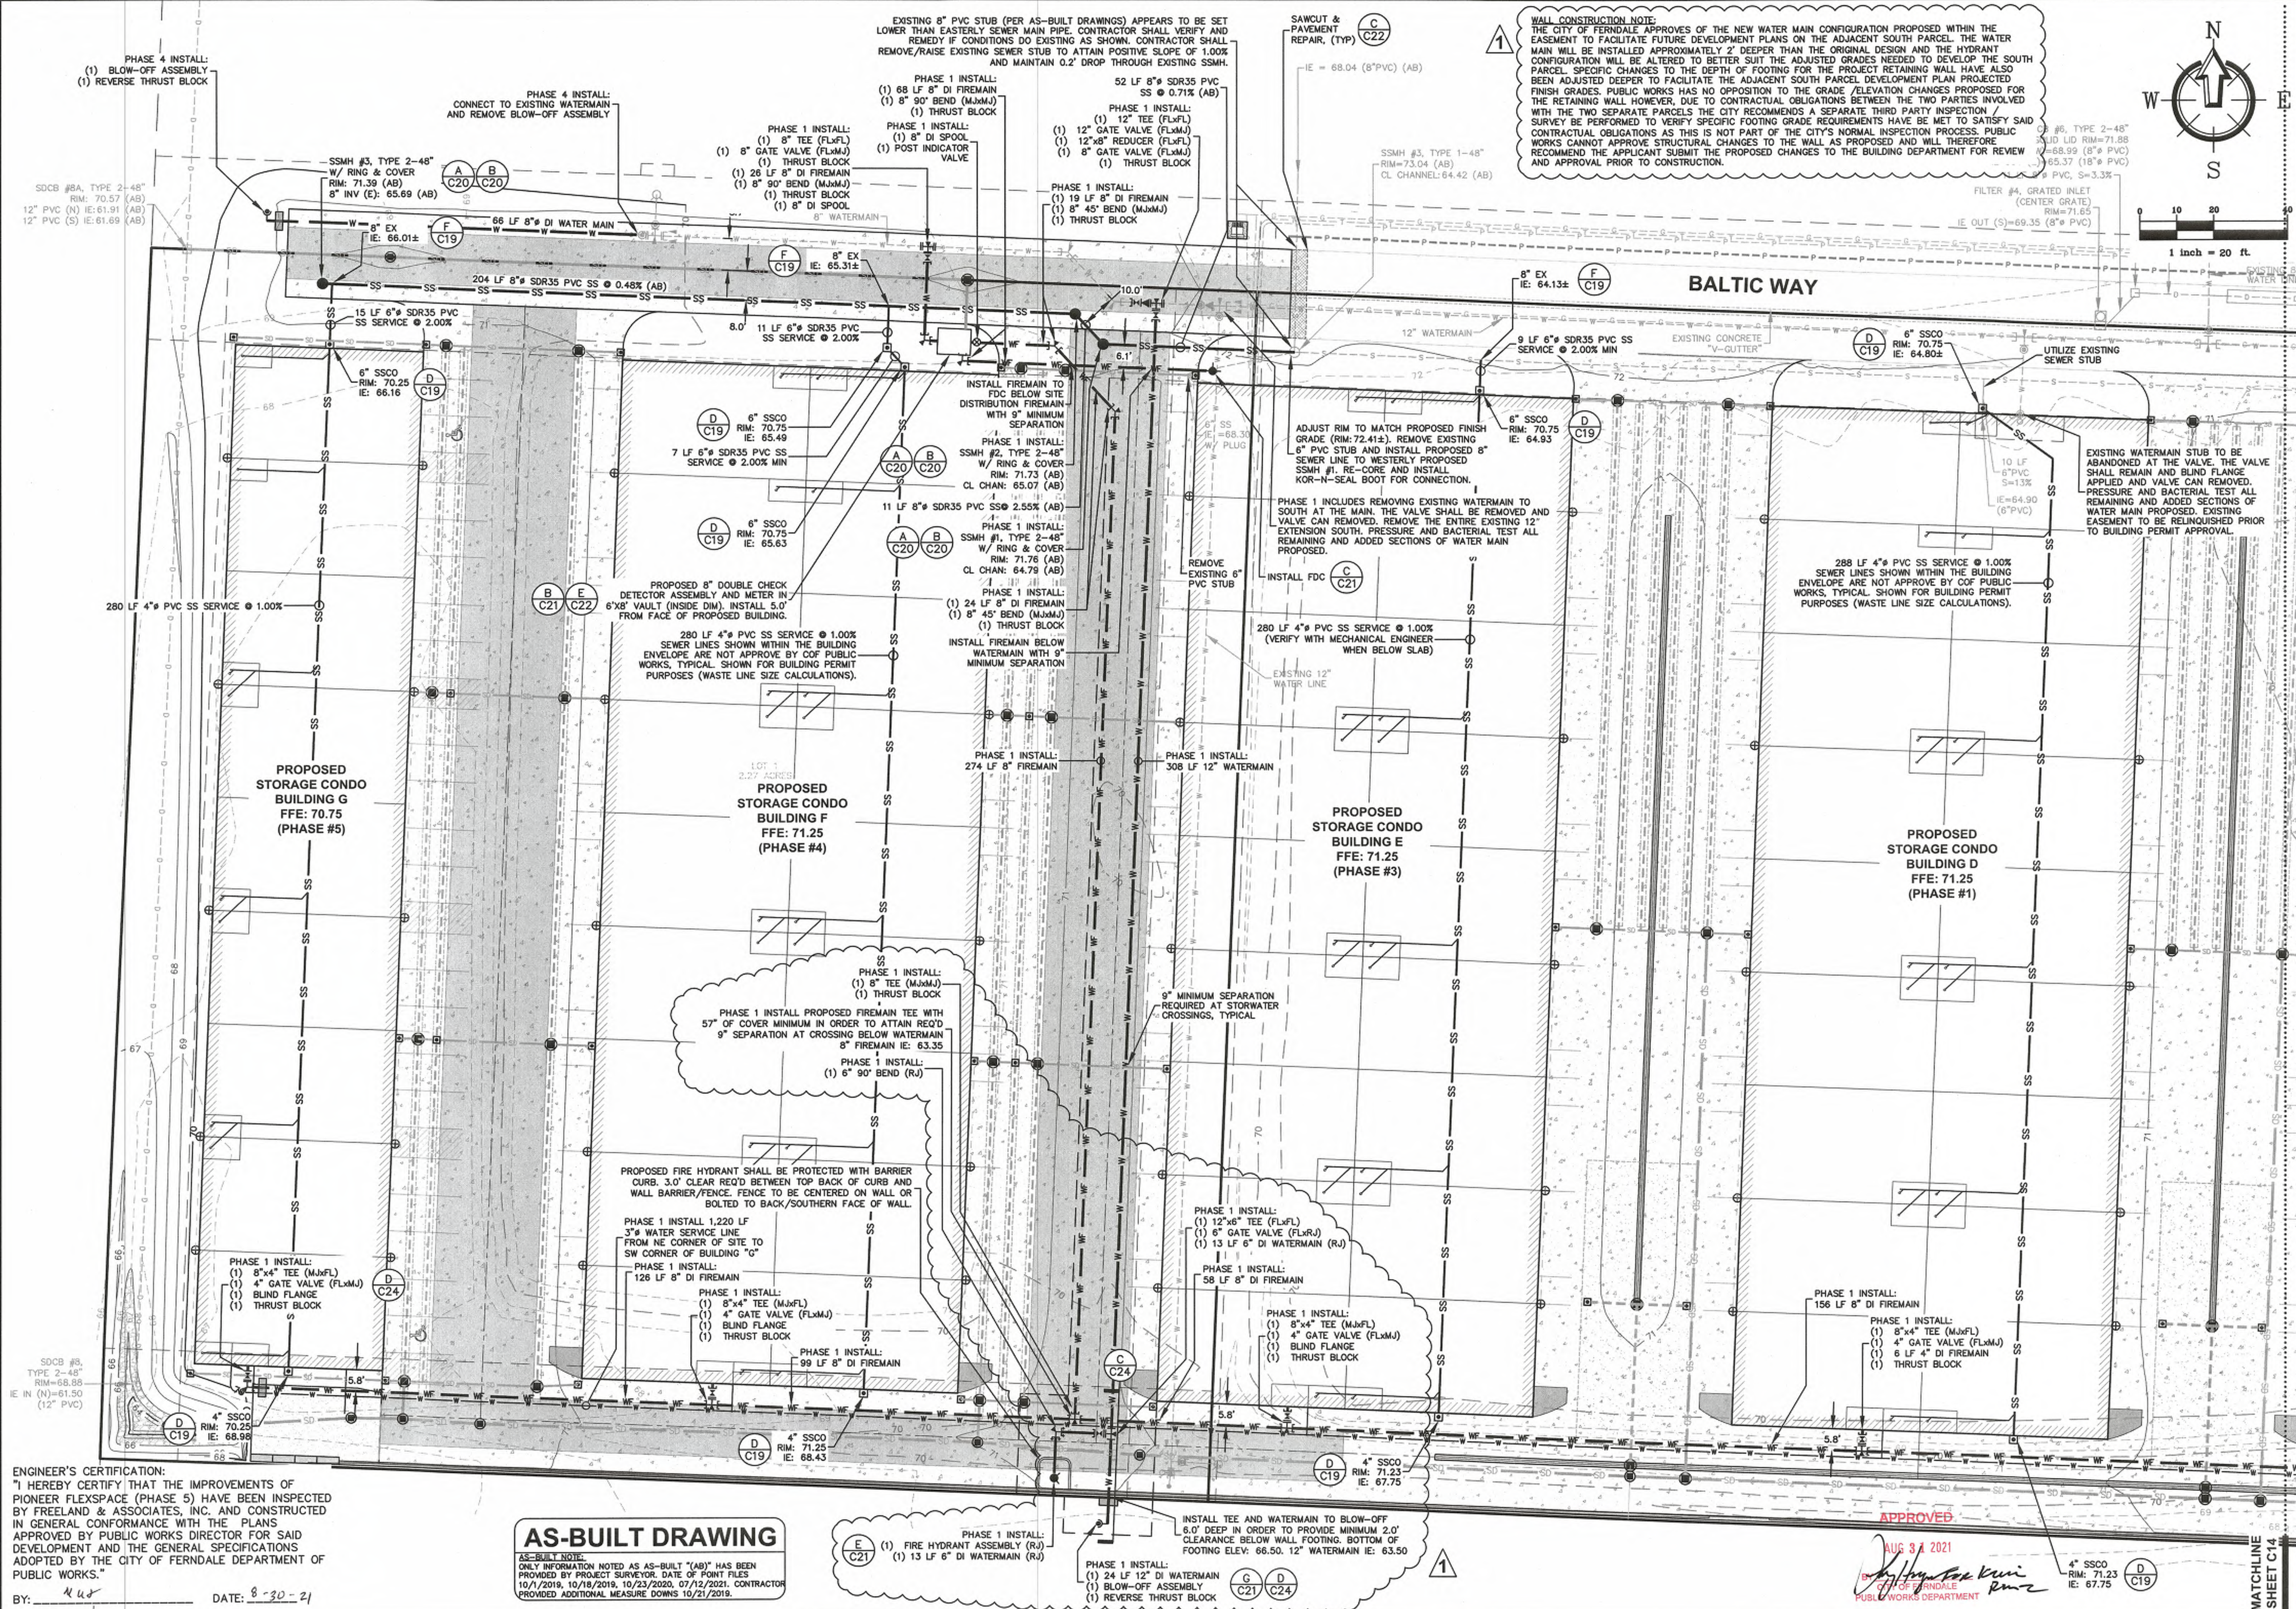

ENGINEER'S CERTIFICATION:
"I HEREBY CERTIFY THAT THE IMPROVEMENTS OF
PIONEER FLEXSPACE (PHASE 5) HAVE BEEN INSPECTED
BY FREELAND & ASSOCIATES, INC. AND CONSTRUCTED
IN GENERAL CONFORMANCE WITH THE PLANS
APPROVED BY PUBLIC WORKS DIRECTOR FOR SAID
DEVELOPMENT AND THE GENERAL SPECIFICATIONS
ADOPTED BY THE CITY OF FERNDALE DEPARTMENT OF
PUBLIC WORKS."

BY: *[Signature]* DATE: 8-30-21

AS-BUILT DRAWING

ONLY INFORMATION NOTED AS AS-BUILT (AB) HAS BEEN
PROVIDED BY PROJECT SURVEYOR. DATE OF POINT FILES
10/1/2019, 10/18/2019, 10/23/2020, 07/12/2021. CONTRACTOR
PROVIDED ADDITIONAL MEASURE DOWNS 10/21/2021.

PHASE 1 INSTALL:
(1) FIRE HYDRANT ASSEMBLY (RJ)
(1) 13 LF 6" DI WATERMAIN (RJ)

PHASE 1 INSTALL:
(1) 24 LF 12" DI WATERMAIN
(1) BLOW-OFF ASSEMBLY
(1) REVERSE THRUST BLOCK

PHASE 1 INSTALL:
(1) 12"x8" TEE (FLxFL)
(1) 4" GATE VALVE (FLxRJ)
(1) 13 LF 6" DI WATERMAIN (RJ)

PHASE 1 INSTALL:
(1) 8"x4" TEE (MxFL)
(1) 4" GATE VALVE (FLxM)
(1) BLIND FLANGE
(1) THRUST BLOCK

PHASE 1 INSTALL:
(1) 8"x4" TEE (MxFL)
(1) 4" GATE VALVE (FLxM)
(1) BLIND FLANGE
(1) THRUST BLOCK

PHASE 1 INSTALL:
(1) 8"x4" TEE (MxFL)
(1) 4" GATE VALVE (FLxM)
(1) BLIND FLANGE
(1) THRUST BLOCK

PHASE 1 INSTALL:
(1) 8"x4" TEE (MxFL)
(1) 4" GATE VALVE (FLxM)
(1) BLIND FLANGE
(1) THRUST BLOCK



220 West Champion Street, Suite 200
Bellingham, WA 98225
T: 360.850.1408
F: 360.850.1401

REV.	DATE	DESCRIPTION
1	1/30/2019	CROSS SECTION REVISION PER OWNER REQUEST

CLIENT:
PIONEER POST FRAME
6208 PORTAL WAY
FERNDALE, WASHINGTON
CALL BEFORE YOU DIG
FOR BURIED UTILITY LOCATIONS
1-800-424-5555

PROJECT LOCATION:
PIONEER FLEXSPACE, LLC
6407 PORTAL WAY
FERNDALE, WASHINGTON
DRAWN BY: C.A.
CHECKED BY: HAF
DESIGNED BY: HAF

SHEET CONTENTS:
UTILITY PLAN (WEST)



JOB #: 18084
DATE: 8-30-2021
SCALE: HORIZ: 1"=20'
VERT: N/A
SHEET: **C13**

-
- Technical drawing showing a cross-section of a pole building foundation. The drawing includes dimensions for the building width (54.0'), pile spacing (27.0'), and various structural details. Key features include:
- Building "G" FFE: 70.75** on the left and **Building "F" FFE: 71.25** on the right.
 - Proposed Concrete (Impermeable)** sections labeled **A C17** and **B C17**.
 - Proposed Concrete (Permeable)** section labeled **B C17**.
 - Proposed Roof Runoff Infiltration Trench (TYP)** labeled **G C17**.
 - Finish Grade Elev: 70.35**.
 - Existing Ground Water Elevation** per soils report = Elev. 66.20± (0.8' below ex grade).
 - Dimensions:** 5.0', 13.0', 6.0" MIN, 14.0', 14.0', 5.0', 2.0', 4.3', 11.2', 2.8', 6.0', 4.2', 5.2'.
 - Notes:**
 - POLE BUILDING ON CONCRETE PILE PER ARCHITECTURAL PLANS. PILE ARE TO BE INSTALLED TO A MINIMUM DEPTH OF 5.0'. BOTTOM OF PILE ELEVATION SHALL BE BELOW THE BOTTOM ELEVATION OF WASHED ROCK FOR BOTH THE ROOF RUNOFF INFILTRATION TRENCH(S) AND VEHICULAR TREATMENT TRENCH/GALLERY.
 - INSTALL PROPOSED 6" PERFORATED PIPE W/ 1.9' COVER FOR THIS SECTION IN ORDER TO MAINTAIN REQUIRED 1.0' SEPARATION BETWEEN THE BOTTOM ELEVATION ROCK AND GROUND WATER.
 - POLE BUILDING TO BE SET ON 24"Ø CONCRETE PILE PER ARCHITECTURAL PLANS. TYPICAL CONCRETE PILE INSTALLATION IS GREATER THAN OR EQUAL TO 5.0' PER ARCHITECT/CONTRACTOR DESIGN.

INSPECTION NOTE:

1. UNDERGROUND INFILTRATION AREAS AS DESIGNED THROUGH OUT THE PROJECT WILL REQUIRE SPECIAL INSPECTION REQUIREMENTS. THE CITY WILL INSPECT STRUCTURES AND CONVEYANCE ONLY FOR CITY DOCUMENTATION. ALL THINGS RELATED TO SPECIFIC SOILS, GRAVELS AND PLACEMENT OF SAID MATERIALS WILL BE DONE BY THE ENGINEER OF RECORD OR A LICENSED GEOTECHNICAL ENGINEER. CERTIFICATION FOR ALL INFILTRATION FACILITIES FOR THE PROJECT WILL BE CERTIFIED BY THE ENGINEER OF RECORD PRIOR TO FINAL PROJECT ACCEPTANCE BY THE CITY.

[illegible]

PIONEER POST FRAME
6208 PORTAL WAY
FERNDALE, WASHINGTON

CALL BEFORE YOU DIG
FOR BURIED UTILITY LOCATIONS
1-800-424-5555

PIONEER FLEXSPACE, LLC

6407 PORTAL WAY,
FERNDALE, WASHINGTON


DRAWING #:	18064SP26 (PHS).DWG	DRAWN BY:	CUL
DESIGNED BY:	HAF	CHECKED BY:	HAF

SITE SECTIONS (BUILDING TO BUILDING)




JOB #: 18084	DATE: 8-30-2021
SCALE: HORIZ: 1"=4' VERT: N/A	SHEET: C15

- NOTES**
1. THE DESIGN INTENT REPRESENTED IN THIS SECTION IS TO HORIZONTALLY SEPARATE THE ROCK RUNOFF WATER FROM THE VEHICULAR PAVEMENT RUNOFF. THE PAVEMENT HAS BEEN MOVED TO WEST SIDE OF THE DRIVE ISLE IN ORDER TO PROVIDE SEPARATION FROM THE WATERMAIN.
 2. TOP OF WASHED ROCK FOR ROCK RUNOFF INFILTRATION TRENCHES SHALL BE INSTALLED A MINIMUM OF 1'-0" ABOVE PERFORATED PIPE INVERT ELEVATION, TYPICAL.
 3. SEE DRAINAGE PLAN SHEETS C8 & C9 FOR SPECIFIED OVERTFLOW ELEVATION
 4. THE OVERTFLOW CATCH BASIN DETAIL SPECIFIED THE TOP OF WASHED ROCK TO BE SET 0.2' ABOVE THE OVERTFLOW ELEVATION SPECIFIED AT EACH OVERTFLOW CATCH BASIN..
 5. THE GROUND WATER DEPTH IDENTIFIED IN THIS SECTION IS BASED ON GEOTECHNICAL REPORT (SOIL INFILTRATION EVALUATION) PROVIDED BY SOUND GEOLOGY, DATED APRIL 13TH, 2018.

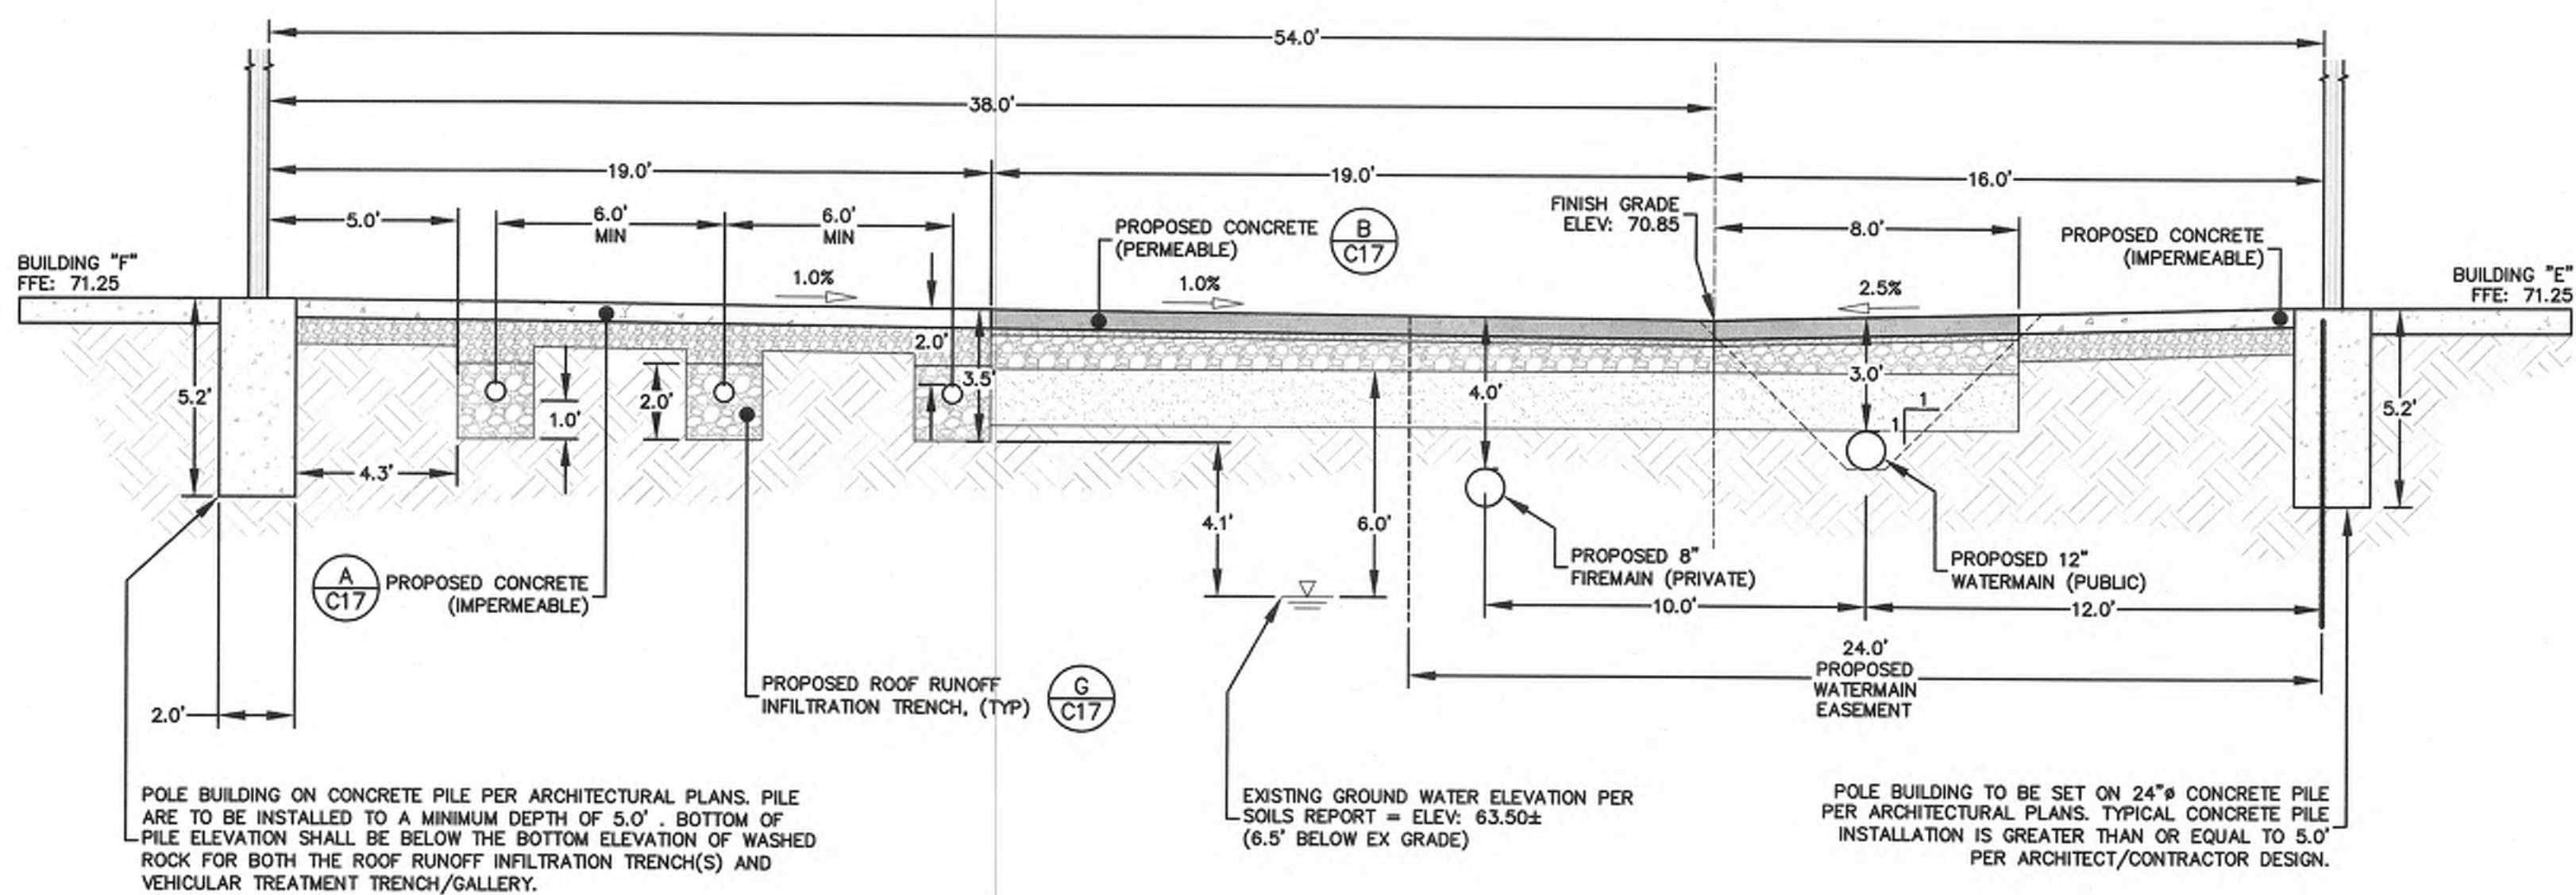


(B) PAVEMENT SECTION BUILDING "F" TO BUILDING "E"
SCALE 1" = 4'

1. THIS SECTION IS TYPICAL FOR NORTHERN END OF MOST DRY ISLES OTHER THAN THE TWO WITH WATERMANS AND WHERE PERMEABLE PAVEMENT IS PROPOSED. SEE SHEET CG DETAIL "B" FOR WATERMAN AND ROOF INFILTRATION TRENCH SEPARATION AS WELL AS WATERMAN OFFSET FROM BUILDING PILING.
2. TOP OF WASHED ROCK FOR ROOF RUNOFF INFILTRATION TRENCHES SHALL BE INSTALLED A MINIMUM OF 1'0" ABOVE PERFORATED PIPE INVERT ELEVATION, TYPICAL.
3. SEE DRAINAGE PLAN SHEETS C8 & C9 FOR SPECIFIED OVERFLOW ELEVATION.
4. THE OVERFLOW CATCH BASIN DETAIL SPECIFIES THE TOP OF WASHED ROCK TO BE SET 0.2' ABOVE THE OVERFLOW ELEVATION SPECIFIED AT EACH OVERFLOW CATCH BASIN.
5. TWO SIMILAR PAVEMENT/SITE SECTIONS ARE LOCATED BETWEEN BUILDING "A" AND "B" AS WELL AS BUILDING "C" AND "D". GROUND WATER DEPTH FROM EXISTING GRADE IS 8.4' DEEP AND 8.0' DEEP RESPECTIVELY. SEE GROUND WATER TO FINISH GRADE INFORMATION FOR THE FOREMENTIONED SITE SECTIONS TO THE RIGHT OF THIS PARTICULAR SITE SECTION.
6. THE PAVEMENT SECTION/SITE SECTION BETWEEN BUILDING "A" AND "B" REQUIRE ADDITIONAL OVERFLOW ROCK DUE TO PROPOSED HEIGHT OF THE 12" OVERFLOW PIPE. TOP OF WASHED ROCK IN THE ROOF RUNOFF INFILTRATION TRENCH(S) SHALL BE RAISED TO ATTAIN POSITIVE DRAINAGE/SLOPE.
7. THE GROUND WATER DEPTH FOR THE REMAINING DRY ISLES TO THE EAST PROGRESSIVELY GETS DEEPER. SEE GEOTECHNICAL REPORT (SOIL INFILTRATION EVALUATION) PROVIDED BY SOIL GEOLOGY, DATED APRIL 13TH, 2018.

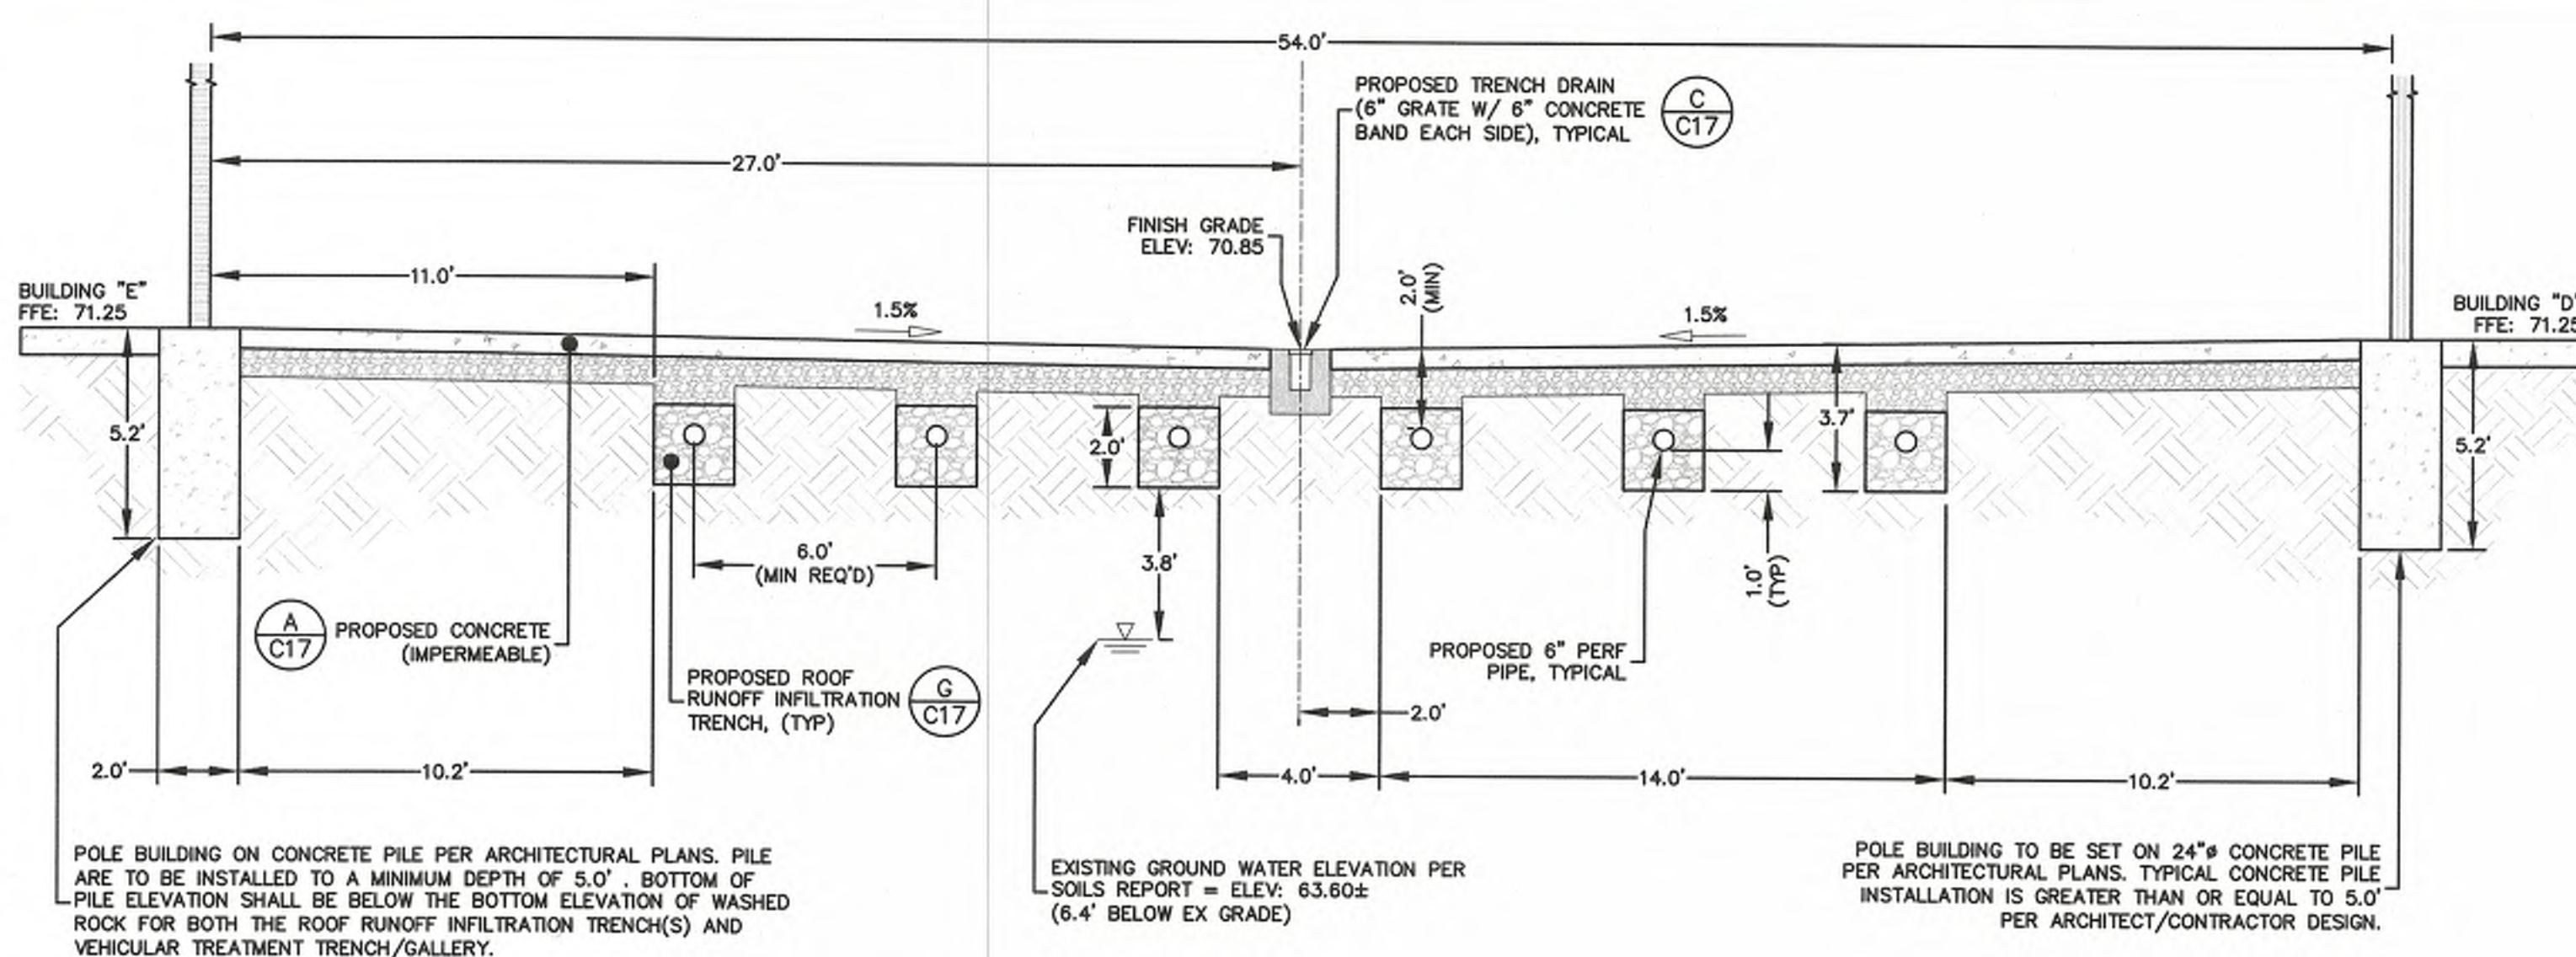

(C) PAVEMENT SECTION BUILDING "E" TO BUILDING "D"
SCALE 1" = 4'

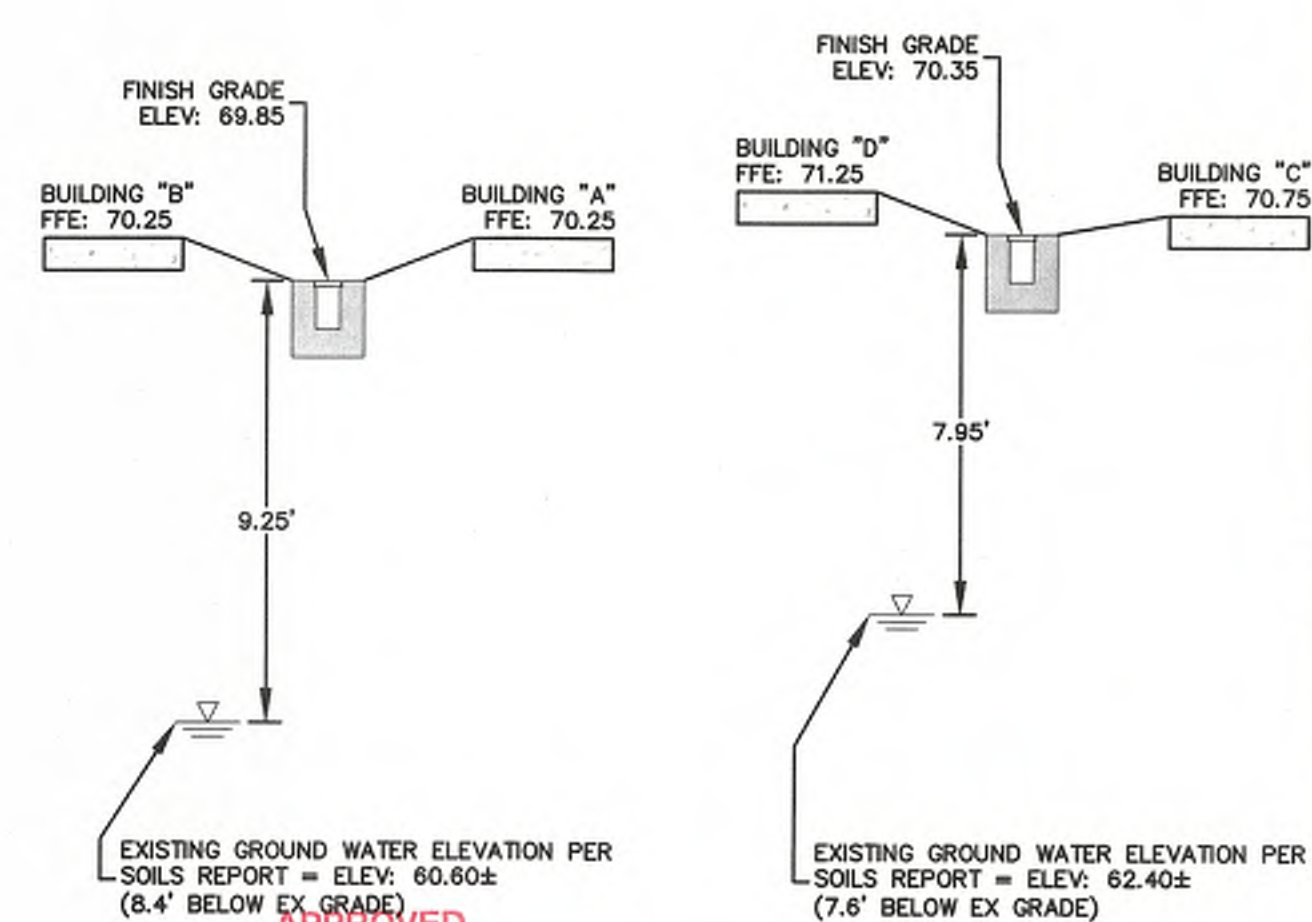


AUG 31 2021
BY 
CITY OF FERNDALE
PUBLIC WORKS DEPARTMENT


AS-BUILT DRAWING

AS-BUILT NOTE:
 ONLY INFORMATION NOTED AS AS-BUILT "(AB)" HAS BEEN
 PROVIDED BY PROJECT SURVEYOR. DATE OF POINT FILES
 10/1/2019, 10/18/2019, 10/23/2020, 07/12/2021. CONTRACT


- NOTES:**
- THIS SECTION IS TYPICAL FOR SOUTHERN END OF TWO OTHER DRIVE ISLES. SEE SHEET C15 FOR PERMEABLE PAVEMENT/SITE SECTIONS. SEE SHEET C16, DETAIL "C" FOR SITE SECTION WITH WATERMAIN WHICH INCLUDES VEHICULAR PAVEMENT INFILTRATION TRENCH SEPARATION AS WELL AS WATERMAIN OFFSET FROM BUILDING PILING.
 - SEE DRAINAGE PLAN SHEETS C8 & C9 FOR SPECIFIED OVERFLOW ELEVATION.
 - THE OVERFLOW CATCH BASIN DETAIL SPECIFIES THE TOP OF WASHED ROCK TO BE SET 0.2' ABOVE THE OVERFLOW ELEVATION SPECIFIED AT EACH OVERFLOW CATCH BASIN.
 - TWO SIMILAR PAVEMENT/SITE SECTIONS ARE LOCATED BETWEEN BUILDING "A" AND "B" AS WELL AS BUILDING "C" AND "D". GROUND WATER DEPTH FROM EXISTING GRADE IS 10.0' DEEP AND 9.5' DEEP RESPECTIVELY. SEE GROUND WATER TO FINISH GRADE INFORMATION FOR THE AFOREMENTIONED SITE SECTIONS TO THE RIGHT OF THIS PARTICULAR SITE SECTION.
 - THE PAVEMENT SECTION/SITE SECTION BETWEEN BUILDING "A" AND "B" WILL REQUIRE ADDITIONAL WASHED ROCK DUE TO PROPOSED HEIGHT OF THE 12" OVERFLOW PIPE. THE TOP OF THE WASHED ROCK IN THE PAVEMENT INFILTRATION TRENCH/GALLERY SHALL BE RAISED TO ATTAIN POSITIVE DRAINAGE/SLOPE.
 - WASHED ROCK CAN REPLACE A PORTION OF THE 8" GRAVEL BASE SHOWN FOR TYPICAL CONCRETE PAVEMENT (IMPERMEABLE CONCRETE) IF NECESSARY TO ACHIEVE OVERFLOW ELEVATION. THE CRUSHED ROCK ROCK SECTION BELOW CONCRETE CAN BE REDUCED BUT SHALL HAVE MINIMUM 2" GRAVEL/ CHOKER COURSE.
 - THE GROUND WATER DEPTH FOR THE REMAINING DRIVE ISLES TO THE EAST PROGRESSIVELY GETS DEEPER. SEE GEOTECHNICAL REPORT (SOIL INFILTRATION EVALUATION) PROVIDED BY SOUND GEOLOGY, DATED APRIL 13TH, 2018.

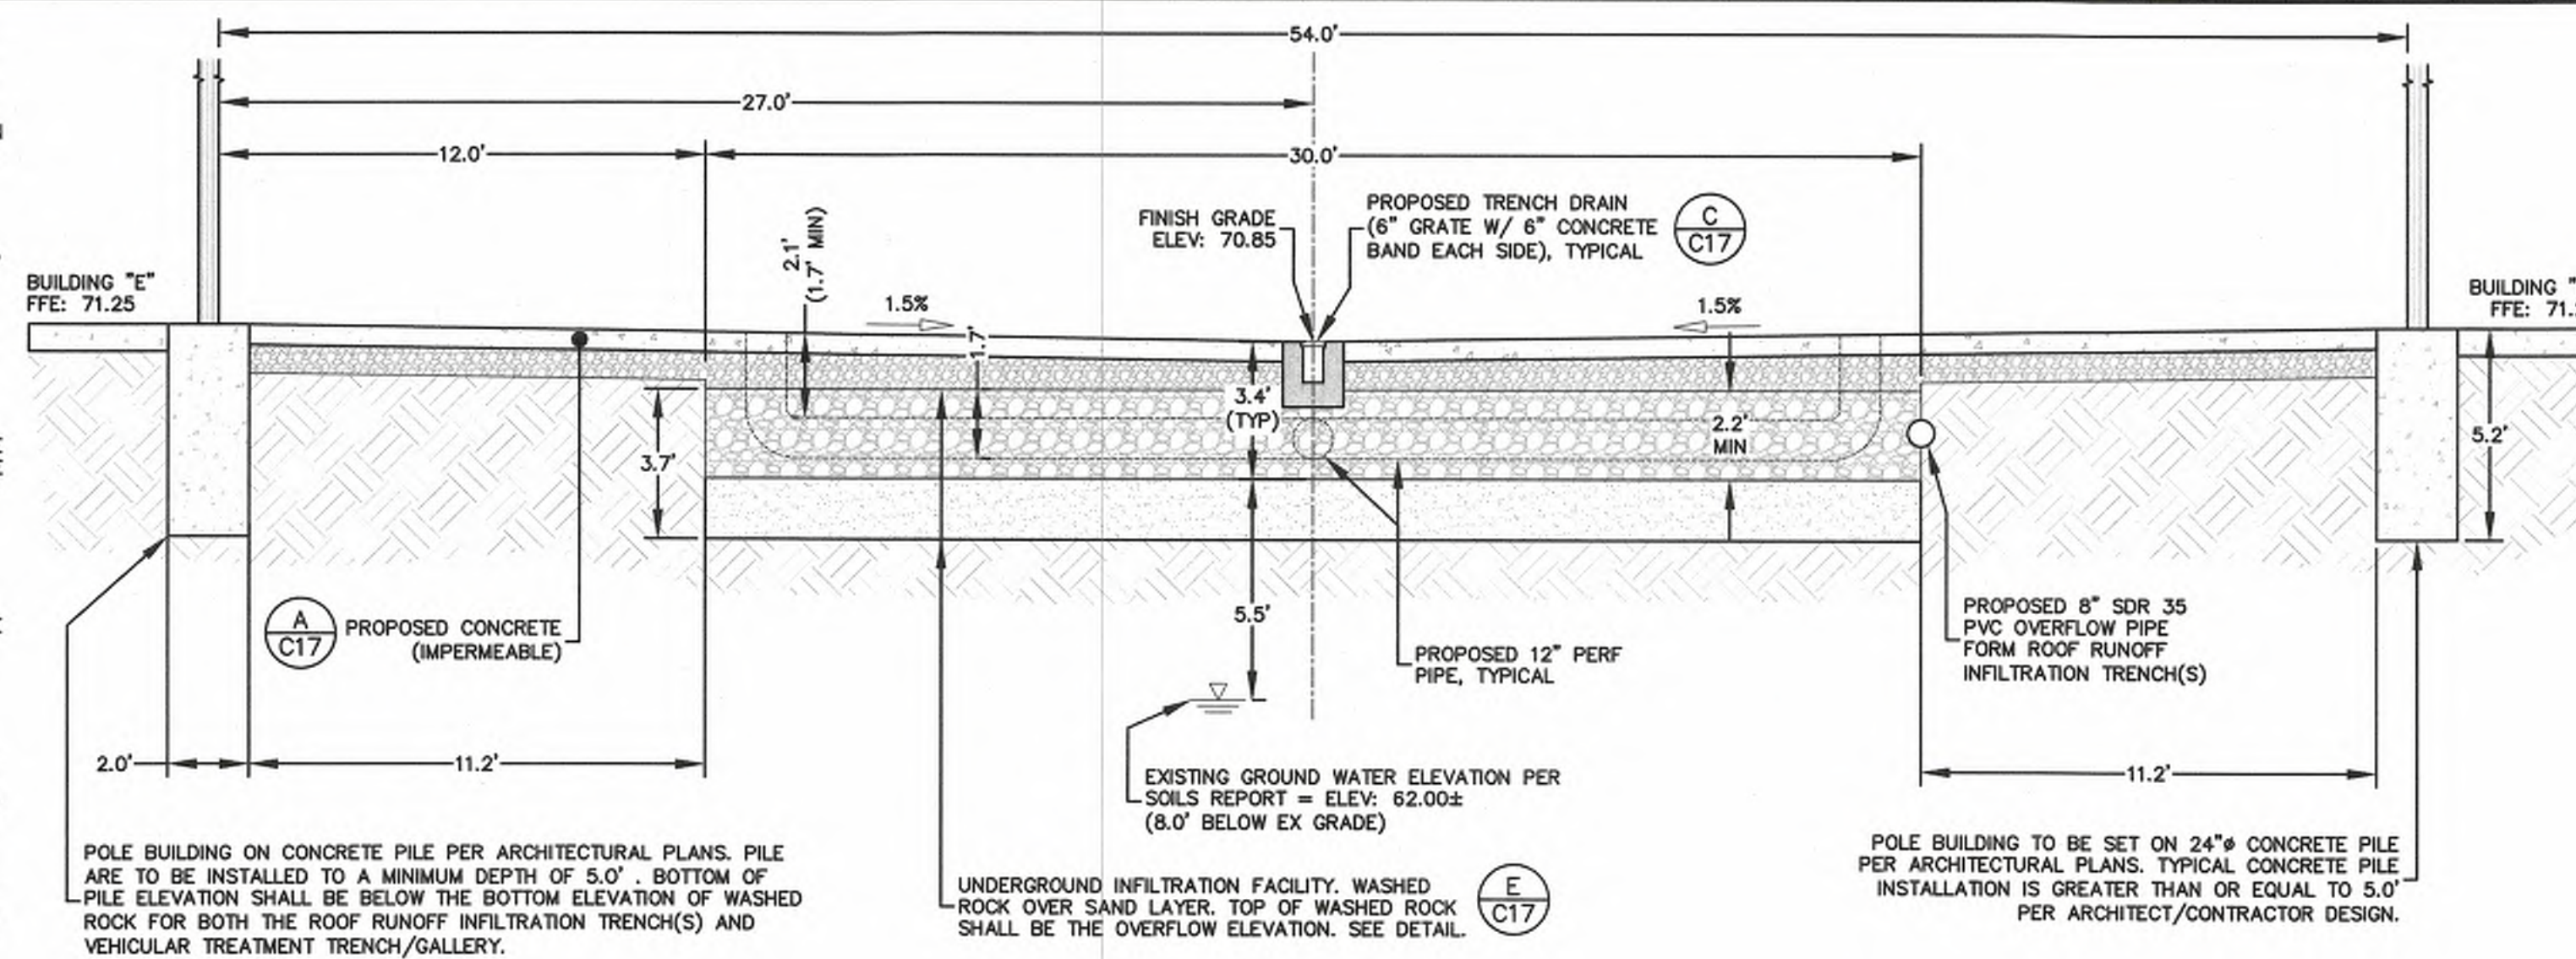


A PAVEMENT SECTION BUILDING "E" TO BUILDING "D"
SCALE 1" = 4'

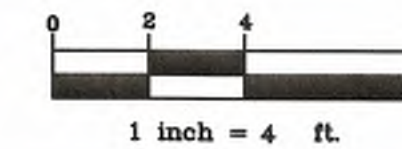


- NOTES:**
- THIS SECTION IS ATYPICAL DUE TO THE PROPOSED WATERMAIN TO BE INSTALLED ALONG THE EASTERN SIDE OF THE DRIVE ISLE. THE INTENT OF THIS SECTION IS TO SHOW ROOF RUNOFF INFILTRATION TRENCH SEPARATION AS WELL AS WATERMAIN OFFSET FROM BUILDING PILING.
 - TOP OF WASHED ROCK FOR ROOF RUNOFF INFILTRATION TRENCHES SHALL BE INSTALLED A MINIMUM OF 1.0' ABOVE PERFORATED PIPE INVERT ELEVATION, TYPICAL.
 - SEE DRAINAGE PLAN SHEETS C8 & C9 FOR SPECIFIED OVERFLOW ELEVATION.
 - THE OVERFLOW CATCH BASIN DETAIL SPECIFIES THE TOP OF WASHED ROCK TO BE SET 0.2' ABOVE THE OVERFLOW ELEVATION SPECIFIED AT EACH OVERFLOW CATCH BASIN. THE WASHED ROCK FOR THE ROOF RUNOFF INFILTRATION TRENCH HAS BEEN RAISED TO ATTAIN POSITIVE DRAINAGE/SLOPE DUE TO THE FACT THAT THE CONNECTION POINT TO THE MAIN OVERFLOW PIPE HAS HIGHER INVERT ELEVATION THAN THE ROOF RUNOFF TRENCH PIPE(S).
 - WASHED ROCK CAN REPLACE A PORTION OF THE 8" GRAVEL BASE SHOWN FOR TYPICAL CONCRETE PAVEMENT (IMPERMEABLE CONCRETE) IF NECESSARY TO ACHIEVE OVERFLOW ELEVATION. THE CRUSHED ROCK ROCK SECTION BELOW CONCRETE CAN BE REDUCED BUT SHALL HAVE MINIMUM 2" GRAVEL/ CHOKER COURSE.
 - THE GROUND WATER DEPTH FOR THE REMAINING DRIVE ISLES TO THE EAST PROGRESSIVELY GETS DEEPER. SEE GEOTECHNICAL REPORT (SOIL INFILTRATION EVALUATION) PROVIDED BY SOUND GEOLOGY, DATED APRIL 13TH, 2018.

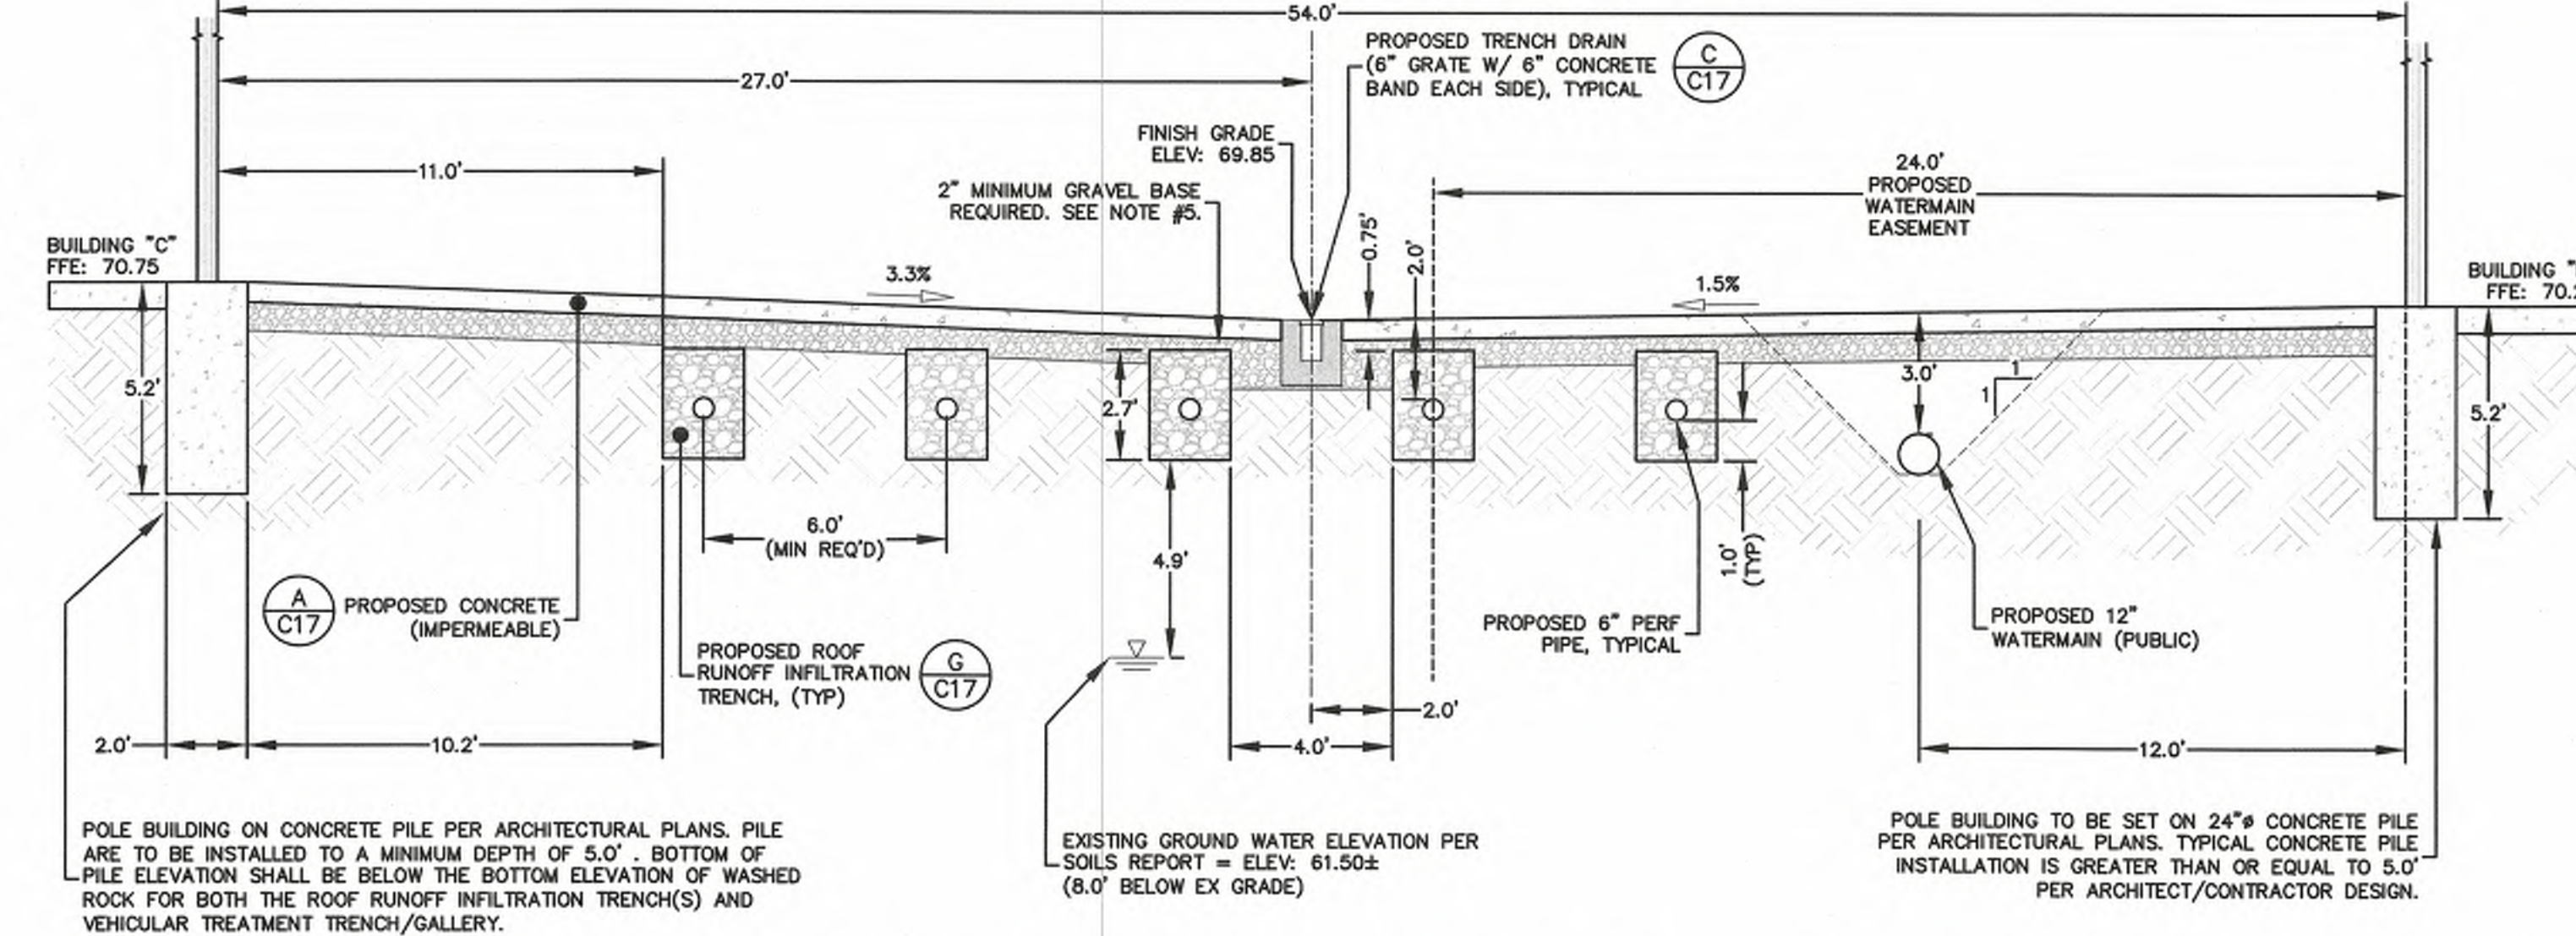



B PAVEMENT SECTION BUILDING "C" TO BUILDING "B"
SCALE 1" = 4'

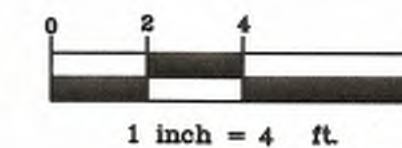

- NOTES:**
- THIS SECTION IS ATYPICAL DUE TO THE PROPOSED WATERMAIN TO BE INSTALLED ALONG THE EASTERN SIDE OF THE DRIVE ISLE. THE INTENT OF THIS SECTION IS TO SHOW PAVEMENT RUNOFF INFILTRATION TRENCH SEPARATION AS WELL AS WATERMAIN OFFSET FROM BUILDING PILING.
 - SEE DRAINAGE PLAN SHEETS C8 & C9 FOR SPECIFIED OVERFLOW ELEVATION.
 - THE OVERFLOW CATCH BASIN DETAIL SPECIFIES THE TOP OF WASHED ROCK TO BE SET 0.2' ABOVE THE OVERFLOW ELEVATION SPECIFIED AT EACH OVERFLOW CATCH BASIN. THE WASHED ROCK FOR THE PAVEMENT RUNOFF INFILTRATION TRENCH/GALLERY HAS BEEN RAISED TO ATTAIN POSITIVE DRAINAGE/SLOPE DUE TO THE FACT THAT THE CONNECTION POINT TO THE MAIN OVERFLOW PIPE HAS HIGHER INVERT ELEVATION AT THIS LOCATION.
 - WASHED ROCK CAN REPLACE A PORTION OF THE 8" GRAVEL BASE SHOWN FOR TYPICAL CONCRETE PAVEMENT (IMPERMEABLE CONCRETE) IF NECESSARY TO ACHIEVE OVERFLOW ELEVATION. THE CRUSHED ROCK ROCK SECTION BELOW CONCRETE CAN BE REDUCED BUT SHALL HAVE MINIMUM 2" GRAVEL/ CHOKER COURSE.
 - THE GROUND WATER DEPTH FOR THE REMAINING DRIVE ISLES TO THE EAST PROGRESSIVELY GETS DEEPER. SEE GEOTECHNICAL REPORT (SOIL INFILTRATION EVALUATION) PROVIDED BY SOUND GEOLOGY, DATED APRIL 13TH, 2018.

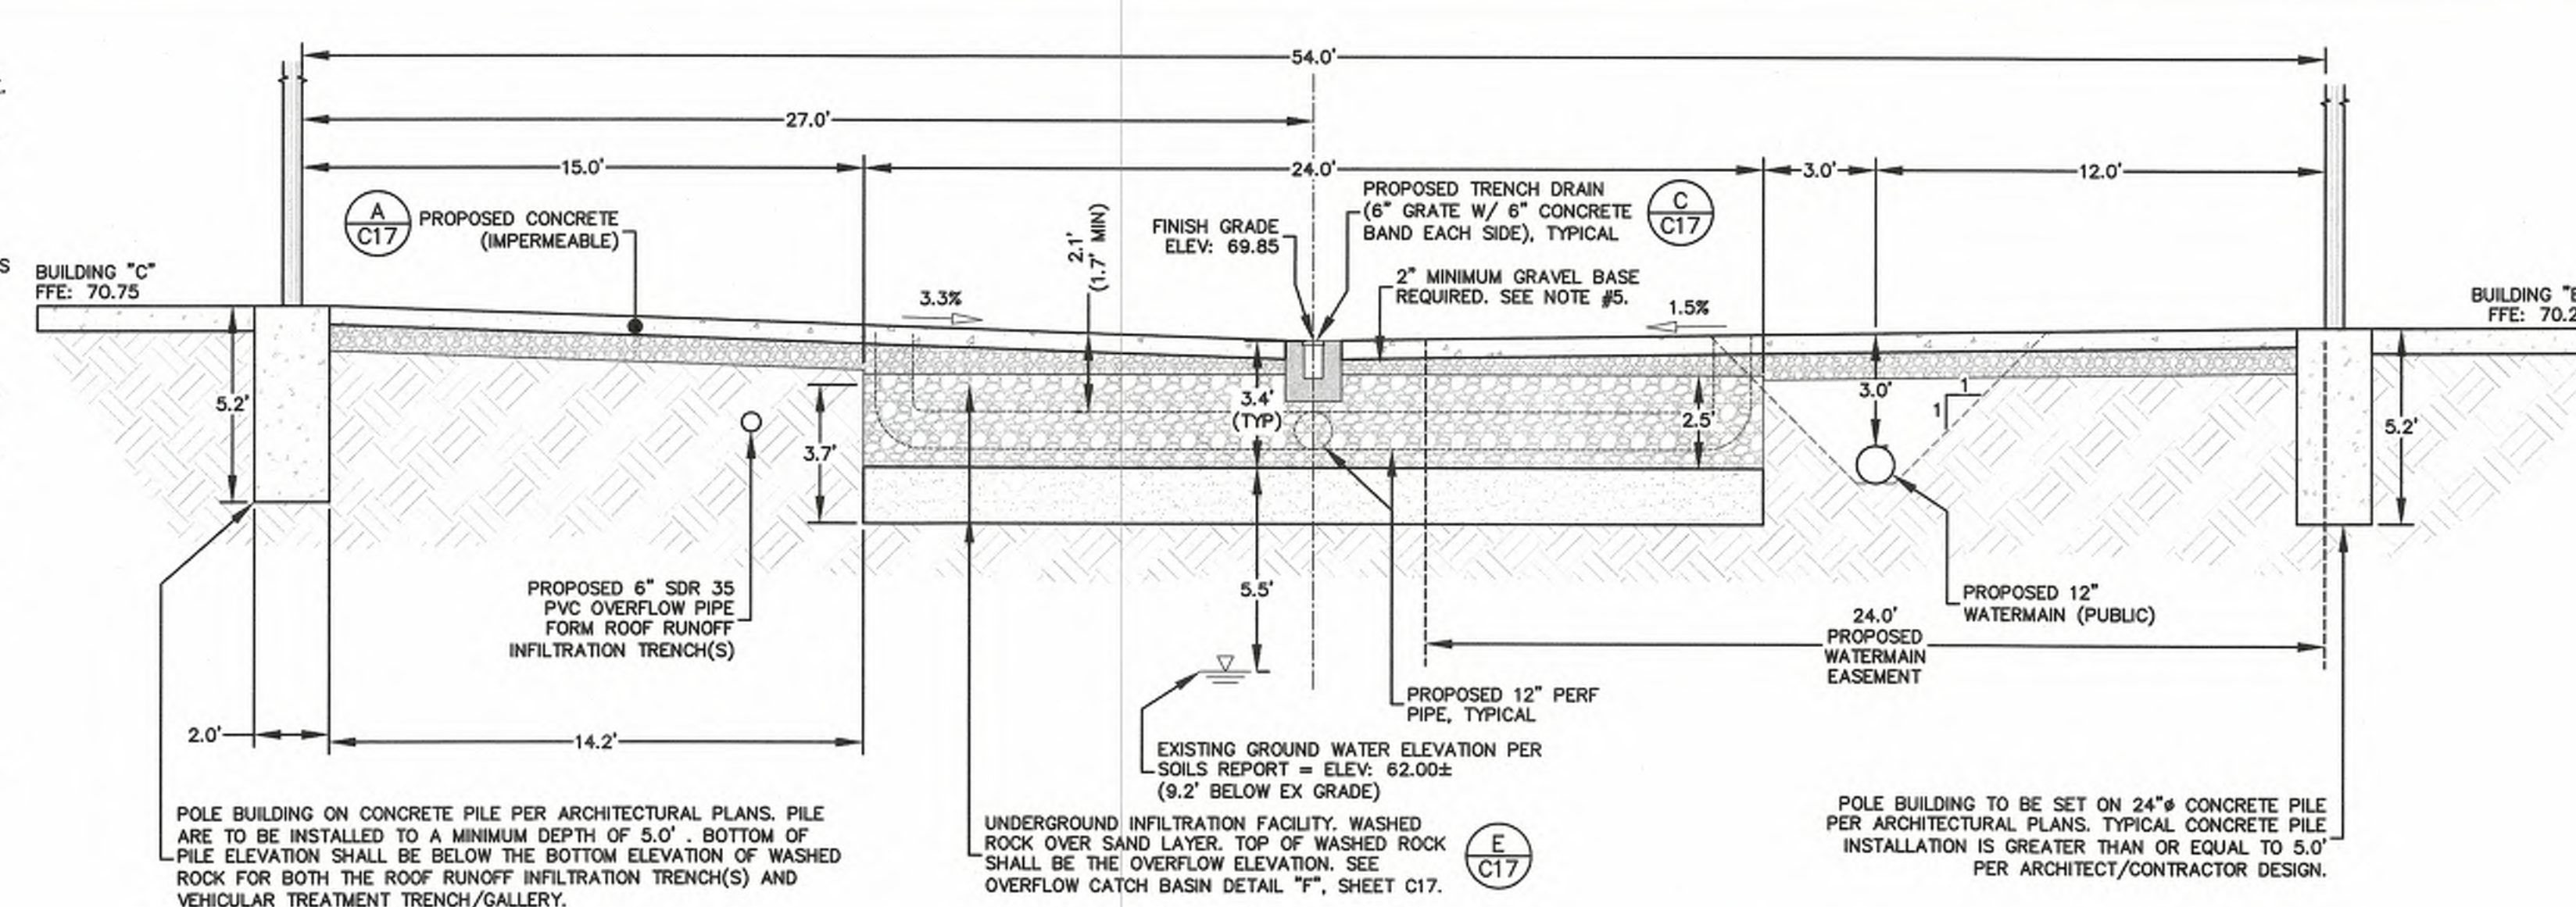

C PAVEMENT SECTION BUILDING "C" TO BUILDING "B"
SCALE 1" = 4'

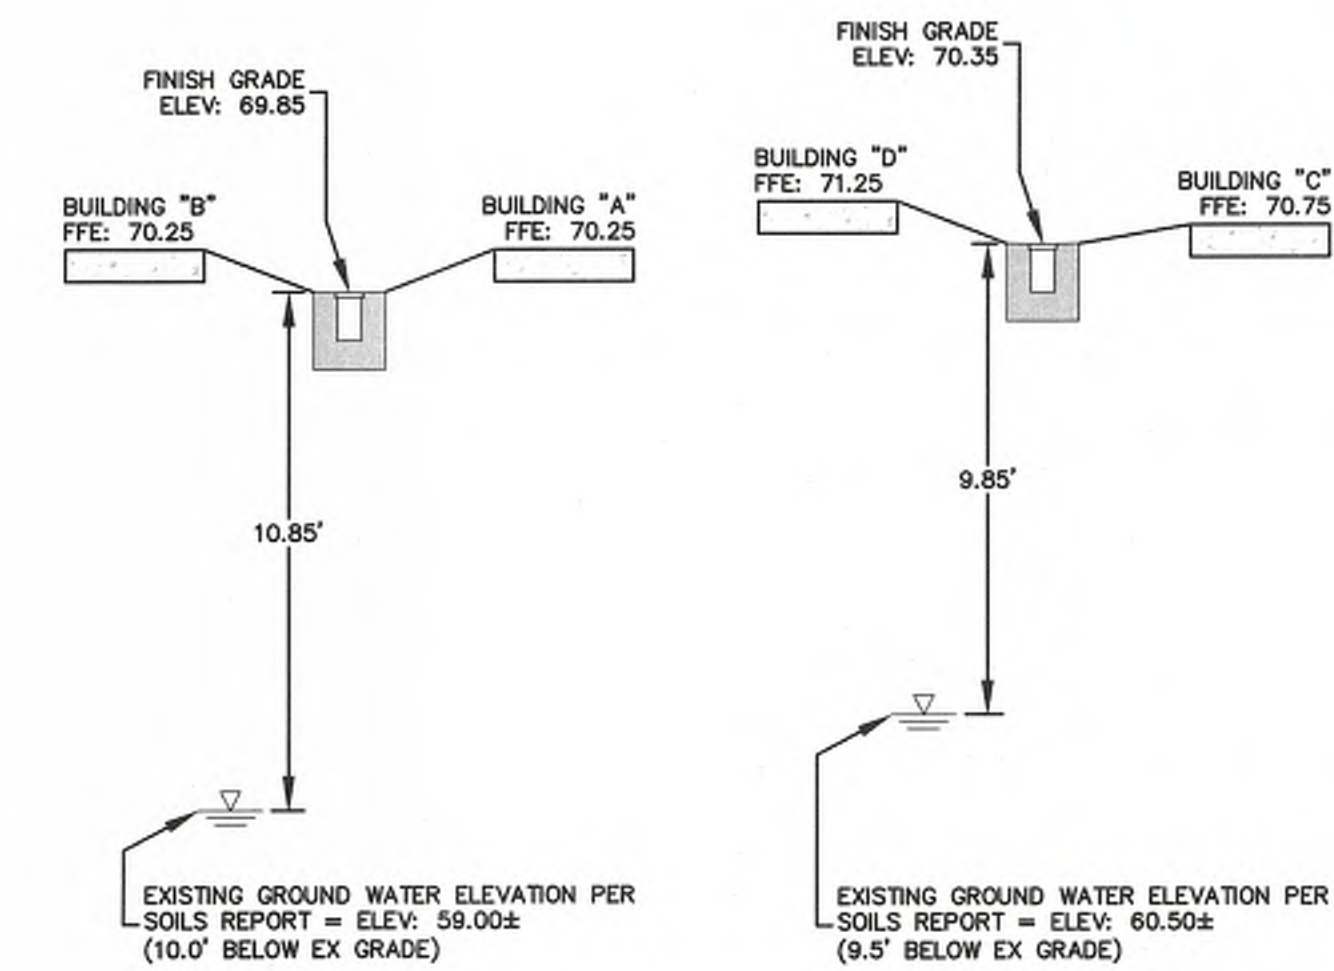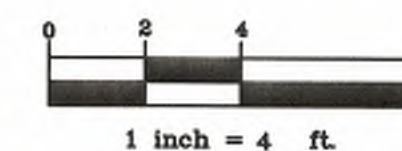

- INSPECTION NOTE:**
- UNDERGROUND INFILTRATION AREAS AS DESIGNED THROUGH OUT THE PROJECT WILL REQUIRE SPECIAL INSPECTION REQUIREMENTS. THE CITY WILL INSPECT STRUCTURES AND CONVEYANCE ONLY FOR CITY DOCUMENTATION. ALL THINGS RELATED TO SPECIFIC SOILS, GRAVELS AND PLACEMENT OF SAID MATERIALS WILL BE DONE BY THE ENGINEER OF RECORD OR A LICENSED GEOTECHNICAL ENGINEER. CERTIFICATION FOR ALL INFILTRATION FACILITIES FOR THE PROJECT WILL BE CERTIFIED BY THE ENGINEER OF RECORD PRIOR TO FINAL PROJECT ACCEPTANCE BY THE CITY.



REV.	DATE	DESCRIPTION

CLIENT:
PIONEER POST FRAME
6208 PORTAL WAY
FERNDALE, WASHINGTON
CALL BEFORE YOU DIG
FOR BURIED UTILITY LOCATIONS
1-800-424-5555

PROJECT LOCATION:
PIONEER FLEXSPACE, LLC
6407 PORTAL WAY
FERNDALE, WASHINGTON
DRAWING #: 1808-SP25 (PH5).DWG
DESIGNED BY: HAF
CHECKED BY: HAF
DRAWN BY: C.L.









SHEET CONTENTS:
SITE SECTIONS
(BUILDING TO BUILDING)



APPROVED
AUG 1 2021
PUBLIC WORKS DEPARTMENT

AS-BUILT DRAWING
ONLY INFORMATION NOTED AS AS-BUILT ("AB") HAS BEEN PROVIDED BY PROJECT SURVEYOR. DATE OF POINT FILES 10/1/2019, 10/18/2019, 10/23/2020, 07/12/2021. CONTRACTOR PROVIDED ADDITIONAL MEASURE DOWNS 10/21/2019.

JOB #: 18084
DATE: 8-30-2021
SCALE: HORIZ: 1"=4'
VERT: N/A
SHEET: C16

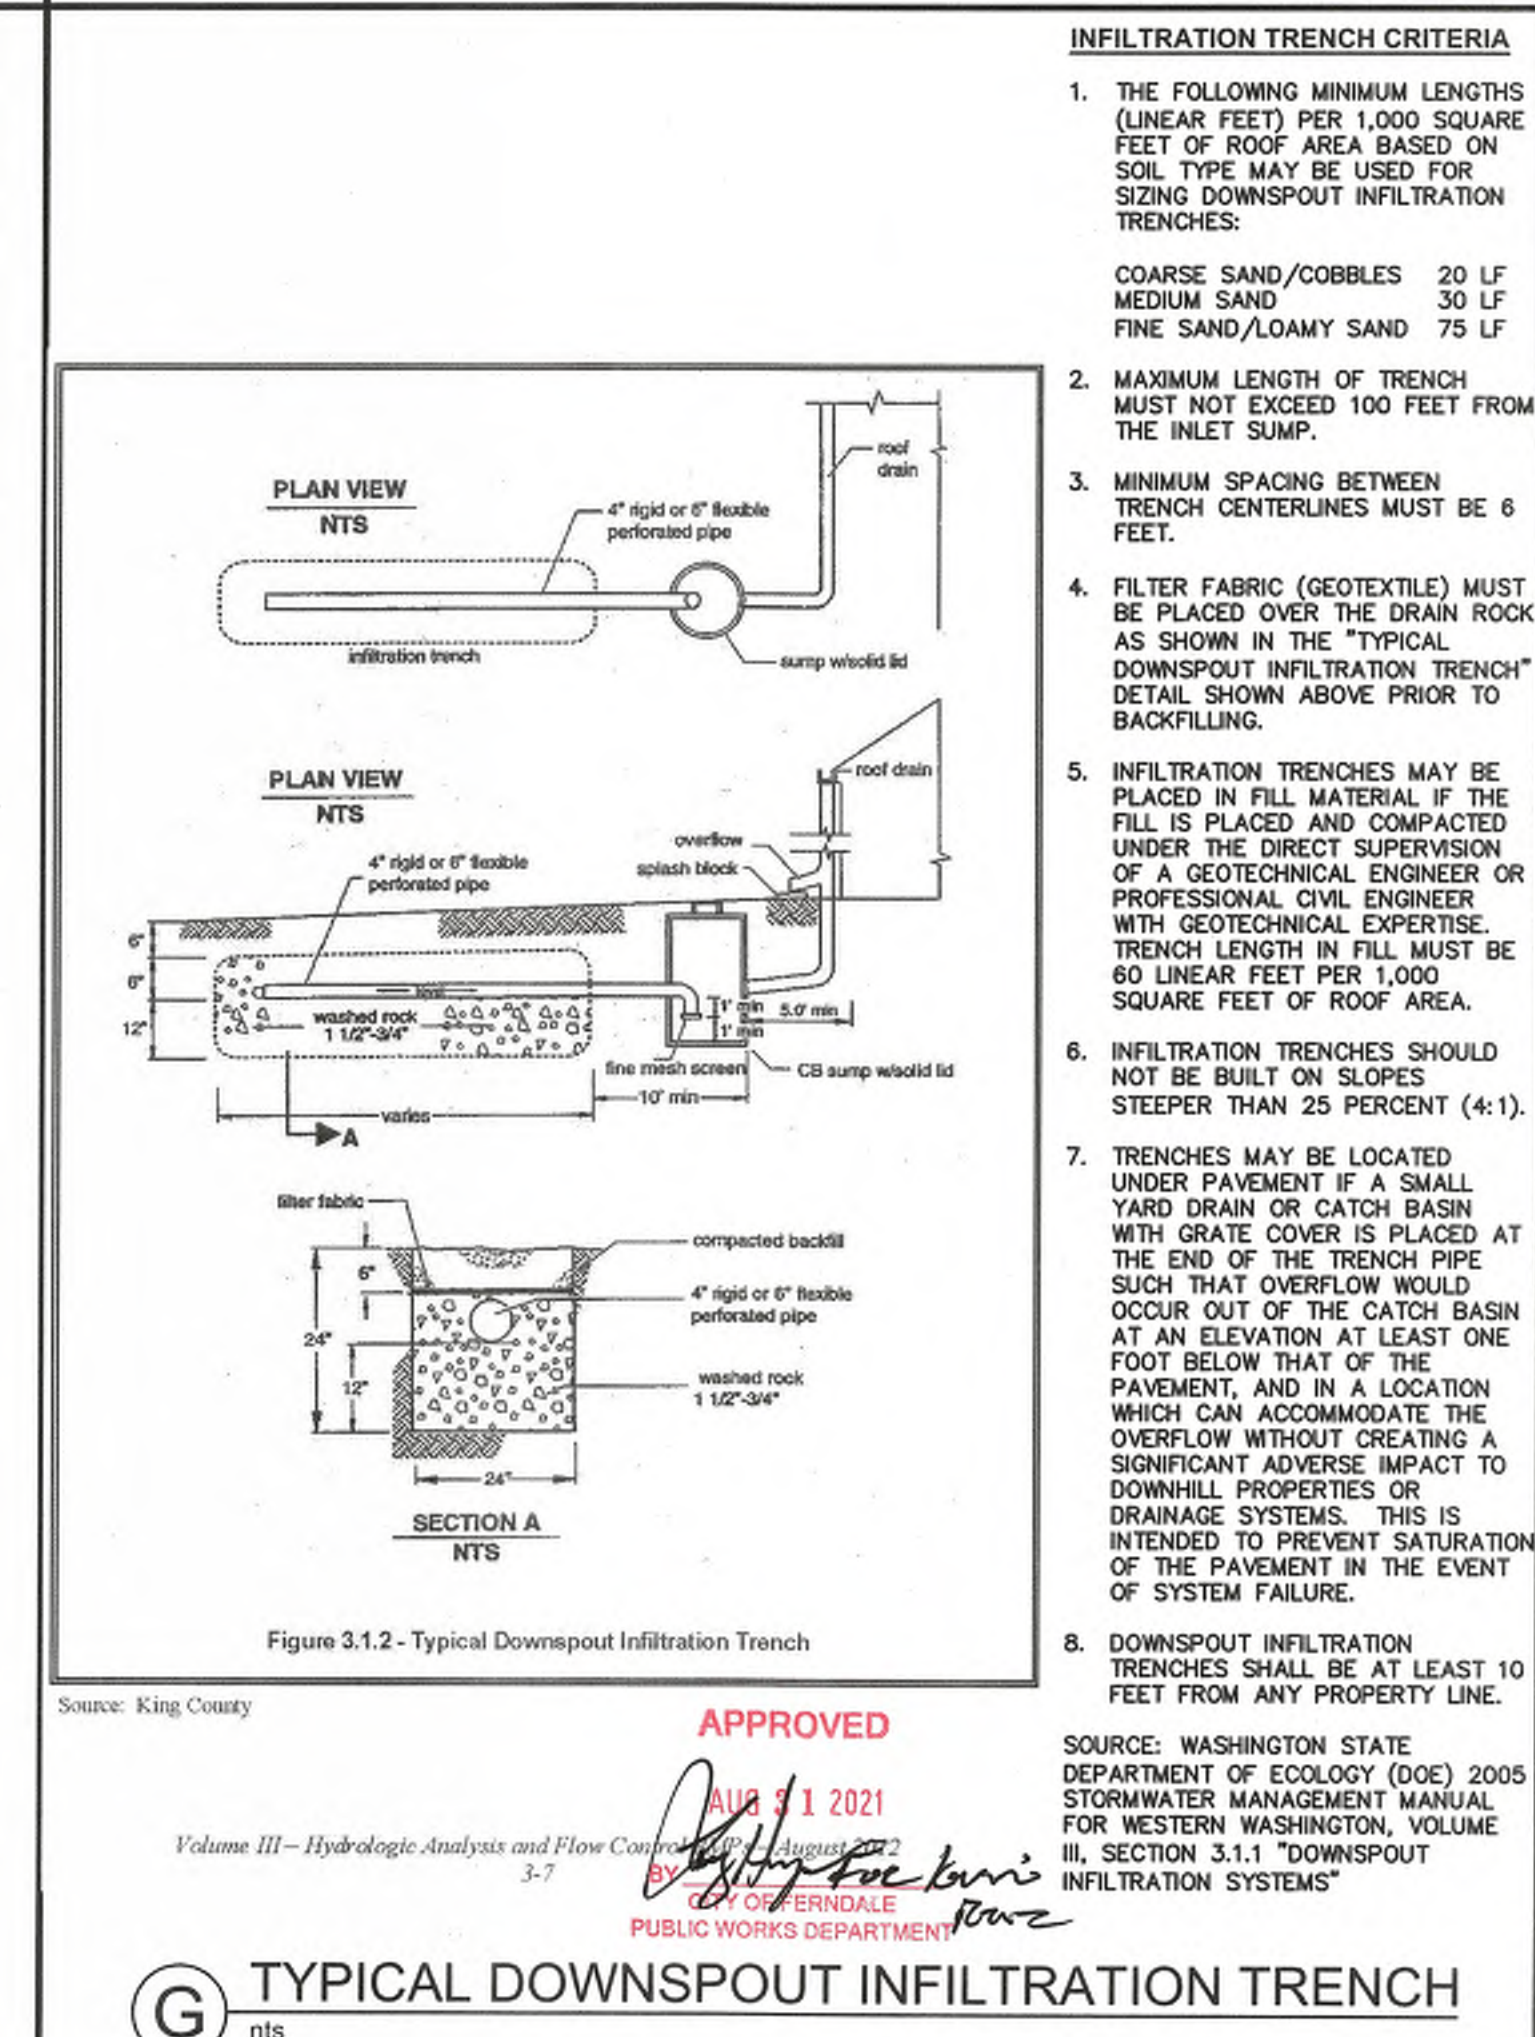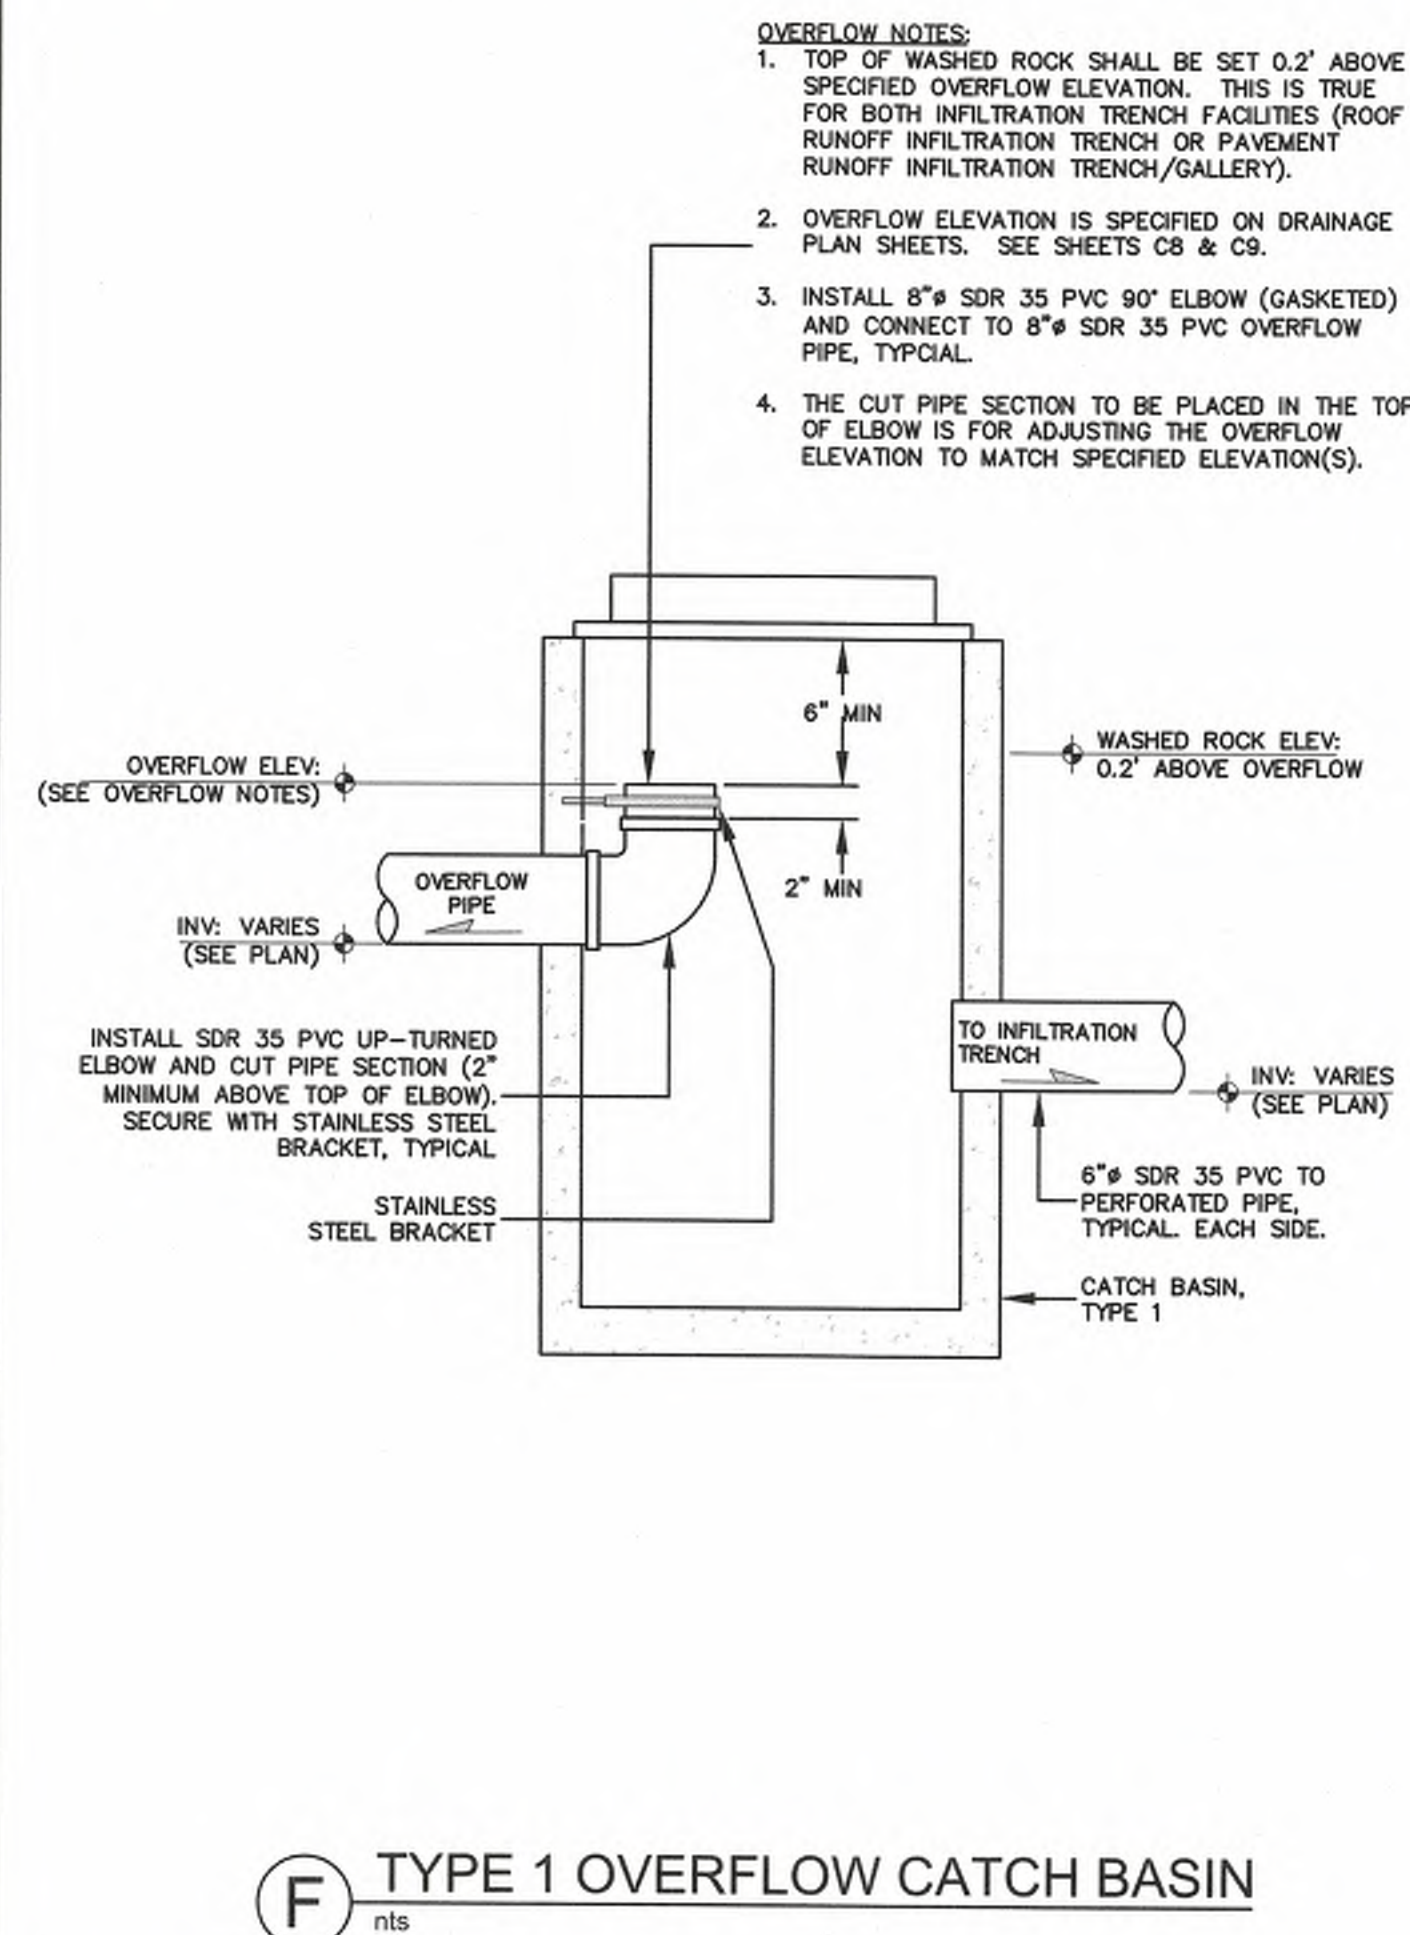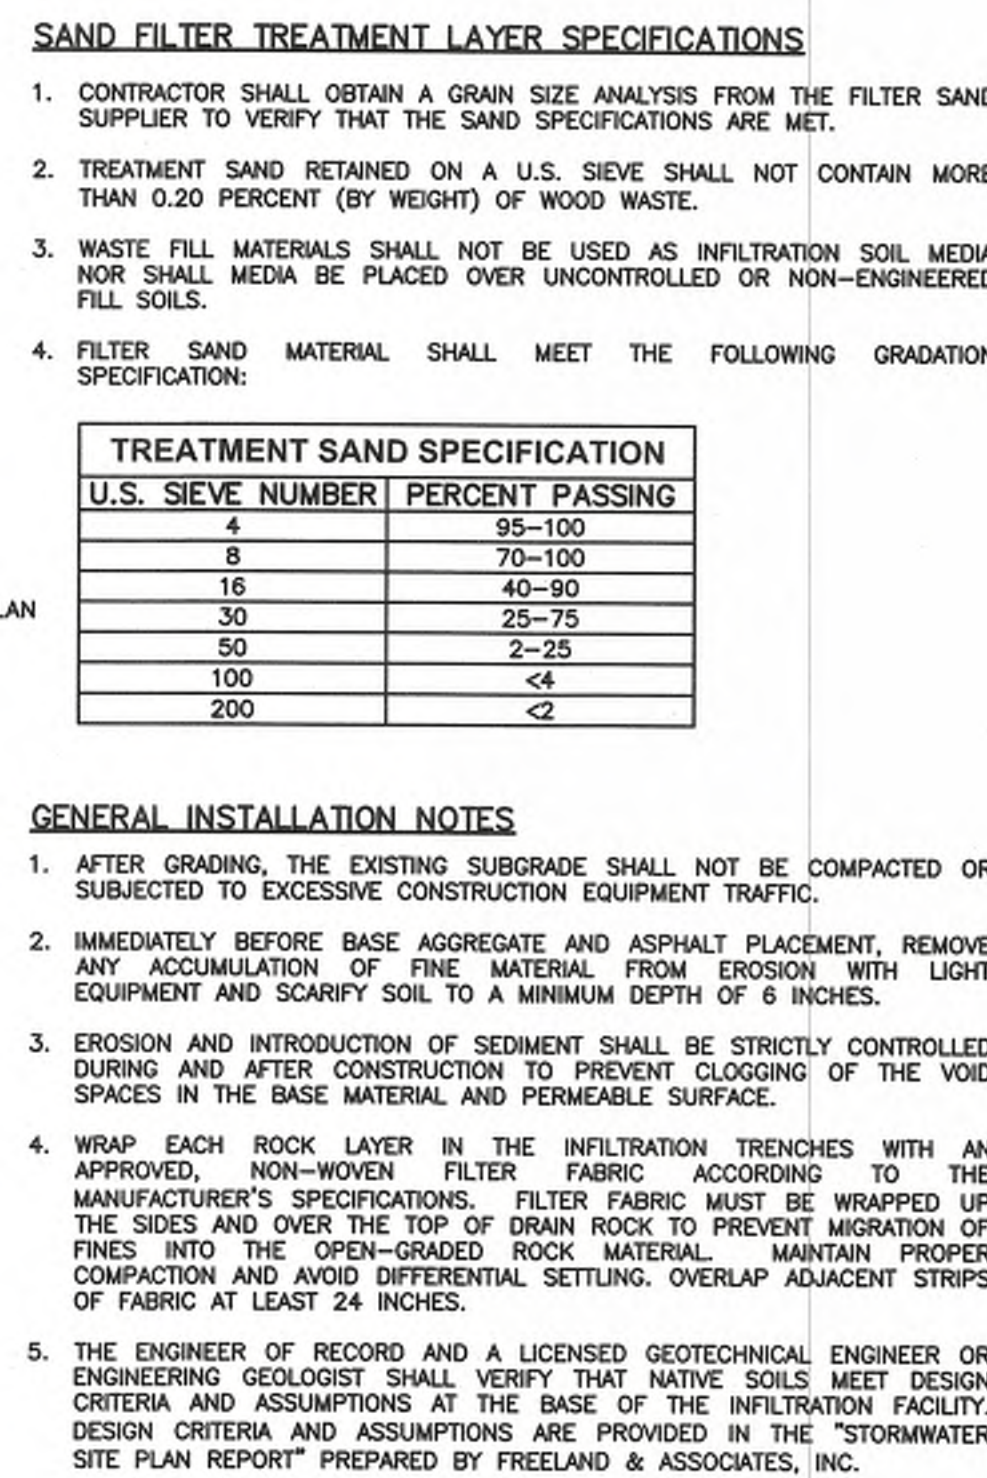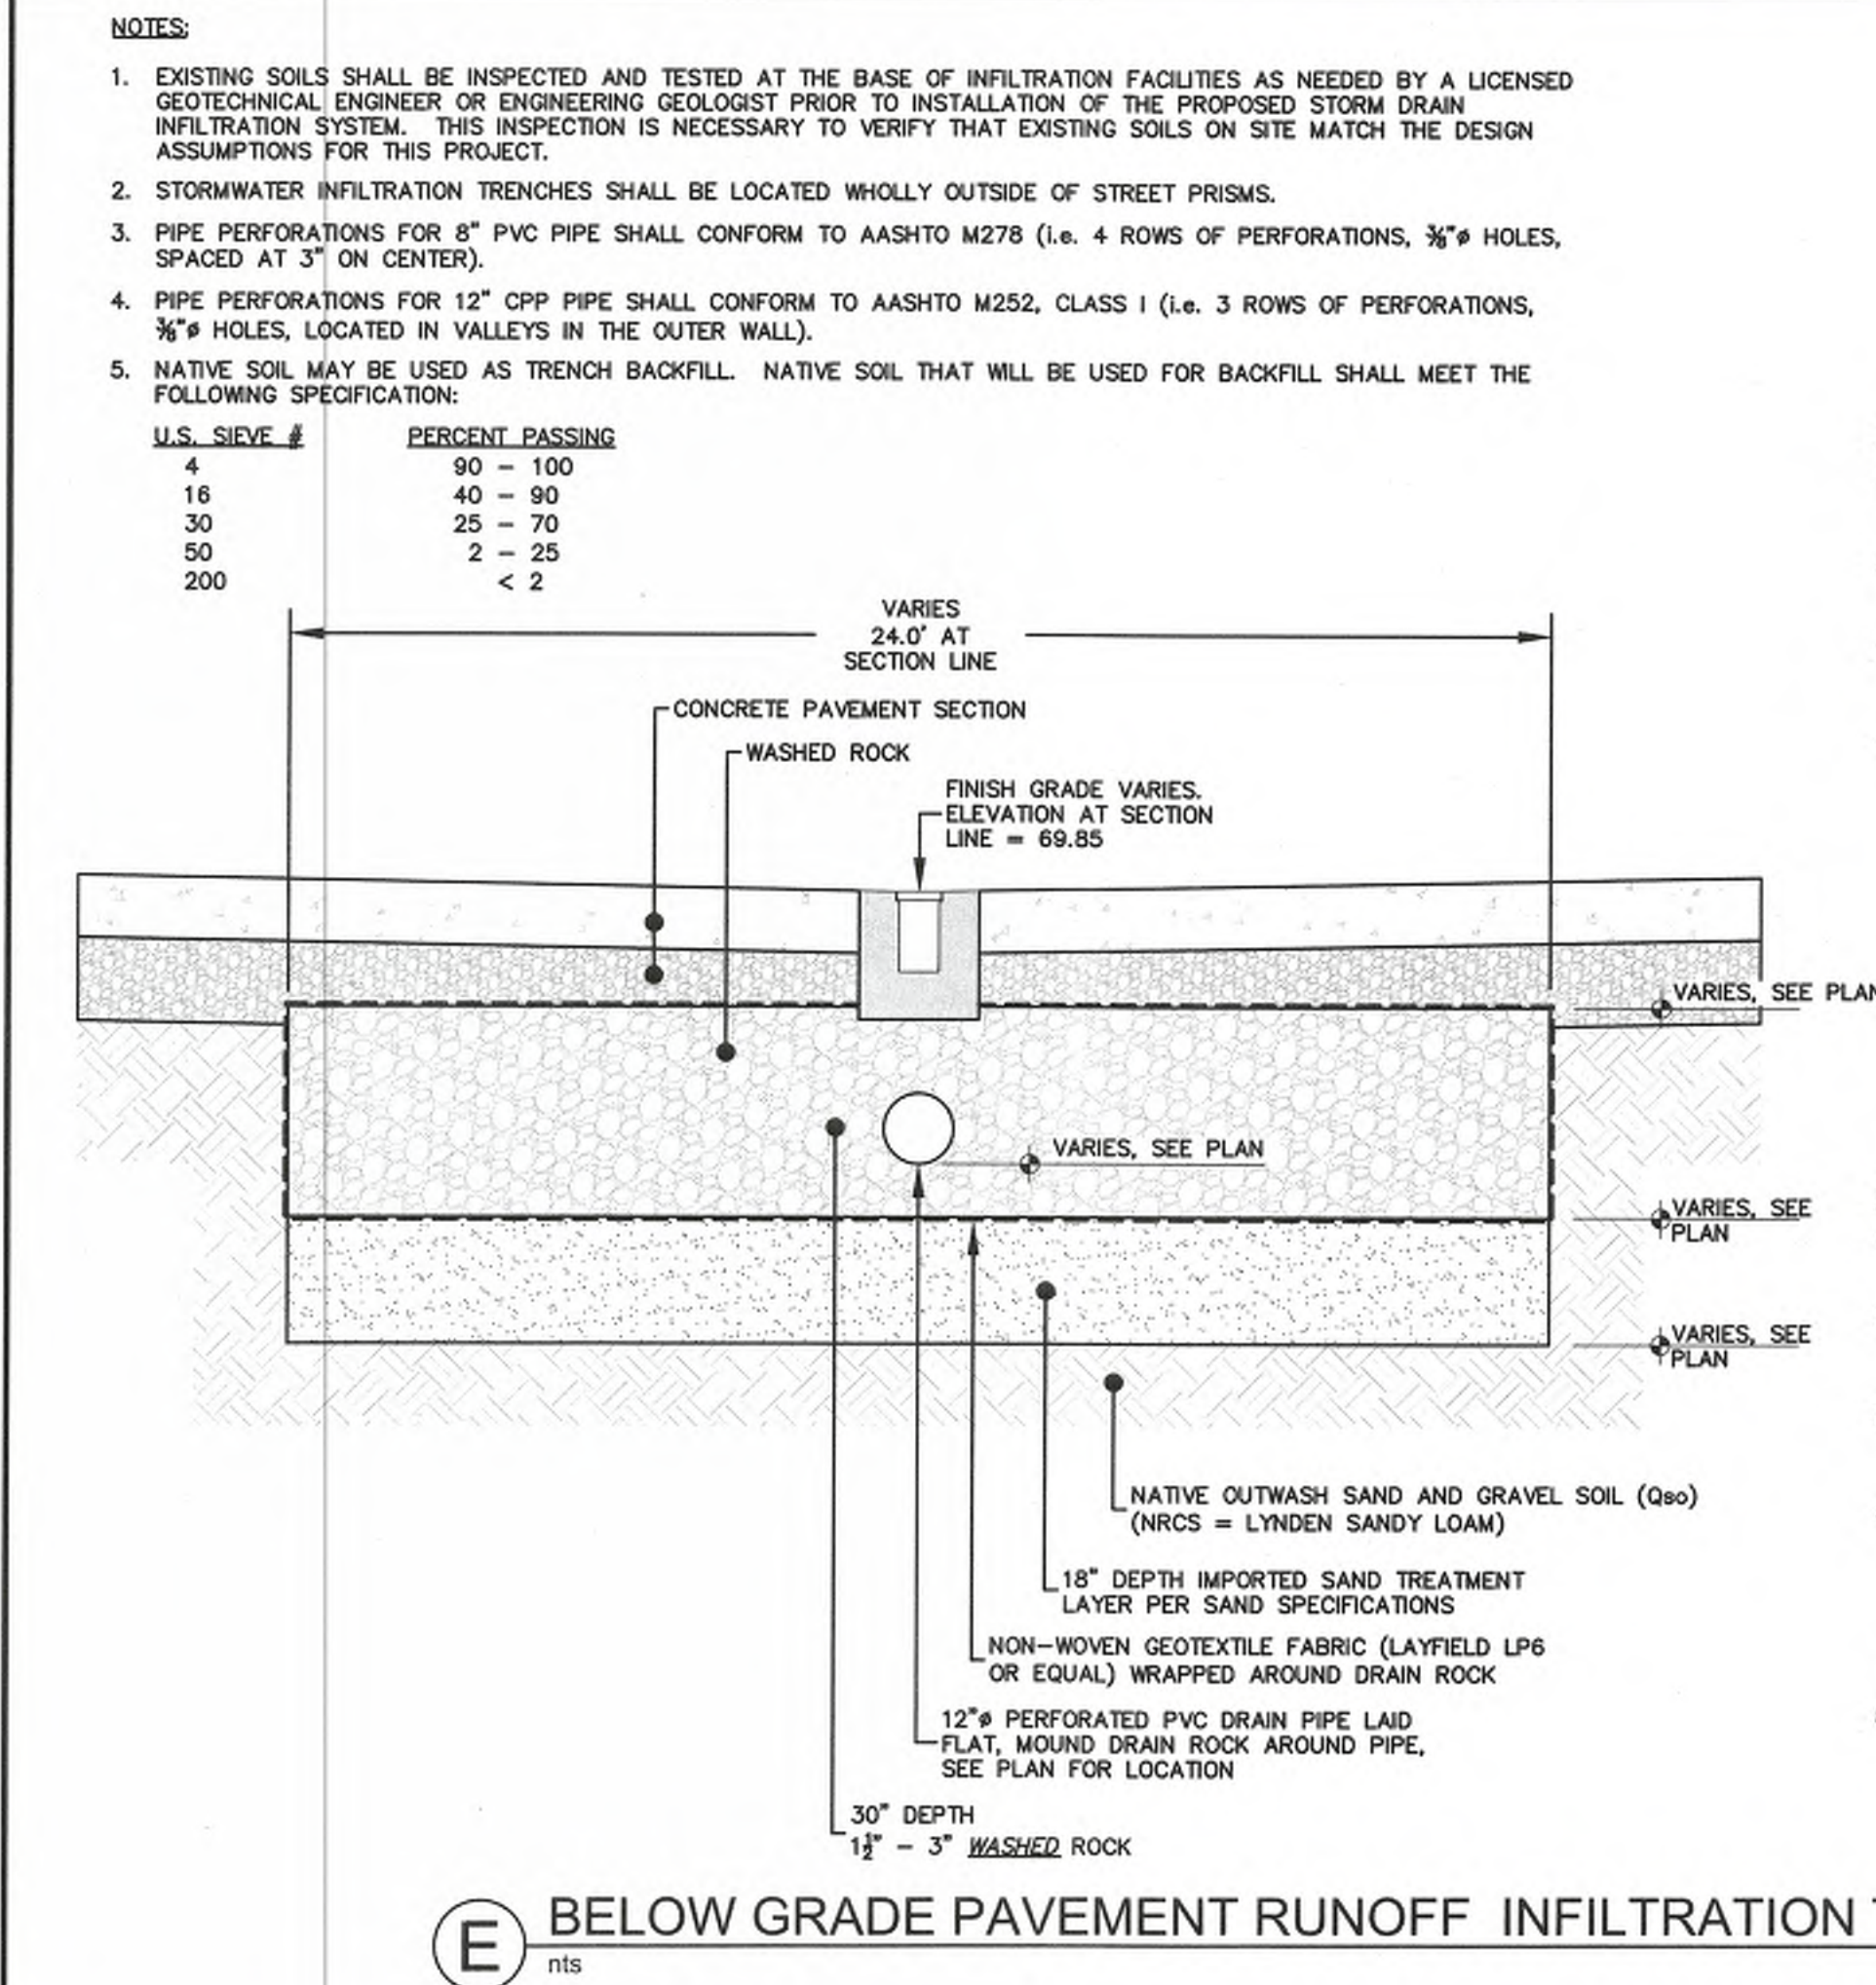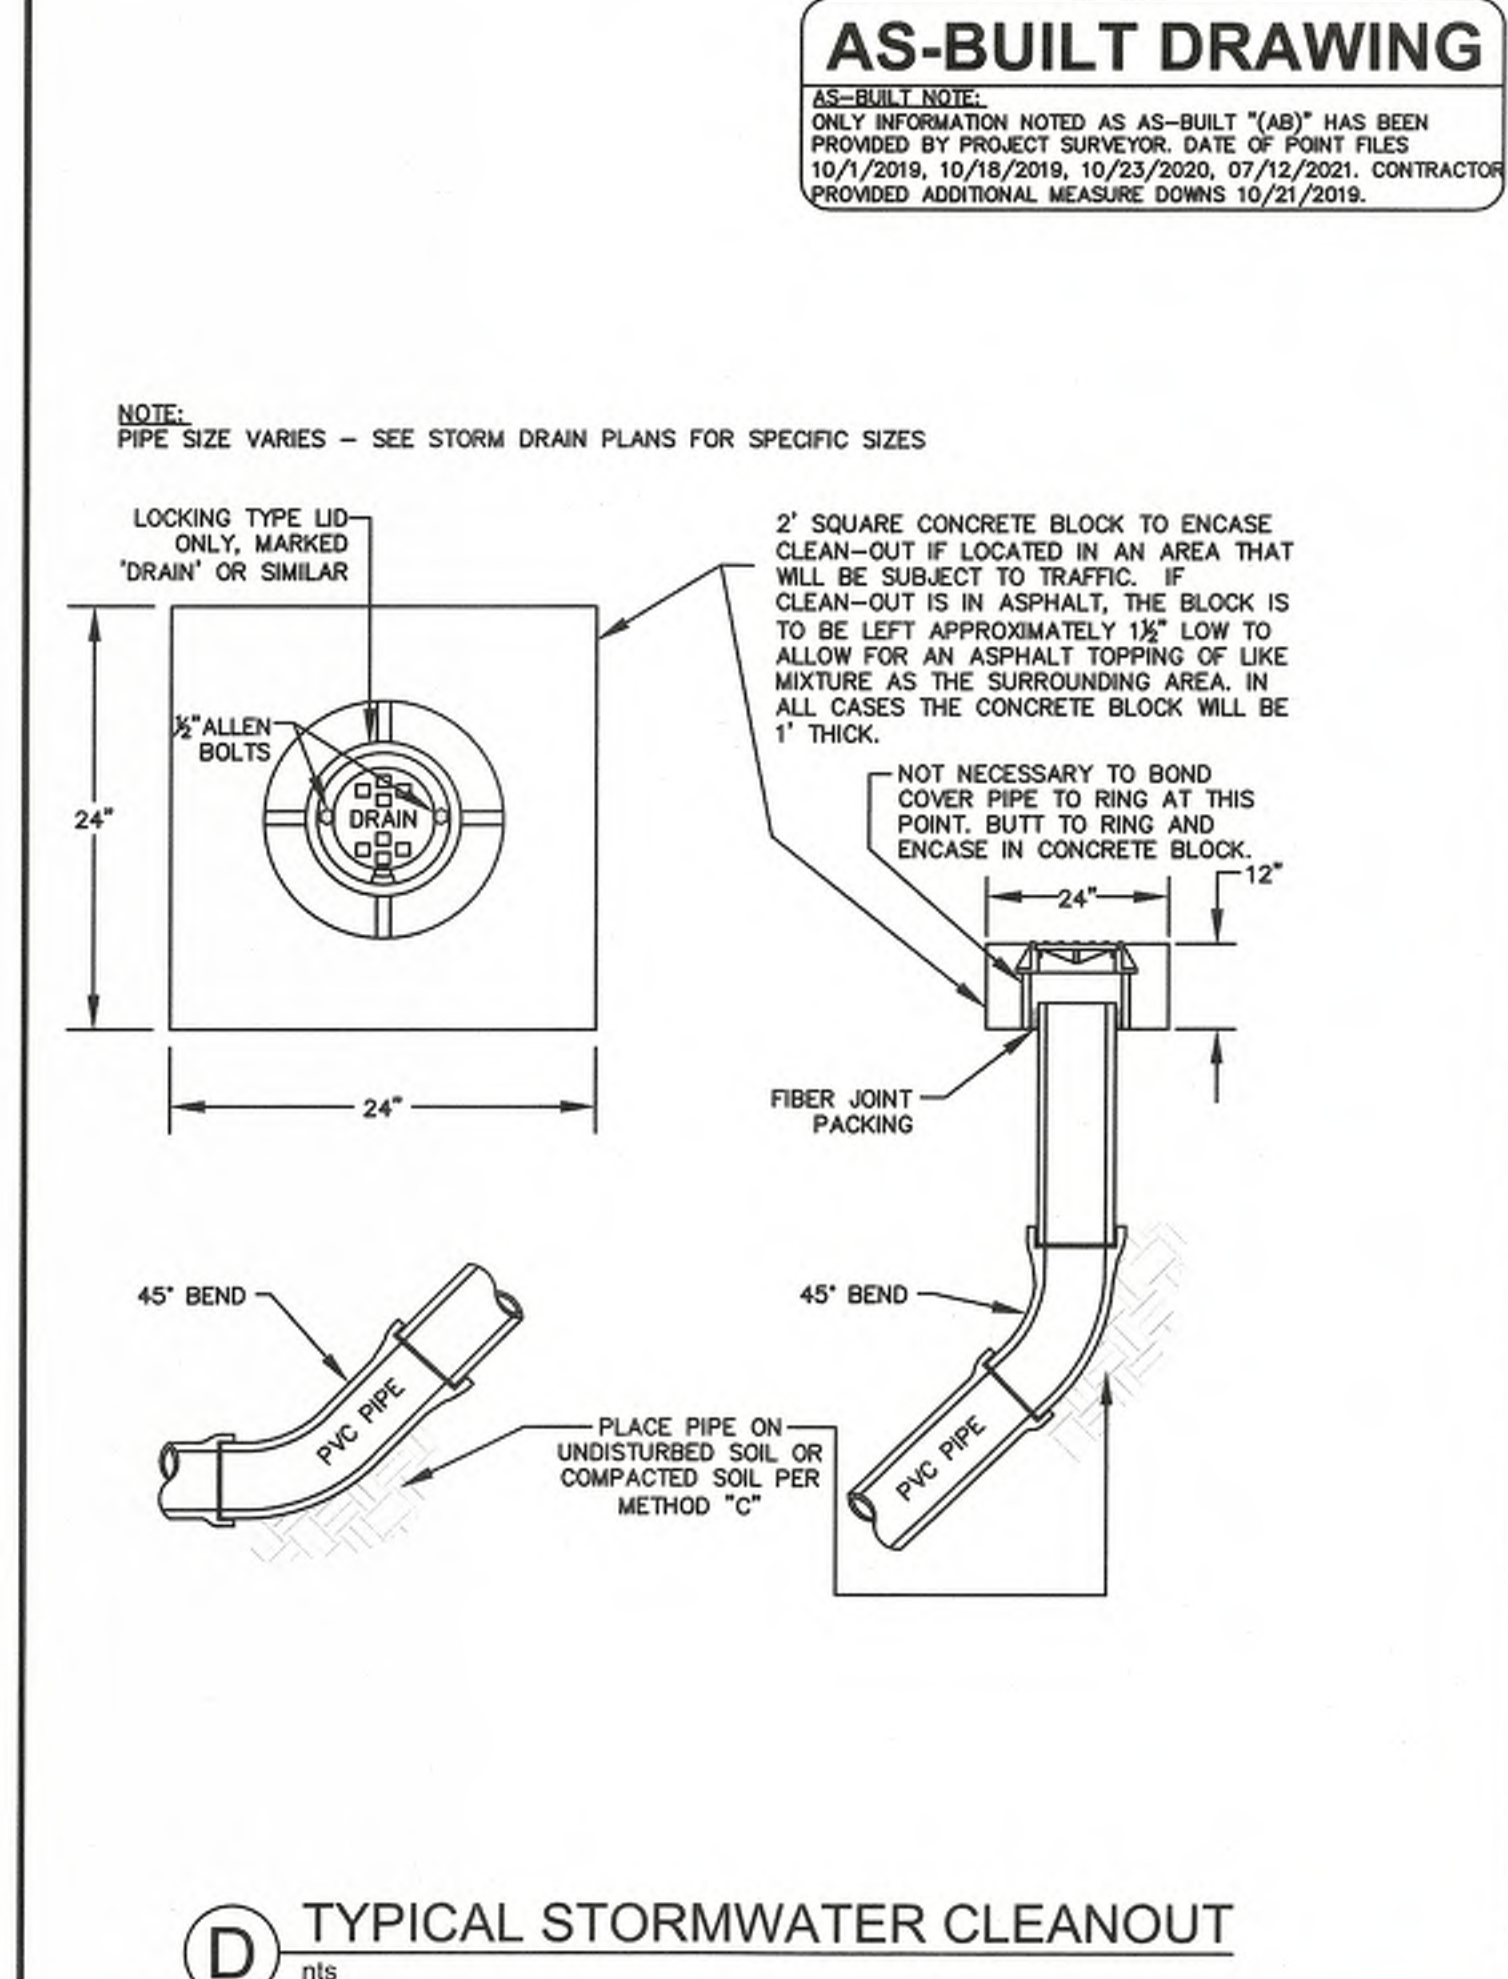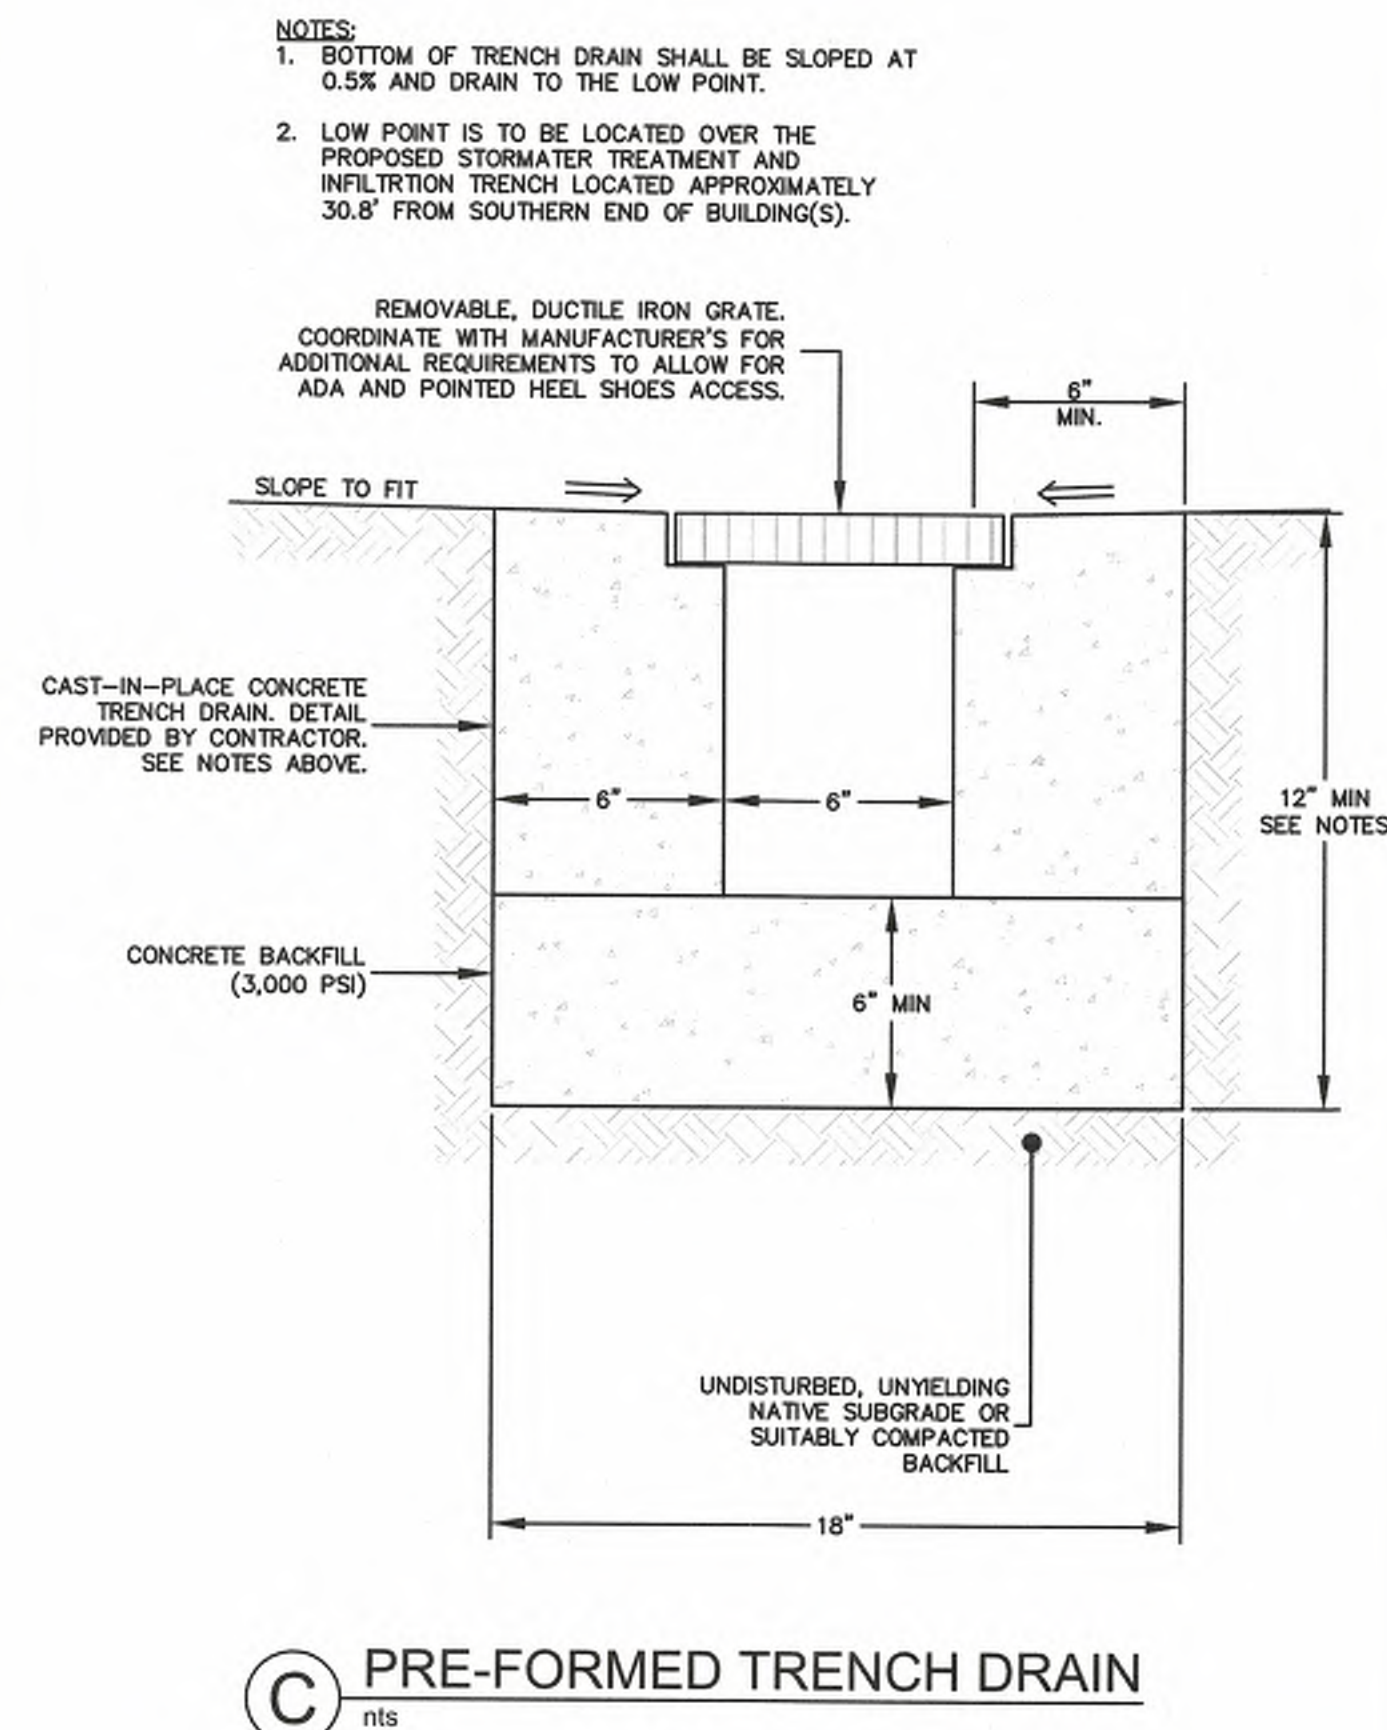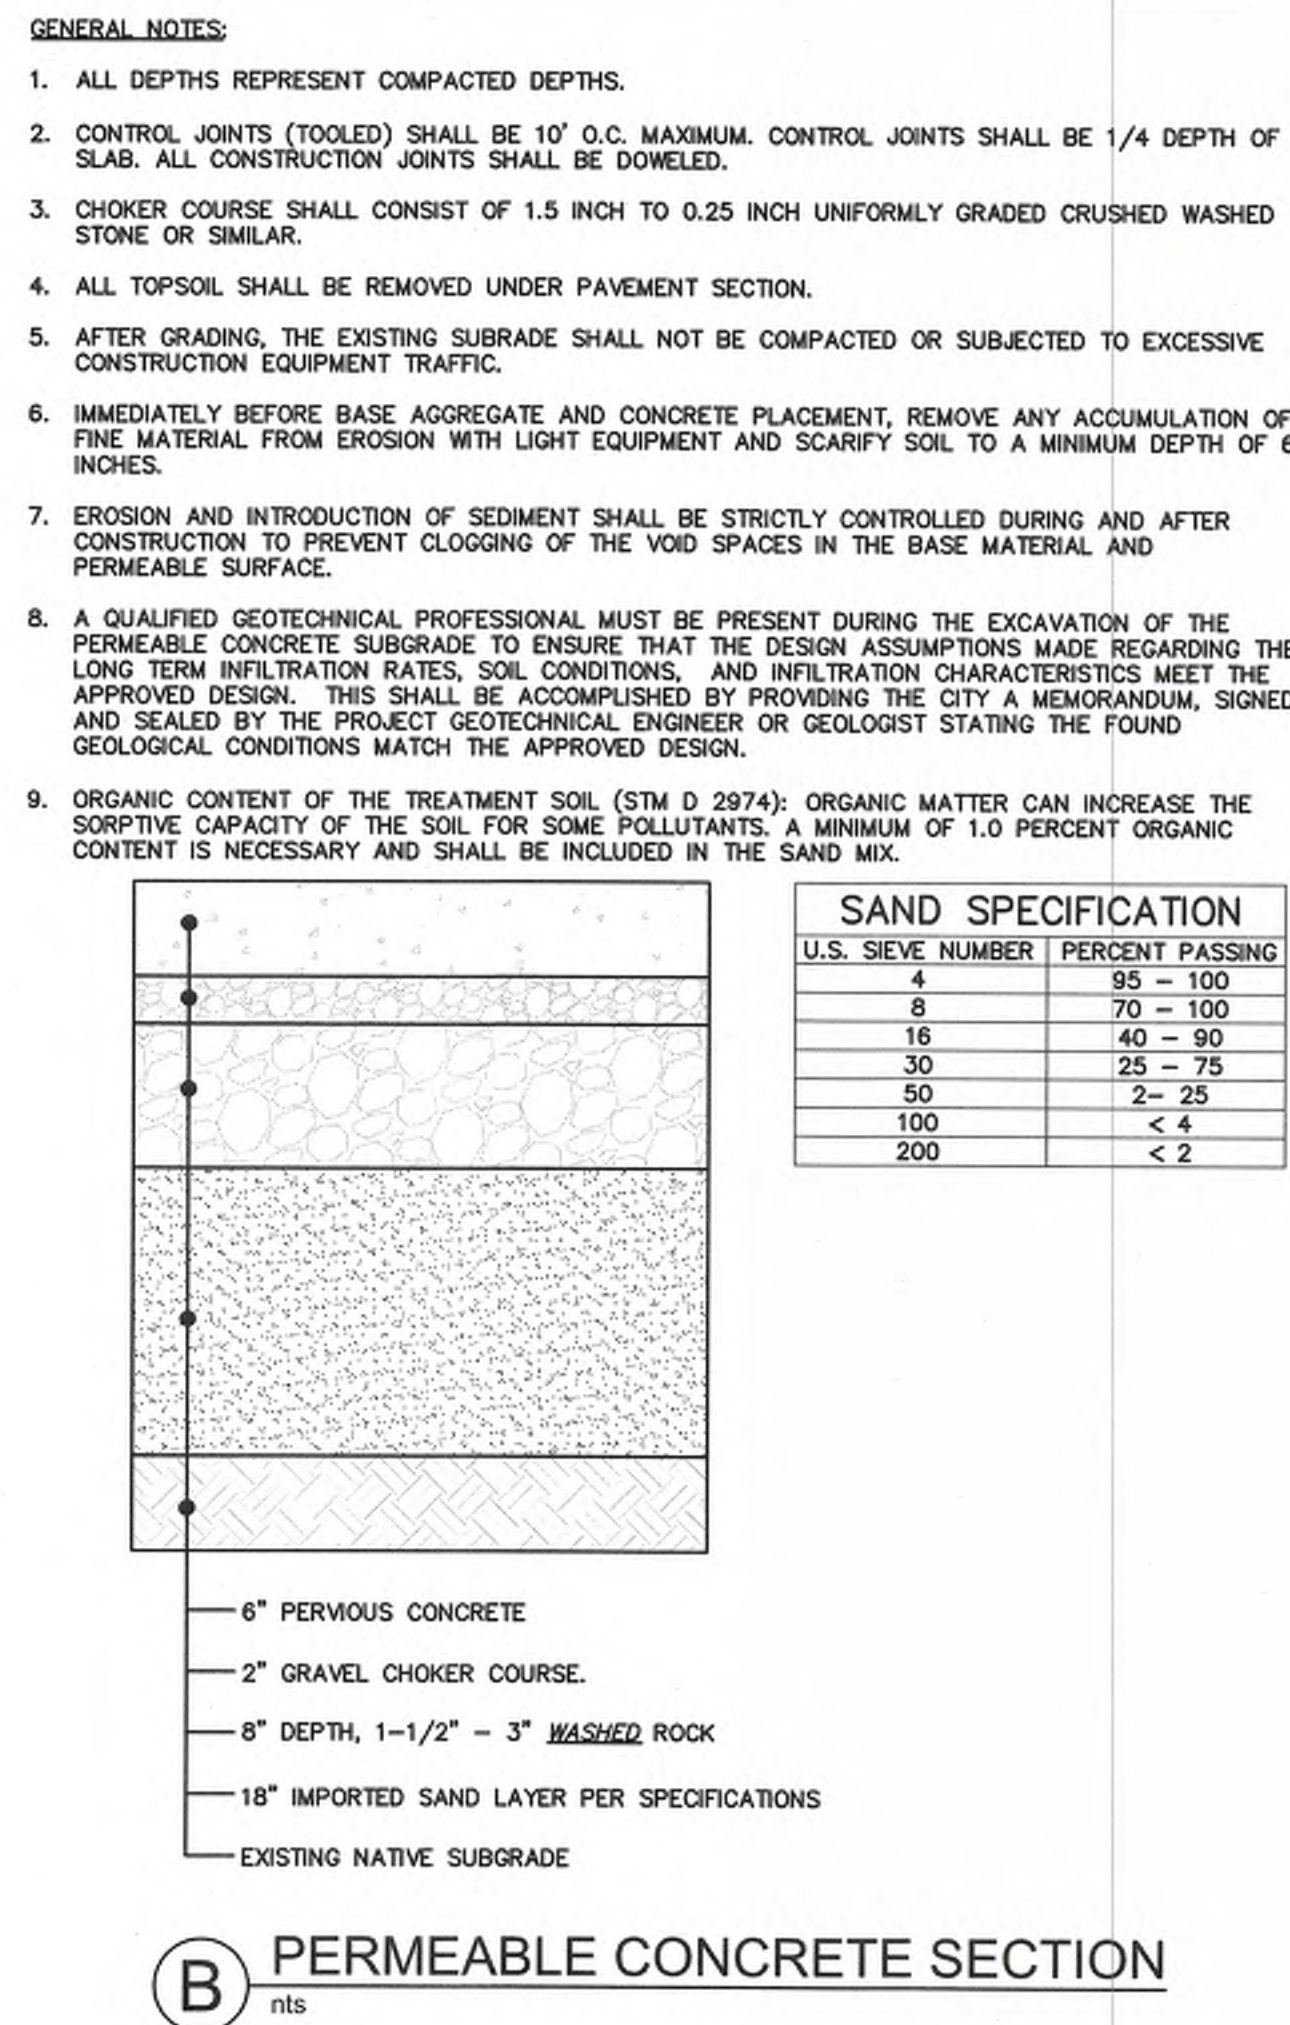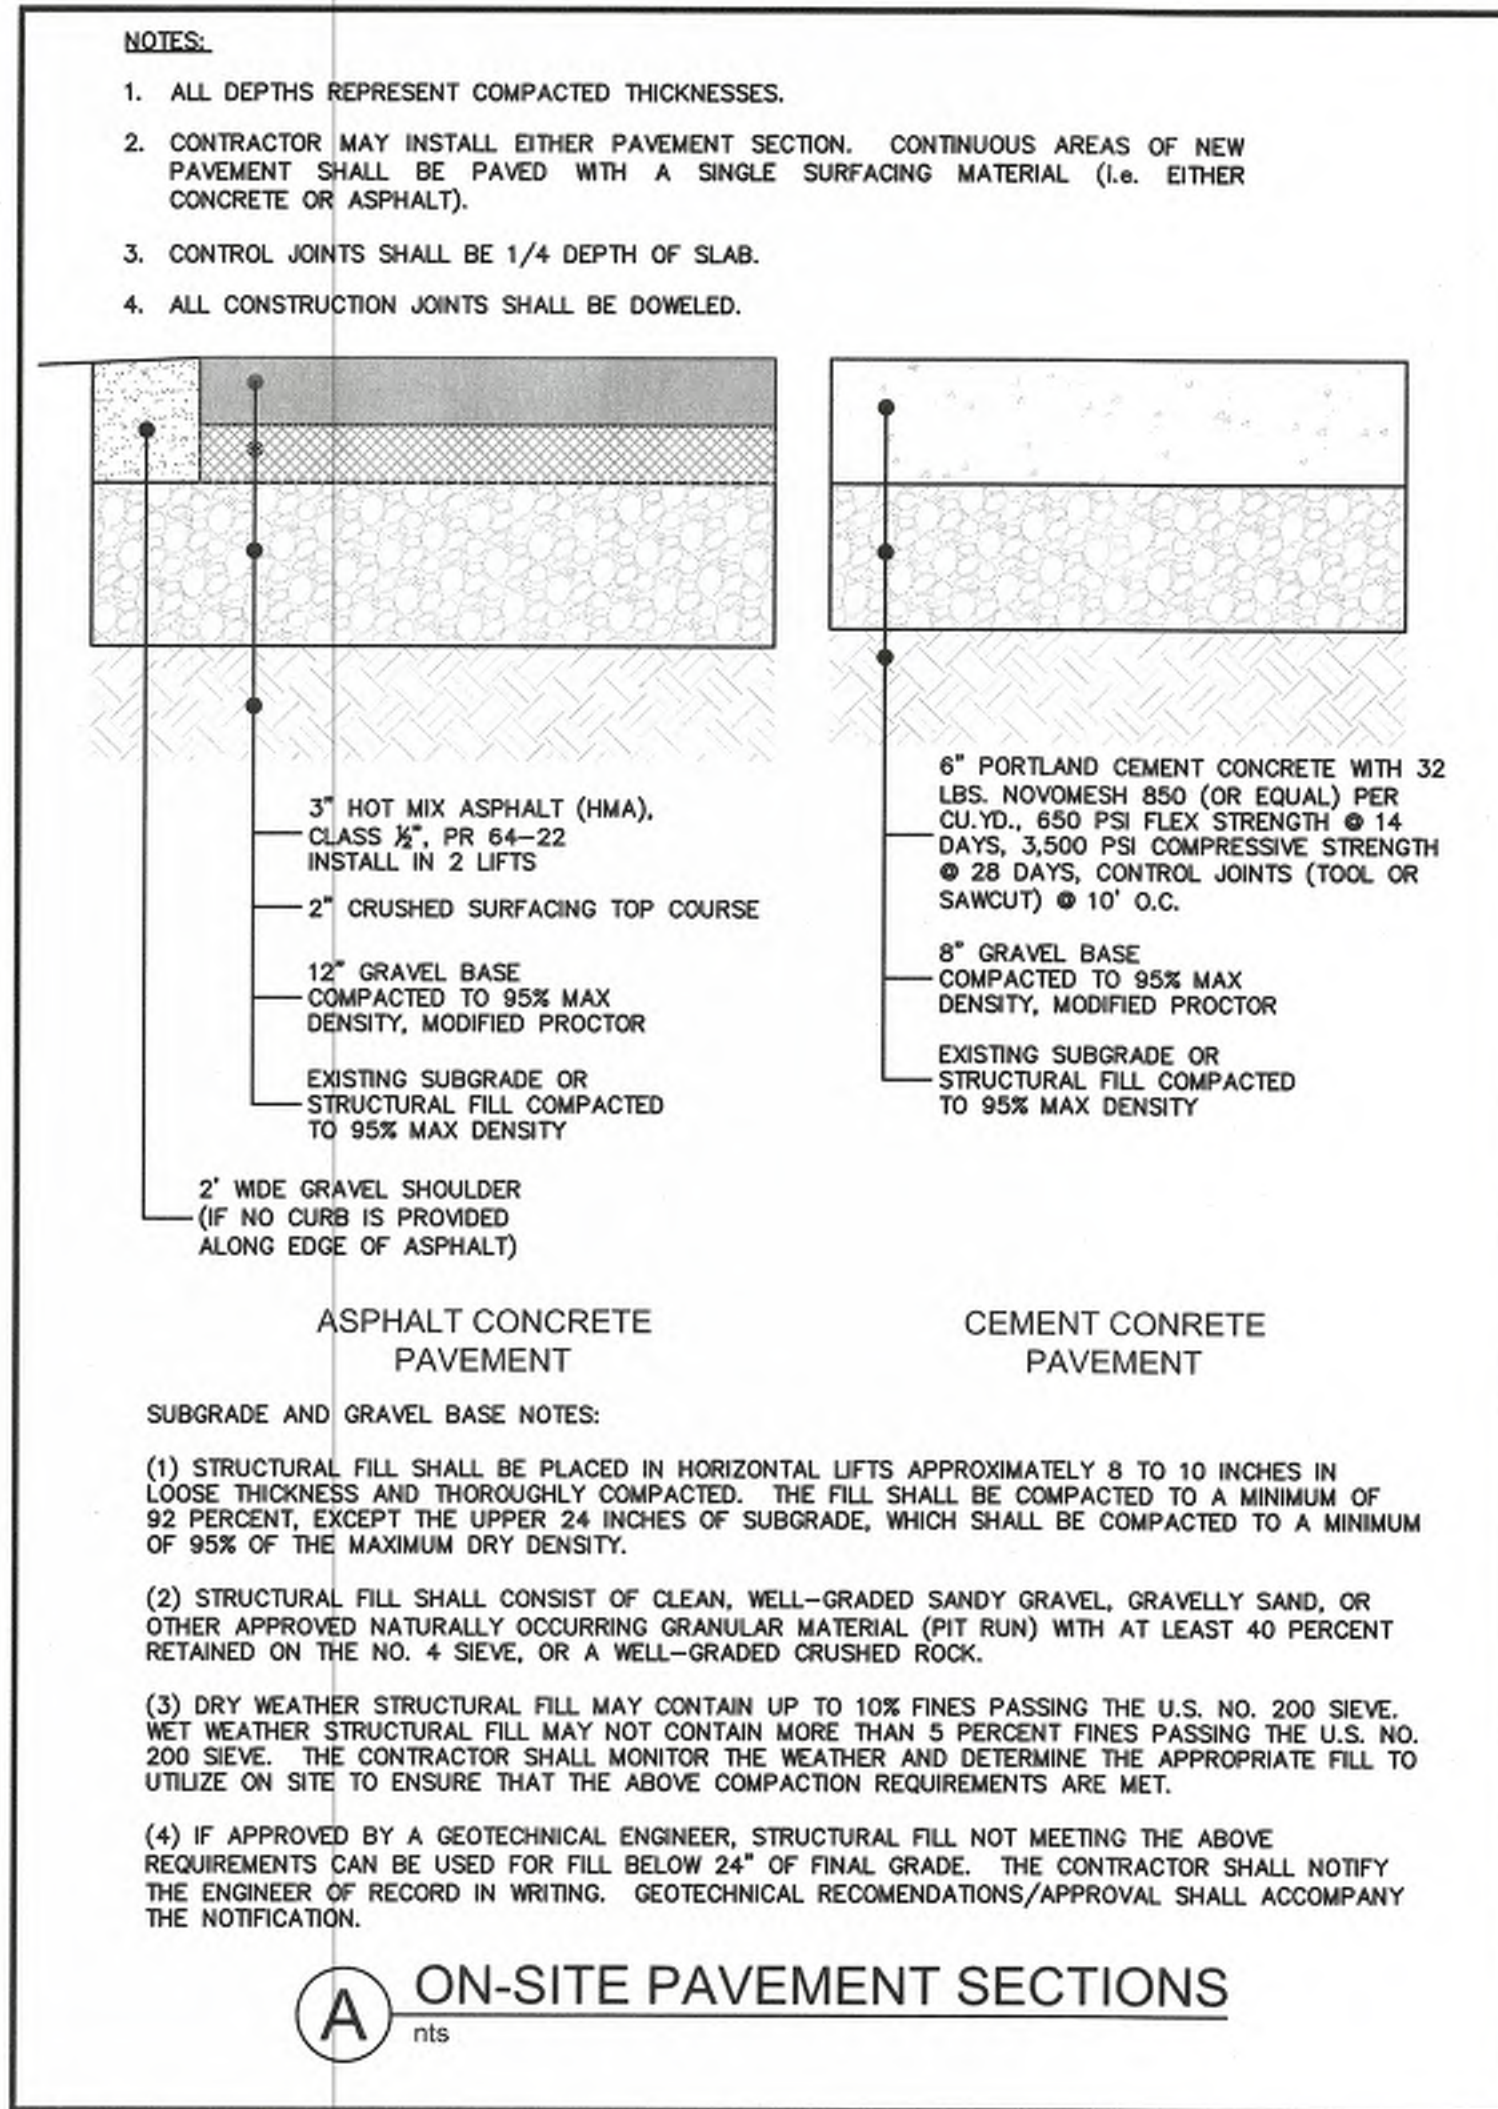

FREELAND & ASSOCIATES

220 West Champion Street, Suite 200 | 360.650.1408
Bellevue, WA 98005 | 360.650.1401

BY: [Signature]

DESCRIPTION:

REV: DATE:

CLIENT: **PIONEER POST FRAME**
6208 PORTAL WAY
FERNDALE, WASHINGTON

CALL BEFORE YOU DIG
FOR BURIED UTILITY LOCATIONS
1-800-424-5555

PROJECT LOCATION: **PIONEER FLEXSPACE, LLC**
6407 PORTAL WAY
FERNDALE, WASHINGTON

DRAWING # 18084SP26 (PH5).DWG
DESIGNED BY: HAF
CHECKED BY: HAF
DRAWN BY: CUL

SHEET CONTENTS: **PAVING AND DRAINAGE DETAILS**


STATE OF WASHINGTON
REGISTERED PROFESSIONAL ENGINEER
8848

JOB #: 18084
DATE: 8-30-2021
SCALE: HORIZ: N/A
VERT: N/A
SHEET: **C17**



-

1. ALL WORK SHALL CONFORM TO NFPA 24 AND THE INTERNATIONAL FIRE CODE.
2. BACKFLOW PREVENTOR, PIV, AND FDC CHECK VALVE SHALL BE LOCATED OUTSIDE OF THE BUILDING.
3. THE FIRE DEPARTMENT HOSE CONNECTION FOR SUPPLY SHALL BE OUTFITTED WITH A FIVE (5) INCH STORZ UNIVERSAL QUICK-CONNECT COUPLING AND BLIND CAP.
4. INSTALLER MUST BE A LEVEL "U" CERTIFICATE HOLDER.
5. IN THE UNCOVERED DITCH, THE COMPLETED UNDERGROUND FIRE LINE SHALL BE HYDROSTATICALLY TESTED TO 200 PSI FOR 2 HOURS, AND COMPLETELY FLUSHED IN THE PRESENCE OF A FIRE DEPARTMENT INSPECTOR.
6. A TAMPER PROTECTION SWITCH SHALL BE INSTALLED ON THE POST INDICATOR VALVE.
7. CONTACT ENGINEER OF RECORD IF FIELD CONDITIONS DO NOT MATCH CONDITIONS SHOWN ON THE DETAIL.
8. ALL BOLTS AND MILD STEEL COMPONENTS SHALL BE COATED WITH BITUMINOUS COATING, OR SPRAYED WITH GALVANIZED PAINT.
9. VALVE TO BE LOCATED IN RISER ROOM TO ISOLATE THE FIRE LINE.

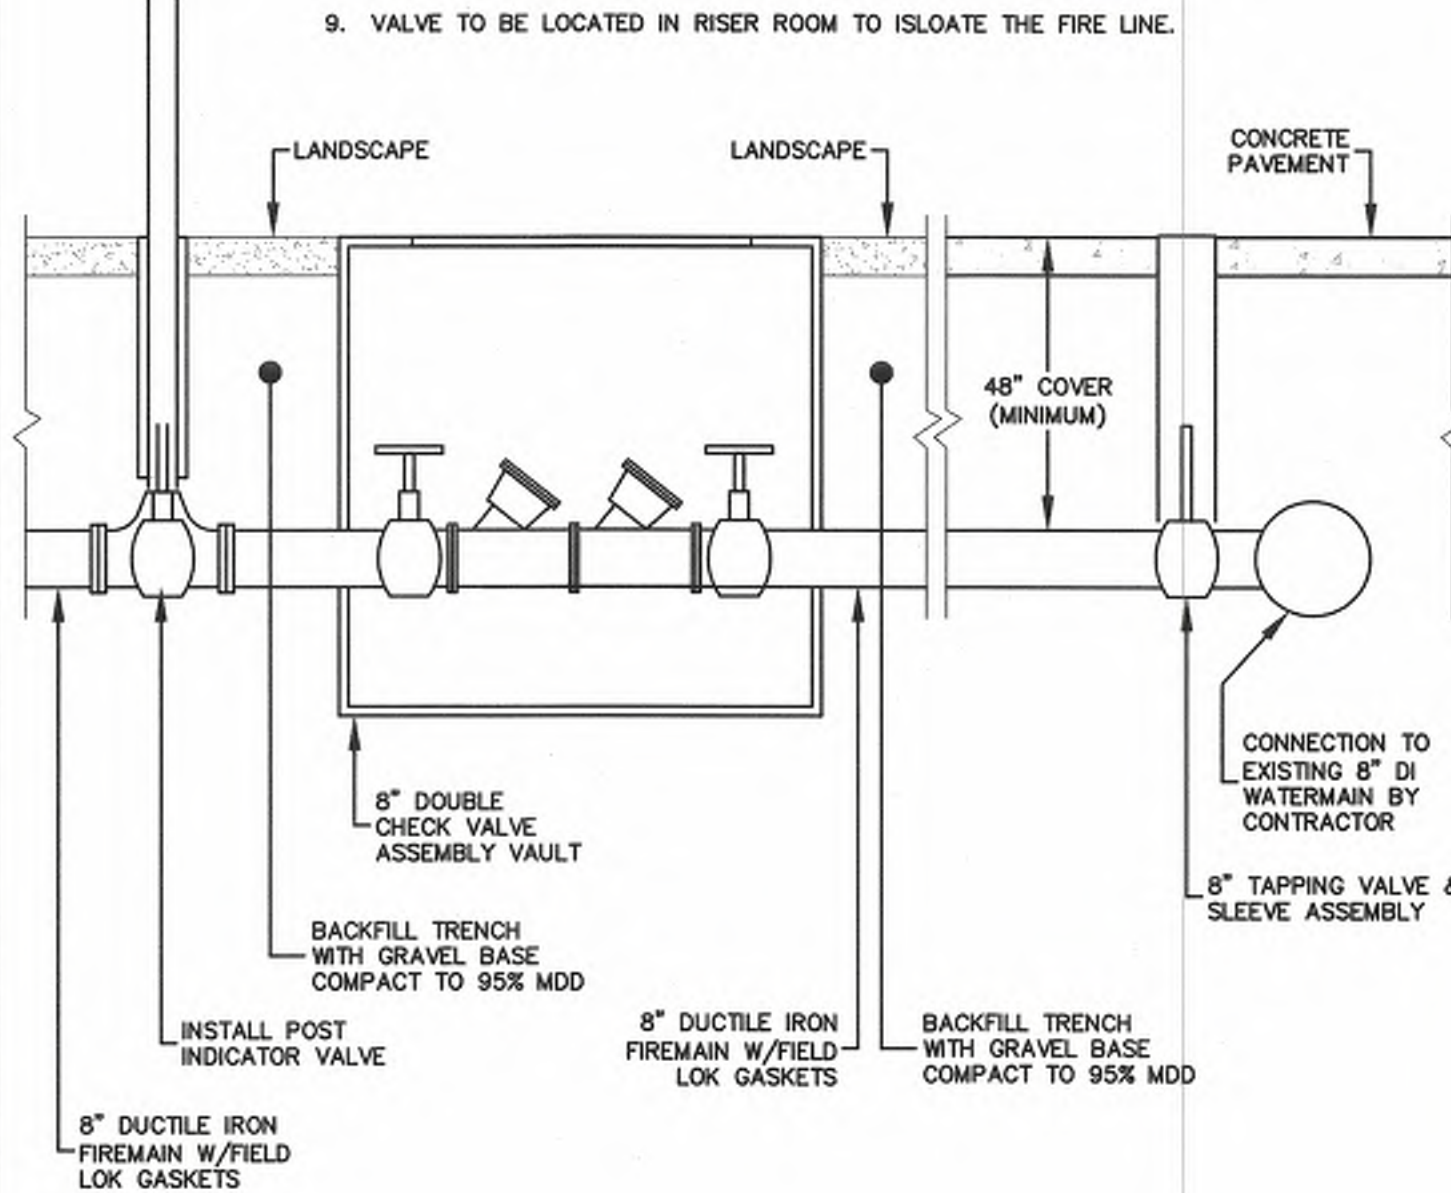

5" STORZ W/ LOCKING BLIND CAP

30° BEND

6" SCH 40 GALV PIPE

12" ROUND x 3.5" DEEP CONCRETE PAD

LANDSCAPE

36" TO 42"

CONCRETE PAVEMENT

PROPOSED 12" WATERMAIN (36" COVER TYPICAL)

9" MINIMUM SEPARATION UNDER PROPOSED WATERMAIN, TYPICAL

57" COVER AT CROSSING

48" COVER (MINIMUM)

PRIME AND WRAP PIPE WITH 10 MIL PVC TAPE

BALL DRIP VALVE

FLANGE

1 - 6" 90° D.I. BEND (FLMJ) MEGALUG RESTRAINTS

BACKFILL TRENCH WITH GRAVEL BASE COMPACT TO 95% MDD

8" DUCTILE IRON FIREMAN W/FIELD LOK GASKETS

8" DUCTILE IRON FIREMAN W/FIELD LOK GASKETS FROM DCVA LOCATION

Technical drawing of a pump assembly. The vertical view on the left shows a total height of 8.00 and a section labeled '6" NPSH'. The side view on the right shows a horizontal dimension of 4.50 and a vertical dimension of 5.83. A third view on the far right shows a component with a vertical dimension of 7.72.

	DWG NO.: H30E-50-60NPSH/CAP	
	DESCRIPTION: 30" ELBOW 5" STORZ X 6" NPSH FEMALE SWIVEL with STORZ CAP w/CABLE	
Harrington, Inc. 2630 W. 21st Street Erie, PA 16506	DATE: 11/6/07	DATE: MFC
	SCALE: N/T	SHEET 1 OF 1




220 West Champion Street, Suite 200 t: 360.655.1414
 Bellingham, WA 98225 f: 360.655.1414

FREELAND
 & ASSOCIATES

[illegible]

PIioneer POST FRAME
6208 PORTAL WAY
FERNDALE, WASHINGTON

CALL BEFORE YOU DIG
FOR BURIED UTILITY LOCATIONS
1-800-424-5556

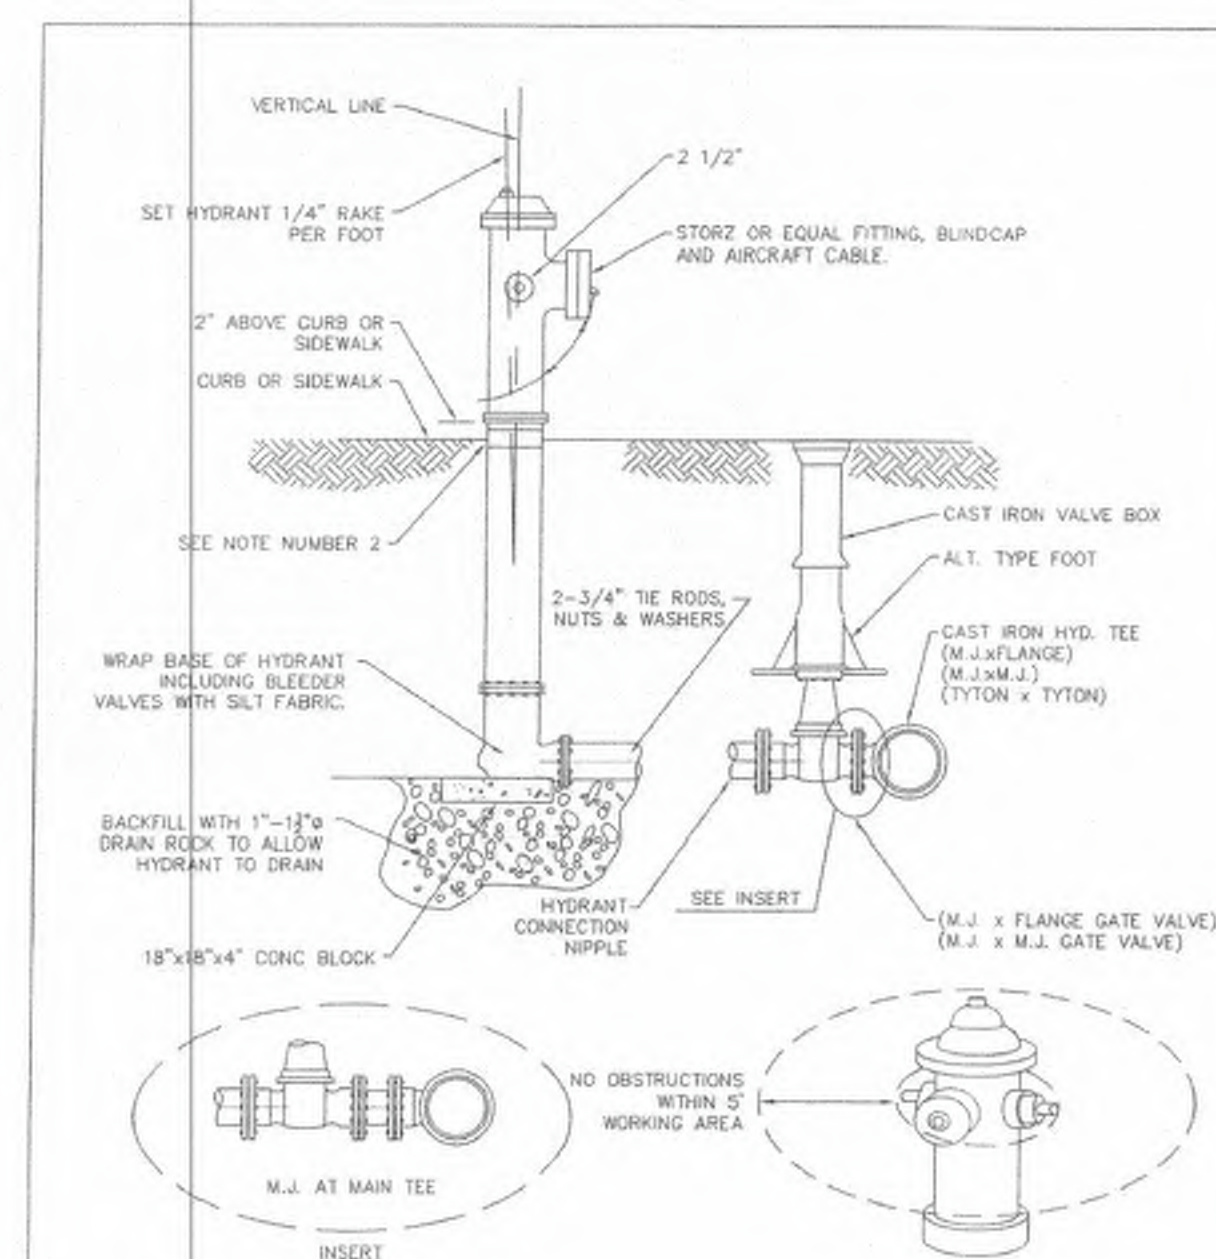

- NOTES
1. FOR CLOSE COUPLED HYDRANTS USE ALL FLANGE TYPE CONNECTIONS.
 2. IF HYDRANT RISES THROUGH CONCRETE USE EXPANSION STRIP AROUND HYDRANT BARREL.
 3. ALL HYDRANT ASSEMBLIES WILL BE M&H MODEL 929T.

AUGUST 2, 2017

VED

FIRE HYDRANT ASSEMBLY

Public Works Director


8/11/17
Date

STANDARD DETAIL W-1

NOT TO SCALE

BOLLARD NOTES:

1. BOLLARDS SHALL BE 4" DIAMETER DUCTILE IRON POSTS SET IN 36" OF CONCRETE AT LEAST 18" IN DIAMETER. THE INSIDE OF POSTS SHALL ALSO BE FILLED WITH CONCRETE WITH SMOOTH MOUND AS TOP CAP.
2. BOLLARDS SHALL BE LOCATED 3' CLEAR FROM FIRE HYDRANT AND SHALL BE INSTALLED AT ± 0.0 . AND SHALL PROTECT FIRE HYDRANT FROM ALL FOUR SIDES.
3. BOLLARDS SHALL EXTEND ABOVE GROUND TO A MINIMUM HEIGHT OF 4'.
4. BOLLARDS SHALL BE OF SUFFICIENT NUMBER TO PROTECT THE STRUCTURE, MINIMUM OF 2.
5. PAINT BOLLARDS RUSTOLEUM YELLOW.

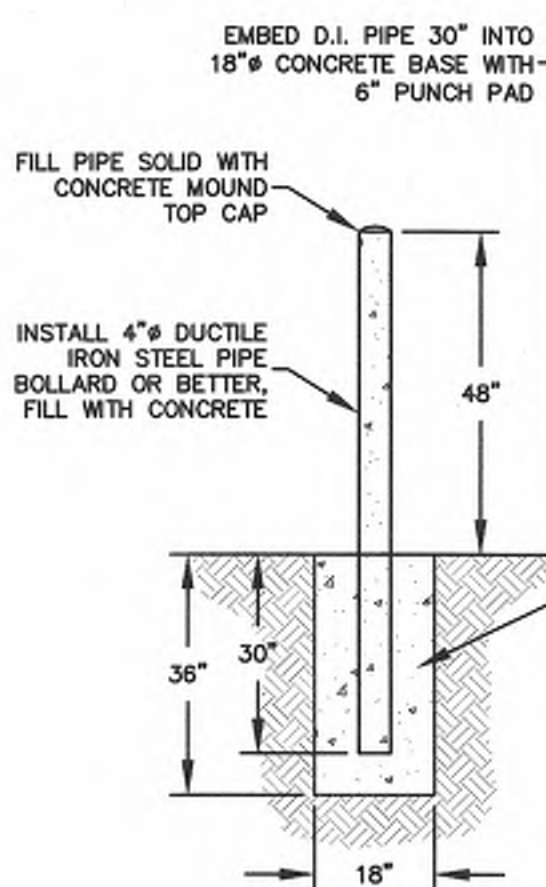

GROUND LEVEL

6"

CAP/PLUG
THREADED WITHIN
6" OF THE SURFACE/GROUND LEVEL

CAST IRON
VALVE BOX

FULL SIZE VALVE DETERMINED
BY SIZE OF WATER MAIN

3/4" MIN. RODS

D.I. WATER
MAIN

2" GALV. STEEL PIPE
AND ELBOW

3/4" DRAIN ROCK

MECHANICAL JOINT PLUG

USE REINING GLANDS AND/OR
ADEQUATE ROD ASSEMBLIES AS REQUIRED
BY THE PUBLIC WORKS DIRECTOR.

D.I. WATER MAIN
TAR PAPER

CONCRETE THRUST BLOCK

FIVE AND ONE HALF SACK CONCRETE. SIZE DEPENDS
UPON SIZE OF MAIN AND EXISTING GROUND CONDITIONS.
PLACE WELL BACK INTO UNDISTURBED GROUND PER
THE PUBLIC WORKS DIRECTOR.

EXISTING UNDISTURBED GROUND

2" BLOW-OFF TO BE USED WHERE THE MAIN WILL BE EXTENDED IN
THE FUTURE. FOR MAINS WITH NO FURTHER EXTENSION, REFER TO
2" BLOW-OFF, NON-EXTENDABLE MAIN.

AUGUST 1, 2017

APPROVED

8/11/17

Public Works Director

Date


NOT TO SCALE

2" BLOW-OFF FUTURE
WATERMAIN EXTENSION
STANDARD DETAIL W-9

CITY OF TULSA
ENGINEERING

NOTE:

1. CONTRACTOR TO VERIFY 3'x5' BOX NOTED ON PLAN SHEET C14 WILL WORK. UPSIZE AS NECESSARY TO 5'x5.4' CONCRETE VAULT AS AVAILABLE AT GRANITE PRECAST OR EQUAL.

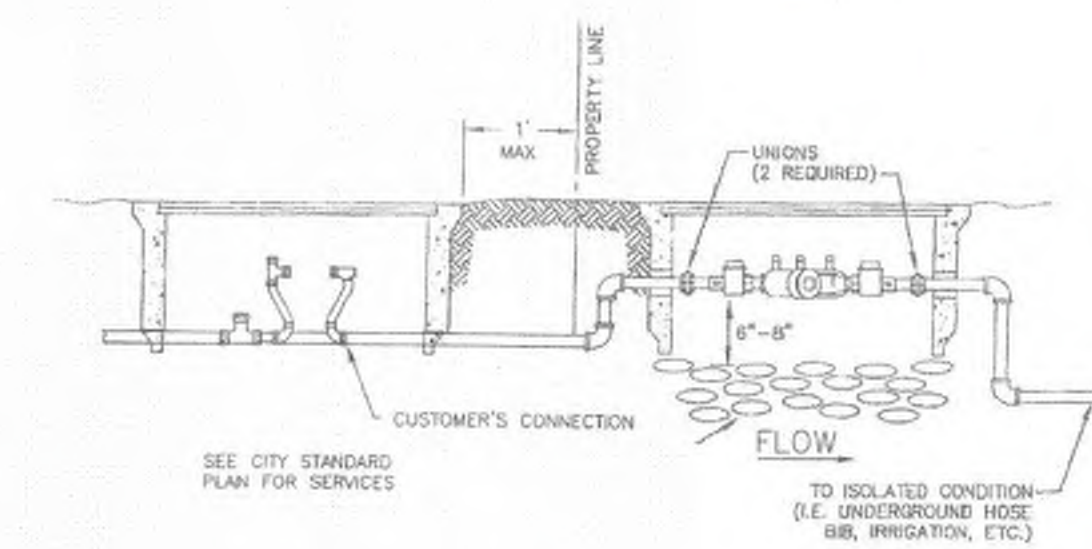

1. NOTES:
1. DEPTH MAY VARY DUE TO SITE CONDITIONS.
2. ADDITIONAL ROOM MAY BE REQUIRED FOR TESTING AND MAINTENANCE.
3. FOR INSTALLATIONS EXPOSED TO FREEZING, PROTECTION MAY BE REQUIRED.
4. IF FLOODING HAZARD EXISTS, TEST COCKS MUST BE PLUGGED.
5. DCVA MUST BE ON WASHINGTON STATE DOH APPROVED LIST.
6. DCVA MUST BE TESTED UPON INSTALLATION AND THEN ANNUALLY THEREAFTER.
7. DCVA MUST BE TESTED IF MOVED OR REPAIRED.
8. ALL TESTING MUST BE PERFORMED BY A WASHINGTON STATE CERTIFIED BACKFLOW ASSEMBLY TESTER.

NOVEMBER 23, 2016

APPROVED

APPROVED _____
Public Works Director

8/11/17
Date

BELOW GROUND BOX
STANDARD DETAIL W-18
NOT TO SCALE

PROJECT LOCATION: **PIONEER FLEXSPACE, LLC**
 6407 PORTAL WAY,
 FERDALE, WASHINGTON

WATER DETAILS



JOB #: 18084	DATE: 8-30-2021
SCALE: HORIZ: N/A VERT: N/A	SHEET: C21

FIELD LOK 350® GASKET

FIELD LOK 350® Gasket

Restrained joint pipe and fittings are used in pressurized ductile iron pipelines to prevent the joints of the line from separating due to thrust forces. Thrust forces generally occur at changes of direction in the line. Usually, a calculated length of pipeline extending from the location of the thrust force is restrained in the joints so that this force can be transmitted to the soil surrounding the line. The entire pipeline is often restrained for installations in year old or for critical lines.

U.S. Pipe's FIELD LOK 350 Gasket has proven to be an extremely successful, trouble-free means of joint restraint for well over one million Ductile Iron pipe and fitting joint assemblies across North America. By simply inserting a FIELD LOK 350 Gasket into the socket of a TYTON JOINT® Pipe, Fitting or Valve, restraint is instantly achieved when the joint is assembled. Stainless steel locking supports vulcanized into the FIELD LOK 350 Gasket grip the pipe to prevent joint separation.

FIELD LOK 350 Gaskets, utilizing patented improvements, are rated by U.S. Pipe for operating pressures up to 350 psi — a rating that now matches that of Pressure Class 350 pipe — giving the engineer and user new flexibility in designing piping systems.

Underwriters Laboratories lists the 4"-24" sizes for 350 psi. Factory Mutual, utilizing a safety factor of 4, approves the 4"-16" sizes for 250 psi and the 18"-24" sizes for 200 psi service.

With the use of the FIELD LOK 350 Gasket, push-on joint Ductile Iron TYTON JOINT® Pipe or Fittings can be quickly and securely restrained as the joint is assembled. The restraint provided shall be a bottom, integral restraining system and shall be rated for 350 psi in accordance with the performance requirements of ANSI/AWWA C111/A21.11. Field cut pipe are no longer a problem to restrain. No pipe surface preparation or grinding is required for any push-on joint spigot end. With the FIELD LOK 350 Gasket in place the joints are restrained without thrust blocks, bells, grooves, rods, clamps or restraint glands resulting in savings of labor, material and time.


CAUTION: U.S. Pipe does not recommend FIELD LOK 350 Gaskets for use above ground. The long-term effect of cyclical movements can be gradual joint separation in the joint that the seal on the gasket and is compromised. Sources of cyclical movements include vibration as may be found on bridge crossings, and thermal expansion and contraction resulting from atmospheric temperature changes. These conditions are not experienced with buried pipe lines.

*See note on page 5 regarding pipe with thick coatings or tape wraps.

FIELD LOK® FIELD LOK 350®, TYTON®, TYTON JOINT® and TR FLEX® are Registered Trademarks of U.S. Pipe and Foundry Company.

ANSI/AWWA C111/A21.11 Standard for Rubber-Gasket Joints for Ductile Iron Pressure Pipe and Fittings.

FIELD LOK 350 Gaskets are available in 4"-24" sizes and the pressure rating is based on the performance requirements of ANSI/AWWA C111/A21.11.

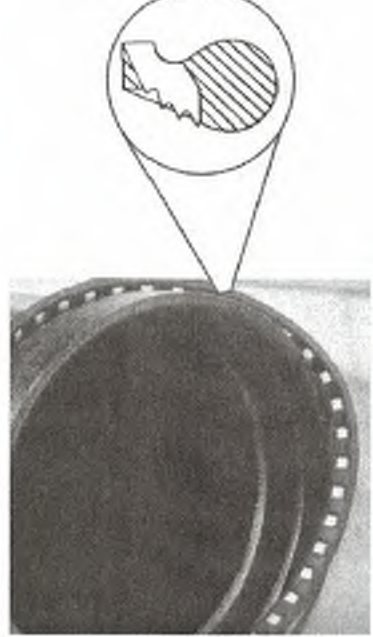

NOTE: If specifiers and users believe that corrosion will be an excavation concern, products are to be installed, please refer to ANSI/AWWA C150/A21.5 Polyethylene Encasement for Ductile Iron Pipe Systems for proper external protection procedures.

Pressure Rating: The working pressure rating of the FIELD LOK 350 Gasket Restrained Joint Systems does not exceed that of the working pressure rating of the pipe in which it is installed.

U.S. PIPE AND FOUNDRY CO. FIELD LOK 350® GASKET BRD-080

REVISED 07.12

FIELD LOK 350 GASKET

TYTON JOINT® Pipe

Thickness Class – Thicknesses, Dimensions and Weight

SIZE Inches	THICKNESS CLASS	THICKNESS Inches	OUTSIDE DIAMETER* Inches	18-FOOT LAYING LENGTH		20-FOOT LAYING LENGTH	
				AVG. WEIGHT PER FOOT† Pounds	WEIGHT PER FOOT† Pounds	AVG. WEIGHT PER FOOT† Pounds	WEIGHT PER FOOT† Pounds
4	51	0.26	4.80	215	11.3	—	—
4	52	0.29	4.80	235	12.6	—	—
4	53	0.32	4.80	260	13.8	—	—
4	54	0.35	4.80	280	15.9	—	—
4	55	0.38	4.80	300	18.1	—	—
4	56	0.41	4.80	320	17.3	—	—
6	50	0.25	6.90	305	16.0	335	16.0
6	51	0.28	6.90	335	17.8	370	17.8
6	52	0.31	6.90	370	19.6	410	19.6
6	53	0.34	6.90	400	21.4	445	21.4
6	54	0.37	6.90	435	23.2	480	23.2
6	55	0.40	6.90	465	25.0	515	25.0
6	56	0.43	6.90	495	26.7	550	26.7
8	50	0.27	9.05	430	22.8	475	22.8
8	51	0.30	9.05	475	25.2	525	25.2
8	52	0.33	9.05	520	27.7	575	27.7
8	53	0.36	9.05	560	30.1	620	30.1
8	54	0.39	9.05	605	32.5	670	32.5
8	55	0.42	9.05	650	34.8	720	34.8
8	56	0.45	9.05	690	37.2	765	37.2
10	50	0.29	11.10	570	30.1	630	30.1
10	51	0.32	11.10	625	33.2	690	33.2
10	52	0.35	11.10	680	36.2	750	36.2
10	53	0.38	11.10	730	39.2	810	39.2
10	54	0.41	11.10	785	42.1	870	42.1
10	55	0.44	11.10	840	45.1	930	45.1
10	56	0.47	11.10	890	48.0	990	48.0

NOTE: Thicknesses and dimensions of 4" through 64" Ductile Iron pipe conform to ANSI/AWWA C151/A21.51. Weights may vary from the standard because of differences in bell weights.

*Tolerance of O.D. of spigot end: 4-12 in., ±0.06 in.; 14-24 in., ±0.05 in.; 30-48 in., ±0.08 in.; 54-64 in., ±0.04 in.; >10 in.

†Including bell, calculated weight of pipe rounded off to nearest 5 lbs.


*† Including bell, average weight, per foot, based on calculated weight of pipe before rounding.

Table continued on next page.


U.S. PIPE AND FOUNDRY CO. TYTON JOINT Pipe BRD-003

REVISED 6.12


PIPE SPECIFICATIONS

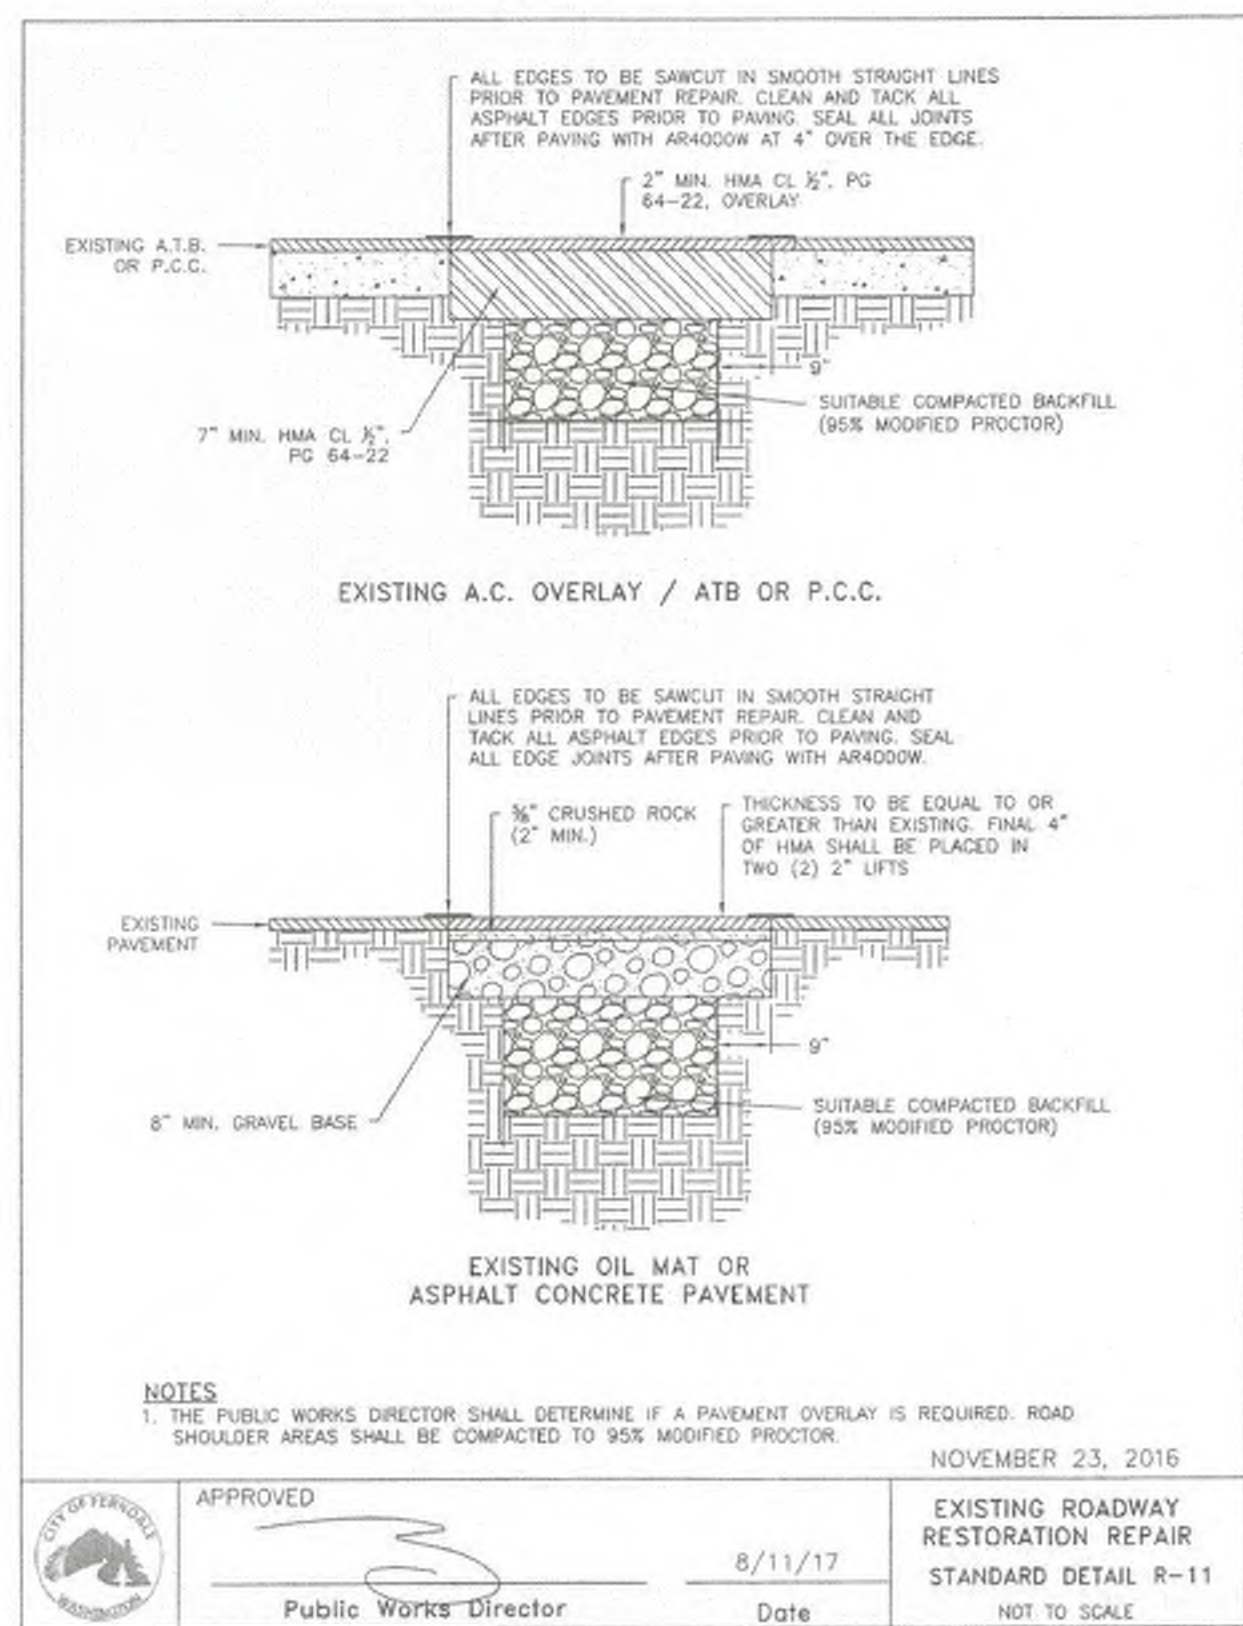


EXISTING ROADWAY RESTORATION REPAIR

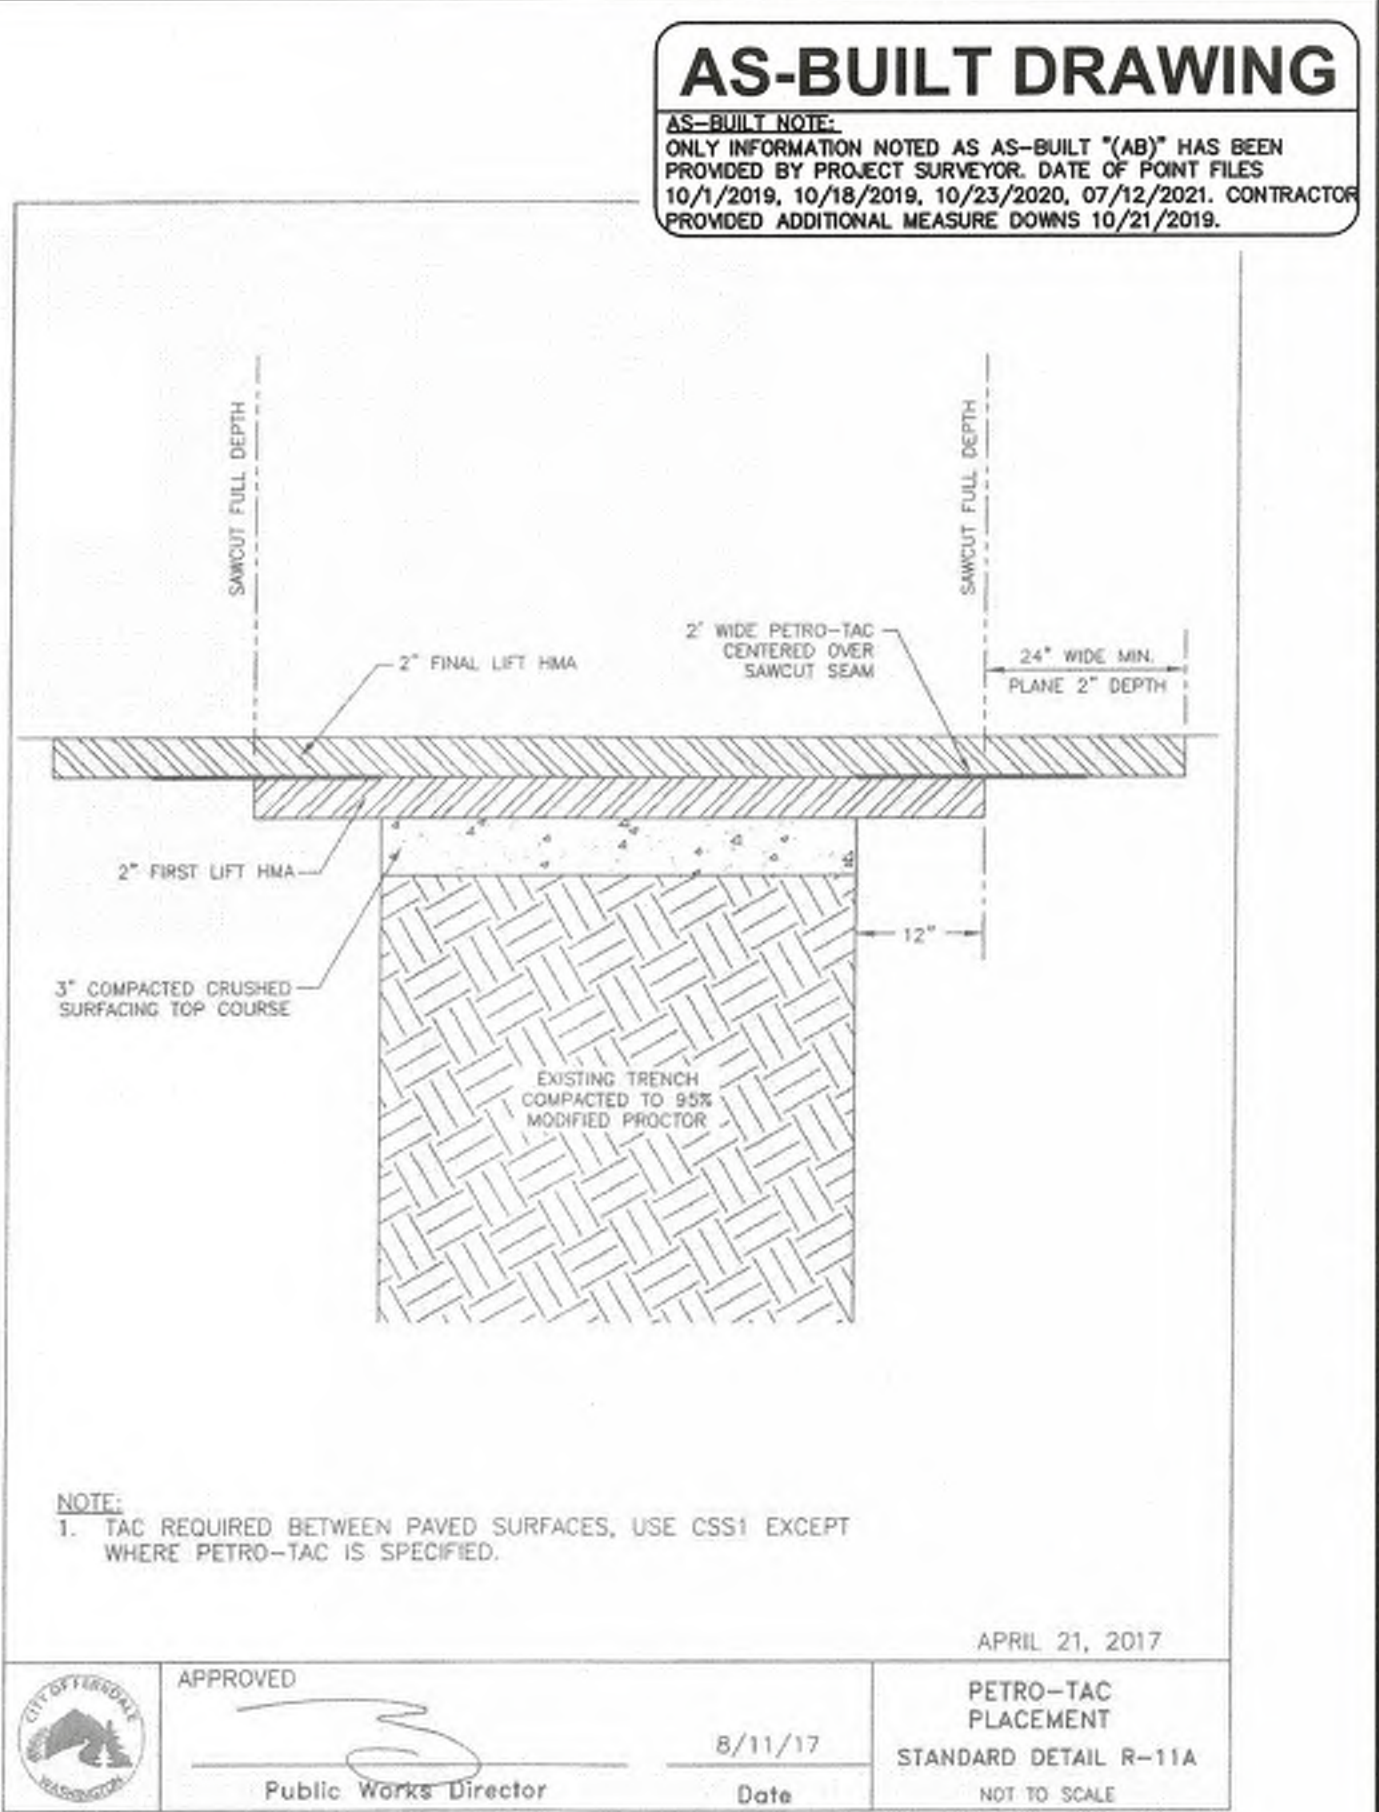


PETRO-TAC PLACEMENT

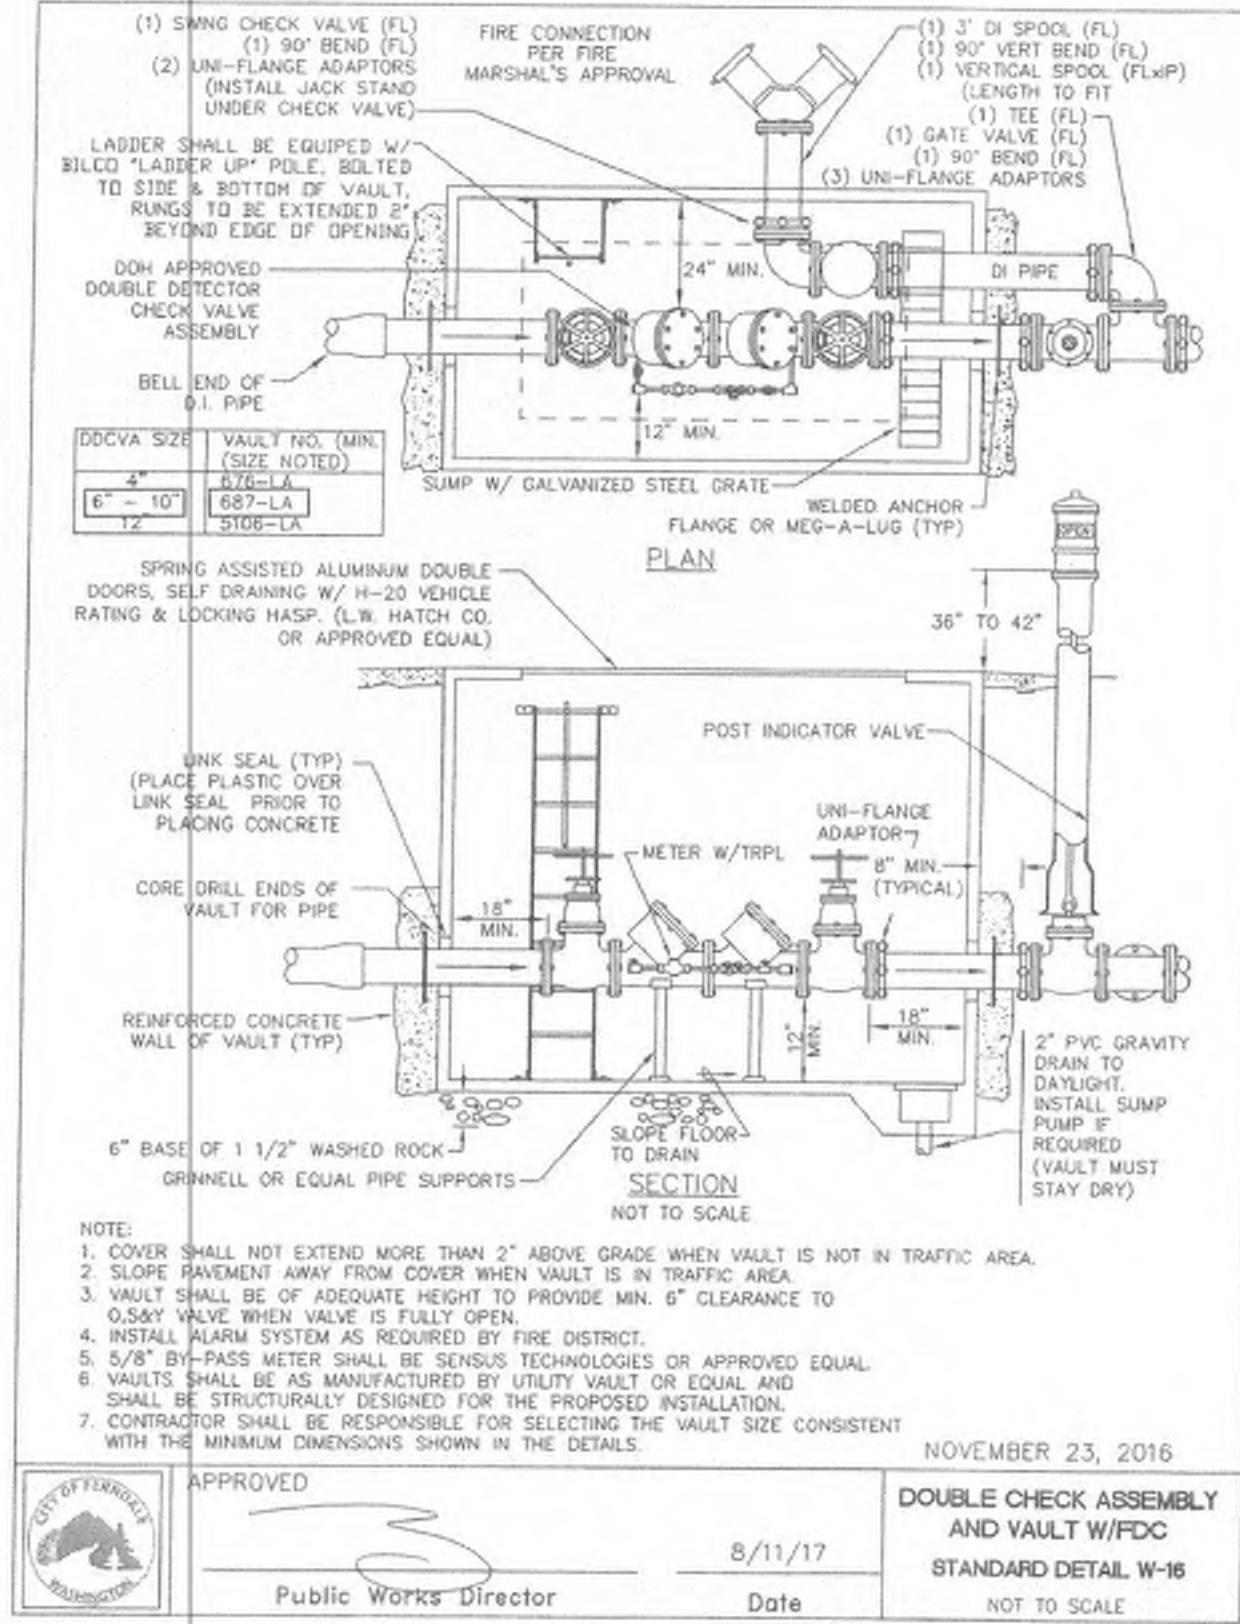


DOUBLE DETECTOR CHECK & VAULT W/ FDC

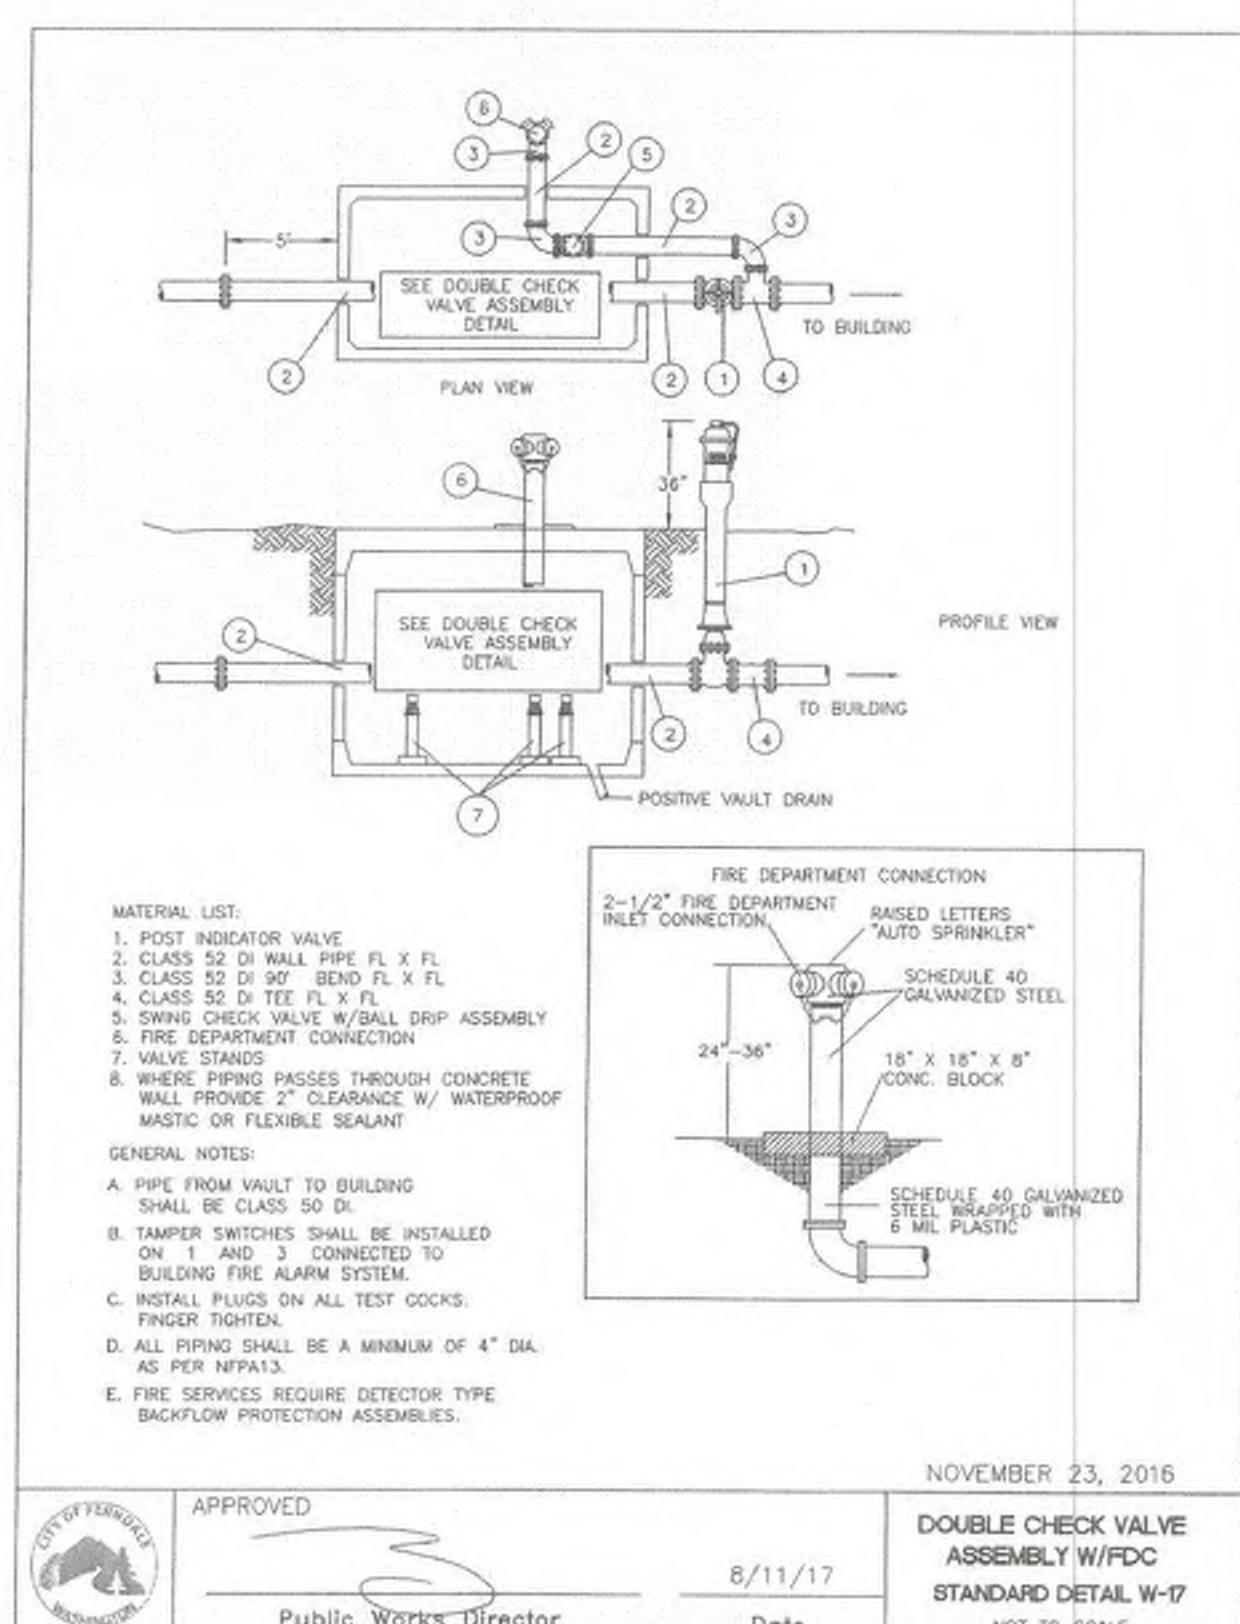

DCVA WITH FDC

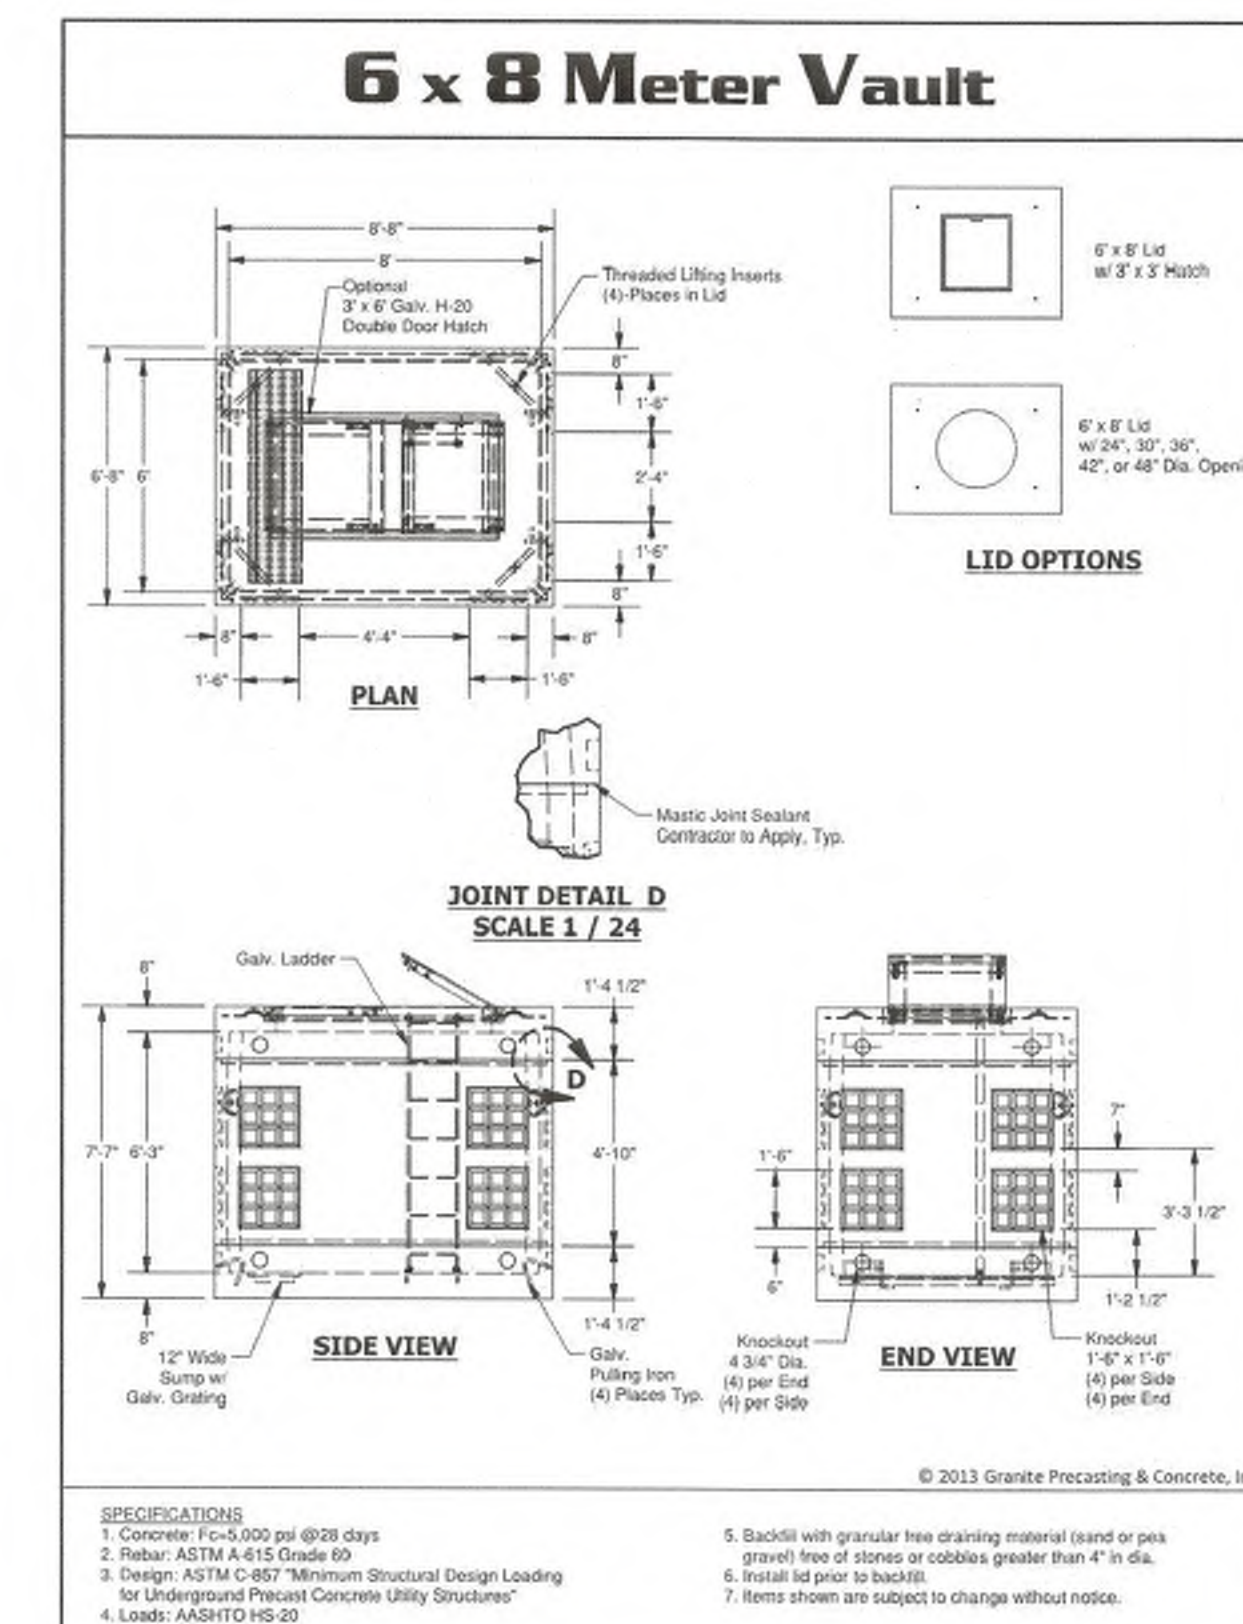

FIREMAIN DCVA 687-LA VAULT

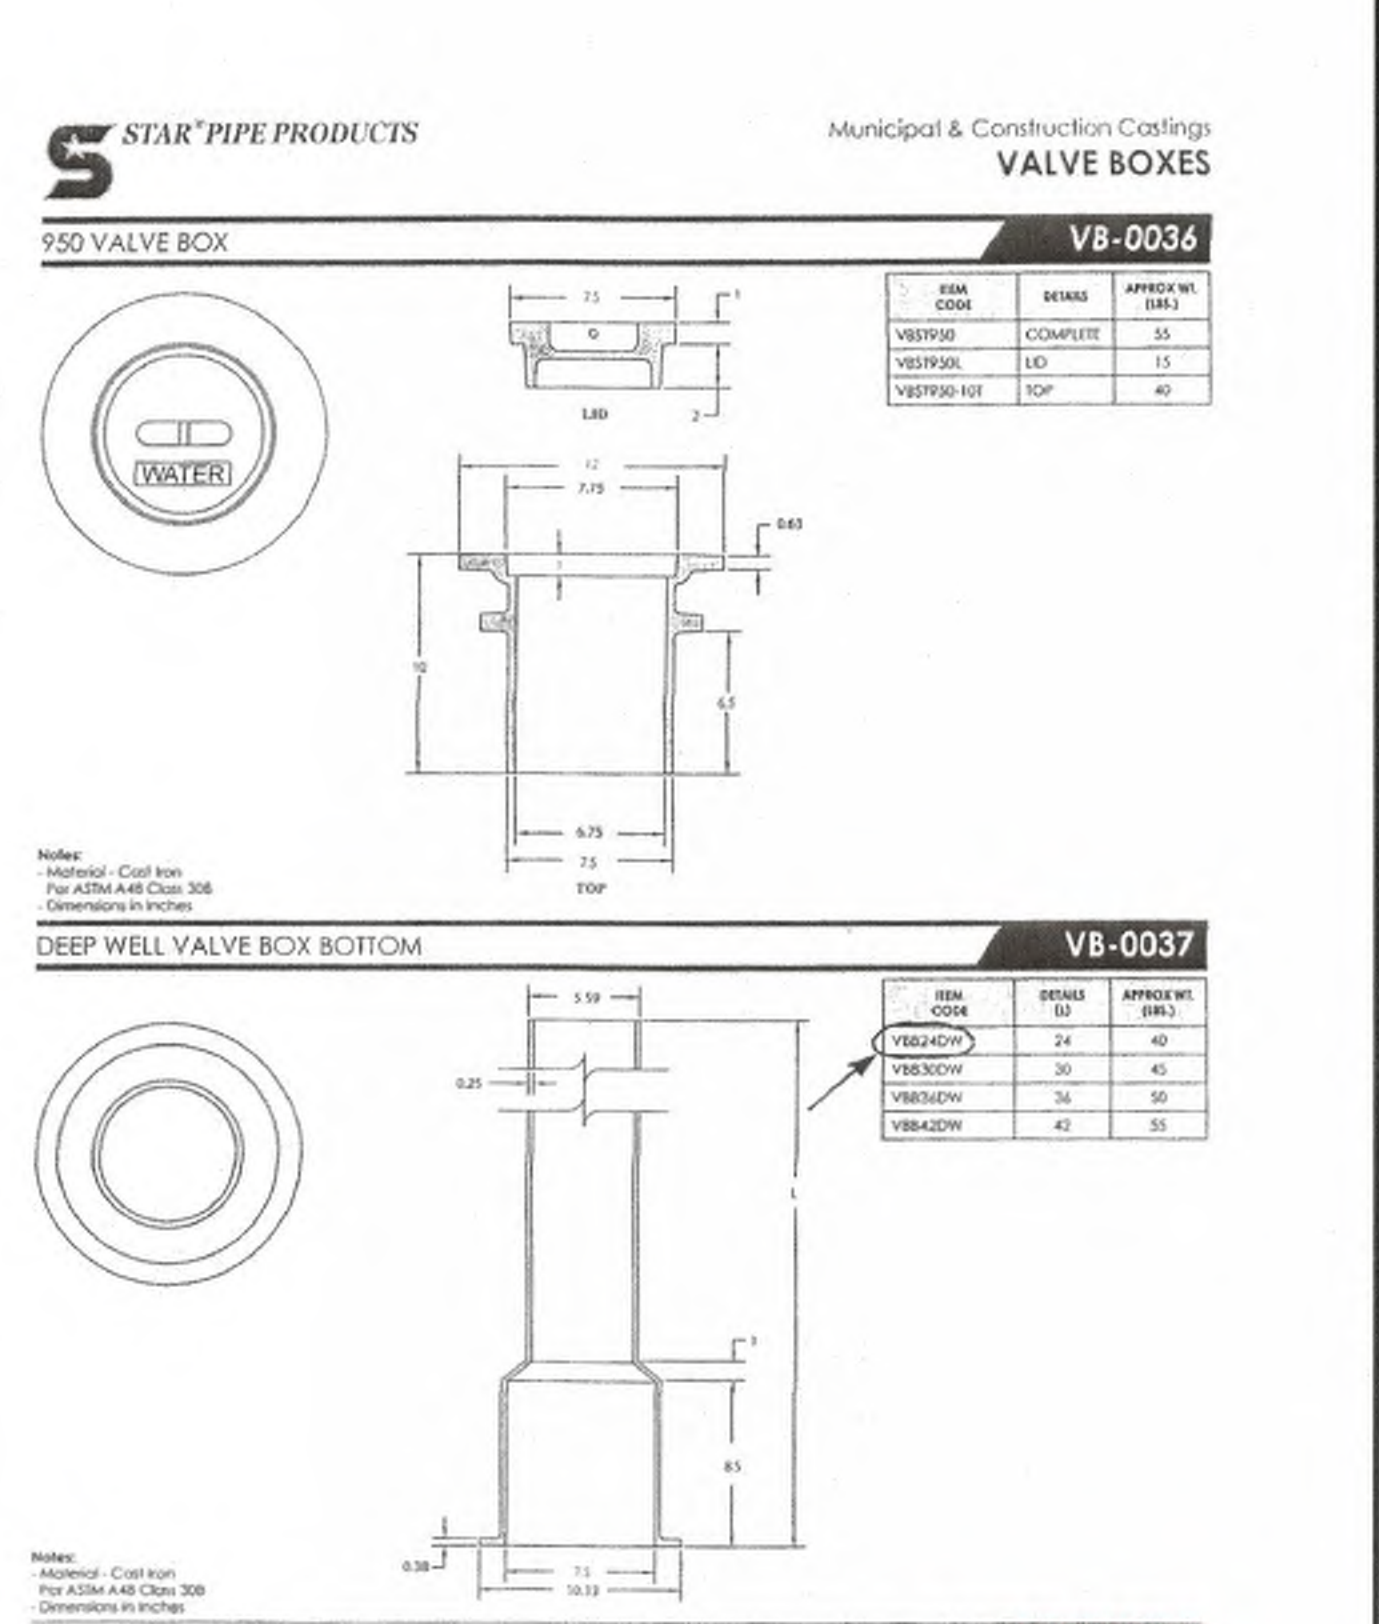

VALVE BOX

AS-BUILT DRAWING

ONLY INFORMATION NOTED AS AS-BUILT (AB) HAS BEEN PROVIDED BY PROJECT SURVEYOR. DATE OF POINT FILES 10/1/2019, 10/18/2019, 10/23/2020, 07/12/2021. CONTRACTOR PROVIDED ADDITIONAL MEASURE DOWNS 10/21/2019.

220 West Champion Street, Suite 200 • t. 360.650.1408
Bellingham, WA 98225 • f. 360.650.1401

FREELAND & ASSOCIATES

BY: [Signature] DATE: [Date]

DESCRIPTION: [Blank]

REV: [Blank] DATE: [Blank]

CLIENT: PIONEER POST FRAME
6208 PORTAL WAY
FERNDALE, WASHINGTON

CALL BEFORE YOU DIG
FOR BURIED UTILITY LOCATIONS
1-800-424-5555

PROJECT LOCATION: PIONEER FLEXSPACE, LLC
6407 PORTAL WAY
FERNDALE, WASHINGTON


DRAWING #: 18084SP26 (PHS)DWG
DESIGNED BY: HAF
CHECKED BY: HAF

SHEET CONTENTS: WATER DETAILS


STATE OF WASHINGTON
REGISTERED PROFESSIONAL ENGINEER
18084

JOB #: 18084 DATE: 8-30-2021
SCALE: HORIZ: N/A VERT: N/A SHEET: C22


00716.022 08/31/2021 RH

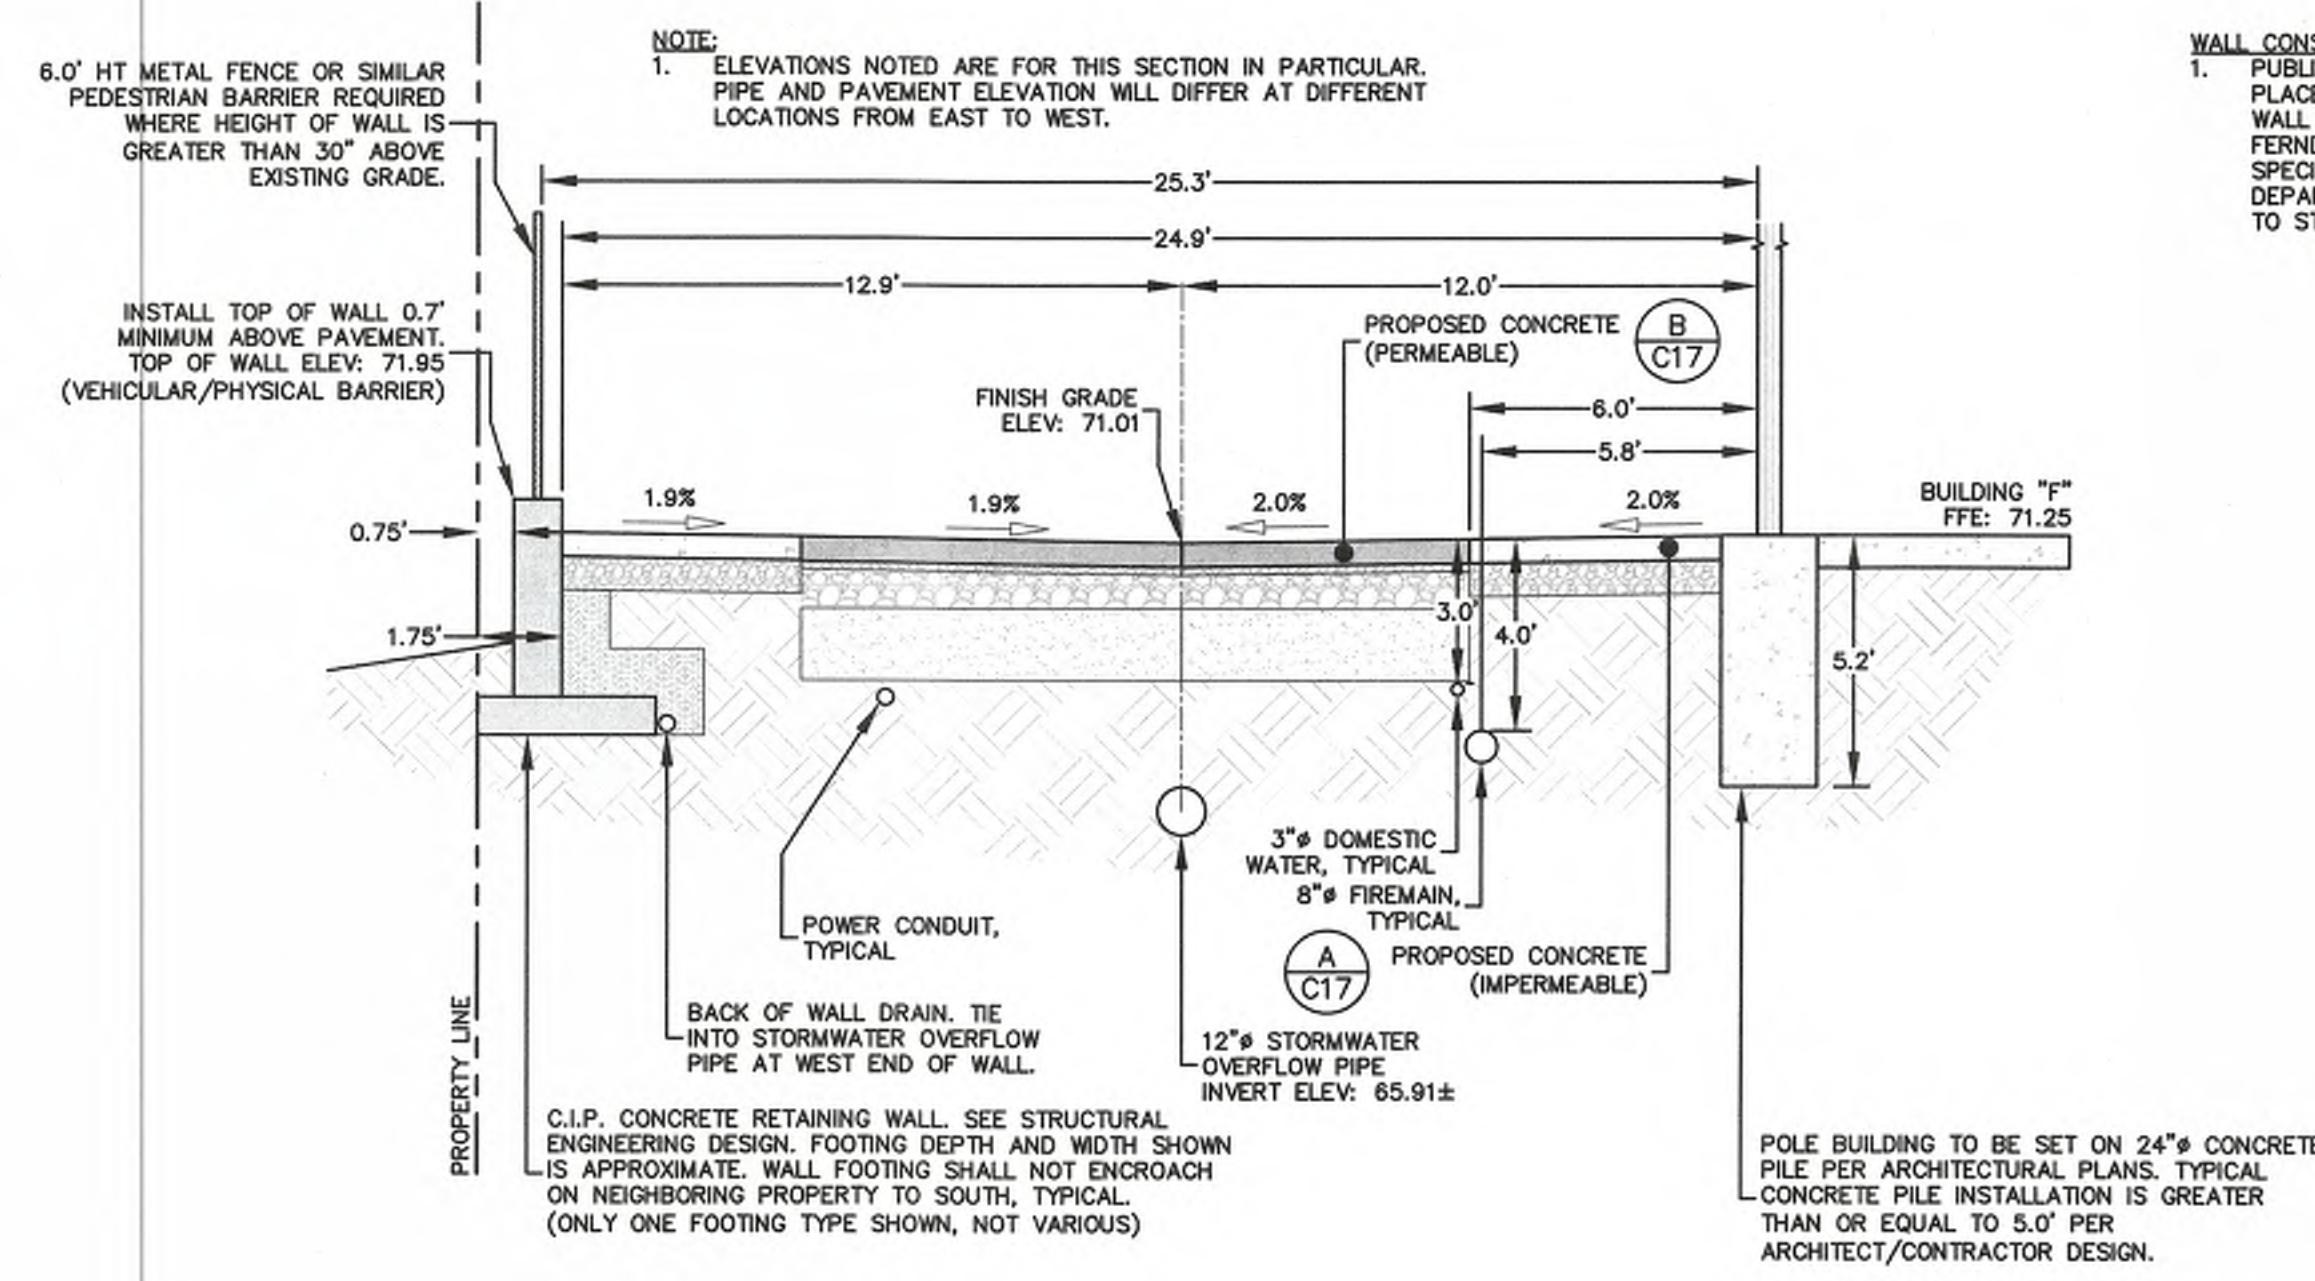



A SITE SECTION - BUILDING "F" TO PROPERTY LINE
SCALE 1" = 4'

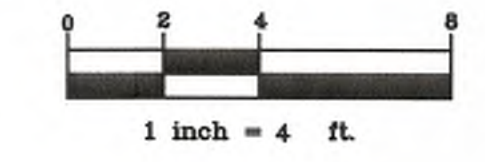



WALL CONSTRUCTION PERMIT NOTE:
1. PUBLIC WORKS CANNOT APPROVE OF RETAINING WALL PLACEMENT AND CONSTRUCTION AS PROPOSED. RETAINING WALL PERMITS MUST BE OBTAINED THROUGH THE CITY OF FERNDALE BUILDING DEPARTMENT. RETAINING WALL PLANS AND SPECIFICATIONS WILL BE SUBMITTED TO THE BUILDING DEPARTMENT FOR REVIEW AND APPROVAL SEPARATELY PRIOR TO START OF CONSTRUCTION.

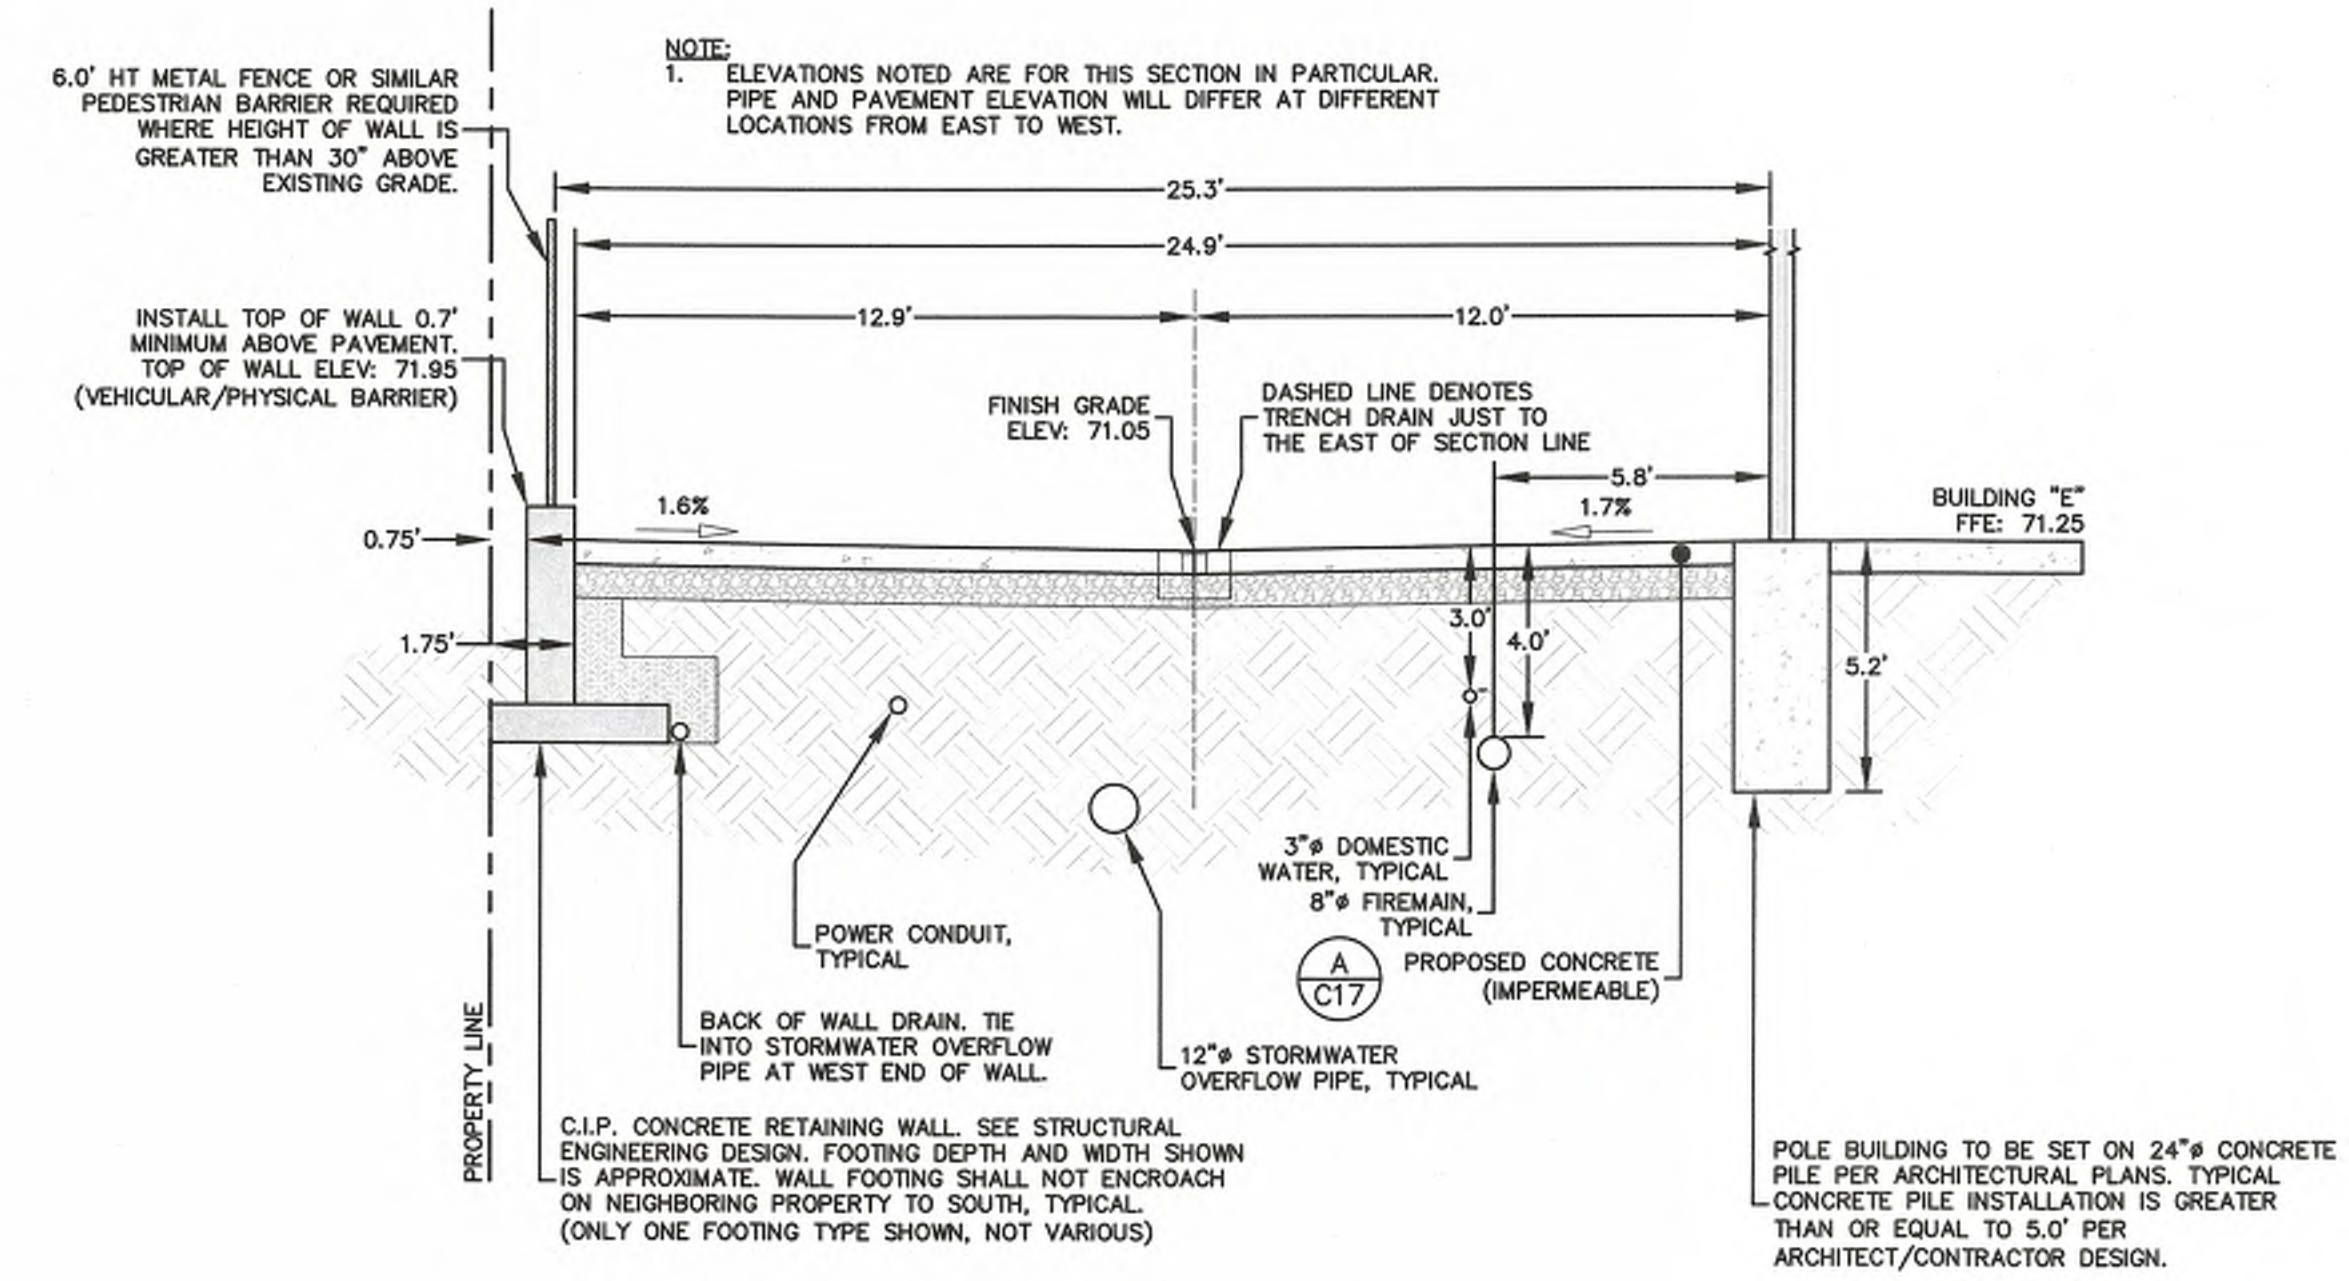


B SITE SECTION - BUILDING "E" TO PROPERTY LINE
SCALE 1" = 4'

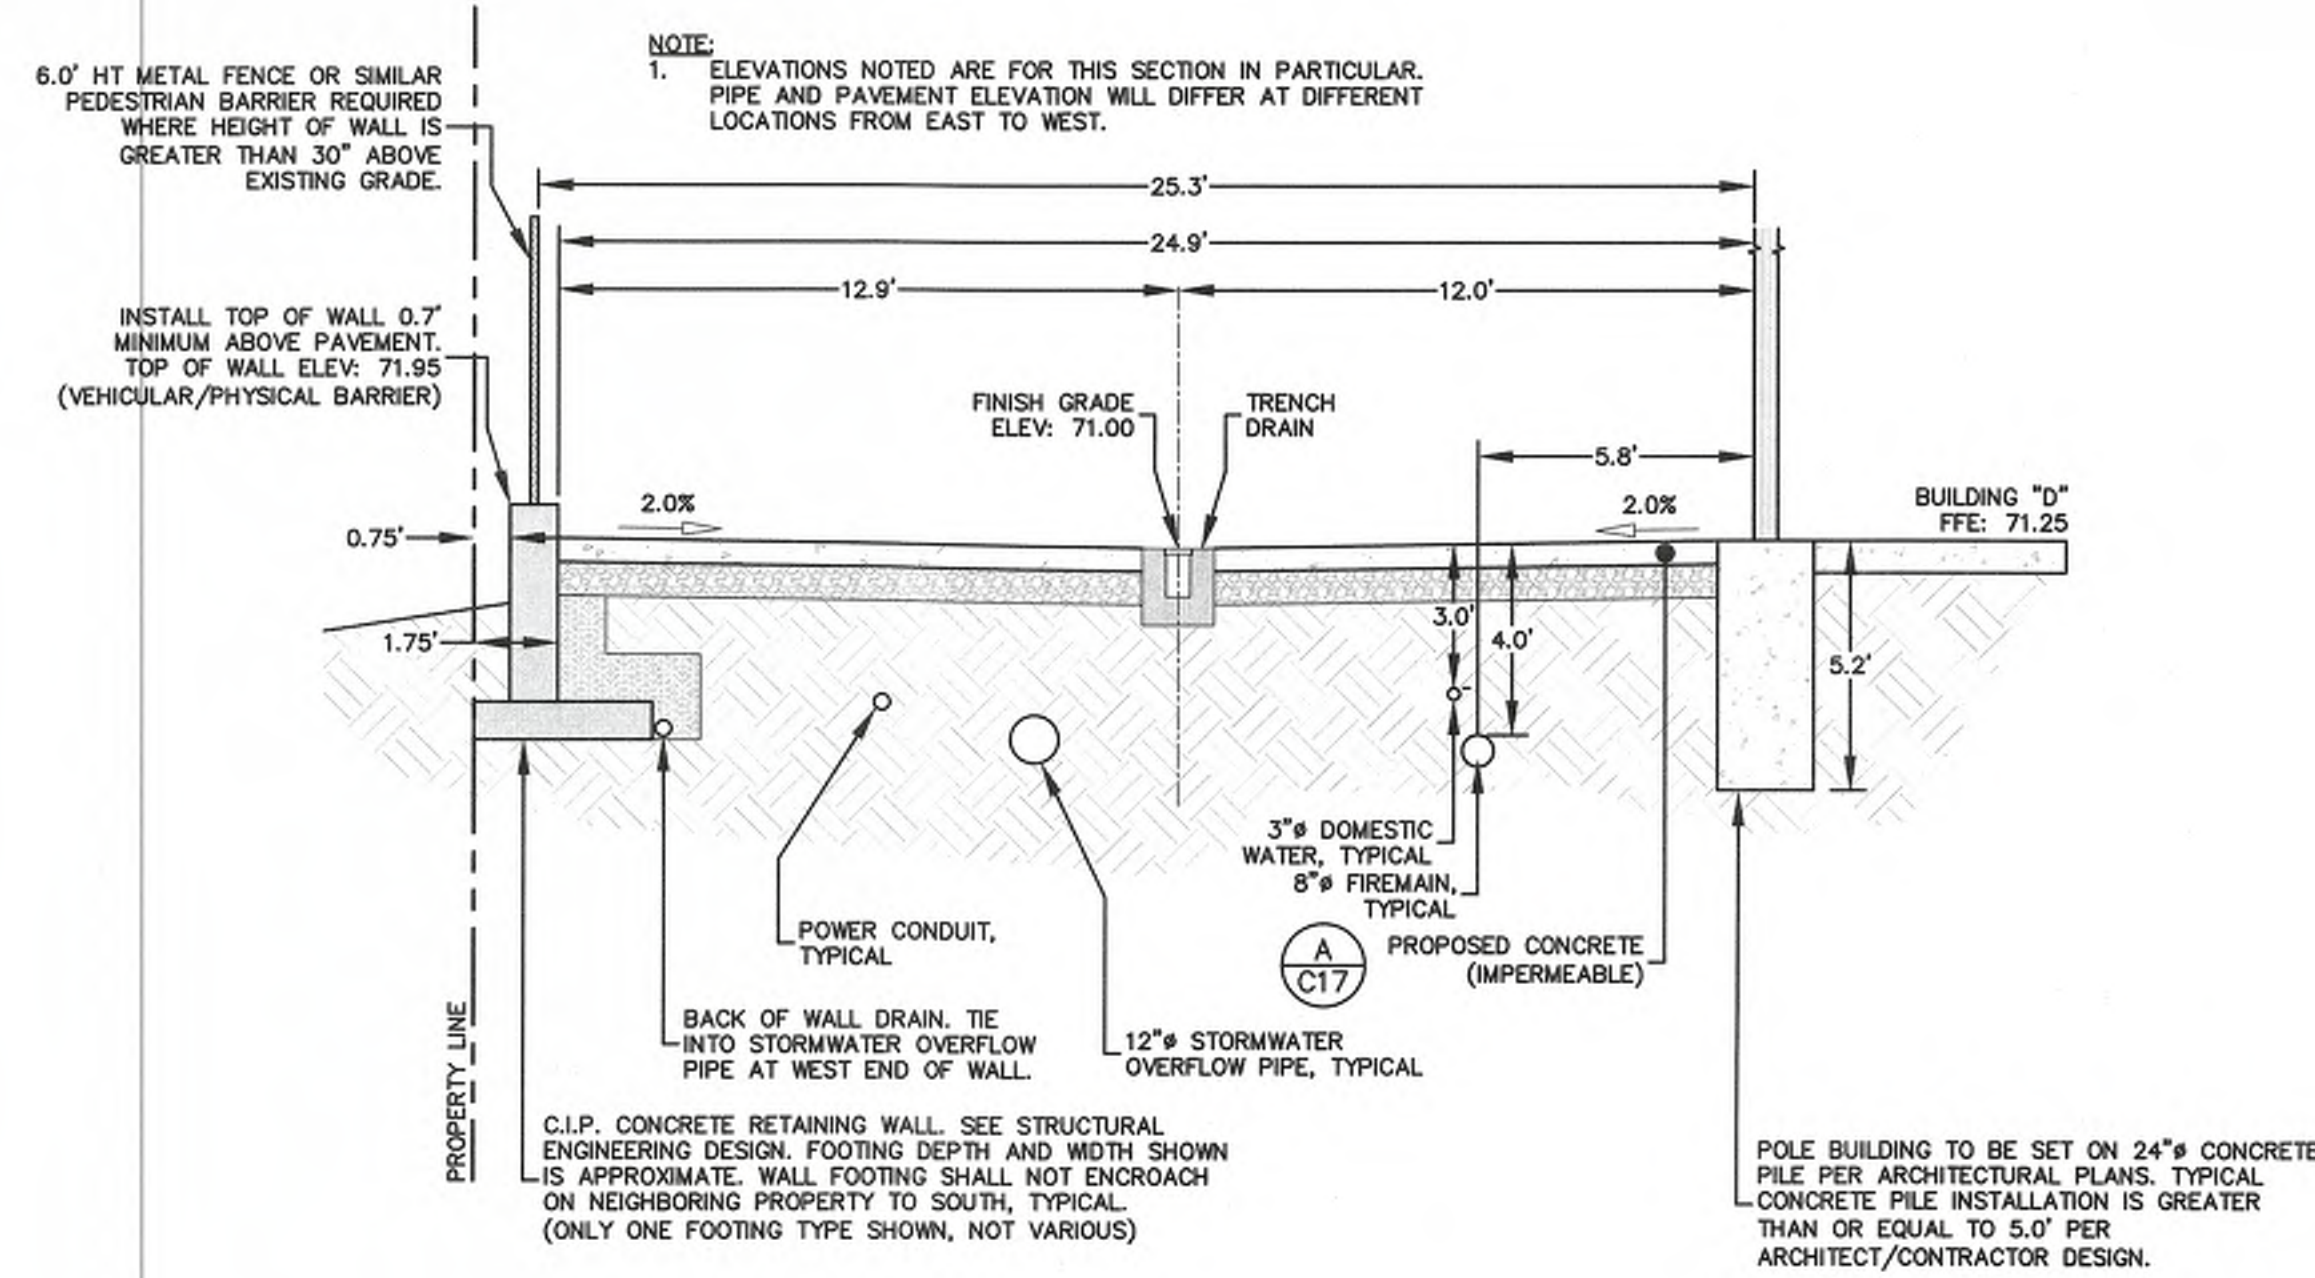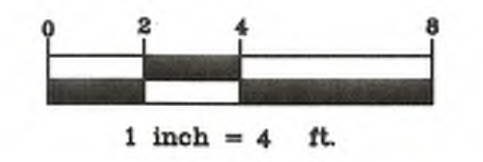

C SITE SECTION - BUILDING "D" TO PROPERTY LINE
SCALE 1" = 4'

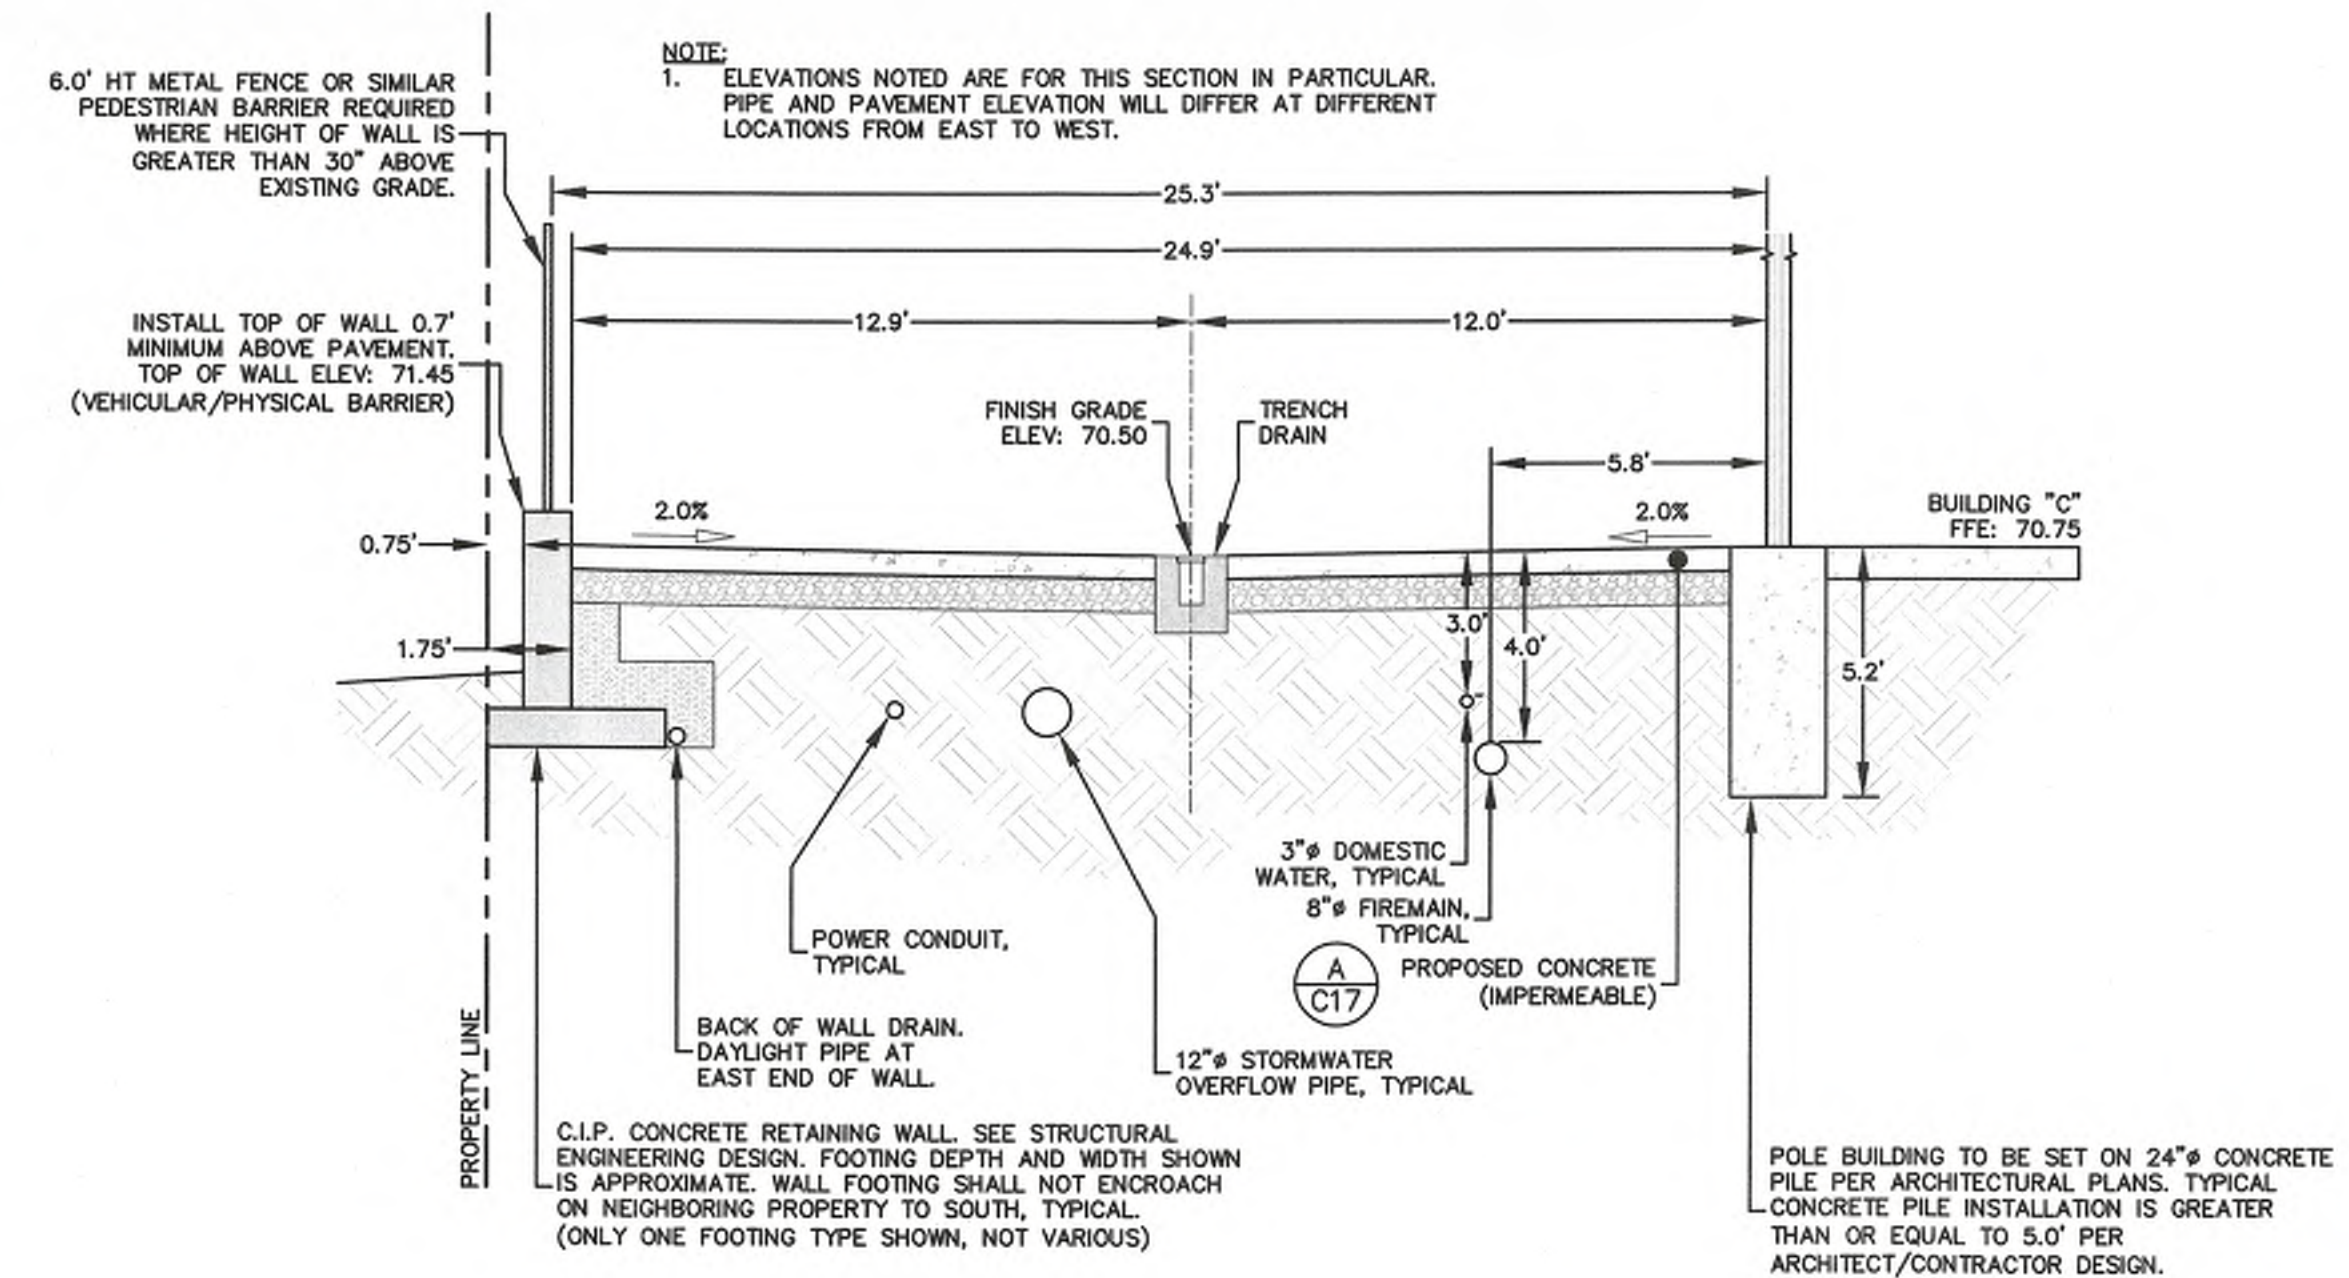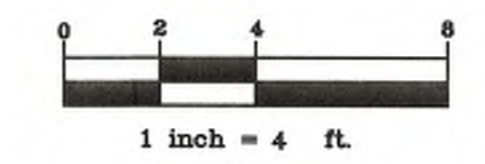


D SITE SECTION - BUILDING "C" TO PROPERTY LINE
SCALE 1" = 4'

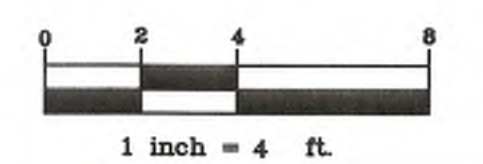


AS-BUILT DRAWING
AS-BUILT NOTE:
ONLY INFORMATION NOTED AS AS-BUILT (AB) HAS BEEN PROVIDED BY PROJECT SURVEYOR. DATE OF POINT FILES 10/1/2019, 10/18/2019, 10/23/2020, 07/12/2021. CONTRACTOR PROVIDED ADDITIONAL MEASURE DOWNS 10/21/2019.

APPROVED
AUG 9 1 2021
BY: [Signature]
CITY OF FERNDALE
PUBLIC WORKS DEPARTMENT


 220 West Champion Street, Suite 200 Bellevue, WA 98225 T: 360.650.1408 F: 360.650.1401 FREELAND & ASSOCIATES	
BY:	
DESCRIPTION:	
REV:	
DATE:	
CLIENT:	PIONEER POST FRAME 6208 PORTAL WAY FERNDAL E, WASHINGTON
PROJECT LOCATION:	PIONEER FLEXSPACE, LLC 6407 PORTAL WAY FERNDAL E, WASHINGTON
DRAWING #:	18084SP28 (PHS).DWG
DESIGNED BY:	HAF
CHECKED BY:	HAF
DRAWN BY:	CAL
FOR BURRED UTILITY LOCATIONS	CALL BEFORE YOU DIG 1-800-424-5555
SHEET CONTENTS:	SITE SECTIONS (BUILDING TO PROPERTY LINE)
JOB #:	18084
DATE:	8-30-2021
SCALE:	HORIZ: 1" = 4' VERT: N/A
SHEET:	C23

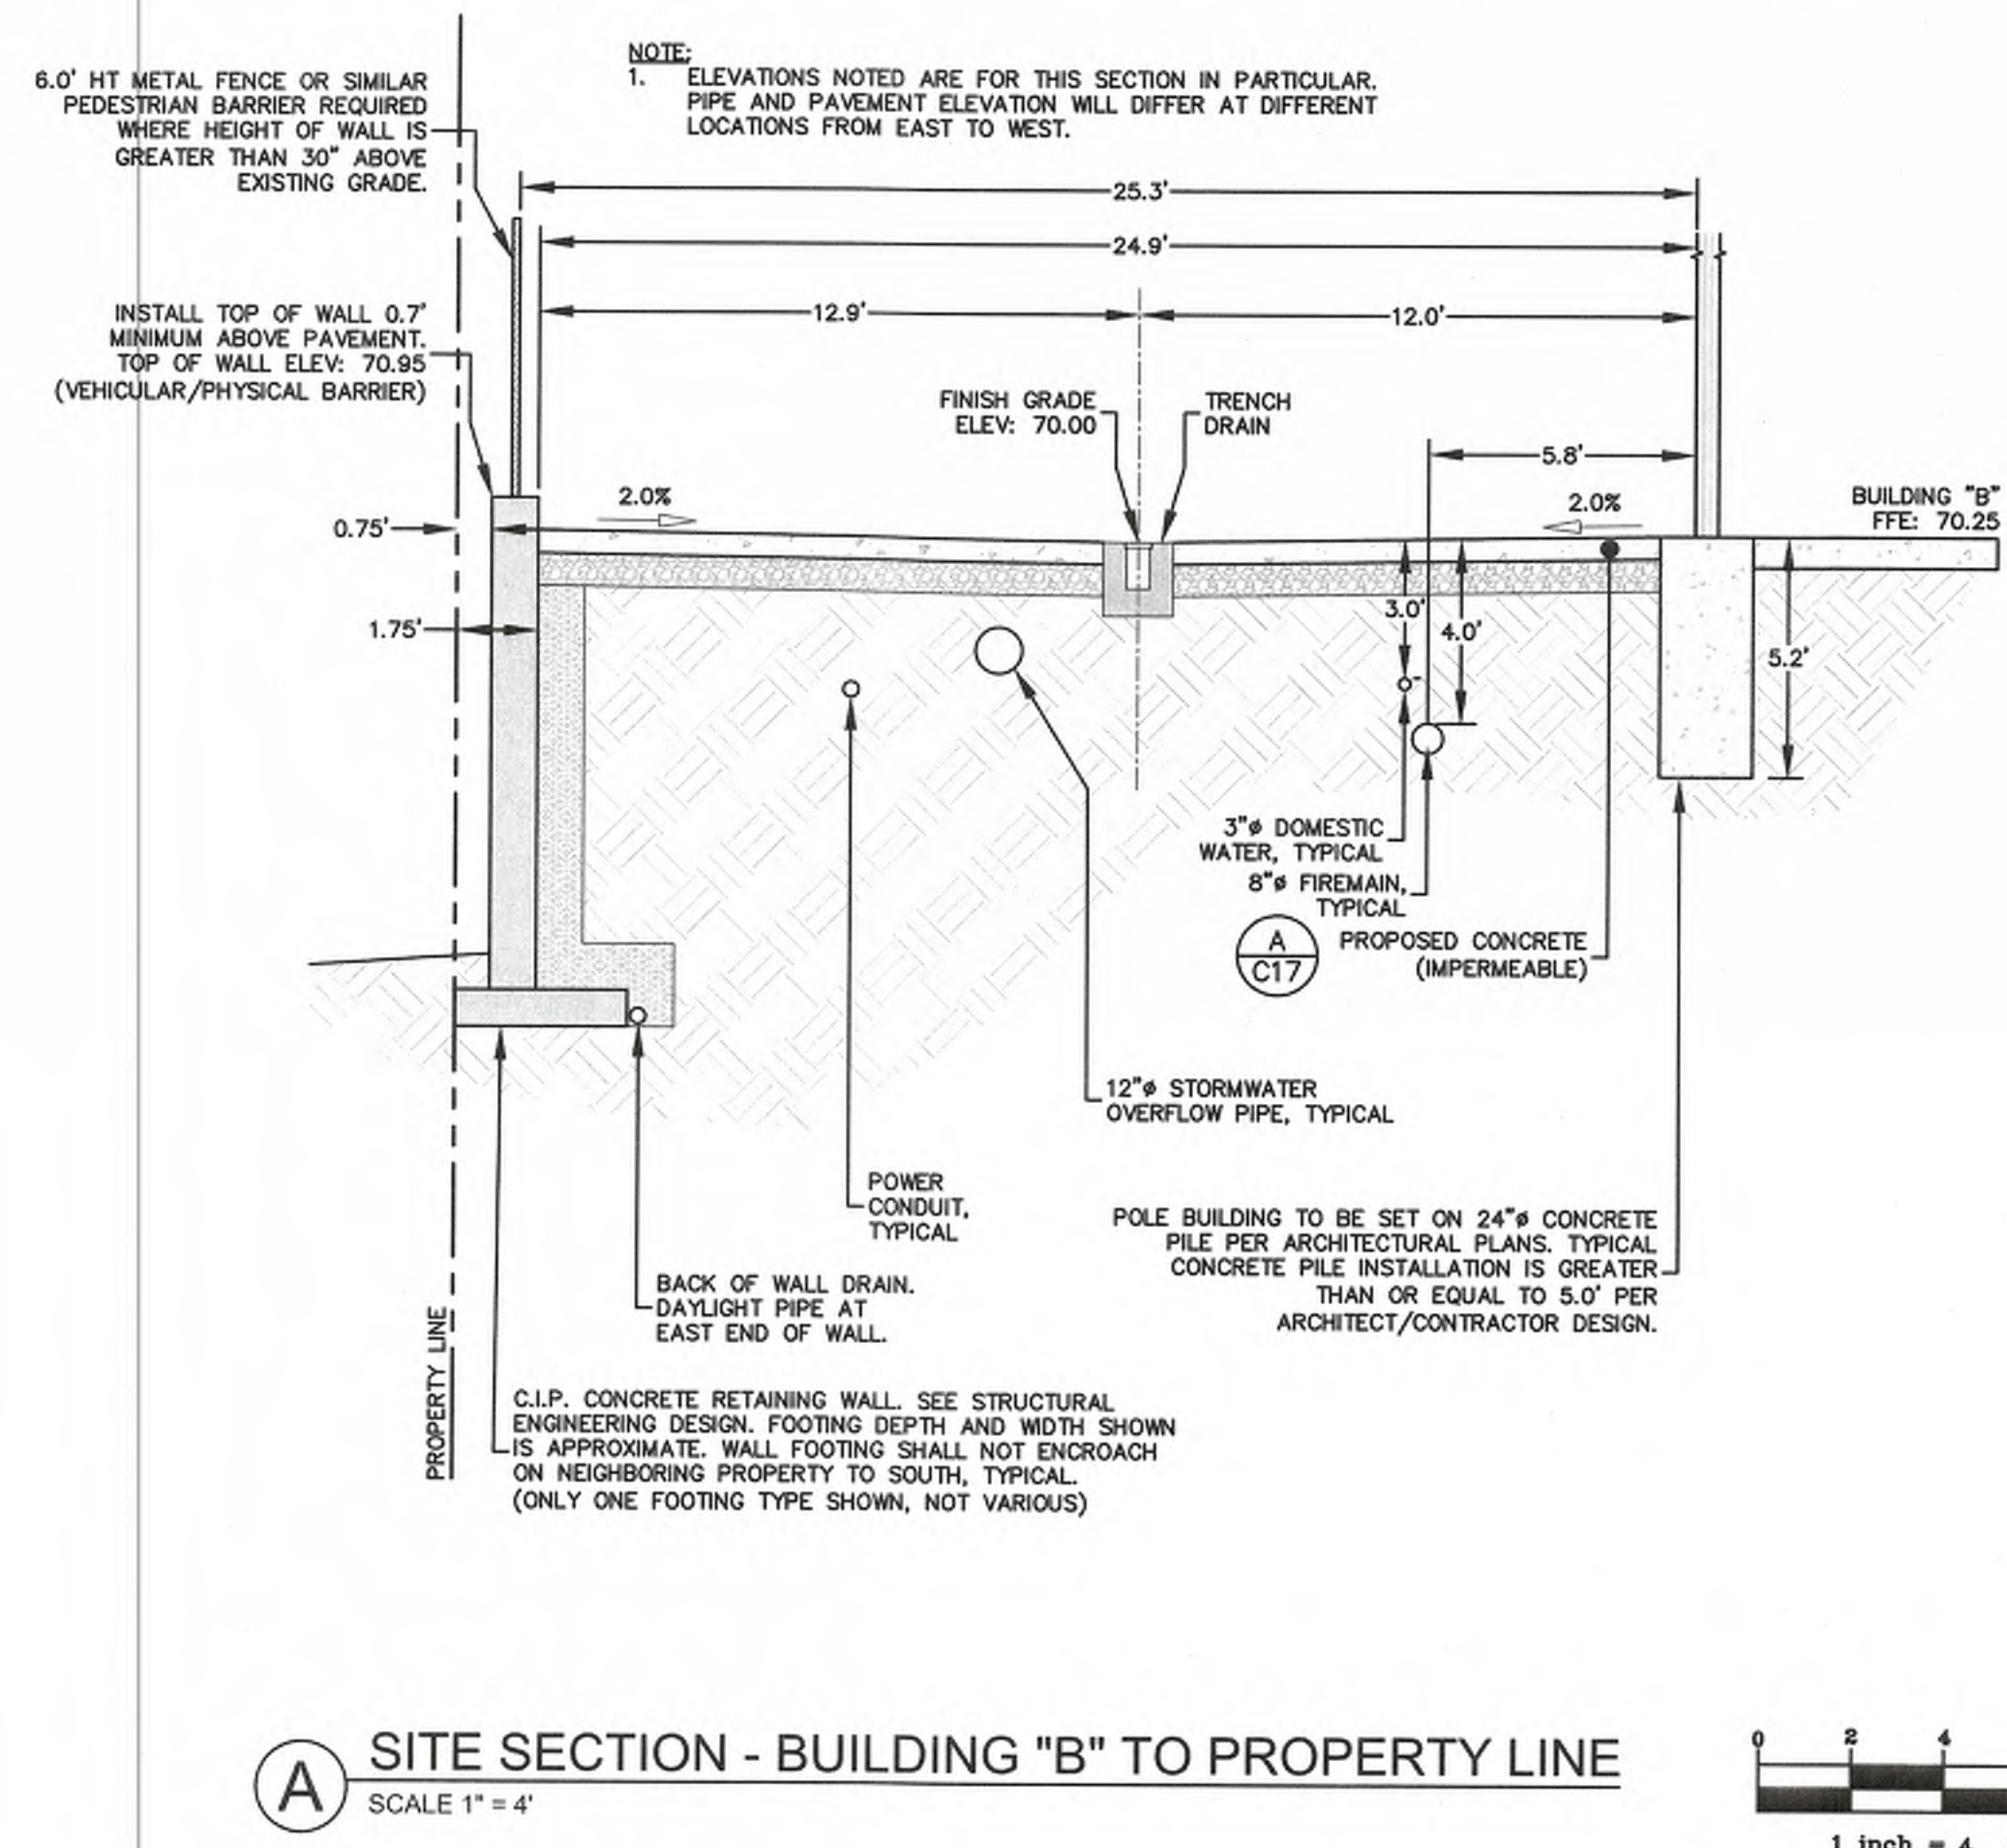

WALL CONSTRUCTION PERMIT NOTE:
1. PUBLIC WORKS CANNOT APPROVE OF RETAINING WALL PLACEMENT AND CONSTRUCTION AS PROPOSED. RETAINING WALL PERMITS MUST BE OBTAINED THROUGH THE CITY OF FERNDALE BUILDING DEPARTMENT. RETAINING WALL PLANS AND SPECIFICATIONS WILL BE SUBMITTED TO THE BUILDING DEPARTMENT FOR REVIEW AND APPROVAL SEPARATELY PRIOR TO START OF CONSTRUCTION.

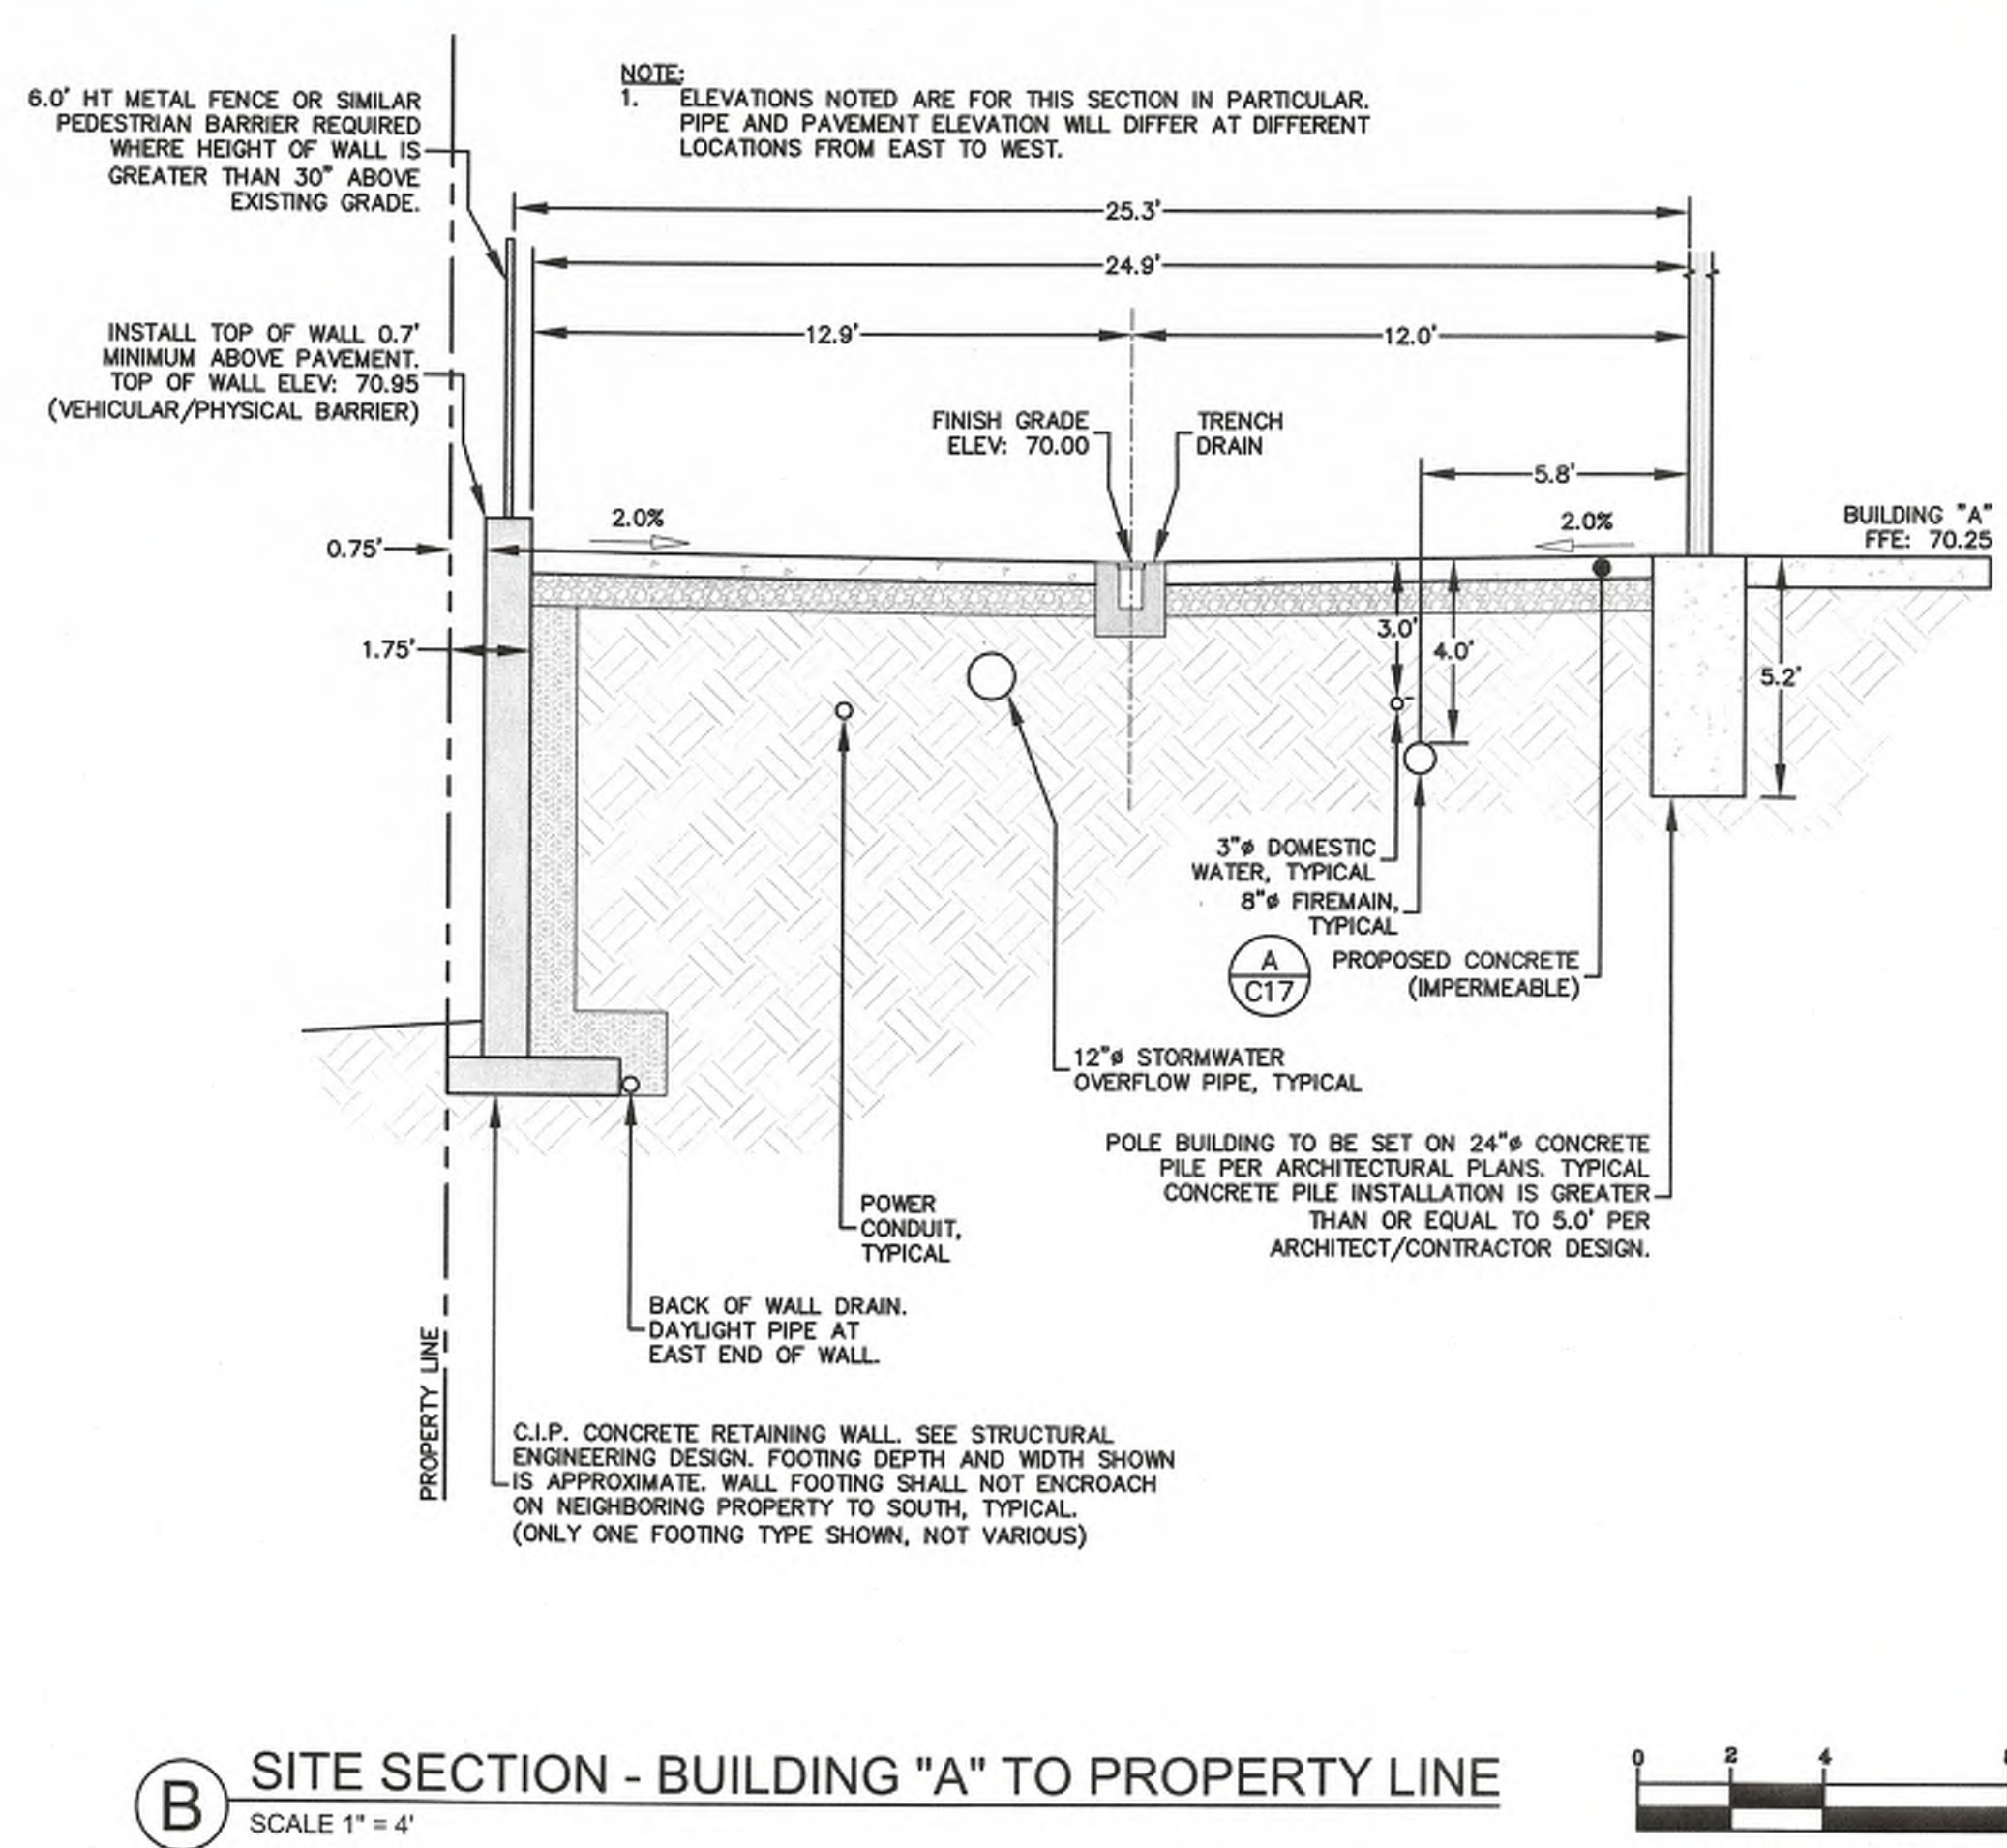

- NOTES:**
1. ELEVATIONS NOTED ARE FOR THIS SECTION IN PARTICULAR. PIPE AND PAVEMENT ELEVATION WILL DIFFER AT DIFFERENT LOCATIONS FROM EAST TO WEST.
2. ALL WATER AND STORM CROSSINGS SHALL MAINTAIN A MINIMUM 0.75' (9") CLEARANCE FOR SEPARATION.
3. FACE OF THE VALVE FLANGE ON SOUTHERN SIDE SHALL BE INSTALLED 7.5' FROM THE LOT LINE OR LESS. TO BE DETERMINED IN THE FIELD AT TIME OF CONSTRUCTION. THE REVERSE THRUST BLOCK SHALL NOT BE INSTALLED BELOW THE WALL FOOTING. THE INTENT IS TO MINIMIZE THE CONNECTION POINT OFFSET FROM THE LOT LINE WHILE MEETING APPROVED DESIGN CRITERIA SHOWN.
4. DEPTH OF WATERMAIN SHALL REMAIN AS SPECIFIED PER CITY OF FERNDALE APPROVED PLANS. WALL HEIGHT AND WATERMAIN MAY BE ADJUSTED IN THE FIELD BASED ON COORDINATION WITH SOUTHERN PROPERTY OWNER AND THEIR CITY OF FERNDALE APPROVED DESIGN GRADES AND STORMWATER TREATMENT FACILITIES.
5. THE RETAINING BOTTOM WALL SHOWN ALONG THE SOUTHERN PROPERTY LINE HAS BEEN REVISED BASED ON FINISH GRADE SURFACE PREPARED BY PACIFIC SURVEYING & ENGINEERING. BOTTOM OF FOOTING IS TO BE MINIMUM 18" BELOW FINISH GRADES SHOWN.
6. APPROXIMATE LENGTH OF WALL REVISED IS 550 LF. WALL HEIGHT ADDED VARIES FROM 0.5' TO 2.25'. APPROXIMATELY 400 LF OF WALL HAS BEEN LOWERED 2.0'. SEE SHEET C10 FOR REVISED GRADES ALONG BASE OF WALL.

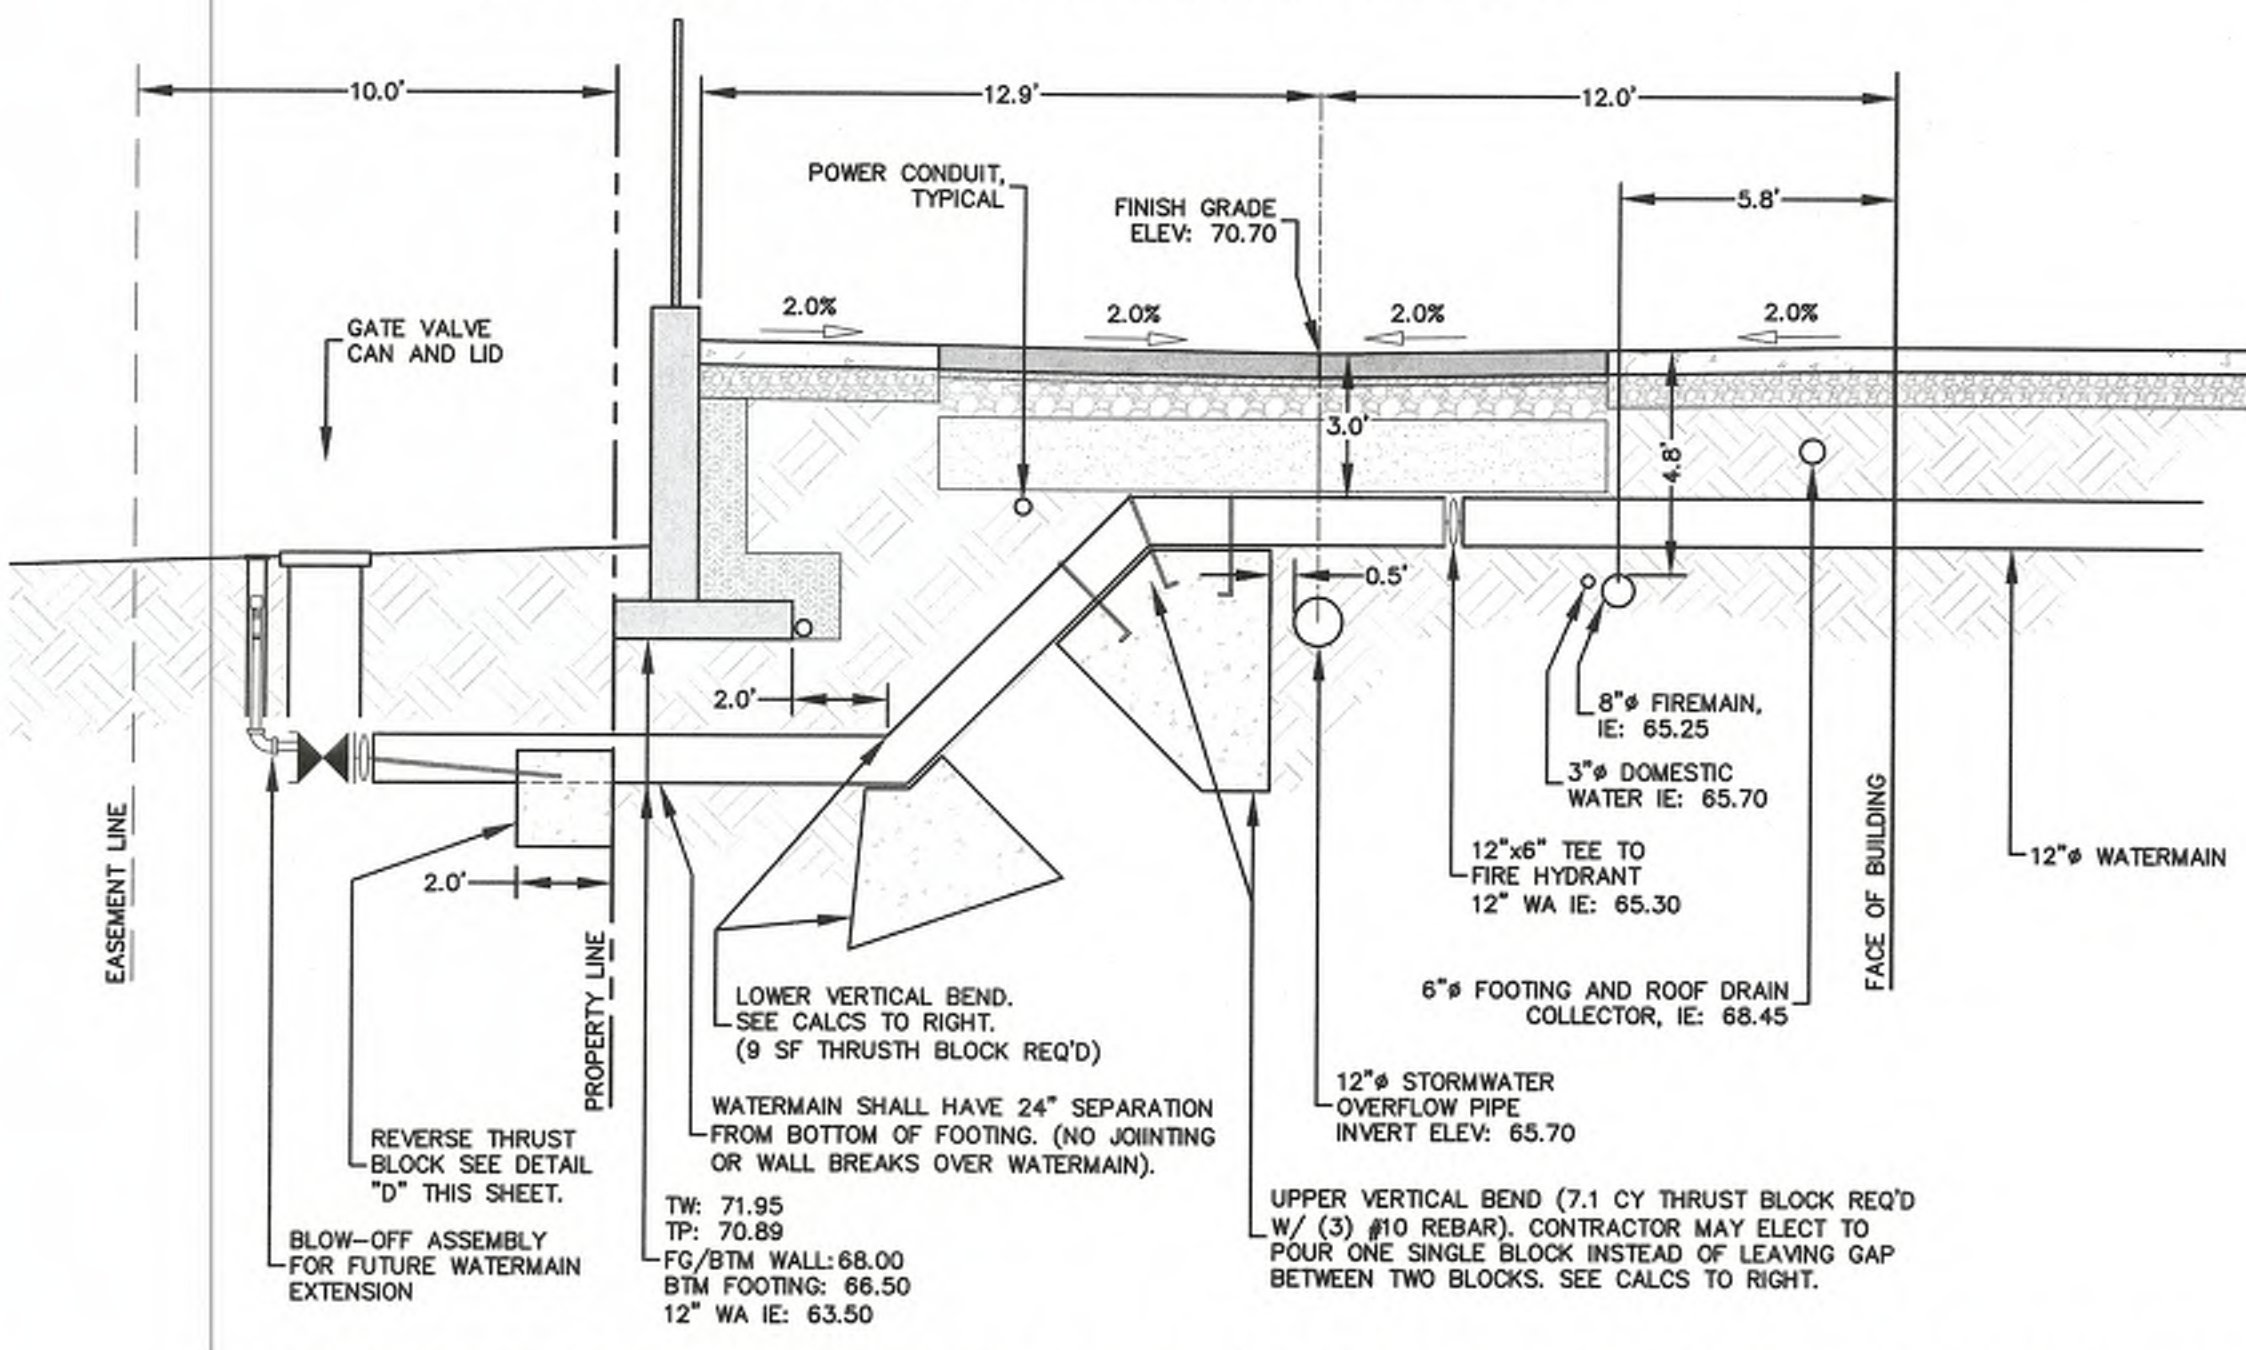


THRUST FORCE
 $P = 210 \text{ PSI}$
 $R_u = 2 \text{ PA sin } (\theta + 2)$
 $R_v = (2) (210 \text{ psi}) \times 154 \text{ in}^2 \times \sin (45 + 2)$
 $R_u = 24,752 \text{ lbs}$

UPPER VERTICAL BEND
 $W_b = L \times W \times D (150 \text{ lbs})$
 $W_b = 5' \times 10' \times 4' (150 \text{ lbs})$
 $W_b = 28,800 \text{ lbs} > 24,752 \text{ lbs}$
 $A_{reqd} = FS \times (R_u + f_v)$
 $A_{reqd} = 1.5 (24,752 \text{ lbs} + 24,000 \text{ psi})$
 $A_{reqd} = 1.55 \text{ in}^2$
 $A_{provided} = 3 \text{ bars} \times 2 \times 1.27 \text{ in}^2$
 $A_{provided} = 7.62 \text{ in}^2 > 1.55 \text{ in}^2$

LOWER VERTICAL BEND
 $A_b = L \times W$
 $A_b = 3 \text{ ft.} \times 3 \text{ ft.}$
 $A_b = 9 \text{ ft}^2$
 $P_b = R_u + A_b$
 $P_b = 24,752 \text{ lbs} + 9 \text{ ft}^2$
 $P_b = 2750 \text{ psf} < 4000 \text{ psf}$

WALL CONSTRUCTION NOTE:
THE CITY OF FERNDALE APPROVES OF THE NEW WATER MAIN CONFIGURATION PROPOSED WITHIN THE EASEMENT TO FACILITATE FUTURE DEVELOPMENT PLANS ON THE ADJACENT SOUTH PARCEL. THE WATER MAIN WILL BE INSTALLED APPROXIMATELY 2' DEEPER THAN THE ORIGINAL DESIGN AND THE HYDRANT CONFIGURATION WILL BE ALTERED TO BETTER SUIT THE ADJUSTED GRADES NEEDED TO DEVELOP THE SOUTH PARCEL. SPECIFIC CHANGES TO THE DEPTH OF FOOTING FOR THE PROJECT RETAINING WALL HAVE ALSO BEEN ADJUSTED DEEPER TO FACILITATE THE ADJACENT SOUTH PARCEL DEVELOPMENT PLAN PROJECTED FINISH GRADES. PUBLIC WORKS HAS NO OBJECTION TO THE GRADE/ELEVATION CHANGES PROPOSED FOR THE RETAINING WALL HOWEVER, DUE TO CONTRACTUAL OBLIGATIONS BETWEEN THE TWO PARTIES INVOLVED WITH THE TWO SEPARATE PARCELS THE CITY RECOMMENDS A SEPARATE THIRD PARTY INSPECTION / SURVEY BE PERFORMED TO VERIFY SPECIFIC FOOTING GRADE REQUIREMENTS HAVE BEEN MET TO SATISFY SAID CONTRACTUAL OBLIGATIONS AS THIS IS NOT PART OF THE CITY'S NORMAL INSPECTION PROCESS. PUBLIC WORKS CANNOT APPROVE STRUCTURAL CHANGES TO THE WALL AS PROPOSED AND WILL THEREFORE RECOMMEND THE APPLICANT SUBMIT THE PROPOSED CHANGES TO THE BUILDING DEPARTMENT FOR REVIEW AND APPROVAL PRIOR TO CONSTRUCTION.

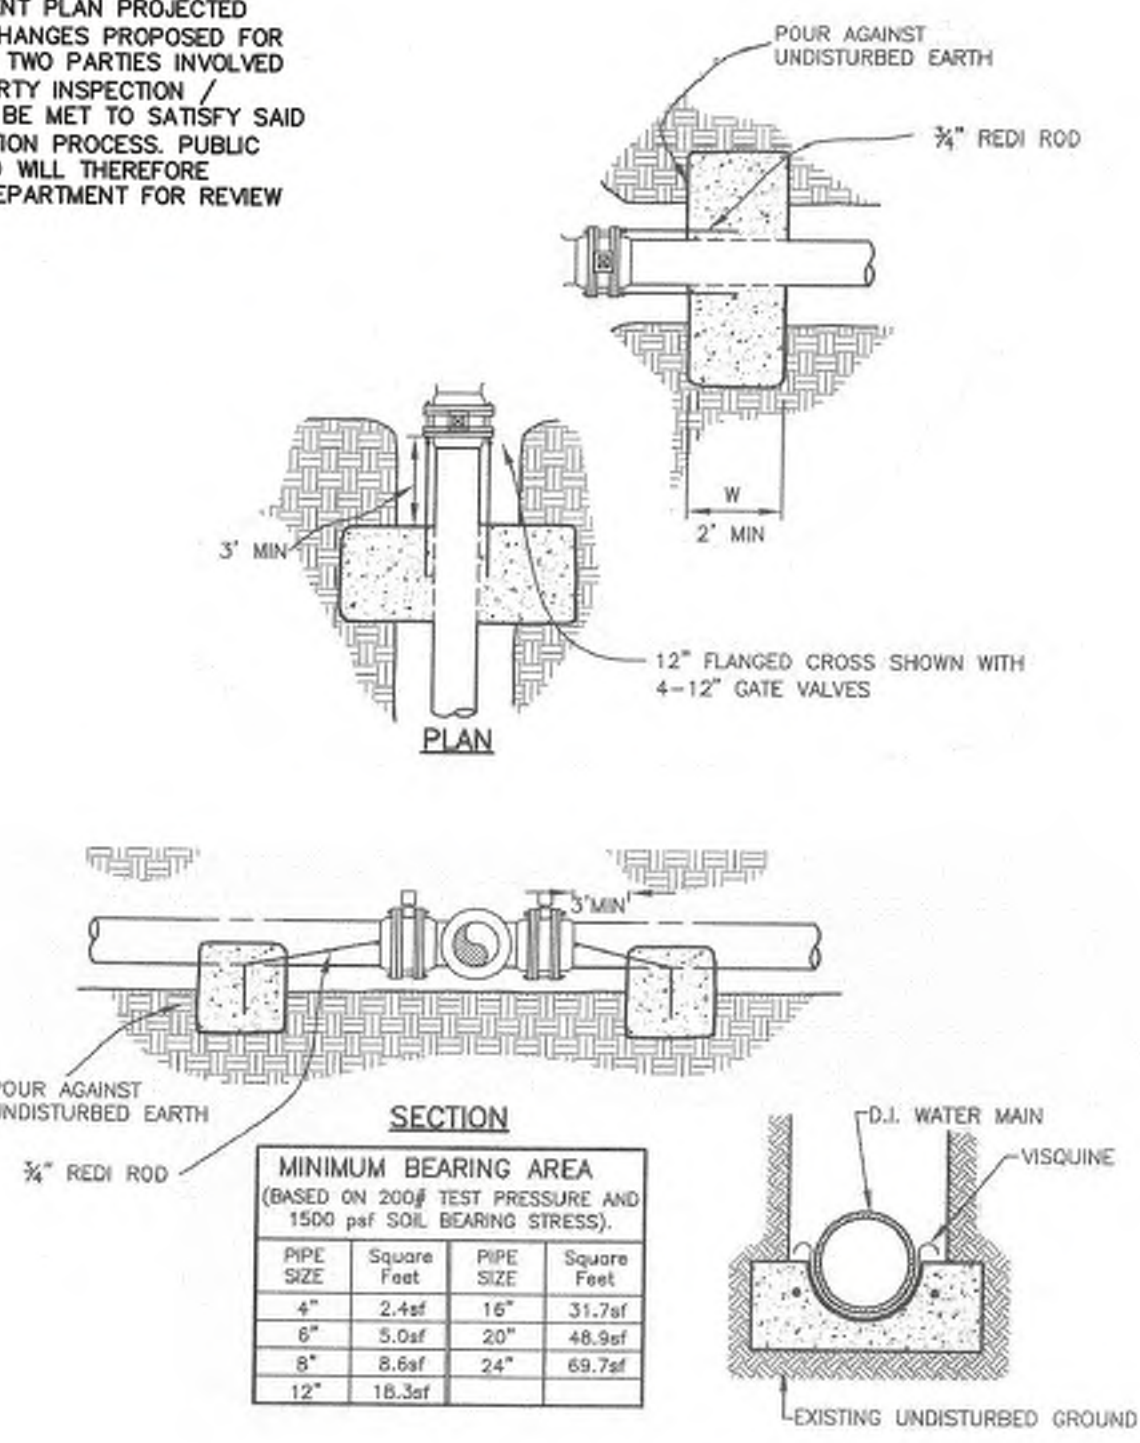

APPROVED
JUG 3.1 2021
PUBLIC WORKS DEPARTMENT

AS-BUILT DRAWING
ONLY INFORMATION NOTED AS AS-BUILT ("AB") HAS BEEN PROVIDED BY PROJECT SURVEYOR. DATE OF POINT FILES 10/1/2019, 10/18/2019, 10/23/2020, 07/12/2021. CONTRACTOR PROVIDED ADDITIONAL MEASURE DOWNS 10/21/2021.

220 West Champion Street, Suite 200
Bellingham, WA 98225
T: 360.650.1408
F: 360.650.1401

FREELAND & ASSOCIATES

BY:	HAF
DESCRIPTION:	CROSS SECTION REVISION PER OWNER REQUEST
REV:	DATE: 1/30/2019
1	

CLIENT: PIONEER FLEXSPACE, LLC
6208 PORTAL WAY
FERNDALE, WASHINGTON

FOR BURIED UTILITY LOCATIONS
CALL BEFORE YOU DIG
1-800-424-5555

PROJECT LOCATION: PIONEER FLEXSPACE, LLC
6208 PORTAL WAY
FERNDALE, WASHINGTON

DRAWN BY: C.J.L.
CHECKED BY: HAF

DESIGNED BY: HAF

SHEET CONTENTS: SITE SECTIONS (BUILDING TO PROPERTY LINE)

ARTHUR A. FREELAND II
STATE OF WASHINGTON
REGISTERED PROFESSIONAL ENGINEER
NO. 28519

JOB #: 18084
DATE: 8-30-2021

SCALE: HORIZ: 1"=4'
VERT: N/A

SHEET: C24