
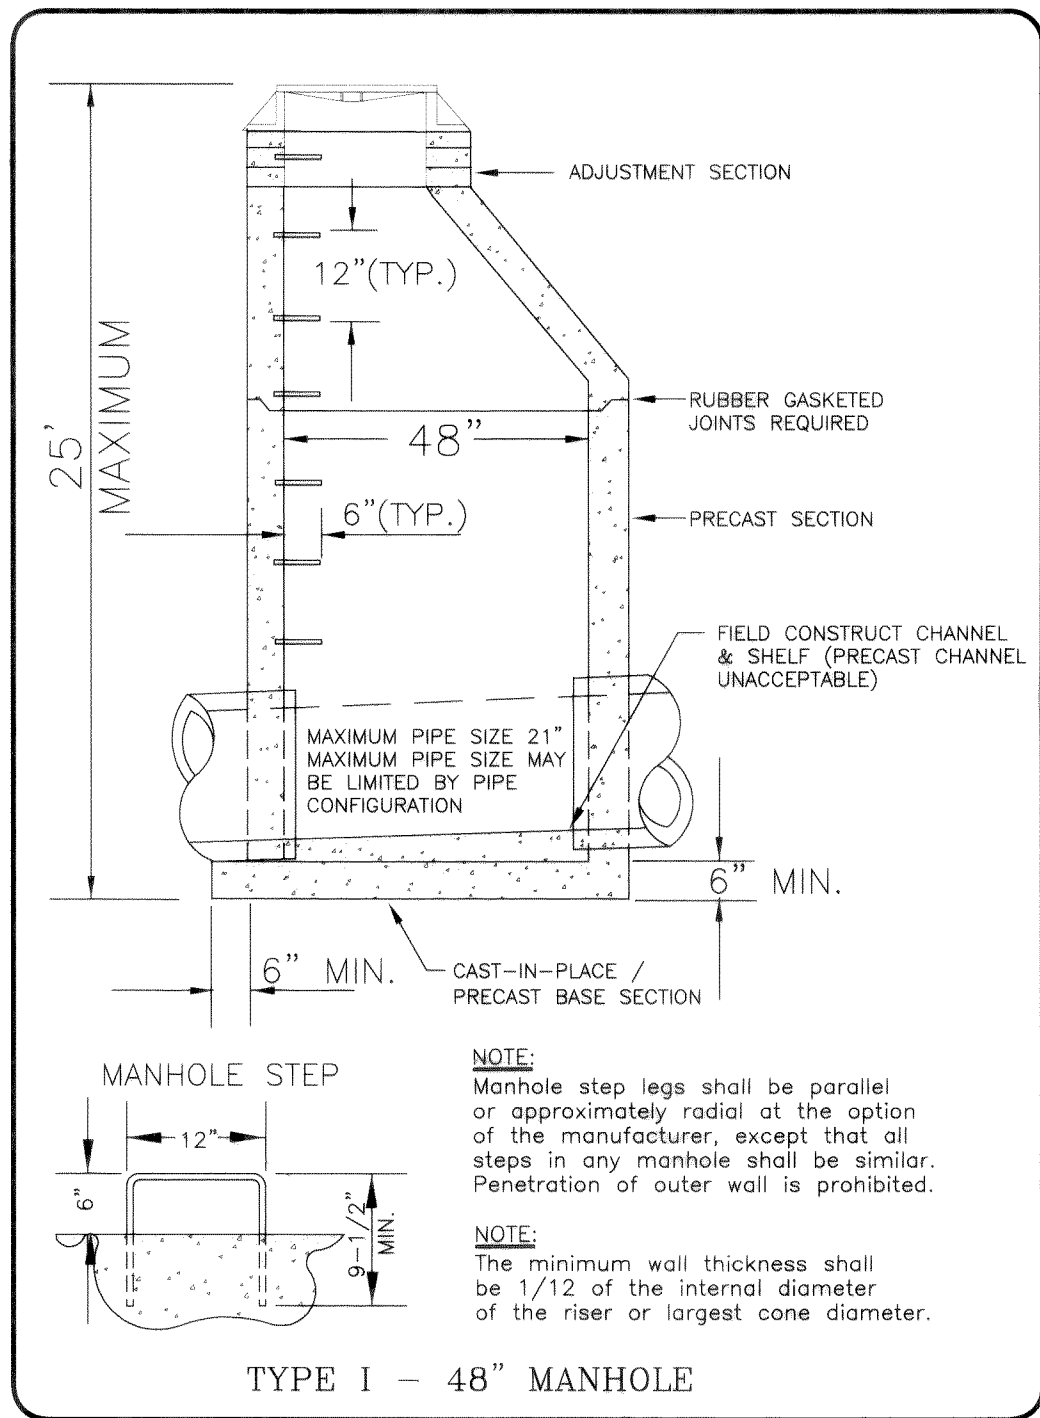
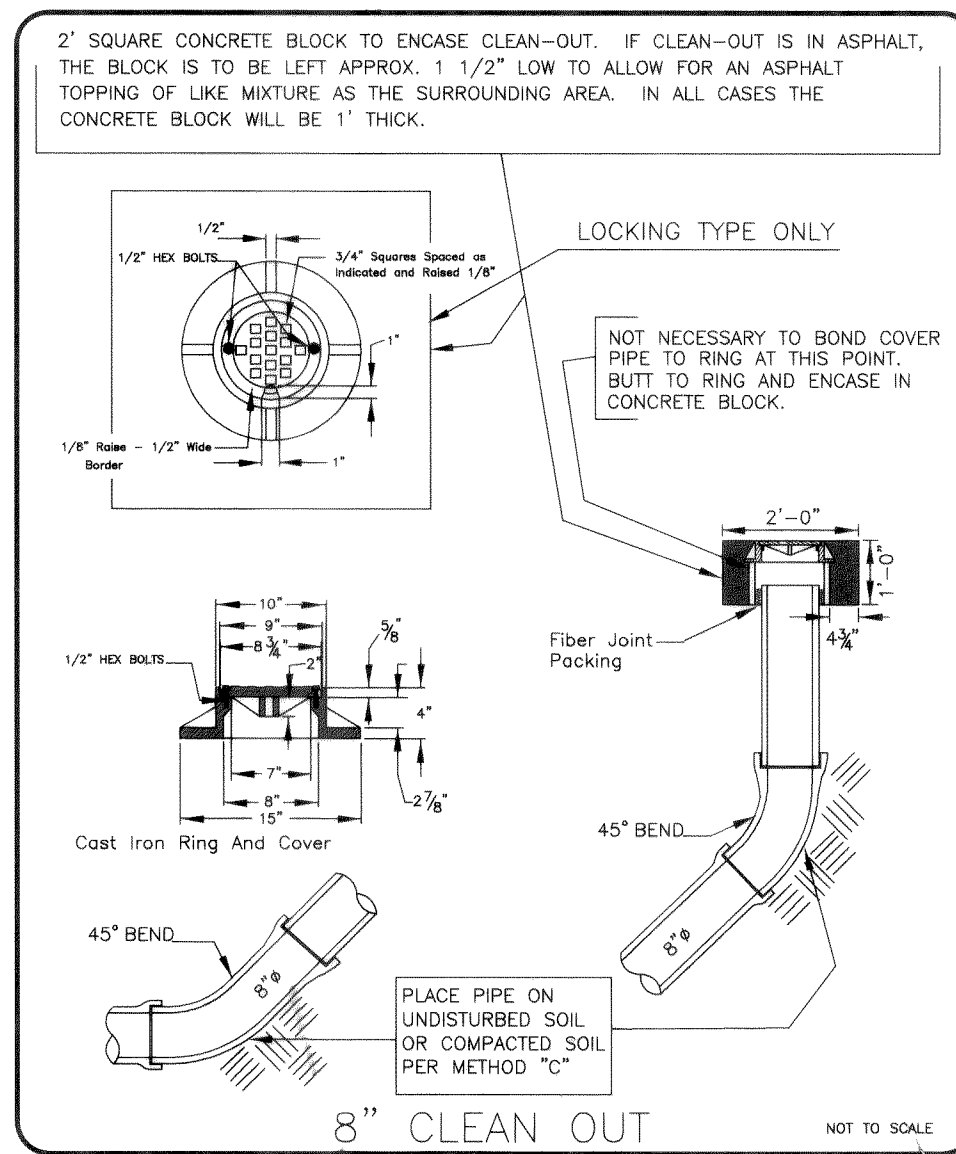
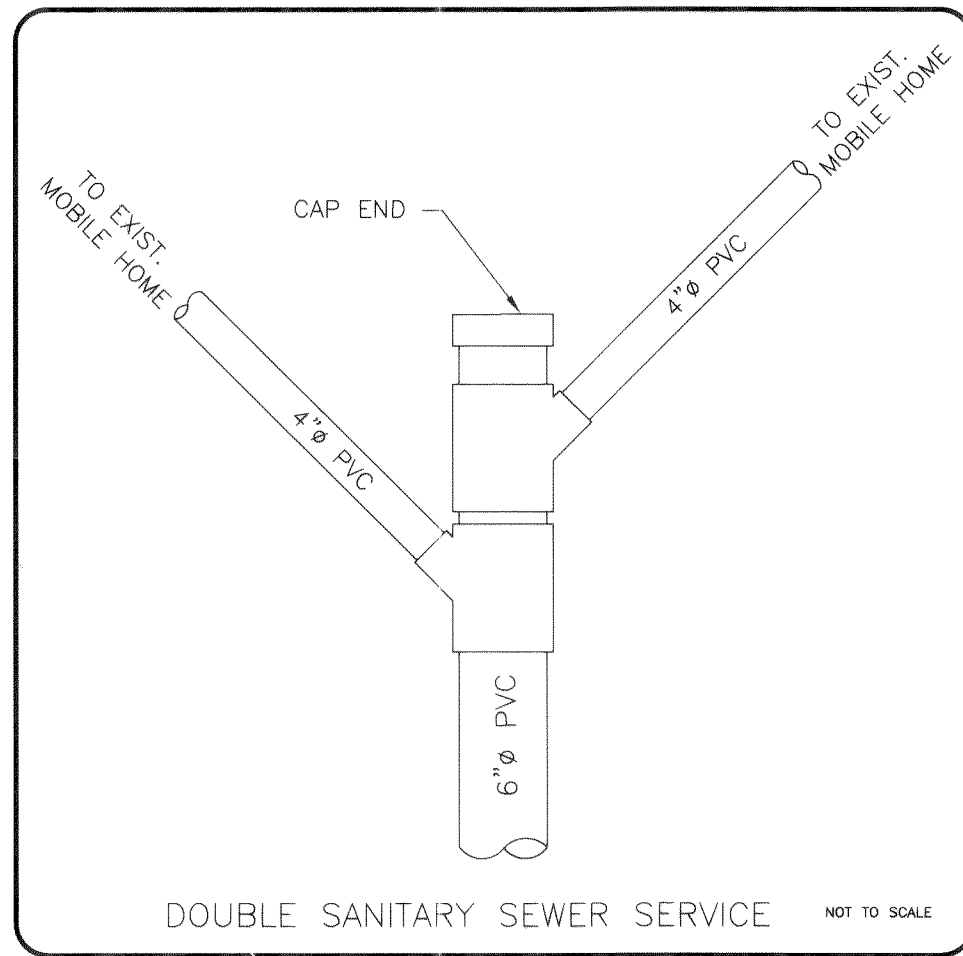


VICINITY MAP  
NO SCALE

| LEGEND |  |
|--------|--|
|        | EXISTING GROUND CONTOUR                  |
|        | EXISTING SANITARY SEWER                  |
|        | EXISTING SEWER MANHOLE                   |
|        | EXISTING FIRE HYDRANT                    |
|        | EXISTING UTILITY POLE                    |
|        | R/W CENTERLINE                           |
|        | EXISTING ASPHALT PAVEMENT                |
|        | EXISTING MOBILE HOME                     |
|        | NEWLY CONSTRUCTED SANITARY SEWER MAIN    |
|        | NEWLY CONSTRUCTED SANITARY SEWER SERVICE |
|        | NEWLY CONSTRUCTED MANHOLE                |
|        | NEWLY CONSTRUCTED CLEANOUT               |

**NOTE:**  
UTILITIES, INCLUDING BUT NOT LIMITED TO WATER, TELEPHONE, GAS, AND POWER, ARE KNOWN TO EXIST IN THE AREA. THE UTILITIES HAVE BEEN SHOWN ON THE PLANS UTILIZING CITY OF FERNDAL U.L.I.D. NO. 7, BUT ALL LOCATIONS ARE APPROXIMATE AND UTILITY LOCATORS MUST BE CALLED PRIOR TO BEGINNING EXCAVATION. EXTREME CAUTION MUST BE TAKEN IN THE TRIGG ROAD CROSSING AND IN THE SITE SERVICES. REPRESENTATIVES FROM P.U.D. #1 MUST BE NOTIFIED PRIOR TO BEGINNING CONSTRUCTION IN THE TRIGG ROAD RIGHT-OF-WAY SO THAT A REPRESENTATIVE MAY BE ON SITE DURING EXCAVATION.

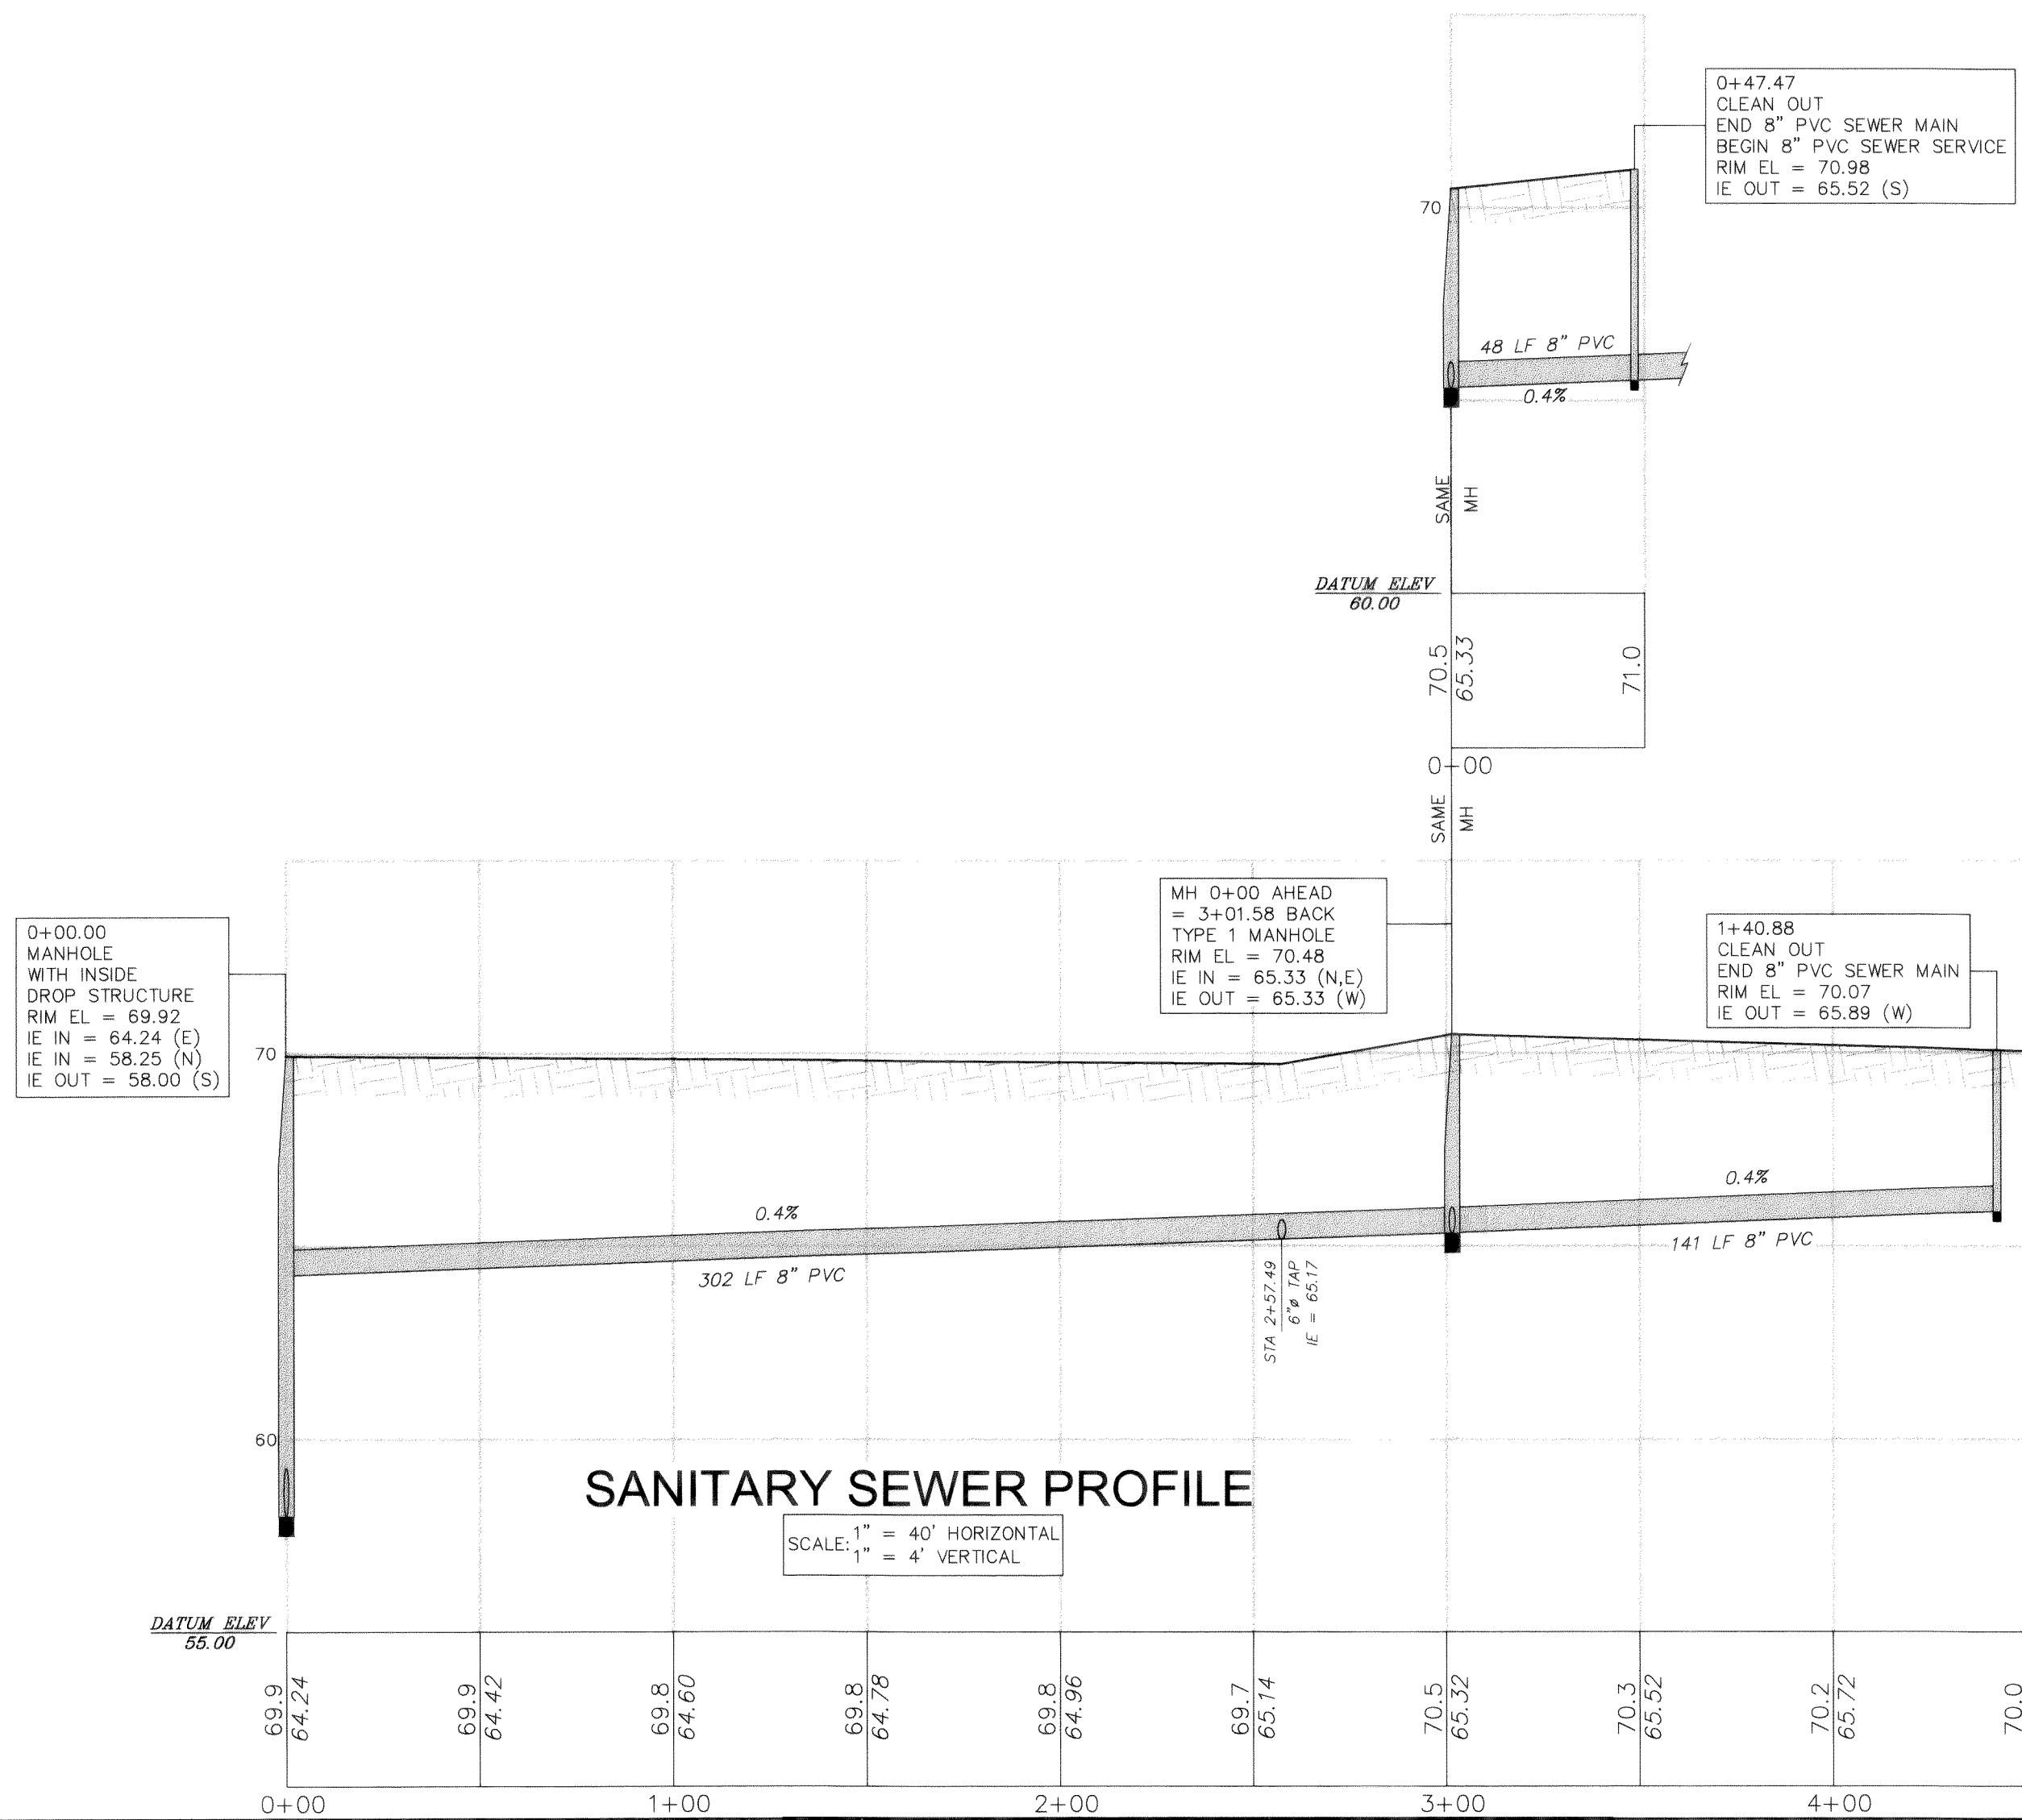

#### NOTES

- EXISTING FIELD DATA PER JEPSON & ASSOCIATES DRAWINGS DATED JANUARY 15, 1998.
- AS BUILT FIELD DATA PER CHRISTIE & CHRISTIE LAND SURVEYING INC., SURVEY PERFORMED SEPTEMBER 1999.


APPROVED BY: *CFK*  
DATE: 4/6/00

#### APPROVAL STAMPS

DATUM  
VERTICAL  
CITY OF FERNDAL PER U.L.I.D. NO. 7  
HORIZONTAL  
ASSUMED NORTHING & EASTING AT SW CORNER OF  
SE1/4 OF SECTION 8, T39N, R2E, W.M.  
N 10000.00' E 10000.00'

#### BASIS OF BEARINGS

WEST LINE OF THE SW1/4 OF THE SE1/4 OF SECTION 8,  
T39N, R2E, W.M. - SAID BEARING BEING N01°20'40\"/>

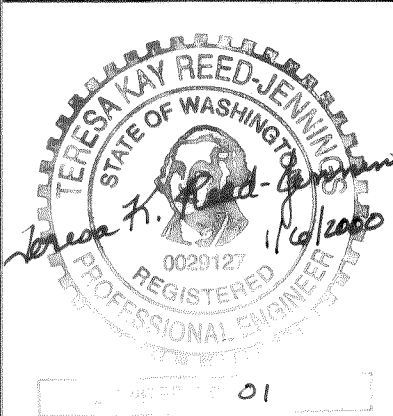

**MILLENNIUM**  
Engineering Group, Inc.

PO BOX 137, LYNDEN WA 98264 (360) 354-8141

PORTAL WAY MOBILE VILLAGE  
SANITARY SEWER IMPROVEMENTS  
**AS BUILT**  
SANITARY SEWER LAYOUT

FOR  
TANKERSLEY

PTN. SW1/4, SE1/4, SEC.08, T39N, R2E, W.M.  
CITY OF FERNDAL, WHATCOM COUNTY, WASHINGTON

SCALE: 1" = 40'  
DATE: 1/06/00  
DRAWN BY: TKRJ  
REVISED: 12/20/99  
SHEET: 1 OF 1  
JOB NUMBER: 98041