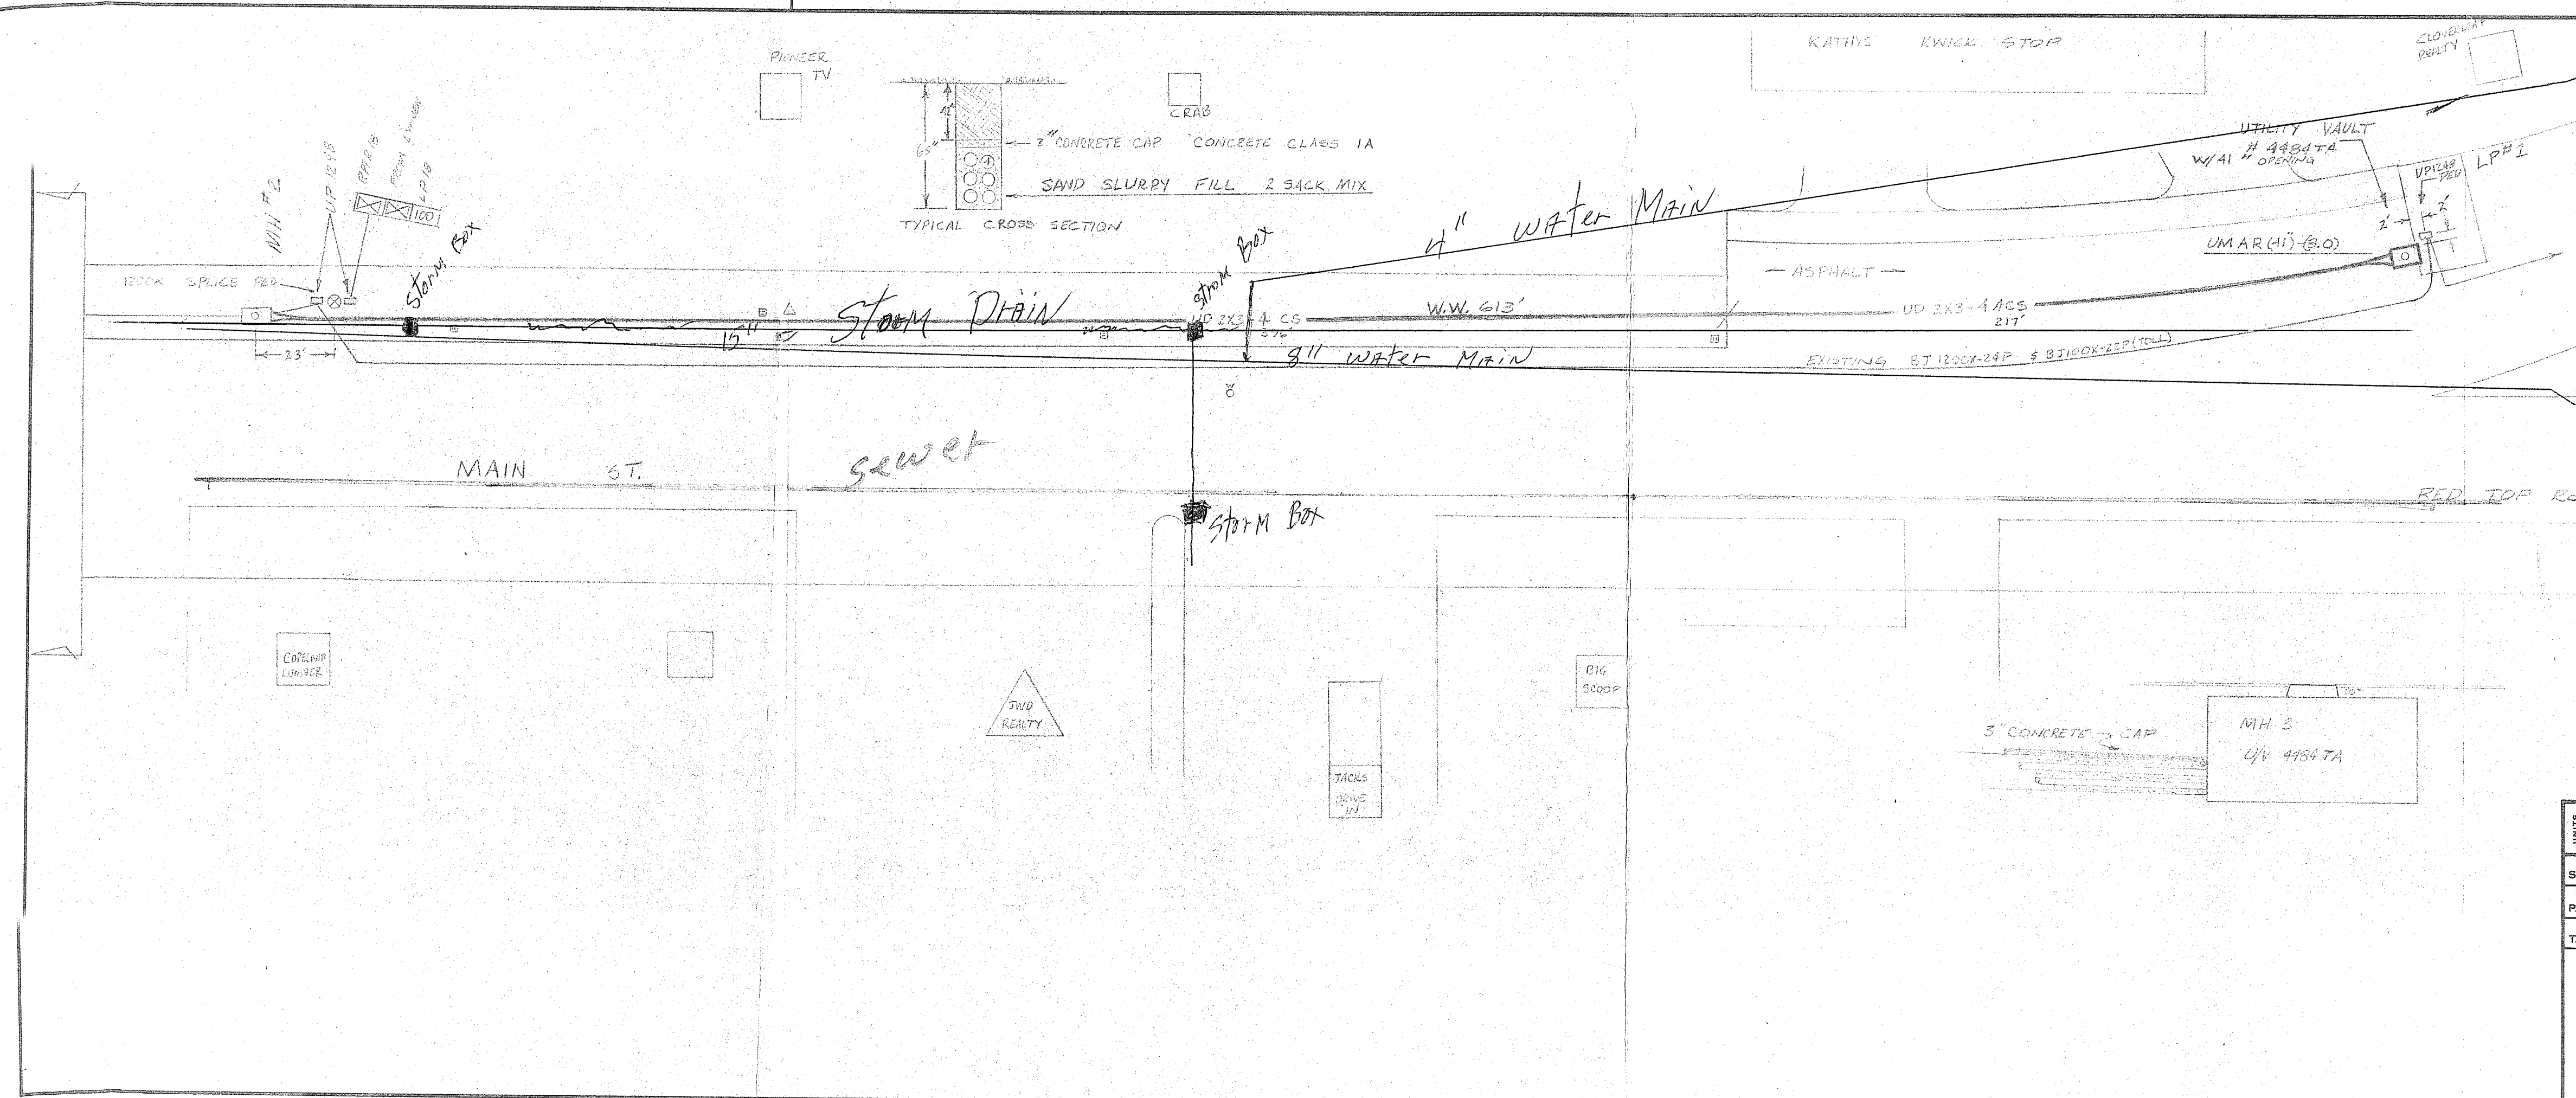


[illegible]

SCHEDULED IN SERVICE:			CTNW			
P.R.M. 61-56			EXCHANGE	FERNDALE		
T.C.A.			DISTRICT	NORTHERN		
	DRAWN	RAN	TITLE EXTEND DUCT SYSTEM ON MAIN STELET			
	DATE					
	SCALE	NTS	DRAWING OR JOB ORDER NUMBER	C1293-55		
	PREPARED BY	RAN			ISSUE	SIZE
	APPROVED BY				SHEET	OF