




918-0511-11002104021000.DWG 12/12/97 PLOTTED: 12/12/97

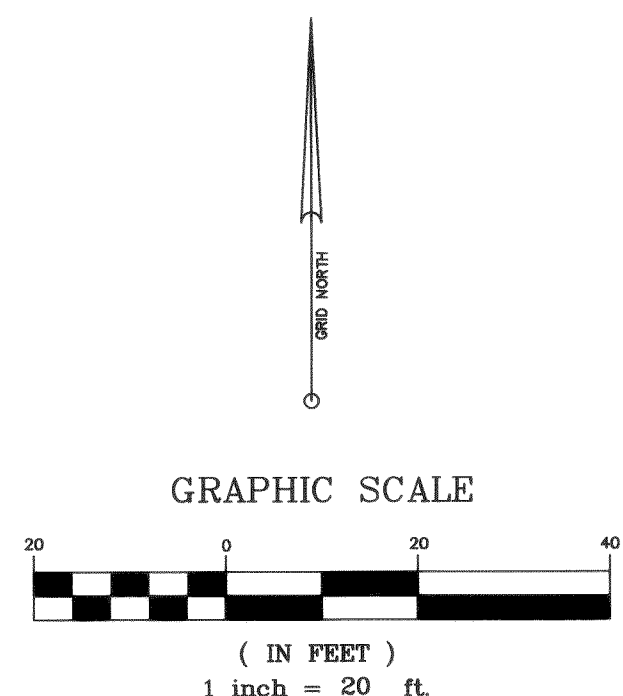

- | | | | | | |
|--|---------------------------|--|-------------------------|--|----------------------------|
| | CATCH BASIN | | WHEELCHAIR RAMP | | UNDERGROUND GAS LINE |
| | STORM DRAIN MANHOLE | | WATER VALVE | | UNDERGROUND TELEPHONE LINE |
| | TRAFFIC CONTROL BOX | | WATER METER | | UNDERGROUND POWER LINE |
| | TRAFFIC SIGNAL POST | | FIRE HYDRANT | | SANITARY SEWER LINE |
| | TRAFFIC SIGNAL CONTROLLER | | SANITARY SEWER MANHOLE | | STORM DRAIN LINE |
| | LUMINARE ON ARM | | SANITARY SEWER CLEANOUT | | WATER LINE |
| | LUMINARE | | | | |

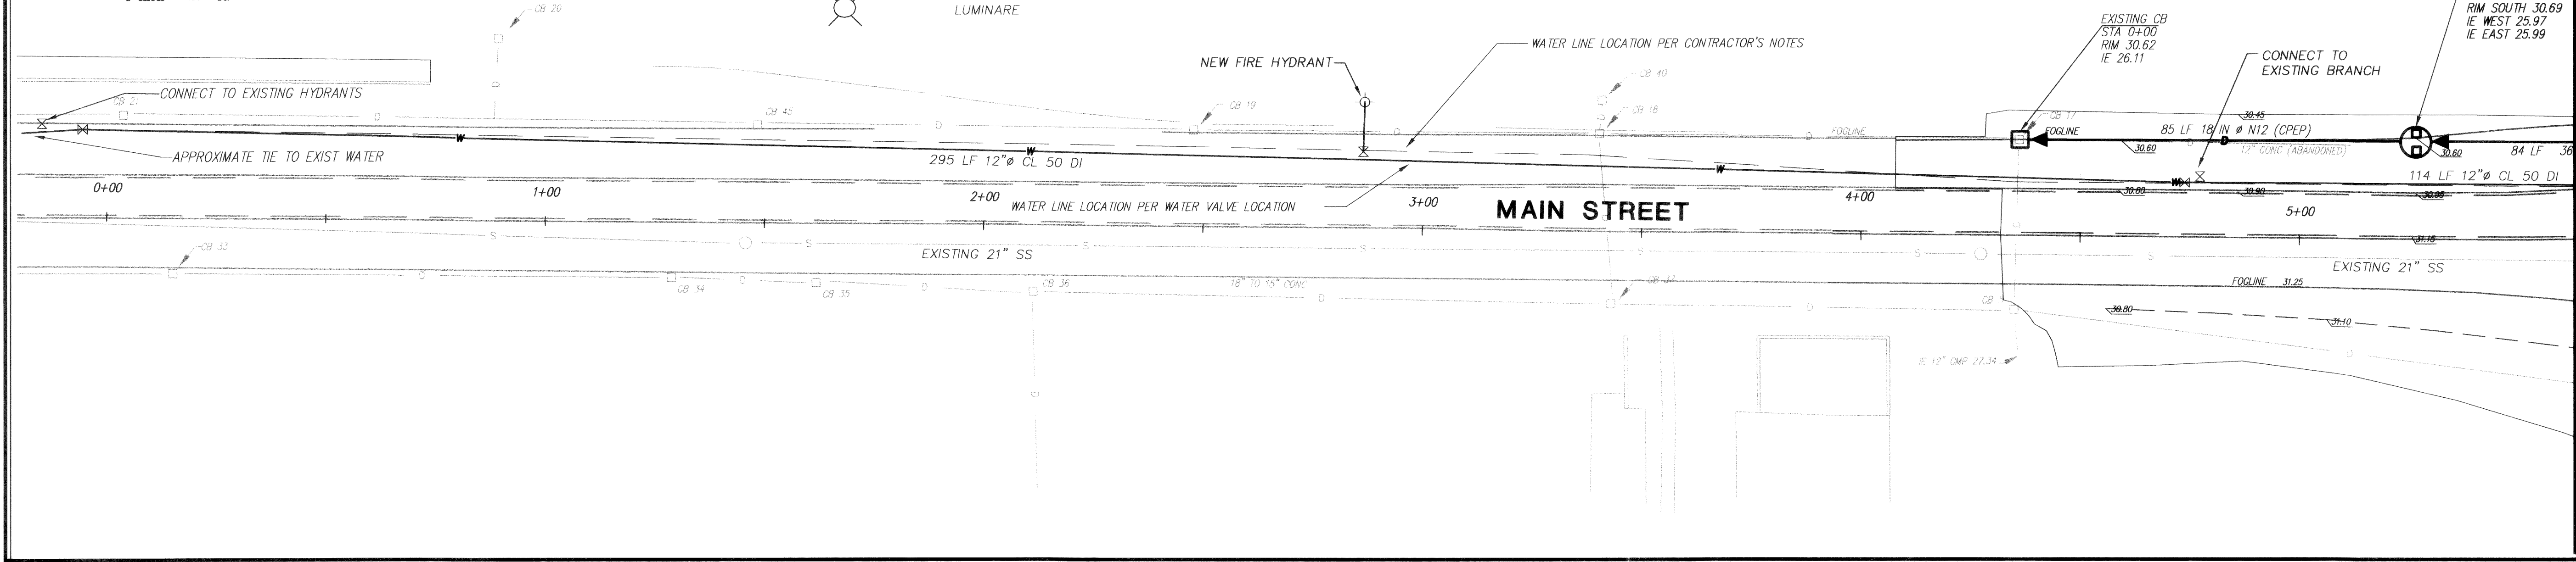

MATCH LINE
SEE ABOVE

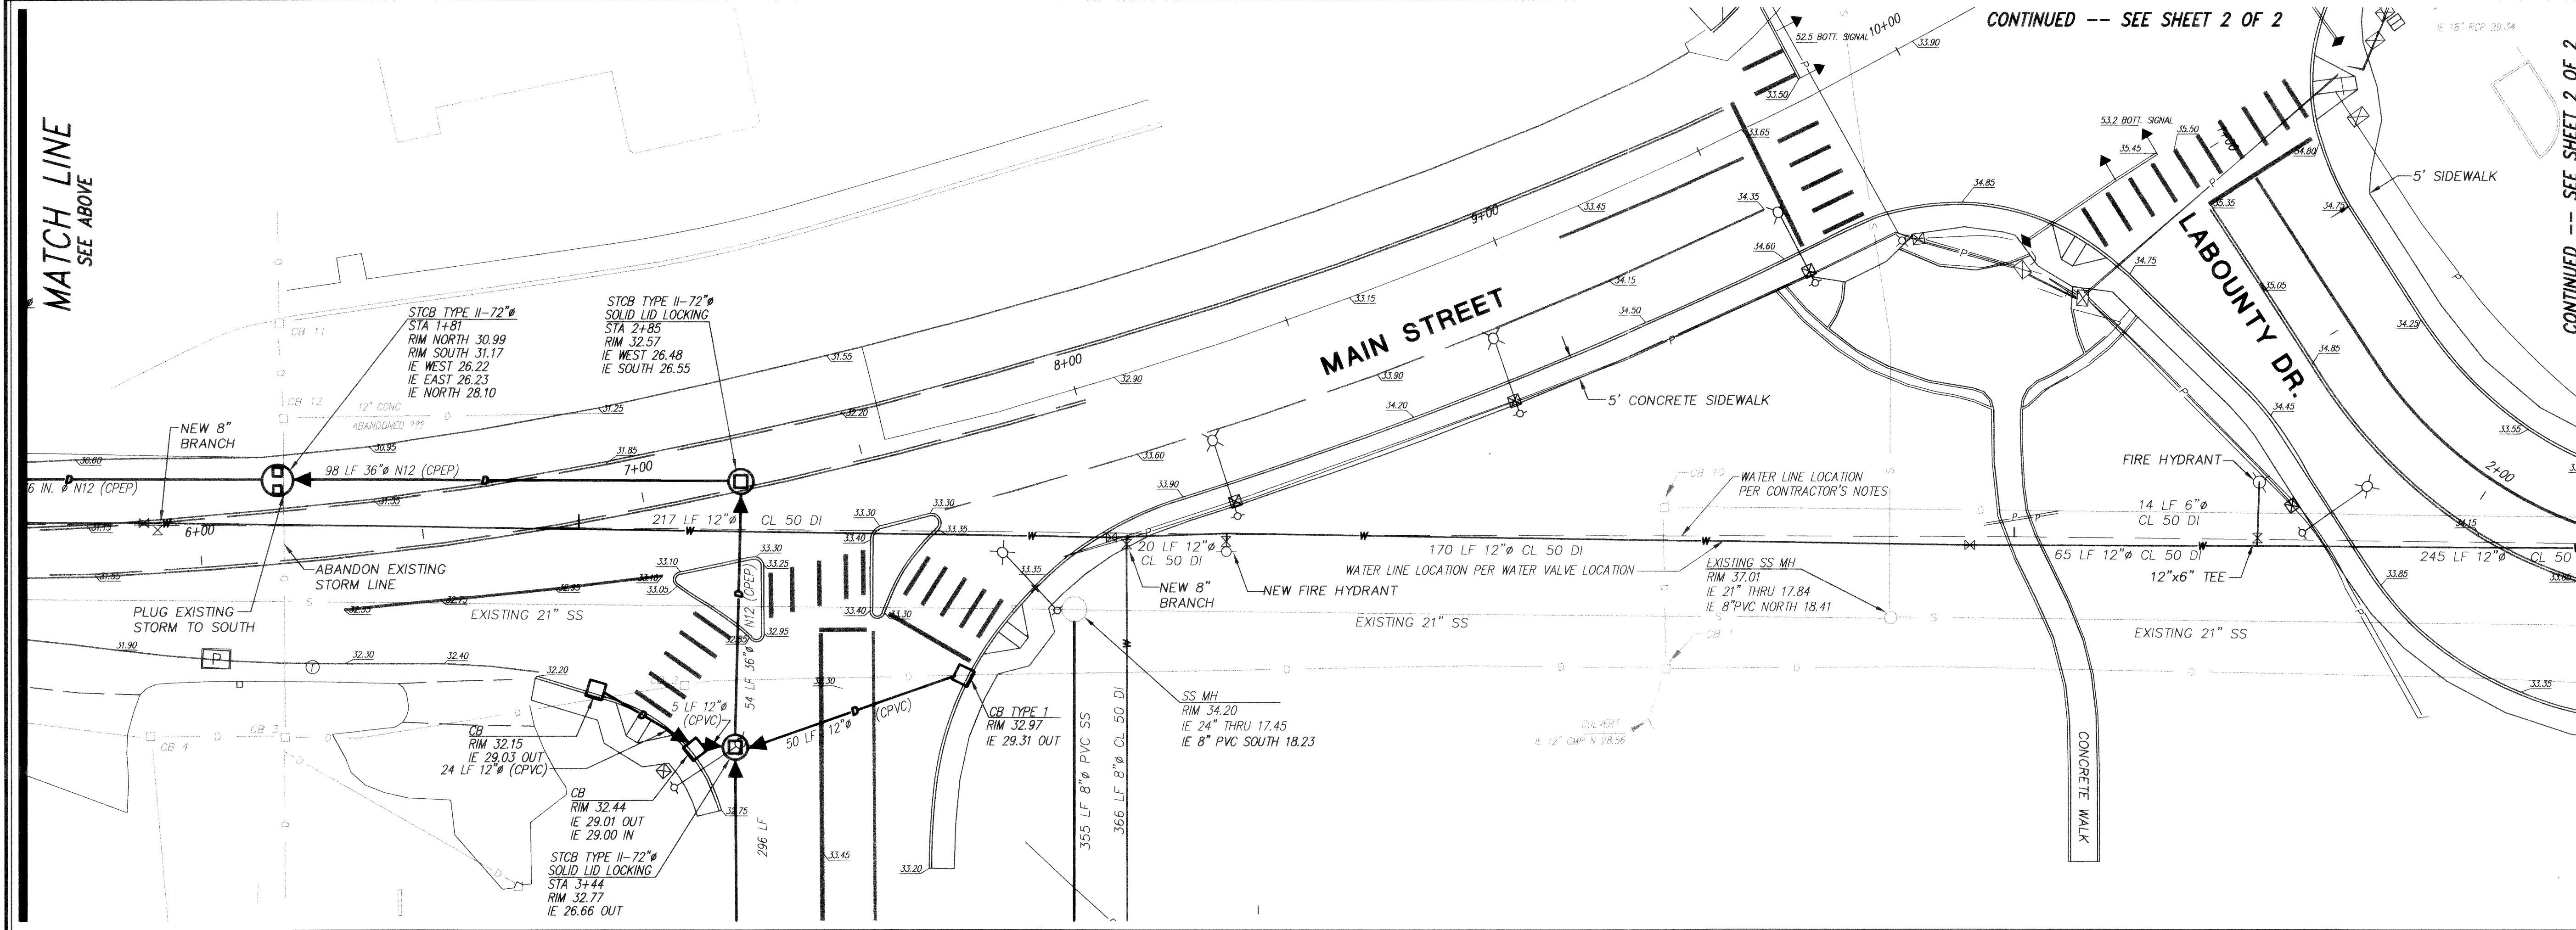

MATCH LINE
SEE BELOW

Northwest Engineering Company
3025 - 112th Avenue, N.E.
Bellevue, Washington 455-867-9800


ROBERT E. WALLIS
PROFESSIONAL ENGINEER
EXPIRES: DEC 15, 1997

BRIAR DEVELOPMENT COMPANY
MAIN STREET AND LABOUNTY DRIVE
OFFSITE ROAD, STORM, & WATER
RECORD DRAWINGS
WASHINGTON
FERNDAL

DESIGNED: LMR
DRAWN: TRT
CHECKED: REW
REVISED:
DRAWING NO: S1064202.DWG



918-05
SHEET
1 / 2

918-05/1-PRO/5106AB02.DWG 12/12/97 PLOTED: 12/12/97

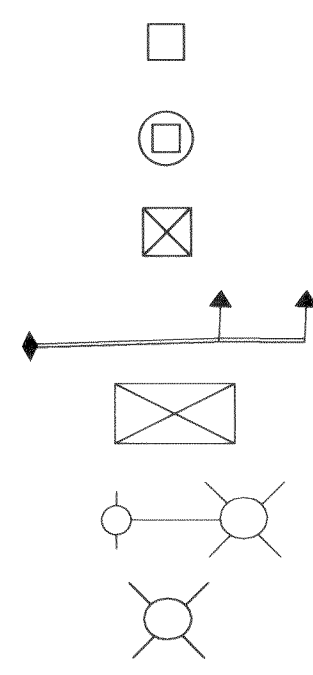


- | | |
|---------------------------|-------------------------|
| CATCH BASIN | WHEELCHAIR RAMP |
| STORM DRAIN MANHOLE | WATER VALVE |
| TRAFFIC CONTROL BOX | WATER METER |
| TRAFFIC SIGNAL POST | FIRE HYDRANT |
| TRAFFIC SIGNAL CONTROLLER | SANITARY SEWER MANHOLE |
| LUMINARE ON ARM | SANITARY SEWER CLEANOUT |
| LUMINARE | |

- | | |
|---|----------------------------|
| G | UNDERGROUND GAS LINE |
| T | UNDERGROUND TELEPHONE LINE |
| P | UNDERGROUND POWER LINE |
| S | SANITARY SEWER LINE |
| D | STORM DRAIN LINE |
| W | WATER LINE |

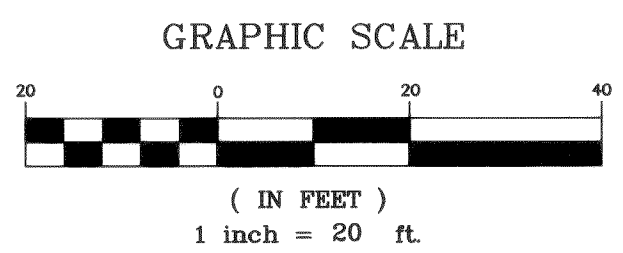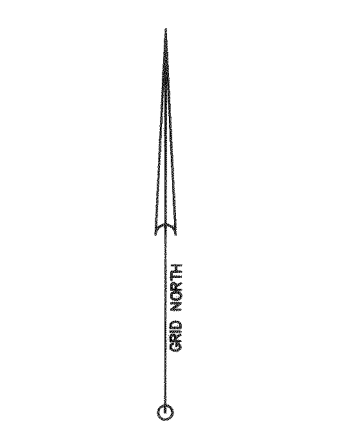

CONTINUED -- SEE SHEET 1 OF 2

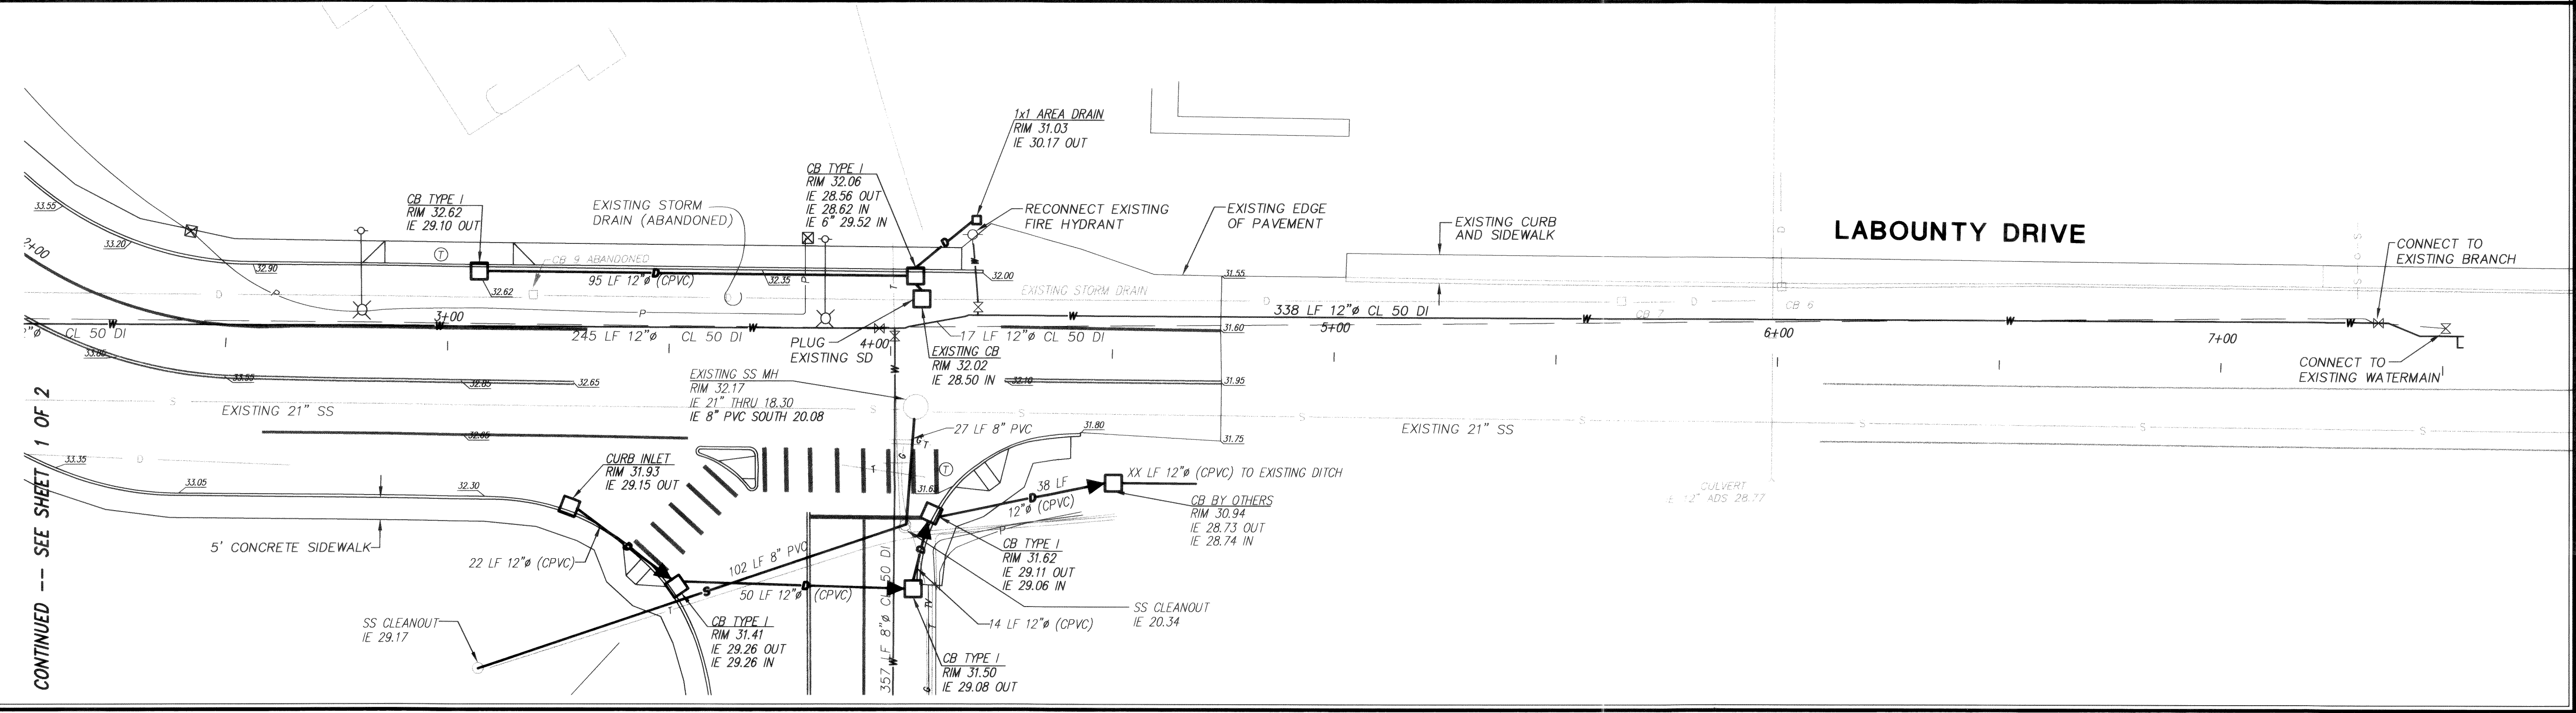

CONTINUED -- SEE SHEET 1 OF 2

Northwest Engineering Company

3025-112th Avenue N.E.
Bellevue, Washington 425-867-9800

PROFESSIONAL SEAL

ROBERT E. WILLIS
STATE OF WASHINGTON
REGISTERED PROFESSIONAL LAND SURVEYOR
EXPIRES: DEC 15, 1997

BRIAR DEVELOPMENT COMPANY
MAIN AND LABOUNTY STREETS
IMPROVEMENTS
WASHINGTON
FERNDAL

DESIGNED: LMR
DRAWN: TRT
CHECKED: REW
REVISED:
DRAWING NO: 5106AB02.DWG

918-05

SHEET
2 / 2