
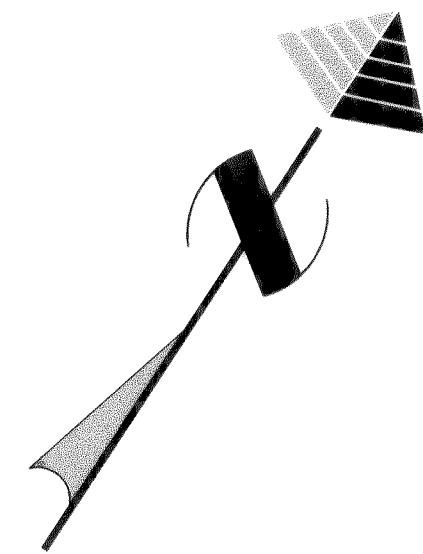
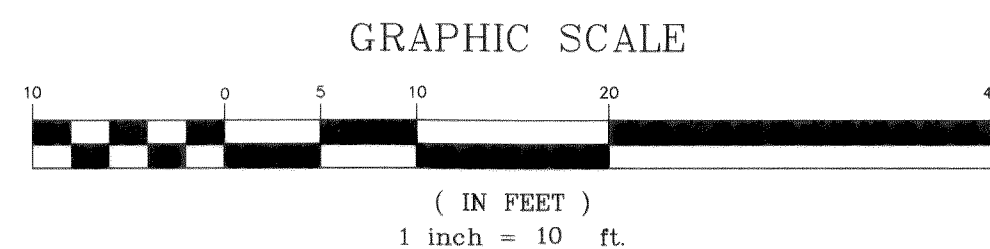


\\teresa\projects\1980\98029\ss-bu\lts\abc2-v2.dwg Fr1 Jun 02 15:20:38 2000 chadmas

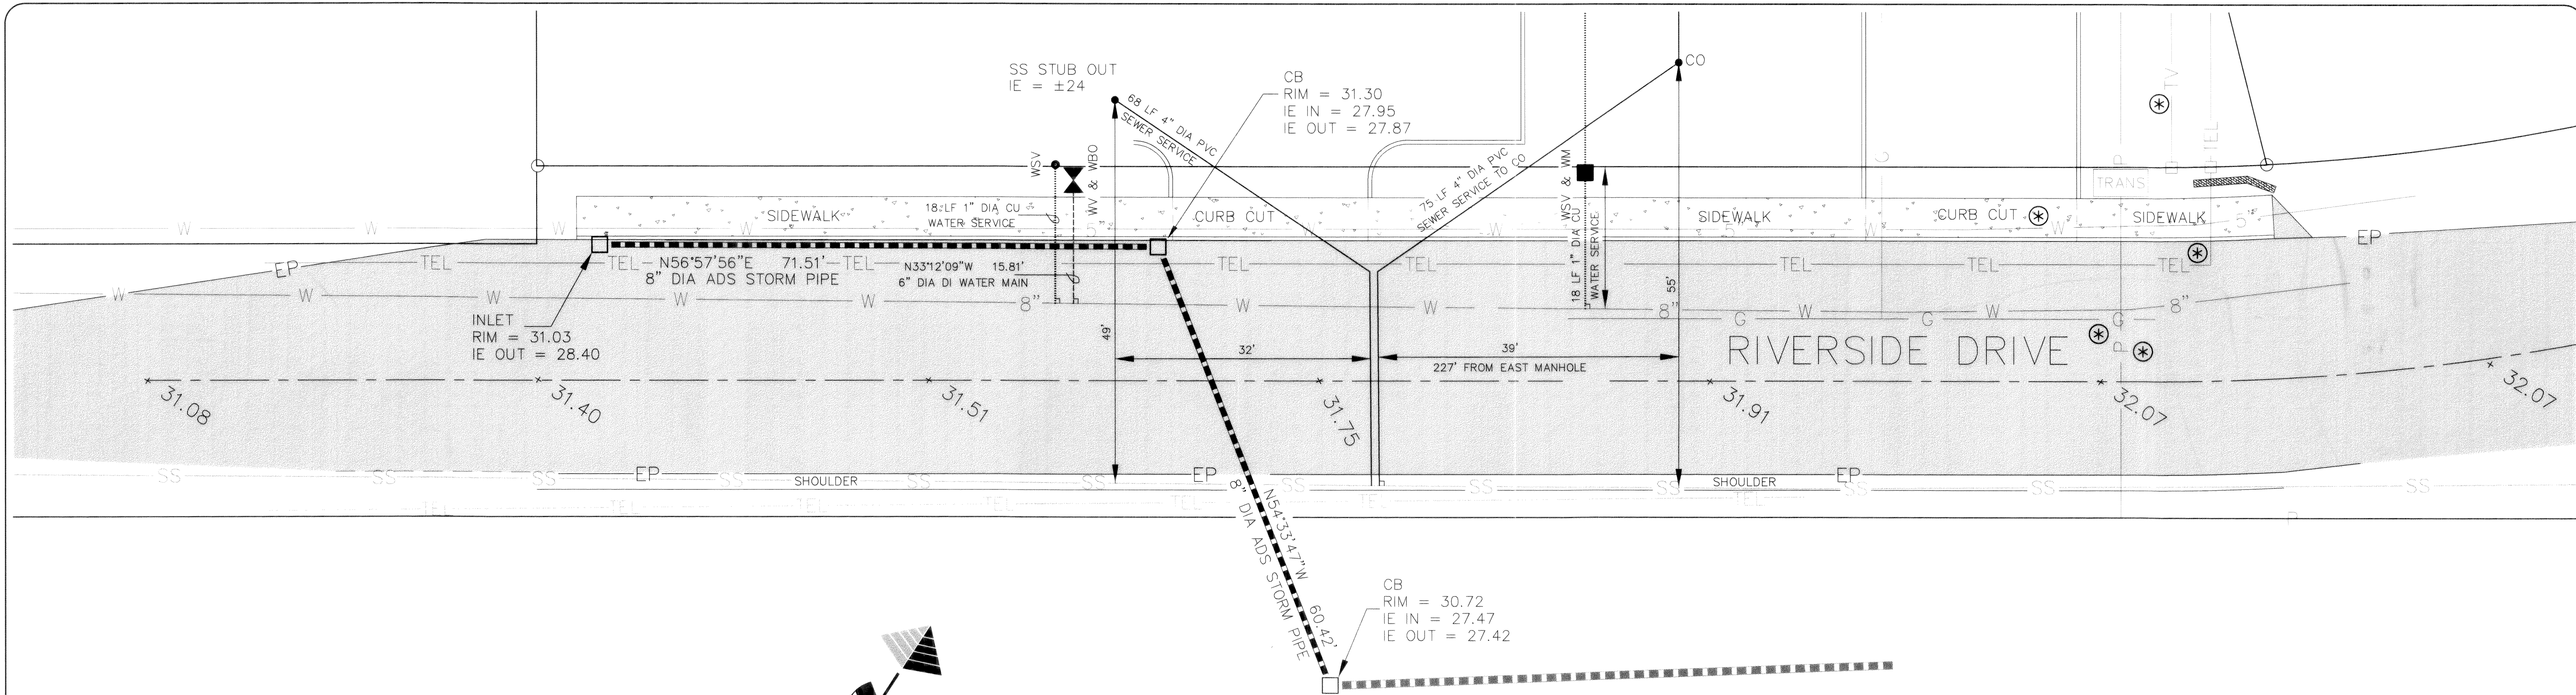

LINE DENOTES APPROXIMATE LOCATION ONLY.
UTILITIES ENCOUNTERED IN FIELD BY THE CONTRACTOR
DURING EXCAVATION FOR THE IMPROVEMENTS
SHOWN ON THIS PLAN.

LEGEND

- | | |
|---------|----------------------------------|
| — | ROW LINE OF RIVERSIDE DRIVE |
| - - - | CENTERLINE OF RIVERSIDE DRIVE |
| — | EDGE OF ROADWAY IMPROVEMENTS |
| —EP— | EDGE OF TRAVEL LANE |
| + 31.40 | SPOT ELEVATION |
| — | PRE-EXISTING STORM MAIN |
| — | STORM MAIN |
| □ | INLET/CATCH BASIN |
| —SS— | PRE-EXISTING SANITARY SEWER MAIN |
| — | SANITARY SEWER SERVICE |
| • | SANITARY SERVICE STUB OUT |
| —W— | PRE-EXISTING WATER MAIN |
| — | WATER MAIN |
| — | WATER SERVICE |
| ✕ | GATE VALVE |
| ■ | WATER SERVICE METER BOX |
| • | WATER SERVICE STUB OUT |
| —TEL— | UNDERGROUND TELEPHONE |
| —NG— | UNDERGROUND NATURAL GAS |
| —TV— | UNDERGROUND CABLE TV |
| —P— | UNDERGROUND POWER |

MILLENNIUM
Engineering Group, Inc.

PO BOX 137, LYNDEN WA 98264 (360) 354-8141

NOTES

- EXISTING FIELD DATA PER LARRY STEELE & ASSOCIATES SURVEYS PERFORMED APRIL, 1998.
- AS BUILT FIELD DATA PER LARRY STEELE & ASSOCIATES SURVEYS PERFORMED JUNE, 1999.

APPROVAL STAMPS

APPROVED

JUN 15 2000

BY *James J. Reed*
CITY OF FERNDALE

DATUM


VERTICAL
U.S.G.S. AND CITY OF FERNDALE
BRASS CAP IN SW SIDEWALK @ SE END OF MAIN STREET
BRIDGE OVER NOOKSACK RIVER ELEV = 34.96

HORIZONTAL

ASSUMED COORDINATES AT NW PROPERTY CORNER
N 9943.86 E 10818.03

BASIS OF BEARINGS

EAST FERNDAL SHORT PLAT FILED IN VOLUME 18,
PAGE 66 OF SHORT PLATS, WHATCOM COUNTY, WA.

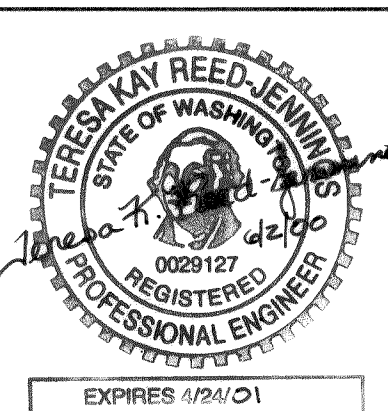

RIVERSIDE DRIVE
AS-BUILT IMPROVEMENTS

FOR
ROSS & McCLURE ARCHITECTS

PTN. N1/2, NE1/4, SEC.29, T39N, R2E, W.M.
CITY OF FERNDAL, WHATCOM COUNTY, WASHINGTON

SCALE: 1" = 10'

DATE: 07/29/99

DRAWN BY: TKRJ

REVISED: 05/23/00

SHEET: 1 OF 1

JOB NUMBER:

98029A

00180.001 2-16-06 KF