




APPROVED
By Cecil Bryant Date 9/7/93



SHEET NO.
4 OF 5

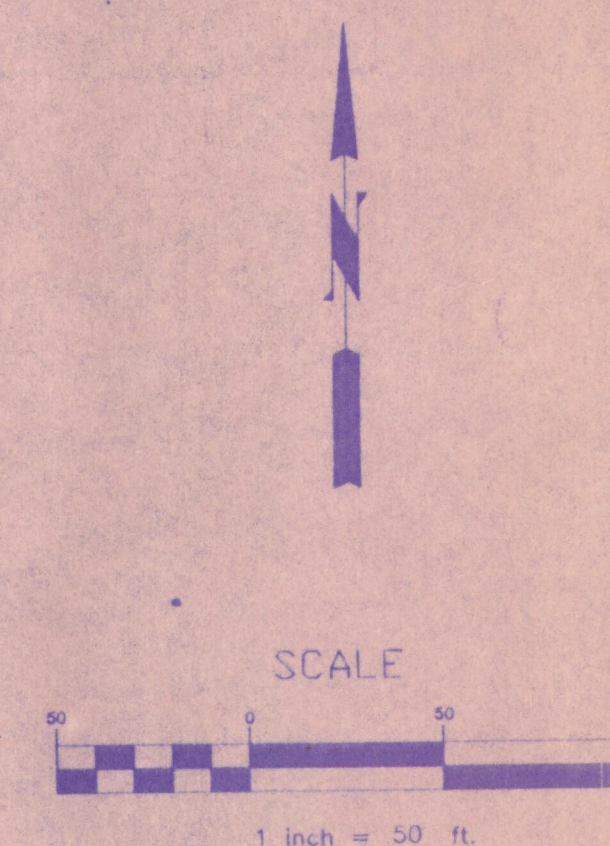