



KR 2.10.06 100-20000

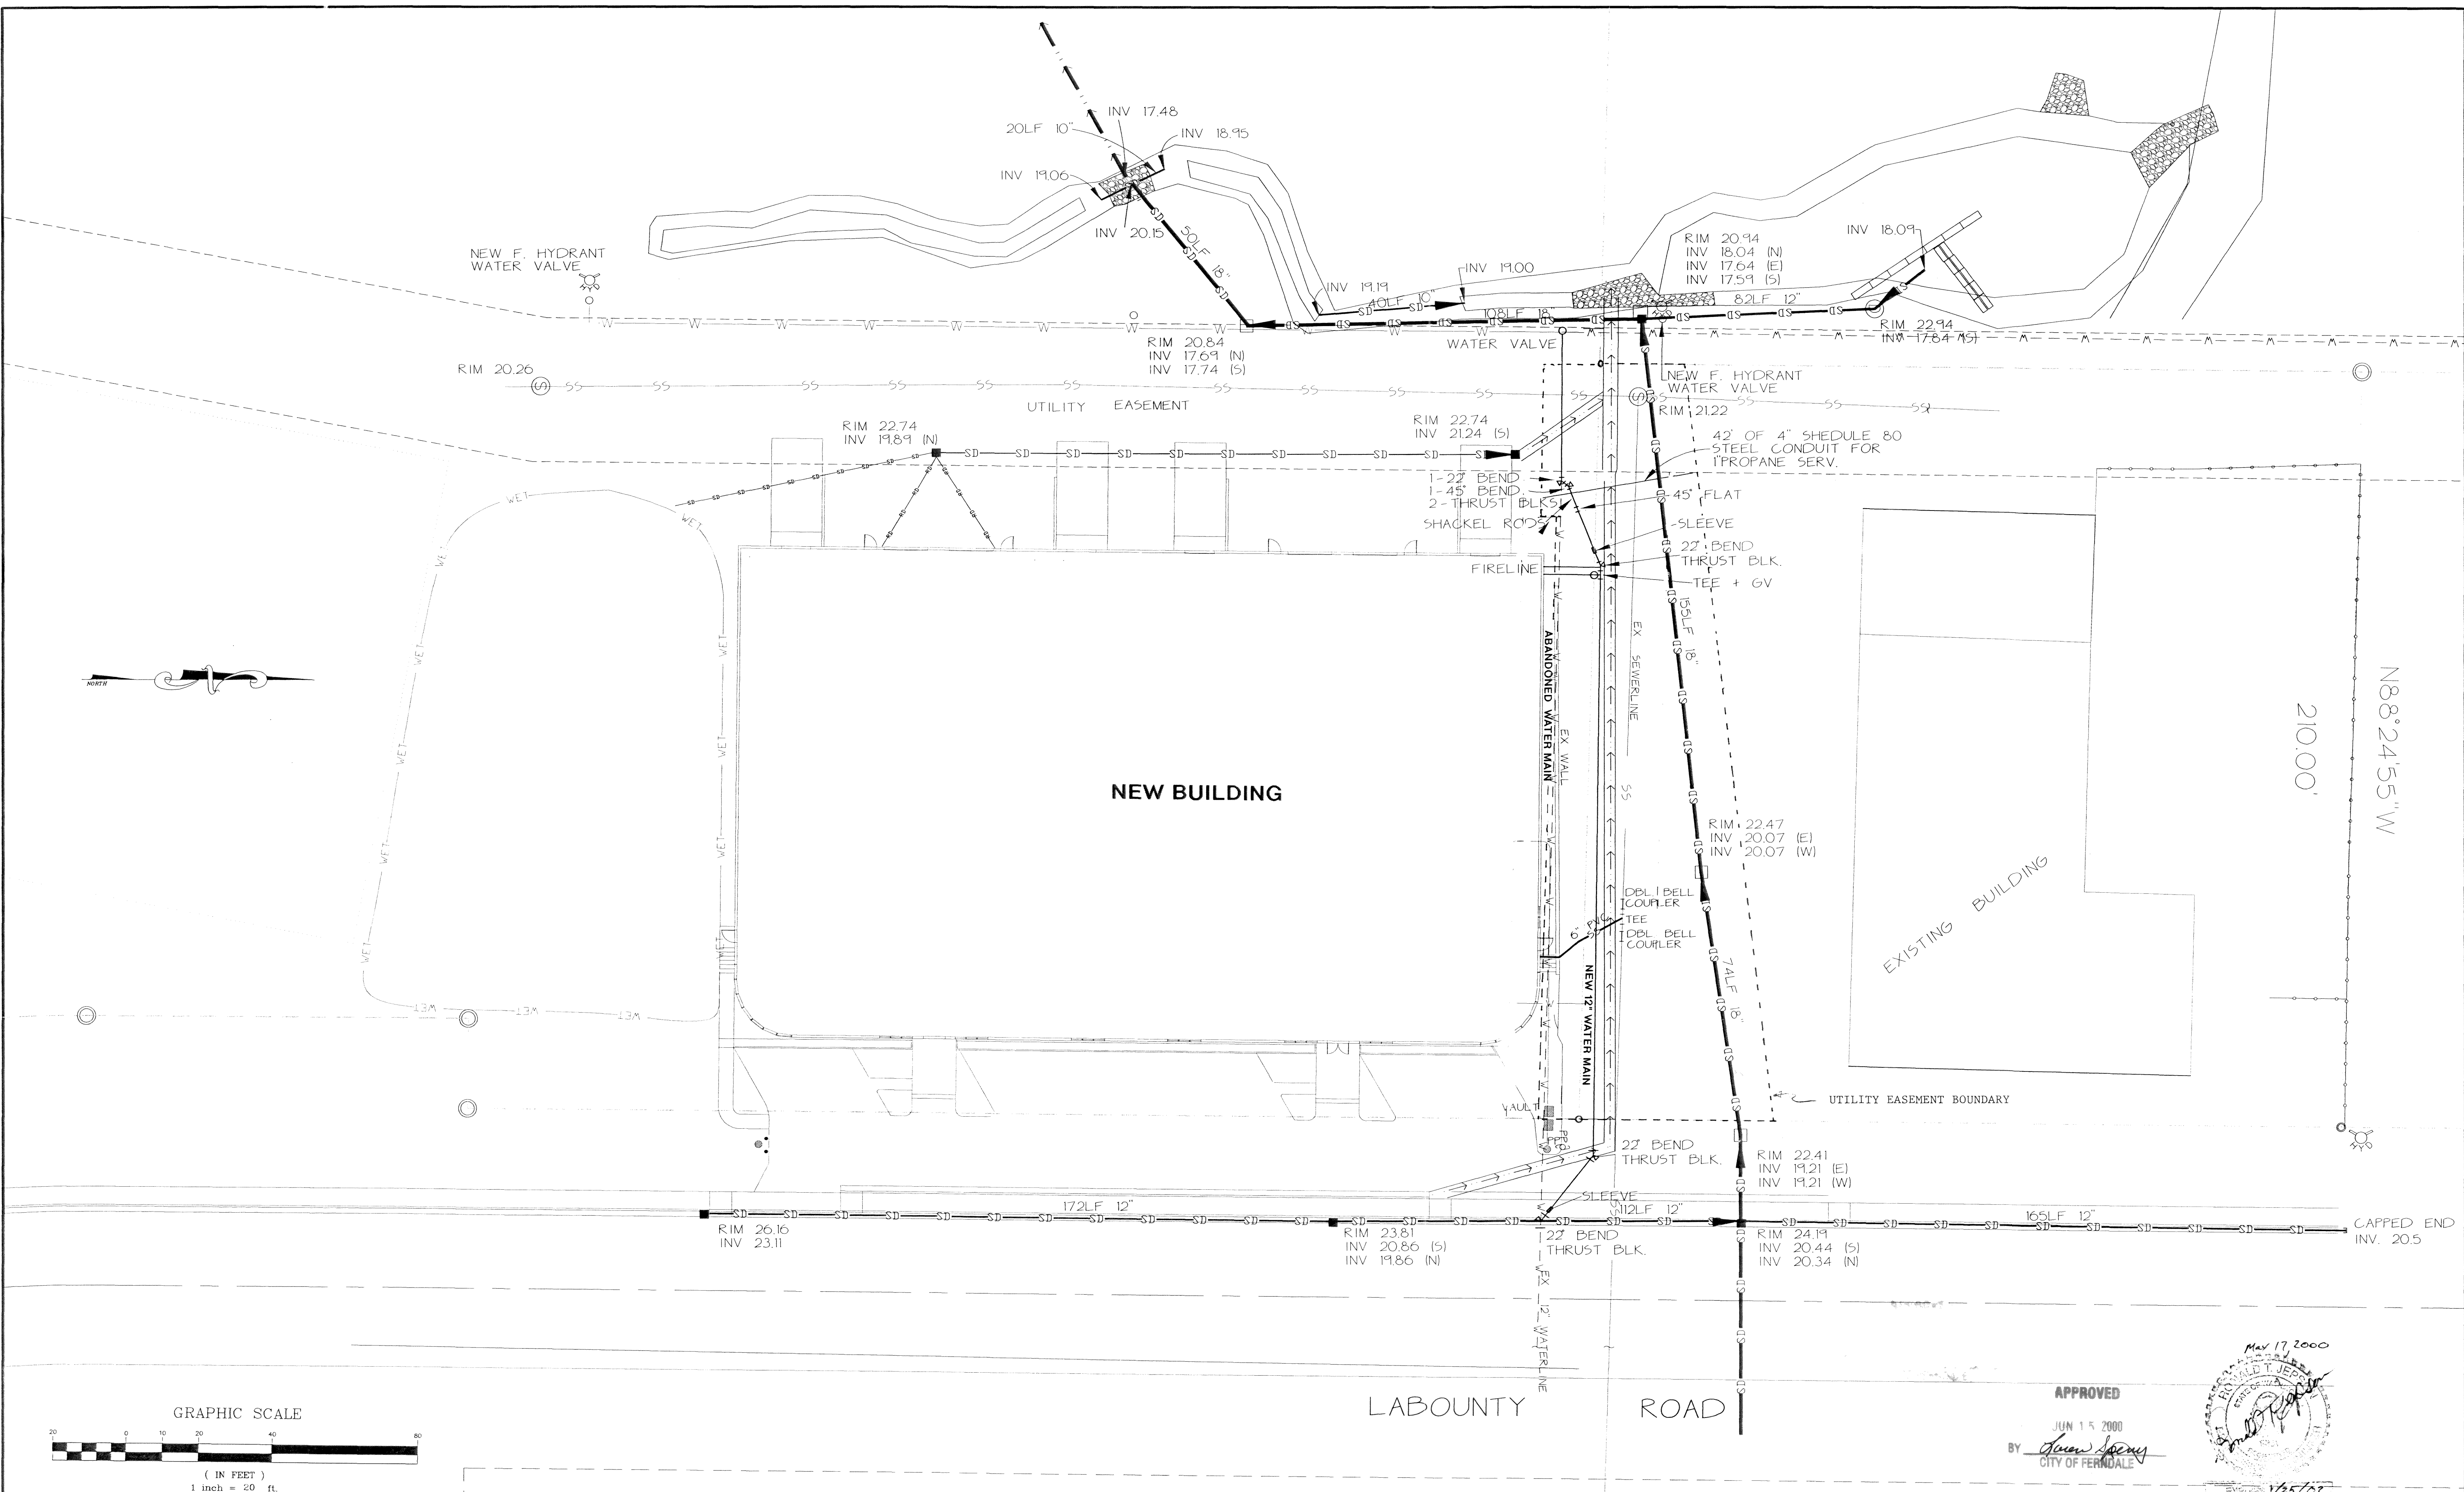

N 88° 24' 55" W
210.00'

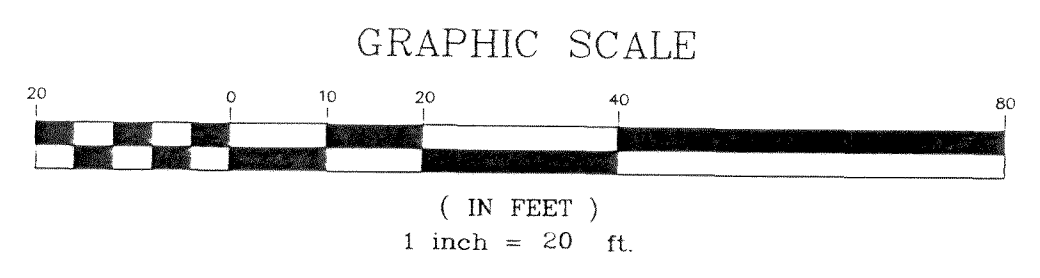

APPROVED
JUN 15 2000
BY *[Signature]*
CITY OF FERDALE

May 17 2000
R. T. JEPSON
1/25/02

RONALD T. JEPSON & ASSOC.
REGISTERED PROFESSIONAL ENGINEERS AND LAND SURVEYORS
222 GRAND, BELLINGHAM, WASHINGTON 98225

SCALE 1"=10'
DRAWN BY J.B.
CHECKED BY R.T.J.
APPROVED BY R.T.J.
DATE 3-10-00

REVISION

CLIENT:
A & R INDUST.

ASBUILTS
UTILITY ASBUILTS

1

96182