


I hereby certify that the improvements to LaBounty Road have been inspected by PS&E and constructed in general conformance with the plans for said improvements approved by the Public Works Director and the general specifications adopted by the City of Ferndale Department of Public Works.


L. Sean Horton, PE

FIELD BOOKS	TBM NO.	LOCATION	ELEV.	DATA	DESIGN BY	CHECKED BY	DATA	DESIGN BY	CHECKED BY	REV	DATE	DESCRIPTION	BY	NO.	DATE
DESIGN				BASE	AMM	KTH	TELEPHONE			1	11/18/06	12" CPP is 18" CPP			
STAKING				TOPOGRAPHY			ELECTRIC								
				PROFILE	LSH	LSH	CABLE TV								
ASBUILT				SANITARY SEWER			DESIGN	LSH	LSH						
CONTRACTOR				STORM SEWER	ELB	LSH	QUANTITIES								
INSPECTOR				WATER			FINAL CHECK	ELB	LSH						
				GAS			DWG # 99015	ASBUILT							
CONSTRUCTION RECORD		VERTICAL DATUM		PLAN CHECK			REVISIONS					ISSUE			

**PACIFIC SURVEY AND ENGINEERING INC.**  
www.pseurvey.com      pse@pseurvey.com

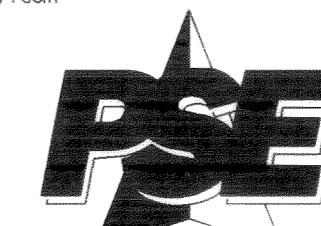

1812 CORNWALL AVE.  
BELLINGHAM, WASHINGTON 98225  
PHONE: 671-7387 FAX LINE: 671-468

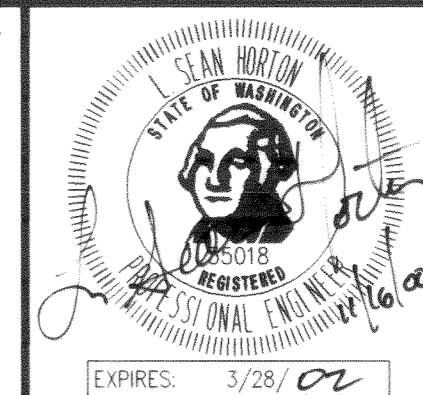

LABOUNTY DRIVE AS-BUILTS  
MOUW PROPERTY FRONTAGE  
Ferndale, Washington  
FOR: Mr. James Takisaki

HOR. SCALE: 1"=20'	DATE 10/4/00	SHEET 1 of 2
VER. SCALE: N/A	JOB/ACCT. NO. 99015	

00162.002 2.13.06 KR