
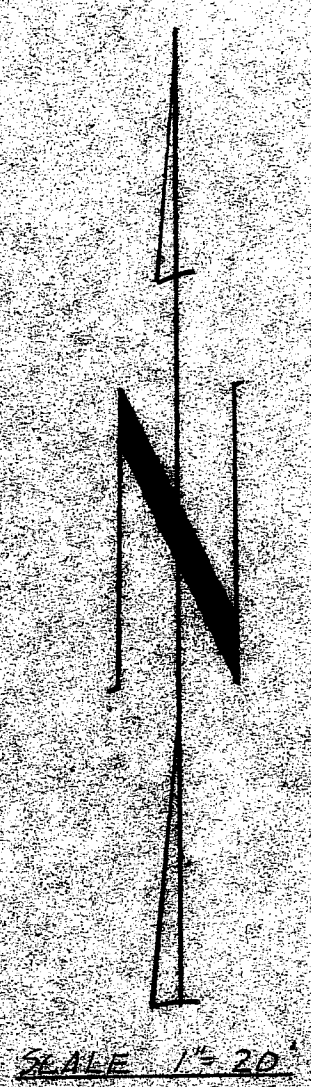


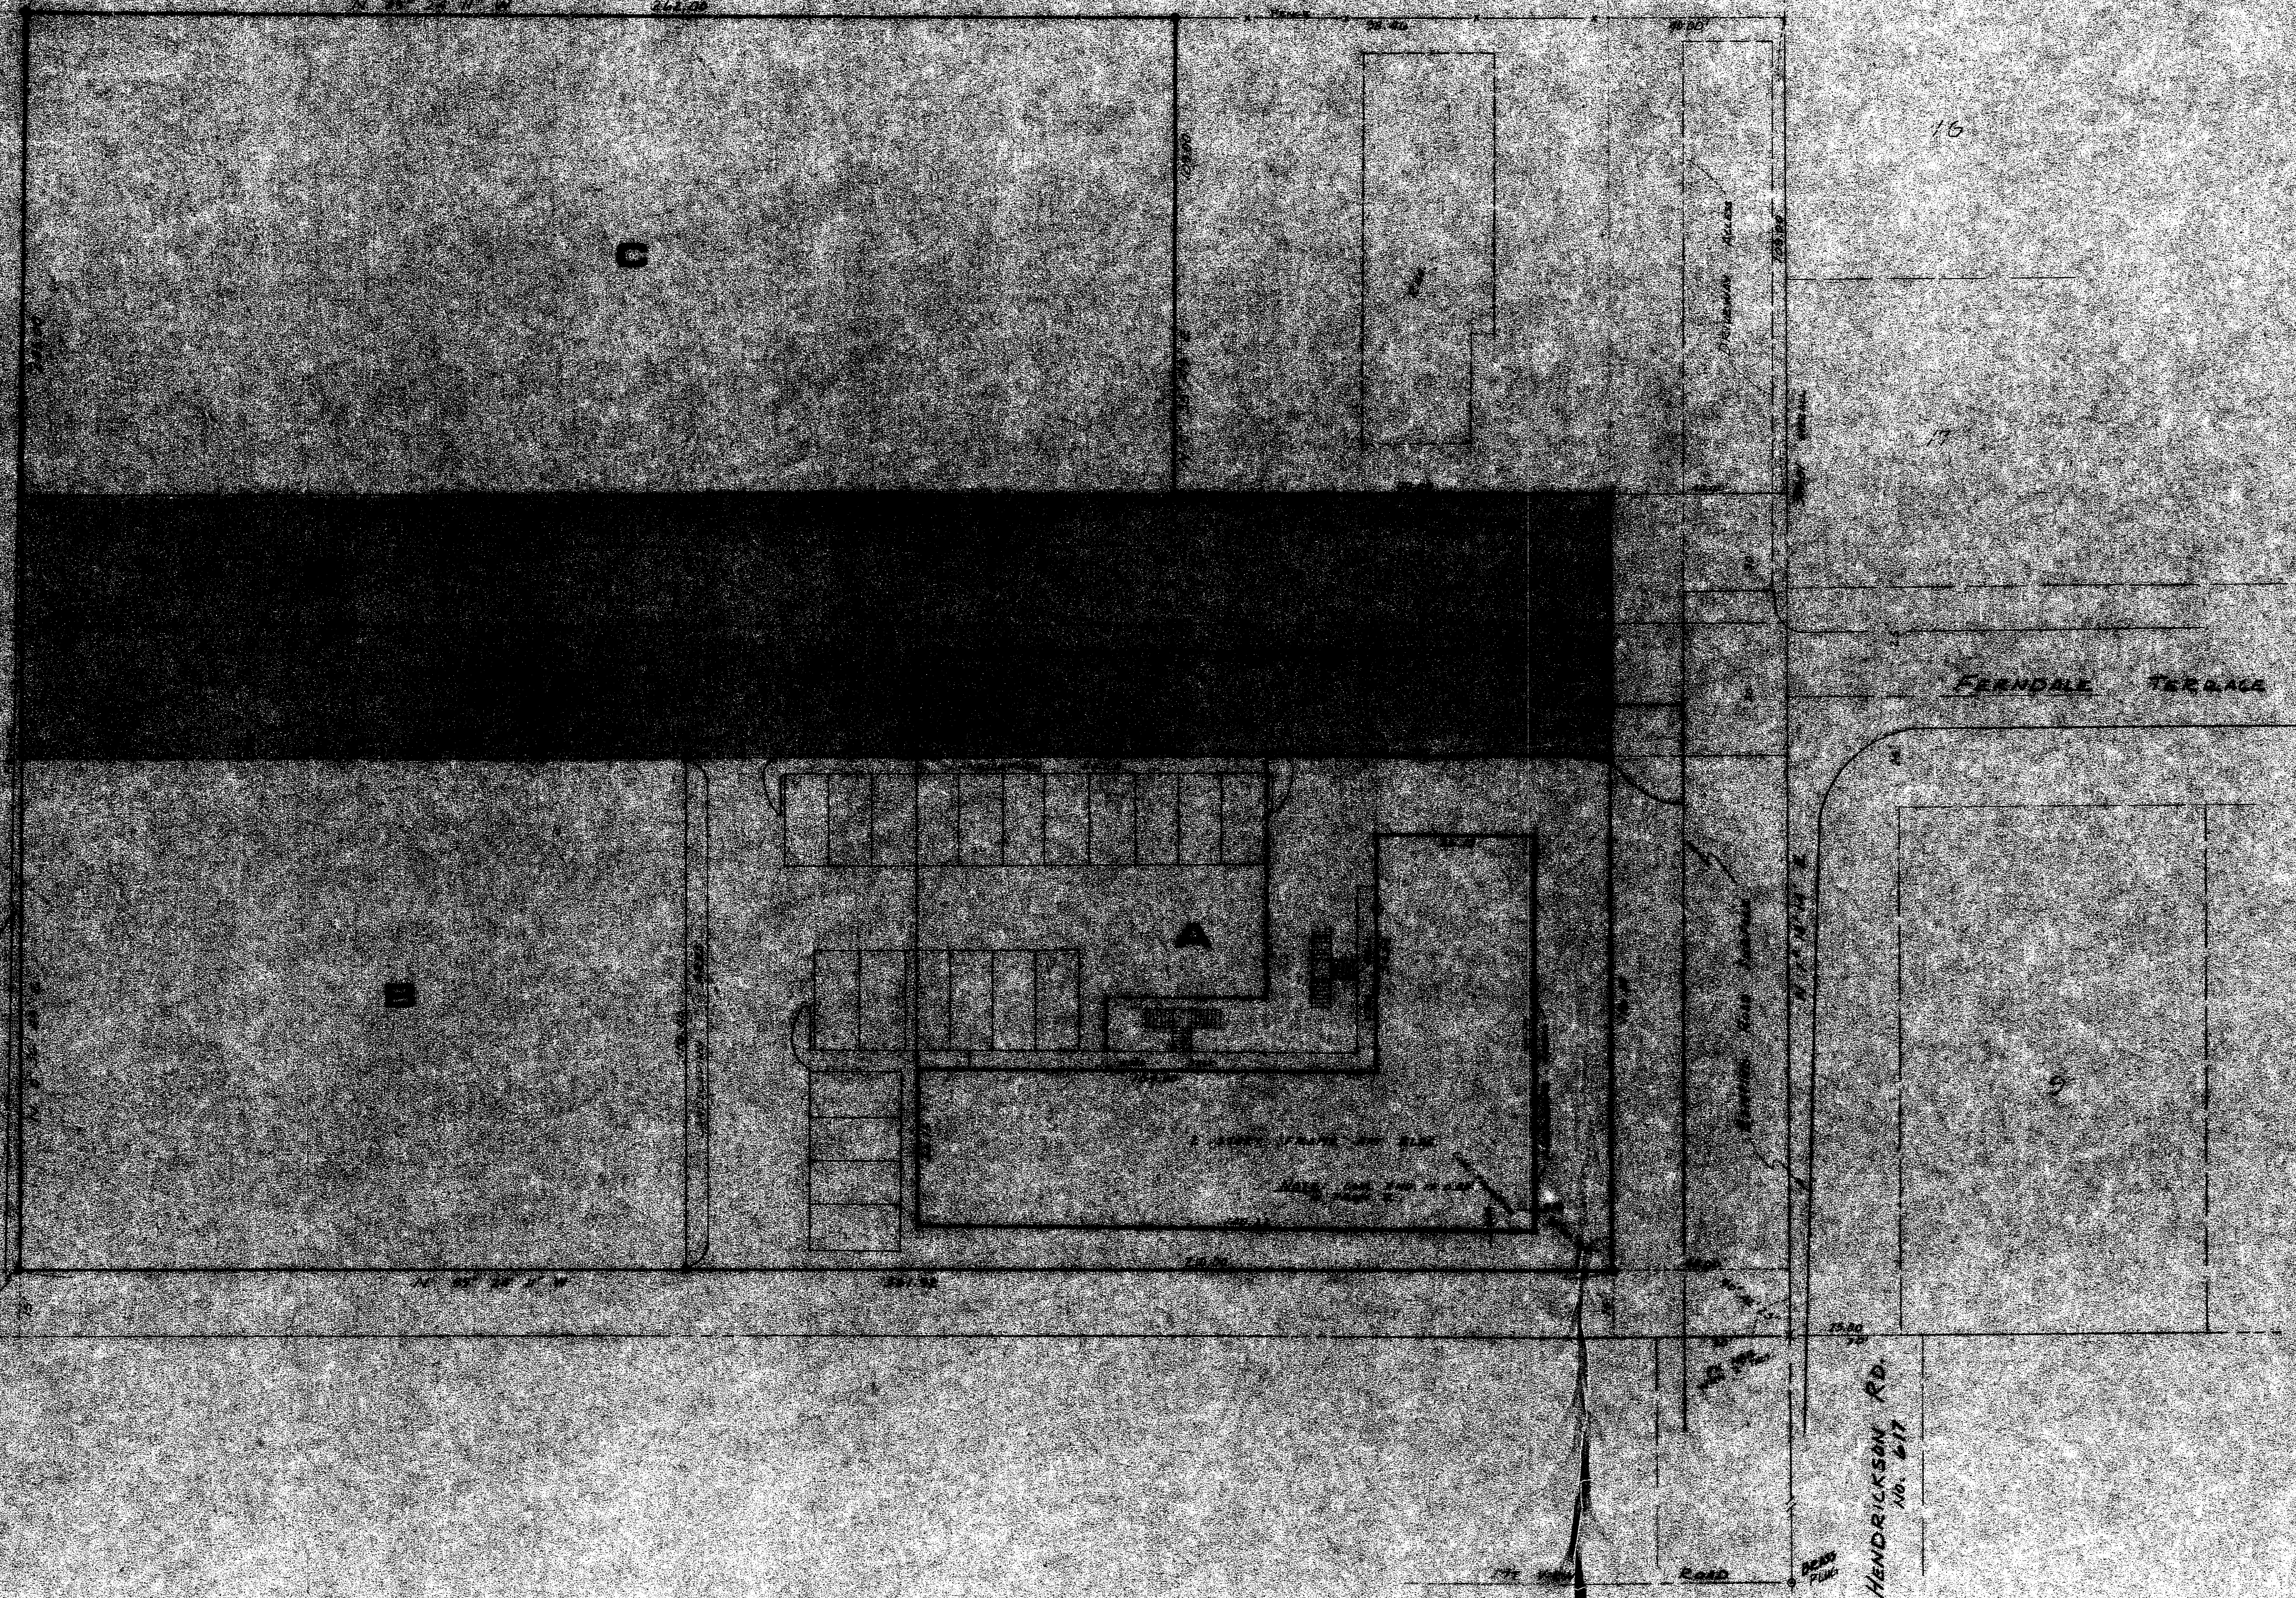

RONALD T. JEPSON & ASSOC., INC.
 REGISTERED PROFESSIONAL ENGINEERS AND LAND SURVEYORS
 1509 CORNWALL AVE. BELLINGHAM, WASHINGTON 98225

SCALE: 1" = 20' DATE: 5-25-1976
 DRAWN BY: _____
 CHECKED BY: _____
 APPROVED: _____

REVISIONS

BOUNDARY SURVEY / BUILDING LOCATION
 FOR: MR. RON KILMER
 9236 DELTA LINE ROAD
 CUSTER WASHINGTON 98240

SHEET
 OF