


W. AXTON RD.

THWEST COR.
28-39N-2E

S88°34'06"E
1310.28'

EAST LINE OF STATE HWY. GRANT
PER A. F. NO. 784809

BASIS OF BEARINGS: ASSUMED MERIDIAN

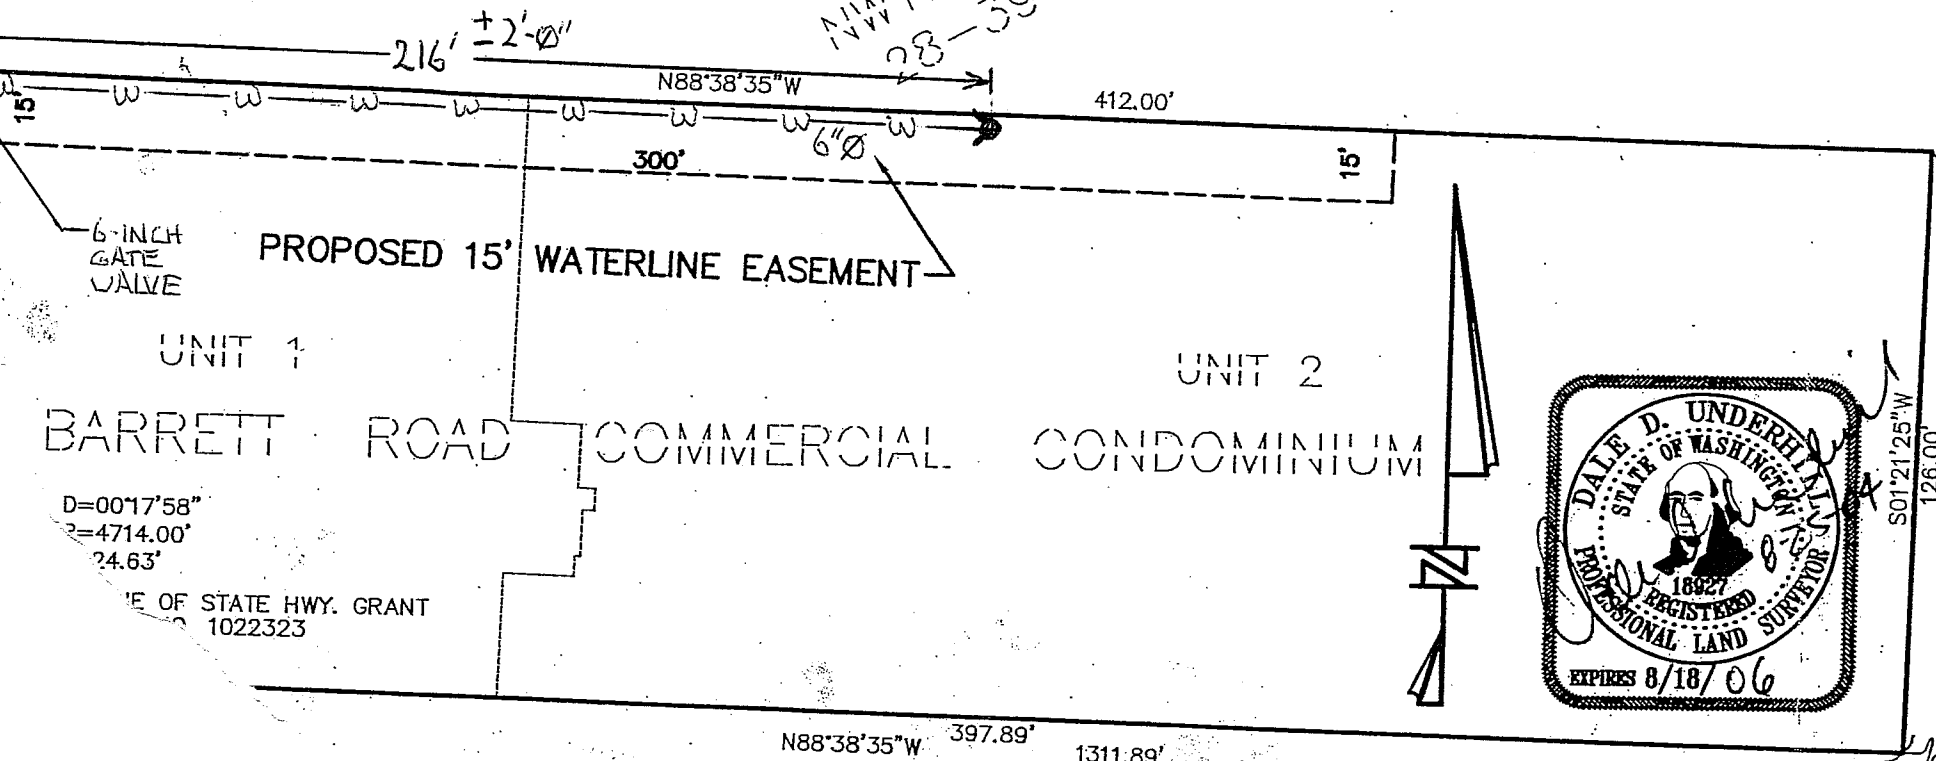

UNIT 1
BARRETT ROAD COMMERCIAL CONDOMINIUM
UNIT 2

D=00°17'58"
P=4714.00'
24.63'
E OF STATE HWY. GRANT
1022323

5610 BARRETT ROAD
Fire Main
RECORD DRAWING

JOB # 01120WAESMT	DATE: 8-25-04	SCALE: 1"=40'
	DR. LARRY CAMPBELL WATERLINE EASEMENT EXHIBIT MAP PTN. NW1/4 NW1/4 SEC. 28, TWP. 39 N., RGE. 2 E. OF W.M.	
CONSTRUCTION SURVEYORS N.W. INC. 1500 I STREET, BELLINGHAM, WA 98225 (360) 733-3383 OR (360) 384-0225		

5610 CL 7/9/12