
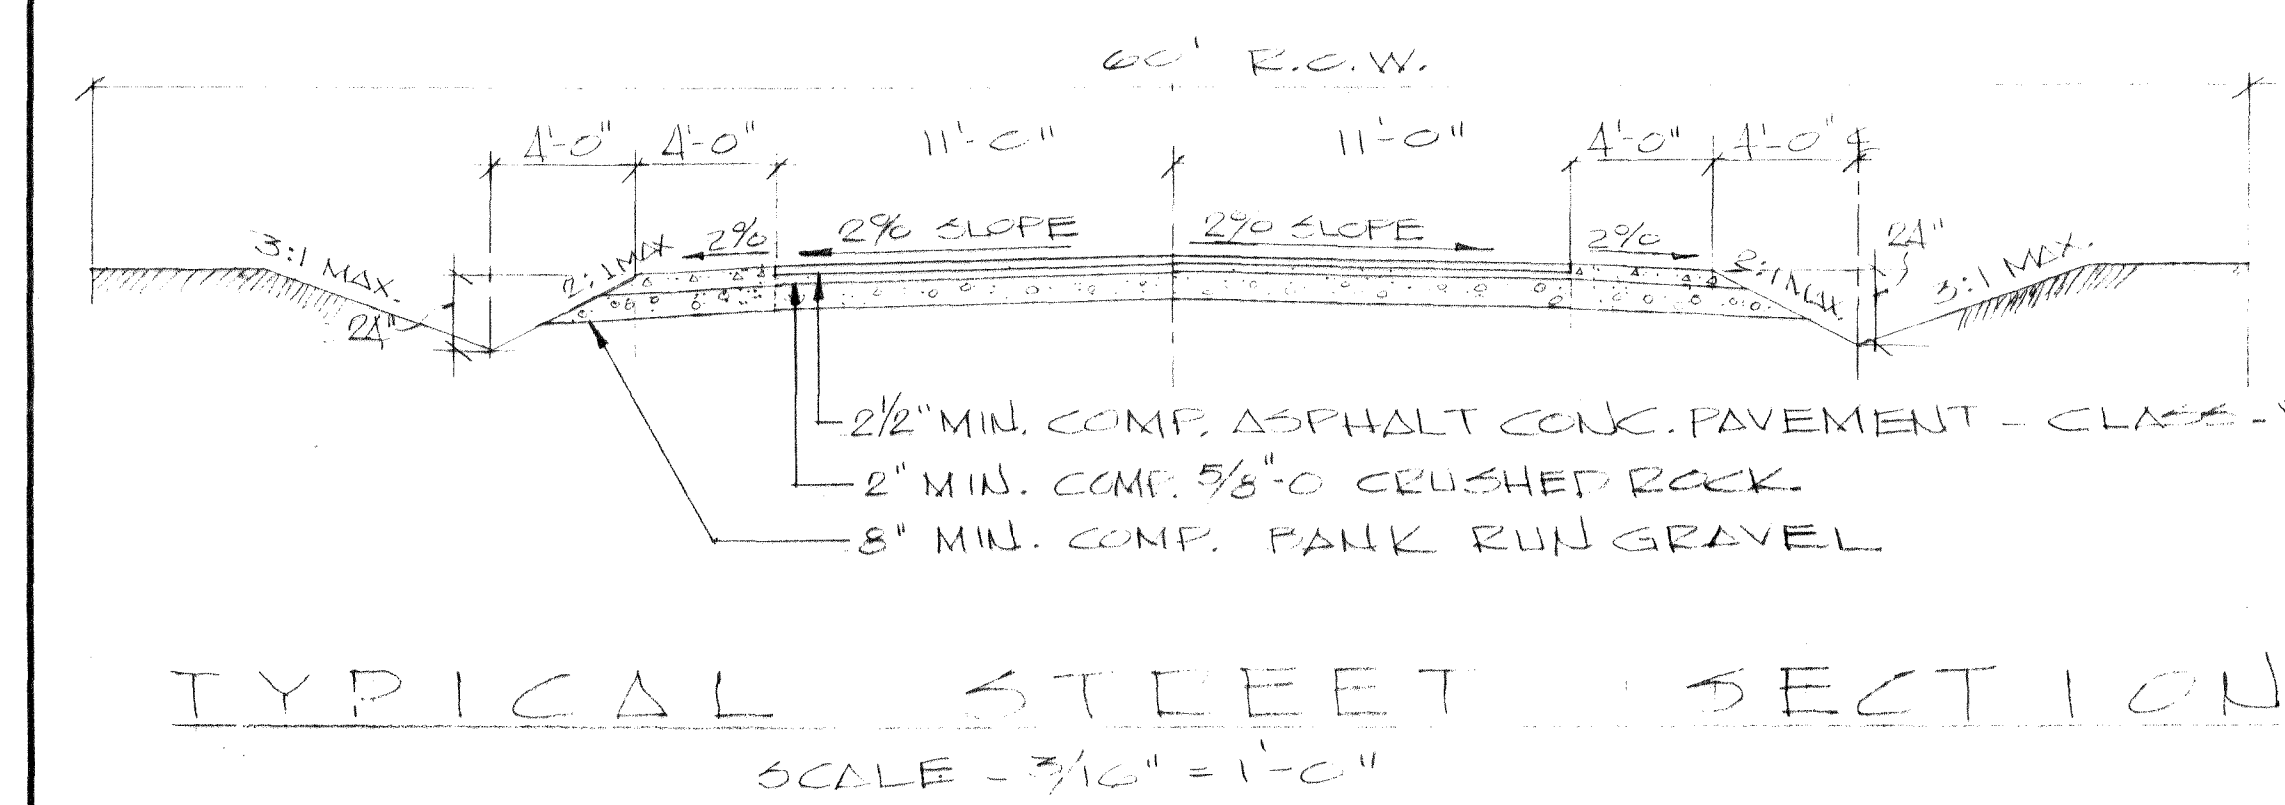
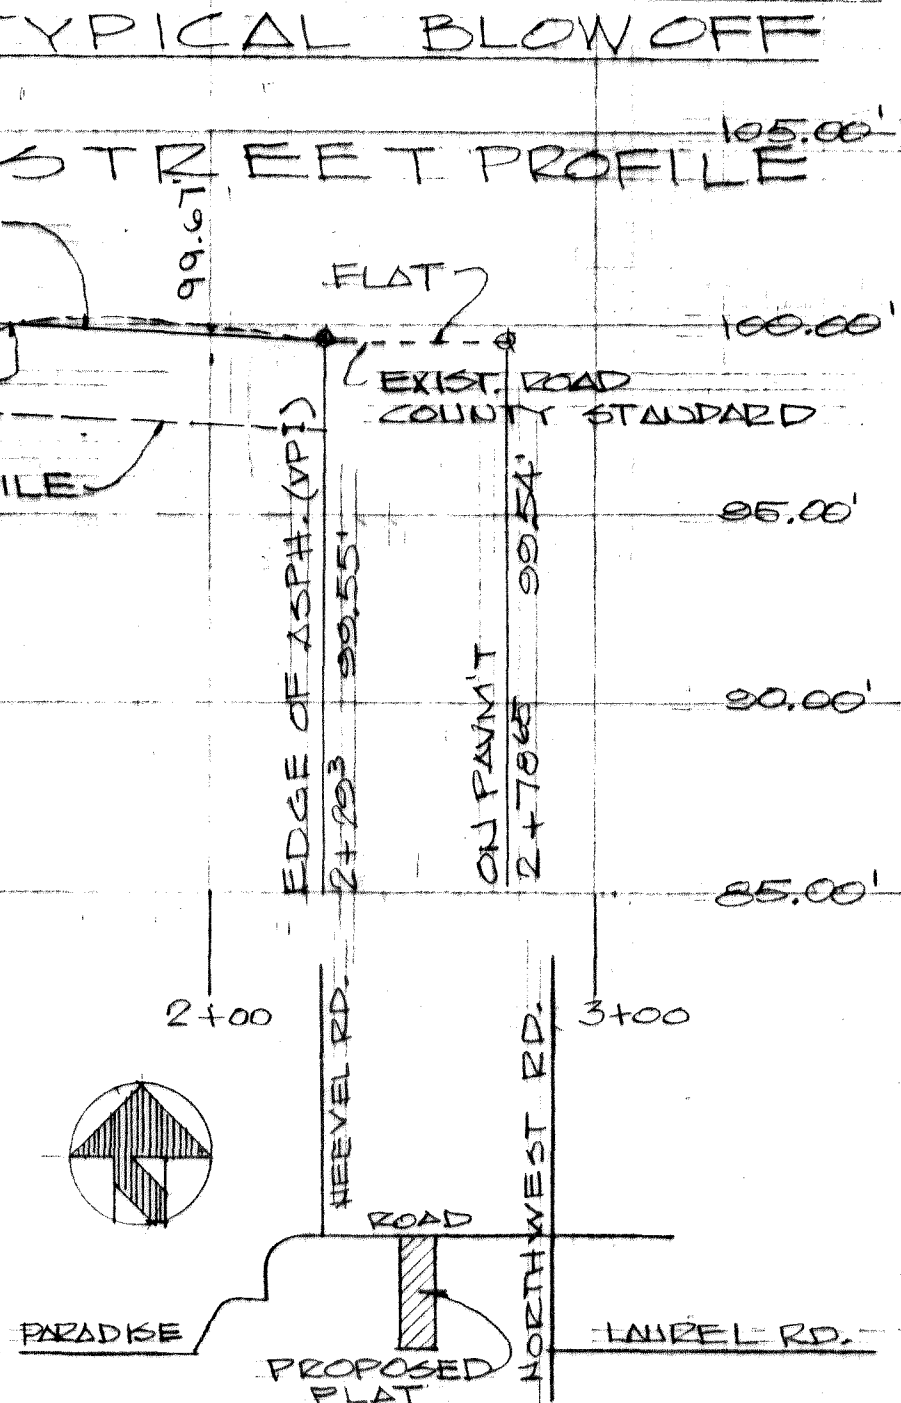
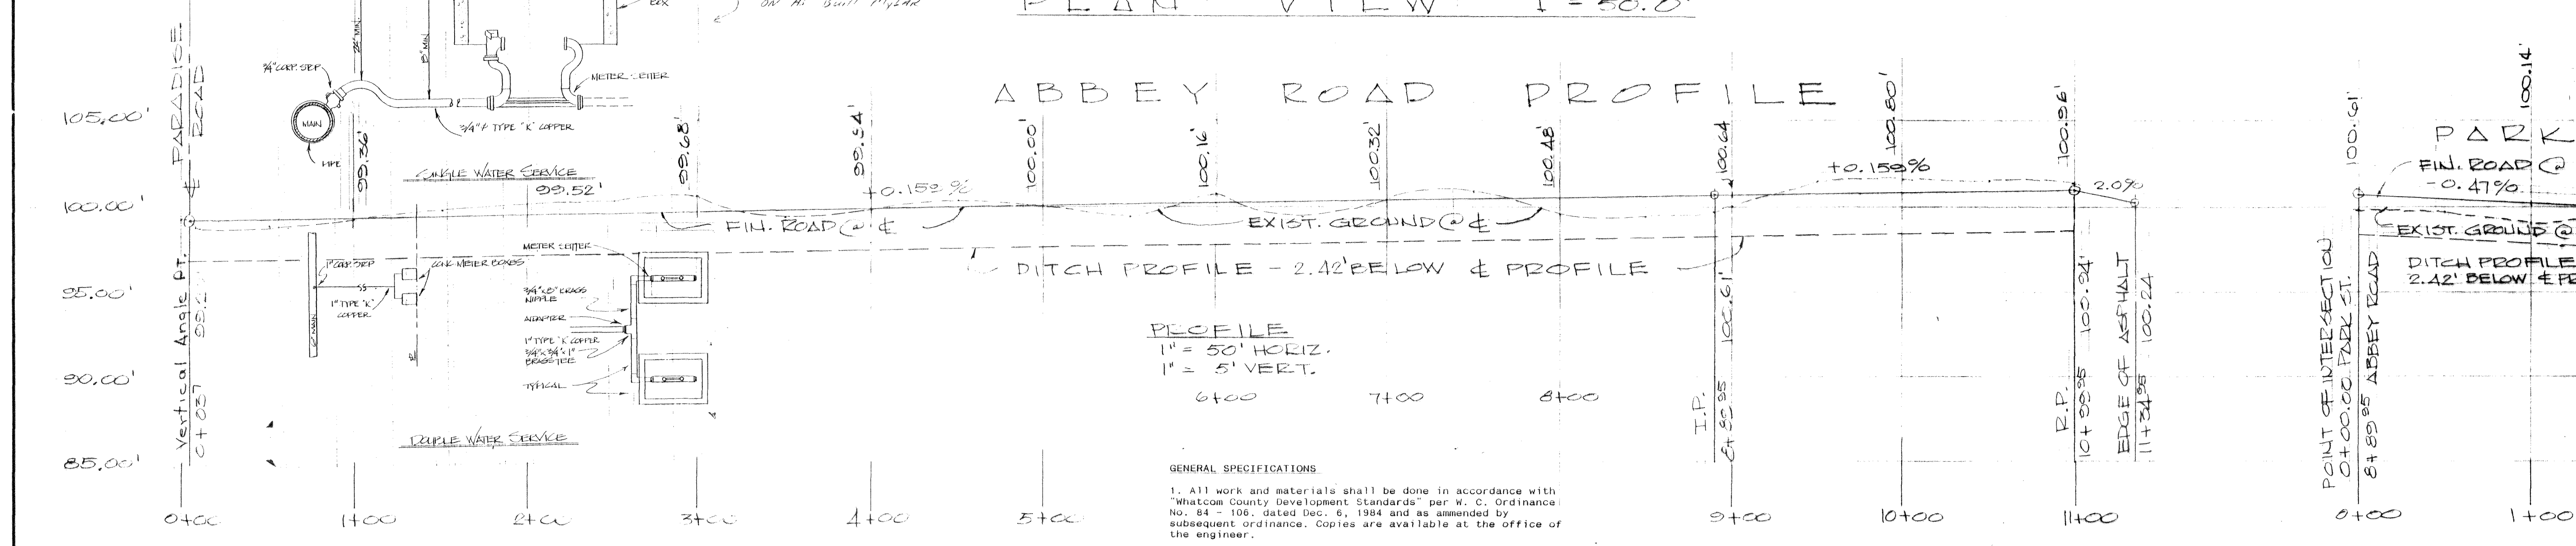
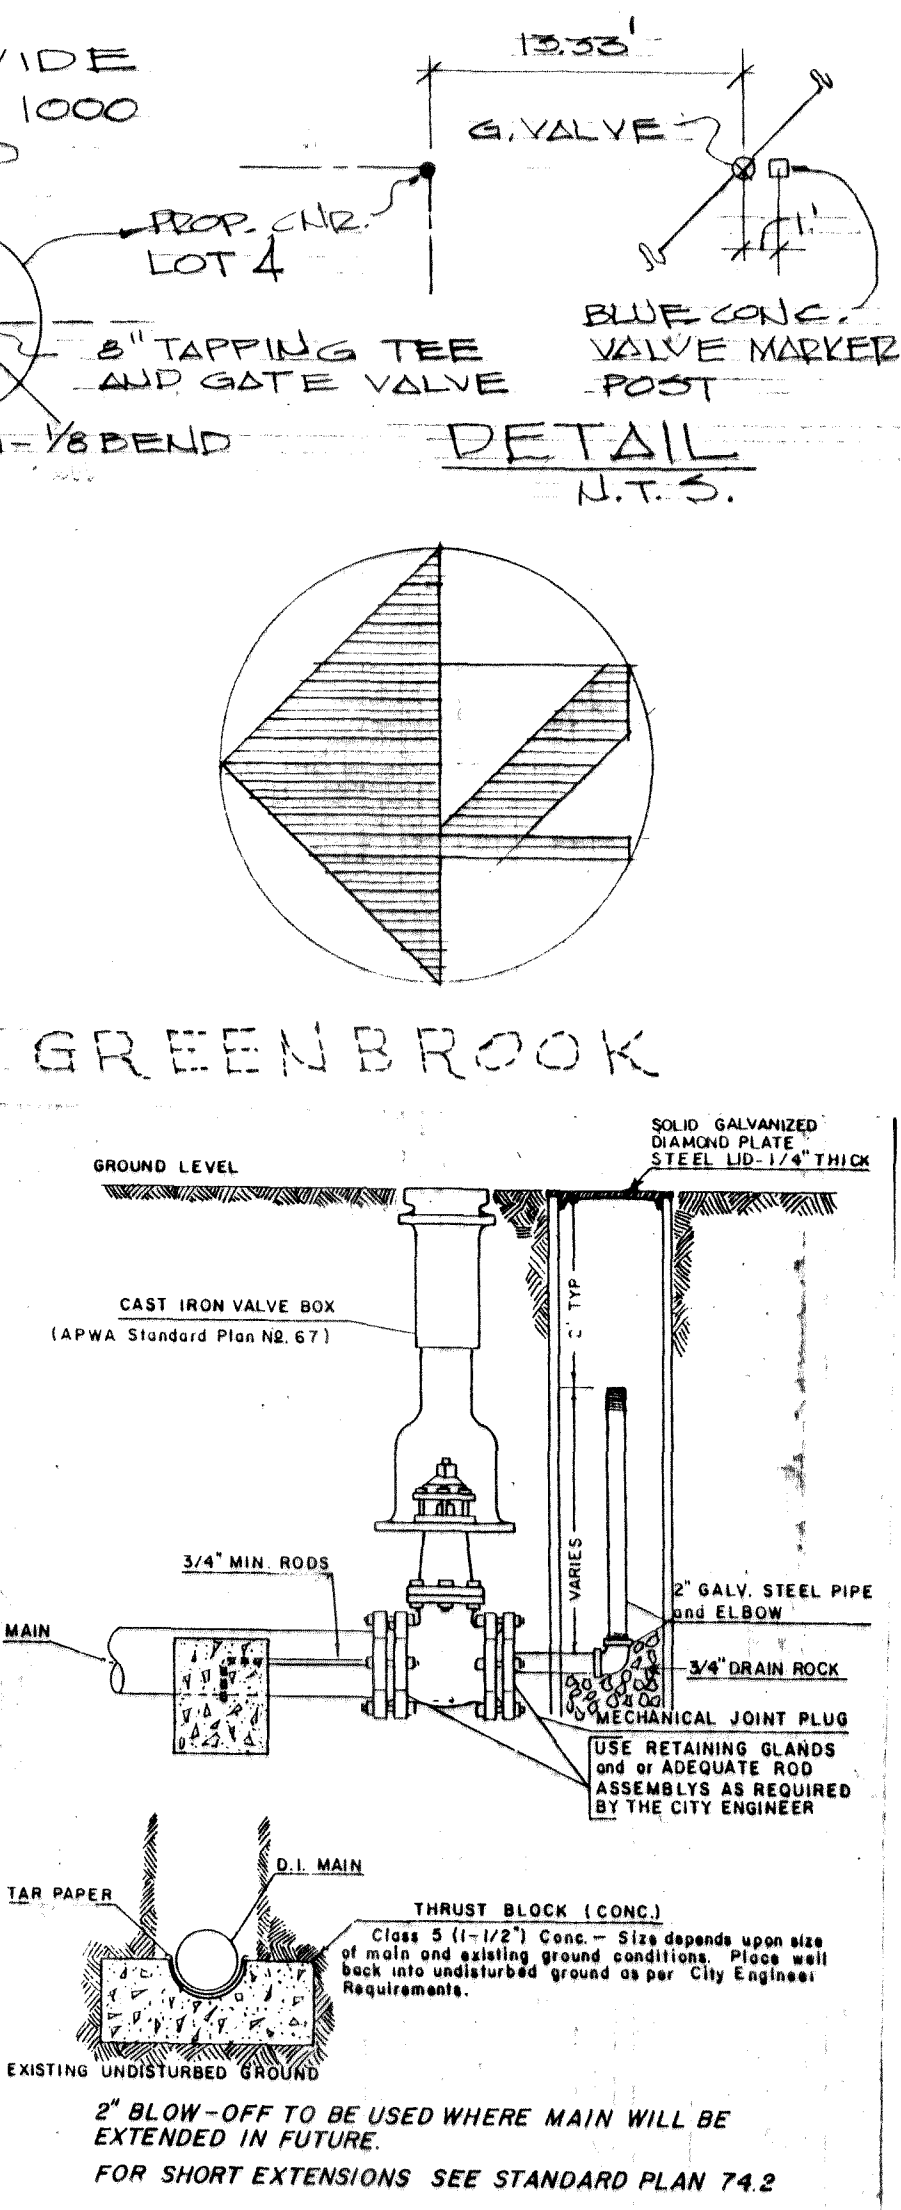


# "UNPLATTED" WHATCOM CO. CEMETERY DISTRICT NO. 6

NOTE:  
ALL DOWNSPOUTS SHALL BE DIRECTED TO A FRENCH DRAIN, TWO FEET WIDE BY TWO FOOT DEEP. MINIMUM AREA SHALL BE 40 SQUARE FEET PER 1000 SQUARE FEET OF ROOF AREA. ROCK SHALL BE CLEAN 3/4 INCH AND SHALL BE COVERED WITH APPROPRIATE SIZED FILTER FABRIC.

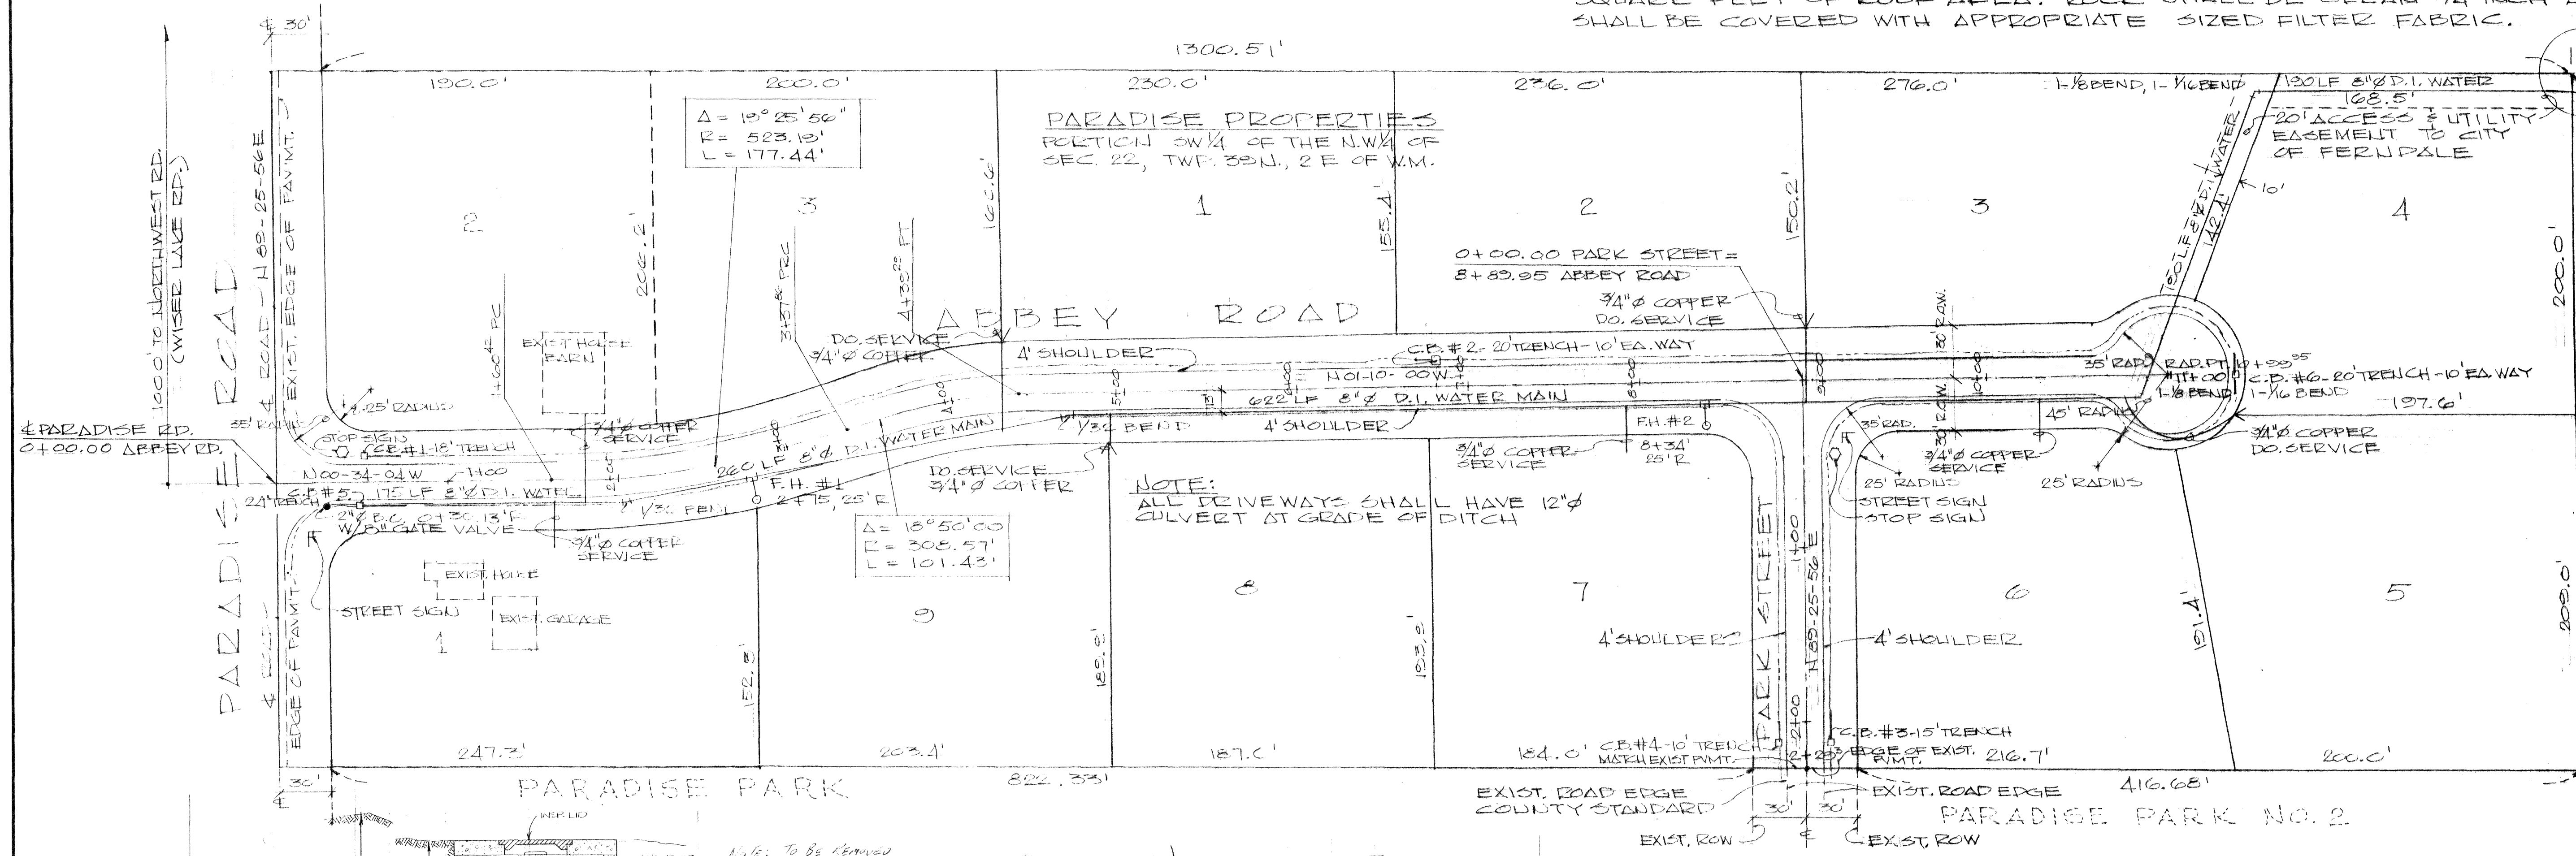


- GENERAL SPECIFICATIONS
- All work and materials shall be done in accordance with "Whatcom County Development Standards" per W. C. Ordinance No. 84 - 106, dated Dec. 6, 1984 and as amended by subsequent ordinance. Copies are available at the office of the engineer.
  - Developer shall call for County inspections as follows:
    - Placement of waterline and backfilling of waterline.
    - Roadway grading at:
      - Completion of subgrade
      - Completion of ballast
      - Completion of crushed surfacing
    - Asphalt paving in progress
    - Overall inspection for finished shoulders, ditches, and monument placement.
    - End of maintenance period
  - Developer shall notify the County Engineers Office at least 24 hours in advance of each required inspection (671 - 6730)
  - Developer shall post a maintenance security as required by the County Engineer for both time and amount, if required.
  - Proposed development is flat, soil is sandy loam and all rainfall percolates direct to water table (10' + below) No erosion control is deemed necessary.
  - Contractor shall restore all private and public property disrupted by the project.
  - Contractor shall contact Utilities Coordinating 48 hours in advance of construction (1-800-424-5555)
  - Contractor shall inform the Engineer of any proposed changes in plan prior to construction of that change. Contractor shall keep record of deviations and forward to Engineer. Engineer will provide a certified As-Built map at the completion of the project.
  - All locations of utilities shown are approximate. It shall be the responsibility of the contractor to verify the true and correct location.

- WATER MAIN & APPURTENANCES
- Water main shall be ductile iron pipe thickness Class 50. Minimum cover shall be 36 inches.
  - All Gate Valves to be AWWA C509-87. All Valve Boxes to be 2 piece Cast Iron. All Main Line Gate Valves to be referenced with a concrete valve marker post.
  - Fittings shall be cast or ductile iron flanged or mechanical joint. Concrete thrust blocking shall be the responsibility of the contractor, but shall not have less than 4 square feet of bearing against undisturbed earth.
  - Contractor shall confer with the City of Ferndale Department of Public Works regarding method of filling and pressure testing pipe prior to proceeding with construction. Test Pressure shall be a minimum of 200 psi.
  - Fire Hydrant assemblies shall be Iowa F 5110 or M&H 929 with 5-1/2" MVO, subject to City of Ferndale approval.
  - Connection to existing City water main shall be by the contractor after satisfactory completion of pressure and sanitary testing.
  - All sterilization and testing (as required) shall be conducted under the supervision of the City Engineer's Office.
  - Contractor shall contact the Engineer for inspection and location of corporation stops and water service lines prior to backfilling trenches.
  - All Work and Material shall be in accordance with City of Ferndale Standards.

- ROAD SPECIFICATIONS
- Grading and subgrade preparation shall meet the requirements of Division 2 of the WSDOT Standard Specifications.
  - Gravel base and Crushed rock surfacing for shoulders shall meet the requirements of Division 4 of the WSDOT Standard Specifications.
  - Asphalt concrete pavement shall meet the requirements of Division 5 of the WSDOT Standard Specifications. This item will include furnishing, heating, hauling, spreading, rolling and all other work incidental to fulfilling the requirements of the Specifications.
  - Any compacting testing required for the subgrade shall be the responsibility of the owner and shall be in conformance with Whatcom County Engineering Department requirements.

AS BUILT  
BY - Greg Dibble  
DATE - 12/19/92

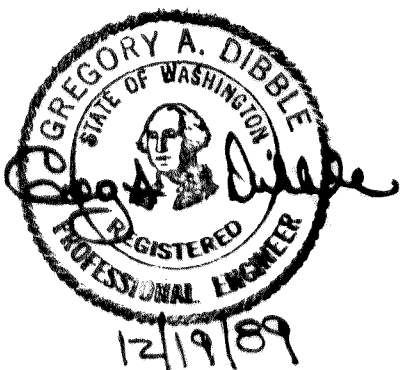

| PARADISE PROPERTIES    |              |                      |  |
|------------------------|--------------|----------------------|--|
| SCALE: 1"=500'         | APPROVED BY: | DRAWN BY T.F.R.      |  |
| DATE: 12/13/89         |              | REVISED              |  |
| ROAD AND WATER DESIGN  |              |                      |  |
| VICTOR & CARRIE LUNICK |              | DRAWING NUMBER 40489 |  |