



SEC.34, T.39 N., R.2 E.


LEGEND

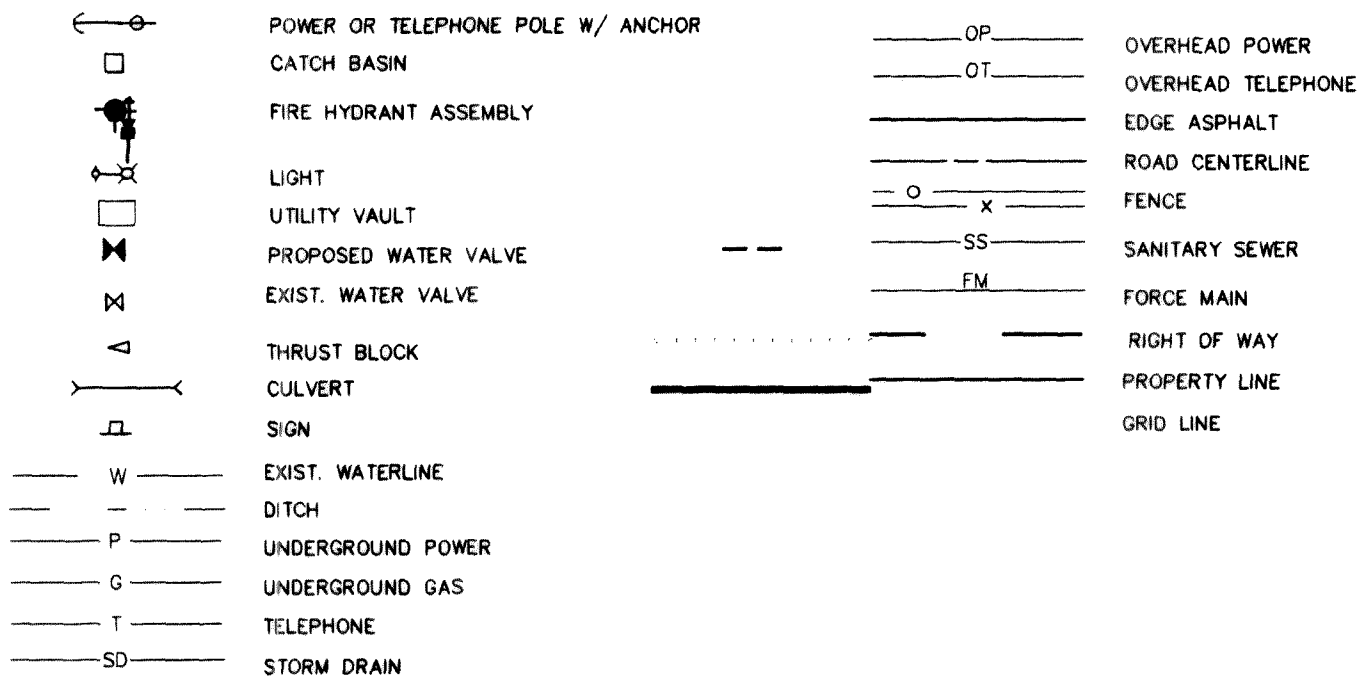


SITE LOCATION

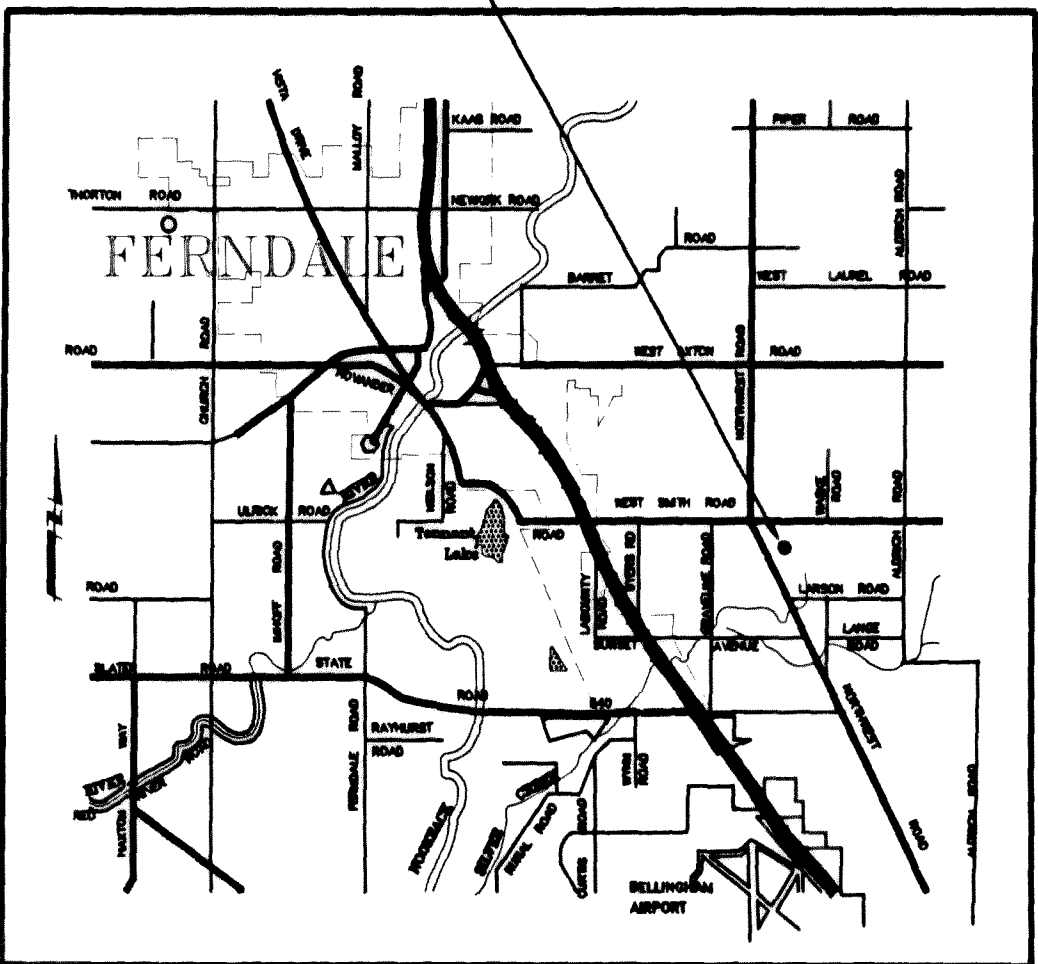


VICINITY MAP
NTS

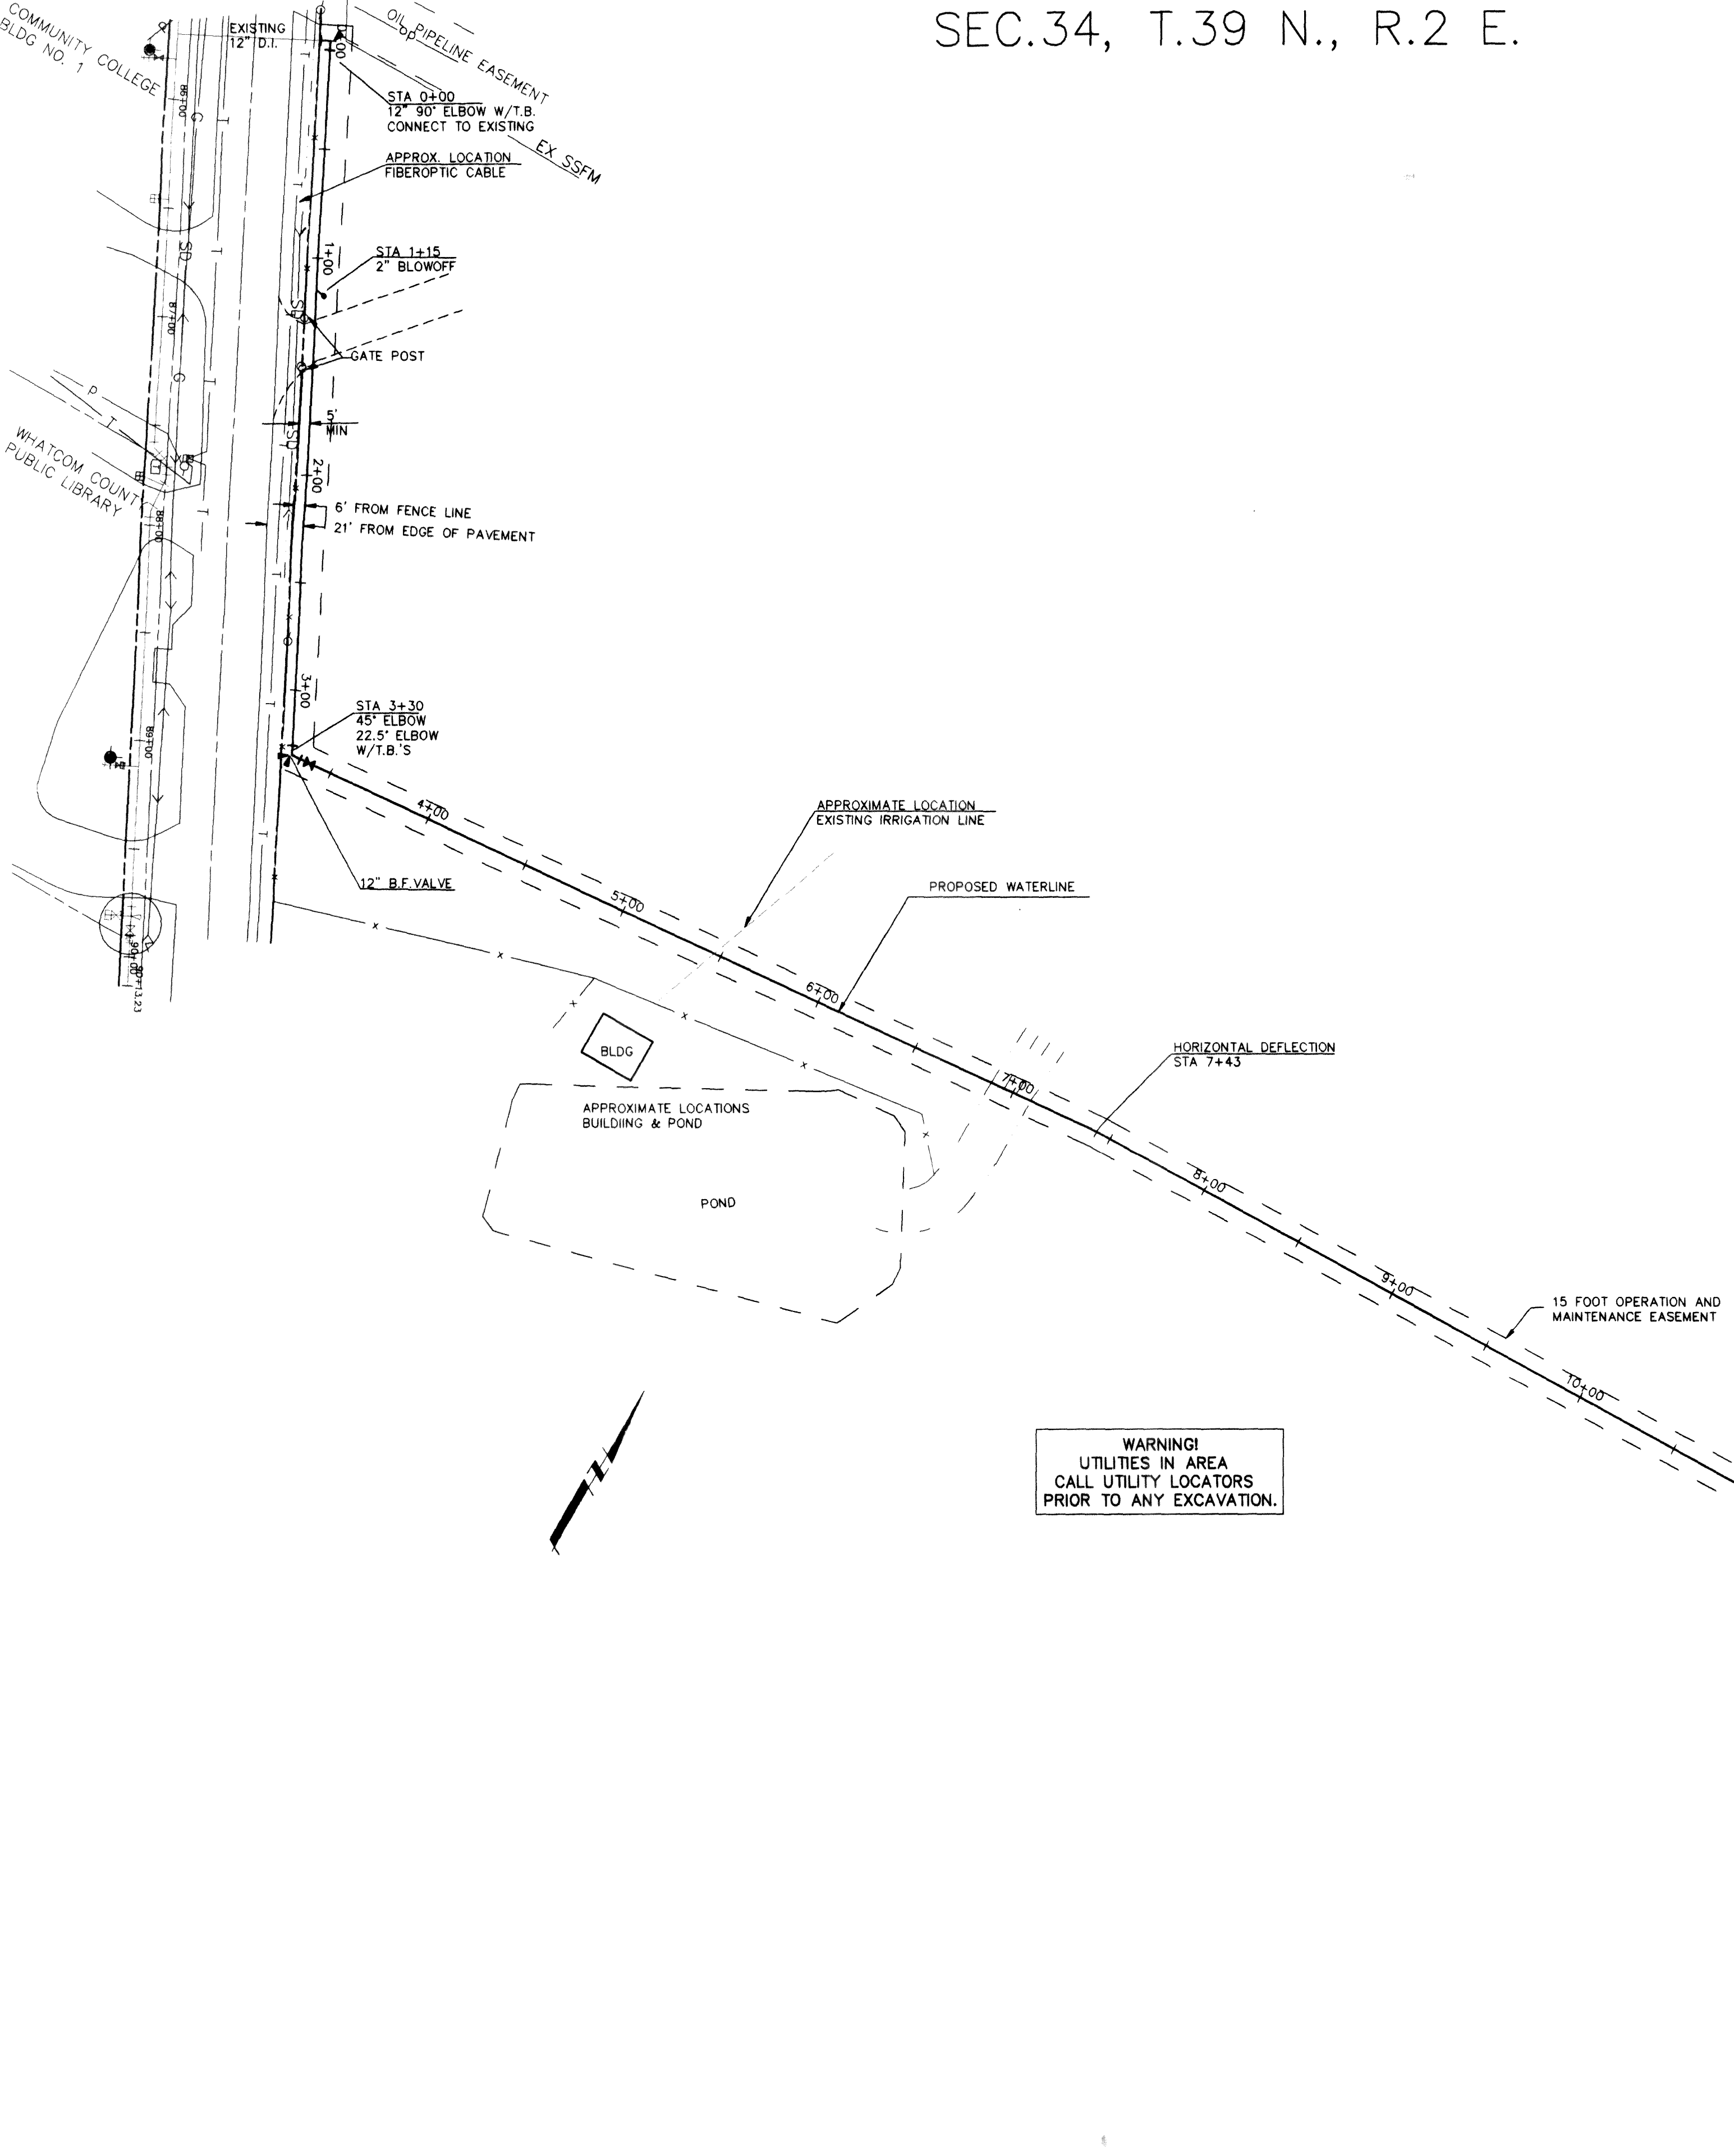

WARNING!
UTILITIES IN AREA
CALL UTILITY LOCATORS
PRIOR TO ANY EXCAVATION.

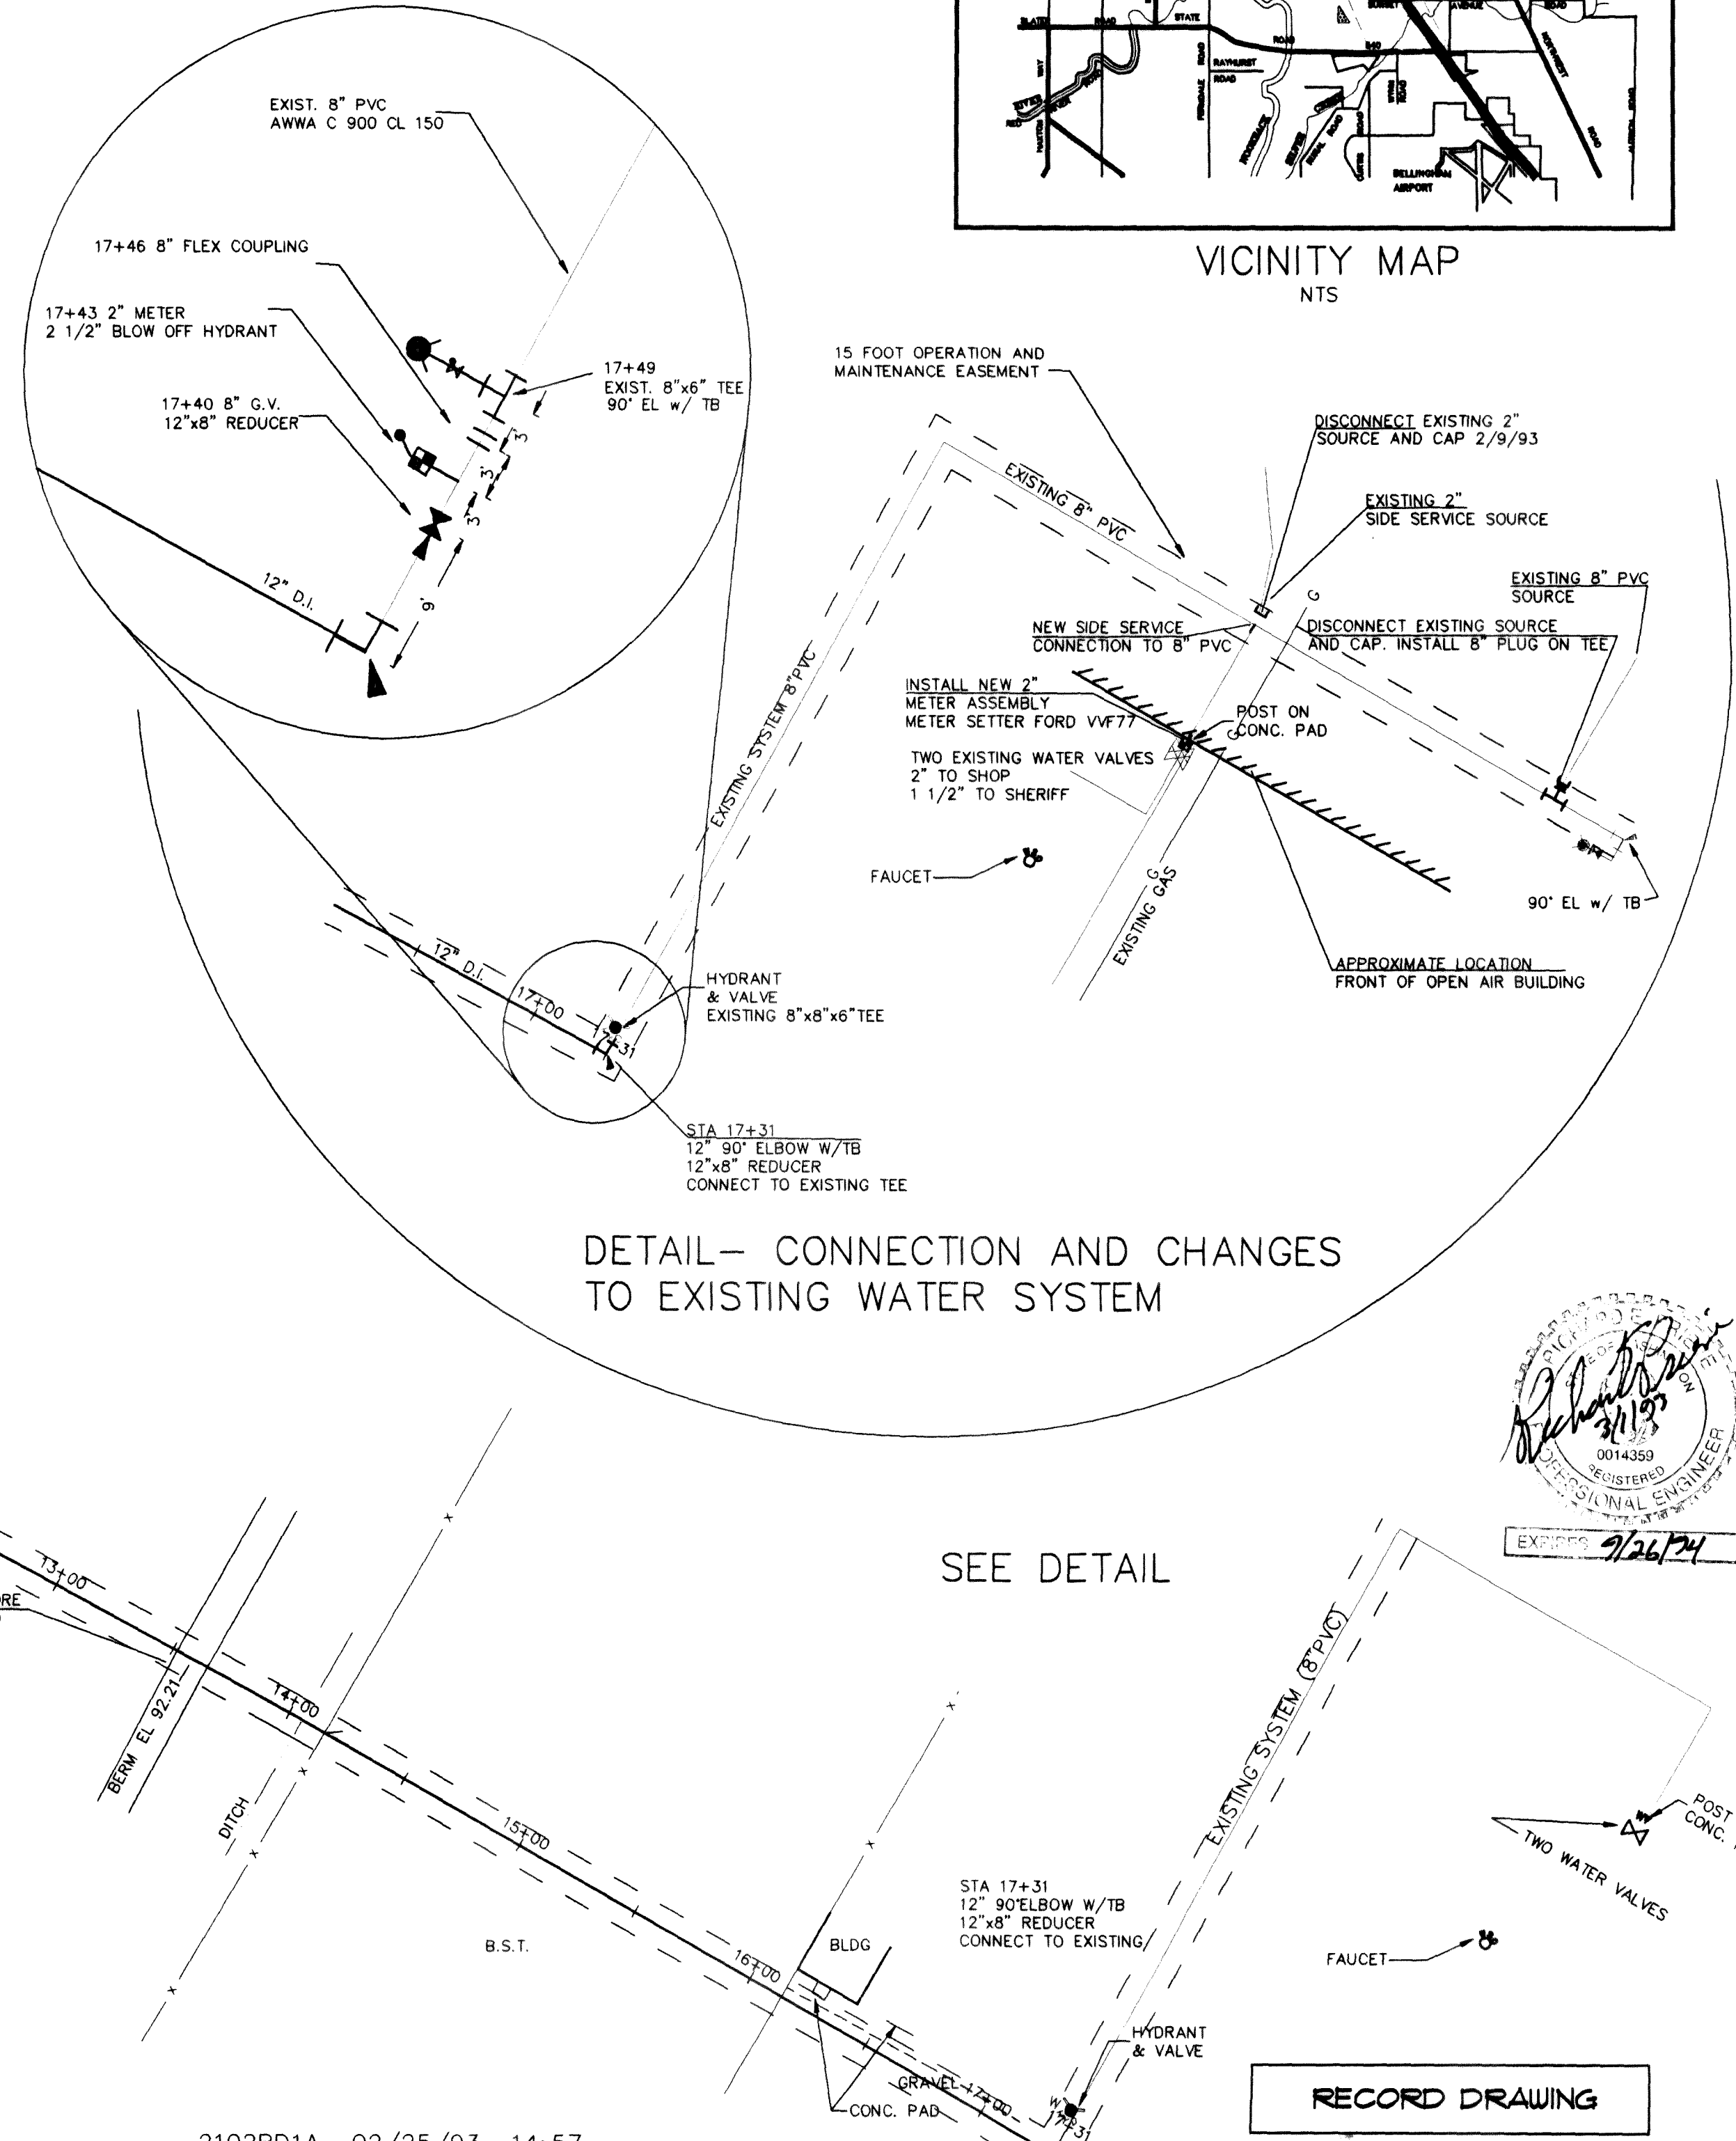


DETAIL- CONNECTION AND CHANGES
TO EXISTING WATER SYSTEM

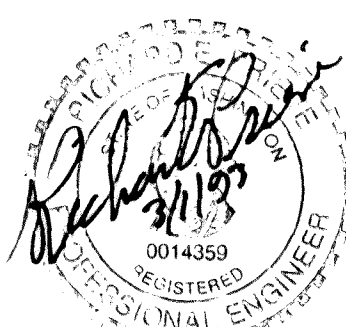

EX-100 9/26/24

NO.	REVISIONS	BY	DATE

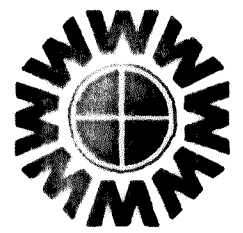

WEDEN ENGINEERING, INC.
119 GRAND AVENUE, SUITE D,
BELLINGHAM, WA. 98225 671-8200

ONE INCH AT FULL SCALE
IF NOT ONE INCH
SCALE ACCORDINGLY

DESIGNED BY
DRAWN BY
CHECKED BY

**WATERLINE EXTENSION
CENTRAL SHOP
SMITH ROAD WATER EXTENSION PROJECT**

DATE
11/4/92
SCALE
1"=50' HOR
REC. NO.
92102


SHEET
1
OF
2

2102RD1A 02/25/93 14:57

RECORD DRAWING


00276.002 2.3.06 KR

RECORD DRAWING

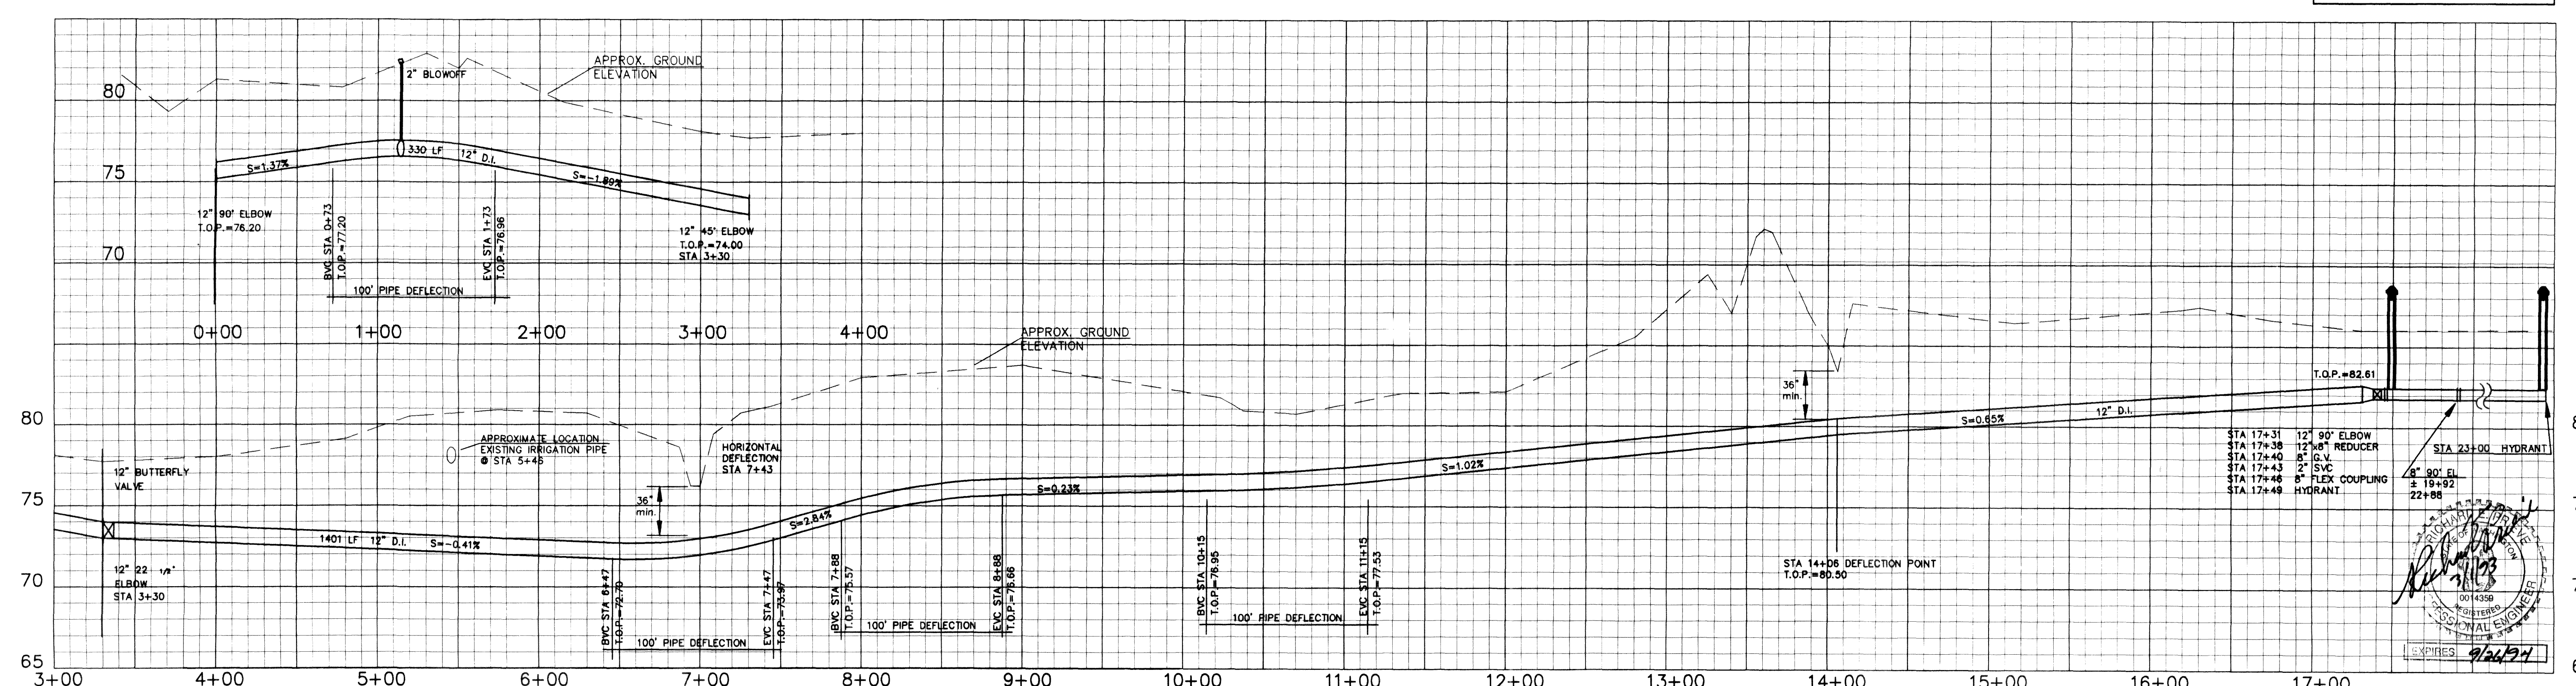

2102RD2A 02/25/93 15:38

RECORD DRAWING	JLW	2/25/93
NO.	REVISIONS	BY DATE

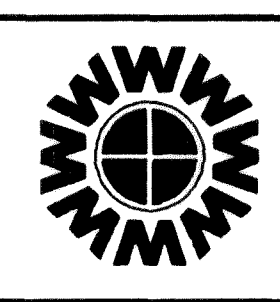

WEDEN ENGINEERING, INC.
119 GRAND AVENUE, SUITE D,
BELLINGHAM, WA. 98225 671-8200

ONE INCH AT FULL SCALE
IF NOT ONE INCH
SCALE ACCORDINGLY

DESIGNED BY
DRAWN BY
CHECKED BY

**WATERLINE EXTENSION
WHATCOM COUNTY CENTRAL SHOP
SMITH ROAD WATER EXTENSION PROJECT**

DATE 11/4/92
SCALE 1"=50'HOR
1"=5'VERT
REC. NO. 92102
SHEET 2 OF 2