


SHARON'S SHORT PLAT NO. 4

SCALE: 1"=50'

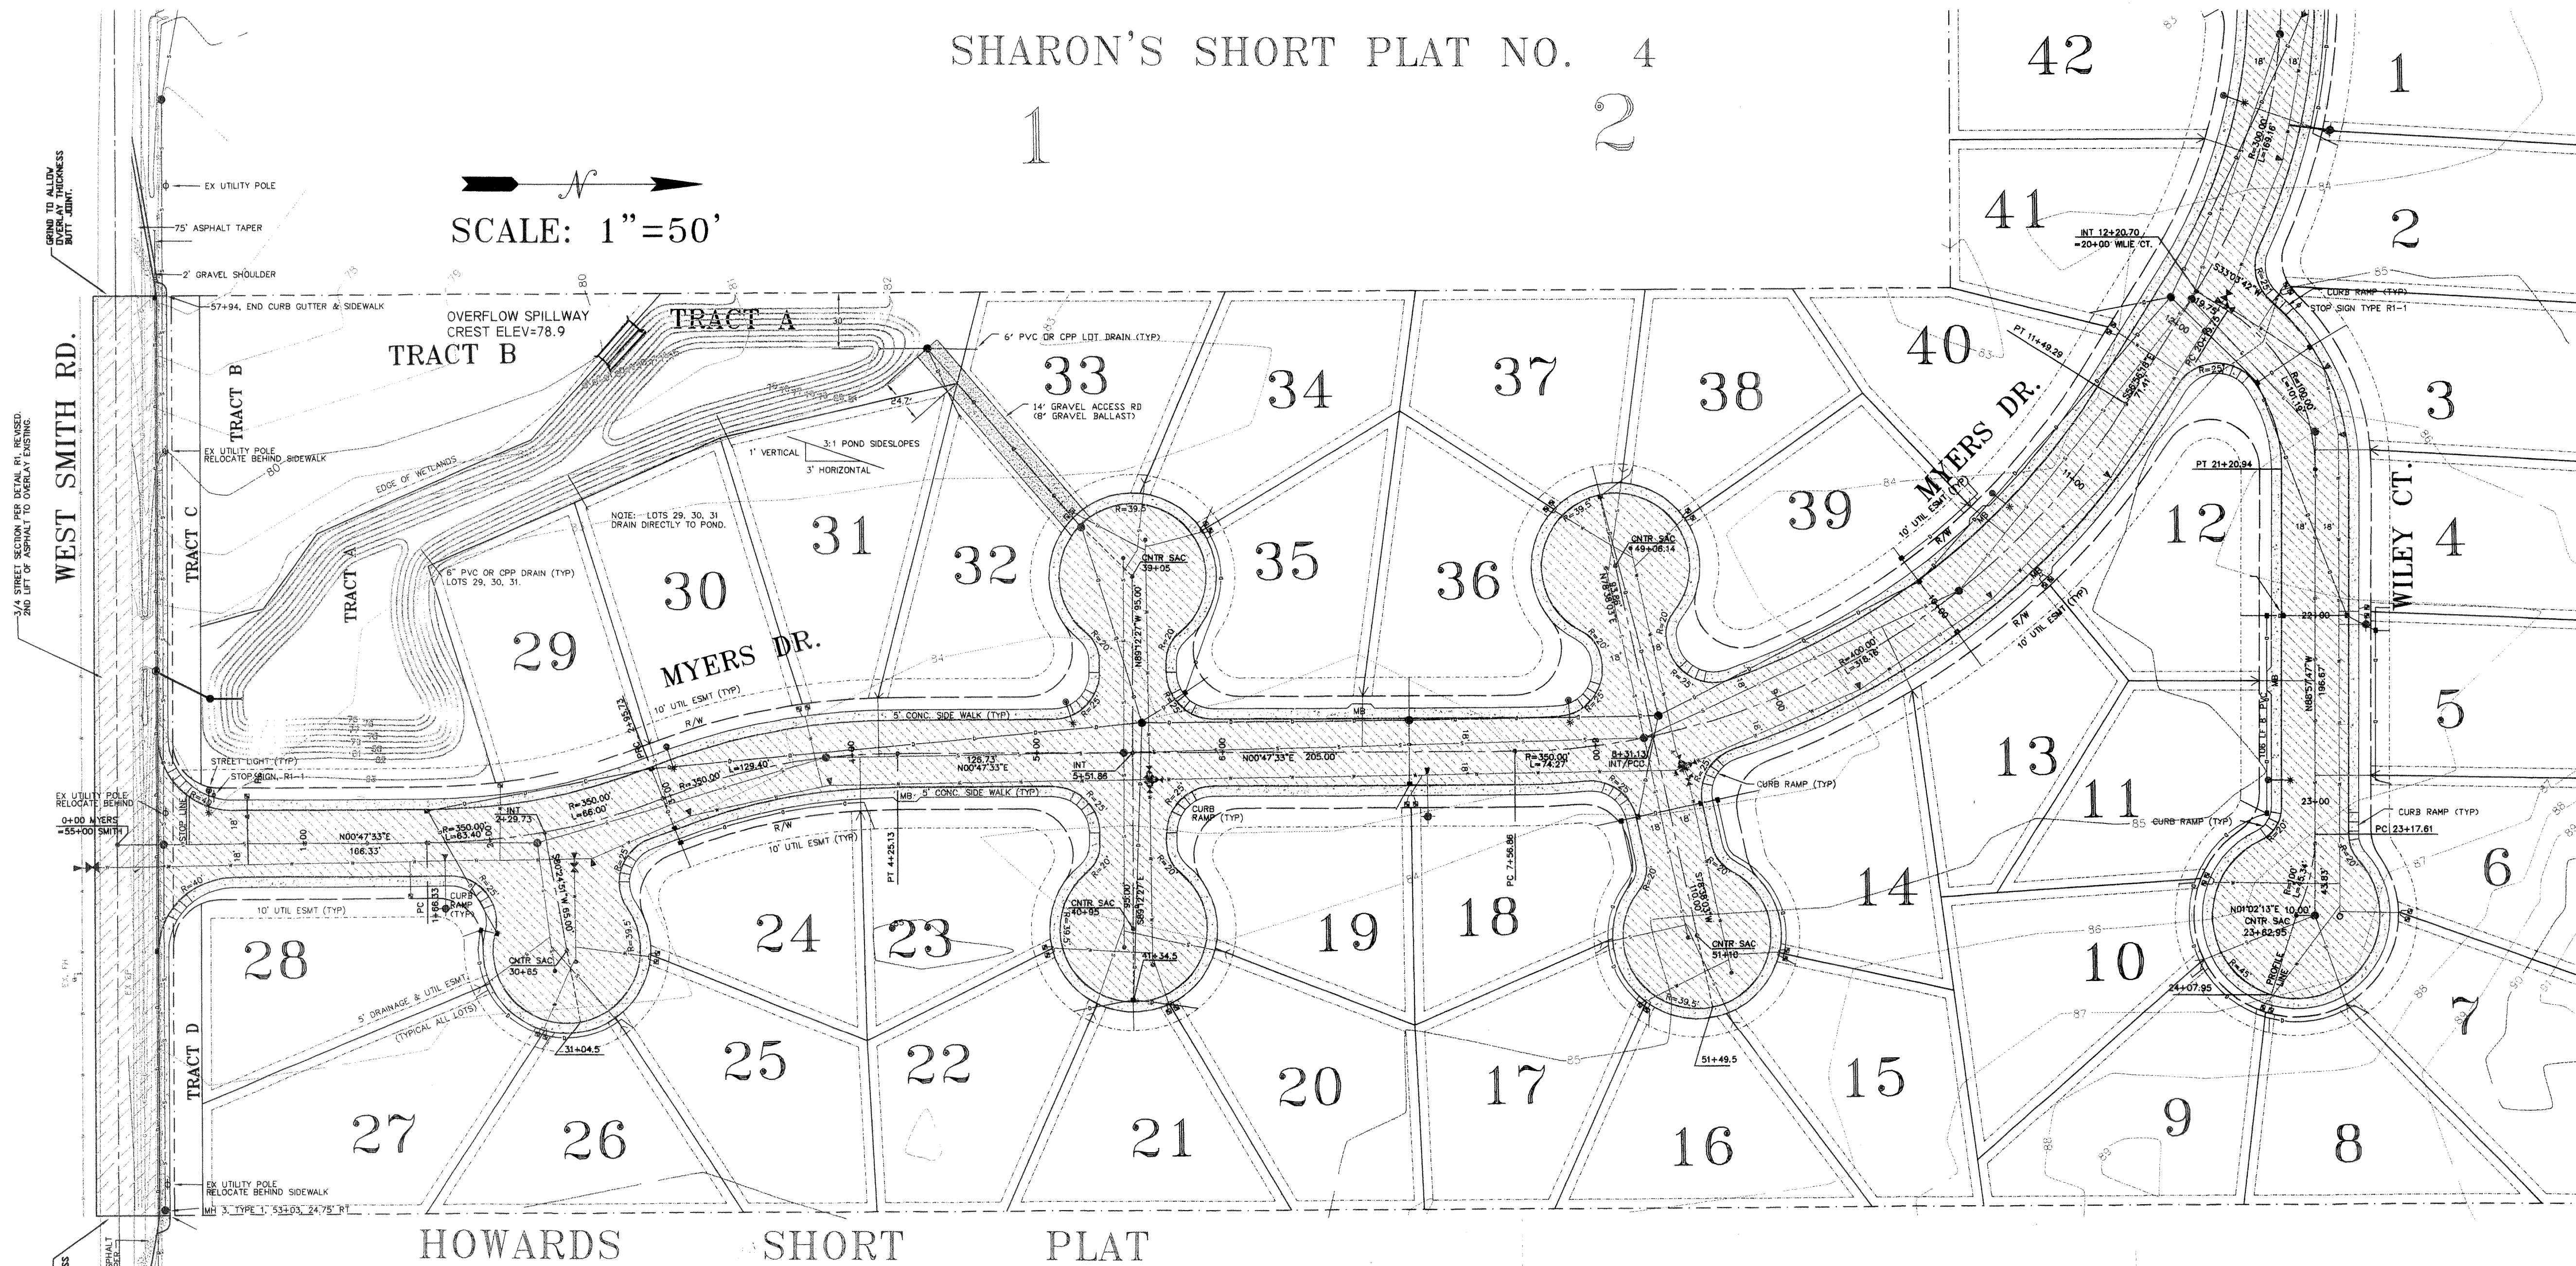

ABBREVIATIONS

CB - CATCH BASIN
CMP - CORRUGATED METAL PIPE
CNTR - CENTER
CPP - CORRUGATED POLYETHYLENE PIPE
CO - CLEAN OUT
CR - CURB RETURN
CT - COURT
DR - DRIVE
ELL - ELBOW
EP - EDGE OF PAVEMENT
ESMT - EASEMENT
EX - EXISTING
FH - FIRE HYDRANT
G - GUTTER
GG - GUTTER GRADE
GHP - GUTTER HIGH POINT
GV - GATE VALVE
HORIZ - HORIZONTAL
INT - INTERSECTION
INV - INVERT
L - LENGTH
LF - LINEAL FEET
LT - LEFT
MB - MAIL BOXES
MH - MAN HOLE
PC - POINT OF CURVATURE
PCC - POINT OF COMPOUND CURVATURE
PRC - POINT OF REVERSE CURVATURE
PT - POINT OF TANGENCY
R - RADIUS
RT - RIGHT
R/W - RIGHT OF WAY
S - SLOPE
SAC - CUL DE SAC
STA - STATION
TB - THRUST BLOCK
TYP - TYPICAL
UTIL - UTILITIES
VERT - VERTICAL
VPC - VERTICAL POINT OF CURVATURE
VPI - VERTICAL POINT OF INTERSECTION
VPT - VERTICAL POINT OF TANGENCY
W - WATER


CONTACT INFORMATION

Surveyor:
Construction Surveyors, Inc.
1500 1 street
Bellingham, WA 98225
360-733-3383
Project Engineer - Craig Olson, PE
Madrona Engineering
2113 Tuttle Lane
Lummi Island, WA 98226
360-758-3150
Wetlands Consultant
Pegasus Eco-Terrestrial
2701 Northwest Ave, Suite B
Bellingham, WA 98226
360-647-8552

GENERAL NOTES:

- All work and materials shall conform with applicable requirements set forth in the current edition of the City of Ferndale Development Standards (COFDS). All relevant elements of COFDS are hereby incorporated into this plan by reference.
- All work and materials shall conform with requirements set forth in the current edition of Standard Plans and Standard Specifications for Road, Bridge, and Municipal Construction, published by the Washington State Department of Transportation and the American Public Works Association, (herein after referred to as "WSDOT") except as modified herein. All relevant elements of WSDOT are hereby incorporated into this plan by reference. In the event of conflict between COFDS and WSDOT standards, the more stringent requirement shall apply.
- MAINTENANCE SECURITY:** All facilities within this Plat shall be publicly maintained. As such, the Contractor is required to provide maintenance securities to the City of Ferndale in accordance with Section 502 of COFDS.
- Existing utilities locations shown on this plan are presented in a general way only and are not necessarily complete. Locations of all existing utilities shall be independently verified by the Contractor prior to beginning construction. Call DIAL DIG at 1-800-424-5555 a minimum of 48 hours prior to beginning work. Any utilities, whether shown or not shown on this plan, which are damaged by the Contractor as a result of implementation of this plan shall be repaired or replaced by the Contractor at no additional cost to the Owner or Engineer.
- All topographic data, including elevations of existing drainage, sewer and other structures was provided by Construction Surveyors, Inc. and was not independently verified by the Engineer. Contractor is responsible for verifying pertinent data prior to commencing related work.
- Contractor shall promptly inform the Project Engineer (Craig Olson, P.E. 360-758-3150) or his appointee of any changes to the plan prior to construction of the change. Contractor shall keep a record of all changes to the plan and forward to the Project Engineer or his appointee at the first of each month and more often if requested by the Project Engineer or his appointee.
- Contractor shall provide temporary and permanent traffic control facilities in conformance with the Manual On Uniform Traffic Control Devices (MUTCD), current edition, and as required by the City of Ferndale.
- Contractor shall provide street illumination facilities in accordance with Section 707 of the COFDS. 100 watt High Pressure Sodium lamps installed on standard concrete octagon or round poles no less than 25 feet high and spaced not more than 250 feet apart. Pole locations are shown on the plan. Contractor shall conform with specifications shown in WSDOT Standard Plan J-11a unless otherwise approved by the Public Works Director.
- Contractor shall restore all Public and Private property disrupted by the project to the satisfaction of the City of Ferndale.
- Contractor shall obtain all required permits prior to commencement of the work.
- Other Utilities and/or their subcontractors may be working in the area of this project. Contractor shall cooperate fully with other utilities and with the Engineer, and reviewing agency personnel.
- All subgrade embankment, roadway gravel base, and trench backfill including, but not limited to, sanitary sewer lines, side sewers, storm drains, storm drain services, water mains and water services, shall be City Approved material. Where material is to be placed within road right-of-way or under concrete or asphalt surfaces, whether existing or proposed, said material shall be placed in maximum 8" (eight inch) lifts loose thickness, and compacted to 95% of maximum density as determined by ASTM D1559 or ASTM STP 399. Materials placed elsewhere shall be placed in 12" (twelve inch) lifts, loose thickness, and compacted to 90% of maximum density per ASTM D1559 or ASTM STP 399. Testing shall be performed by a qualified testing company prior to acceptance by the City of Ferndale.
- Routine and final cleanup shall be included in the work.
- Unless directed otherwise by the Owner or Project Engineer, stripped organic and excess excavation material shall become the property of the Contractor and shall be disposed of at a location arranged by the Contractor at no additional cost to the Owner or Engineer. (Also see Other Notes.)

I hereby certify that the Civil improvements in the Plat of Myers Estates have been reviewed by Madrona Engineering and constructed in general conformance with the plans approved by the Public Works Director for said development and the general specifications adopted by the City of Ferndale Department of Public Works.

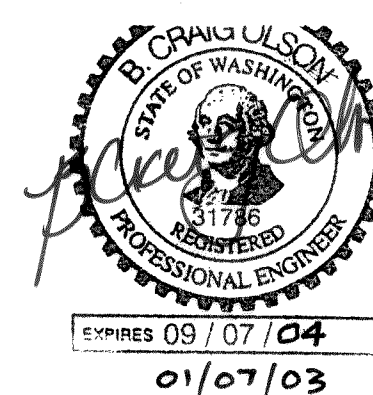

VICINITY MAP

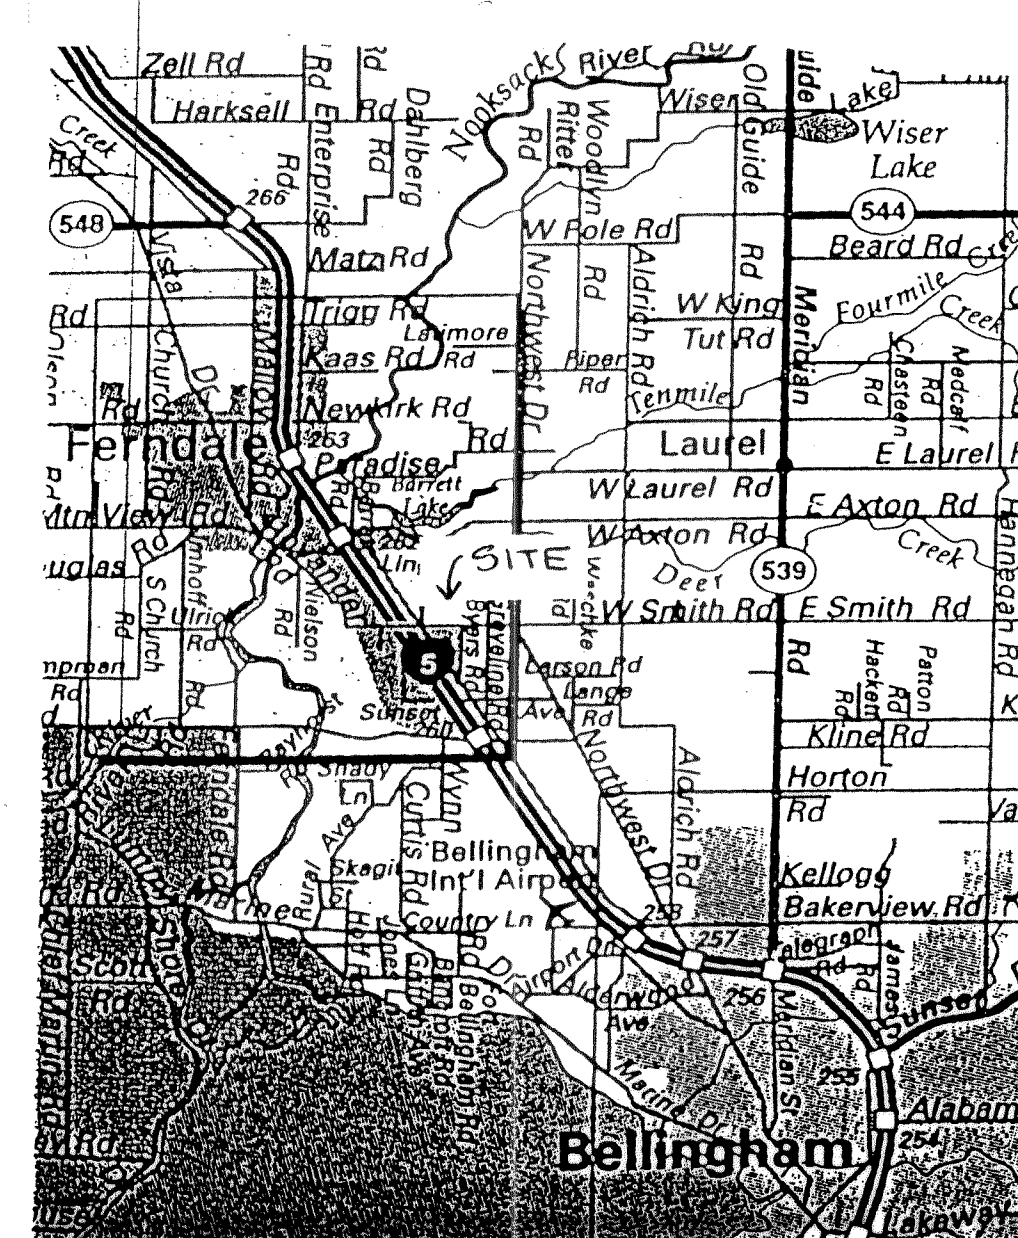


TABLE OF CONTENT

SHEET NO.	DESCRIPTION
1	Cover Sheet
2	Road & Storm Drain Plan & Profile 1
3	Road & Storm Drain Plan & Profile 2
4	Cul-de-sac # 2 & #3
5	Cul-de-sac #1, #4, #5
6	Detention Pond Plan
7	Water and Sanitary Sewer Plan & Profile 1
8	Water and Sanitary Sewer Plan & Profile 2
9	Smith Road Improvements
10	Water and Sanitary Sewer Notes & Details
11	Stormwater Pollution Prevention Plan
12	Construction Notes & Details

AS-BUILT

As-Built surveys were conducted October 31 and November 20, 2002 by Construction Surveyors Northwest, Inc. Bellingham, Washington.

Civil Construction Plans

Plat of Myers Estates

Madrona Engineering


SHEET:

1

OF: 12

CONTINUED ON SHEET 9

WEST SMITH RD.

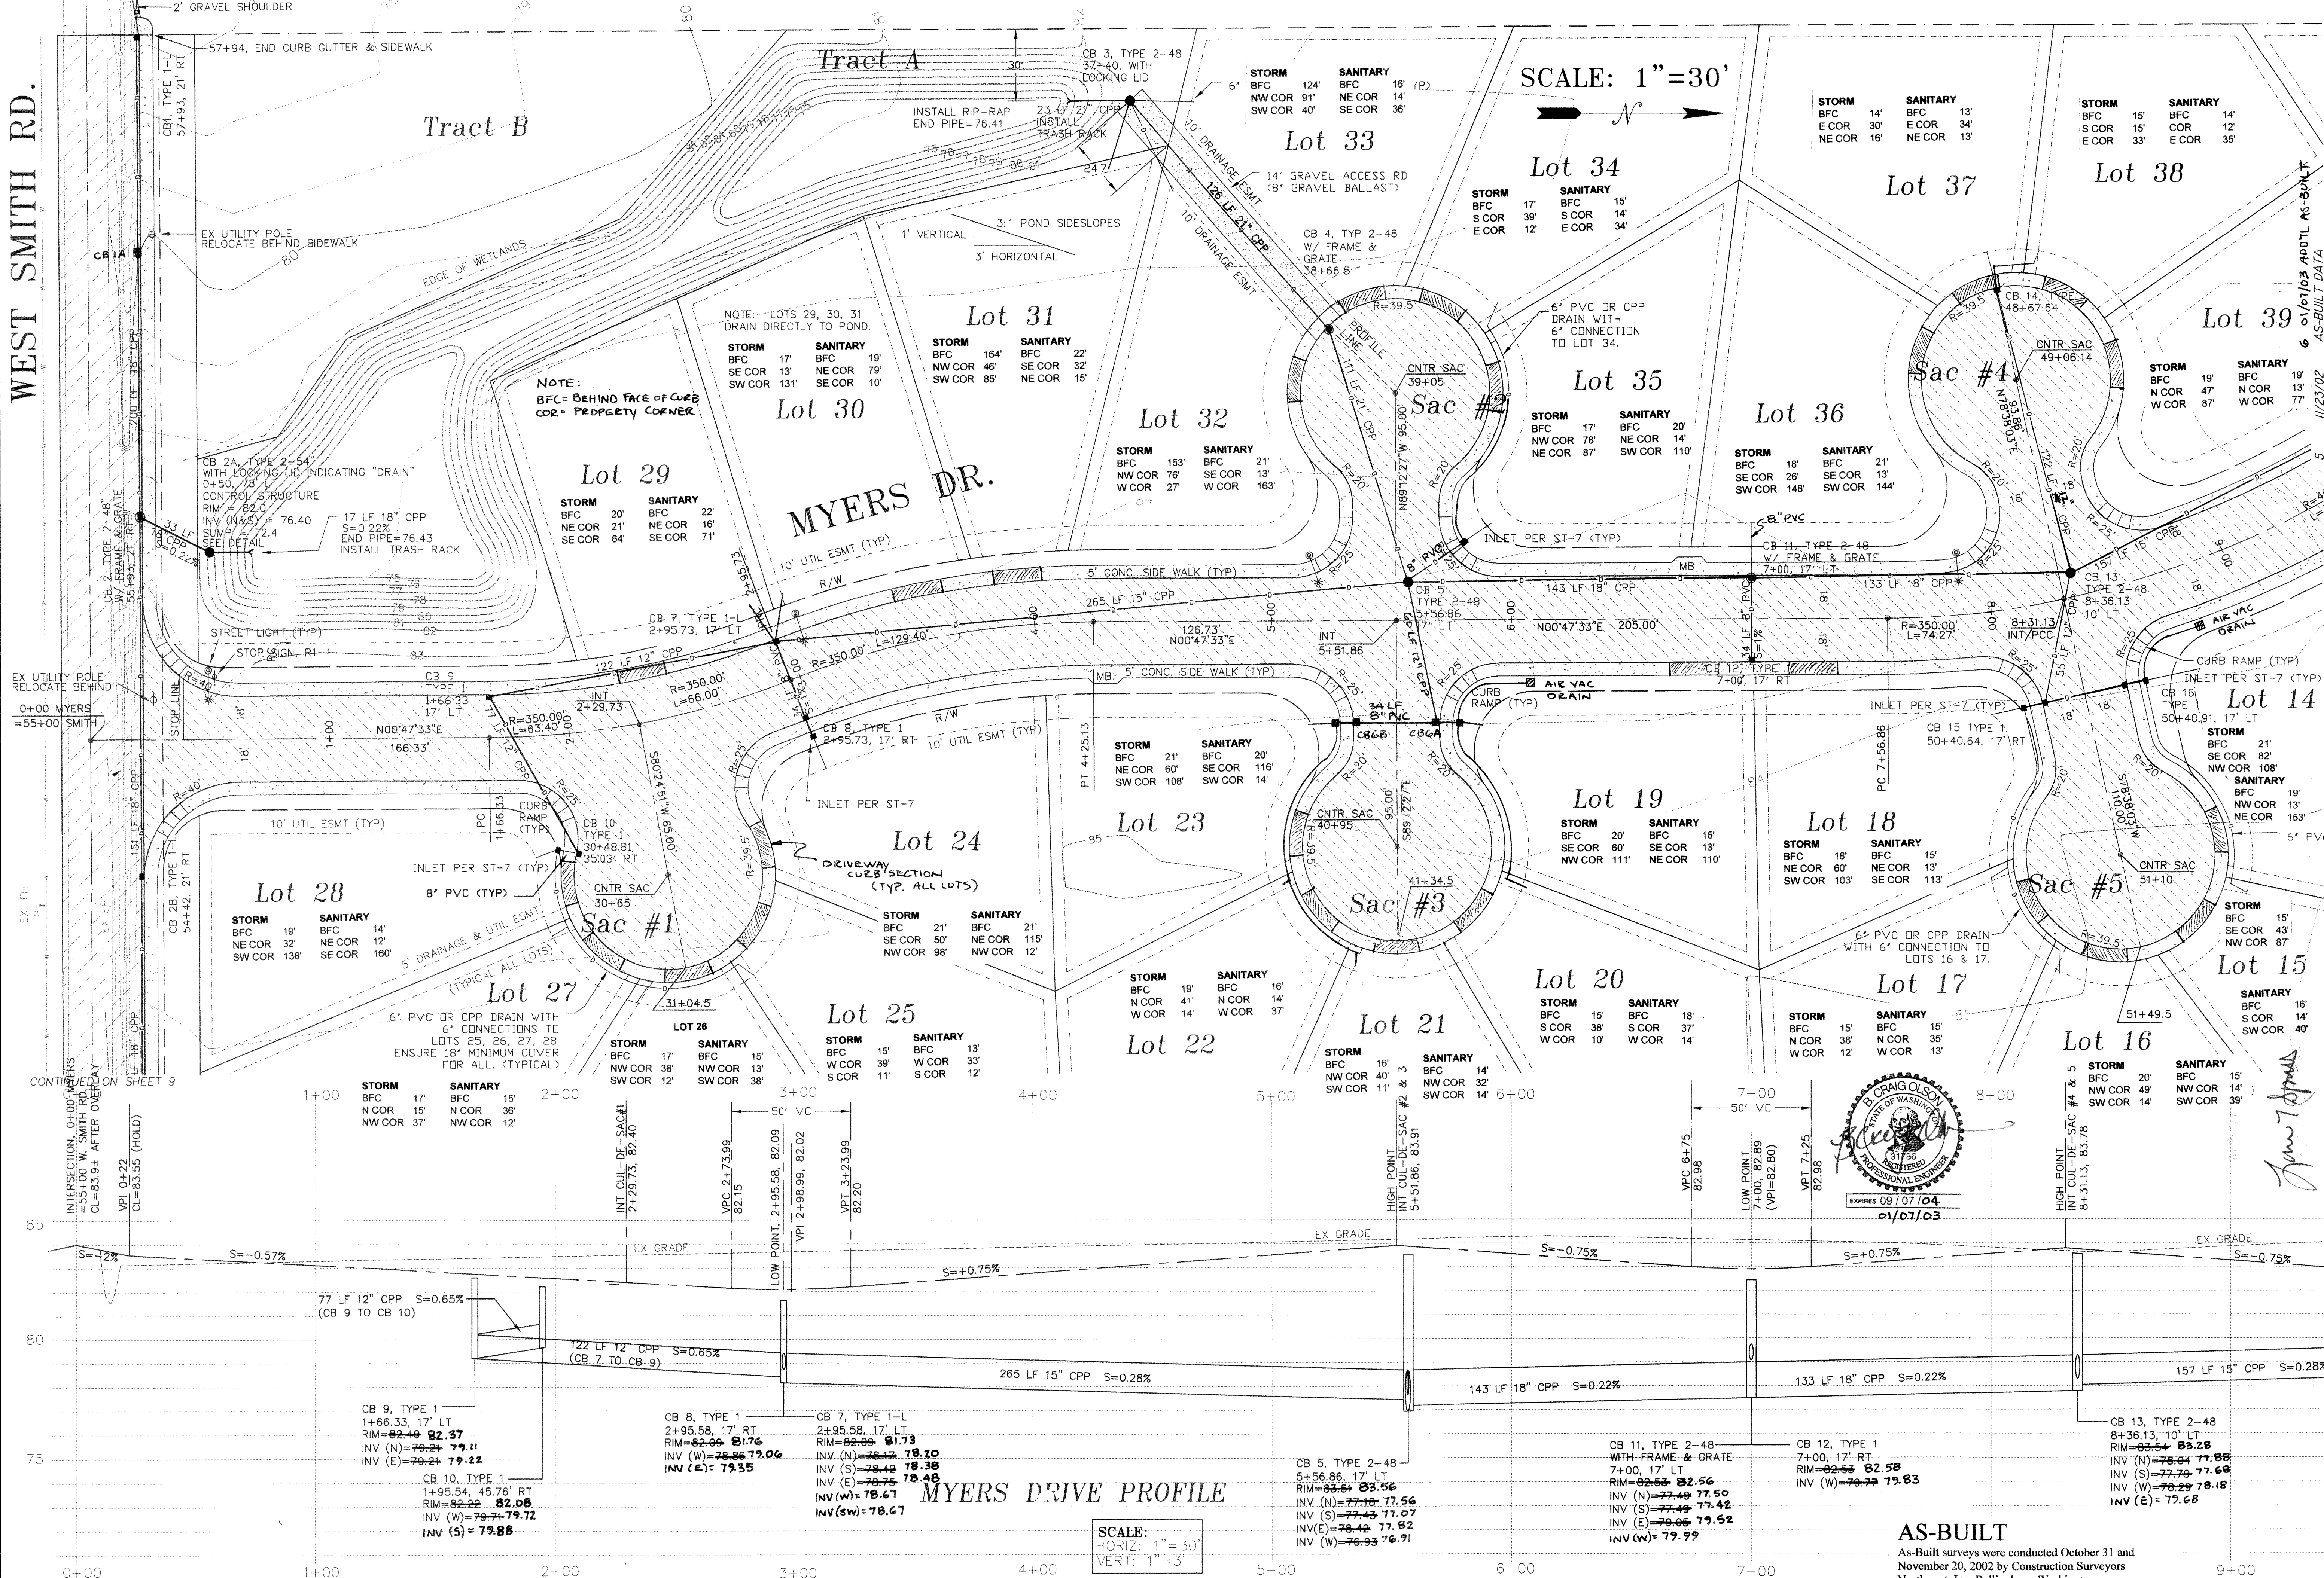

CONTINUED ON SHEET 9

WEST SMITH RD.



AS-BUILT

As-Built surveys were conducted October 31 and November 20, 2002 by Construction Surveyors Northwest, Inc. Bellingham, Washington.

2113 TUTTLE LANE
LUMMI ISLAND, WASHINGTON 98262
TEL: 360.756.3150 FAX: 360.756.3189

Madrona Engineering

Plat of Myers Estates
1376 WEST SMITH ROAD
FERDALE, WASHINGTON 98248
PLAN AND PROFILE

REVISION DATE DESCRIPTION

1 8/13/01 NEW ROAD PROFILE, REVISED STORM DRAIN

2 10/31/01 ALL PER CITY REVIEW REQUIREMENTS

3 01/30/02 ADDED SMITH RD 3/4 ST. IMPROVEMENTS



4 03/22/02 RESPOND TO CITY REQUIREMENTS




5 11/23/02 AS-BUILT DATA

6 01/07/03 400TL AS-BUILT


00185.002 2-13-06

OF 12

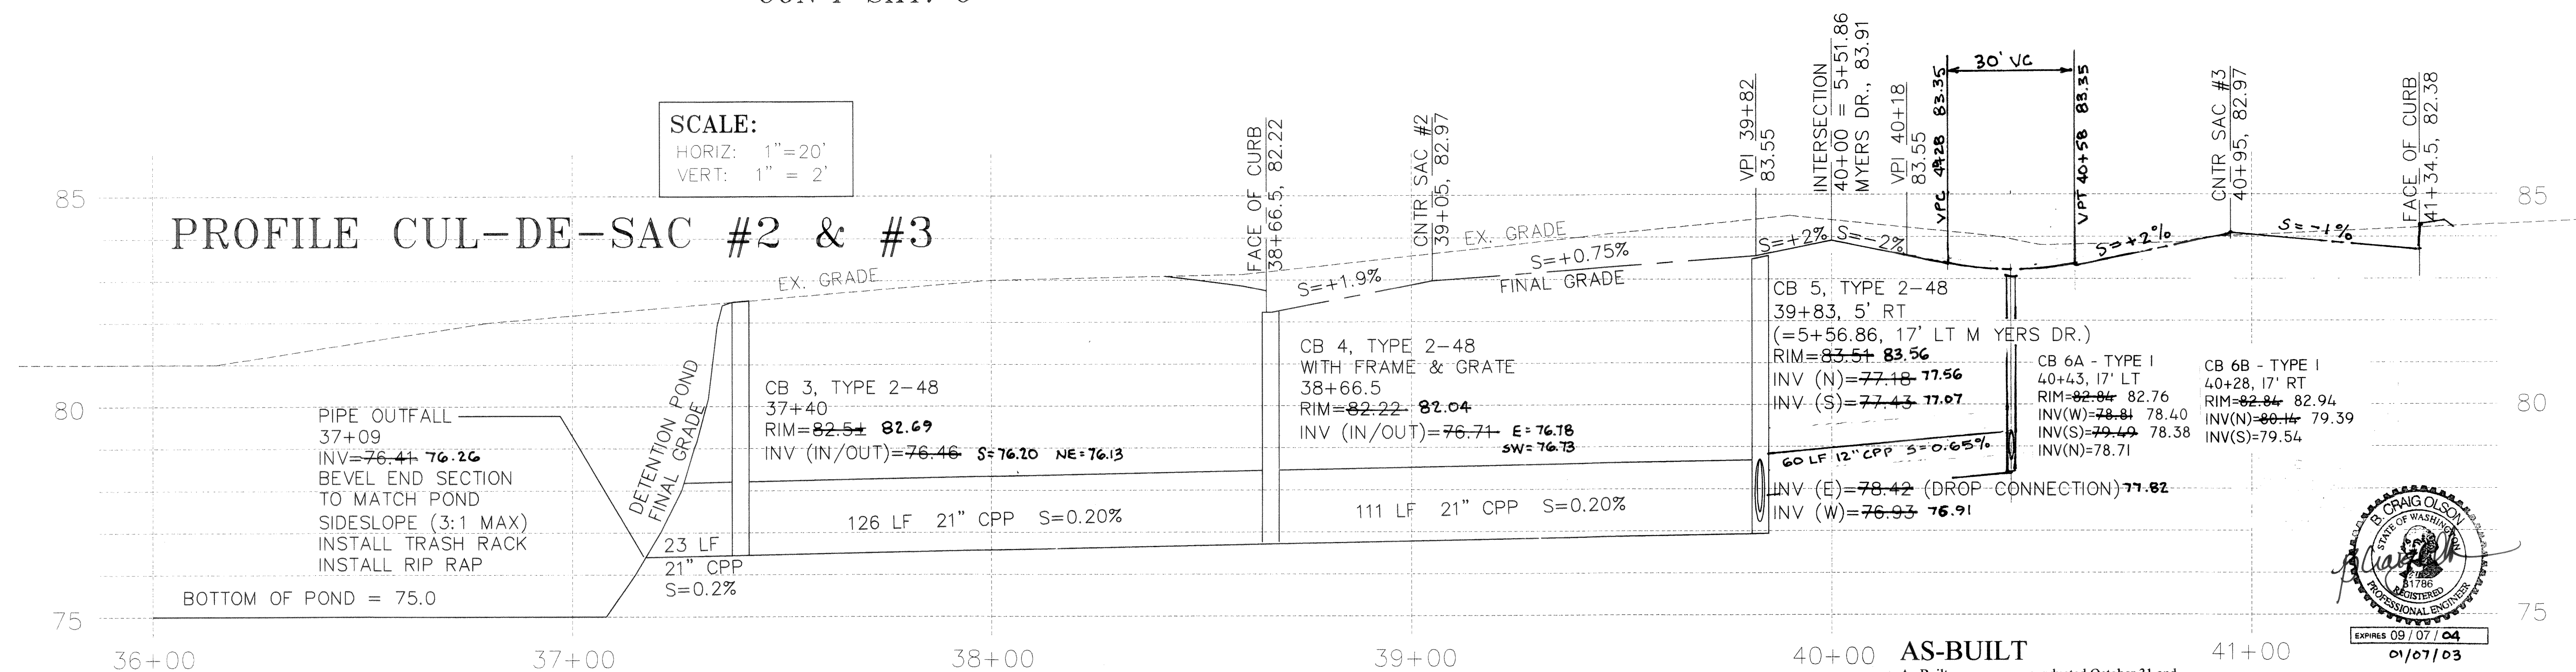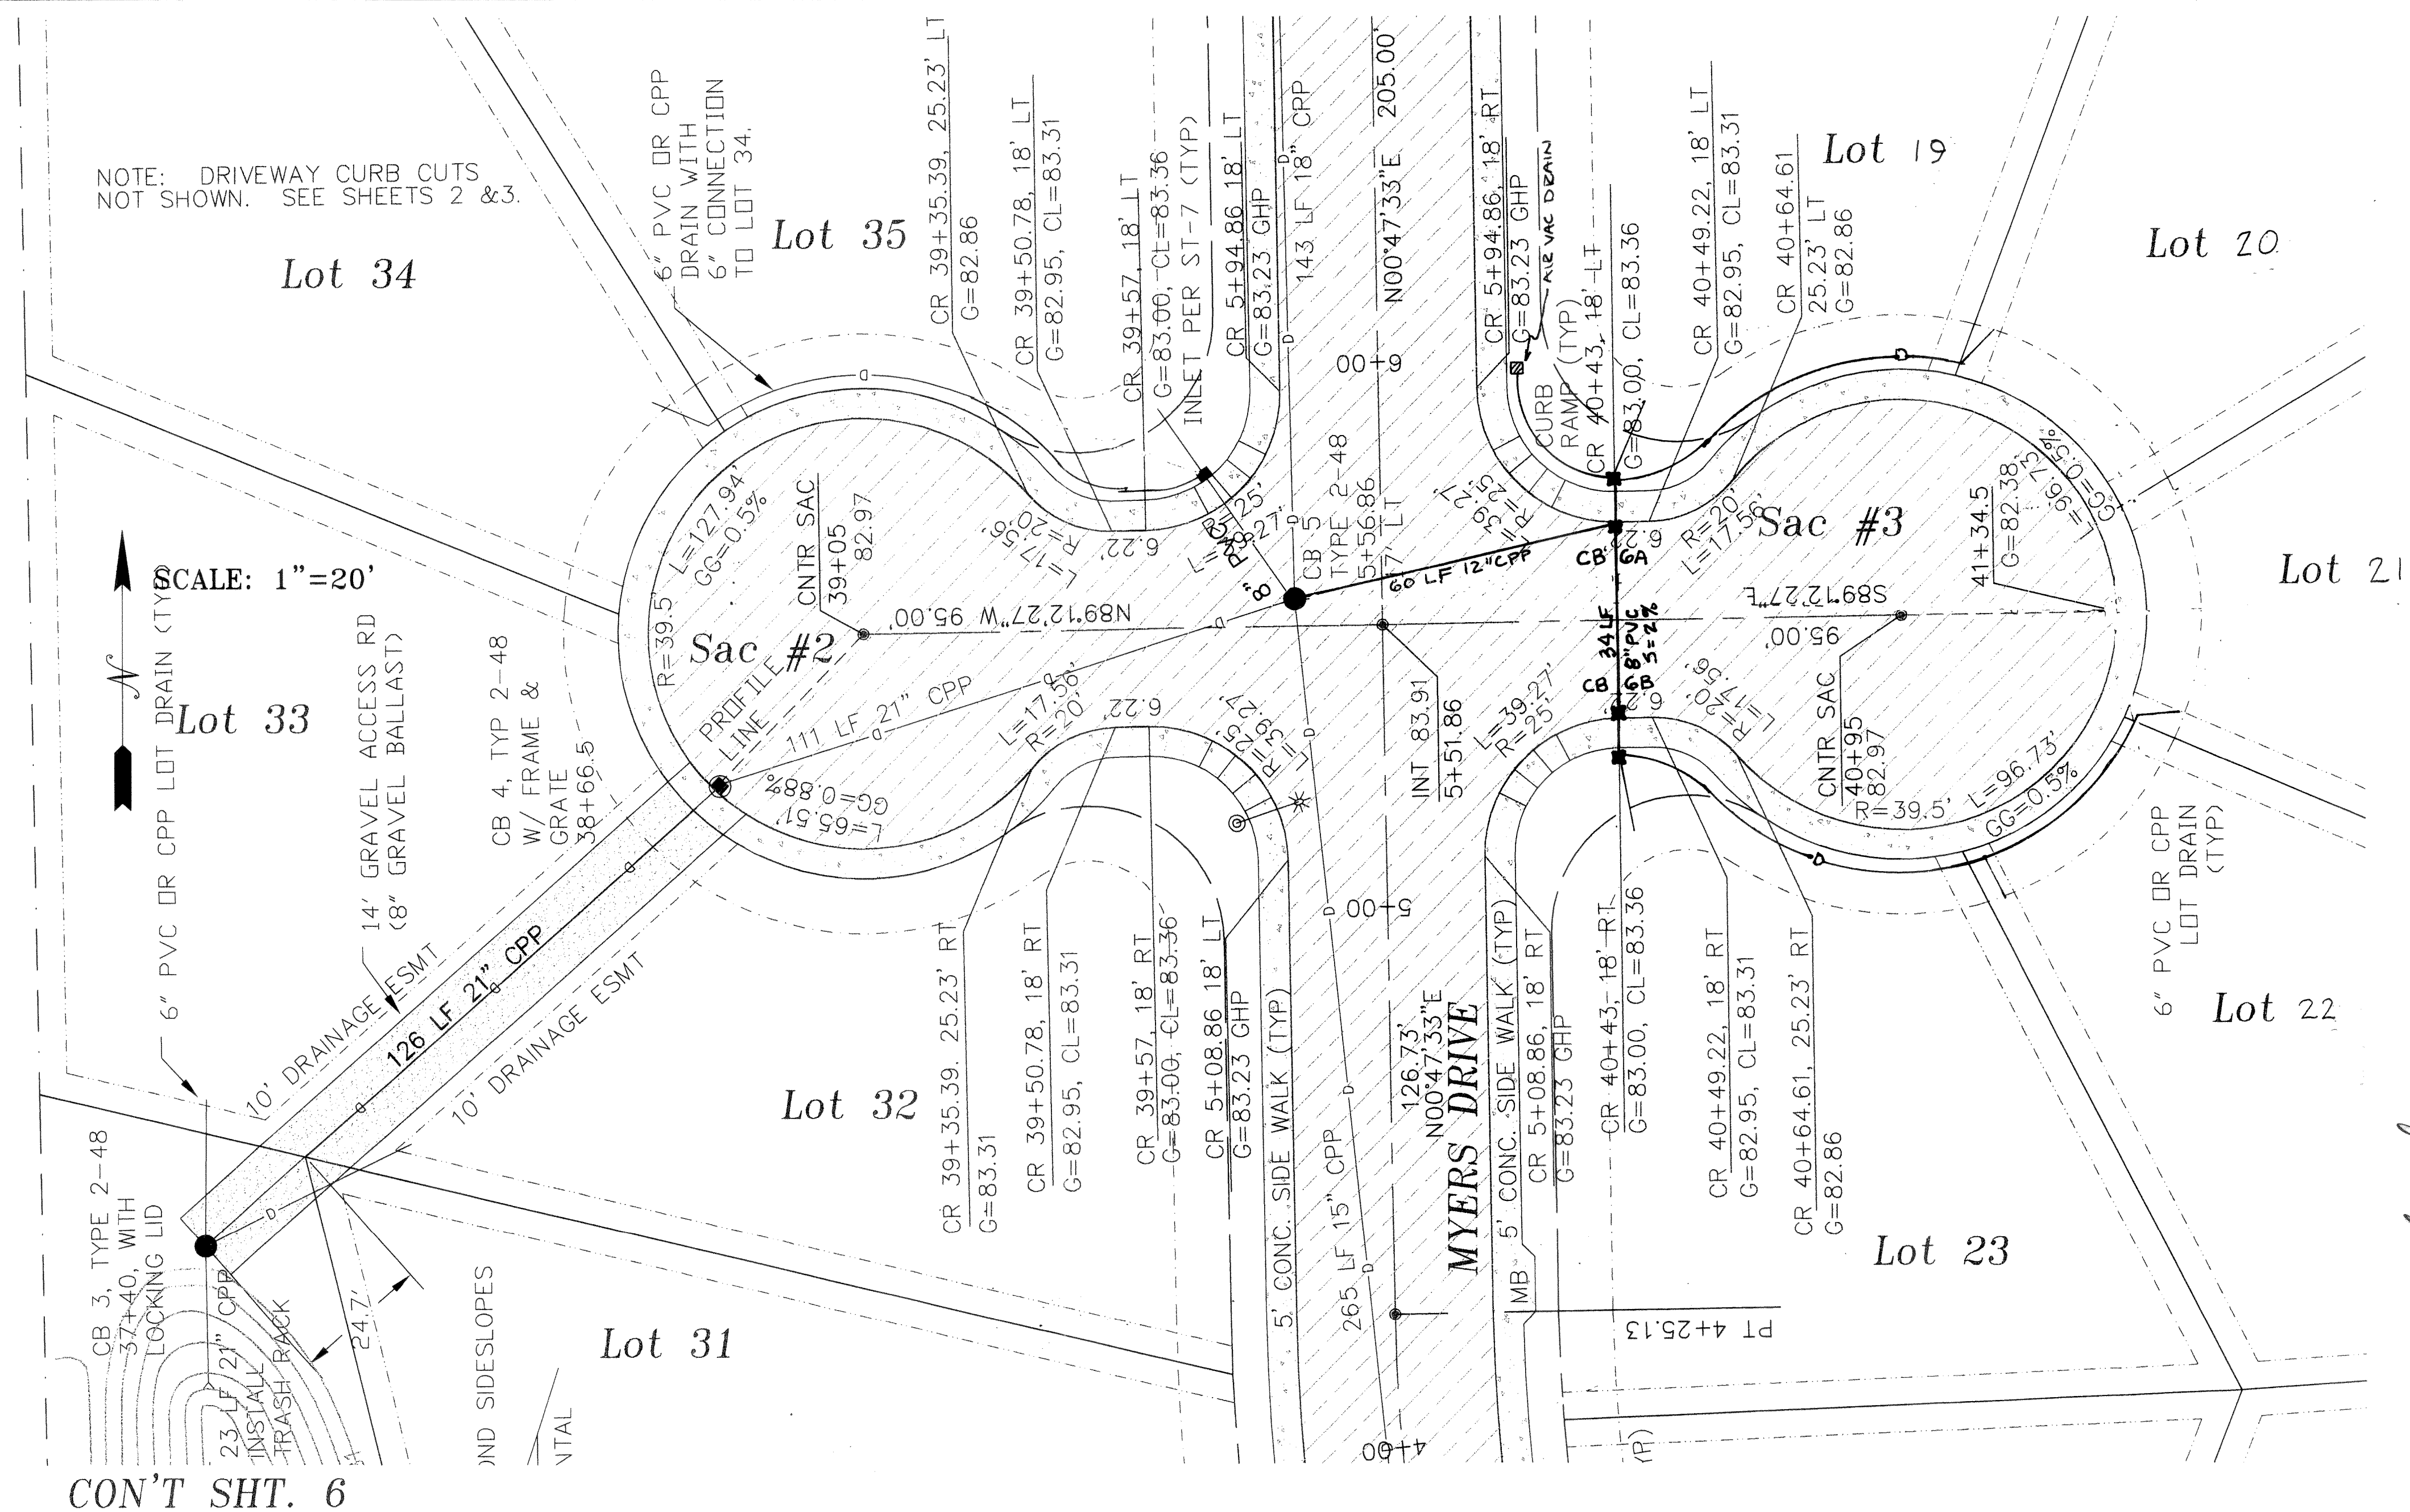

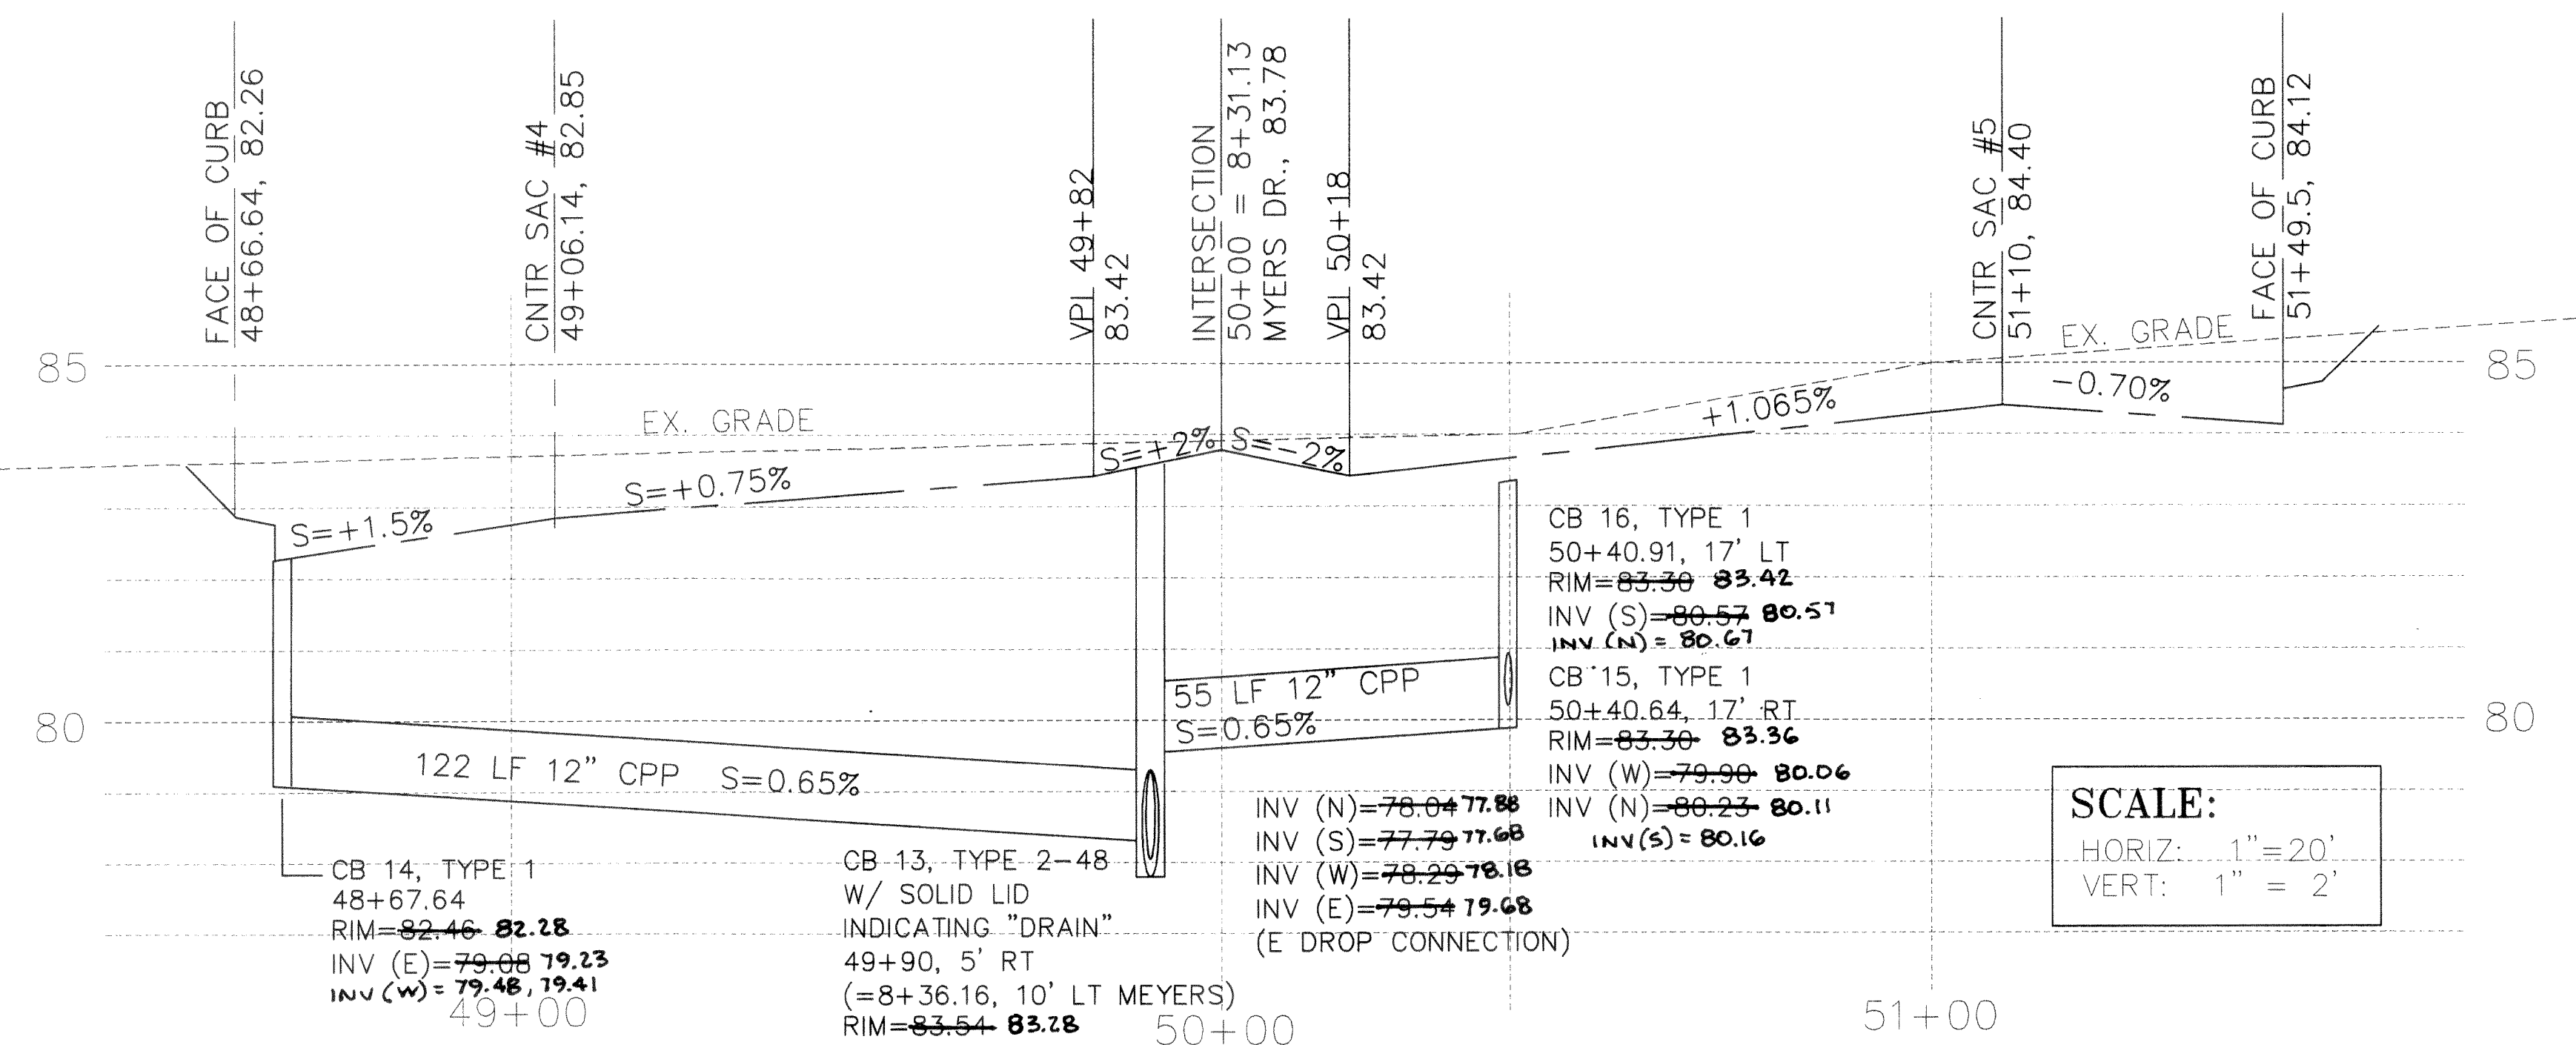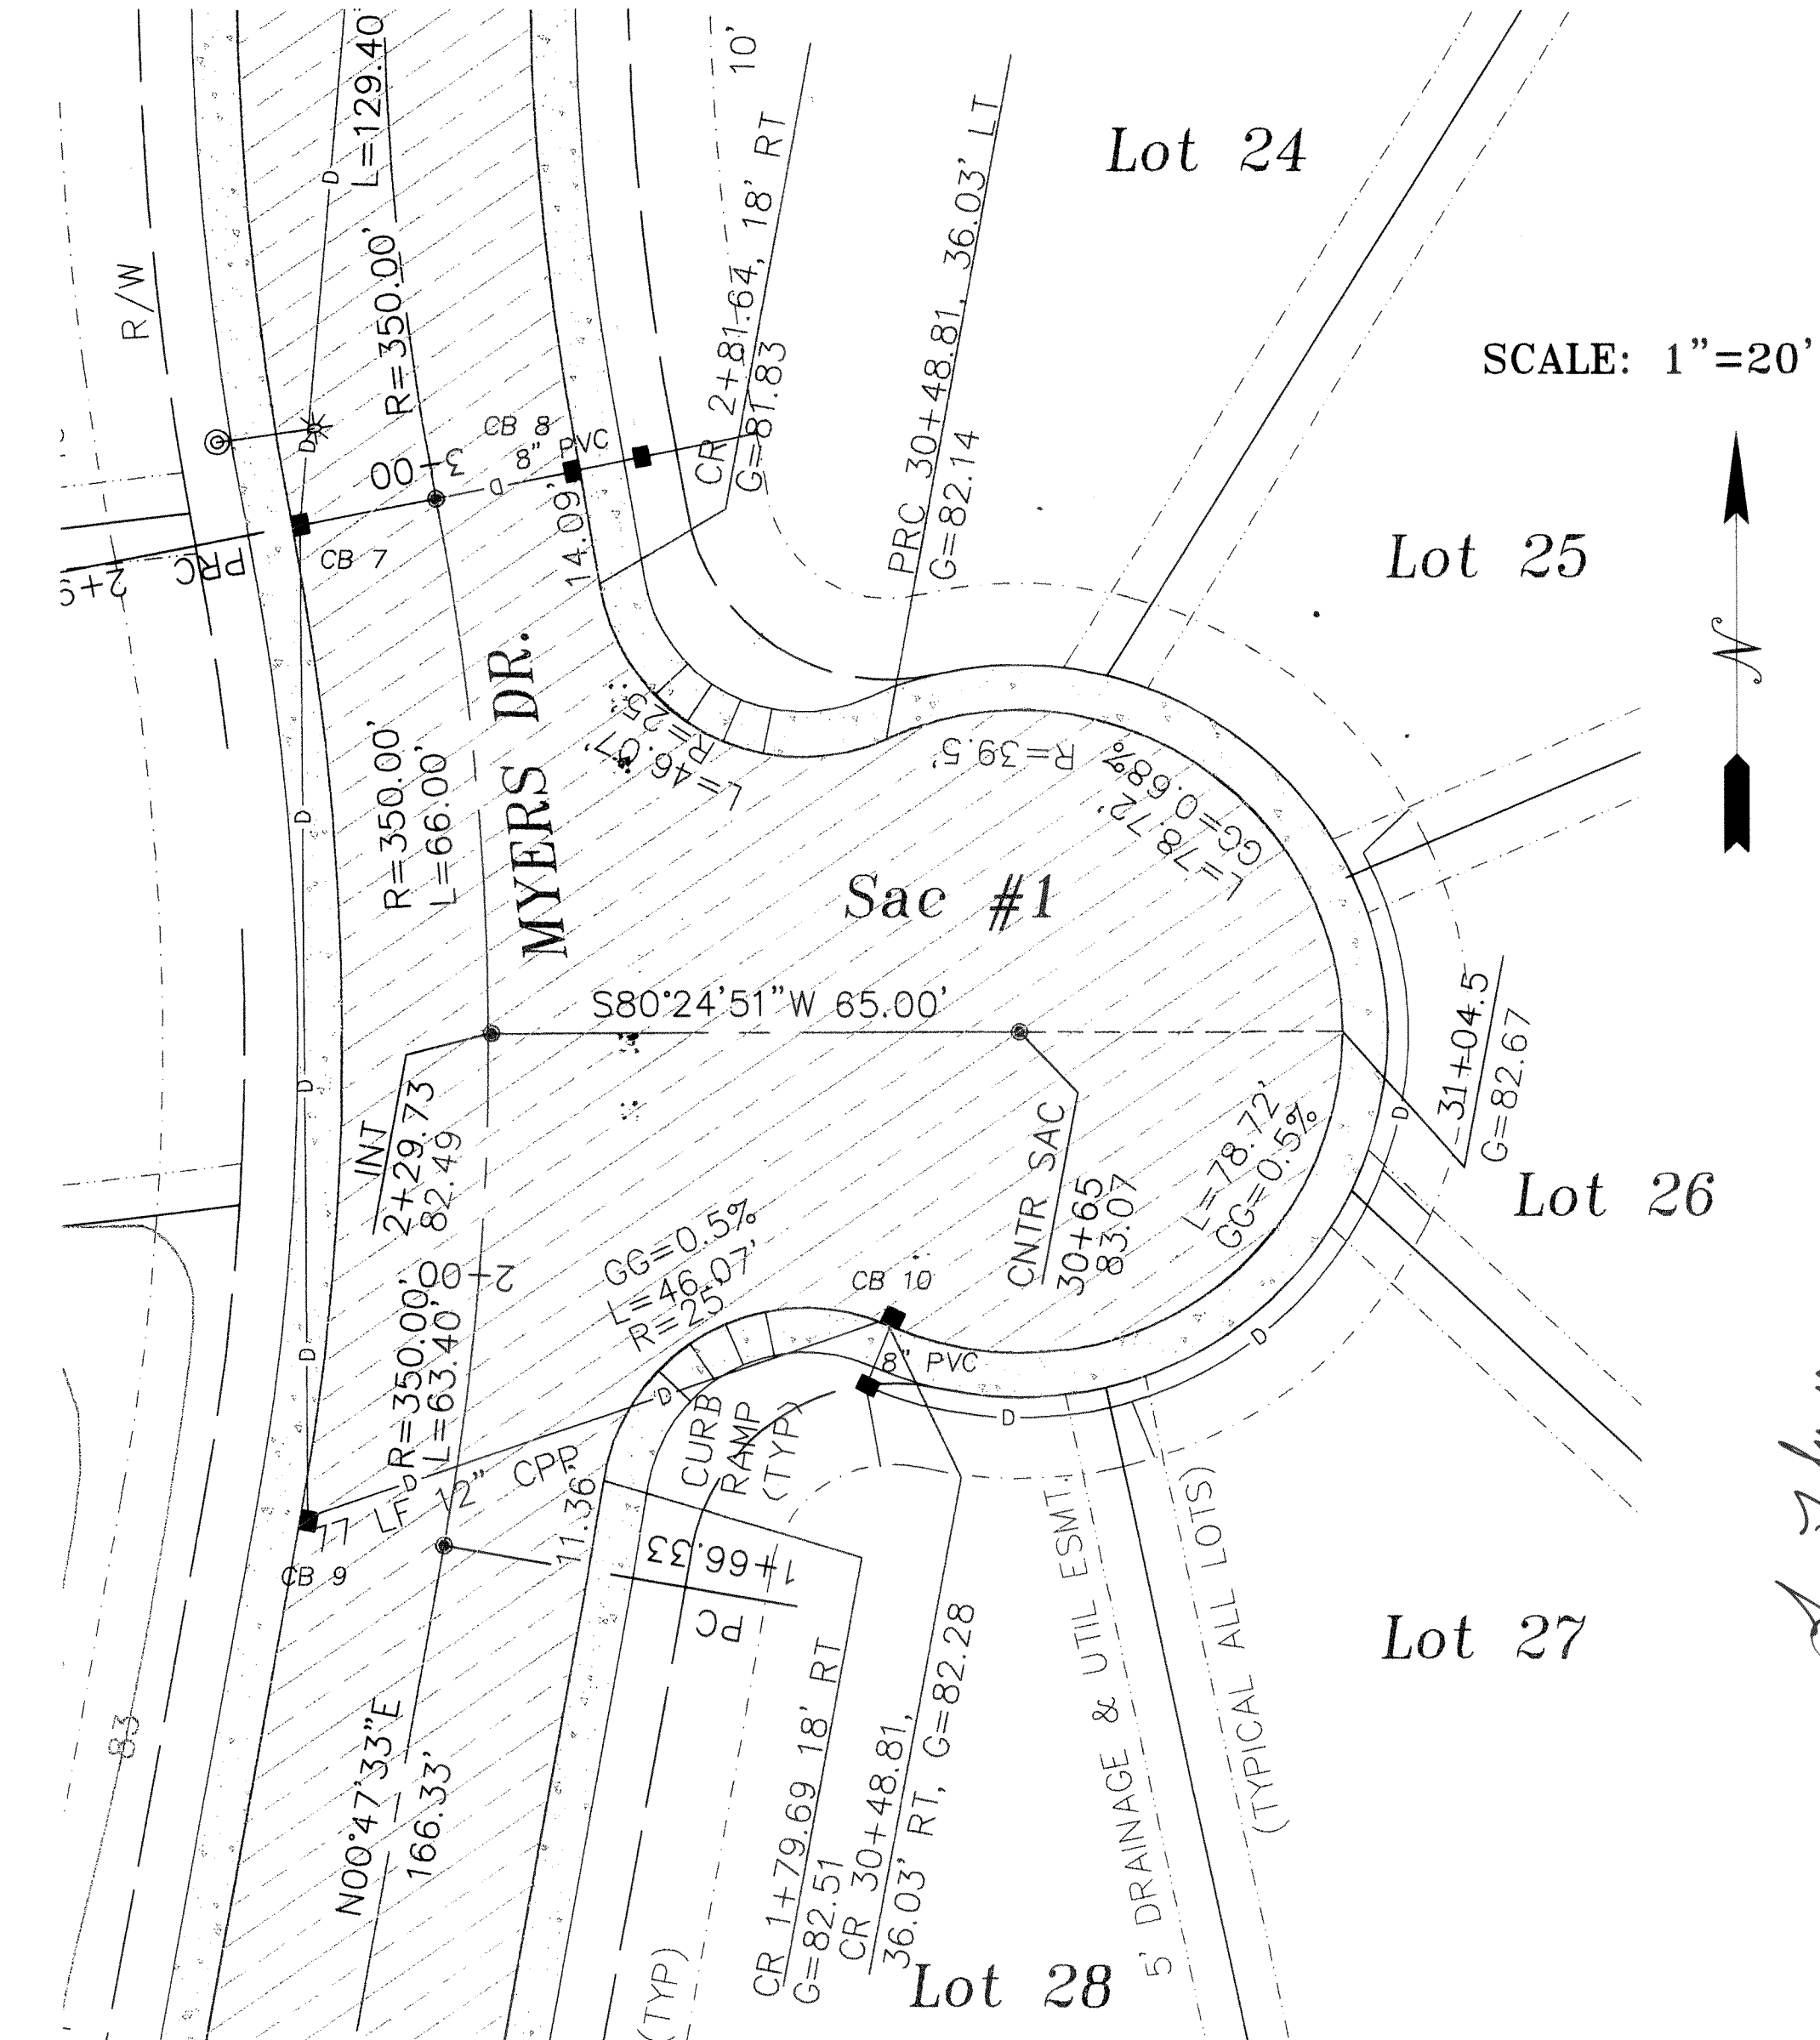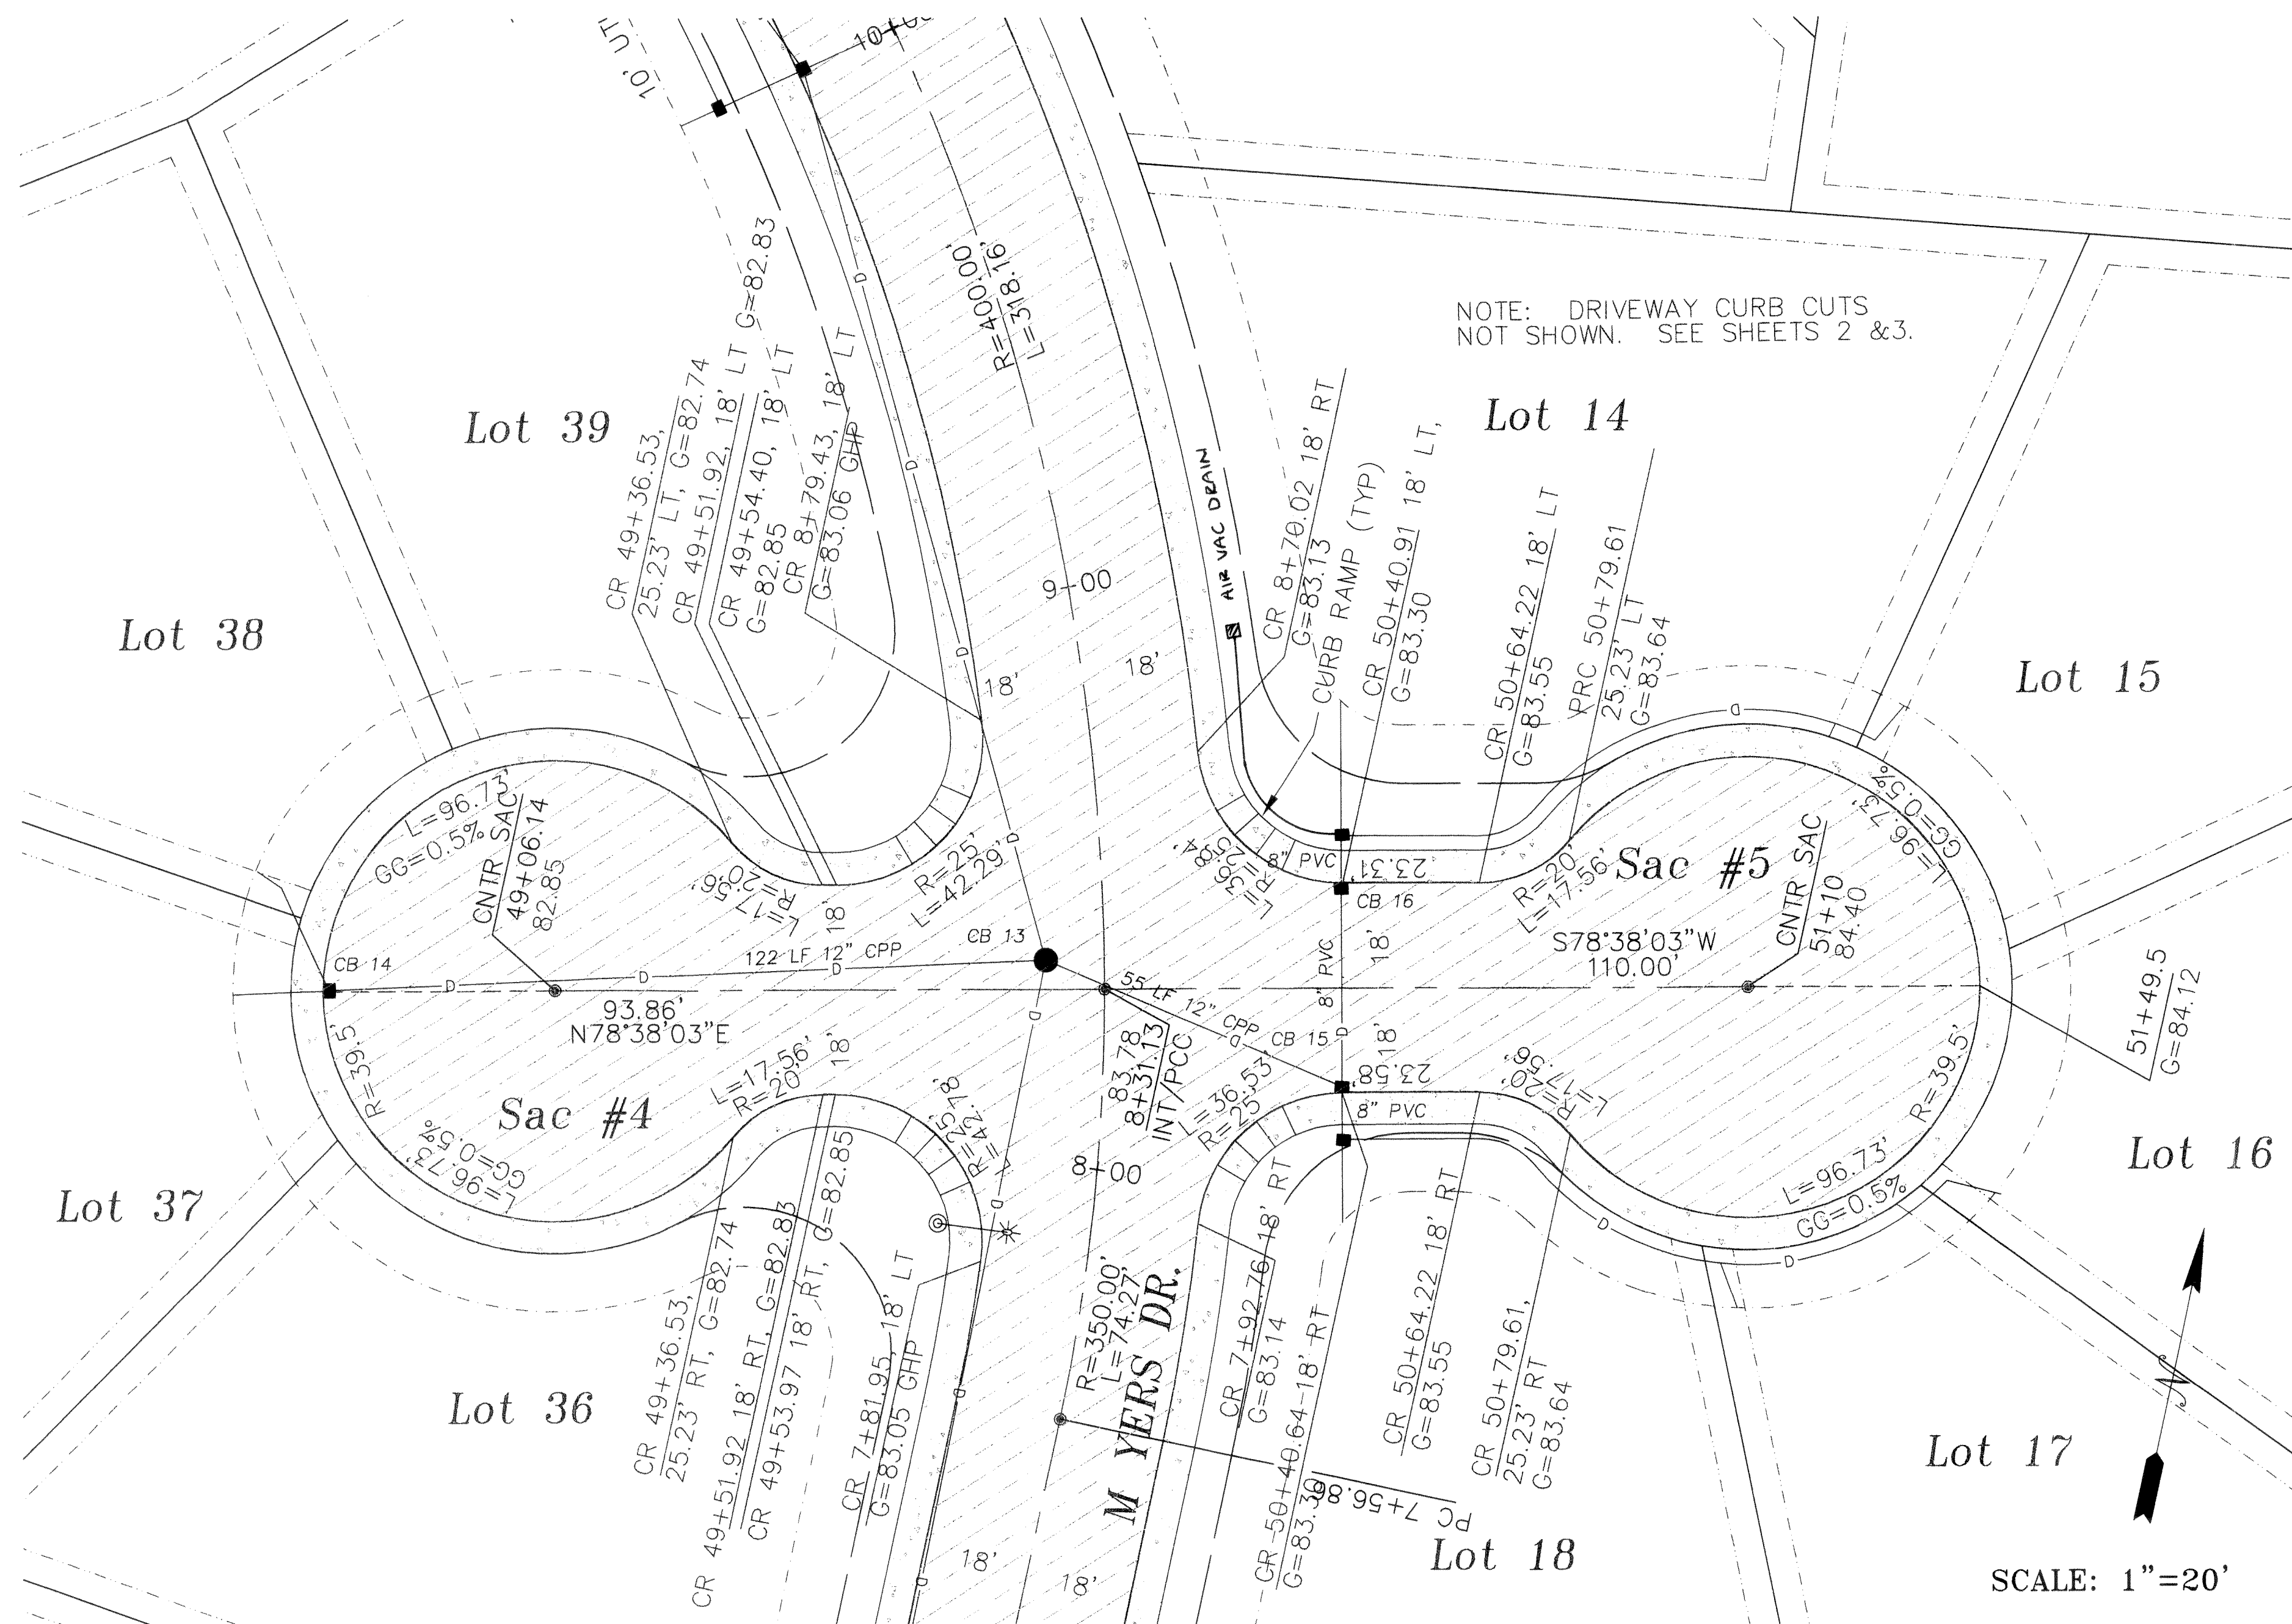

PROFILE CUL-DE-SAC #4 & #5

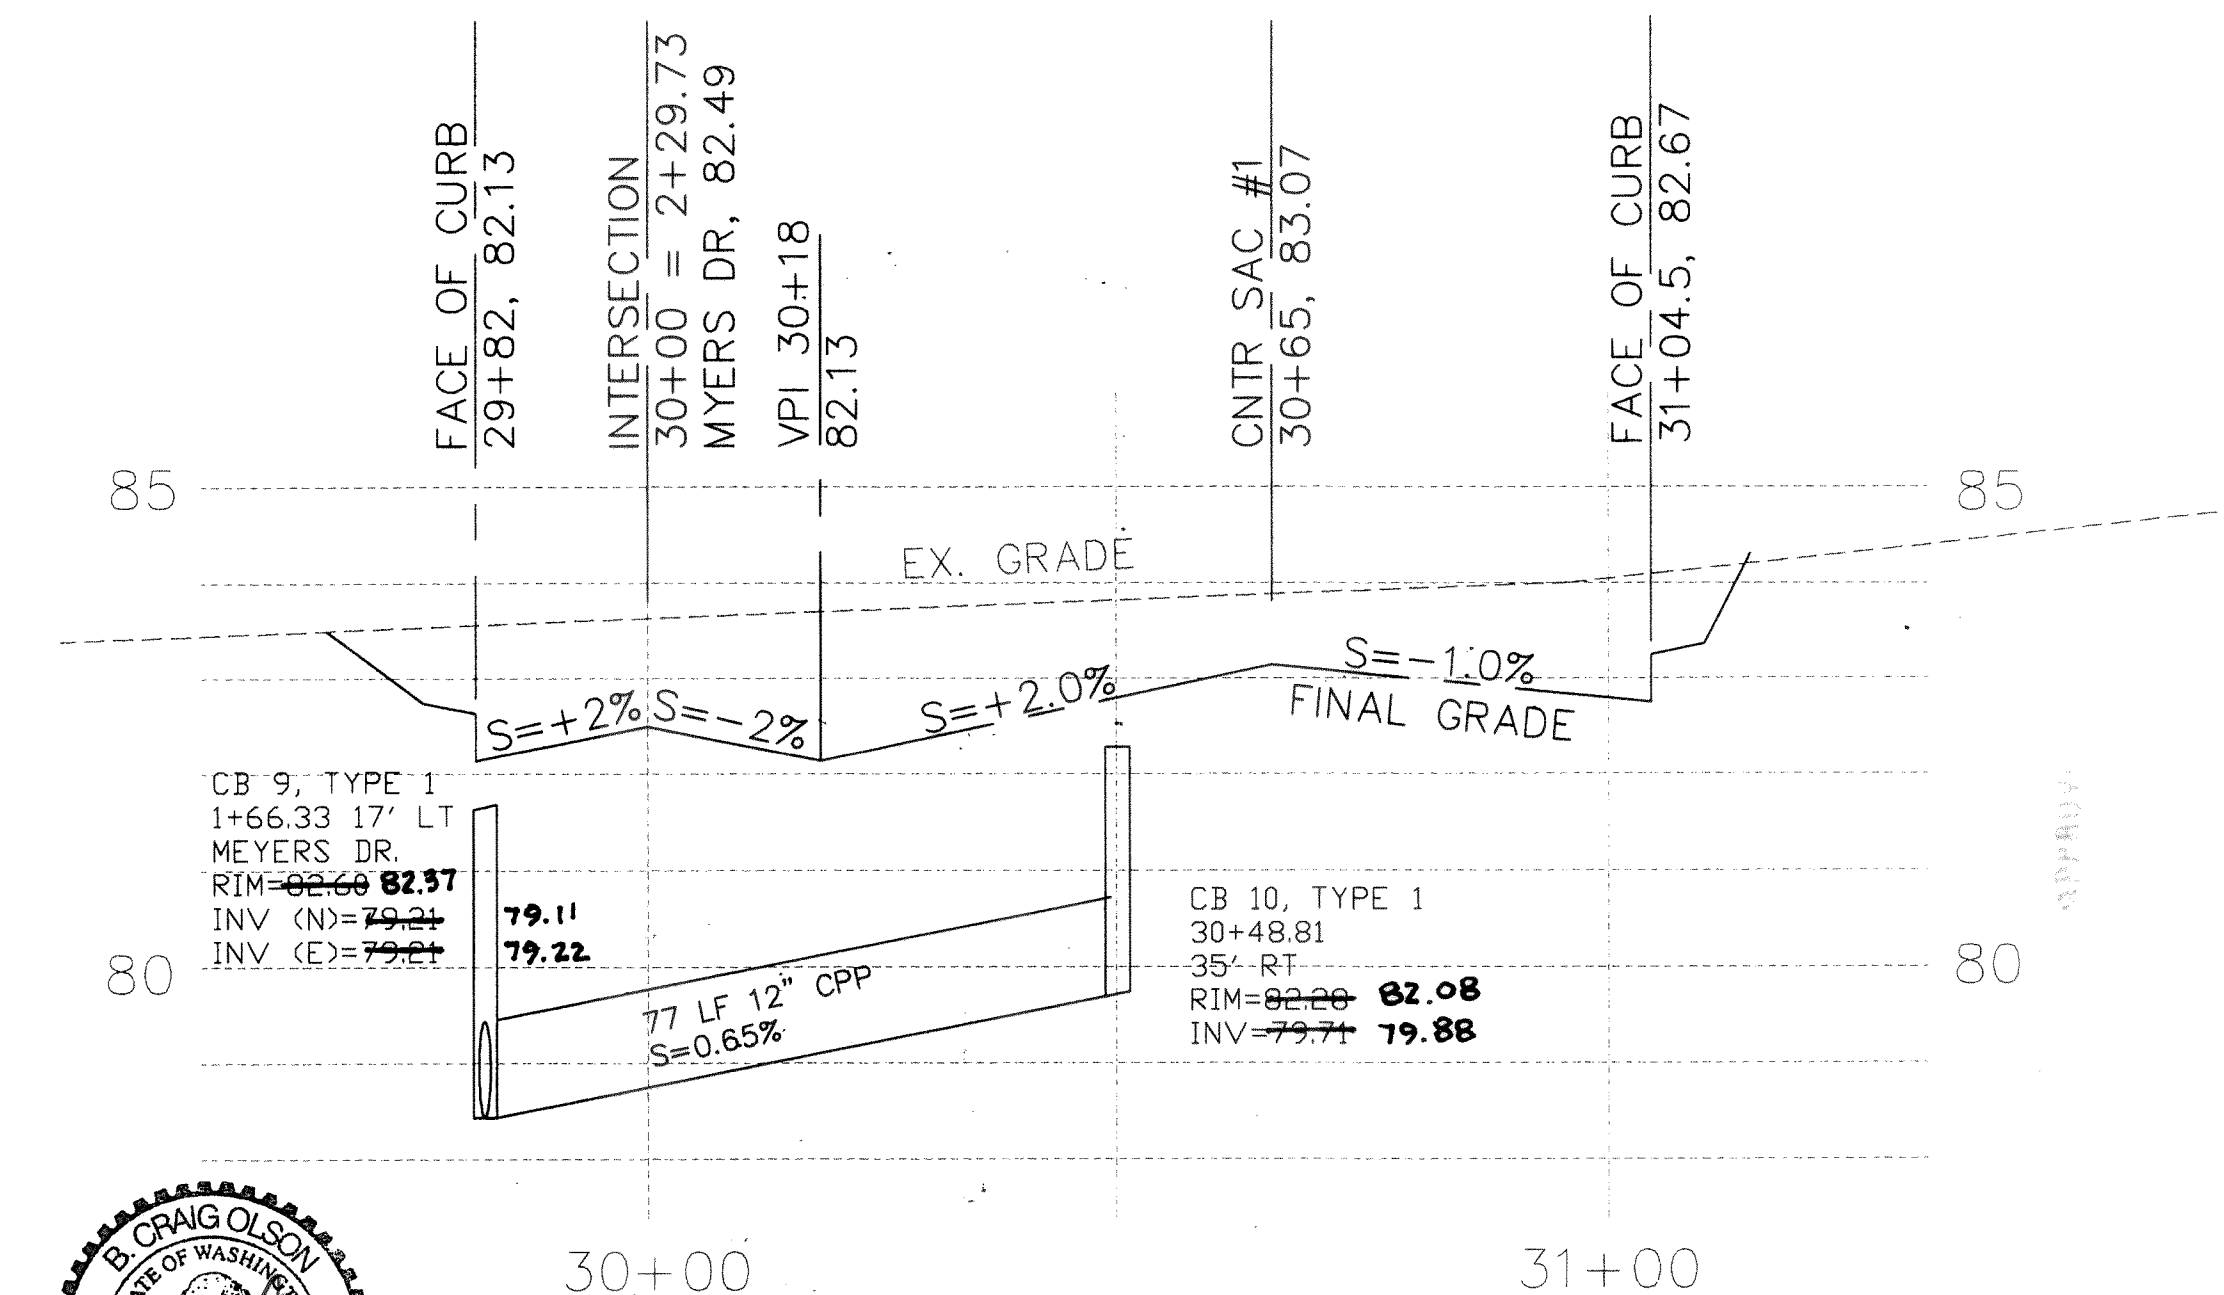

PROFILE CUL-DE-SAC #1

SCALE:
HORIZ: 1"=20'
VERT: 1"=2'

AS-BUILT

As-Built surveys were conducted October 31 and November 20, 2002 by Construction Surveyors Northwest, Inc. Bellingham, Washington.



John J. Olson

REVISION	DATE	DESCRIPTION
1	8/13/01	NEW SHEET, ADDED CUL-DE-SAC PROFILES
2	10/31/01	ALL PER CITY REVIEW REQUIREMENTS
3	01/30/02	REVISED CUL-DE-SAC
4	03/22/02	RESPOND TO CITY REQUIREMENTS
5	11/23/02	AS-BUILT DATA

Cul-de-sac #1, #4 & #5

Plat of Myers Estates

1376 WEST SMITH ROAD
FERNDALE, WASHINGTON 98248

Madrona Engineering

2113 TUTTLE LANE
LUMMI ISLAND, WASHINGTON 98262
TEL: 360.758.3150 FAX: 360.758.3189

SHEET:

5


OF 12

00125.DOS 2-13-06 RYZ

WEST SMITH RD.

3/4 STREET SECTION PER DETAIL R1, REVISED.
2ND LIFT OF ASPHALT TO OVERLAY EXISTING.

CONTINUED SHEET 9

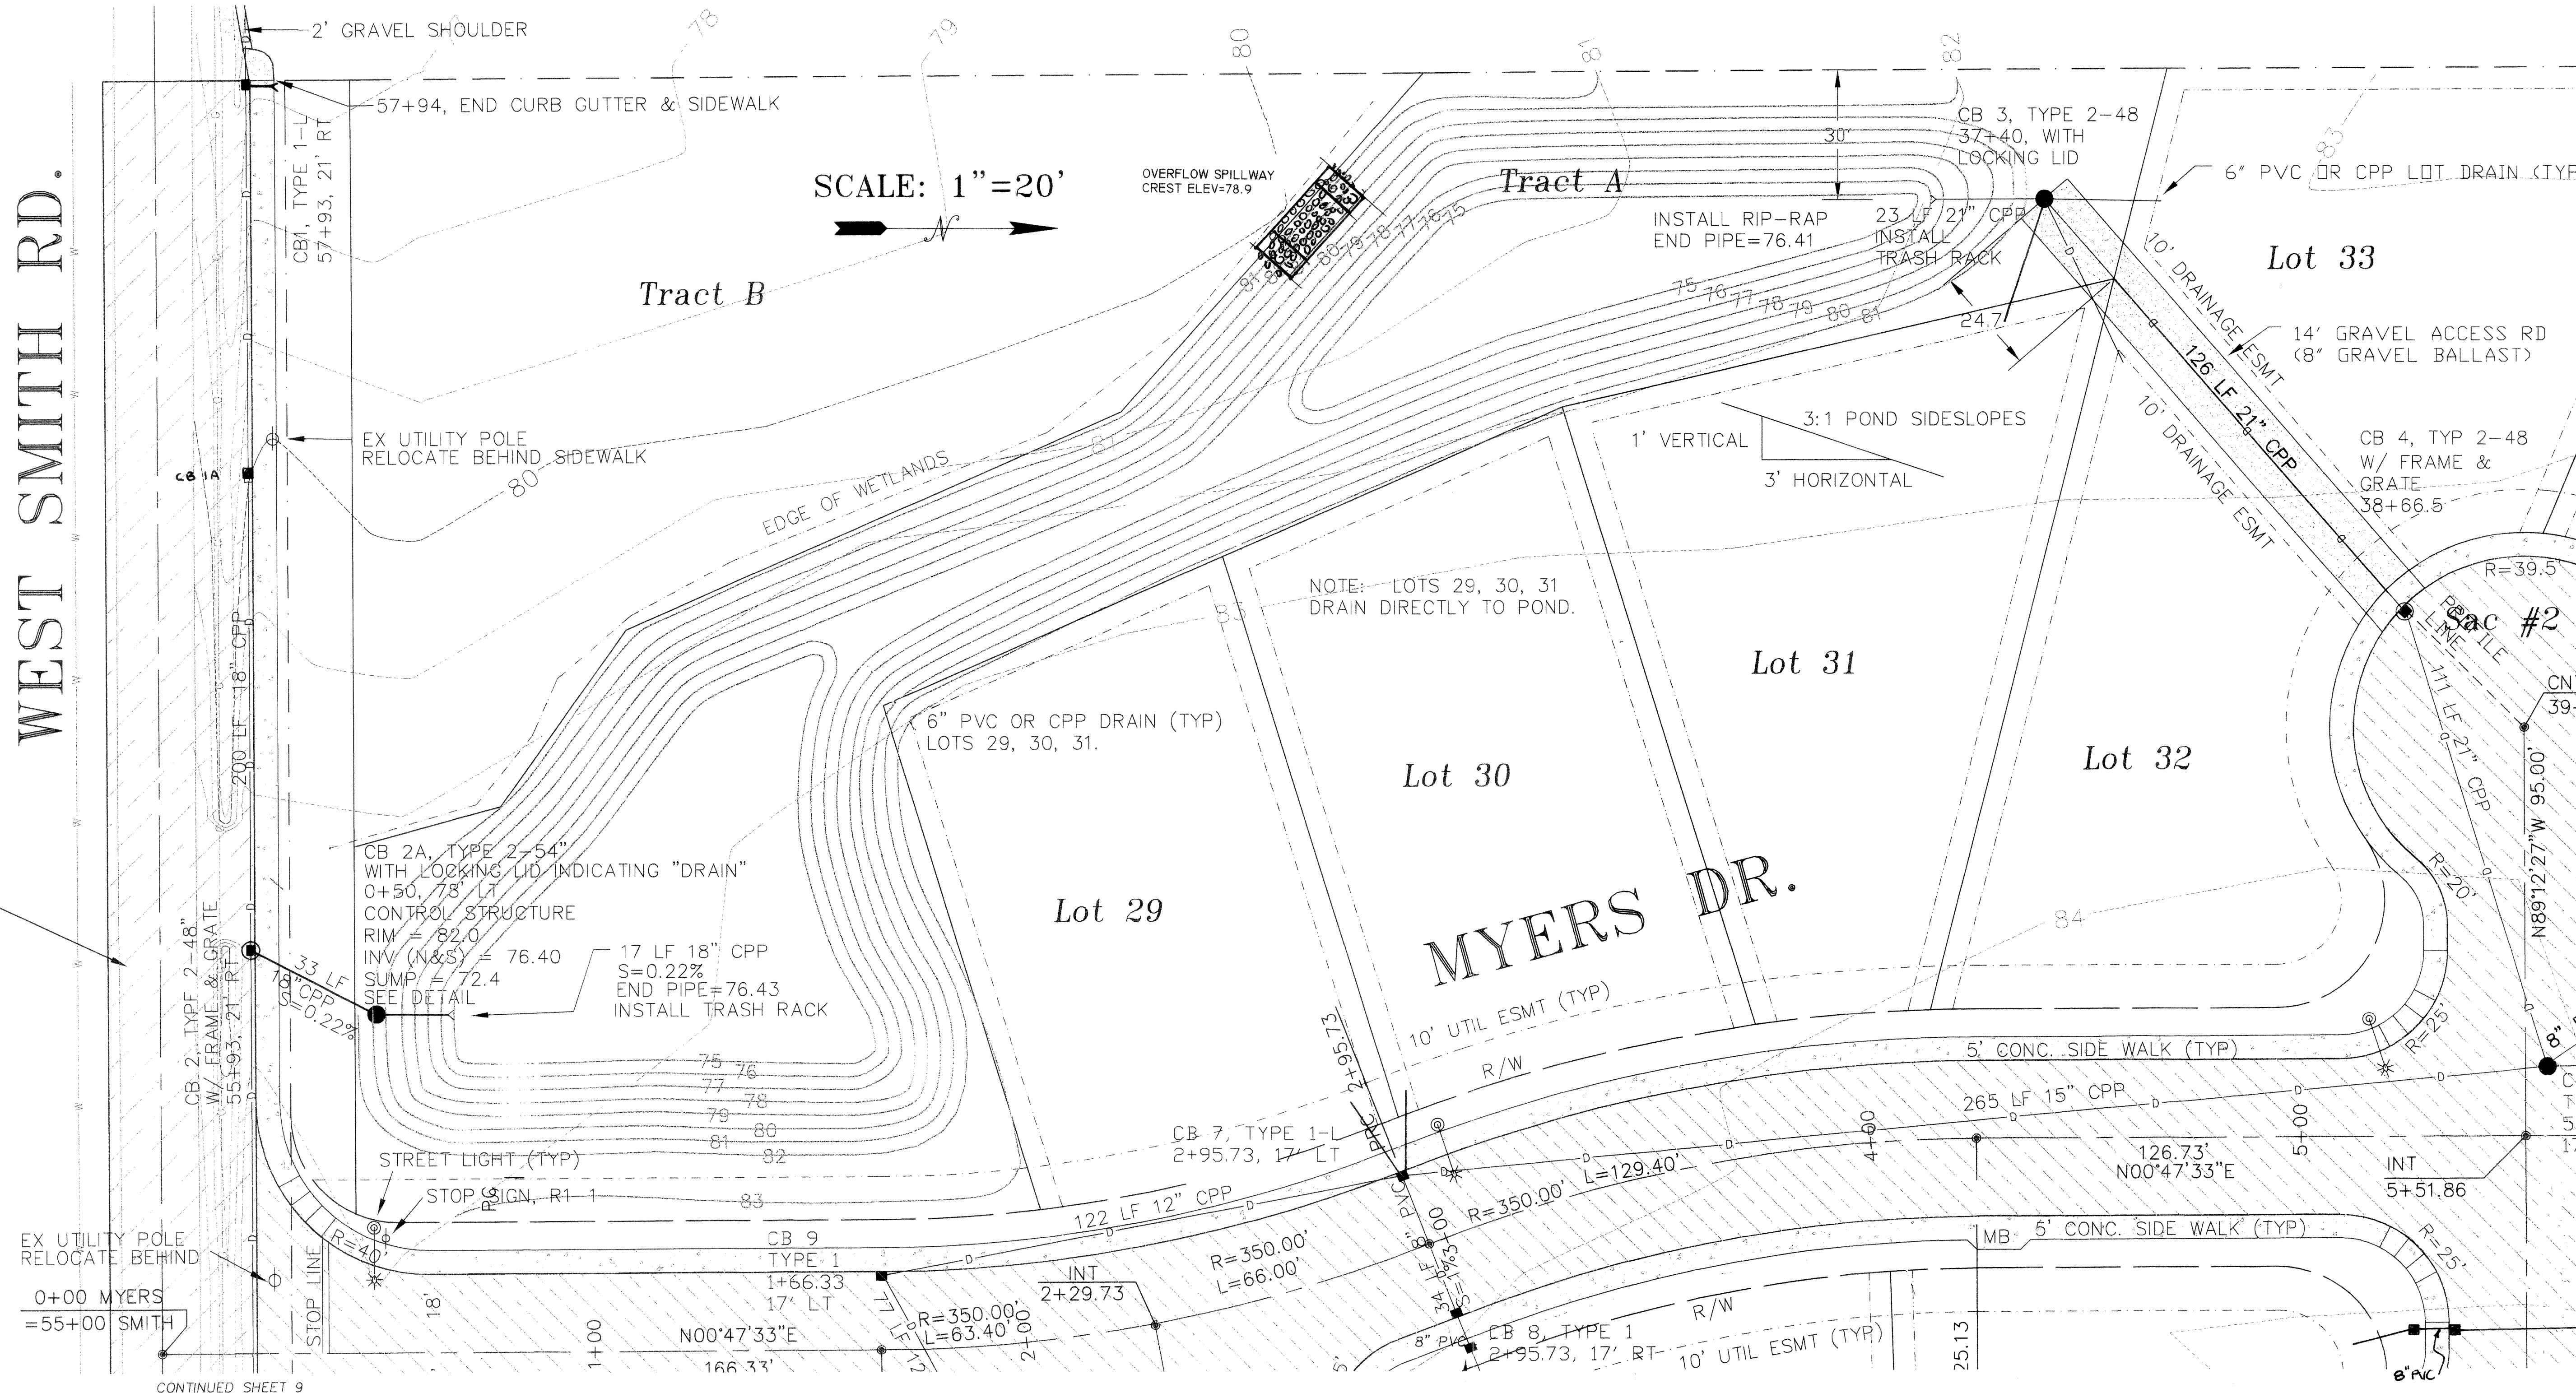

SCALE: 1"=20'

Tract B

Tract A

Lot 33

Lot 31

Lot 30

Lot 32

MYERS DR.




Lot 29

0+00 MYERS
=55+00 SMITH

CONTINUED SHEET 9

BIOFILTER SWALE and DETENTION POND NOTES:

- Subgrade of bioswale and Detention Pond areas shall be graded to four inches below finish grade.
- Four inch depth of topsoil shall be placed in all areas to be seeded. Soil shall be graded smooth and rolled as per lawn installations to provide a suitable growing bed for the grass to be planted.
- The following seed mix is to be used in the bioswale and pond areas:
40% Redtop bentgrass 5% Perennial rye
30% Red fescue 5% Russian wild rye
20% Tall fescue
Other seed mixes may be used if they are designed to grow in wet conditions and are approved by the City of Ferndale.
4. Establish grasses as follows (all weights per 1,000 square feet)
If Hydro-seeding 5 LB seed mix
7 LB 10-20-20 (N-P-K) fertilizer*
50 LB wood cellulose fiber mulch
If broadcast seeding 5 LB seed mix
7 LB 10-20-20 (N-P-K) fertilizer*
70 LB wood cellulose fiber mulch
Fertilizer amount is only an estimate. Actual amount required will vary with soil type. Follow recommendations of seeding company.
5. Contractor shall maintain the seeded areas as needed to assure germination. This may include watering, mulching, reseeding, and or removal of sediment and regrading until a good stand of grass is established.
(Also see GENERAL NOTES and Other Notes)

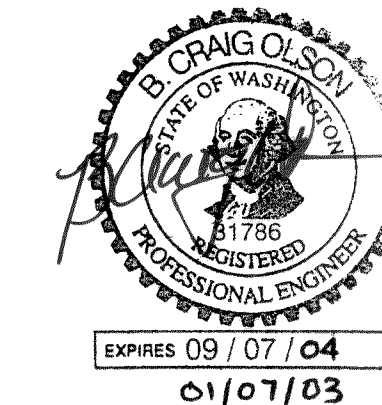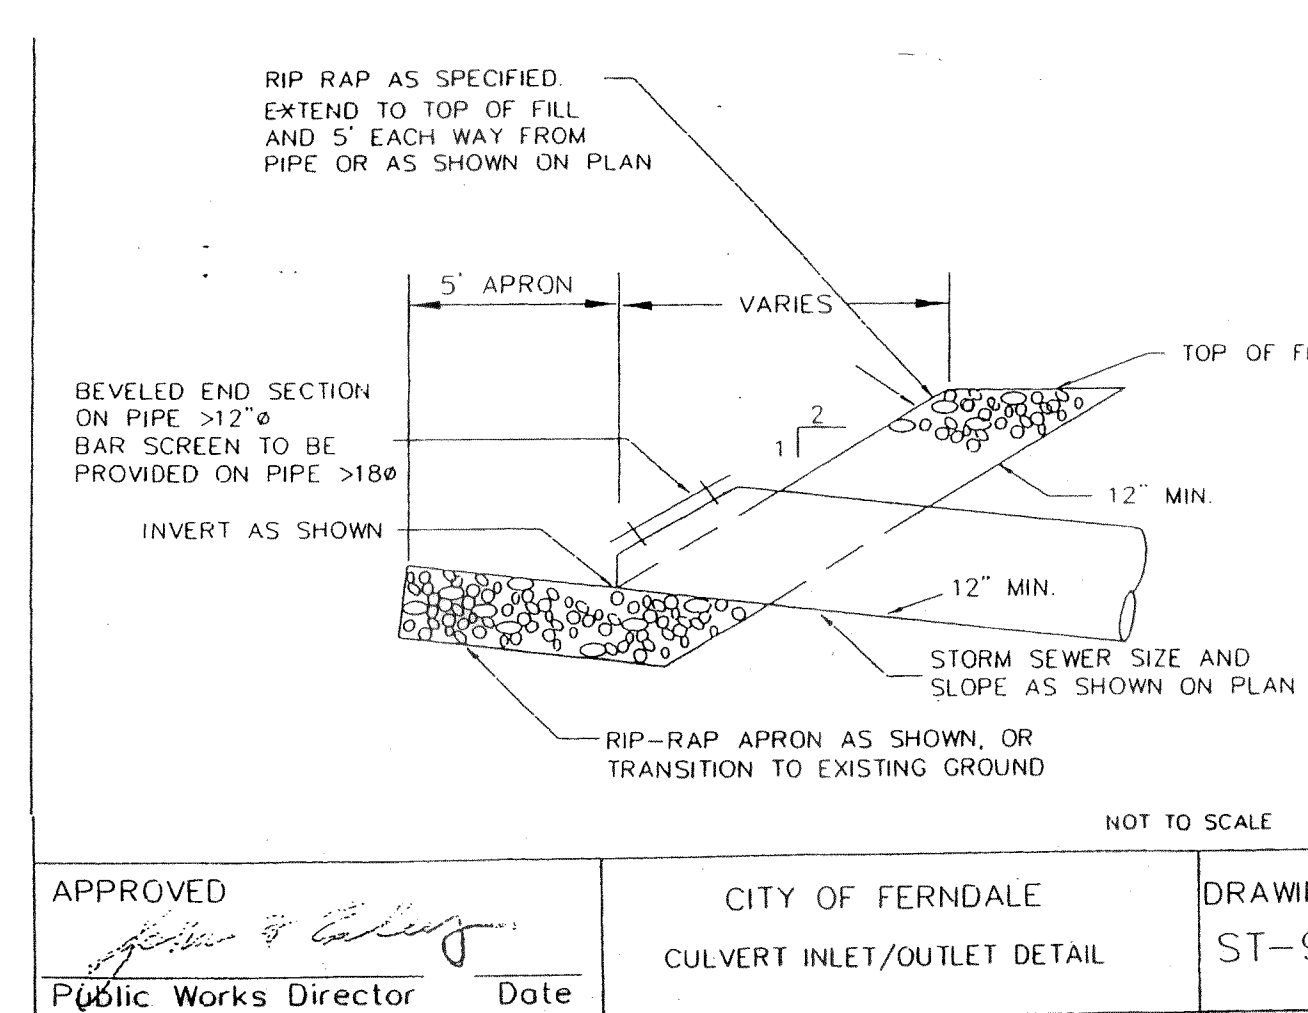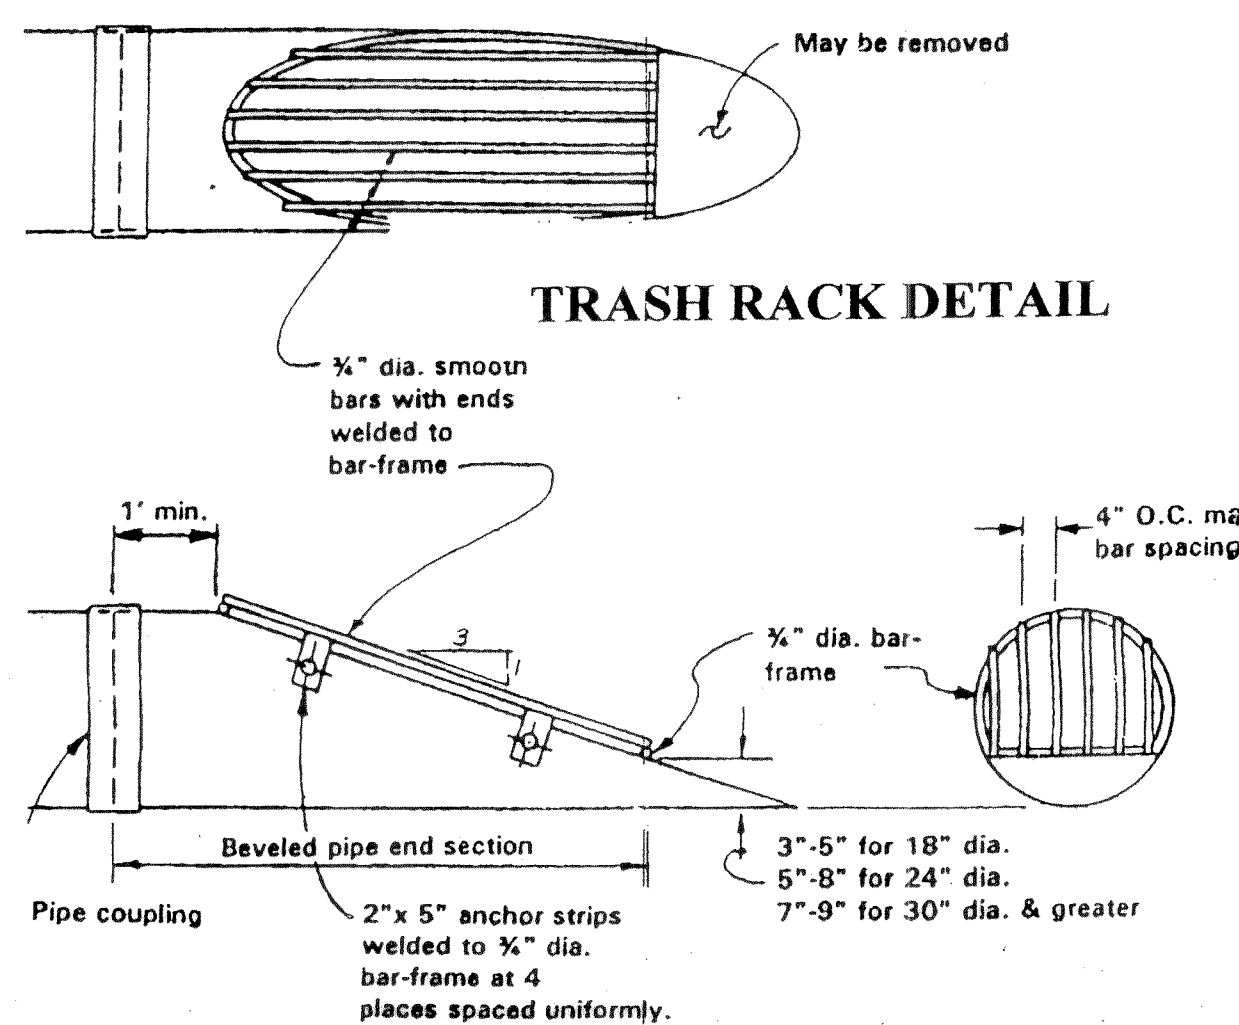

AS-BUILT

As-Built surveys were conducted October 31 and November 20, 2002 by Construction Surveyors Northwest, Inc. Bellingham, Washington.

Detention Pond Plan

Plat of Myers Estates

Madrona Engineering

SHEET:

6

OF: 12

2113 TUTTLE LANE
LUMMI ISLAND, WASHINGTON 98262
TEL: 360.756.3150 FAX: 360.756.3189



1376 WEST SMITH ROAD
FERDALE, WASHINGTON 98248

NOTES AND DETAILS

REVISION DATE DESCRIPTION

REVISION	DATE	DESCRIPTION
1	8/13/01	REVISED POND ACCESS ROAD AND STORM DRAIN
2	10/31/01	ALL PER CITY REVIEW REQUIREMENTS
3	11/30/02	REVISED POND LAYOUT & ACCESS
4	03/22/02	RESPOND TO CITY REQUIREMENTS
5	11/23/02	AS-BUILT DATA

00125.006 2-13-06 KR

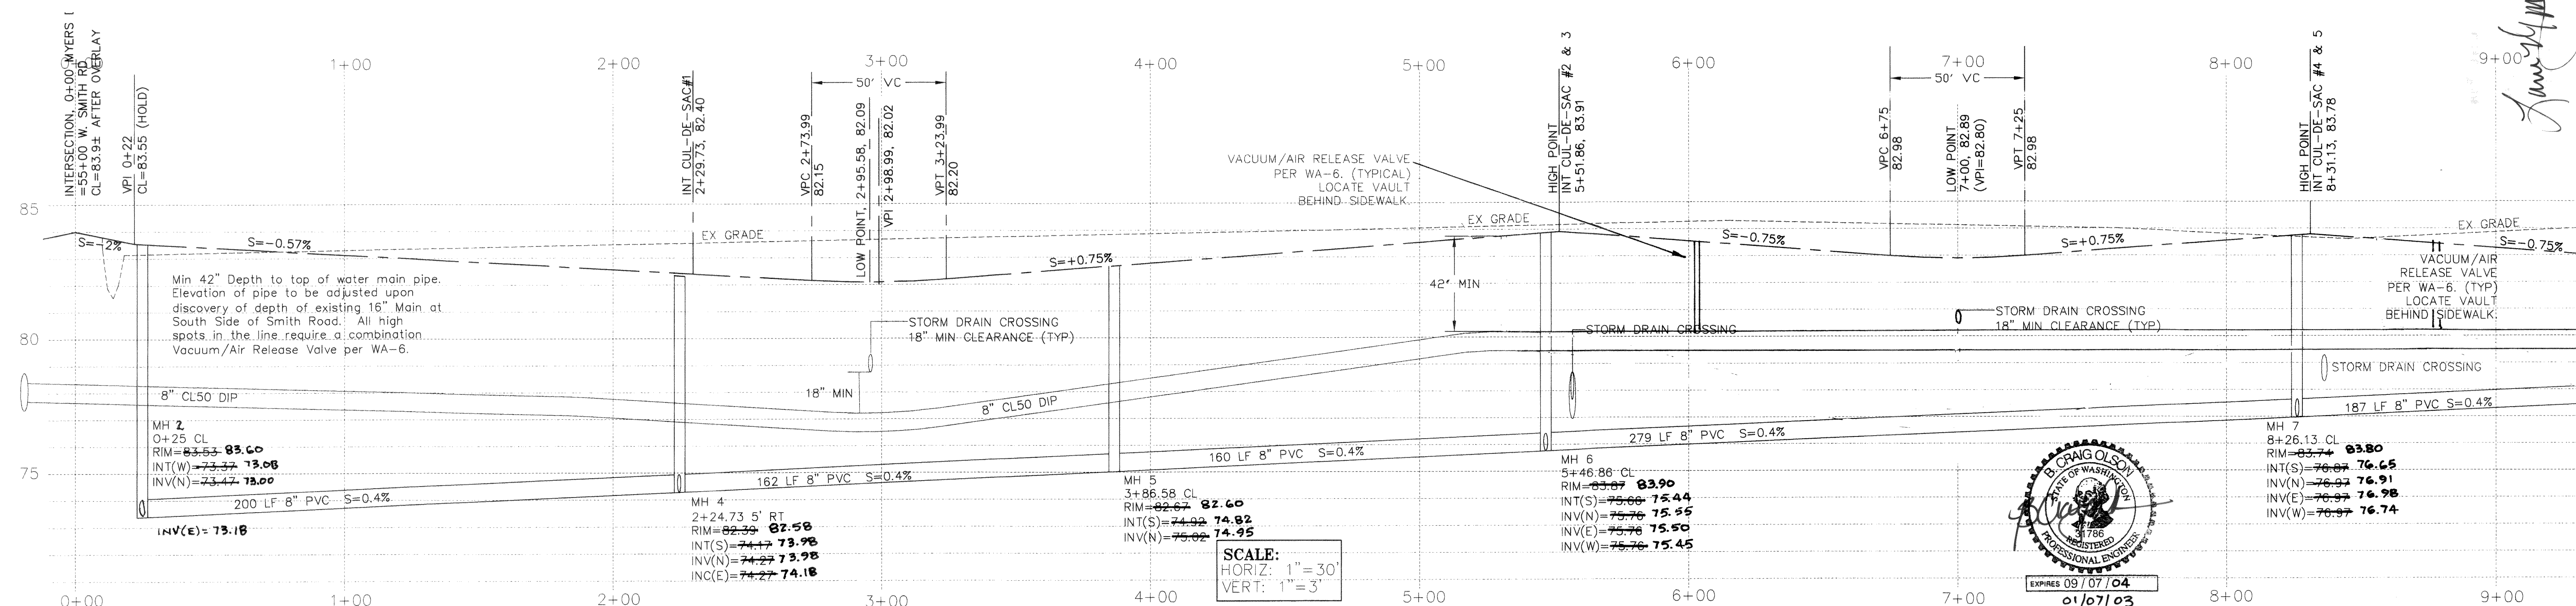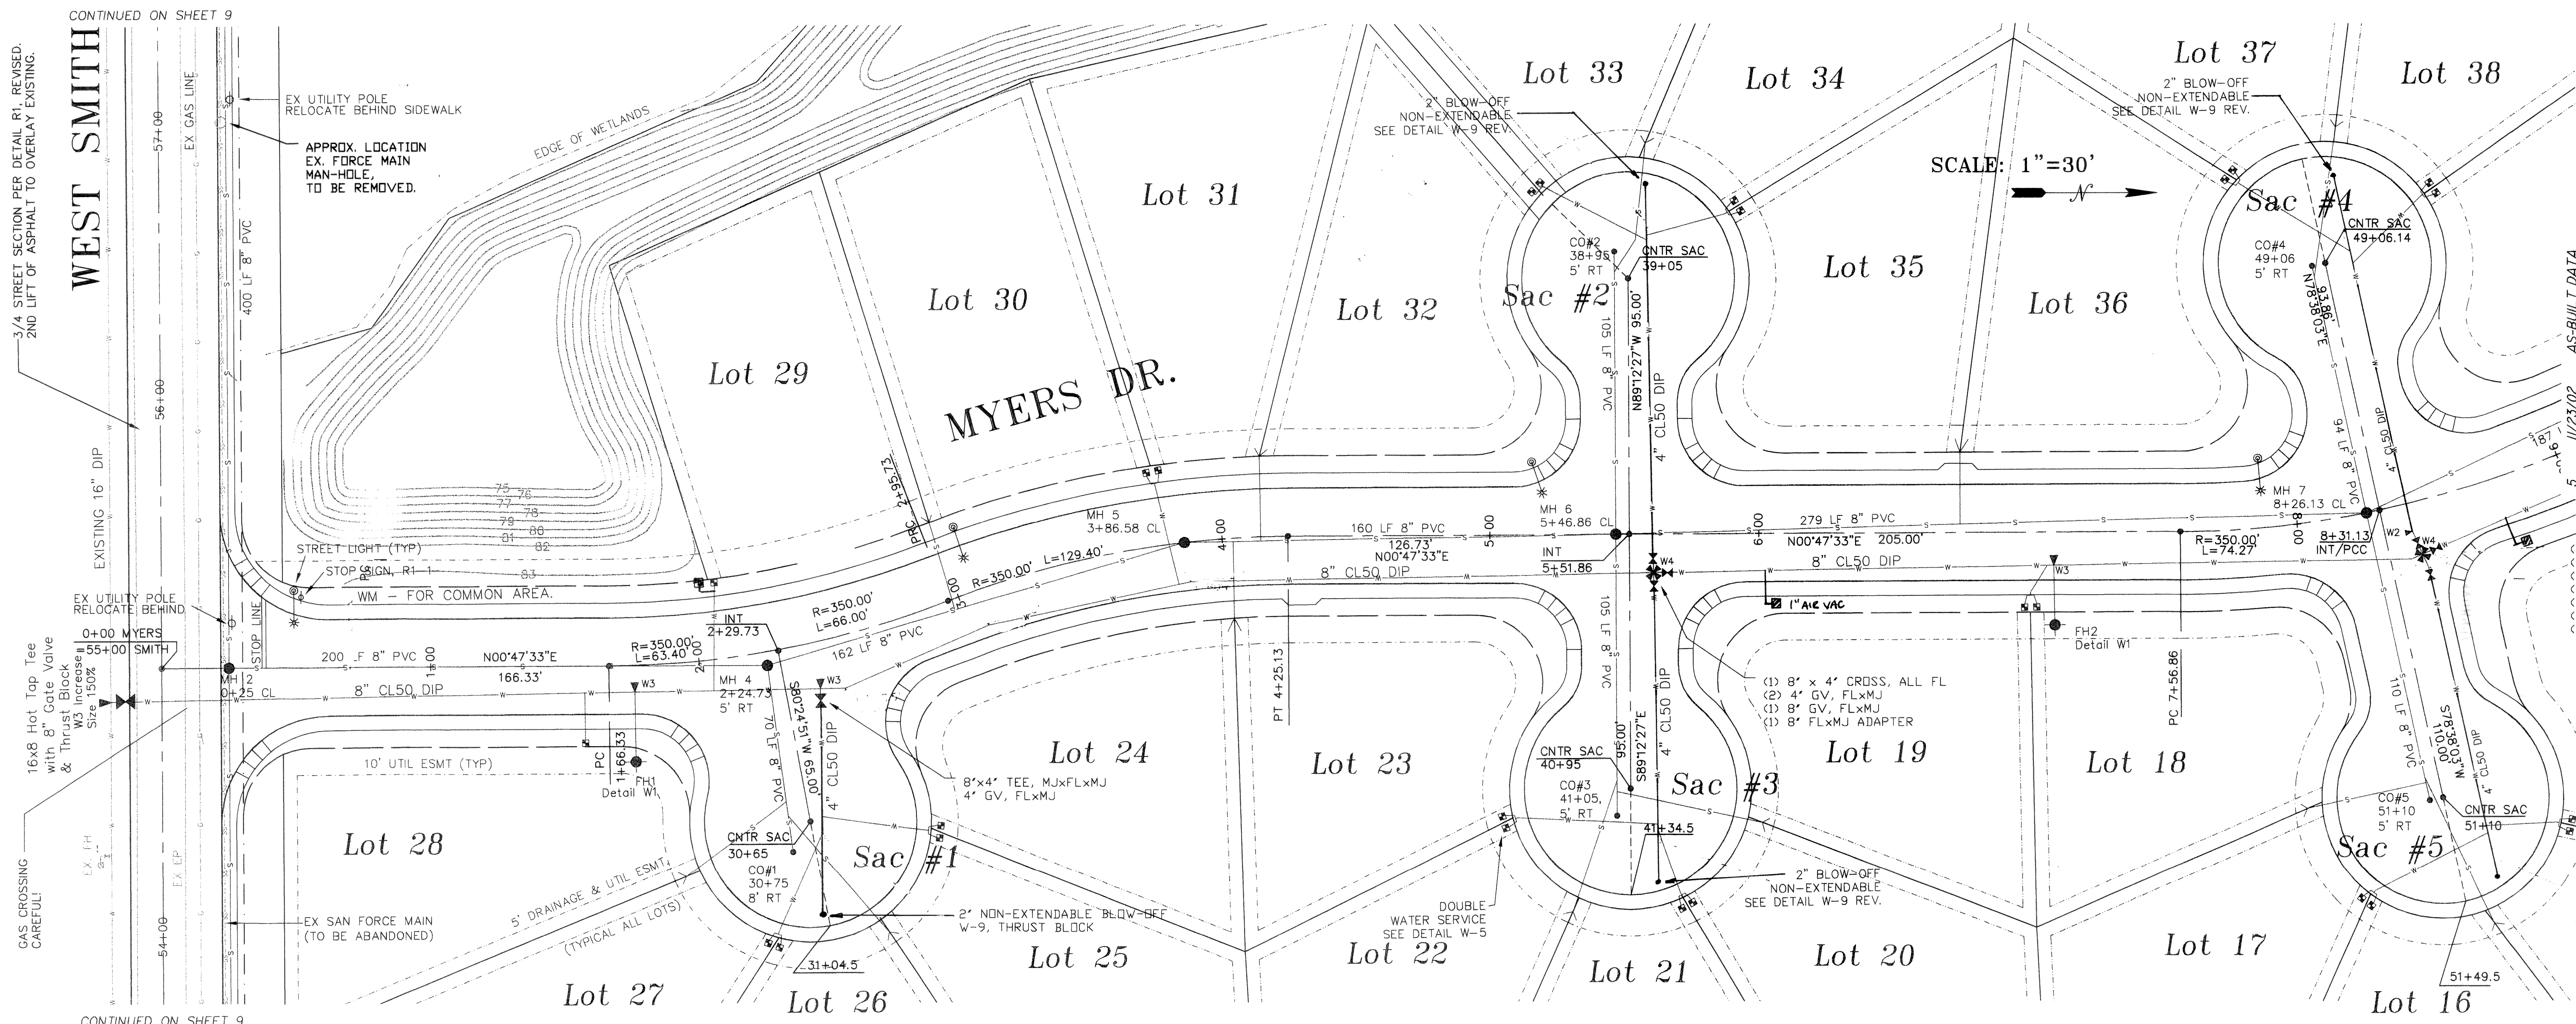

SEWER/WATER PROFILE - MYERS DRIVE

AS-BUILT
As-Built surveys were conducted October 31 and November 20, 2002 by Construction Surveyors Northwest, Inc. Bellingham, Washington.

REVISION	DATE	DESCRIPTION
1	8/13/01	REVISED PER CITY REVIEW
2	10/31/01	ALL PER CITY REVIEW REQUIREMENTS
3	1/30/02	WATERLINE PROFILE & MODIFICATIONS
4	03/22/02	RESPOND TO CITY REQUIREMENTS
5	11/23/02	AS-BUILT DATA




Pinner Engineering, Inc.
5070 Pacific Highway
FERNDALE, WASHINGTON 98248
TEL: 360.384.1285

Plat of Myers Estates
1376 WEST SMITH ROAD
FERNDALE, WASHINGTON 98248

Water & Sanitary Sewer
PLAN & PROFILE
MYERS DRIVE


Continued on Sheet 8
Continued on Sheet 9

00125:007 2:13:06 KR

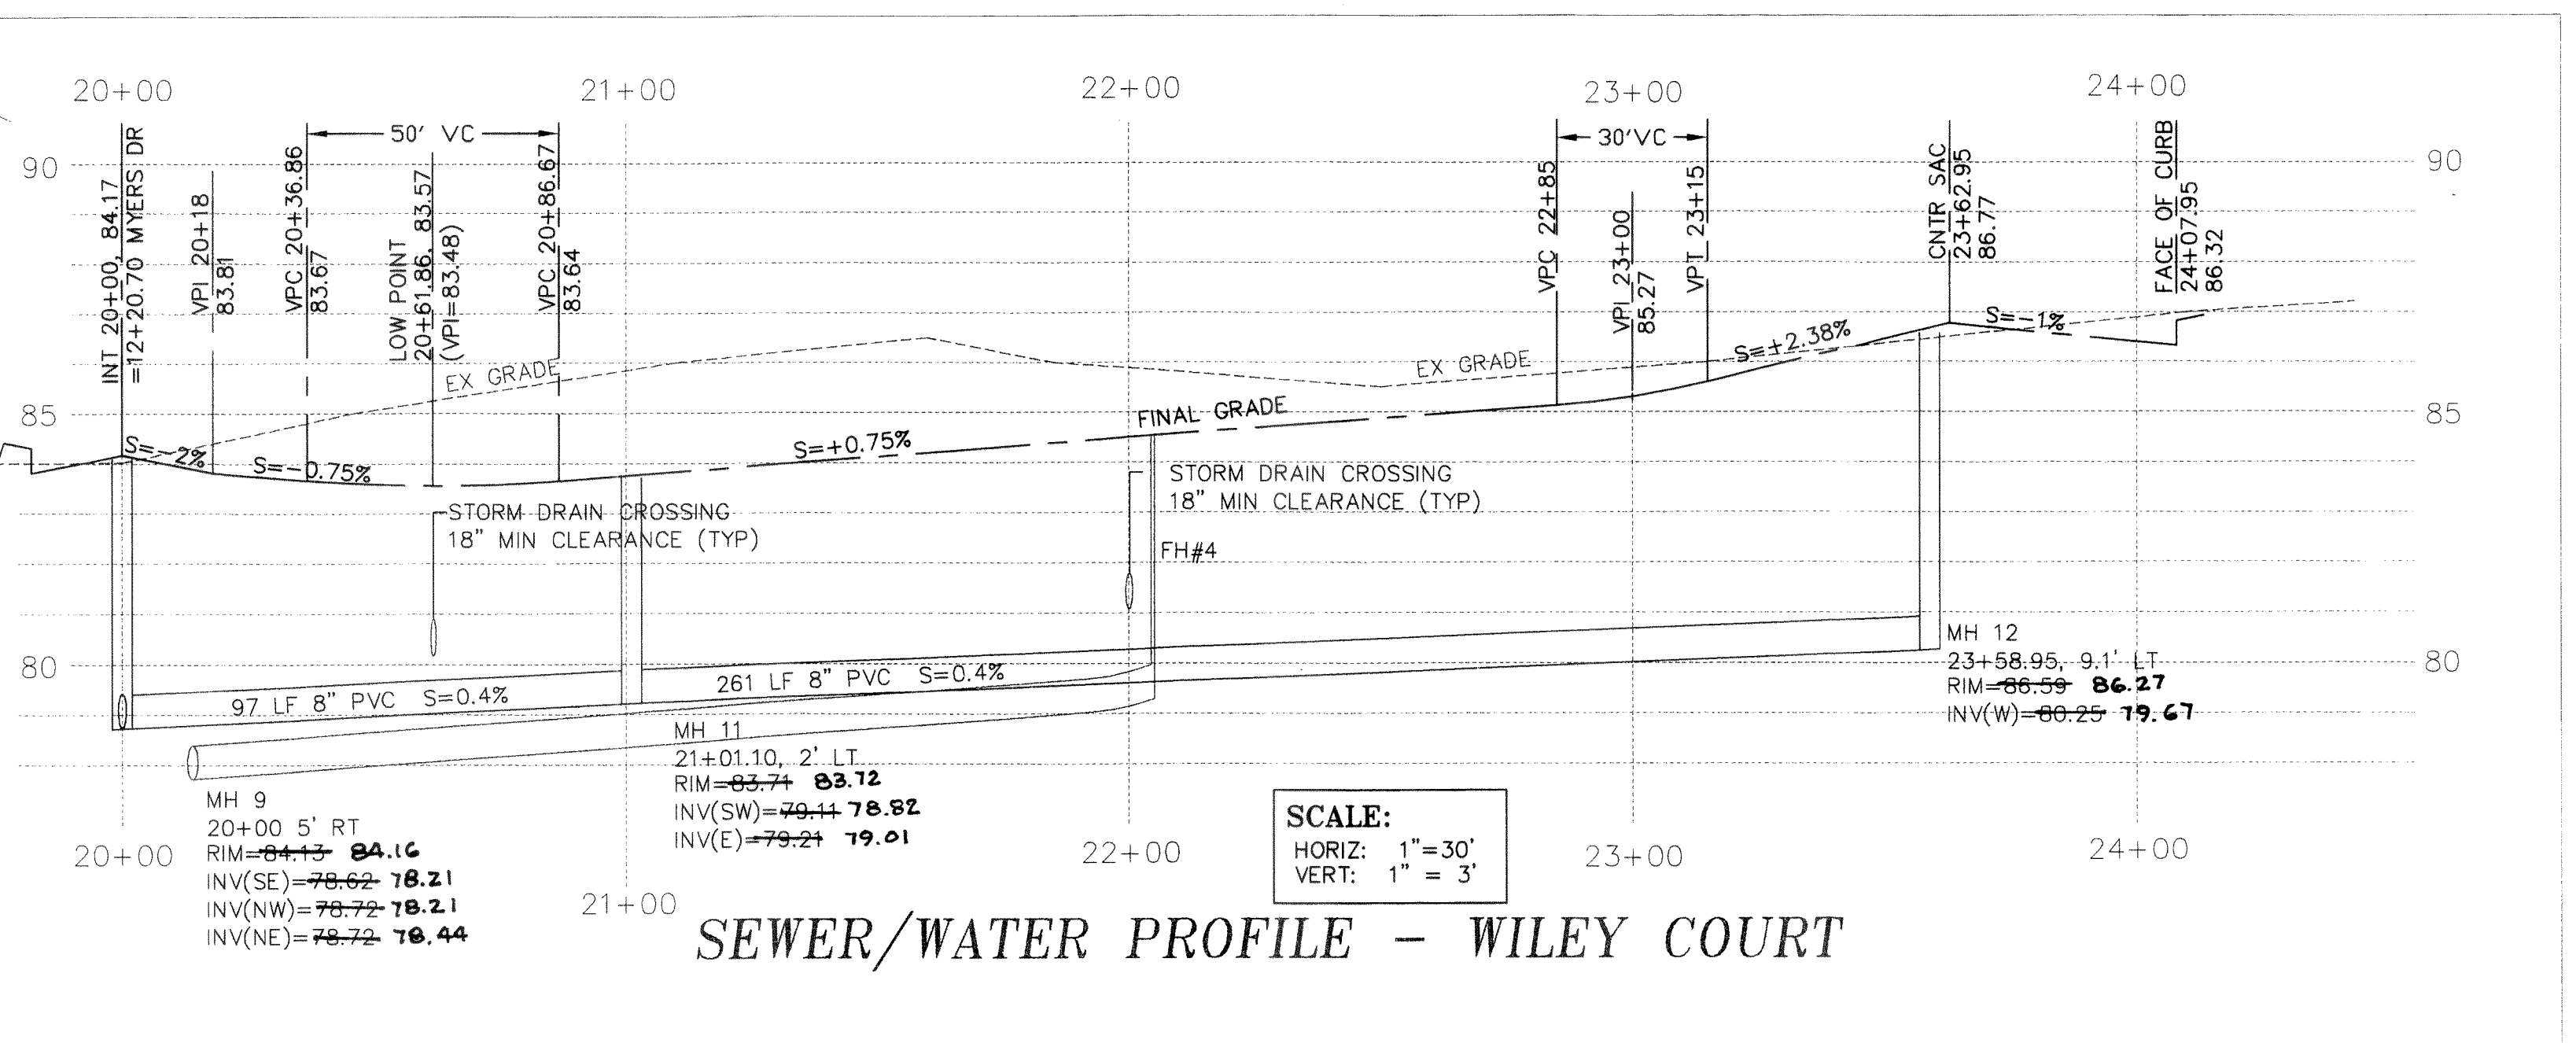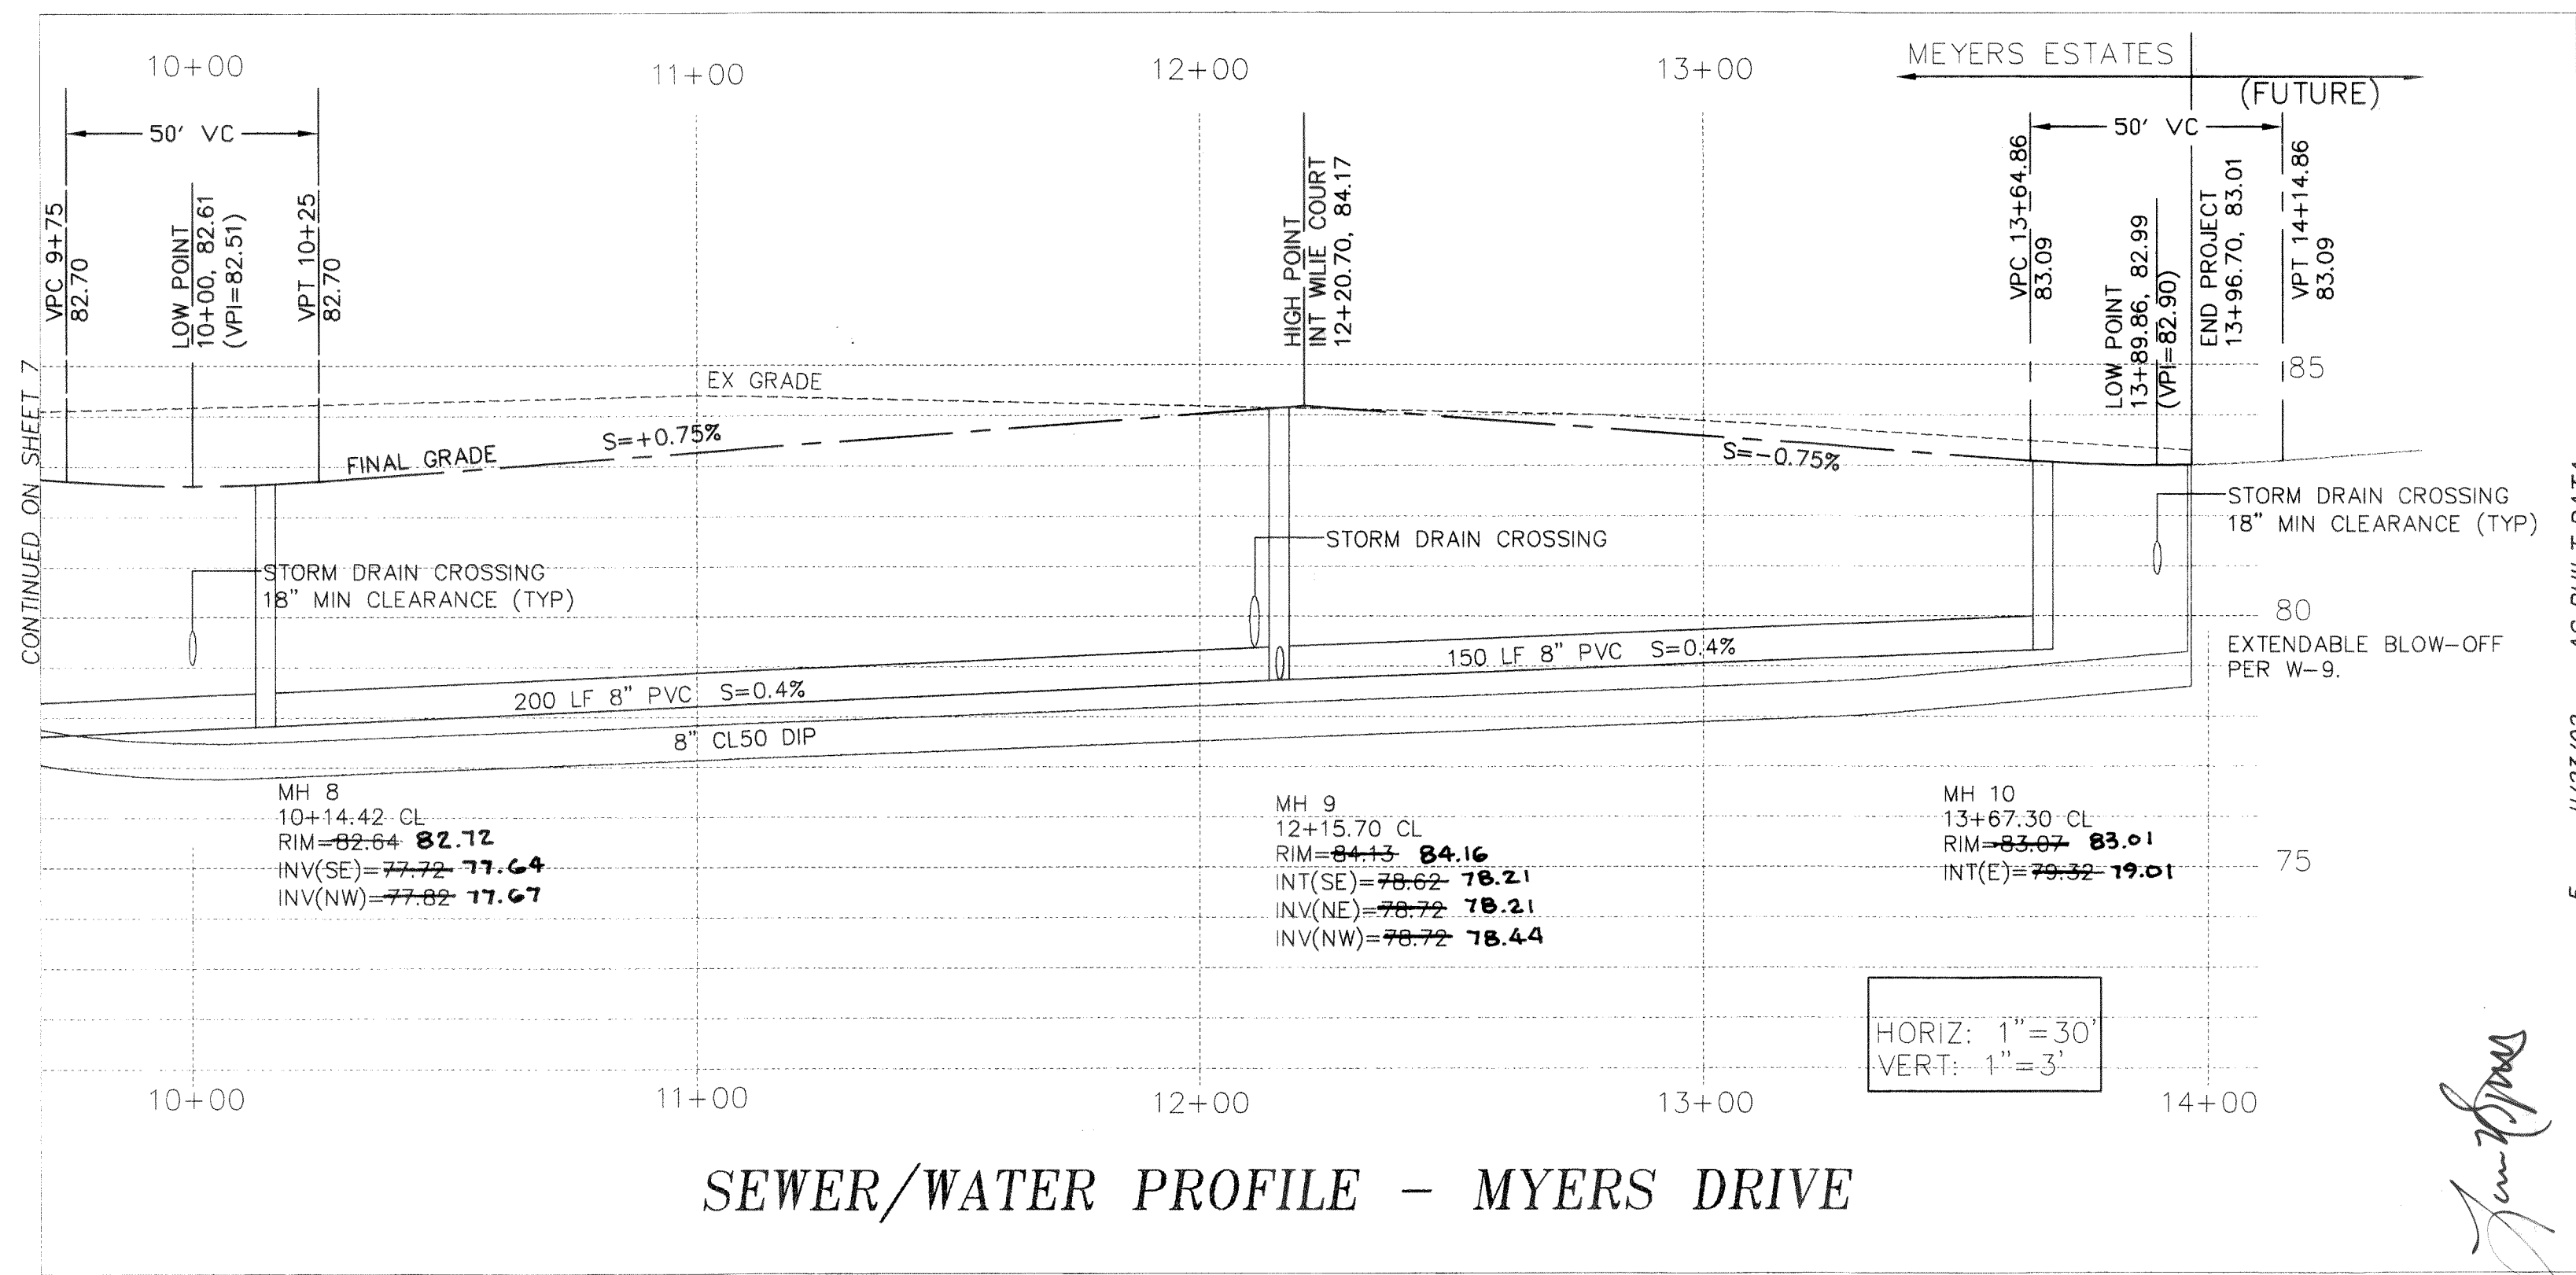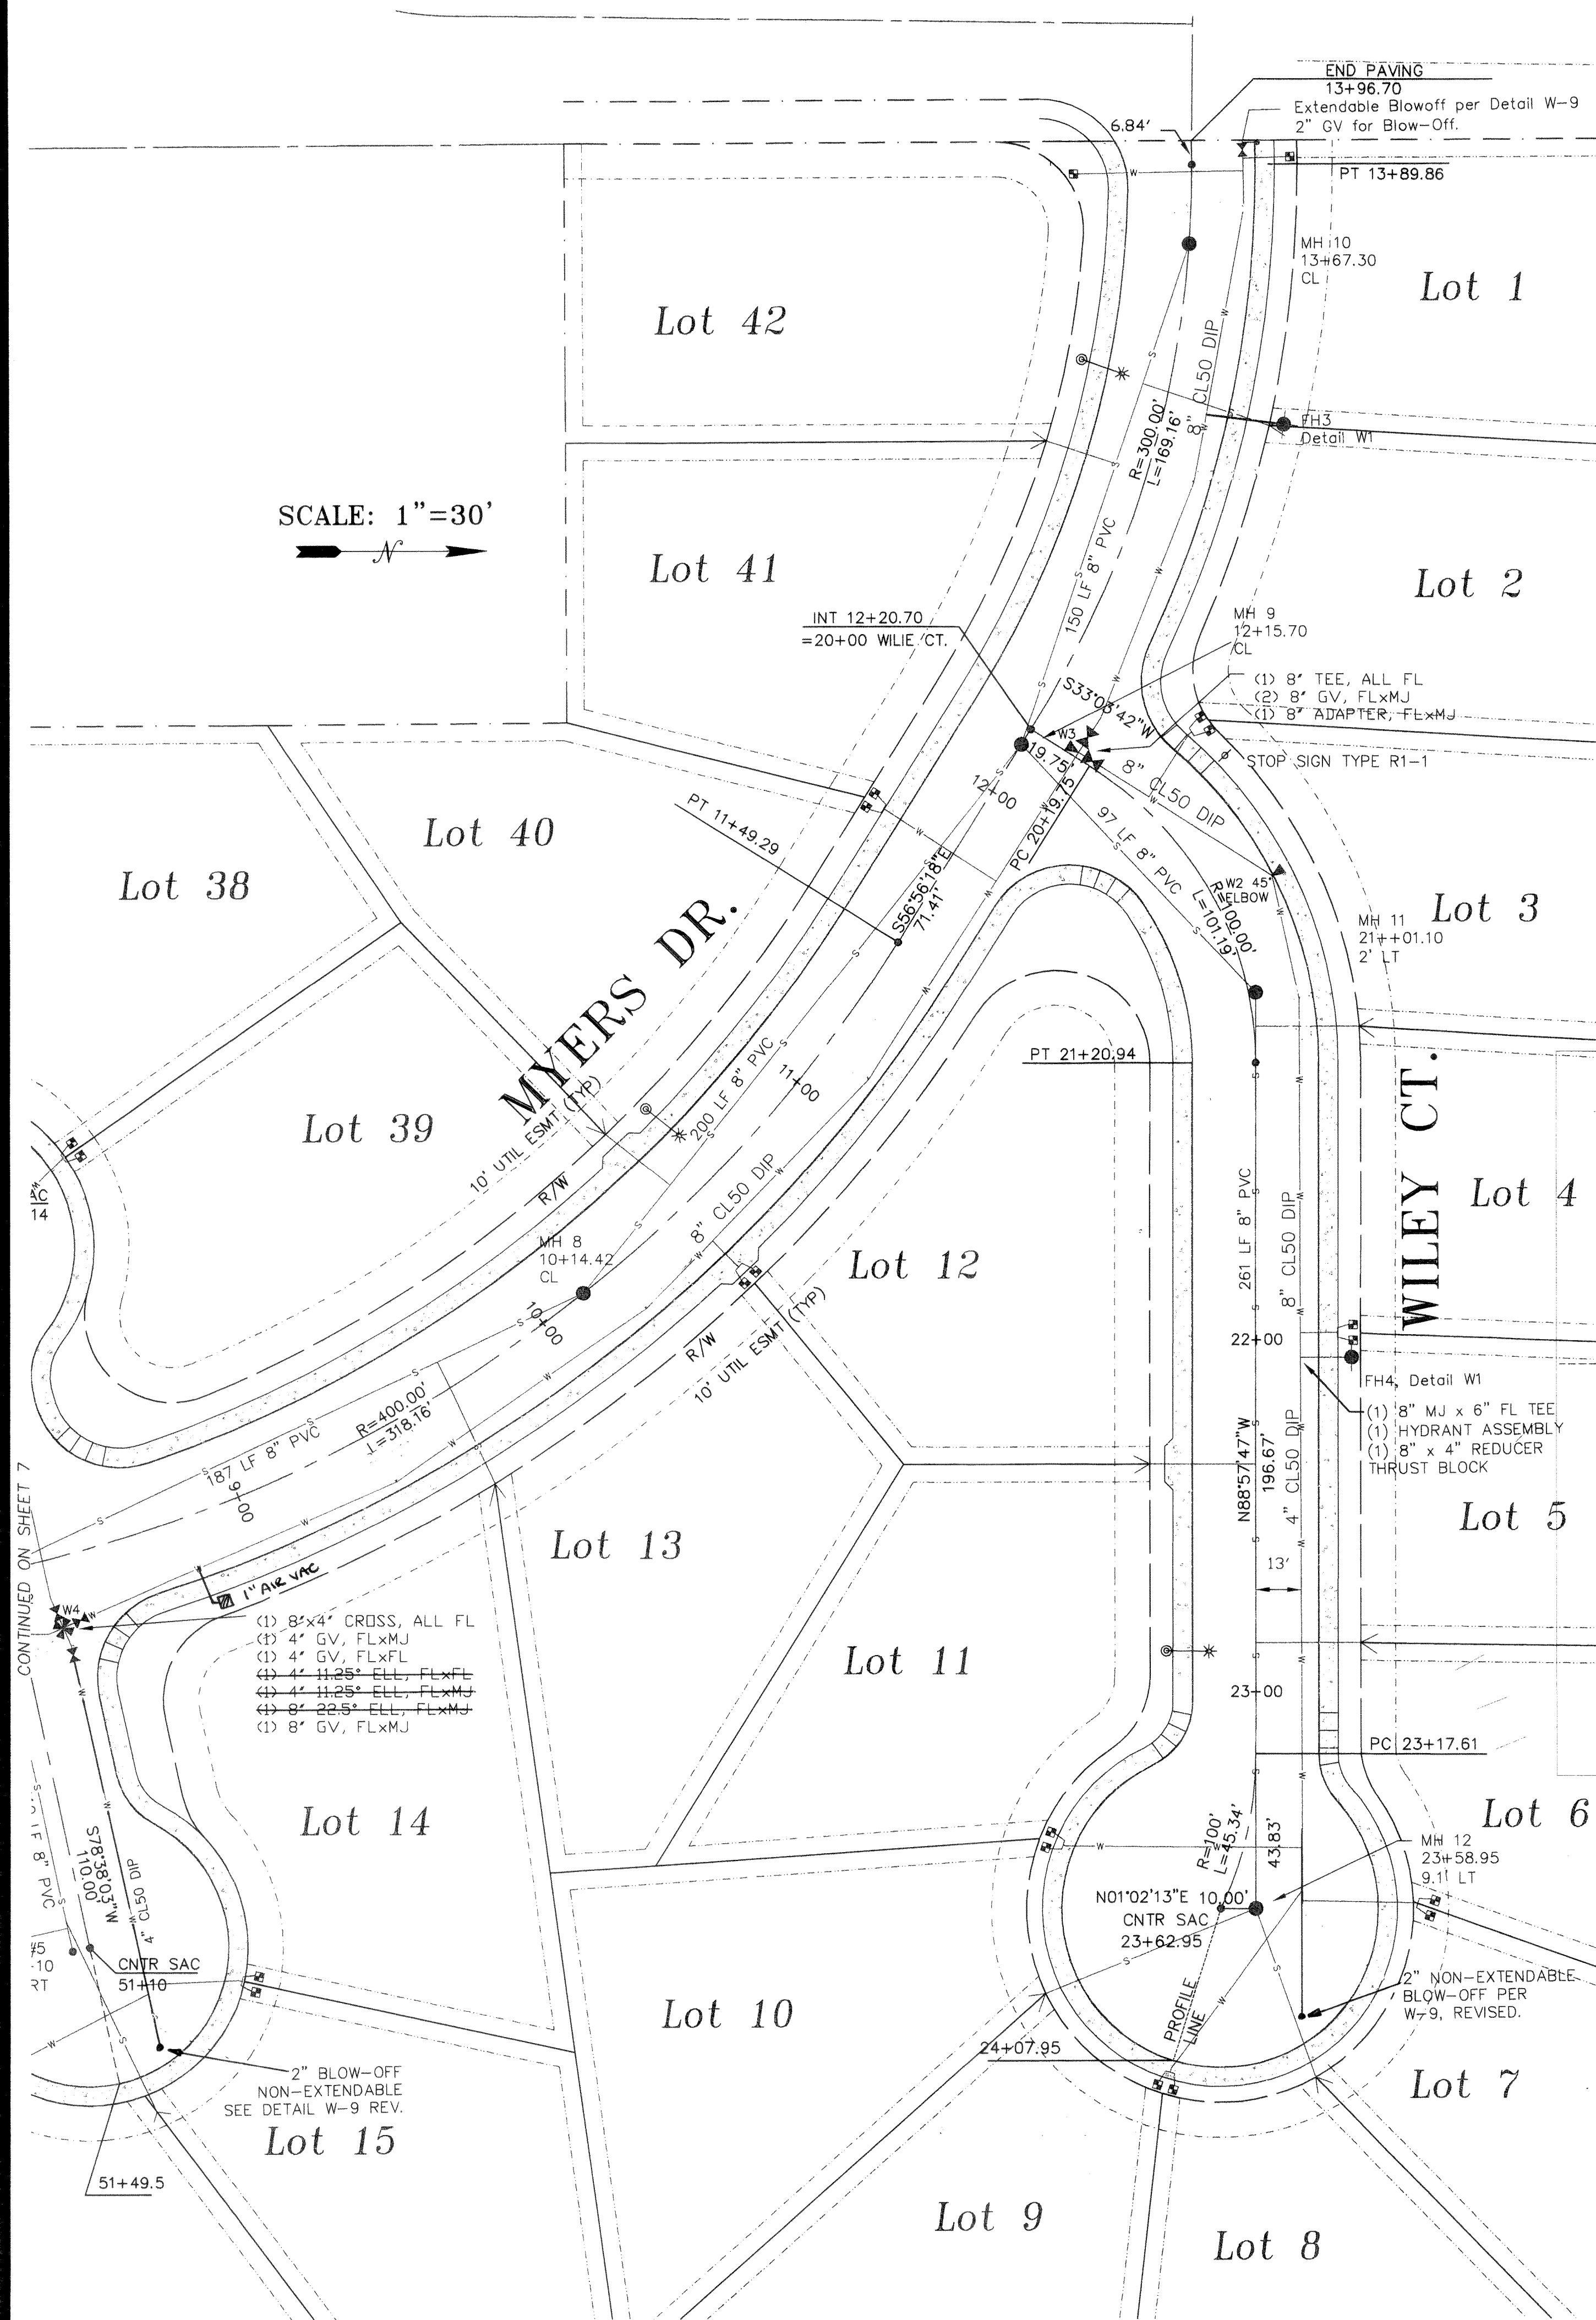

AS-BUILT



As-Built surveys were conducted October 31 and November 20, 2002 by Construction Surveyors Northwest, Inc. Bellingham, Washington.

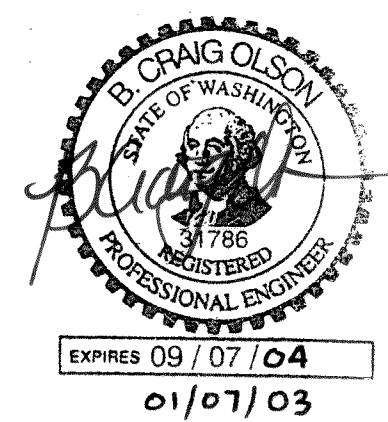

REVISION	DATE	DESCRIPTION
1	8/13/01	REVISED PER CITY REVIEW
2	10/31/01	ALL PER CITY REVIEW REQUIREMENTS
3	1/30/02	ADDED WATERLINE PROFILE
4	03/22/02	RESPOND TO CITY REQUIREMENTS
5	11/23/02	AS-BUILT DATA

Water & Sanitary Sewer
PLAN AND PROFILE
MYERS DRIVE AND WILEY COURT

Pinner Engineering, Inc.
5070 Pacific Highway
FERNDALE, WASHINGTON 98248
TEL: 360.384.1285

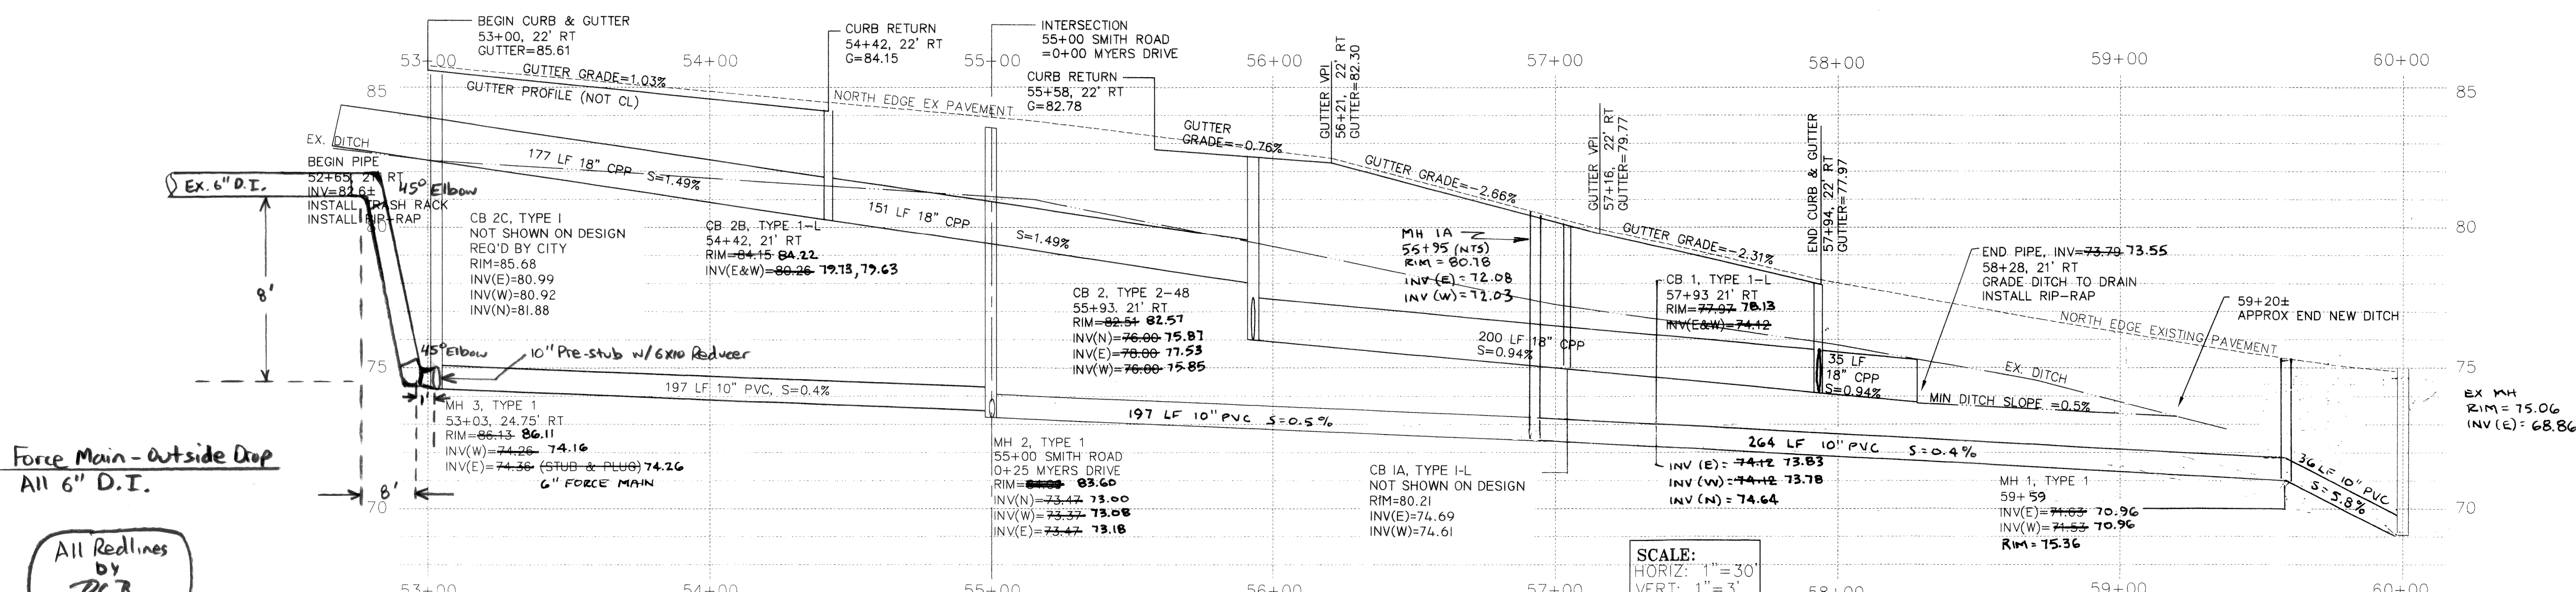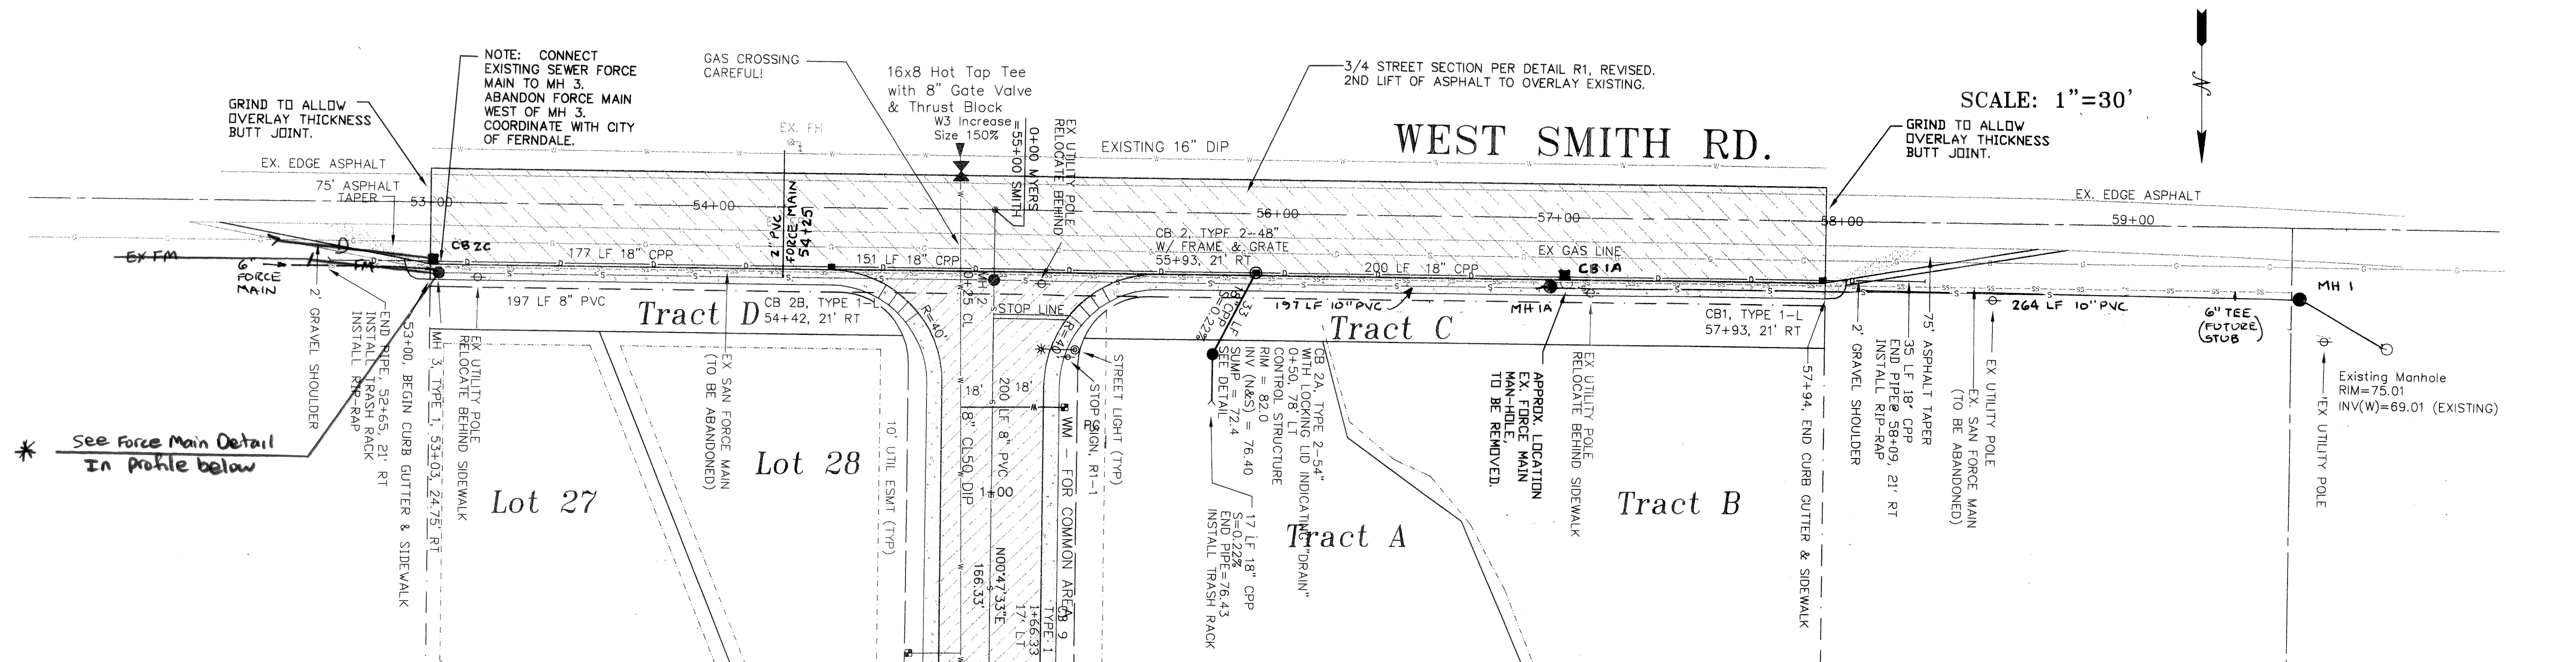

SANITARY SEWER NOTES:

- Contractor shall verify invert elevation of existing manhole on Smith Road prior to construction. The base inside the existing manhole shall be reshaped to a channel equivalent to that specified for a new manhole. All damage to existing facilities resulting from implementation of this plan shall be repaired or replaced at no additional expense to the Owner or Engineer.
- All work and materials shall conform to applicable portions of the current edition of the Standard Plans and Standard Specifications.
- PVC sewer pipe and fittings shall be solid wall construction and shall conform to the requirements of ASTM D 3034 SDR 35.
- Joints for solid wall PVC pipe shall conform to ASTM D 3212 using elastomeric gaskets conforming to ASTM F 477.
- Fittings for solid wall PVC pipe shall be injection molded, factory welded or factory solvent cemented.
- The ends of all pipes shall be trimmed flush with the inside wall of the man hole. Pipe shall be grouted on both the inside and outside of the man hole wall OR use approved elastomeric boot.
- Placement and compaction of trench backfill shall conform with GENERAL NOTE NO. 12, eight inch lifts compacted to 95% density modified proctor.
- Bedding for PVC sanitary sewer pipe shall be six inch compacted depth of "Bedding Material for Thermo-Plastic Pipe" per Standard Specification 9-03.16. Pea gravel or other suitable material may be used with prior written approval from City of Ferndale personnel.
- All man holes shall be Type 1 - 48 inch per Standard Plan B-23a, except as noted.
- Trench backfill material for PVC sanitary sewer pipe shall consist of aggregate for gravel base as specified in Section 9-0.10, except that 100 percent of the material shall pass through a 2-1/2 inch sieve opening.
- All lots within this subdivision shall have a sanitary sewer service installed per detail SS-14 at locations shown on the plans.
- Contractor shall provide Force Main abandonment plan to the City and shall coordinate with the City prior to abandonment procedure.


ALSO SEE GENERAL NOTES AND OTHER NOTES.

SMITH ROAD OVERLAY NOTES:

- Existing Smith Road subgrade to be certified by a Geo-technical Engineer as being adequate for intended use prior to overlay. Inadequate subgrade will require full road reconstruction.
- Amopave 4599 or Engineer-approved equal shall be place between asphalt lifts in accordance with manufacturer's instructions.
- Sawcut existing asphalt road inside fog line prior to new road construction. Location of sawcut to be approved by Public Works Director.
- Smith Road may require pre-level prior to final lift of asphalt.
- Grind road ends to allow overlay thickness butt joint.


WATER NOTES:

- Water-related construction including trench excavation, pipe fitting installations and testing, and backfilling shall conform with applicable sections of the Standard Specifications including 7-09 to 7-15 and in accordance with the City of Ferndale Development Guidelines and Improvement Standards.
- Water Main shall be Class 50 ductile iron pipe conforming with Section 9-30.1 of the Standard Specification. Water fittings for the ductile iron pipe shall meet requirements set forth in section 9-30.2 of the Standard Specification.
- Fire Hydrants shall conform with City of Ferndale Development Standards Section 705.A.5.
- Depth of cover from final grade to top of pipe shall be 42 inches minimum.
- Use City of Ferndale standard Type K Copper pipe for all water services.
- Pressure testing of the water main, disinfection, and "As-Built" shall be in conformance with applicable sections of the Standard Specification. Test pressure shall be 150 psi above working pressure, but not less than 200 psi.

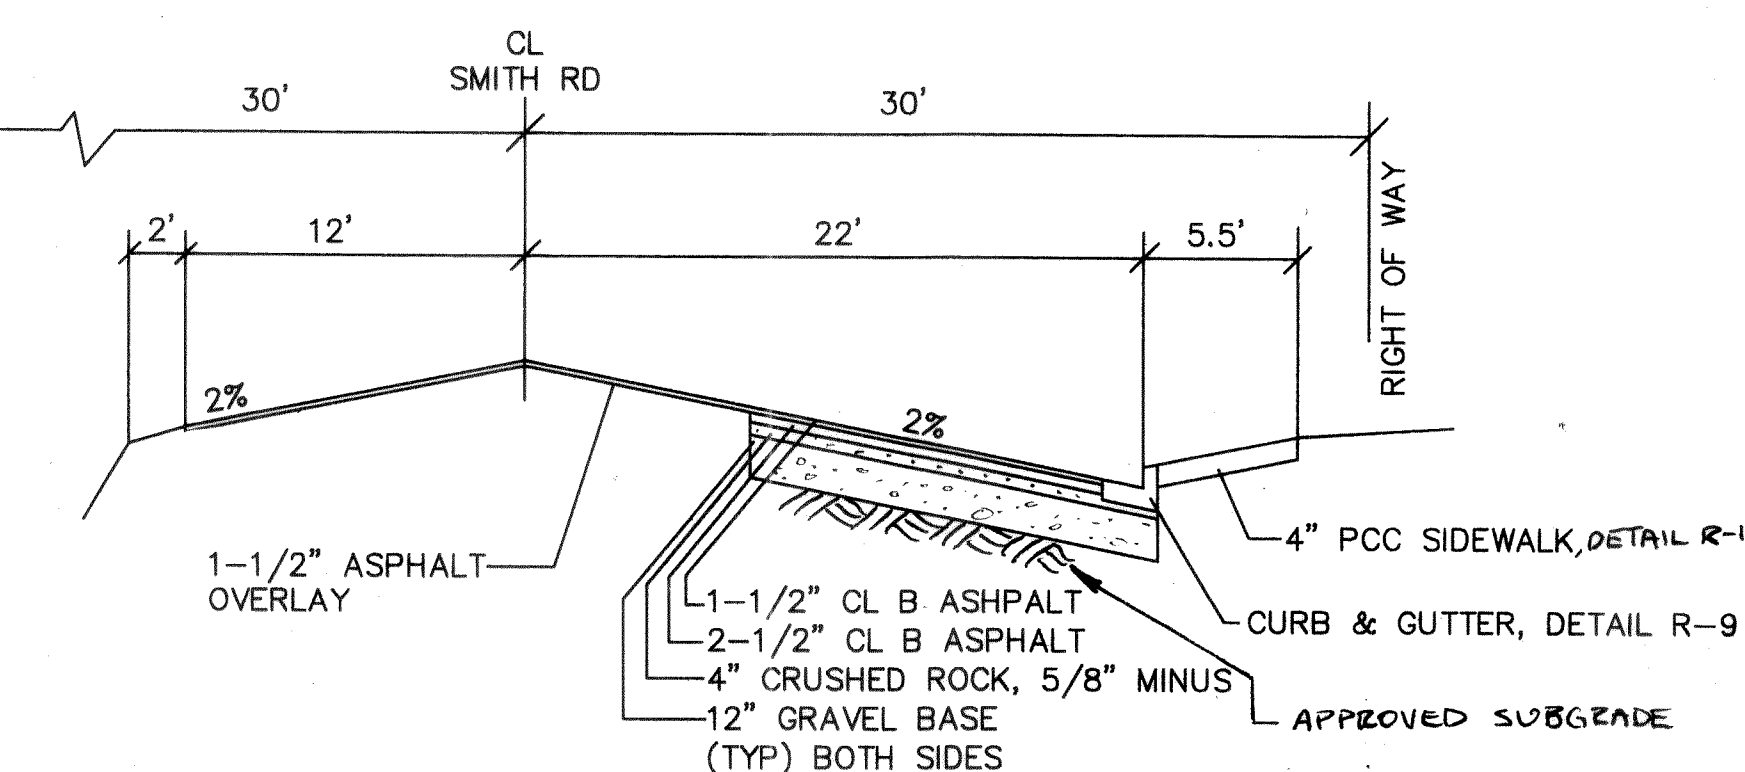

SMITH ROAD 3/4 STREET SECTION
DETAIL R1, REVISED

AS-BUILT
As-Built surveys were conducted October 31 and November 20, 2002 by Construction Surveyors Northwest, Inc. Bellingham, Washington.

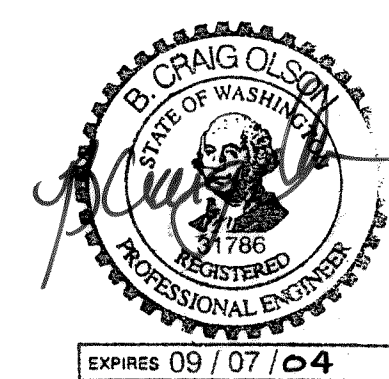

00125.009 2-13-06 KK


AS-BUILT DATA
11/23/02
RESPOND TO CITY REQUIREMENTS
4
03/22/02
ADDED 3/4 ST/ SECTION WITH UTILITIES
3
1/30/02
ADDED NOTES RE: EX. FORCE MAIN
2
10/31/01
REVISED SEWER LAYOUT
1
8/13/01
DATE
DESCRIPTION

Smith Road Improvements
PLAN AND PROFILE
WEST SMITH ROAD


Plat of Myers Estates
1376 WEST SMITH ROAD
FERNDALE, WASHINGTON 98248

Madrona Engineering
2113 TUTTLE LANE
LUMMI ISLAND, WASHINGTON 98262
TEL: 360.758.3150 FAX: 360.758.3189


SHEET:
9
OF: 12

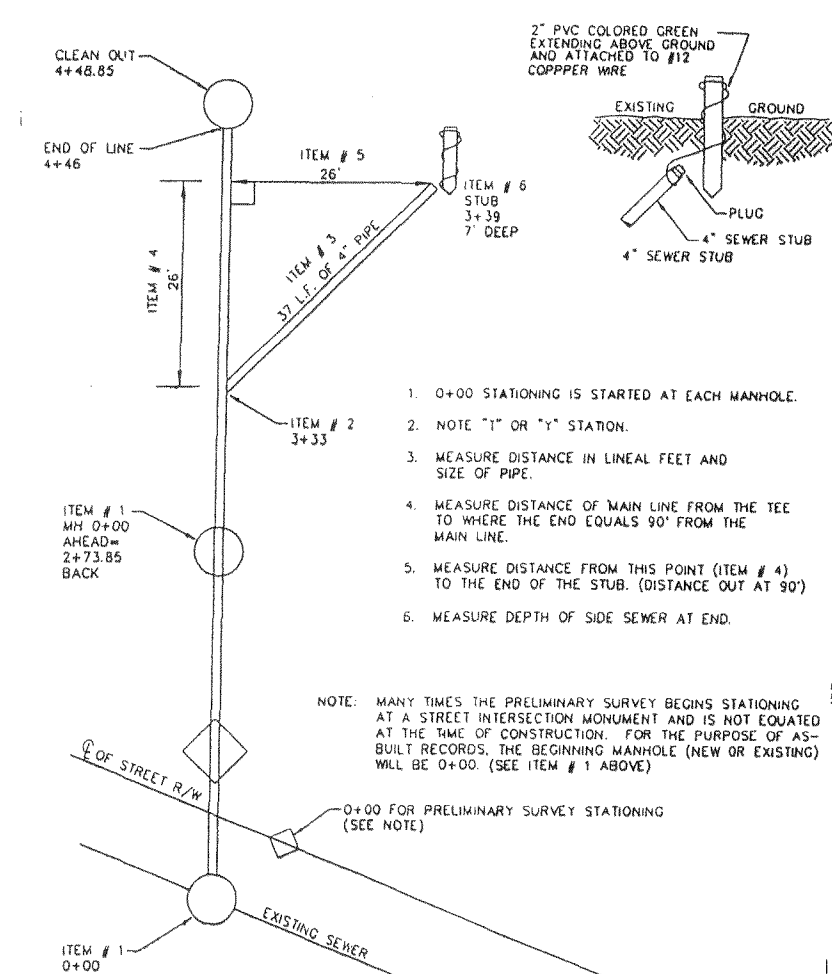


APPROVED: [Signature] CITY OF FERDALE PUBLIC WORKS DIRECTOR DATE: [Blank] DRAWING: SS-14

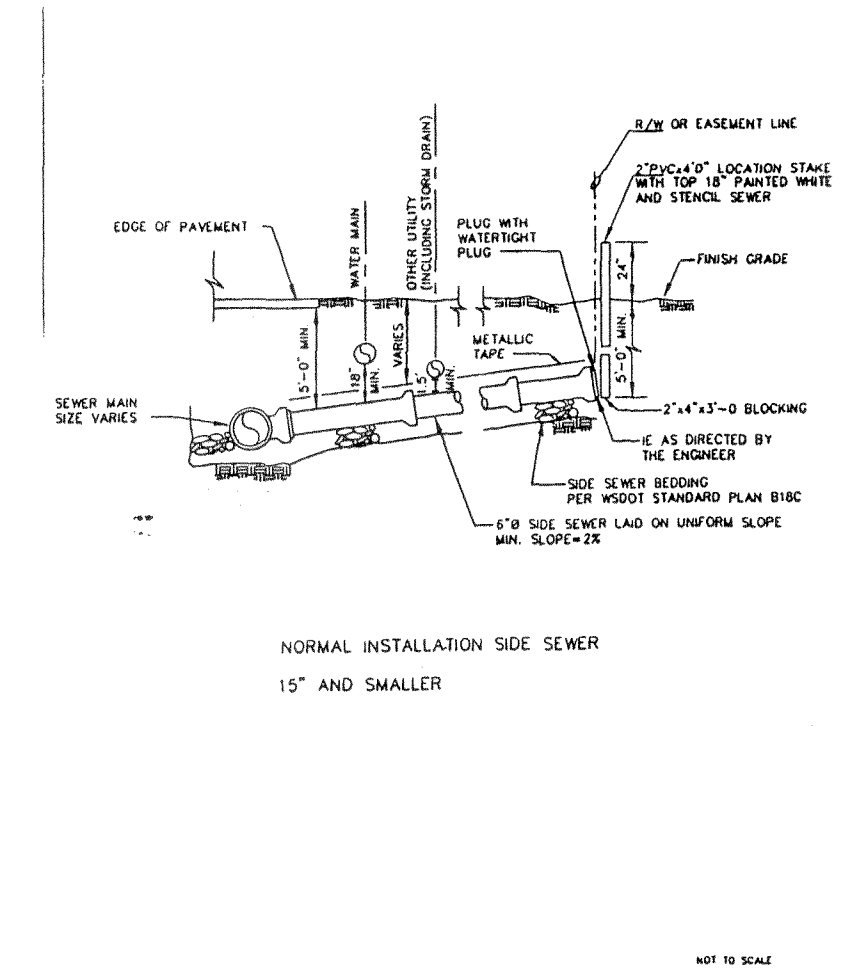


APPROVED: [Signature] CITY OF FERDALE PUBLIC WORKS DIRECTOR DATE: [Blank] DRAWING: SS-6

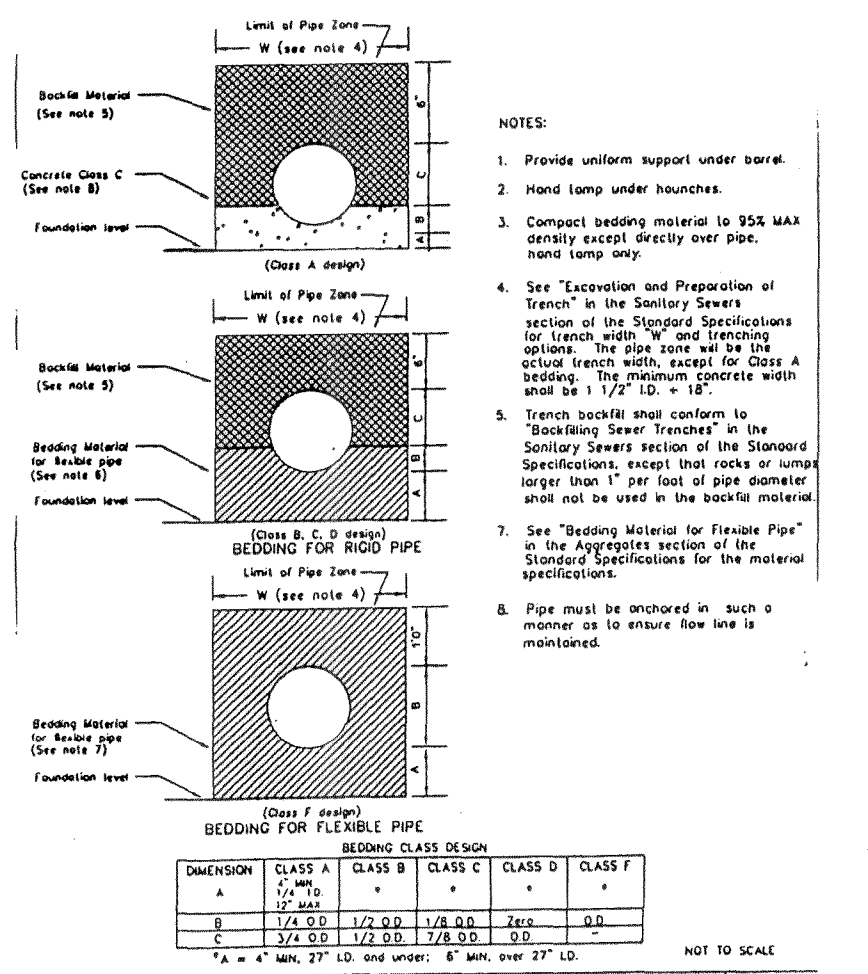


APPROVED: [Signature] CITY OF FERDALE PUBLIC WORKS DIRECTOR DATE: [Blank] DRAWING: SS-1

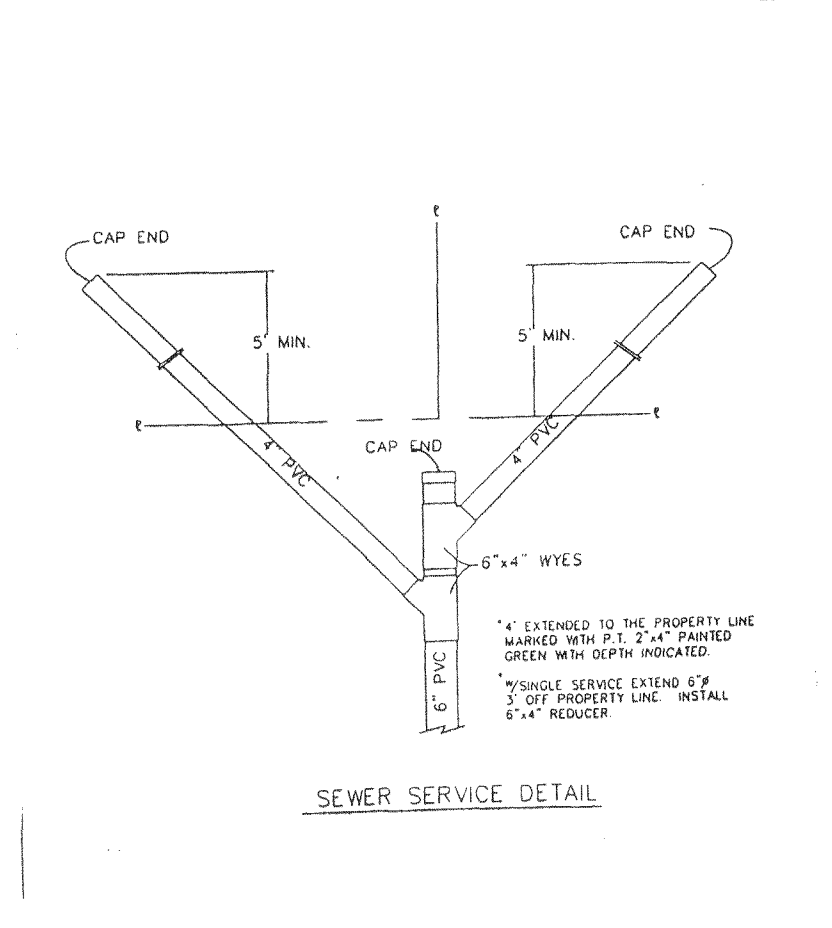


APPROVED: [Signature] CITY OF FERDALE PUBLIC WORKS DIRECTOR DATE: [Blank] DRAWING: SS-13

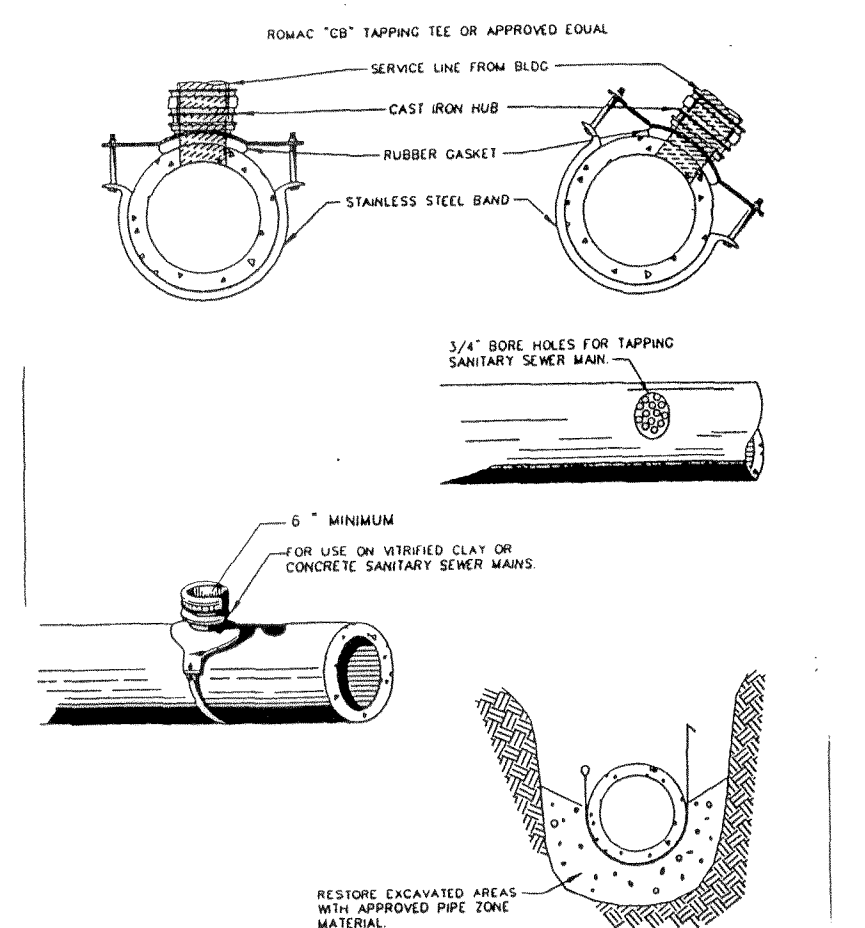


APPROVED: [Signature] CITY OF FERDALE PUBLIC WORKS DIRECTOR DATE: [Blank] DRAWING: SS-12

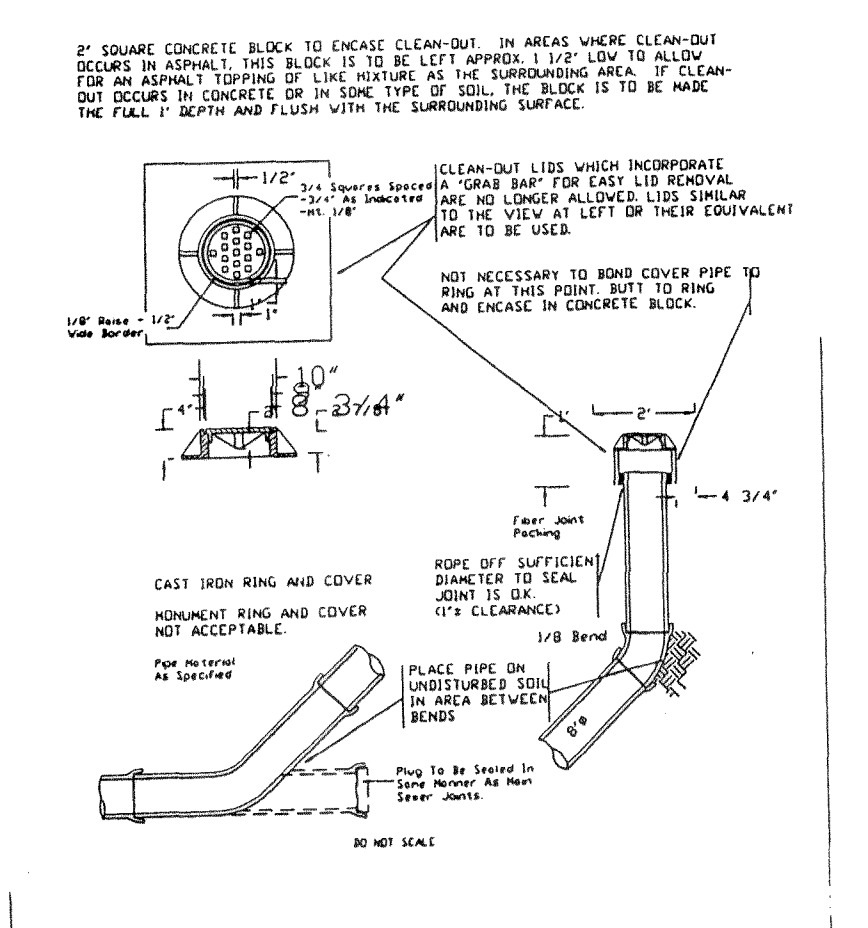


APPROVED: [Signature] CITY OF FERDALE PUBLIC WORKS DIRECTOR DATE: [Blank] DRAWING: SS-5

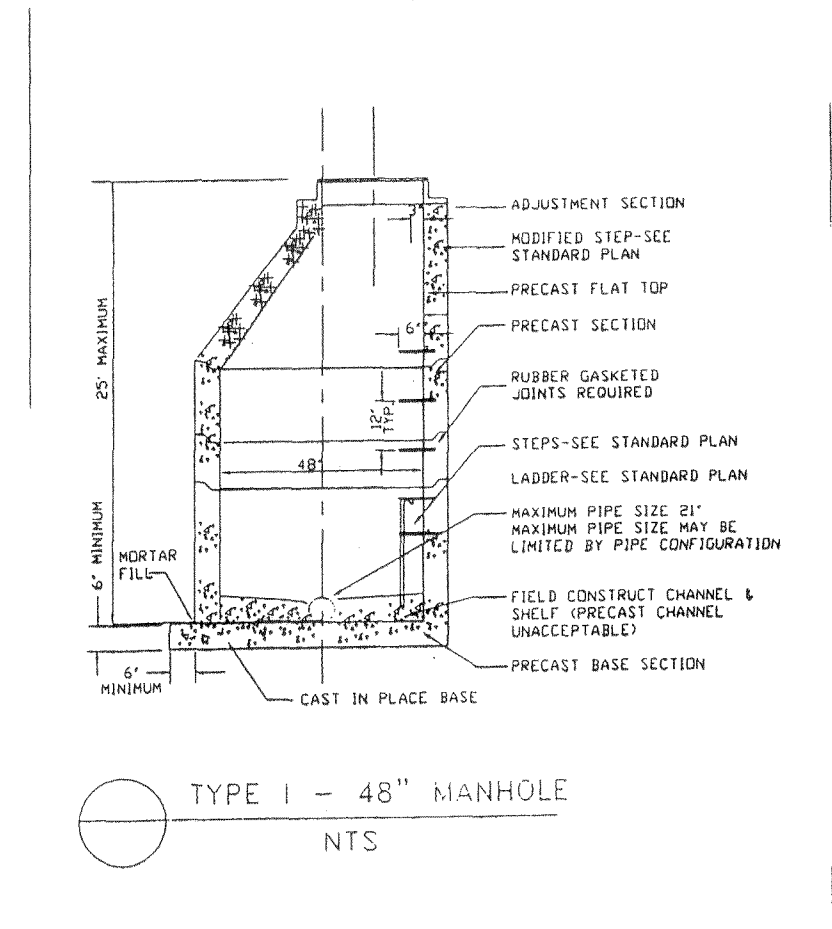


APPROVED: [Signature] CITY OF FERDALE PUBLIC WORKS DIRECTOR DATE: [Blank] DRAWING: SS-2

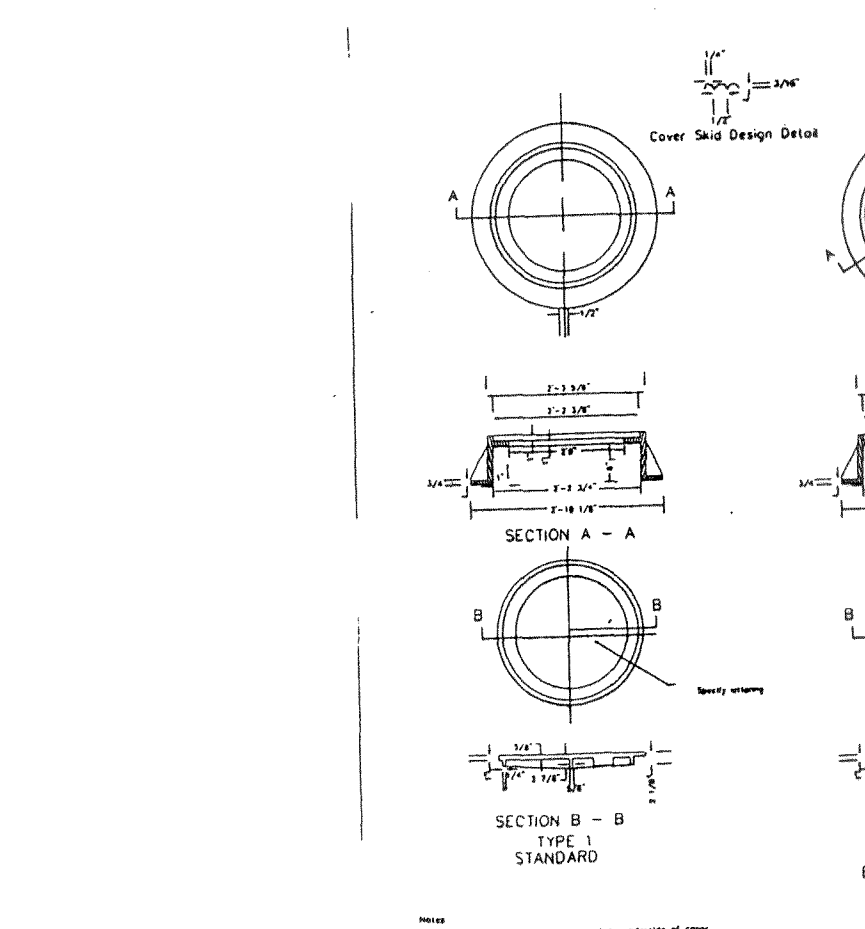


APPROVED: [Signature] CITY OF FERDALE PUBLIC WORKS DIRECTOR DATE: [Blank] DRAWING: SS-9

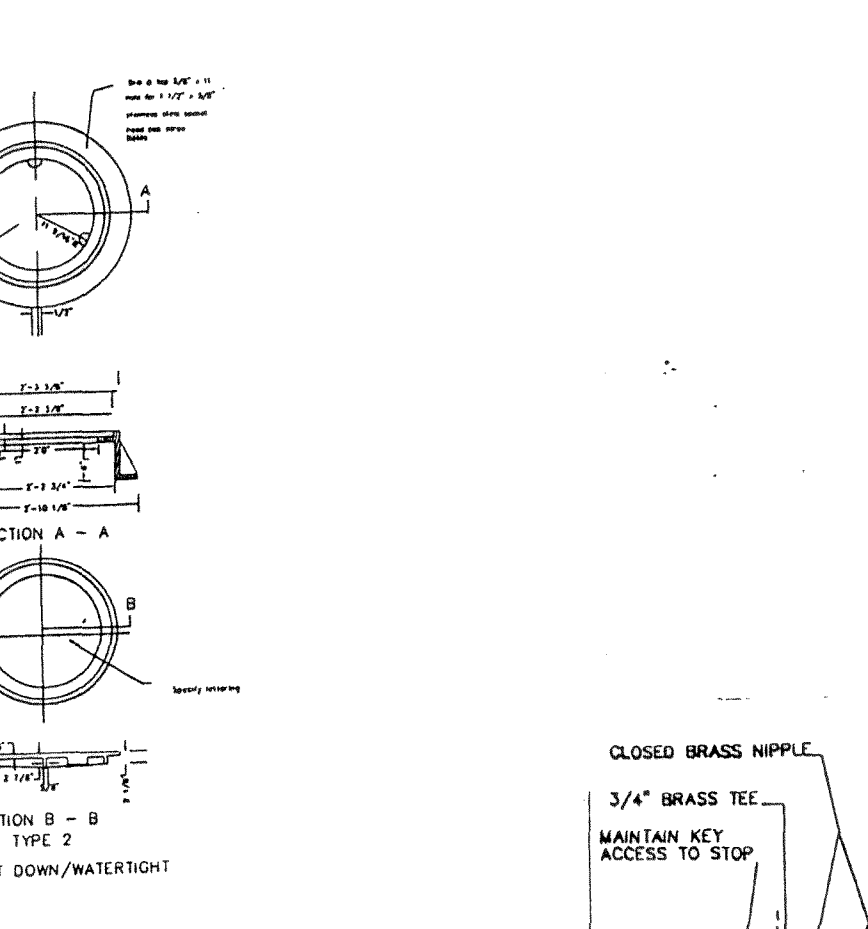


APPROVED: [Signature] CITY OF FERDALE PUBLIC WORKS DIRECTOR DATE: [Blank] DRAWING: SS-9

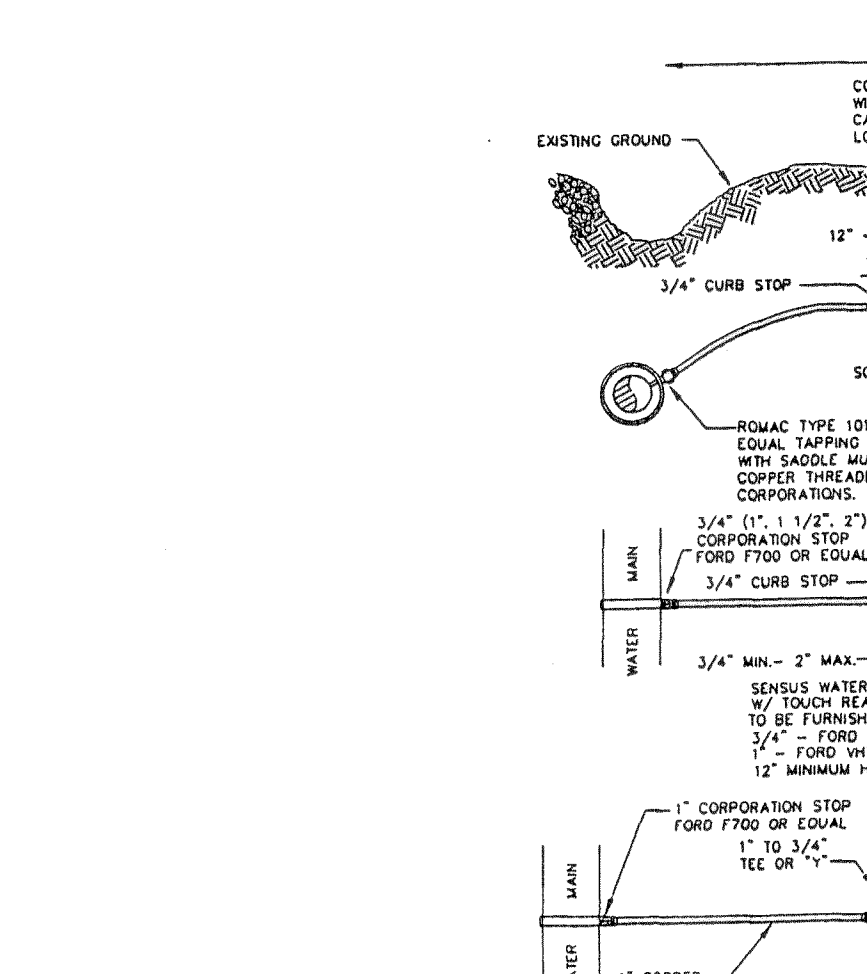


APPROVED: [Signature] CITY OF FERDALE PUBLIC WORKS DIRECTOR DATE: [Blank] DRAWING: SS-1

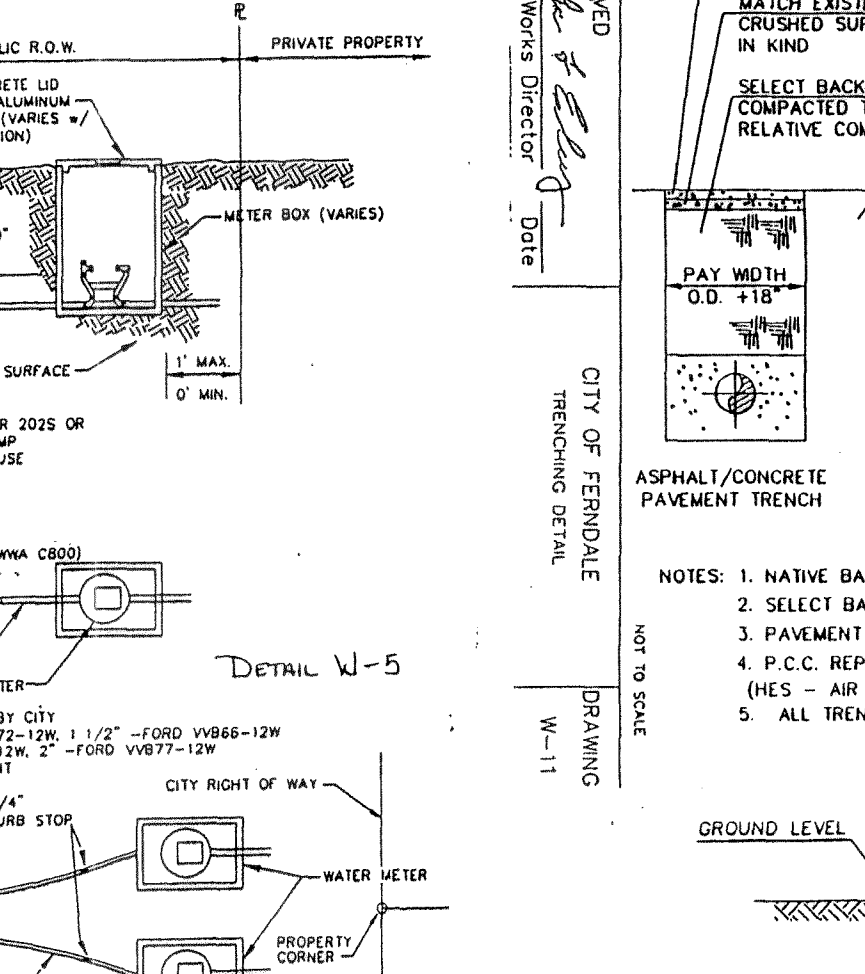


APPROVED: [Signature] CITY OF FERDALE PUBLIC WORKS DIRECTOR DATE: [Blank] DRAWING: SS-1

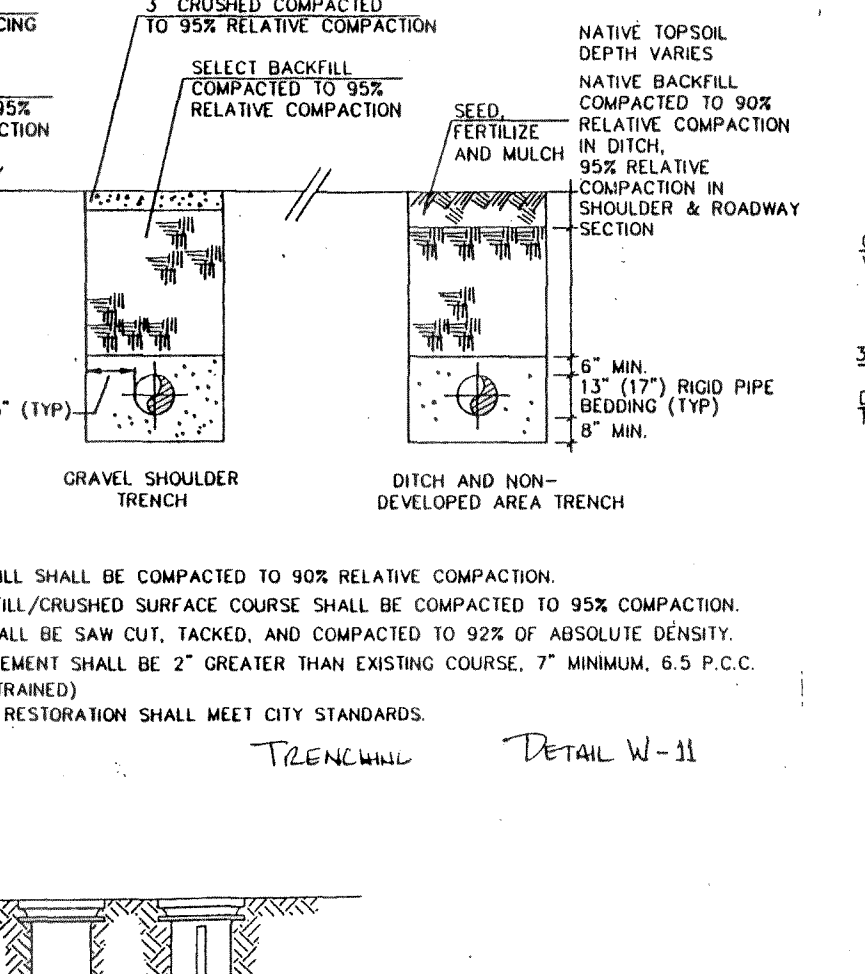


APPROVED: [Signature] CITY OF FERDALE PUBLIC WORKS DIRECTOR DATE: [Blank] DRAWING: SS-1

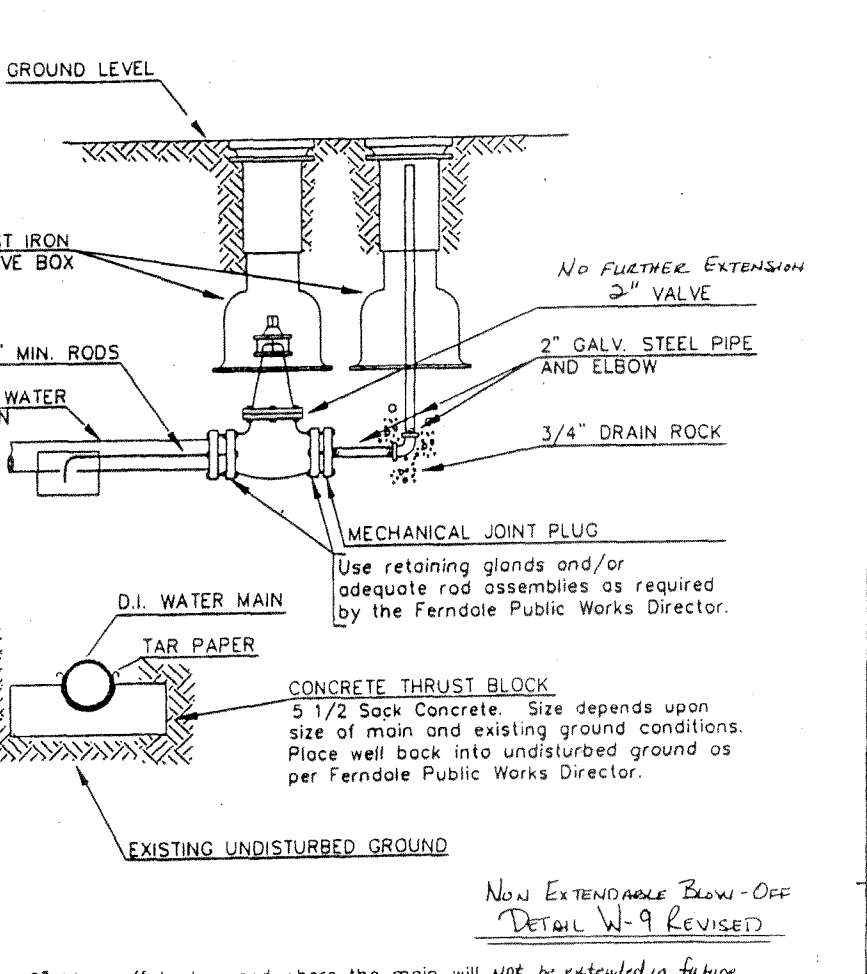


APPROVED: [Signature] CITY OF FERDALE PUBLIC WORKS DIRECTOR DATE: [Blank] DRAWING: SS-1

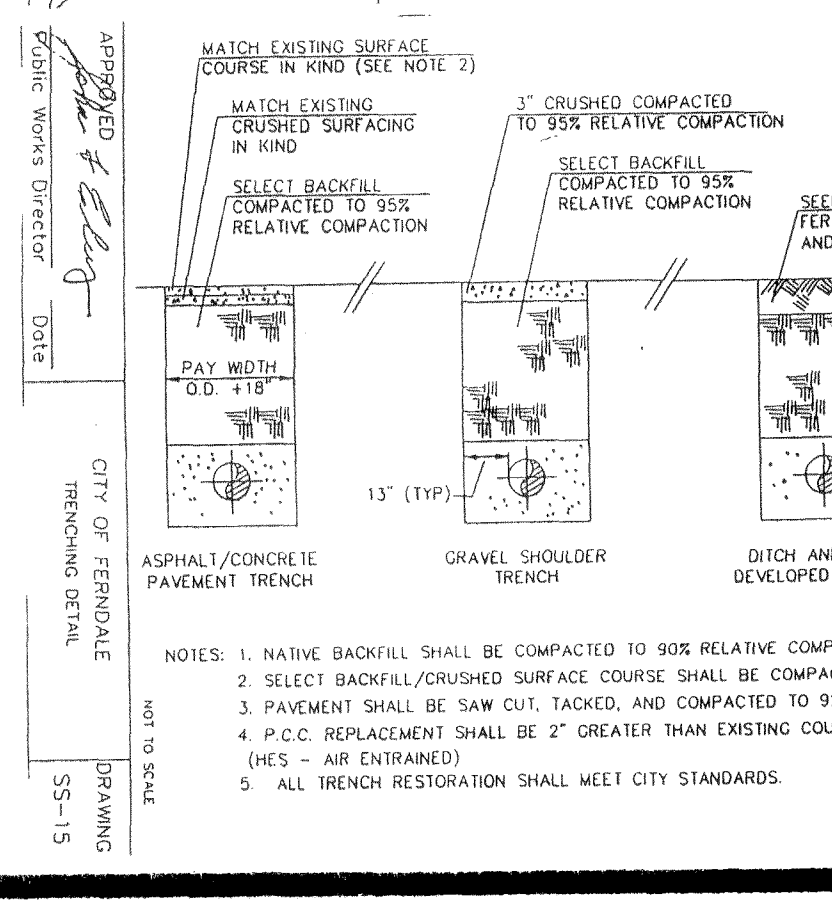


APPROVED: [Signature] CITY OF FERDALE PUBLIC WORKS DIRECTOR DATE: [Blank] DRAWING: SS-15

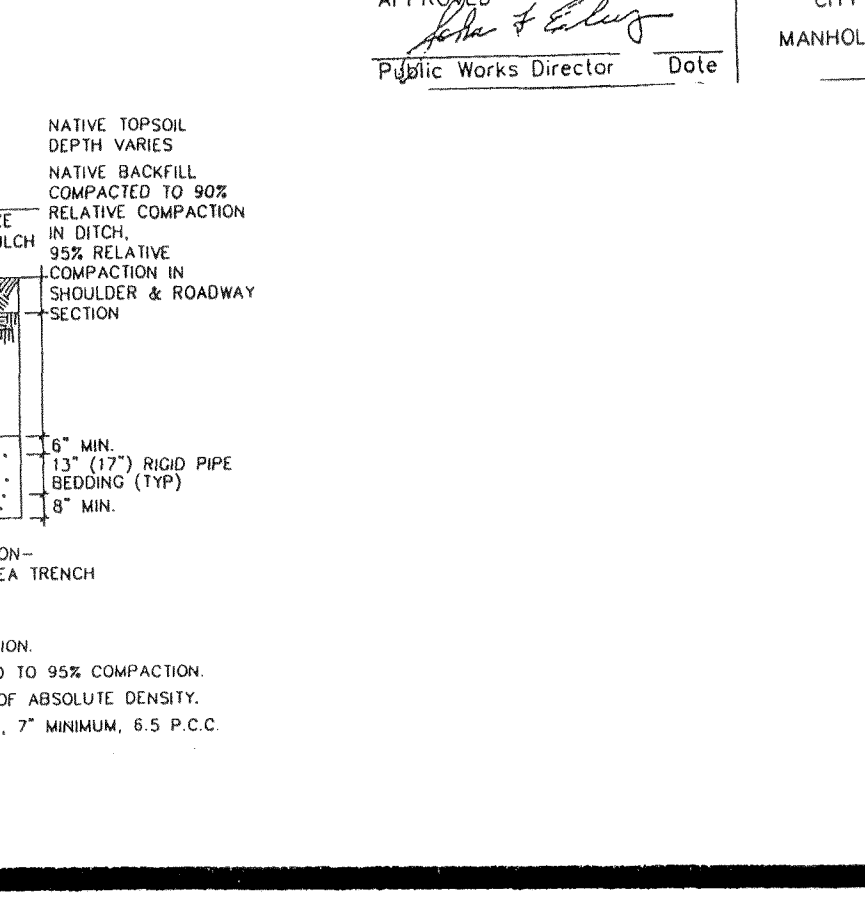


APPROVED: [Signature] CITY OF FERDALE PUBLIC WORKS DIRECTOR DATE: [Blank] DRAWING: SS-15

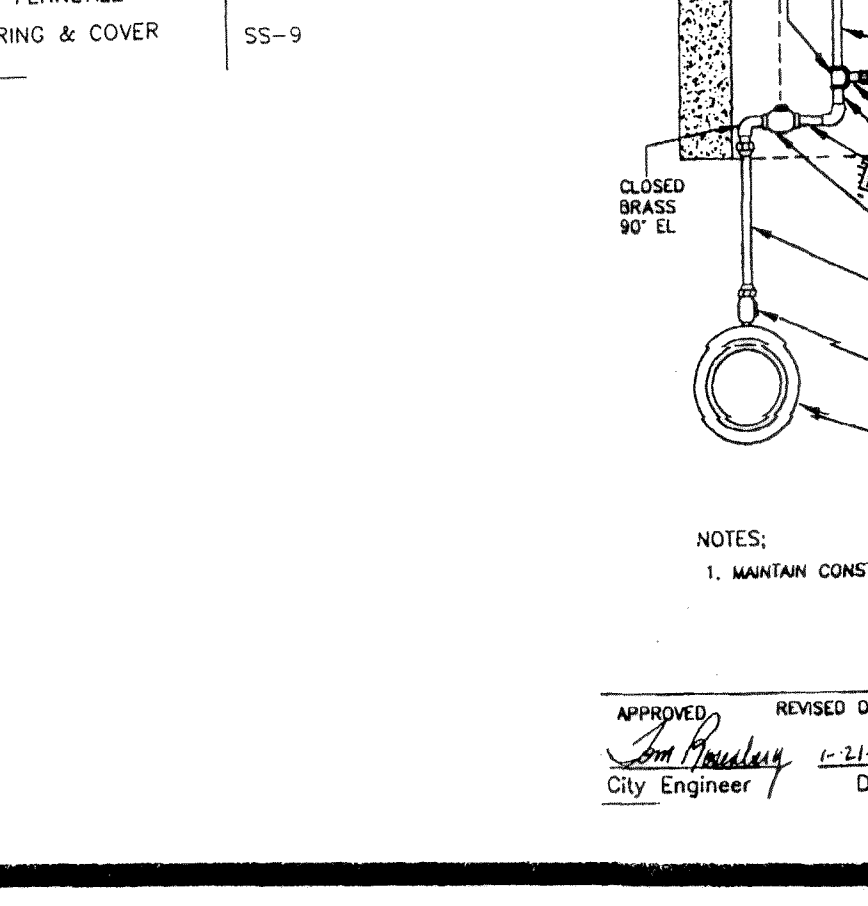


APPROVED: [Signature] CITY OF FERDALE PUBLIC WORKS DIRECTOR DATE: [Blank] DRAWING: SS-15

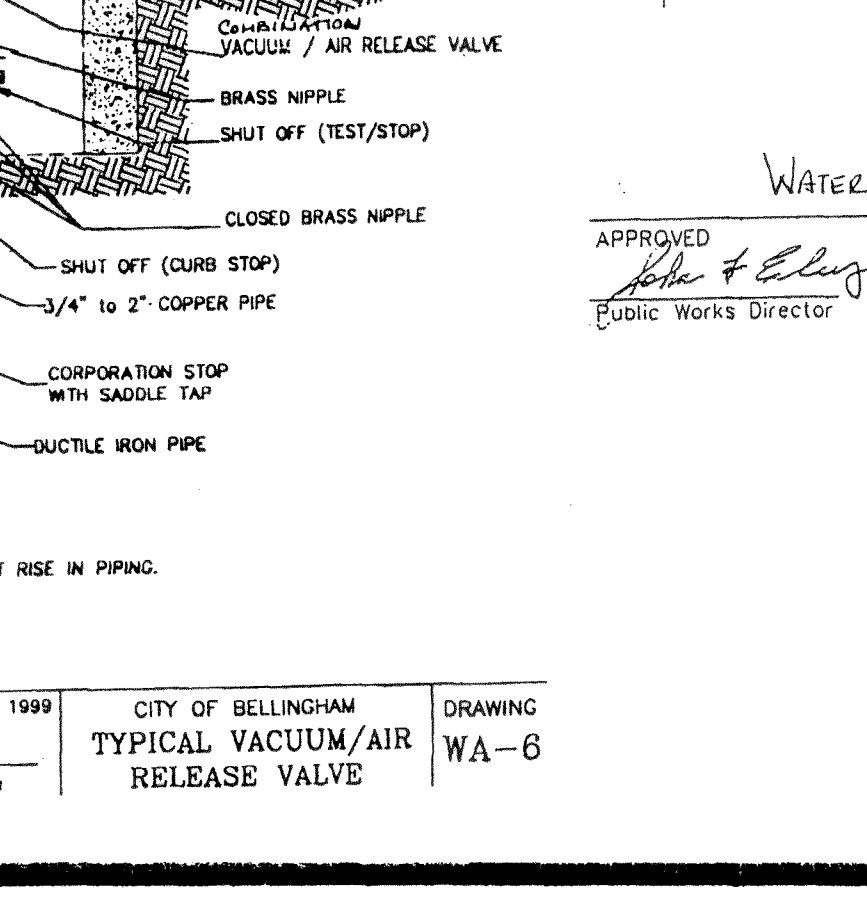


APPROVED: [Signature] CITY OF FERDALE PUBLIC WORKS DIRECTOR DATE: [Blank] DRAWING: SS-15

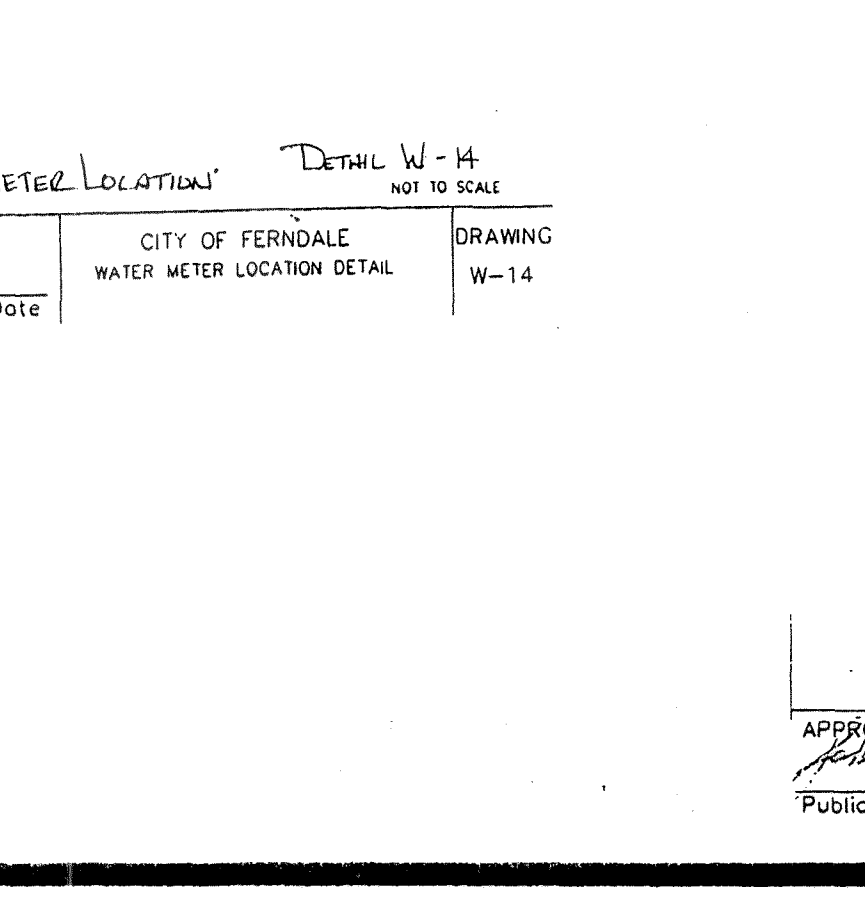


APPROVED: [Signature] CITY OF FERDALE PUBLIC WORKS DIRECTOR DATE: [Blank] DRAWING: SS-15

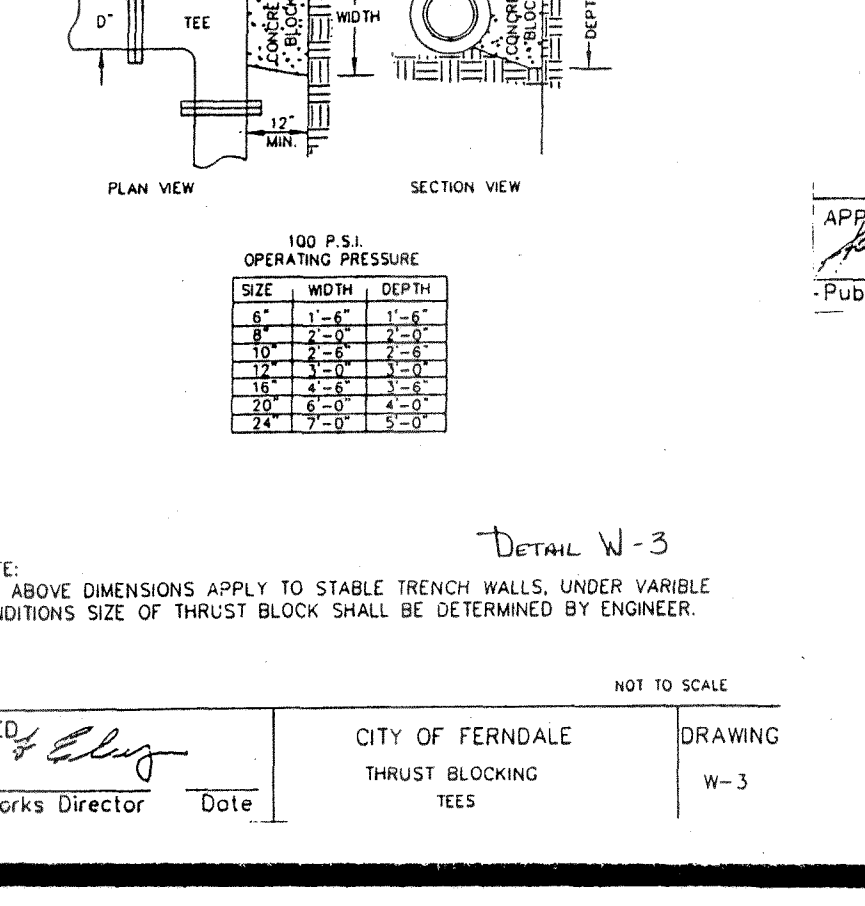

APPROVED: [Signature] CITY OF FERDALE PUBLIC WORKS DIRECTOR DATE: [Blank] DRAWING: SS-15

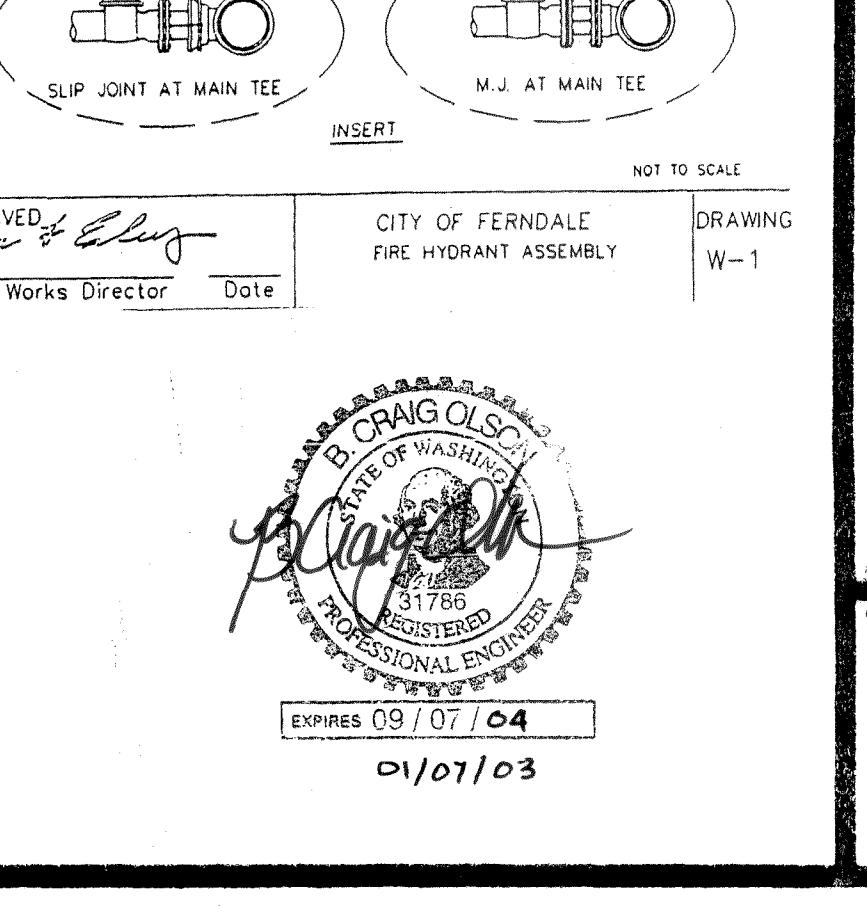

APPROVED: [Signature] CITY OF FERDALE PUBLIC WORKS DIRECTOR DATE: [Blank] DRAWING: SS-15

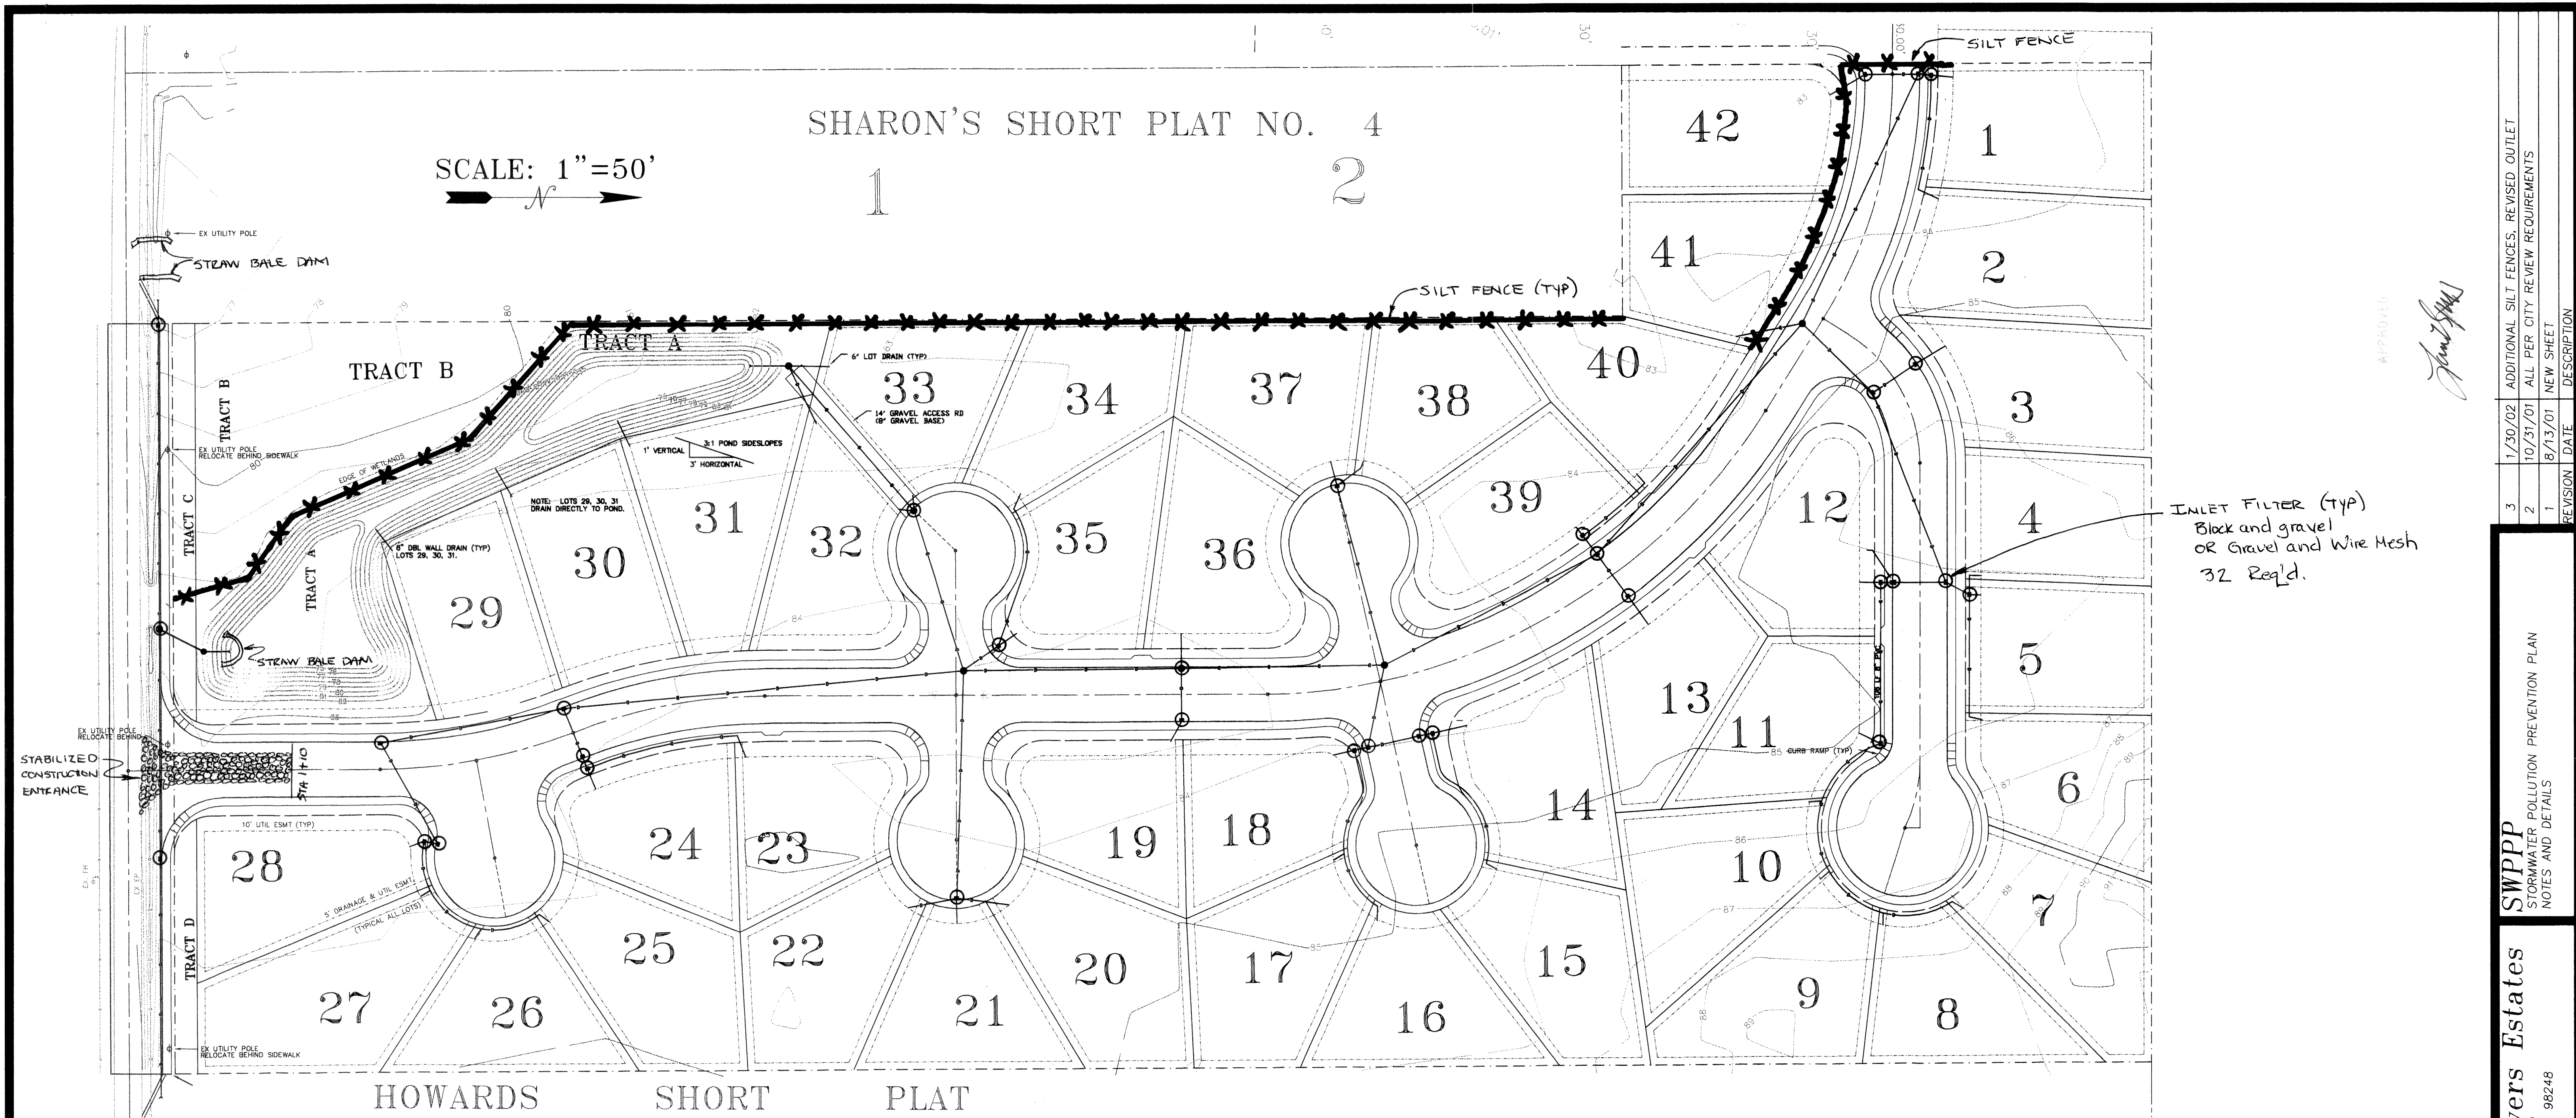

Maintenance

- The entrance shall be maintained in a condition which will prevent tracking or flow of mud onto public rights-of-way. This may require periodic top dressing with 2-inch stone, as conditions demand, and repair and/or cleanout of any structures used to trap sediment. All materials spilled, dropped, washed, or tracked from vehicles onto roadways or into storm drains must be removed immediately.
- All temporary erosion and sediment control measures shall be removed within 30 days after final site stabilization is achieved or after the temporary BMPs are no longer needed. Trapped sediment shall be removed or stabilized on site. Disturbed soil areas resulting from removal shall be permanently stabilized.

STABILIZED CONSTRUCTION ENTRANCE

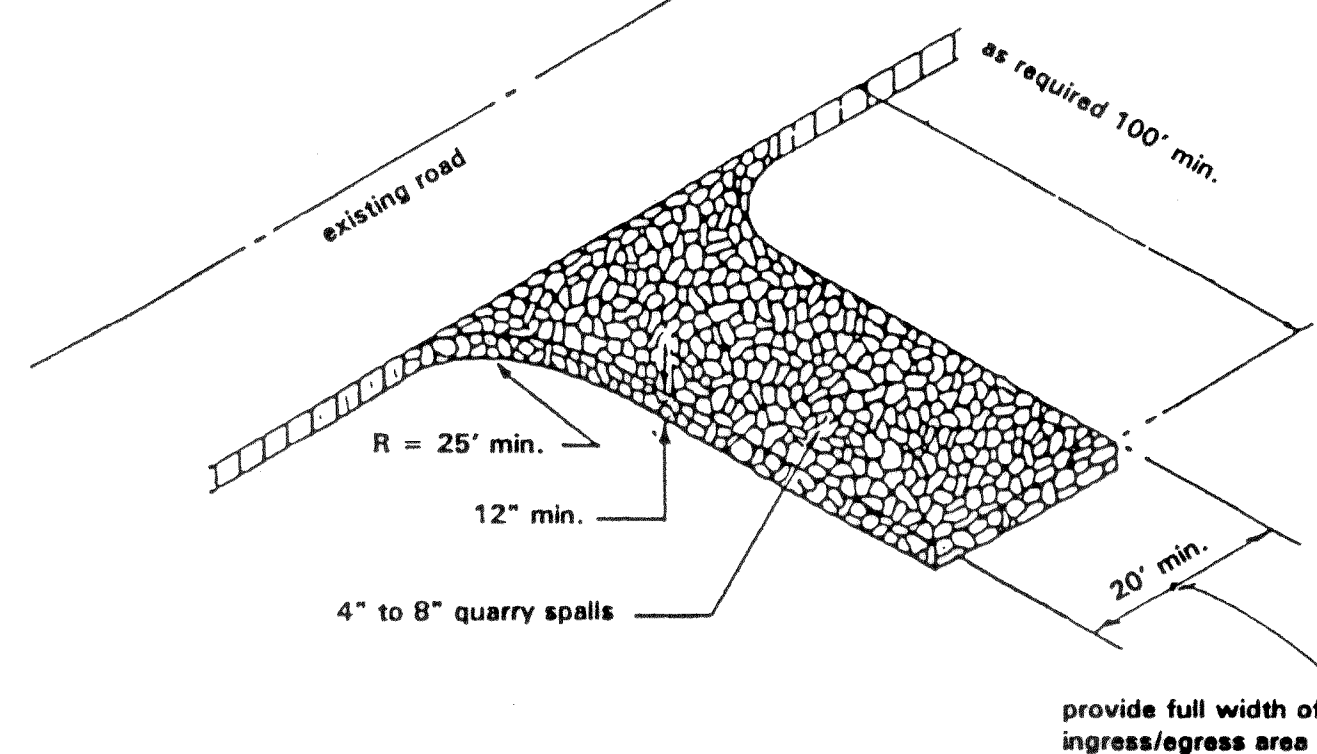


Figure II-5.24 Block and Gravel Filter





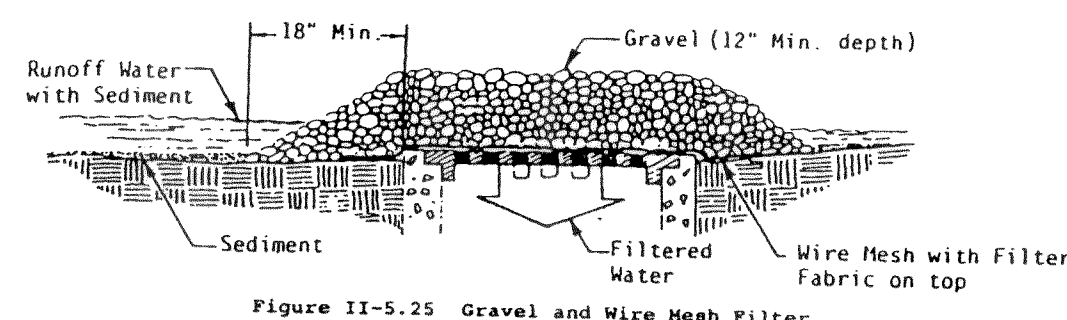


Figure II-5.25 Gravel and Wire Mesh Filter

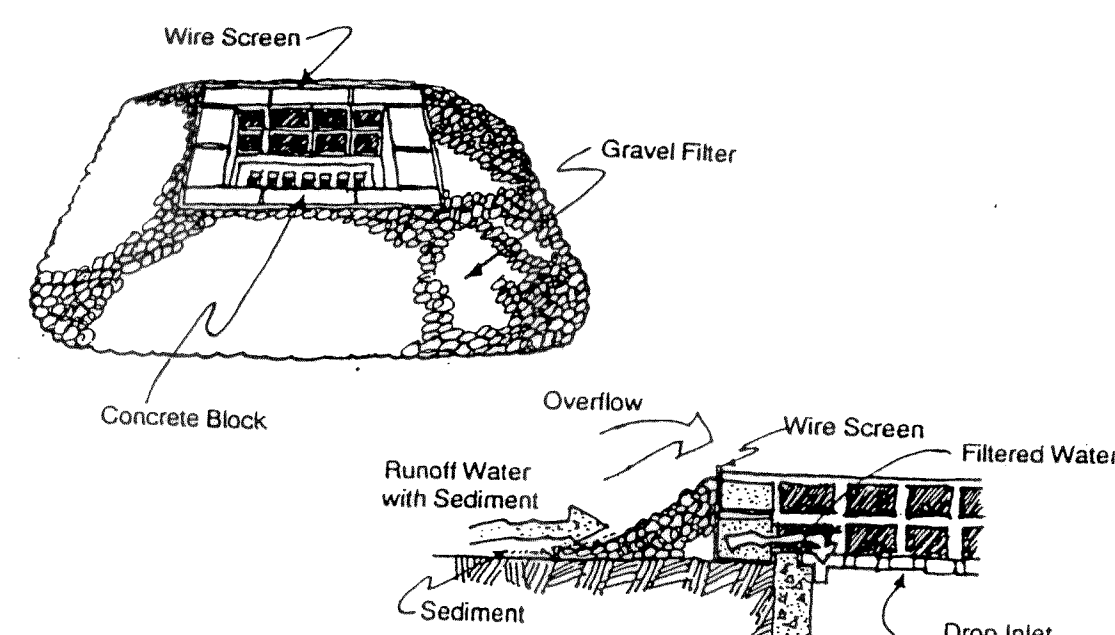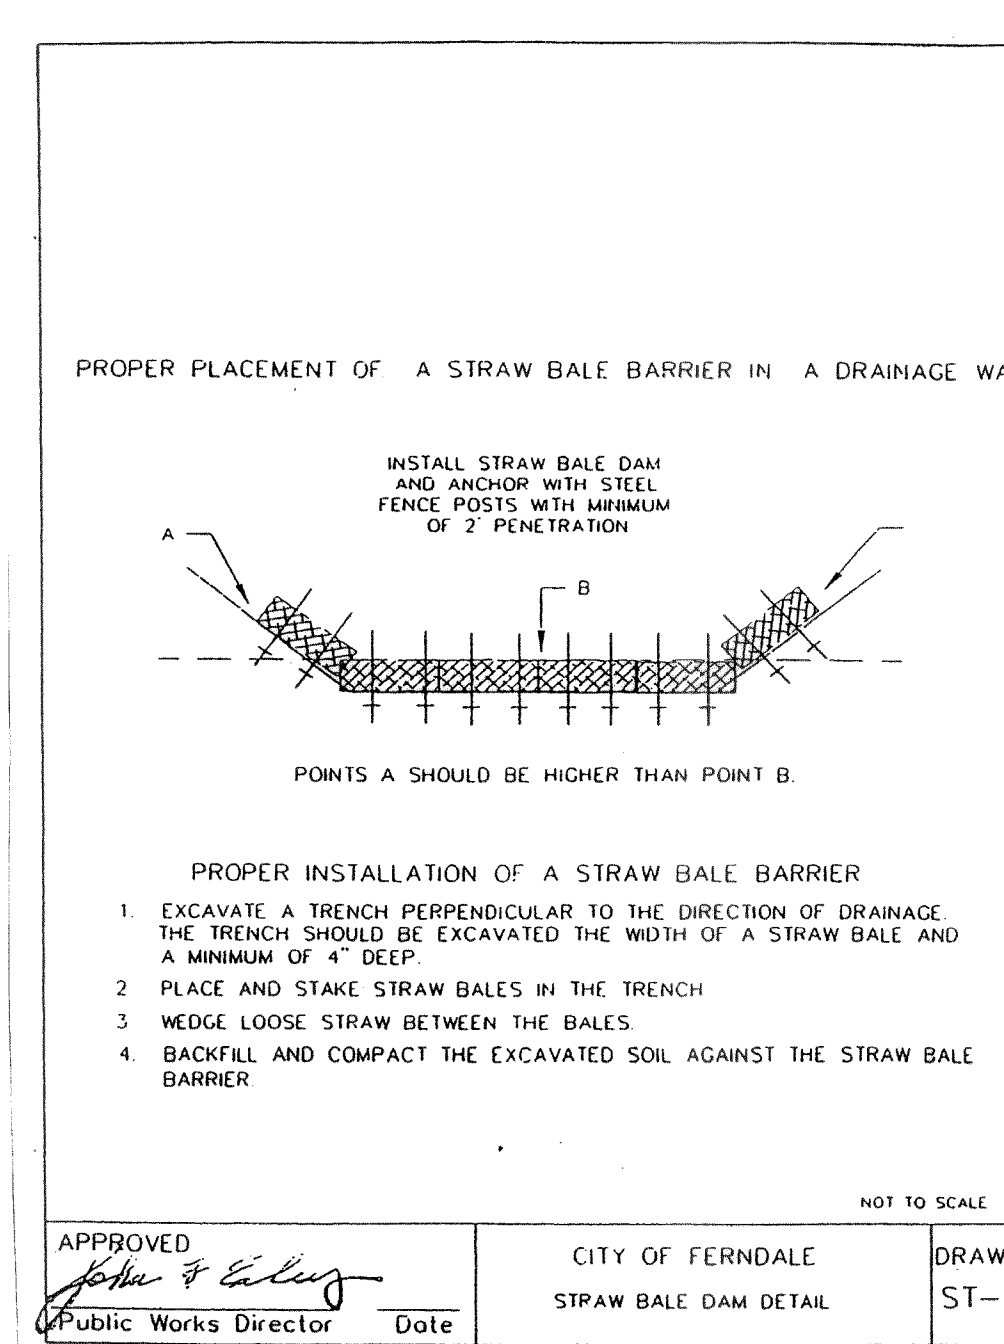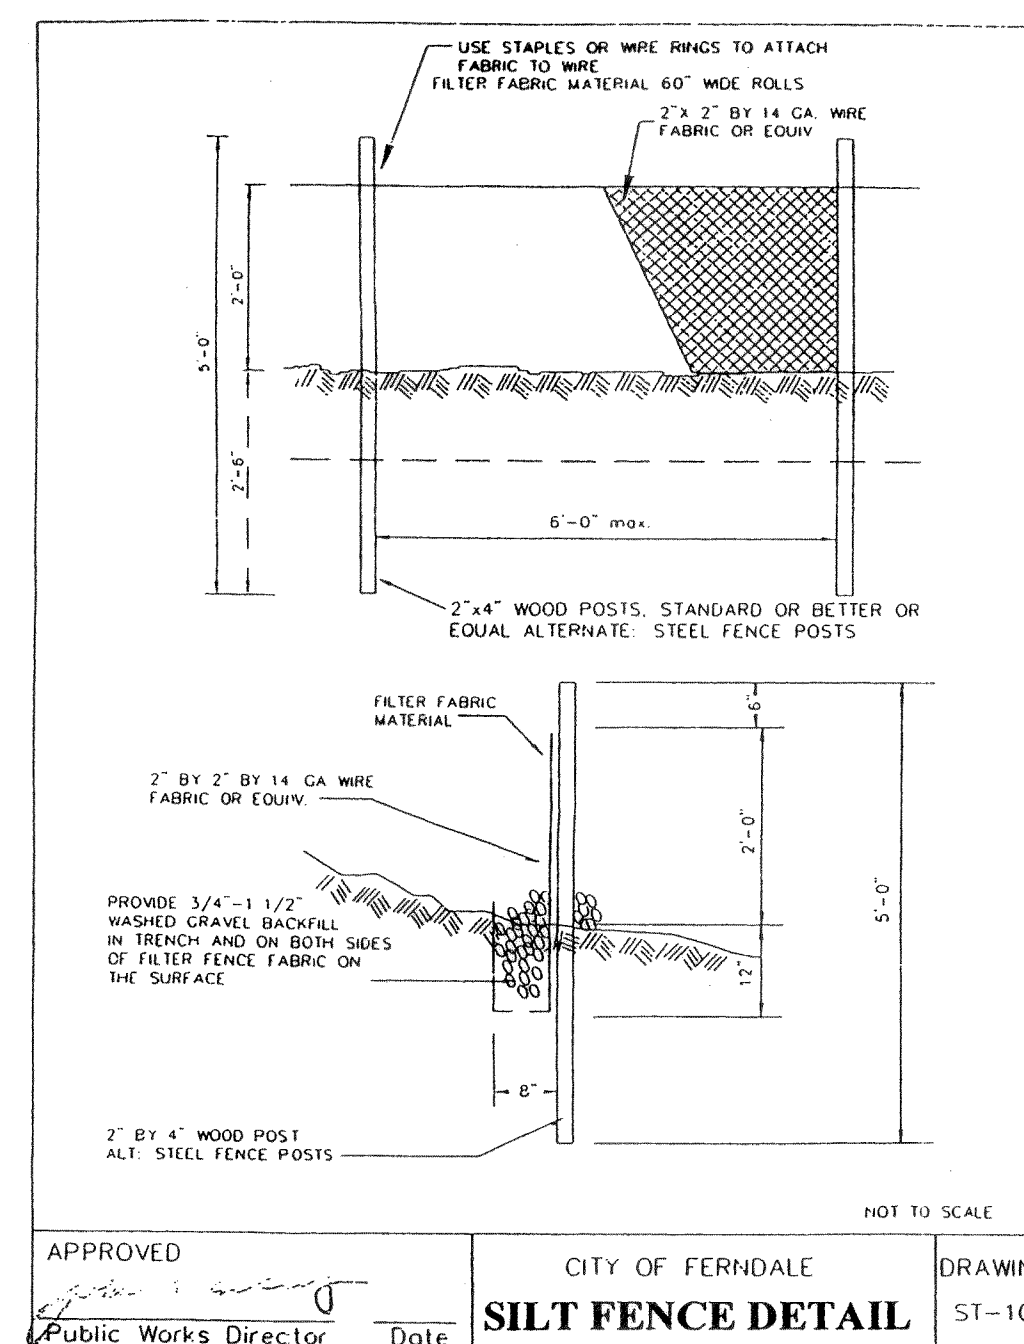









TEMPORARY EROSION / SEDIMENT CONTROL (TESC) NOTES:

- The temporary erosion control system shall be installed prior to all other construction, except for CB inlet filters, which are to be placed immediately after the storm drain is installed.
- Where possible, maintain natural vegetation for silt control.
- As construction progresses and seasonal conditions dictate, the erosion control facilities shall be maintained and / or altered as required by the City or Engineer to insure continuing erosion / sedimentation control by Contractor's ways and means.
- All temporary situation controls shall be maintained in a satisfactory condition until such time that clearing and / or construction is completed, permanent drainage facilities are operational, and the potential for erosion has passed.
- All disturbed land areas subject to erosion as determined by the City that will be left for 30 days or more shall be seeded with a mix and by a method approved by the City of Ferndale and maintained until seed germination is assured.
- The right-of-way shall be kept clean. Tracking of mud and debris from the site will not be allowed. Failure to comply with this condition may result in all work on site being stopped until the condition is remedied. (Also see GENERAL NOTES and Other Notes.)

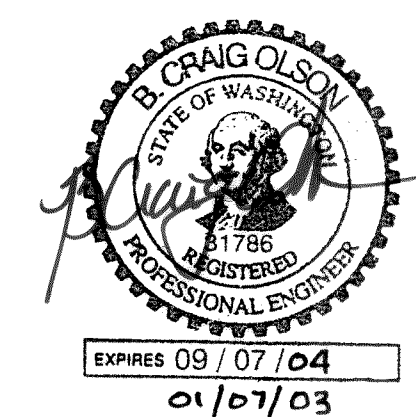

1. All work shall conform with applicable sections of the City of Ferndale Development Standards and with applicable sections of the Department of Ecology Stormwater Management Manual for the Puget Sound Basin, current edition, and with applicable sections of WSDOT Standard Plans and Standard Specifications.. Construction of Biofilter Swale shall conform with Section 1005 of the City of Ferndale Development Standards and with the Biofilter Swale information provided on this plan and shown in the Drainage Report.
2. **IMPORTANT:** Surface drainage on site is dependent upon accurate grading and paving. Subsurface drainage, including pipes and other structures, is dependent upon accurate elevation and placement of said facilities. Contractor shall utilize the services of a competent surveyor to assure proper installation of all drainage facilities.
3. Drainage structures, culverts, and conduits shall meet requirements set forth in APWA 9-05.
4. Rip-Rap shall conform to APWA Section 9-13.
5. PVC pipe shall be Polyvinyl Chloride Pipe conforming to the provisions of ASTM D 3034 SDR 35, and AASHTO M 278.
6. Perforated PVC pipe, if required, shall be Polyvinyl Chloride Pipe conforming to the provisions of ASTM D 3034 SDR 35, and AASHTO M 278.
7. CPP Pipe shall be smooth interior (N-12 type) Corrugated Polyethylene Pipe conforming to requirements set forth in AASHTO M 294.
8. All connections related to lot drainage services shall be made using factory-built components, including all Tees, Elbows and related appurtenances. No "cut-in" connections and no site-built fittings shall be allowed.

(Also see GENERAL NOTES and Other Notes.)

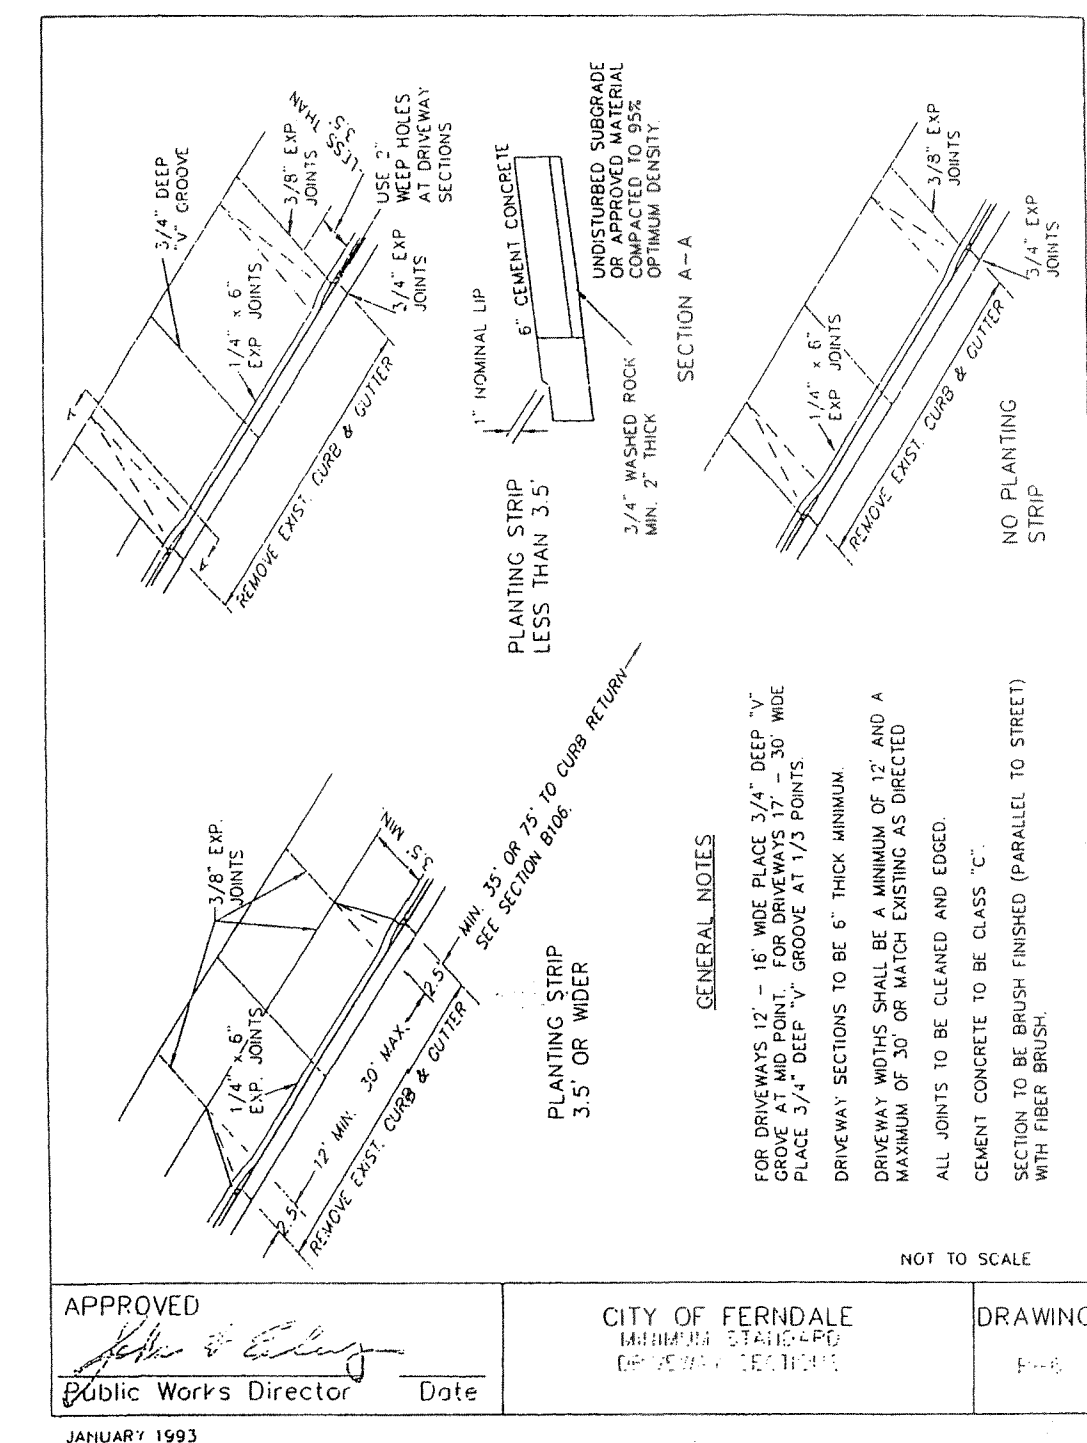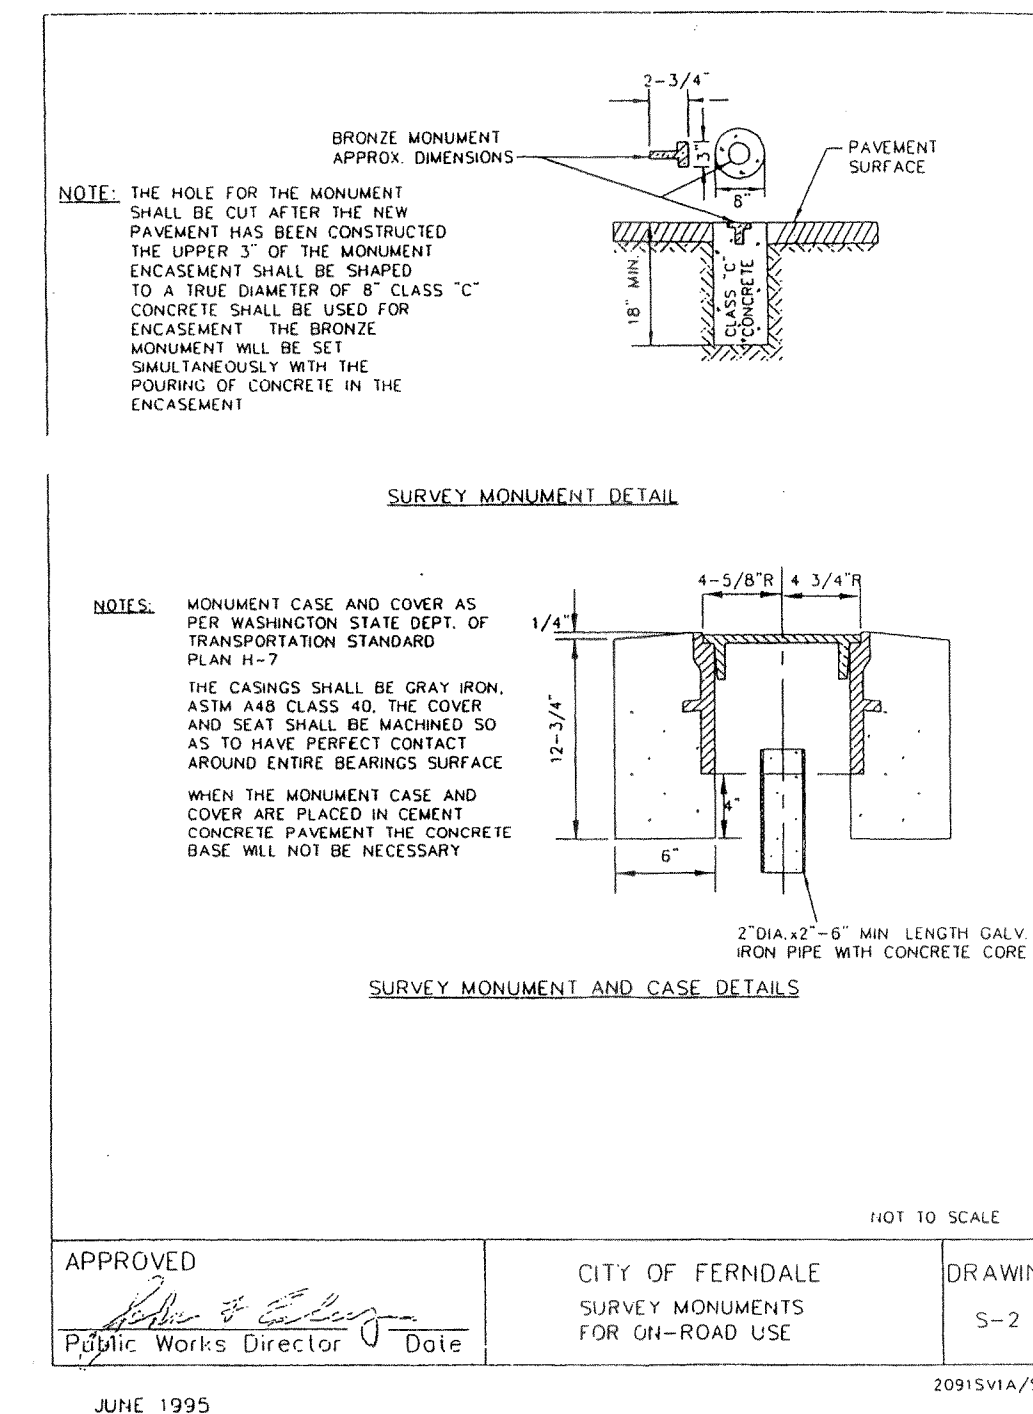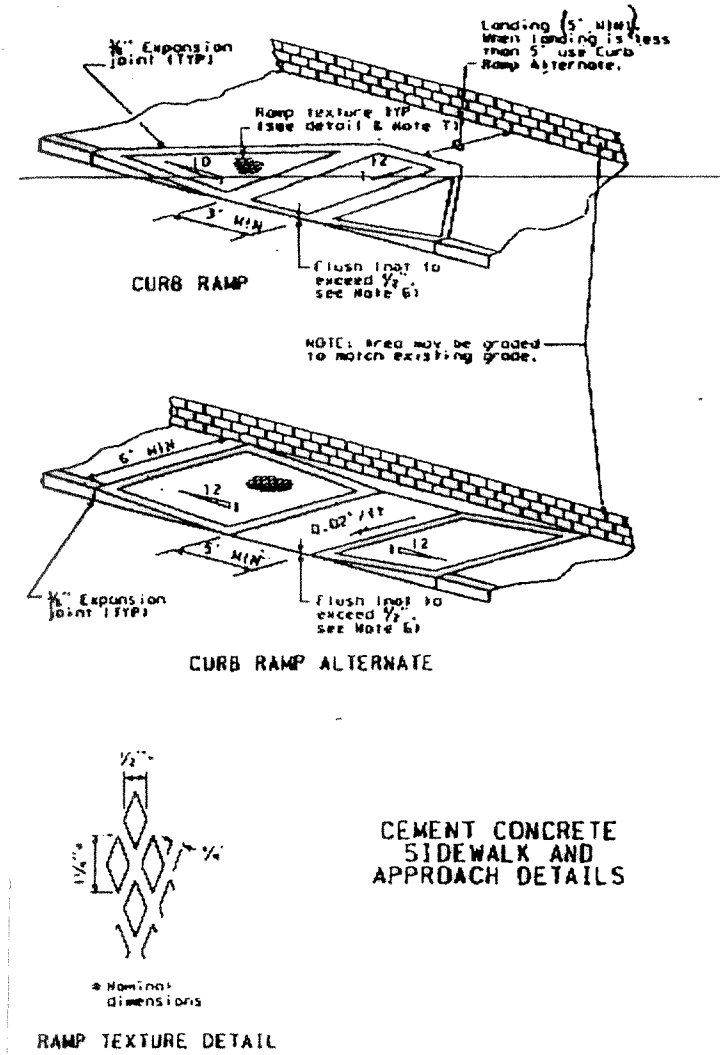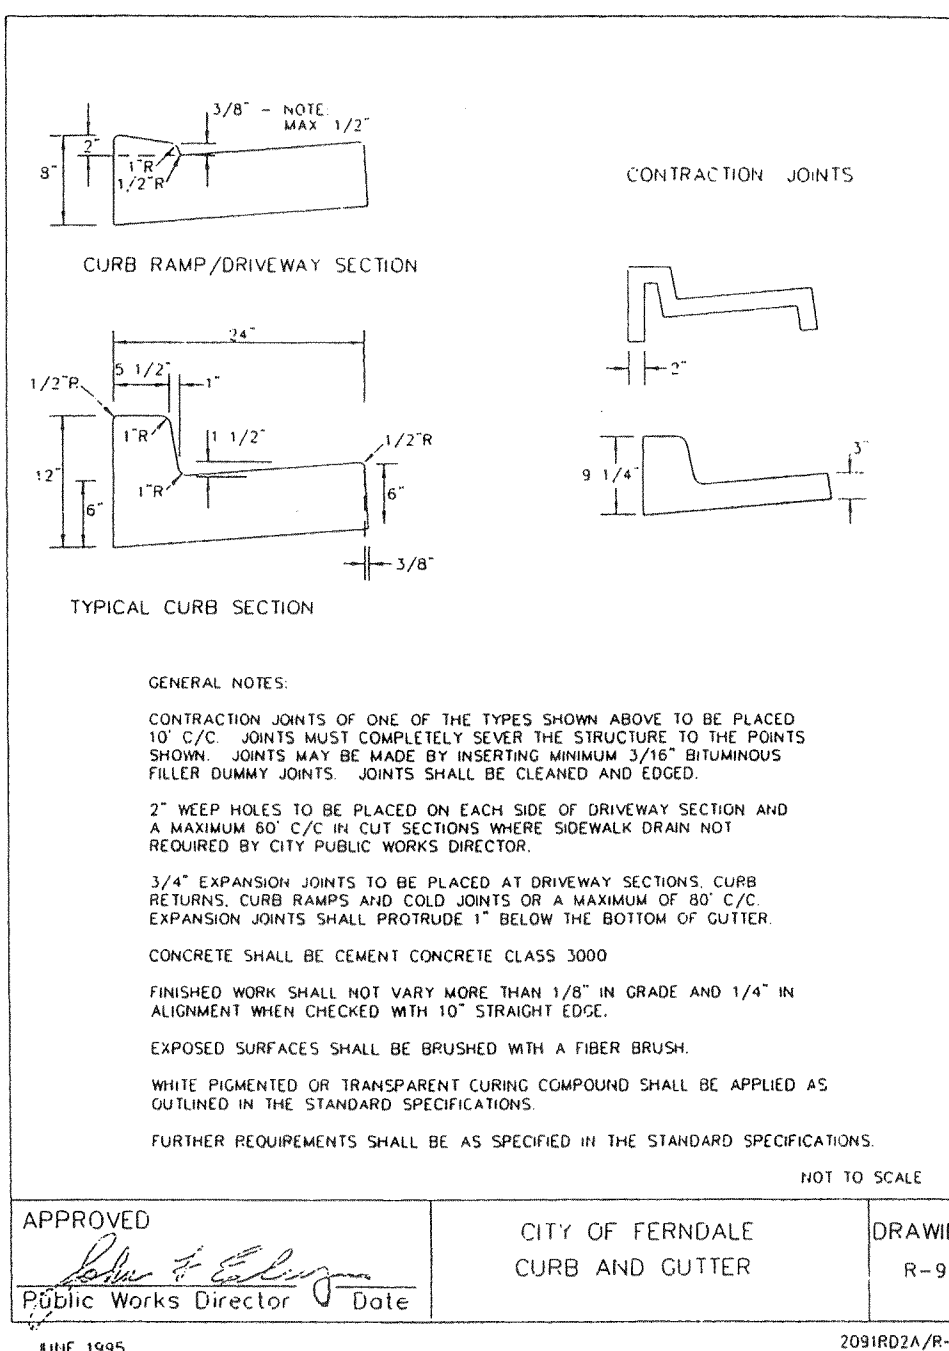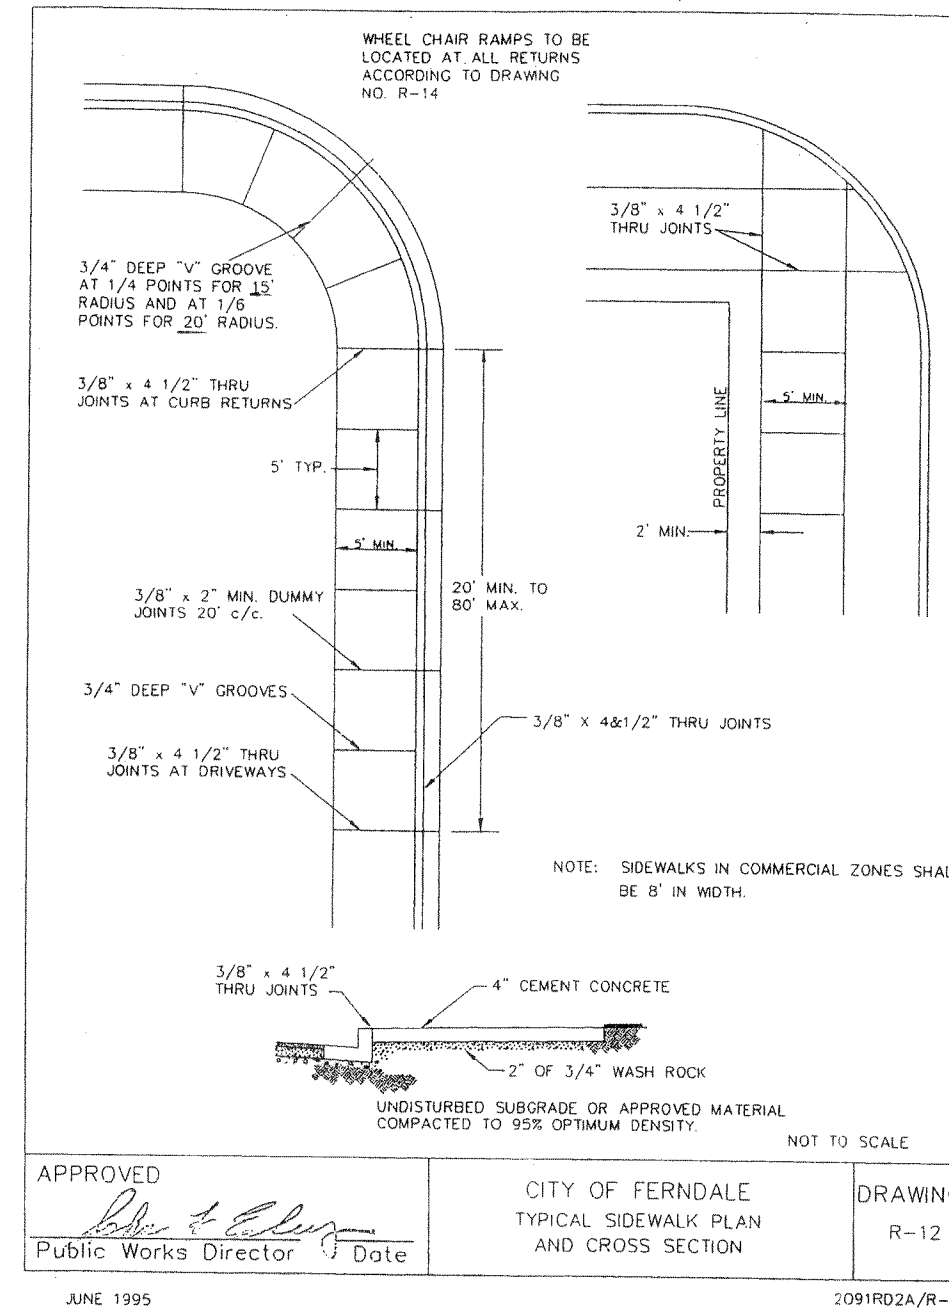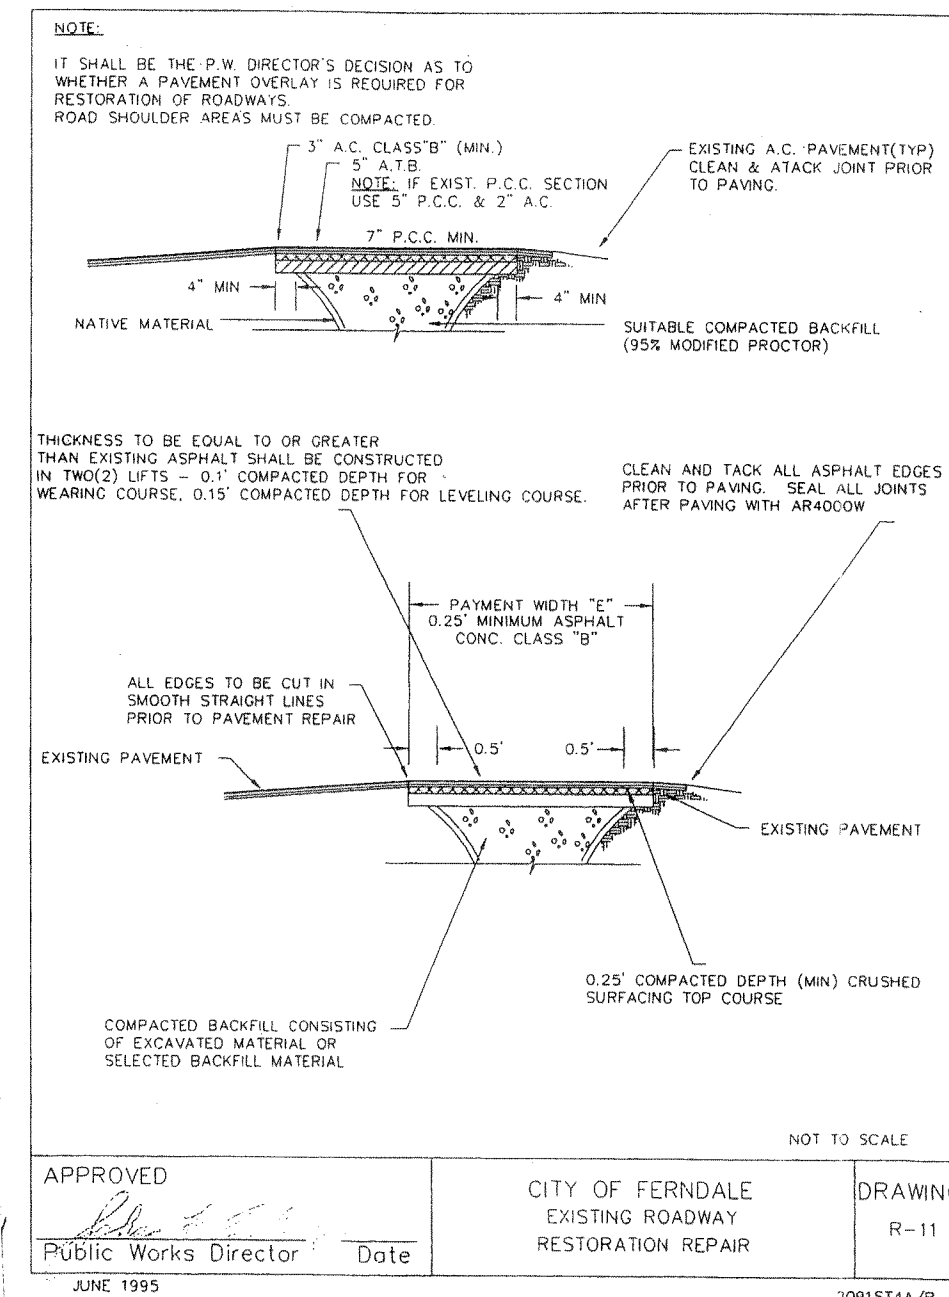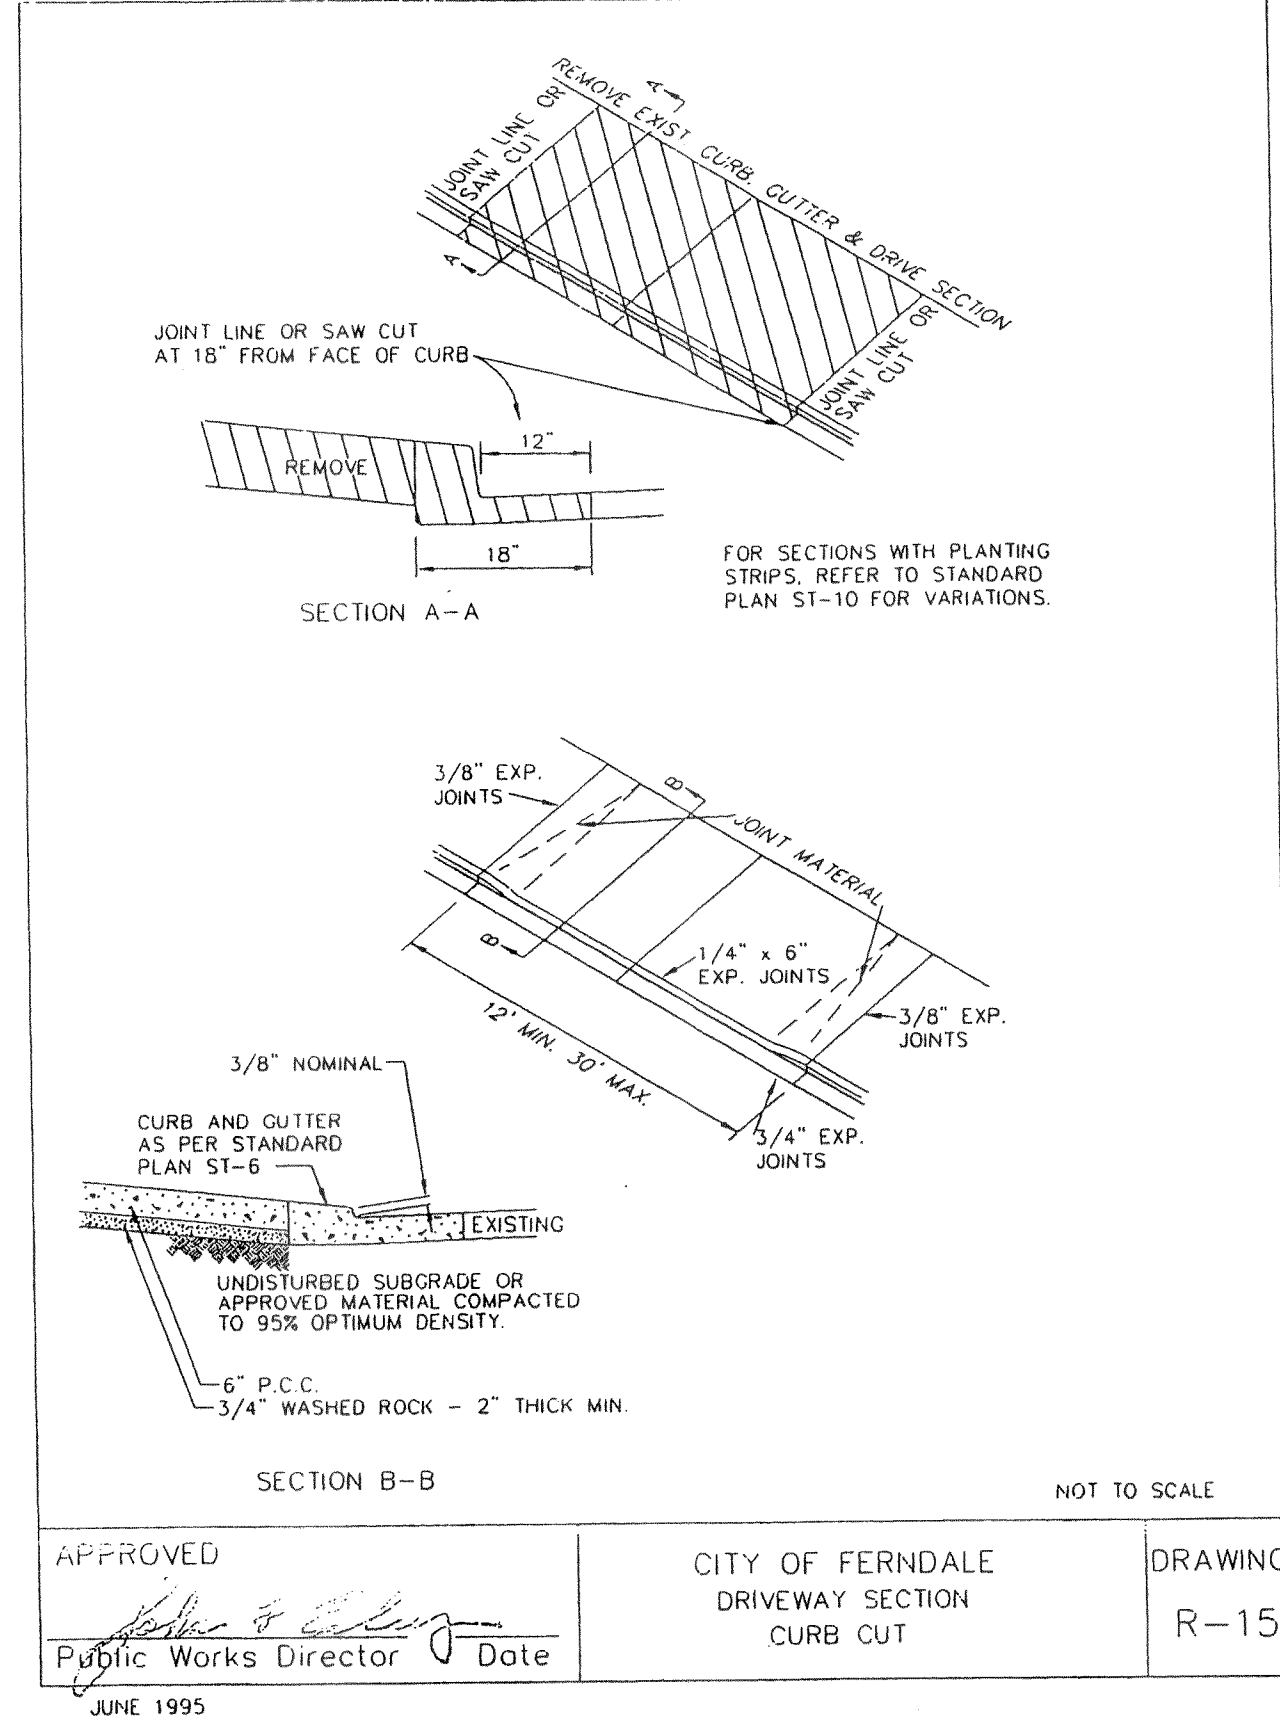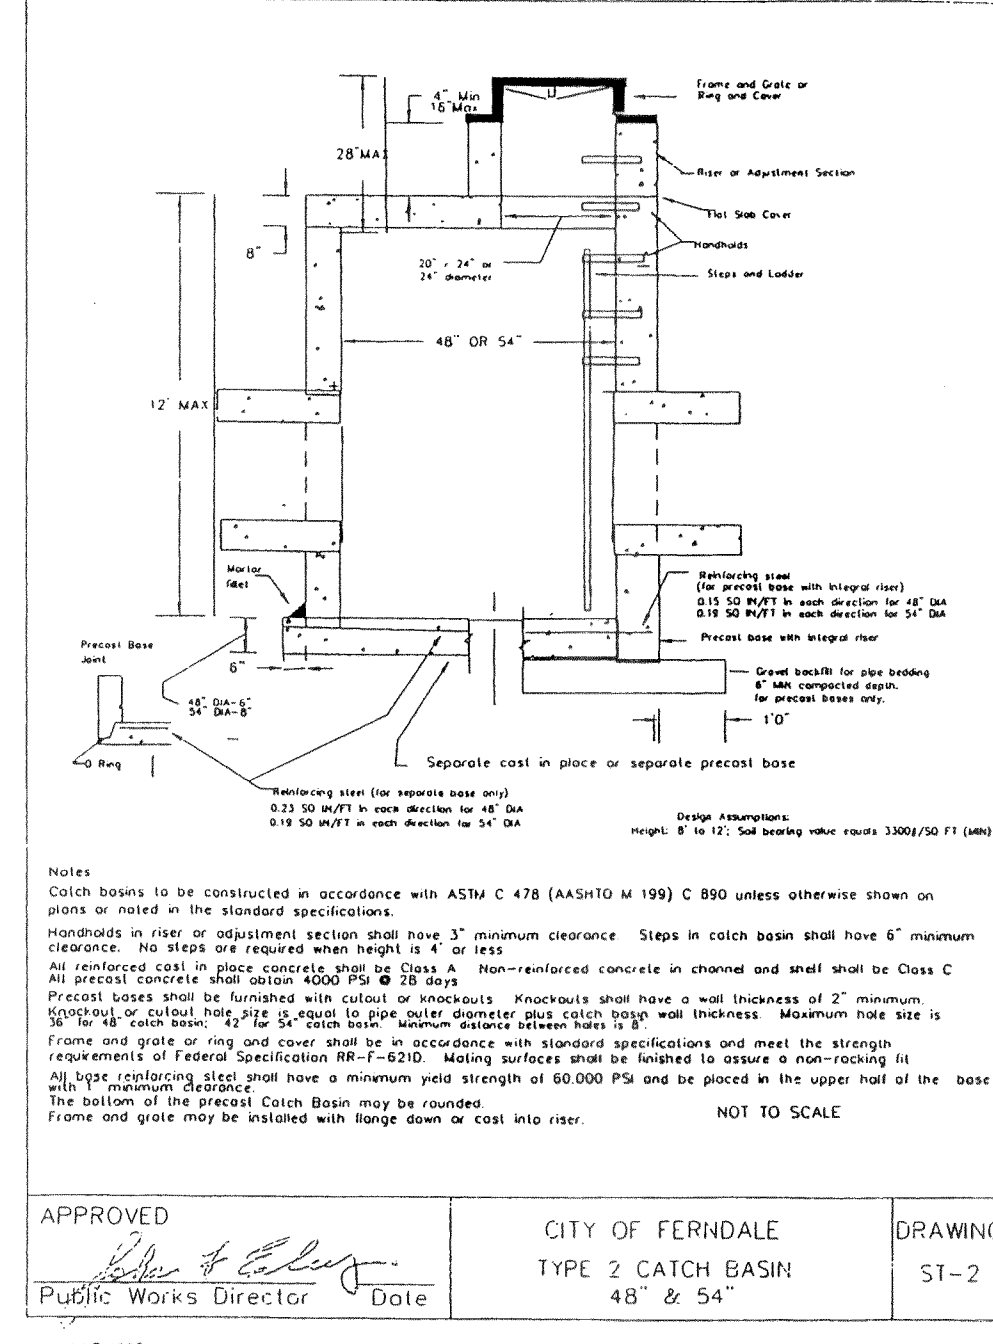

1. **CLEARING AND GRUBBING:** All objectionable growth shall be stripped. Removal of trees, shrubs, and other organic material shall include the removal of stumps and roots to the extent that no root greater than 3 inches in diameter remains within 5 feet of an underground structure or utility line nor under footings or paved areas. Grubbing in open areas shall include removal of stumps and 3 inch roots to 2 feet below finish grade elevations.
2. **SUBGRADE PREPARATION:** All organic materials including, but not limited to, top soil, grass, and plant debris which is located in an area to be covered with concrete or asphalt or gravel shall be removed prior to placement of any other materials. Stripped material shall be disposed of at a location arranged by the Contractor. Subgrade shall be firm, unyielding soil free from organic materials. If additional excavation is required to remove undesirable subgrade materials, said excavation shall be done by the Contractor at no additional expense to the Owner.
3. Contractor shall fully grade the site to serve the final grades and typical sections shown on the plans.
4. Material placed under proposed building locations, in road right-of-ways, or under concrete or asphaltic concrete surfaces shall be placed in maximum eight inch lifts, loose thickness, and compacted per GENERAL NOTE No. 12.
5. Gravel ballast shall conform with APWA section 9-03.9(1).
6. Gravel base shall conform with APWA section 9-03.10, minimum eight inch depth, with maximum stone size of 5 inches in diameter, compacted to 95% ASTM D1559.
7. Crushed Surfacing Top course (CSTC), if required, shall conform with APWA section 9-03.9(3), minimum three inch depth, compacted to 95% ASTM D1559.
8. Asphaltic Concrete materials and installation shall conform with applicable sections of APWA section 5-04 and with the city of Ferndale Drawing R-4 as modified here-in.
9. All depths shown or referenced are fully compacted.

(Also see GENERAL NOTES, and Other NOTES.)

