


SHIELDS ESTATES

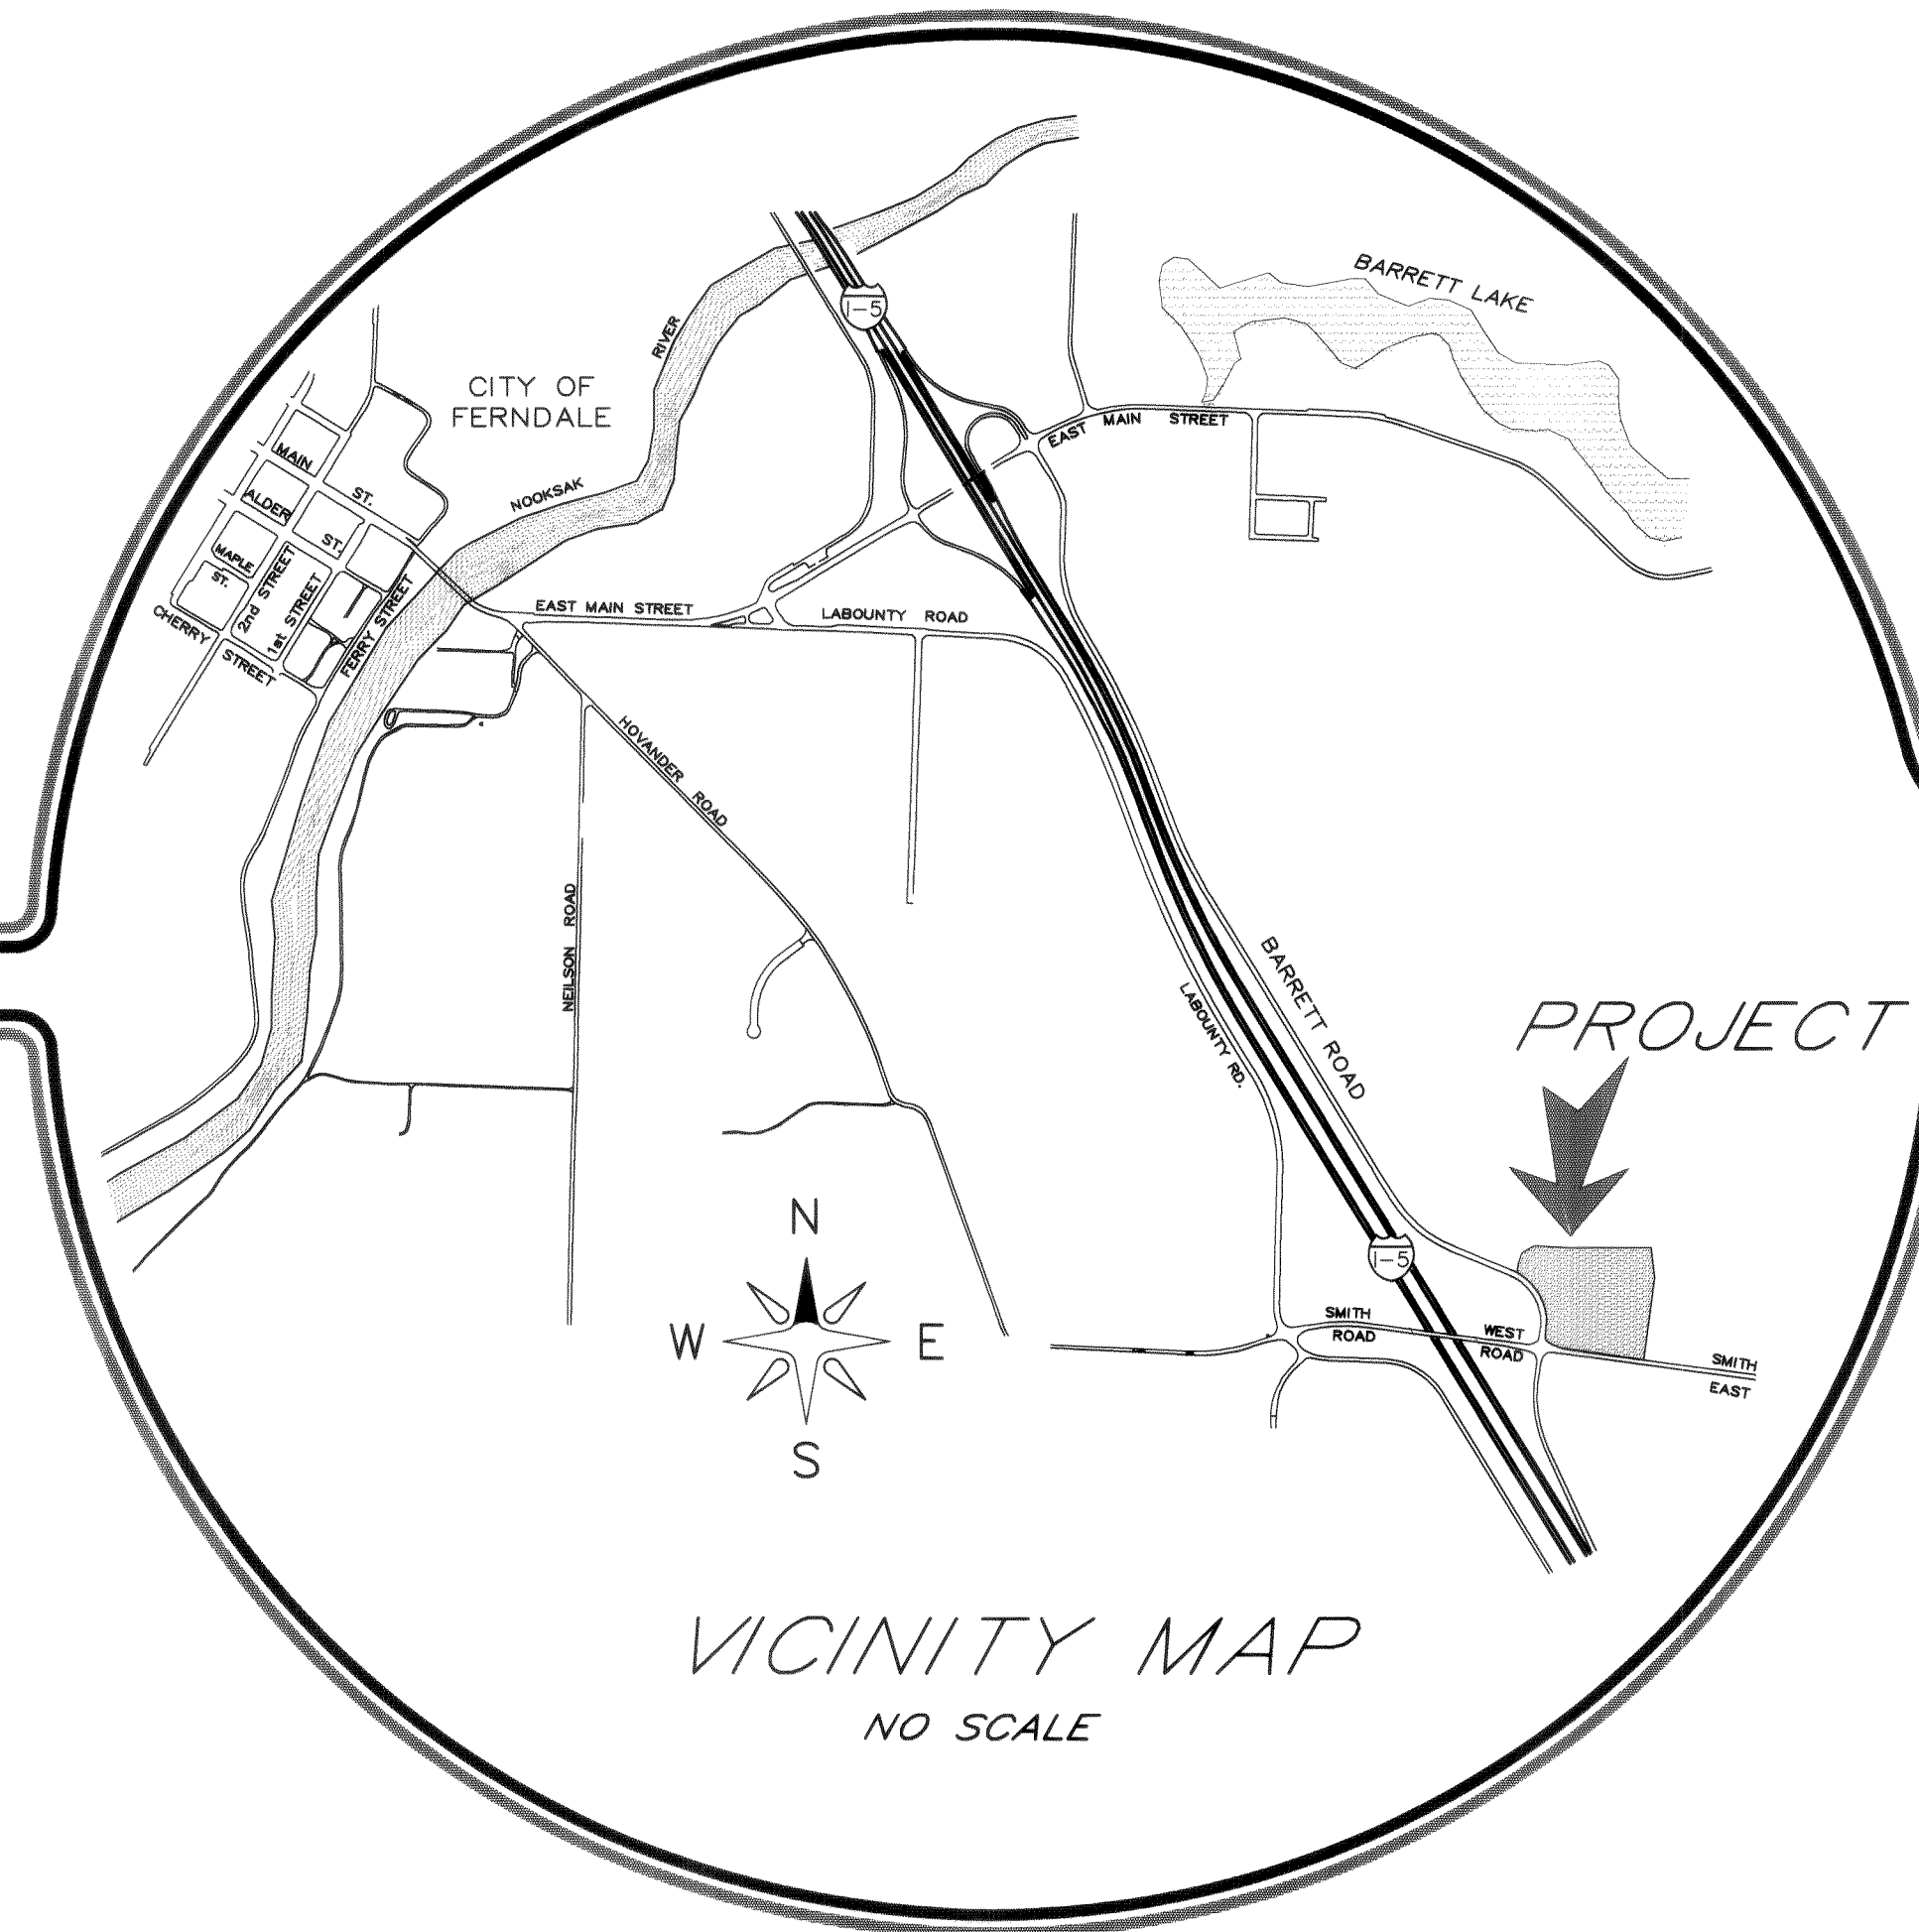

AS-BUILTS DRAWINGS DESIGN & CONSTRUCTION DRAWINGS

1. Cover Sheet & Vicinity Map
2. Existing Conditions: Site Topography / Wetlands / Boundary
3. Existing Conditions: Soils / Geotechnical
4. Existing Conditions: Pre-Development Hydrology
5. Existing Conditions: Pre-Development Hydrology
6. Subdivision Plan
7. Erosion / Sedimentation Control Plan
8. Grading Plan
9. Street Plan & Profile: Shields Road & W. Smith Road Widening
10. Street Plan & Profile: East & West Rainier Court
11. Street Plan & Profile: St. Helens Lane / Adams Ct / Barrett Rd Widening
12. Pavement Design
13. Construction Details
14. Storm Plan & Profile: Shields Road (South)
15. Storm Plan & Profile: E. & N. Rainier Court / Shields Rd (North)
16. Storm Plan & Profile: 100 Yr. Conveyance Ditch
17. Storm Plan & Profile: St. Helens Lane / Adams Court / Pond
18. Post-Development Hydrology
- 18A. Post-Development Hydrology
19. Storm Drainage Hydraulics
- 19A. Water Quality & Detention Calculations
20. Detention Pond Geometry & Details
21. Watermain Plan & Profile: Shields Road
22. Watermain Plan & Profile: Rainier Court
23. Watermain Plan & Profile: St. Helens Lane / Adams Court
24. Sanitary Sewer Plan & Profile: Shields Road
25. Sanitary Sewer Plan & Profile: Rainier Court
26. Sanitary Sewer Plan & Profile: St. Helens / Adams Court
27. Curb Warping: Smith Rd. / Shields Rd / E. & W. Rainier Cul-De-Sacs
28. Curb Warping: Shields Rd. / Rainier Ct / Shields & St. Helens
29. Curb Warping: St. Helens & Barrett Rd / Adams Ct & St. Helens Ln.
30. Landscaping & Street Lighting Plan
- 30A. Signage & Channelization Plan
31. Private Common Utility Trenching Plan
32. Composite Utility / Conflict Resolution Plan: St. Helens Ln.
33. Composite Utility / Conflict Resolution Plan: Rainier Court West & East / Shields
34. Schedule of Materials & Quantities, Summary Specifications & Method of Payment
35. Schedule of Materials & Quantities, Summary Specifications & Method of Payment

DRAWN BY DATE

CHECKED BY DATE

SHIELDS ESTATES

JOB # 97015


FOR:

TEITGE, WILLIAMS & McCOLLUM INVESTMENTS, INC.

PROFESSIONAL CERTIFICATION
I HEREBY CERTIFY THAT THIS PLAN ACCURATELY
DEPicts THE MATERIALS, TYPES, AND LOCATIONS
OF THE IMPROVEMENTS SHOWN HEREON AS OF
THIS DATE.

Harry P. Jones
HARRY P. JONES, P.E.

1/15/98
DATE

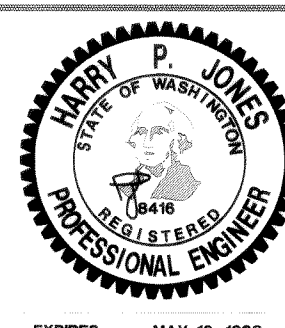

JONES ENGINEERS
INCORPORATED, P.S.

CONSULTING ENGINEERS

851 COHO WAY, SUITE 307
BELLINGHAM, WA 98225 (206) 733-8888

SHIELDS ESTATES
COVER SHEET & VICINITY MAP

DEPARTMENT OF PUBLIC WORKS

FERNDAL
WASHINGTON

APPROVED

This plan has been reviewed and found
to be in conformance with department
standards.



CITY ENGINEER John F. Eley DATE 7-7-97

SHEET

1

OF 35

JOB NO. 97015

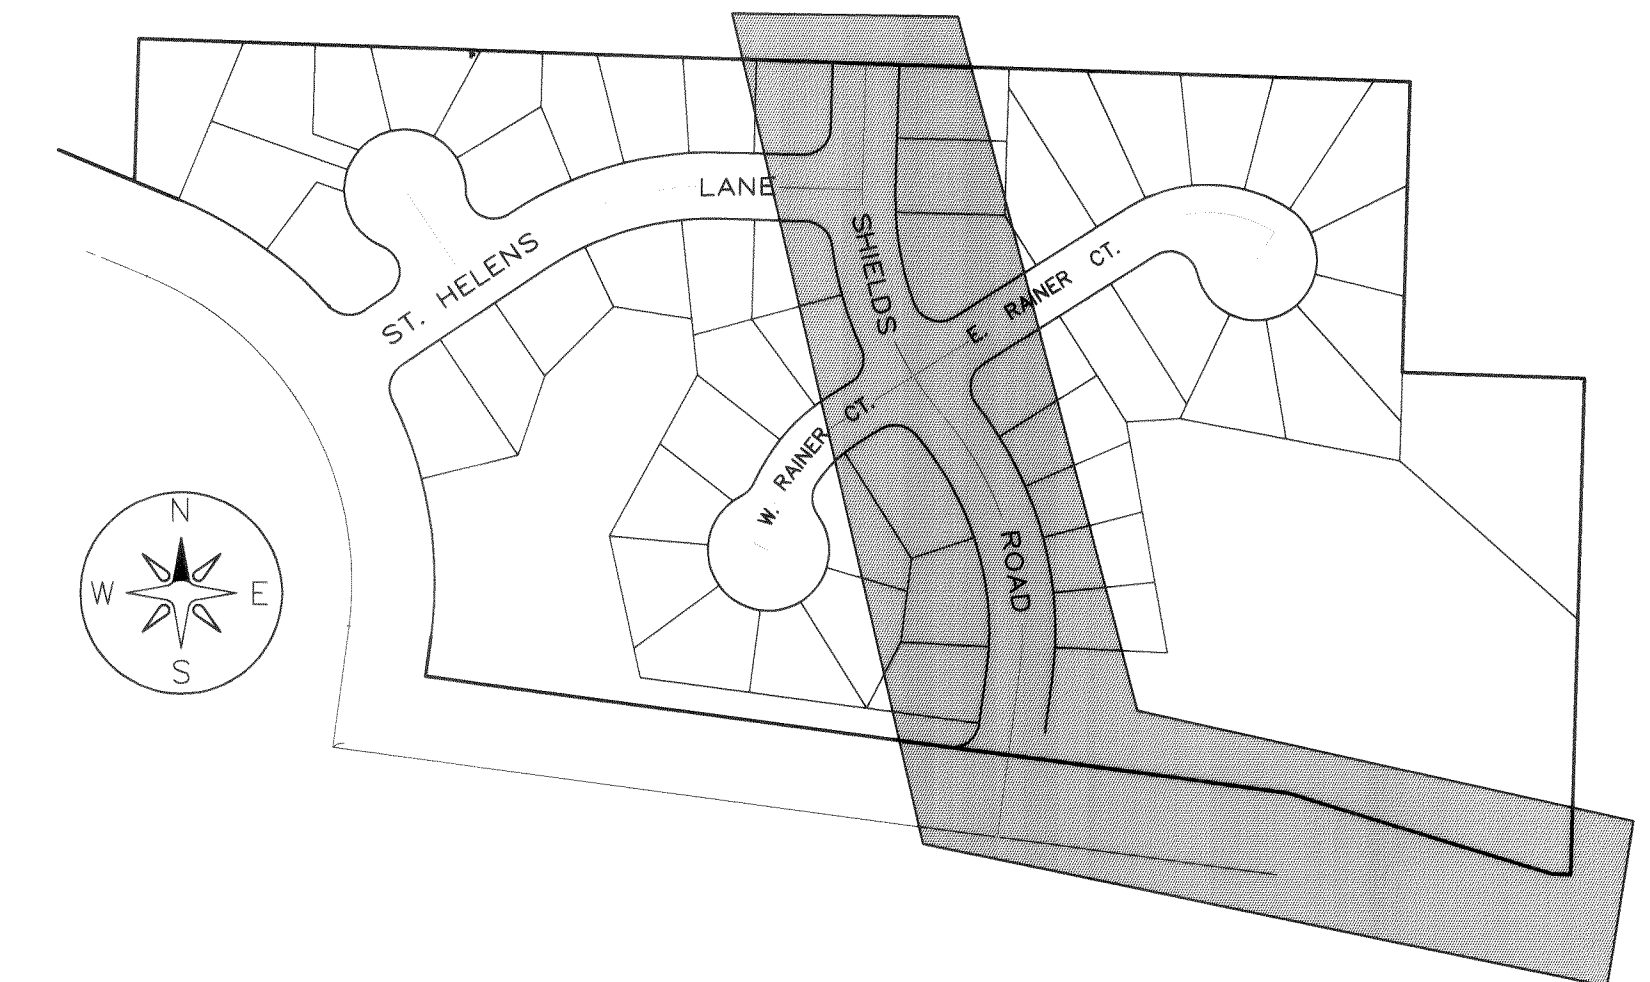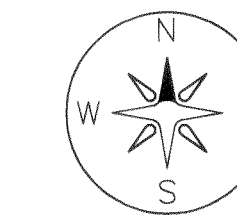

REVISIONS			
NO	DATE	BY	NOTE
1.	6-17-97	A.K.	REVISE PER AGENCY REVIEW
2.			
3.			
4.			
5.			



HORIZONTAL: NAD83(91) WASHINGTON STATE LAMBERT GRID, NORTH ZONE
POSITION: CASED MONUMENT (F-10), SOUTHEAST CORNER SEC. 28, T39N, R2E, W.M.
Y: 673,433.53
X: 1,226,474.60
MERIDIAN: SOUTH LINE OF THE SOUTHEAST QUARTER OF SECTION 28, N88°22'49"W
VERTICAL: NGVD 1929, RAILROAD SPIKE #3, POINT 1050 NORTH OF SMITH ROAD ON THE FRONTAGE ROAD EAST OF I-5
ELEVATION = 81.03

1. PROVIDE ACCESS TO PROPOSED SHIELDS ESTATES
2. PROVIDE INTERNAL CIRCULATION TO THE PROPOSED SHIELDS ESTATES
3. PROVIDE RESIDENTIAL ACCESS

FUNCTIONAL CLASSIFICATION:	LOCAL ACCESS	MIN. C/L RADIUS CURVES:	300 FEET
PROPOSED ACCESS:	W. SMITH RD. / BARRETT RD.	MIN. RADIUS CURB RETURNS:	25 FT
AVERAGE WEEKDAY TRAFFIC:	1090 VPD	SPLIT HORIZONTAL ALIGNMENT:	NO
DESIGN SPEED:	25 MPH	SPLIT VERTICAL ALIGNMENT:	NO
MIN. STOPPING SIGHT DISTANCE:	150 FT	MEDIANS:	NO
MIN. VERT. CURVE PROVIDED:	200 FT	RIGHT OF WAY:	60 FT
MAX. STREET GRADE:	2.3 %	BIKE LANES:	NO
MIN. STREET GRADE:	1.5 %	CURBS:	6" CONC. VERTICAL CURB & GUTTER
MIN. LANE WIDTHS:	18 FT	SIDEWALKS:	4" x 5 FT (BOTH SIDE)

A/B - INDICATES FIELD SURVEY
POSITION / AS-BUILT.

373.0	EXISTING GROUND ELEVATION
373.70	FINISHED GRADE ELEVATION
	TOP OF ROCK ELEV
	AT TEST PIT
	ABBREVIATED LAMBERT GRID COORDINATES
46	LOT NUMBER
	CONC. CURB & GUTTER
	PROPOSED GRAVEL SHOULDER
	PROPOSED PAVEMENT
	PROPOSED ROAD WIDENING
	EXISTING PAVEMENT (TO BE REMOVED)
	EXISTING EOP
	CENTERLINE
	LOT LINES
	PROPERTY/ROW LINE
	LIMITED ACCESS
	STRUCTURAL SECTION
	EXISTING GROUND
	CATCH BASIN
	J-BOX
	4'- 8" ROOF & YARD DRAIN
	6 FAN-QUIT

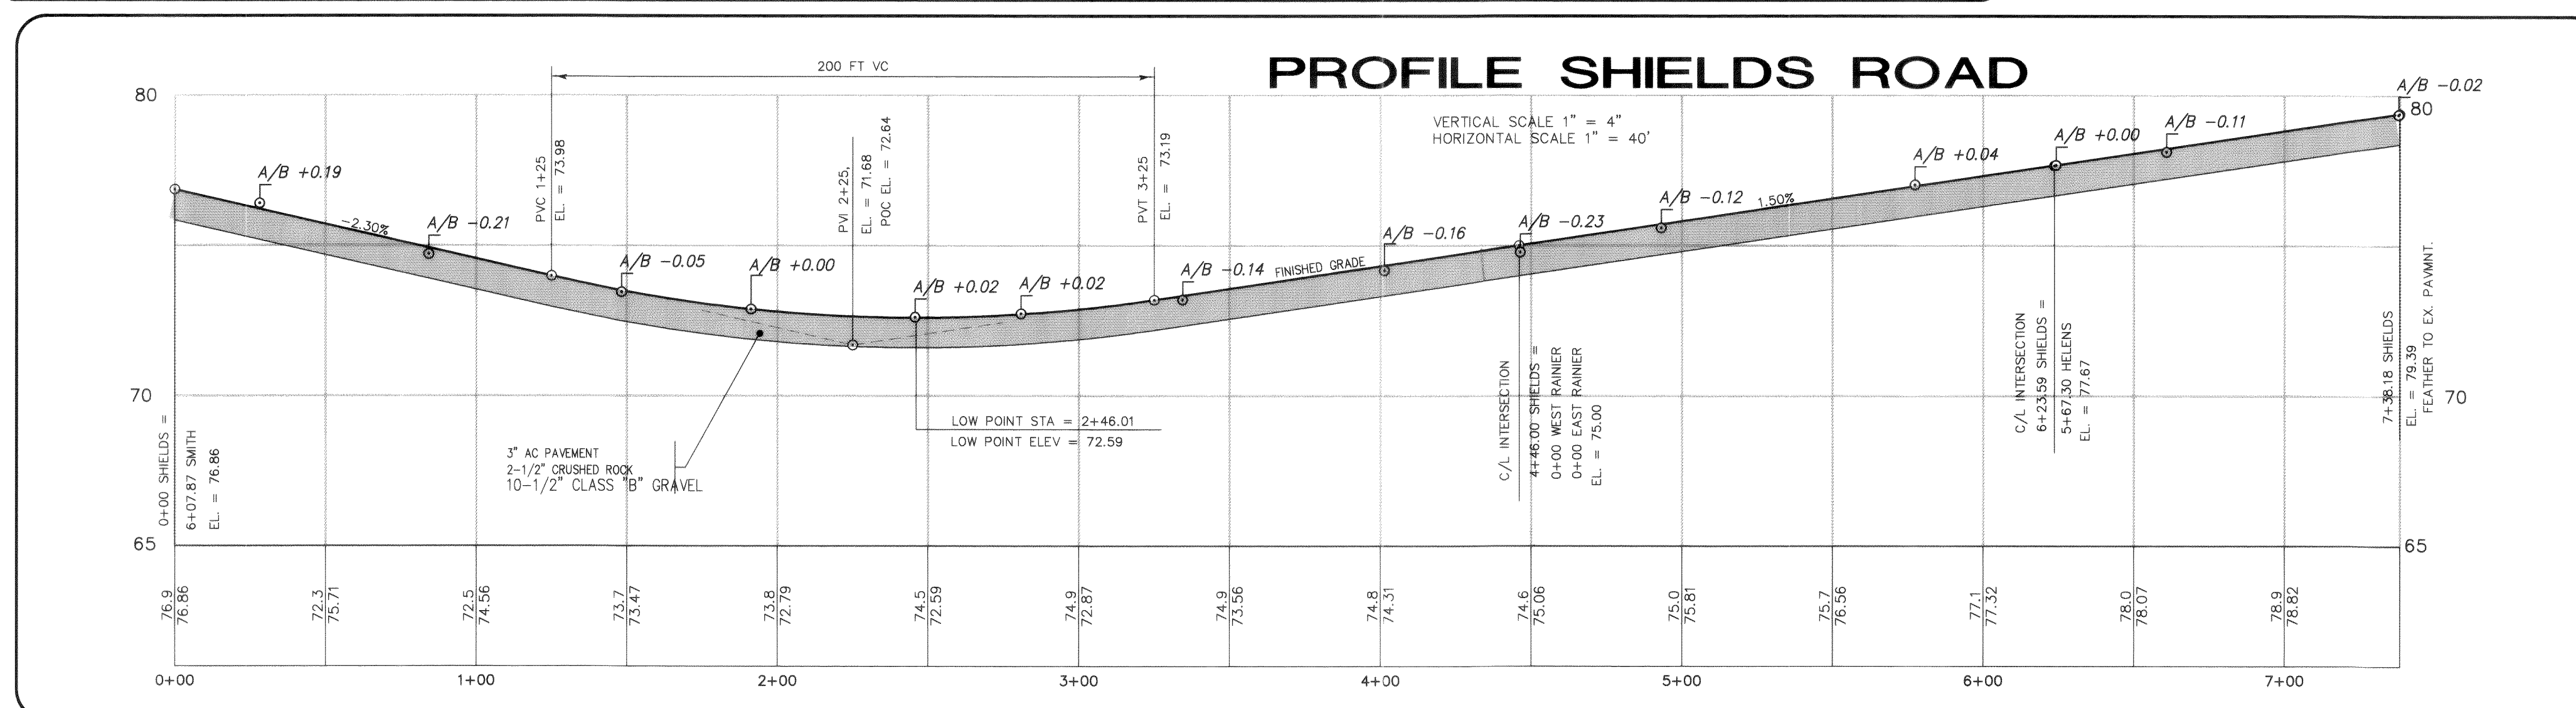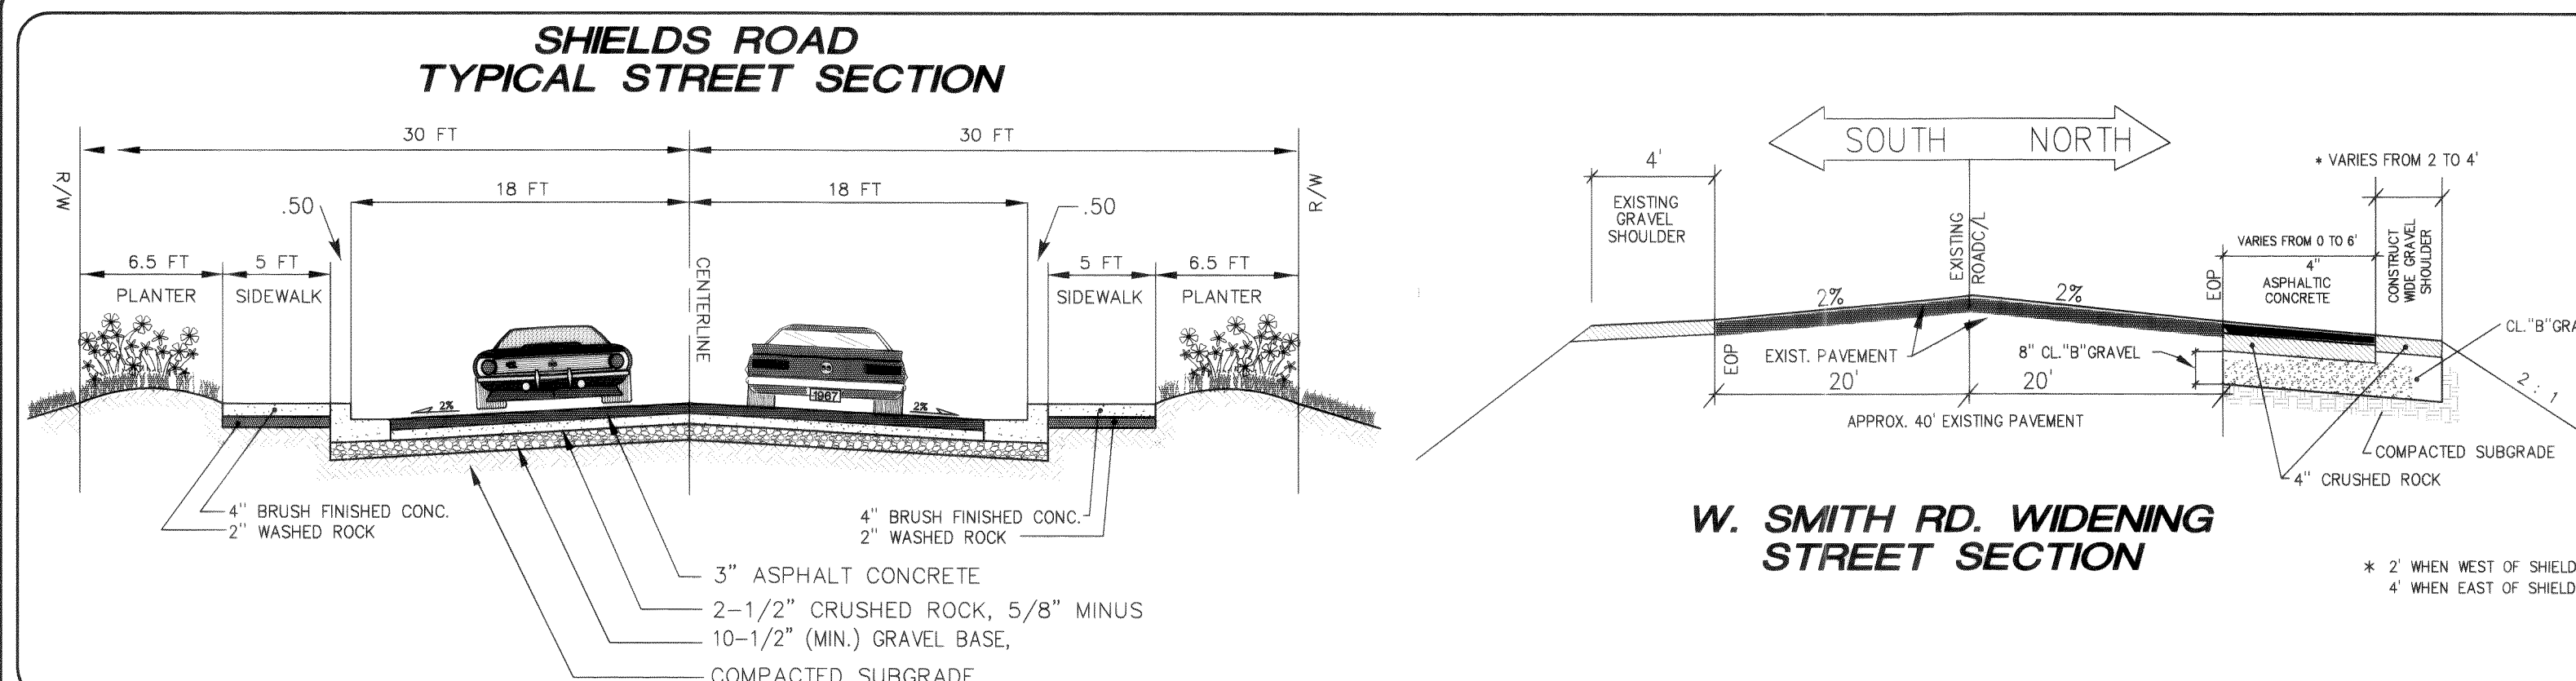


This plan has been reviewed and found to be in conformance with department standards.

CITY ENGINEER _____ DATE _____

35

A PORTION OF THE SW 1/4 OF THE SE 1/4 OF SEC 28 TOWNSHIP 39 NORTH , RANGE 2 EAST , W.M.

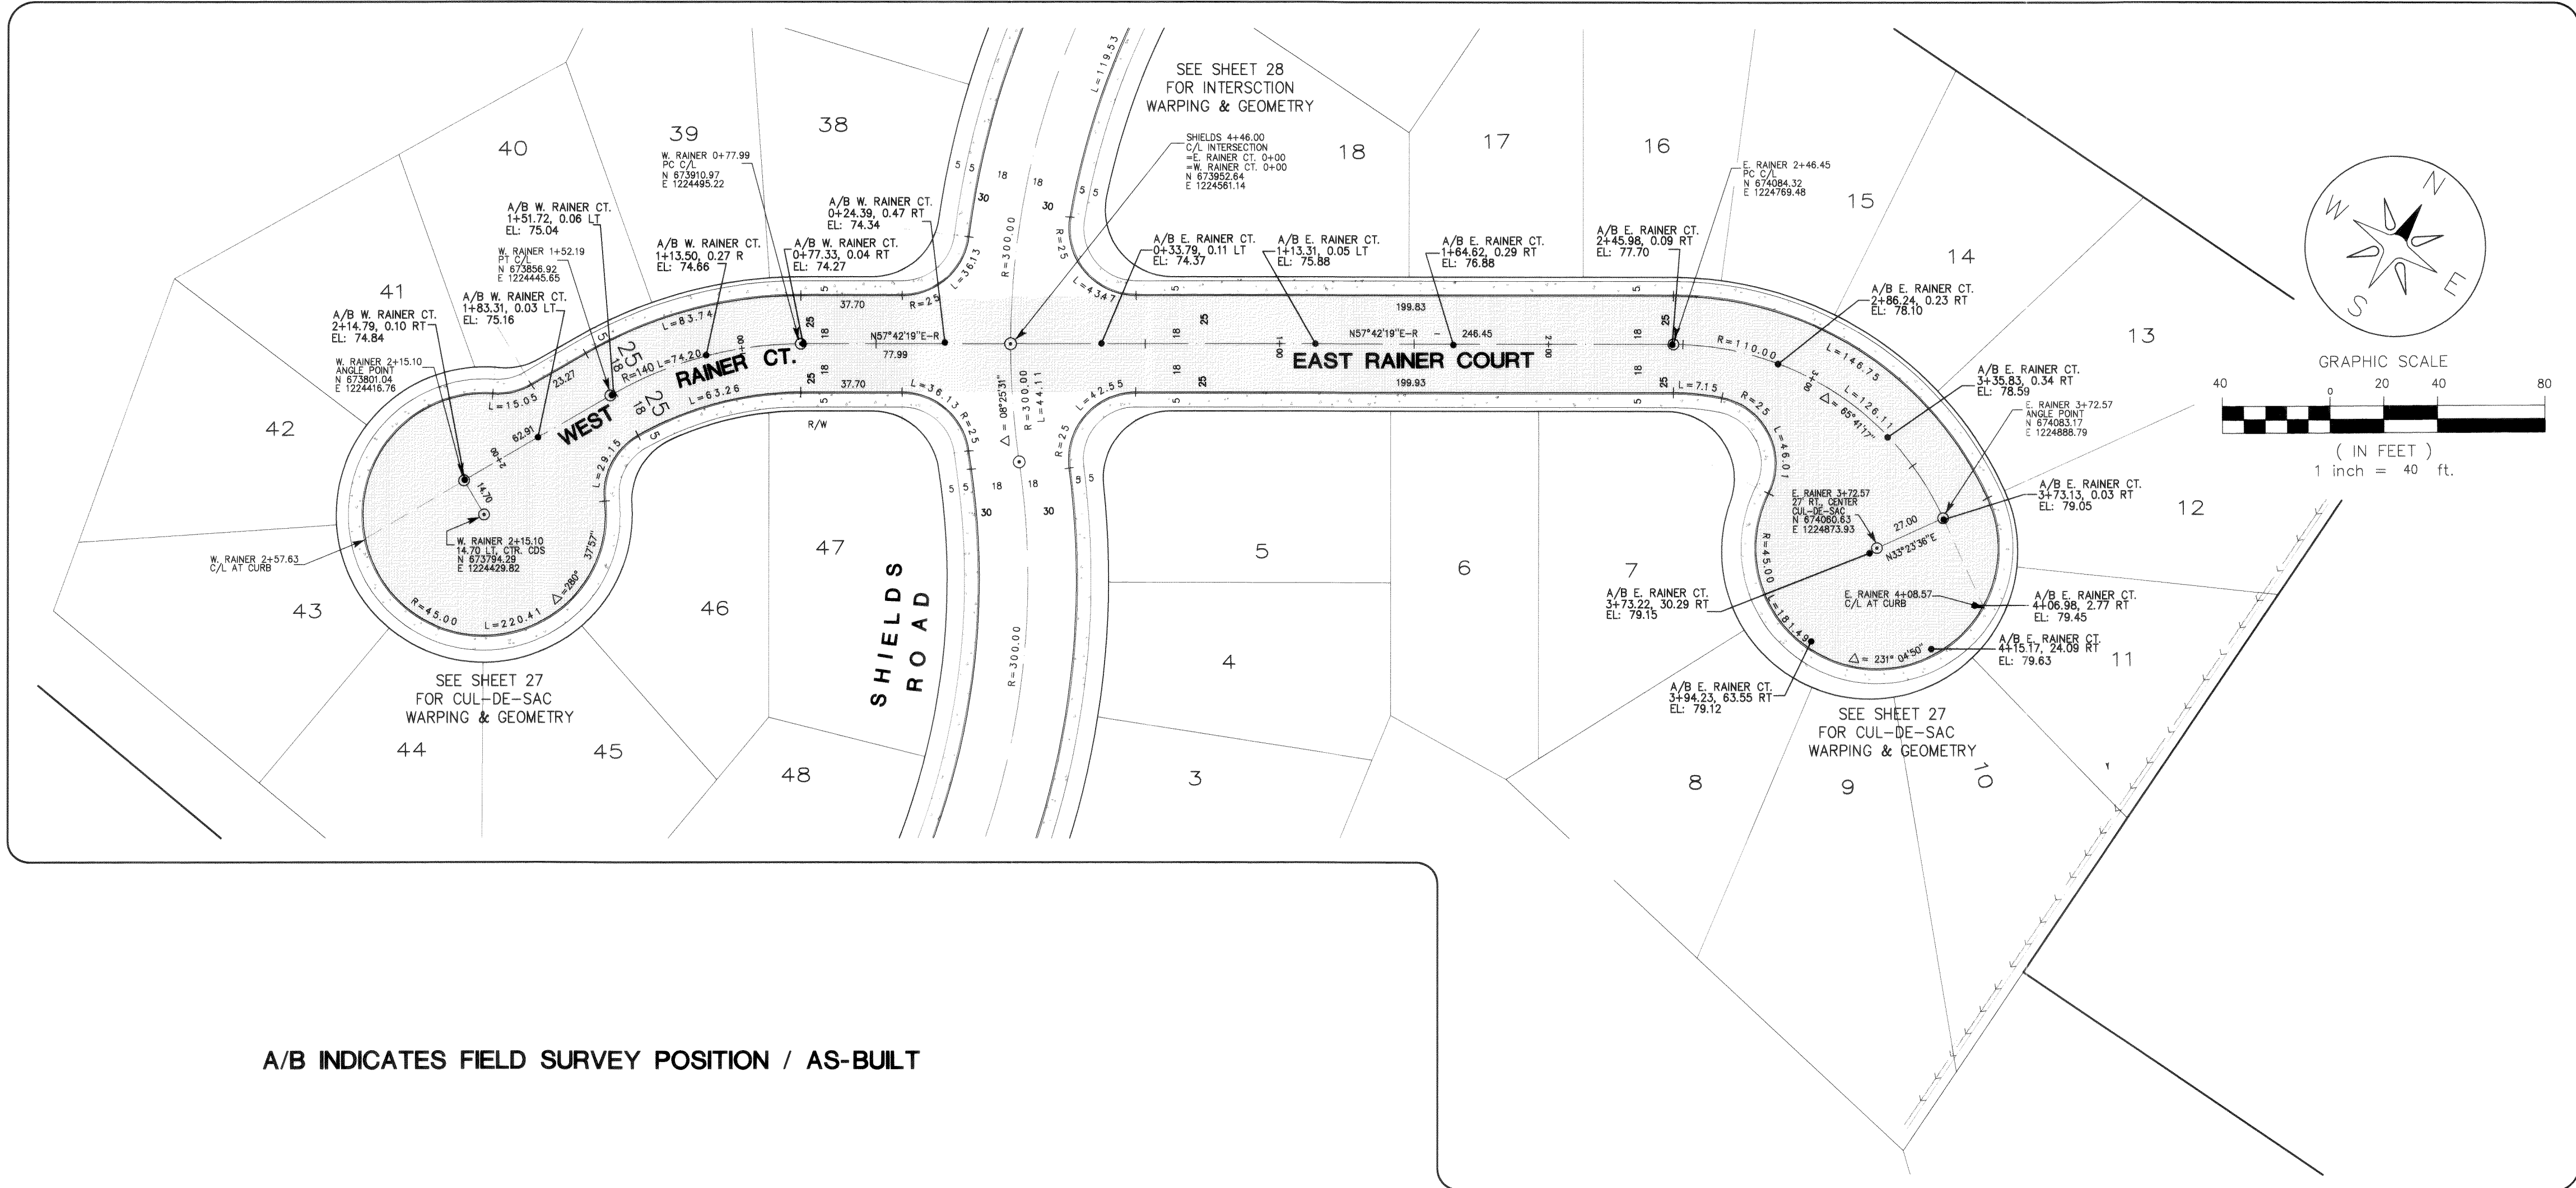


A/B INDICATES FIELD SURVEY POSITION / AS-BUILT

STREET PLAN - E/W RAINER CT.

JOB NO. 97015



EAST & WEST RAINER COURT
TYPICAL STREET SECTION

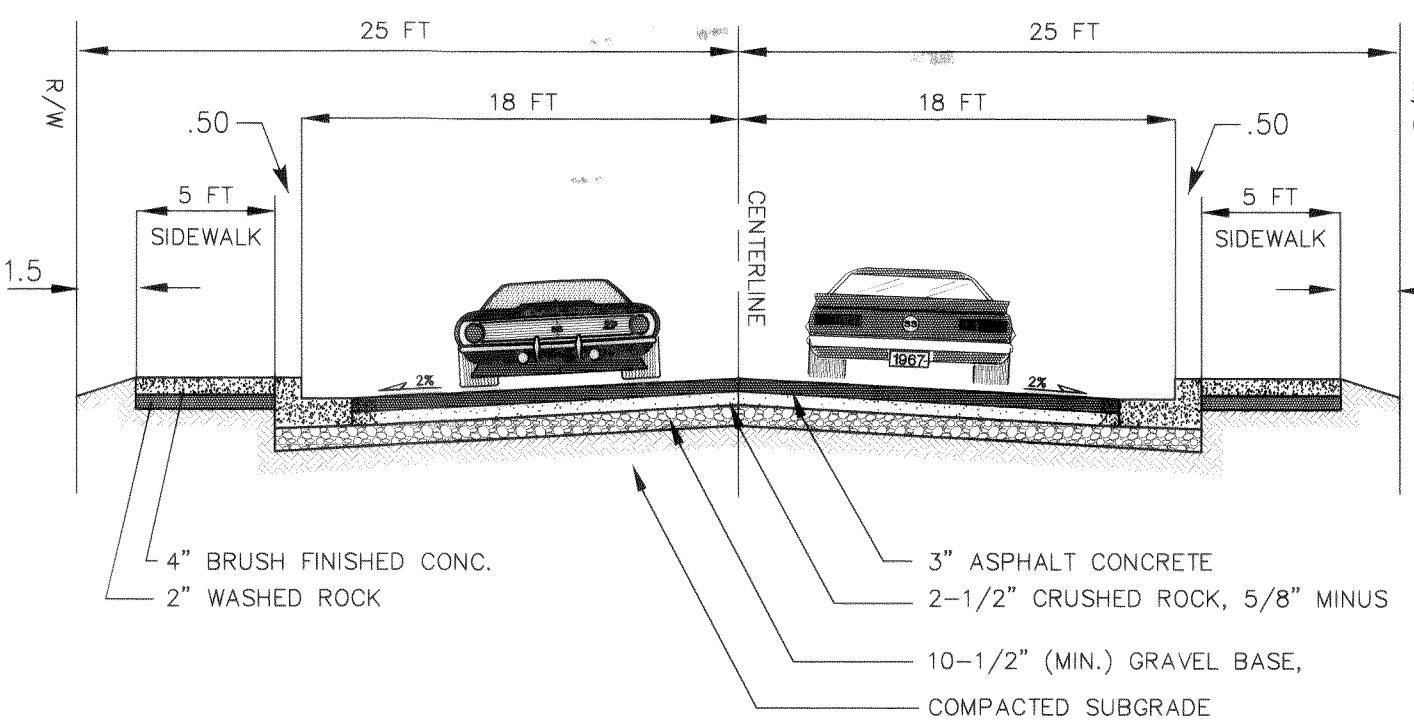

REVISIONS

NO	DATE	BY	NOTE
1			
2			
3			
4			
5			

CONTROL DATUM

HORIZONTAL: NAD83(91) WASHINGTON STATE LAMBERT GRID, NORTH ZONE
POSITION: CASED MONUMENT (F-10), SOUTHEAST CORNER SEC. 28, T39N, R2E, W.M.
Y: 675,433.53
X: 1,226,474.60
MERIDIAN: SOUTH LINE OF THE SOUTHEAST QUARTER OF SECTION 28, N88°22'49"W
VERTICAL: NGVD 1929, RAILROAD SPIKE #3, POINT 1050 NORTH OF SMITH ROAD ON THE FRONTAGE ROAD EAST OF I-5
ELEVATION = 81.03

DESIGN CRITERIA

FUNCTIONAL CLASSIFICATION:	LOCAL ACCESS	MIN. C/L RADIUS CURVES:	110 FEET
PROPOSED ACCESS:	BARRET/SMITH ROAD	MIN. RADIUS CURB RETURNS:	25 FT
AVERAGE WEEKDAY TRAFFIC:	191 VPD	SPLIT HORIZONTAL ALIGNMENT:	NO
DESIGN SPEED:	25 MPH	SPLIT VERTICAL ALIGNMENT:	NO
MIN. STOPPING SIGHT DISTANCE:	150 FT	MEDIANS:	NO
MIN. VERT. CURVE PROVIDED:	50 FT	RIGHT OF WAY:	50 FT
MAX. STREET GRADE:	2.0 %	BIKE LANES:	NO
MIN. STREET GRADE:	1.0 %	CURBS:	CONC. VERTICAL CURB & GUTTER
MIN. LANE WIDTHS:	18 FT	SIDEWALKS:	4" x 5 FT (BOTH SIDE)

LEGEND

R/W	PROPERTY/ROW LINE	376.0	EXISTING GROUND ELEVATION
	LIMITED ACCESS	373.70	FINISHED GRADE ELEVATION
	STRUCTURAL SECTION	46	TOP OF ROCK ELEV
	ESTIMATED ROCK		AT TEST PIT
	EXISTING GROUND		ABBREVIATED LAMBERT GRID COORDINATES
	CATCH BASIN		LOT NUMBER
	J-BOX		CONC. CURB & GUTTER
	4" - 8" ROOF & YARD DRAIN		PAVEMENT
	CLEAN-OUT		CENTERLINE
			LOT LINES

SEE SHEET 13 FOR STREET CONSTRUCTION DETAILS

SEE SHEET 14 (SHIELDS STORM DRAINAGE) FOR
ROOF & YARD DETAILS

DRAWN BY _____ DATE _____

DRAWN BY _____ DATE _____


JOB # 97015

SHIELDS ESTATES

FOR:
TEITGE, WILLIAMS & McCOLLUM INVESTMENTS, INC.

PROFESSIONAL CERTIFICATION
I HEREBY CERTIFY THAT THIS PLAN ACCURATELY
DEPicts THE MATERIALS, TYPES, AND LOCATIONS
OF THE IMPROVEMENTS SHOWN HEREON AS OF
THIS DATE.

HARRY P. JONES, PE
DATE _____

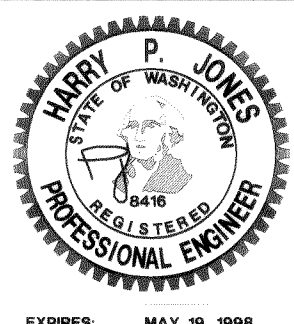

JONES ENGINEERS
INCORPORATED, P.S.
CONSULTING ENGINEERS
851 COHO WAY, SUITE 307
BELLINGHAM, WA 98225 (360) 733-8888

AS-BUILT
SHIELDS ESTATES
EAST & WEST RAINER COURT
STREET PLAN & PROFILE

DEPARTMENT OF PUBLIC WORKS
FERNDALE, WASHINGTON
APPROVED

This plan has been reviewed and found
to be in conformance with department
standards.


CITY ENGINEER _____ DATE _____

SHEET



10

OF 35


<u>REVISIONS</u>			
<u>NO</u>	<u>DATE</u>	<u>BY</u>	<u>NOTE</u>
1.	6-18-97	A.K.	REVISE PER AGENCY REVIEW

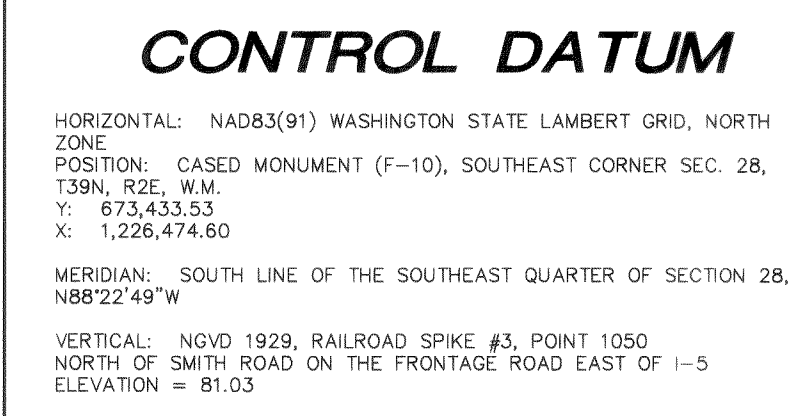



STREET PLAN - ST. HELENS LN. **JOB NO. 97015**

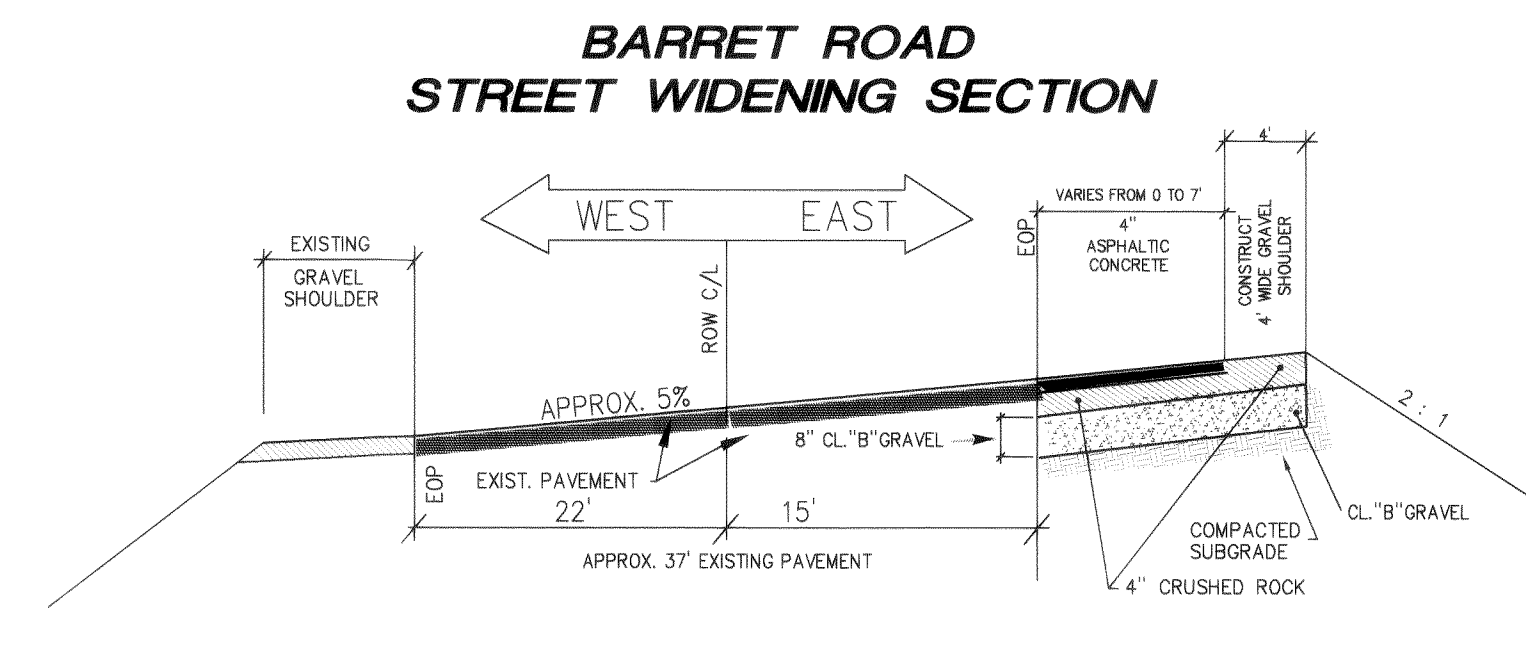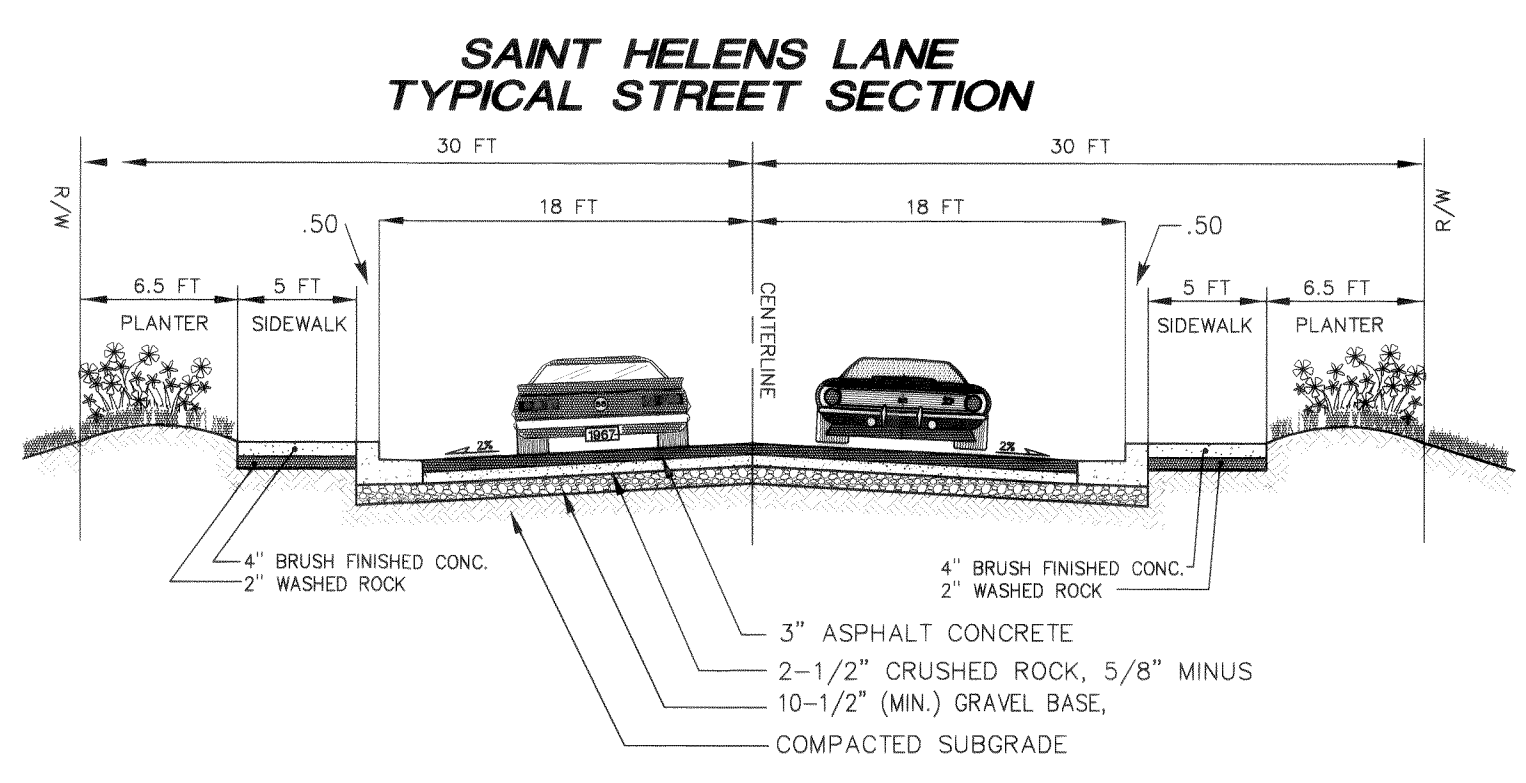

DESIGN CRITERIA			
FUNCTIONAL CLASSIFICATION:	LOCAL ACCESS	MIN. C/L RADIUS CURVES:	300 FEET
PROPOSED ACCESS:	BARRET / SMITH ROAD	MIN. RADIUS CURB RETURNS:	25 FEET
AVERAGE WEEKDAY TRAFFIC: (HELENS)	1090 VPD	SPLIT HORIZONTAL ALIGNMENT:	N/A
DESIGN SPEED:	25 MPH	SPLIT VERTICAL ALIGNMENT:	N/A
MIN. STOPPING SIGHT DISTANCE:	150 FT	MEDIANS:	N/A
MIN. VERT. CURVE PROVIDED:	50 FT	RIGHT OF WAY:	60 FT
MAX. STREET GRADE:	4.7 %	BIKE LANES:	N/A
MIN. STREET GRADE:	0.9 %	CURBS:	6" CONC. VERTICAL CURB & GUTTER
MIN. LANE WIDTHS:	18 FT	SIDEWALKS:	4" x 5 FT (BOTH SIDES)

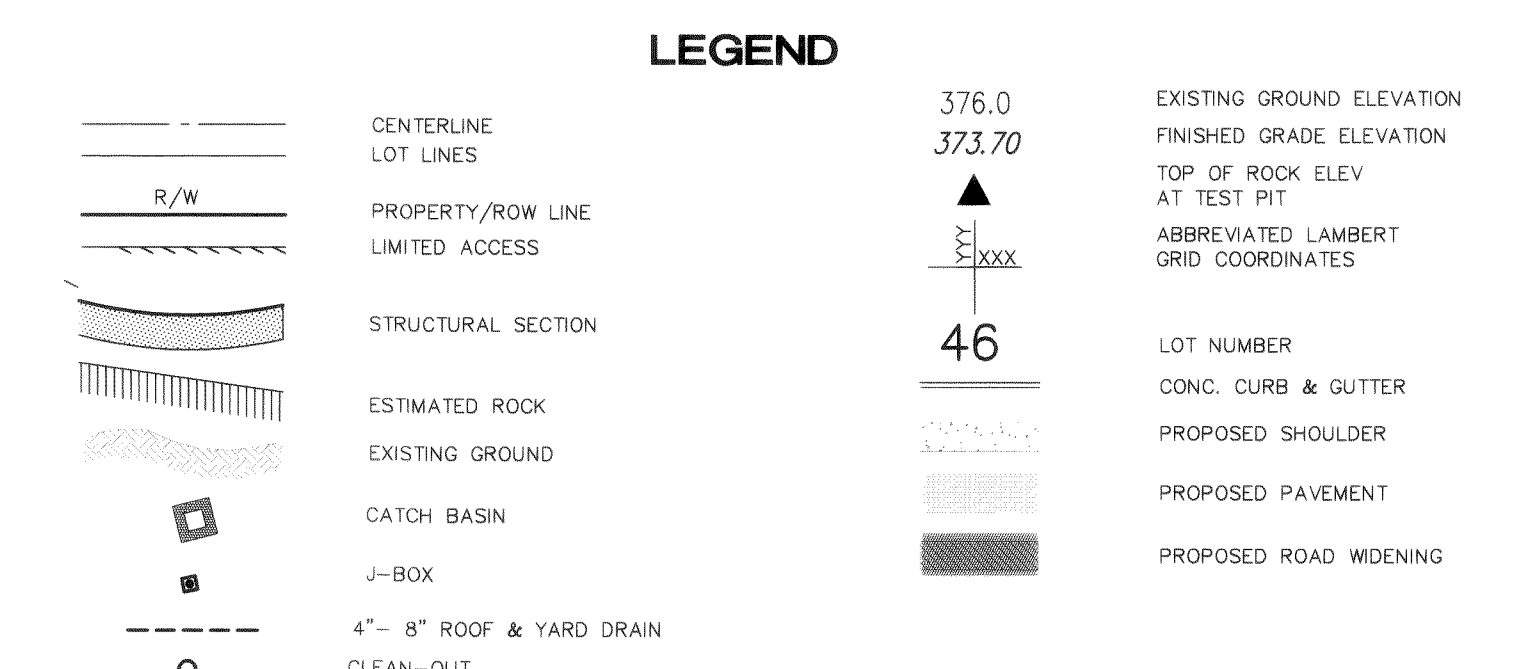

SEE SHEET 14 (SHIELDS STORM DRAINAGE) FOR
ROOF & YARD DETAILS

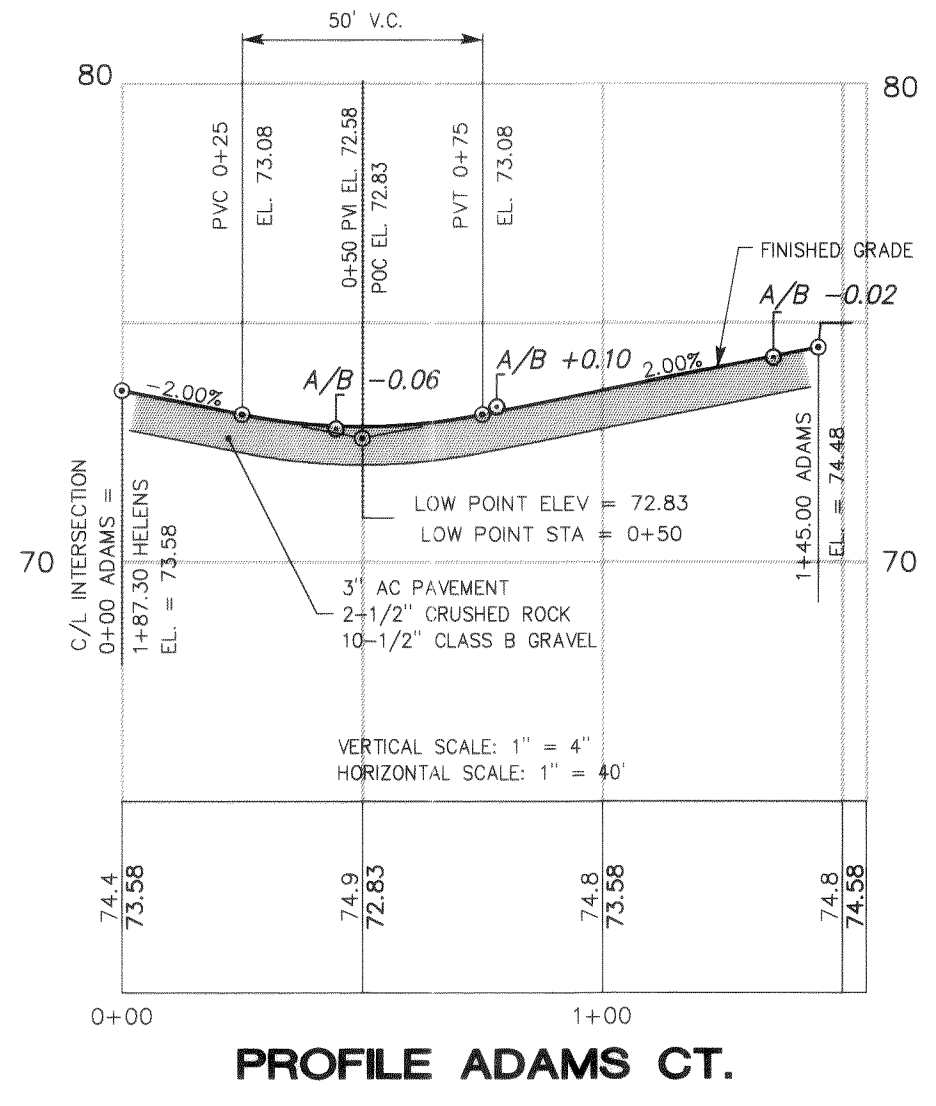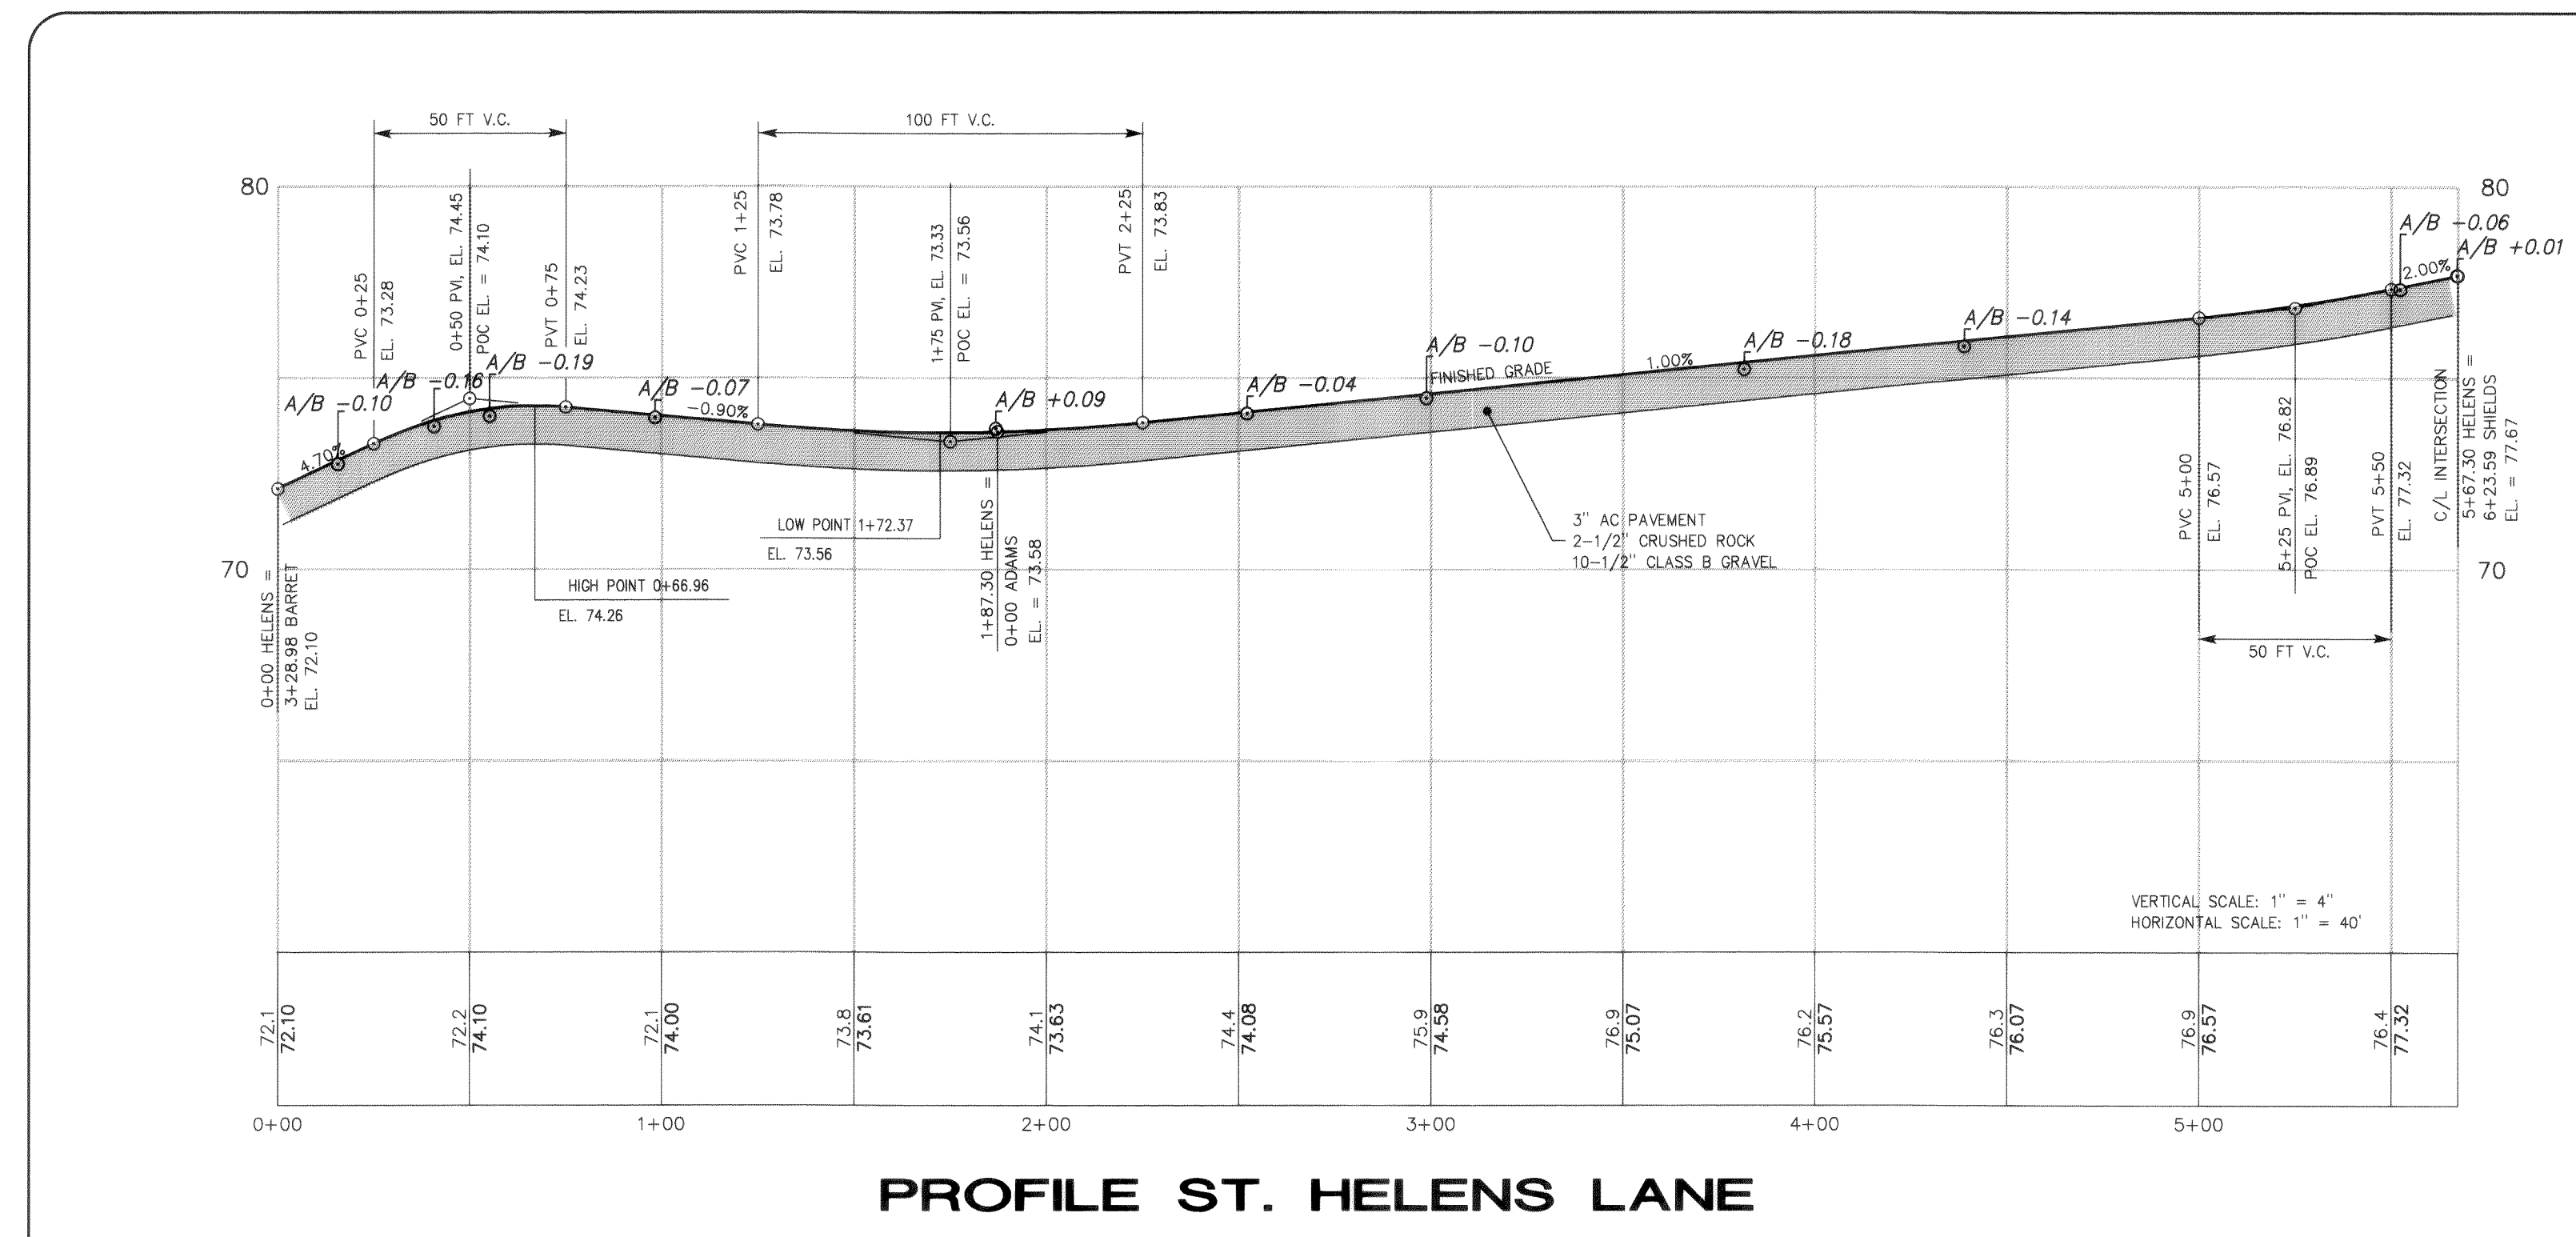


PROFESSIONAL CERTIFICATION

I HEREBY CERTIFY THAT THIS PLAN ACCURATELY
DEPICTS THE MATERIALS, TYPES, AND LOCATIONS
OF THE IMPROVEMENTS SHOWN HEREON AS OF
THIS DATE.

HARRY F. JONES

HARRY F. JONES, PE

DATE _____

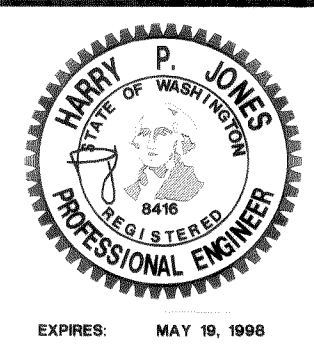

JONES ENGINEERS
INCORPORATED, P.S.

CONSULTING ENGINEERS

851 COHO WAY, SUITE 307
BELLINGHAM, WA 98225 (360) 733-8888

AS-BUILT
SHIELDS ESTATES
ST. HELENS LANE / ADAMS COURT
STREET PLAN & PROFILE
BARRET ROAD WIDENING

DEPARTMENT OF PUBLIC WORKS















FERDALE,
WASHINGTON

APPROVED

This plan has been reviewed and found to be in conformance with department standards.

CITY ENGINEER..... DATE.....

A PORTION OF THE SW 1/4 OF THE SE 1/4 OF SEC 28 TOWNSHIP 39 NORTH , RANGE 2 EAST , W.M.

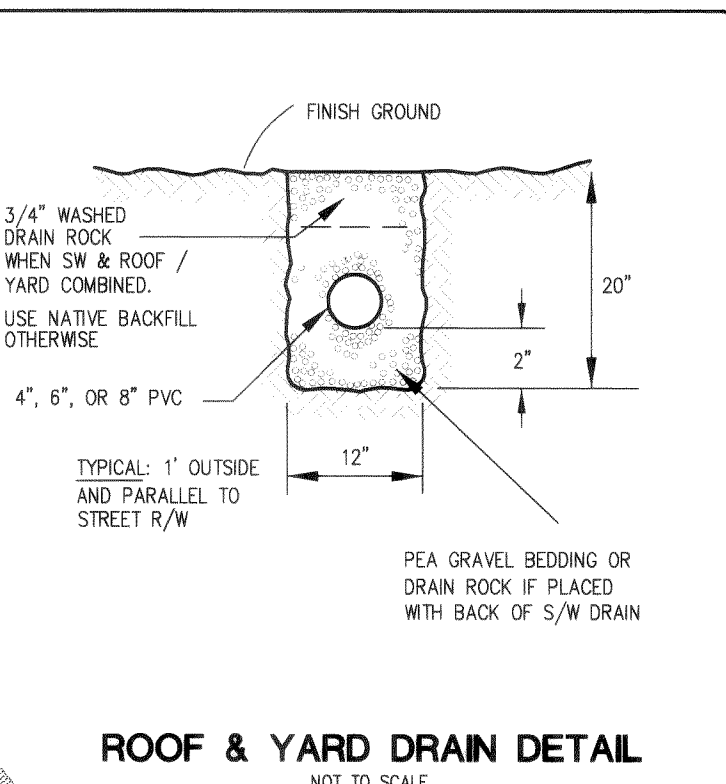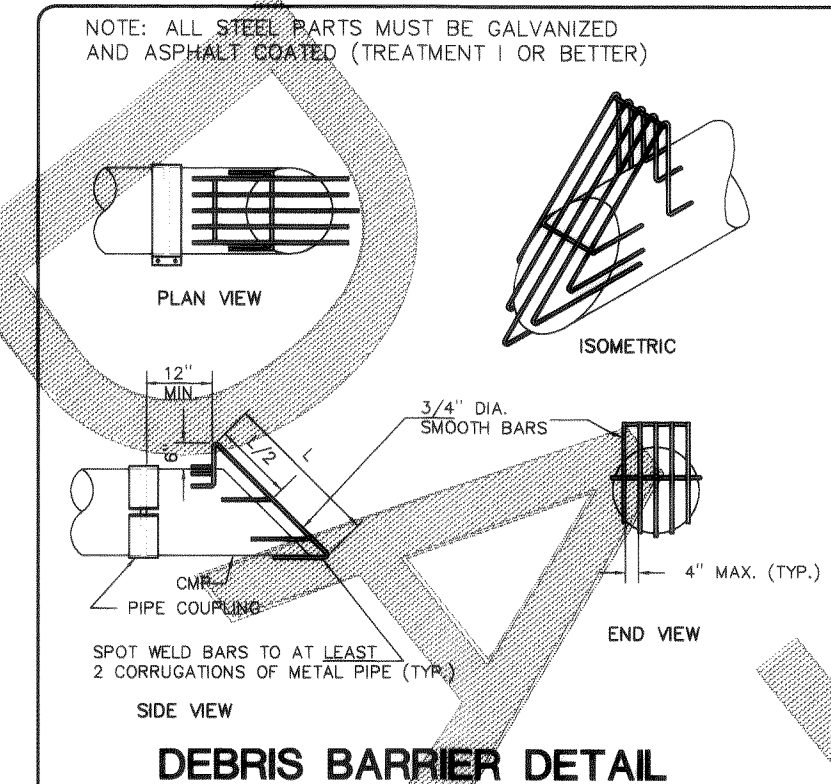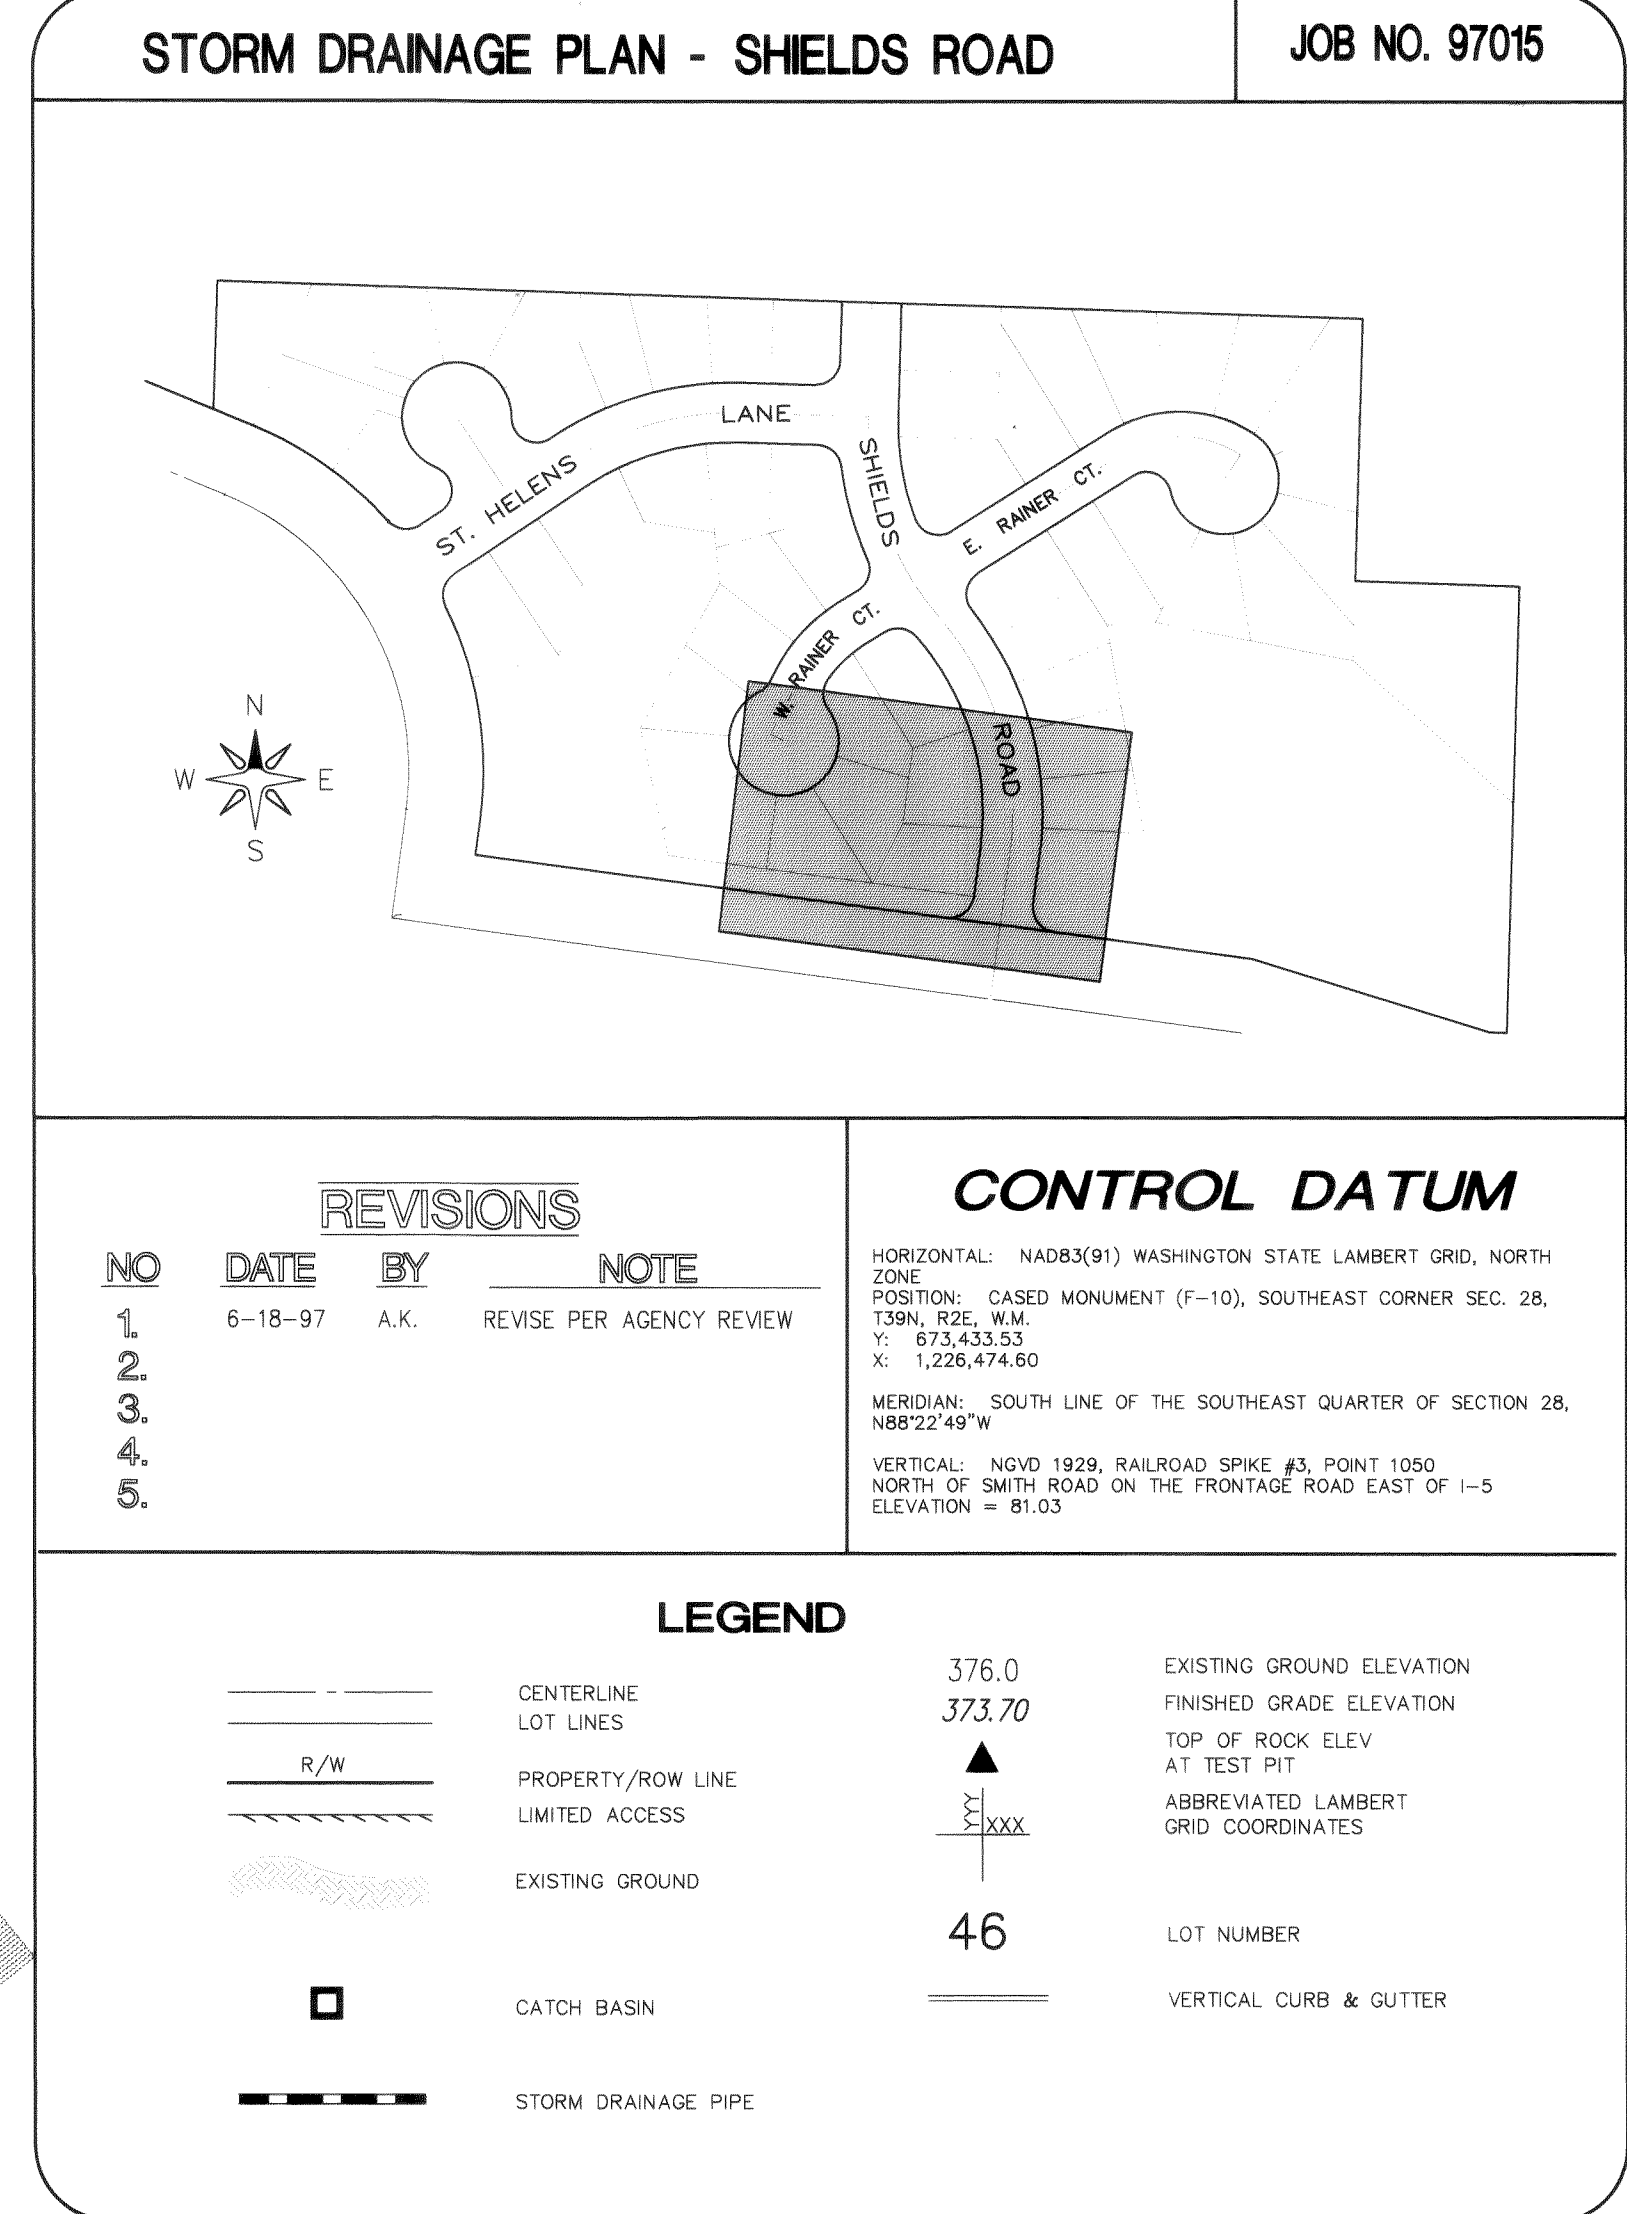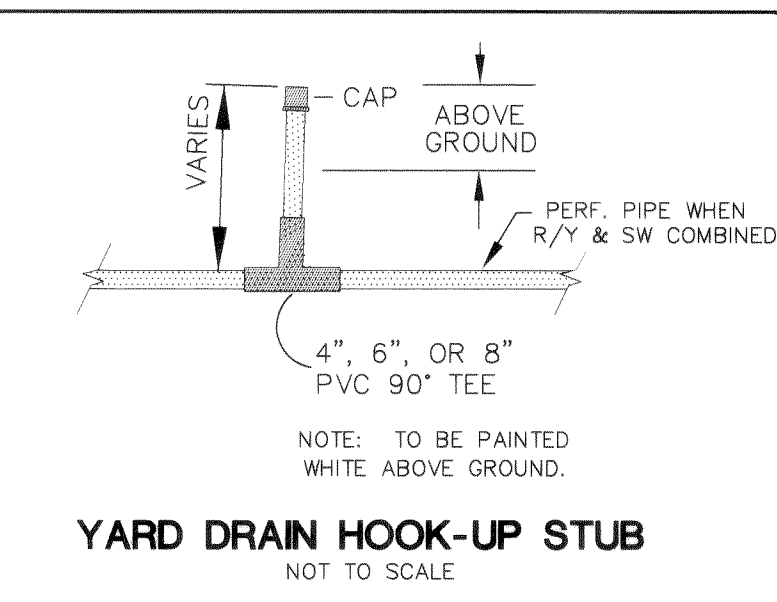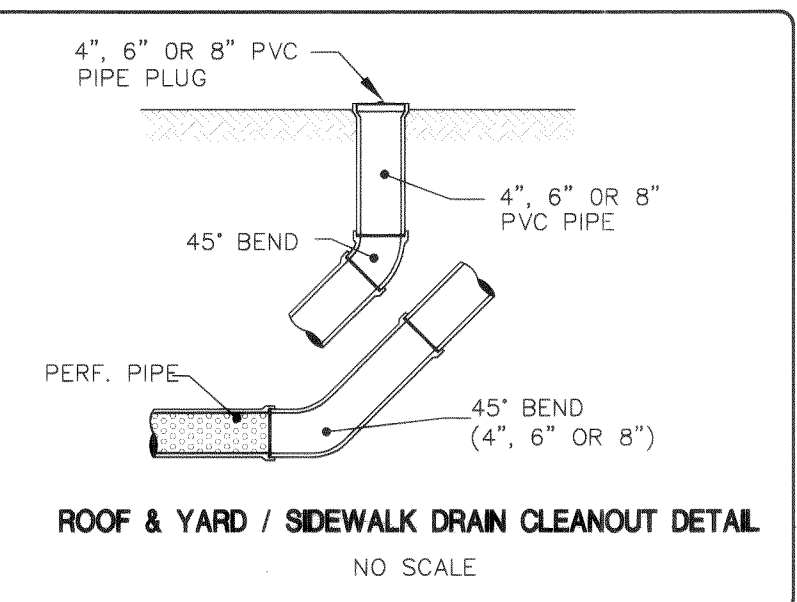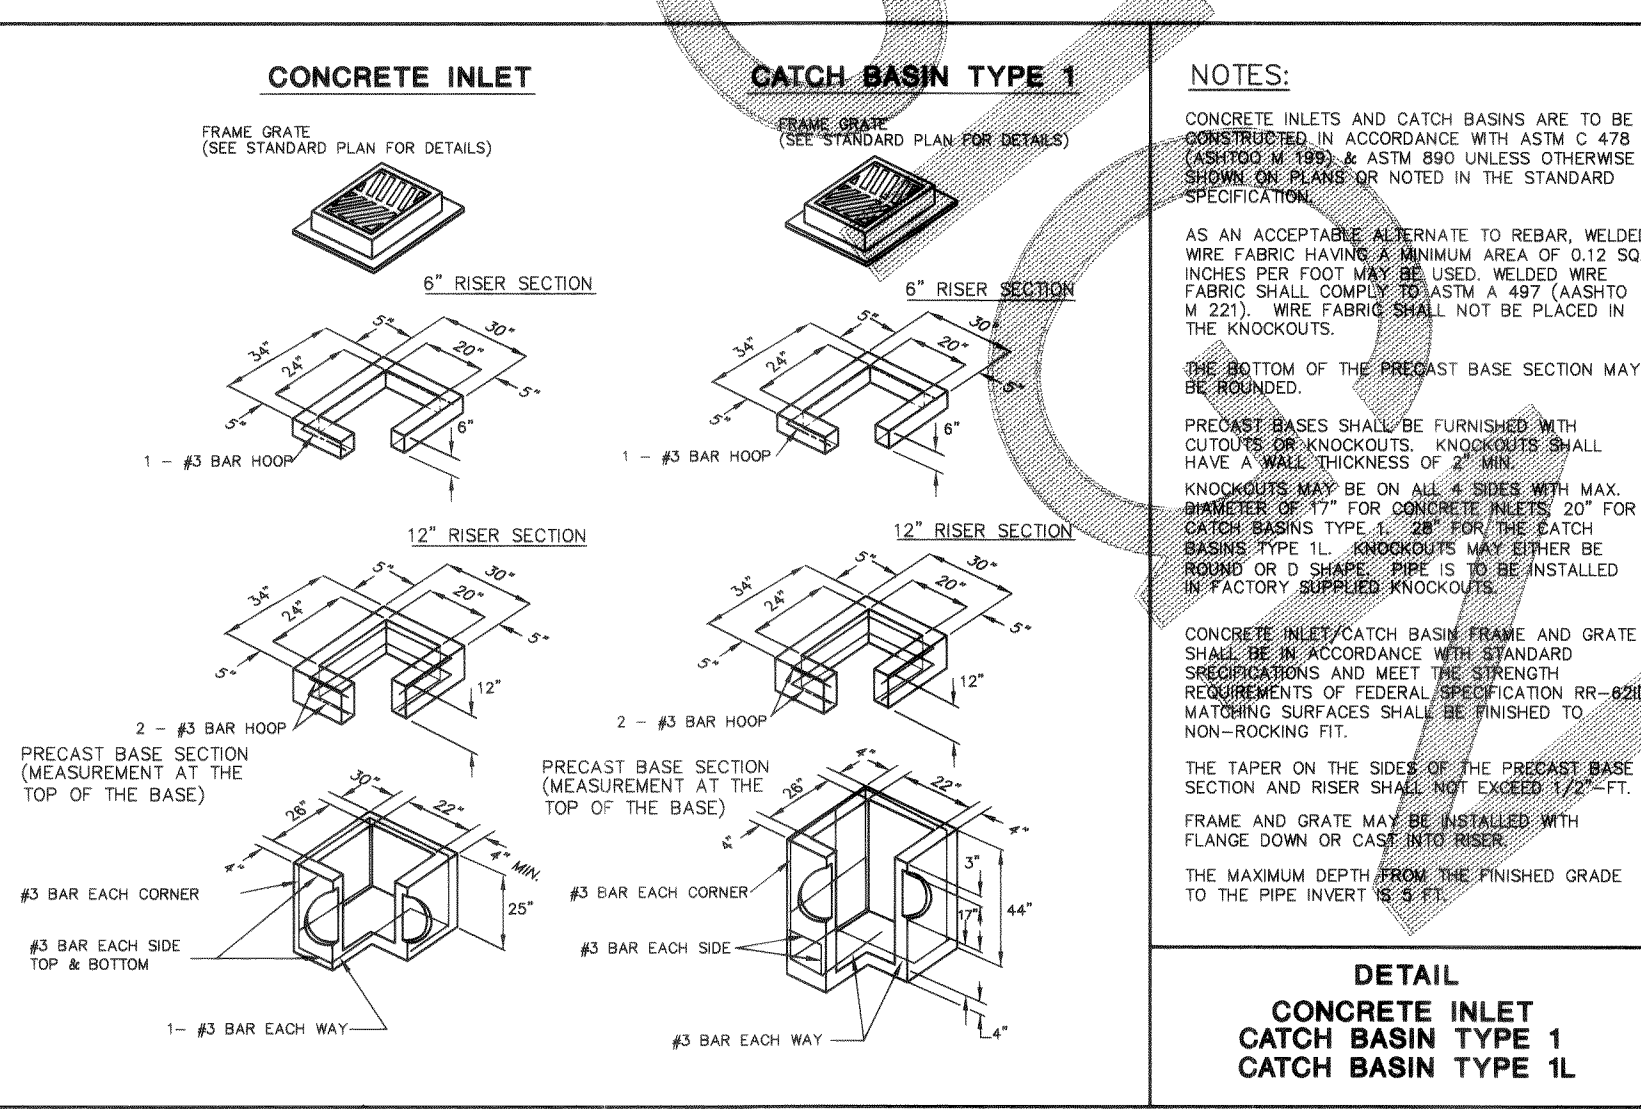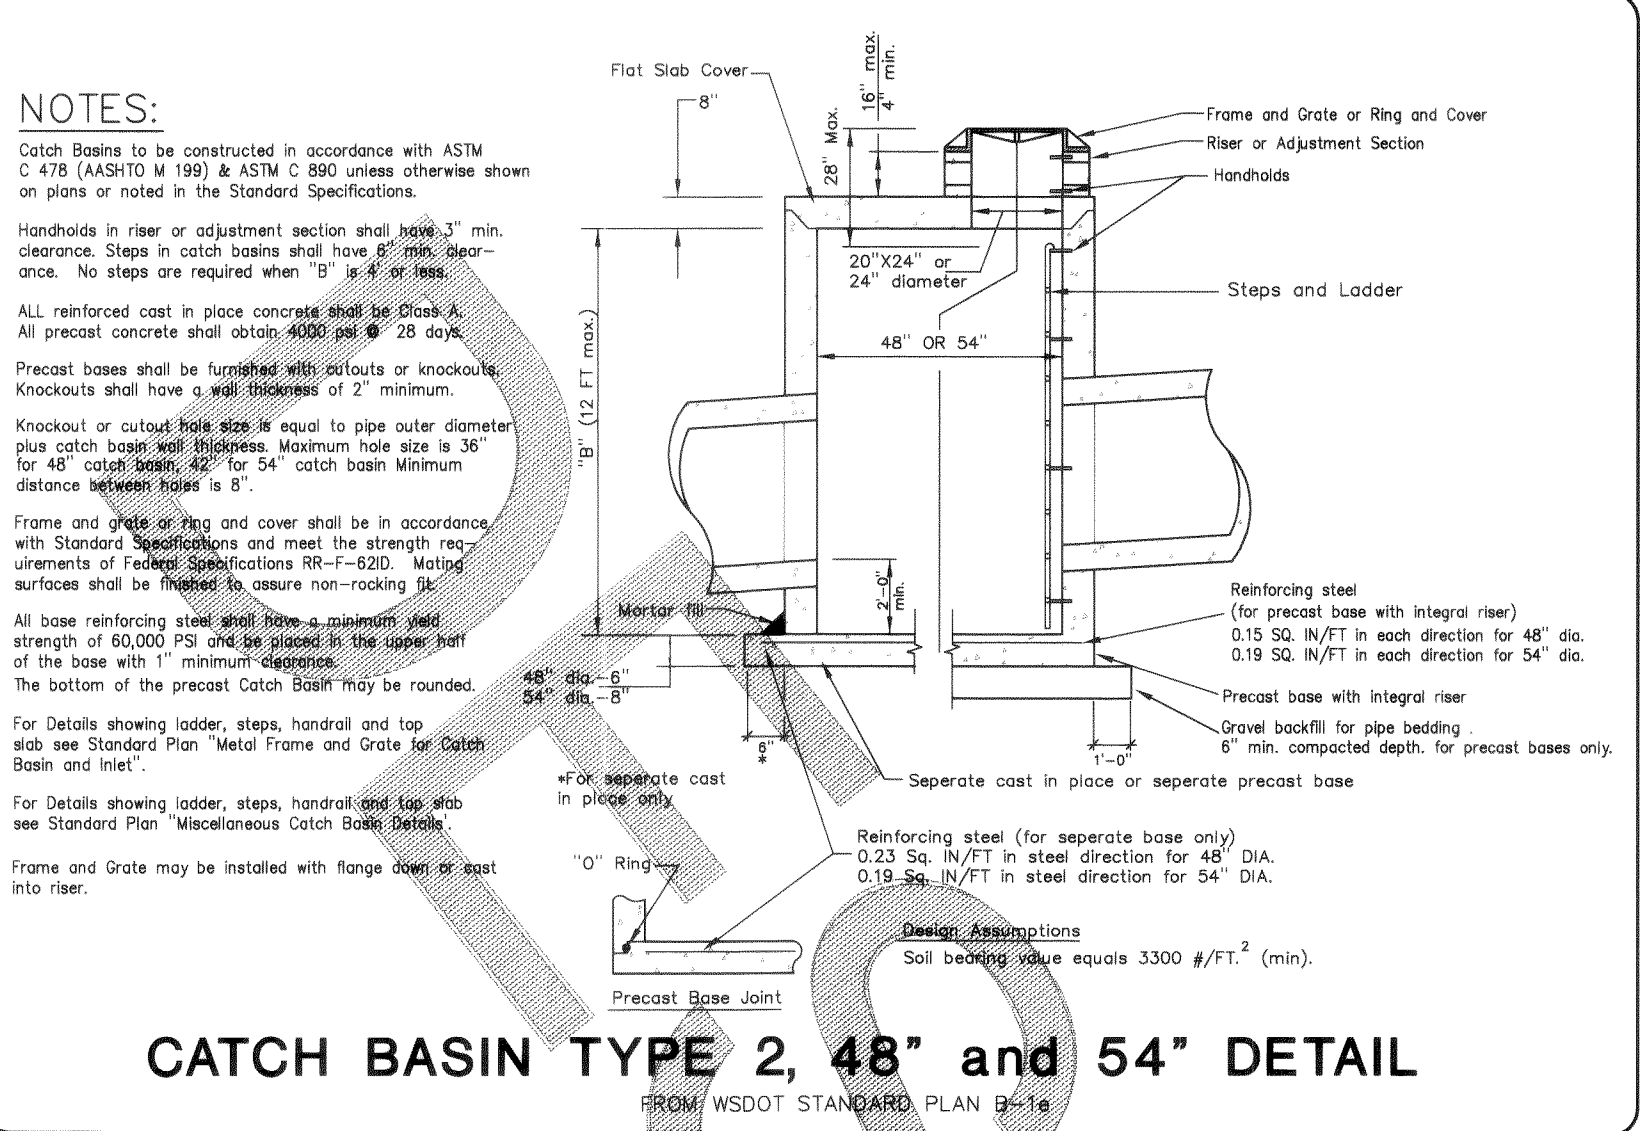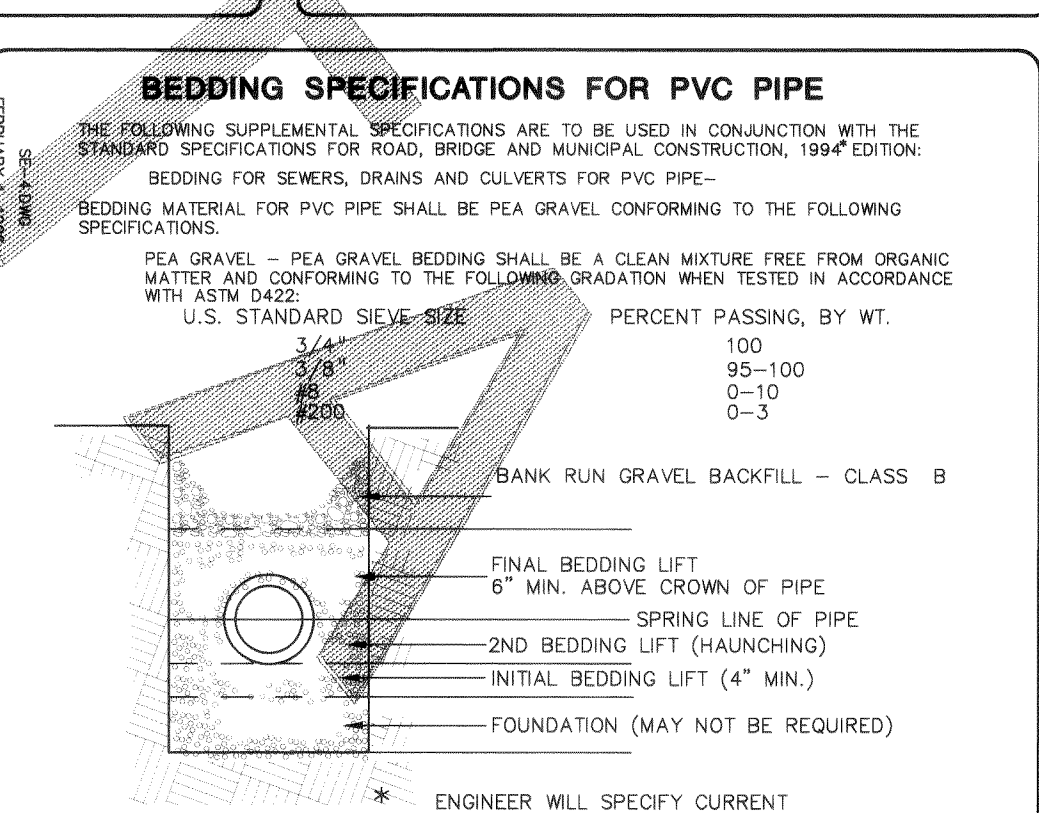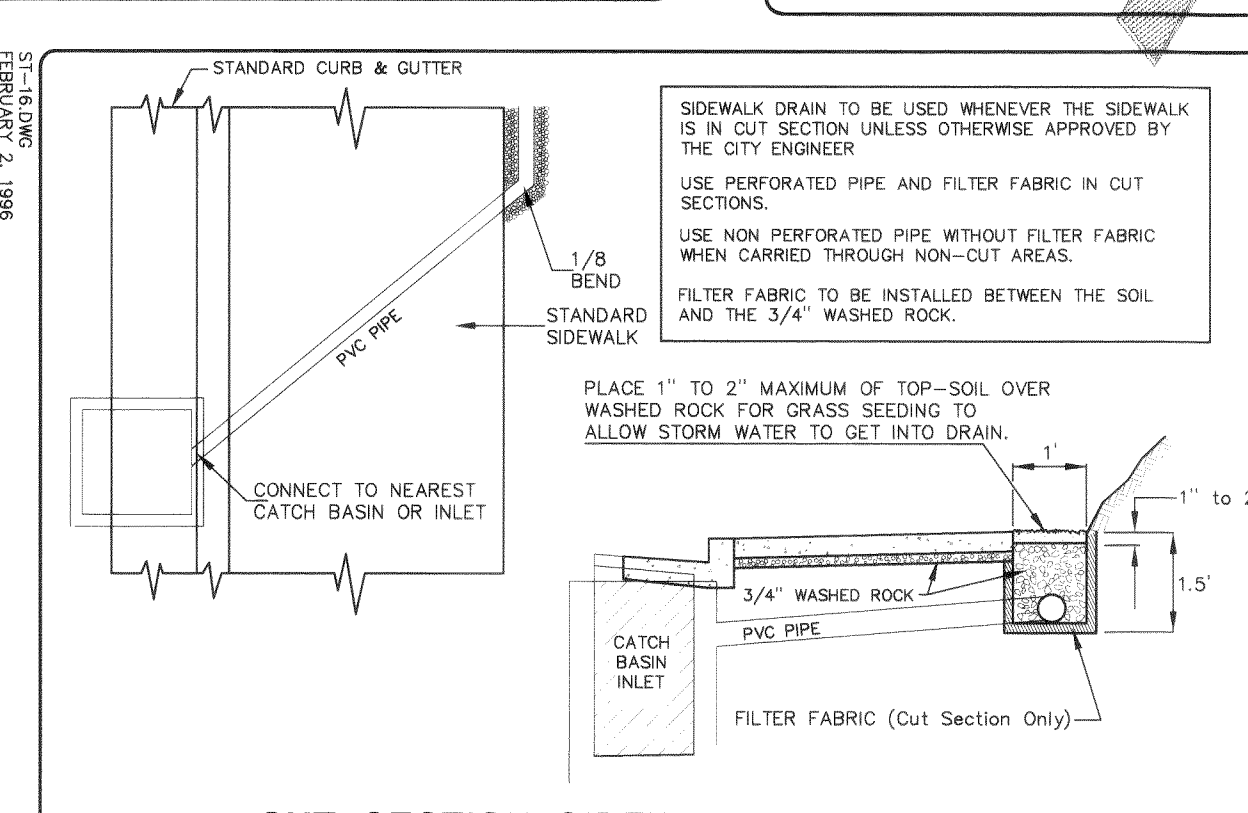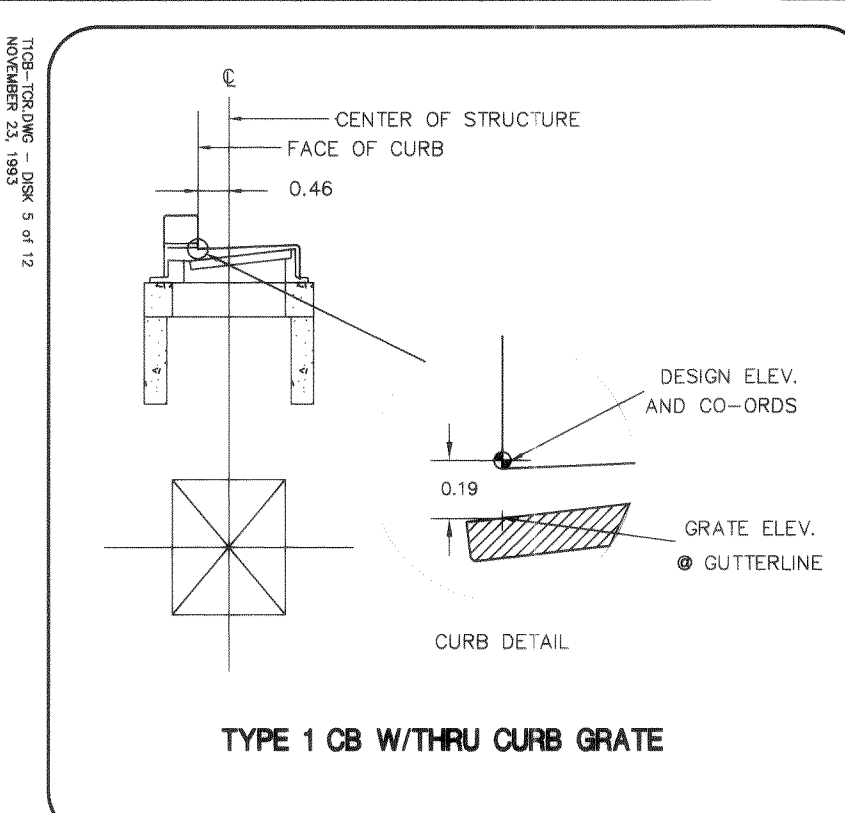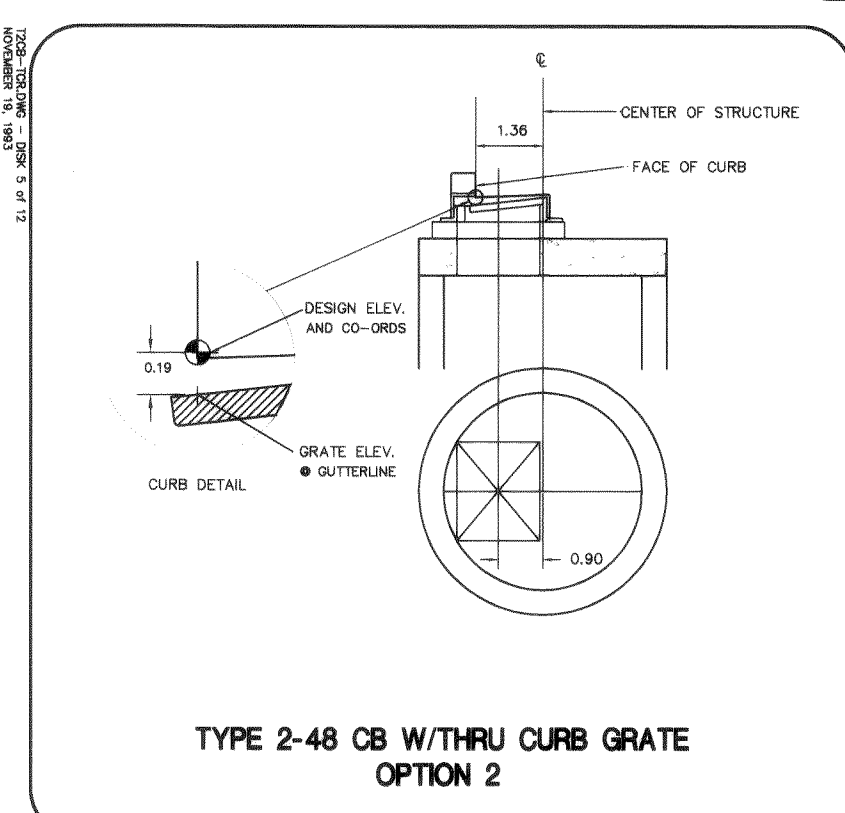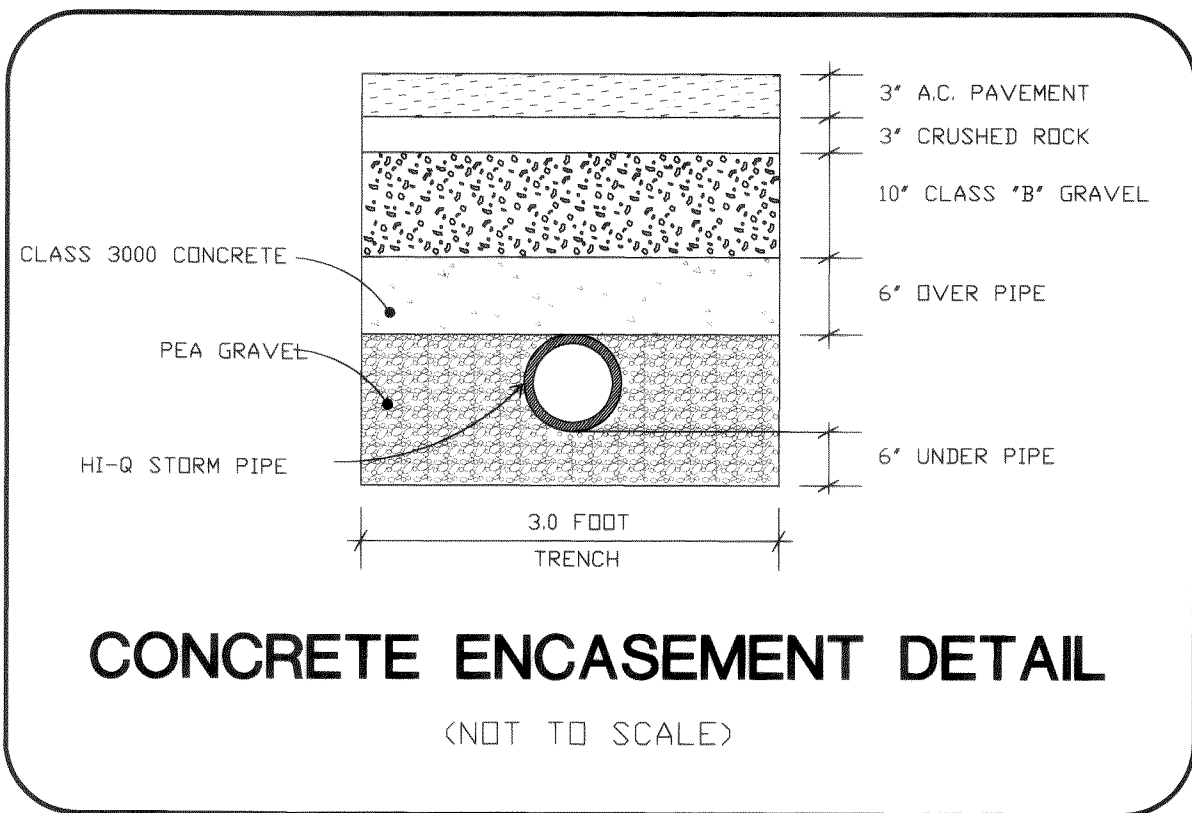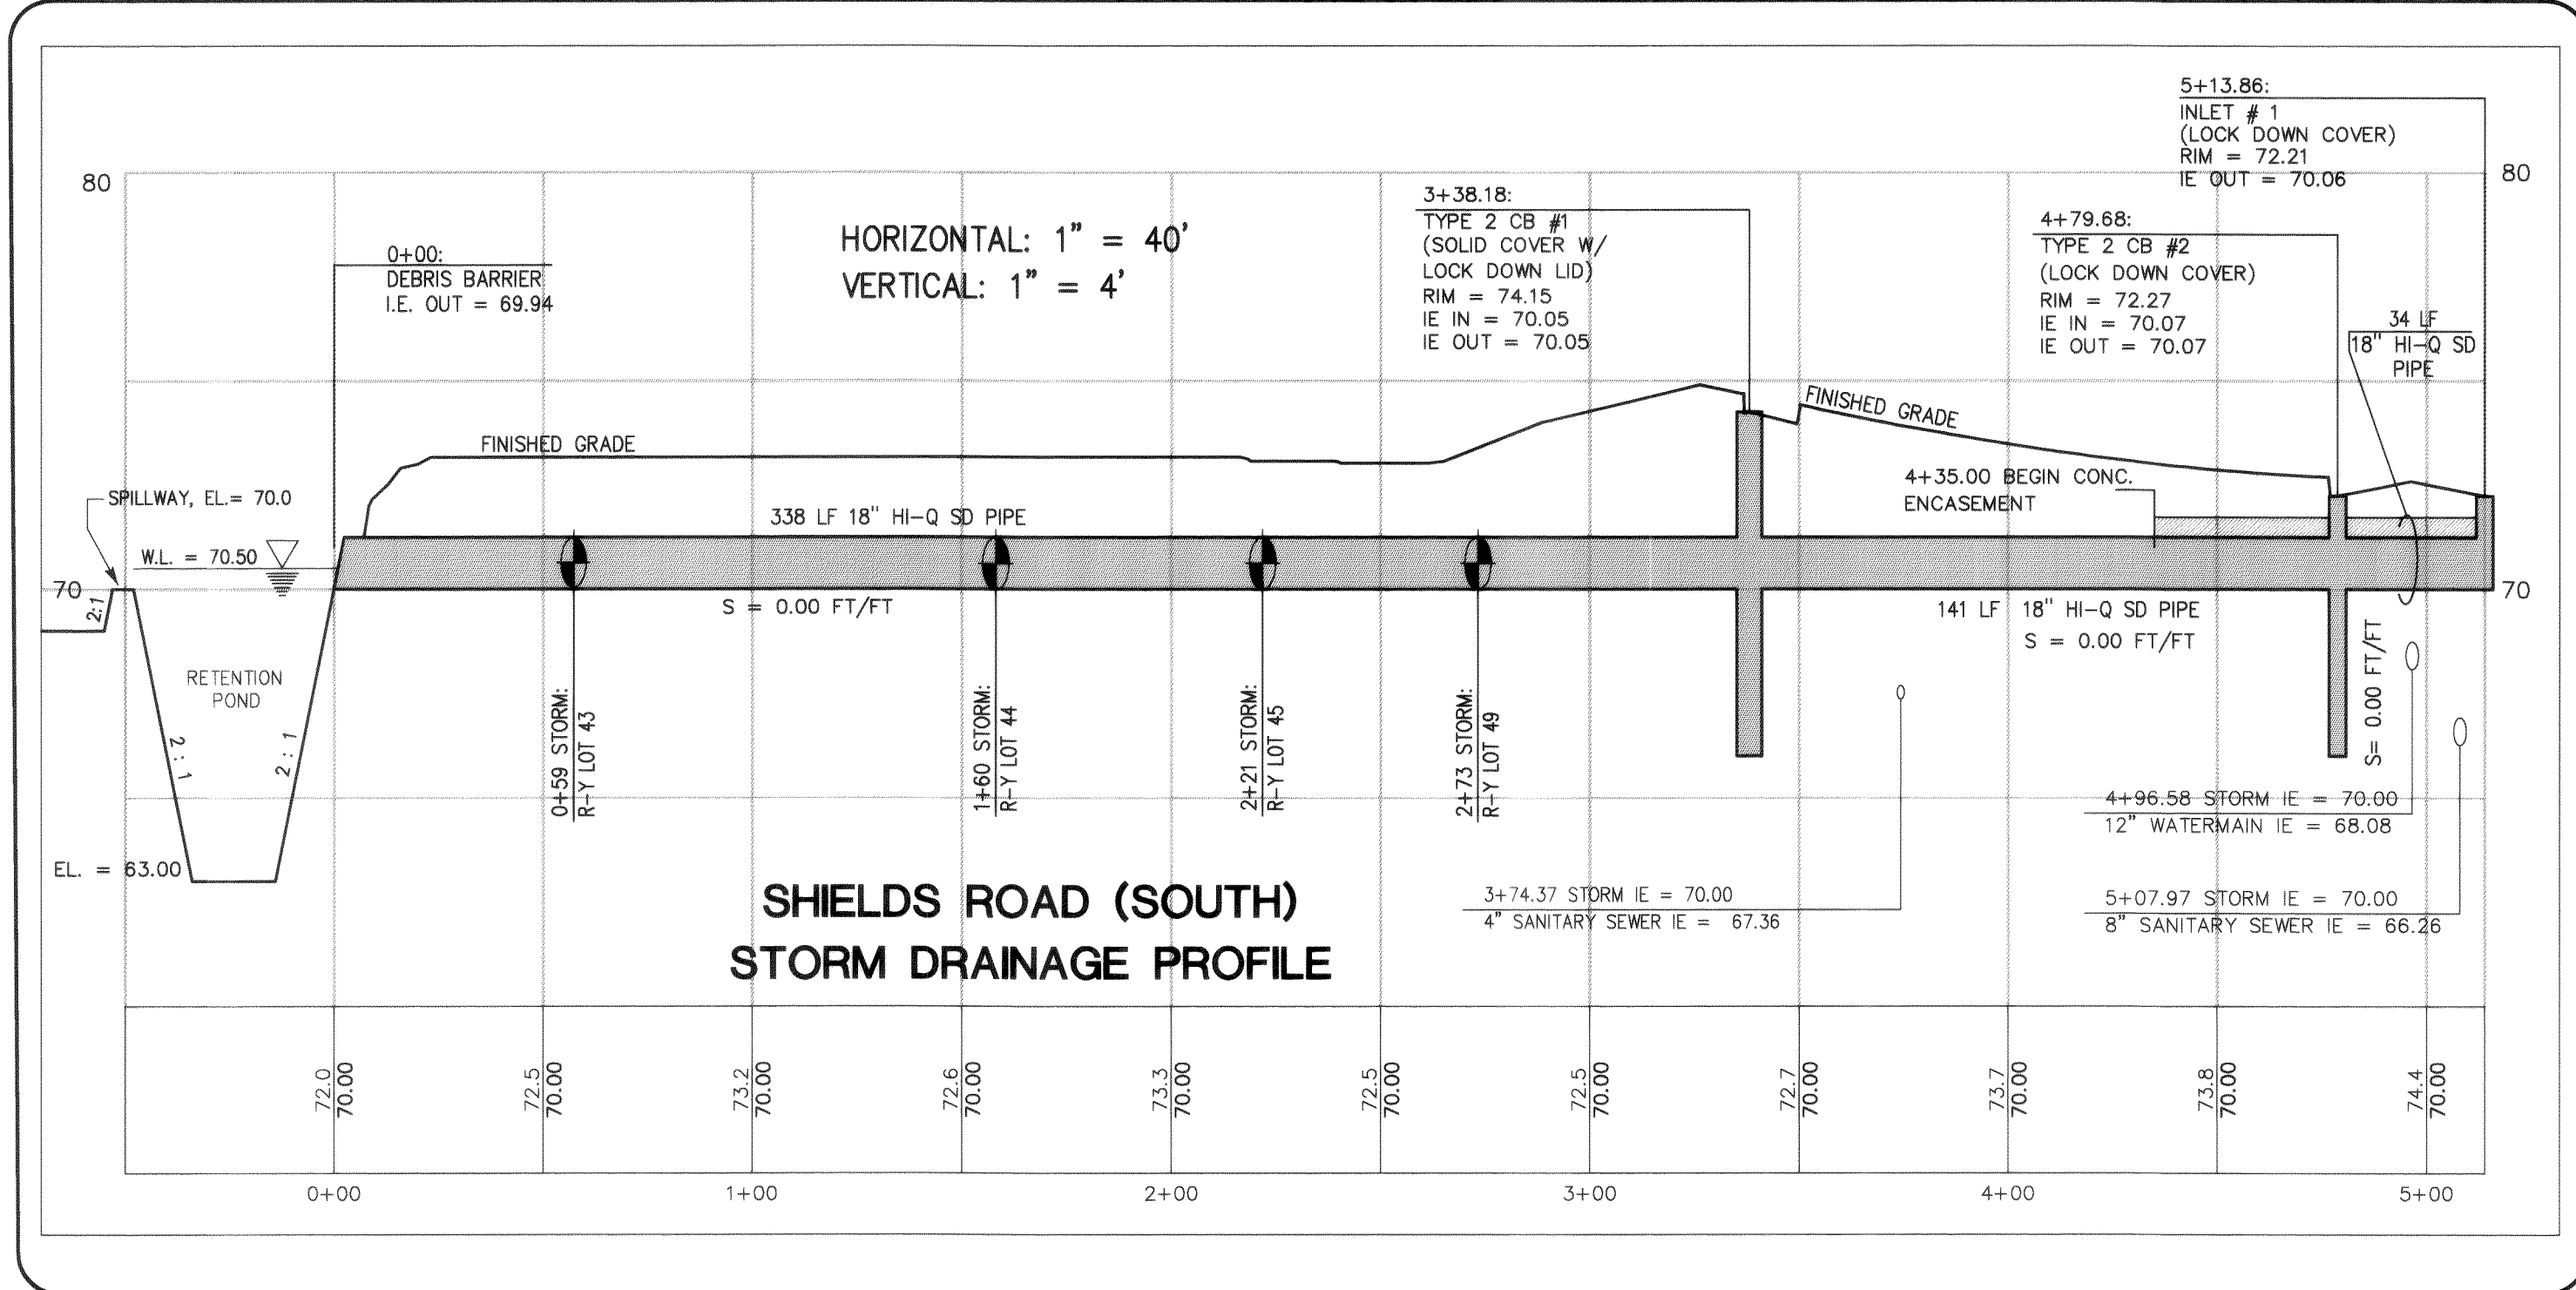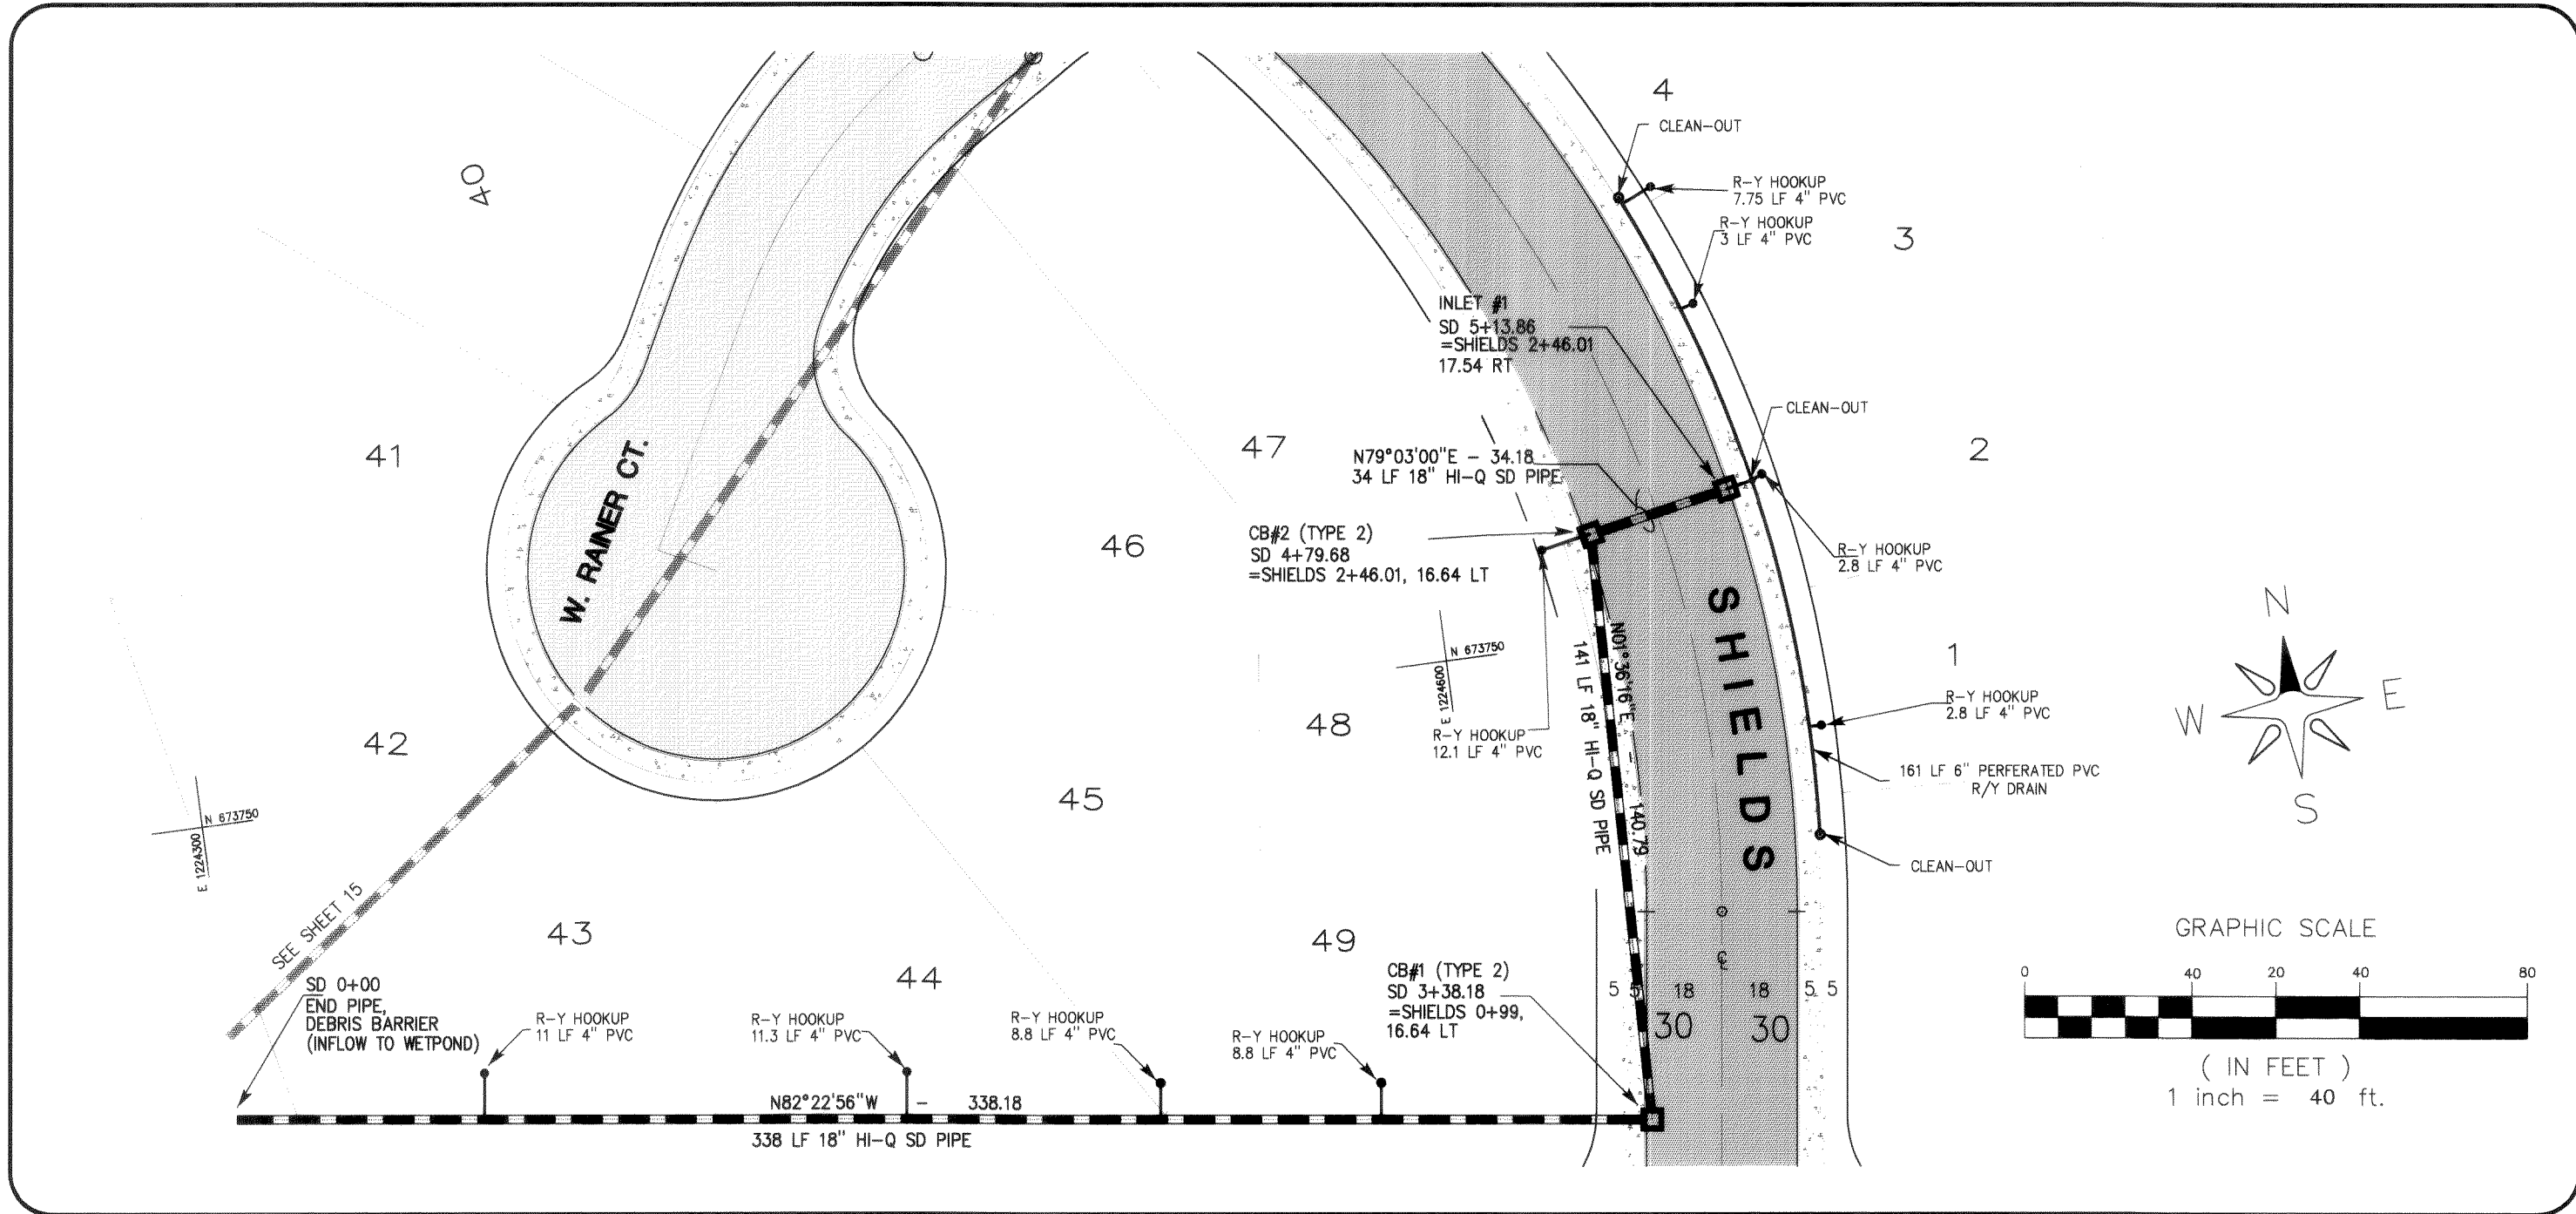

DRAWN BY _____ DATE _____
DRAWN BY _____ DATE _____
JOB # 97015

SHIELDS ESTATES
FOR:
TEITGE, WILLIAMS & McCOLLUM INVESTMENTS, INC.

PROFESSIONAL CERTIFICATION
I HEREBY CERTIFY THAT THIS PLAN ACCURATELY
DEPICTS THE MATERIALS, TYPES, AND LOCATIONS
OF THE IMPROVEMENTS SHOWN HEREON AS OF
THIS DATE.


HARRY P. JONES, PE
3-1-98
DATE

JONES ENGINEERS INCORPORATED, P.S.
CONSULTING ENGINEERS
851 COHO WAY, SUITE 307
BELLINGHAM, WA 98225 (360) 733-8888

AS-BUILT
SHIELDS ESTATES
STORM PLAN & PROFILE: SHIELDS ROAD (SOUTH)


DEPARTMENT OF PUBLIC WORKS
FERNDAL, WASHINGTON
APPROVED
This plan has been reviewed and found
to be in conformance with department
standards.
CITY ENGINEER _____ DATE _____

SHEET
14
OF
35

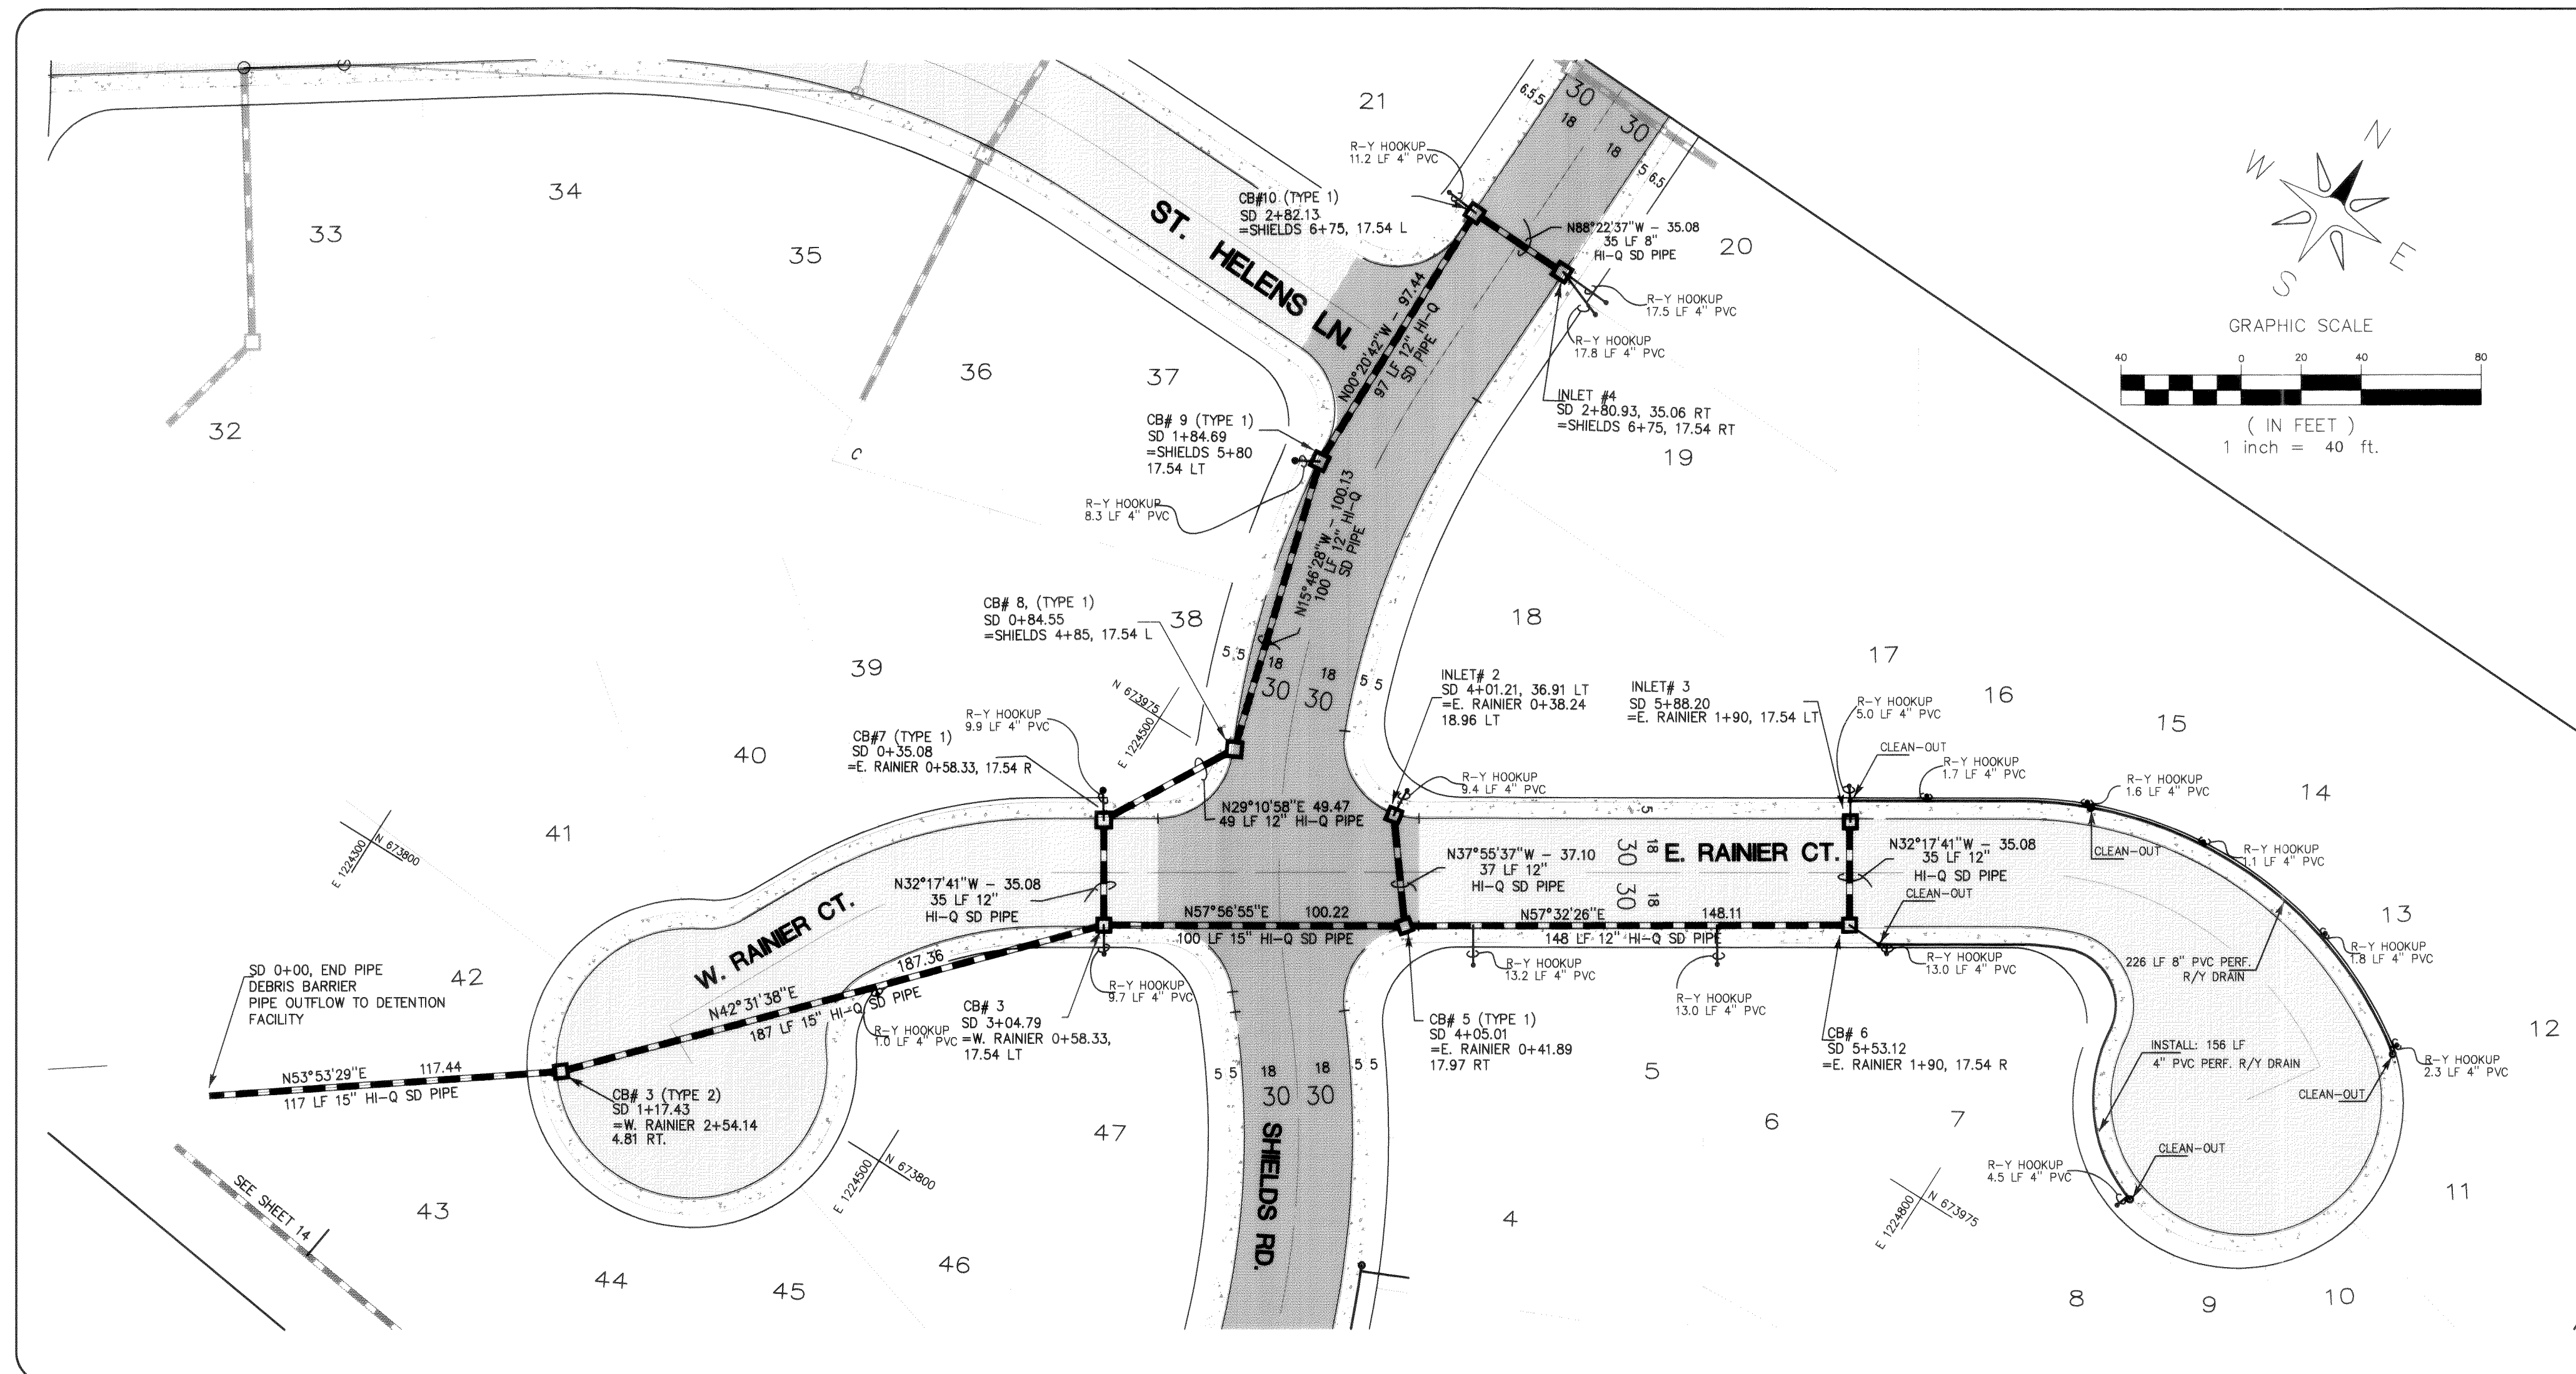

STORM DRAINAGE PLAN

JOB NO. 97015

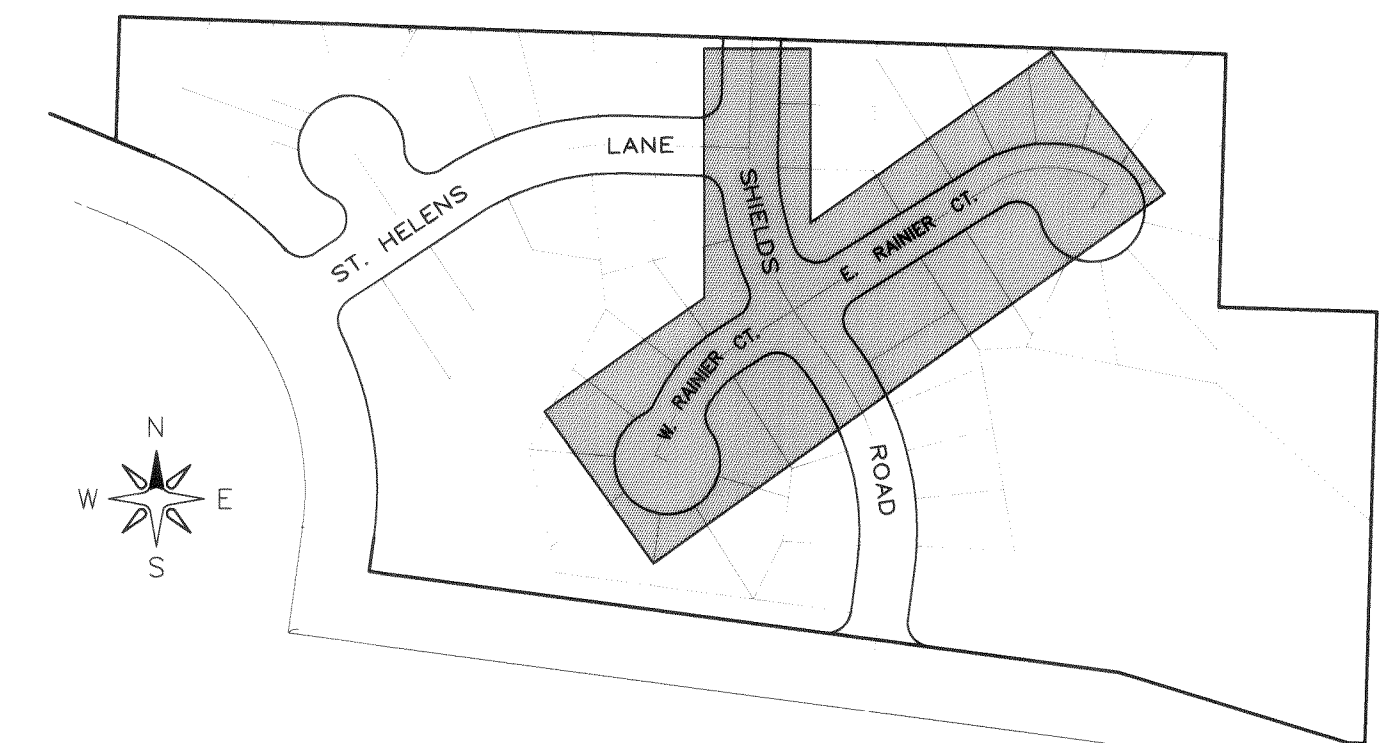

REVISIONS


NO	DATE	BY	NOTE
1.	6-18-97	A.K.	REVISE PER AGENCY REVIEW
2.			
3.			
4.			
5.			

CONTROL DATUM


HORIZONTAL: NAD83(91) WASHINGTON STATE LAMBERT GRID, NORTH ZONE
 POSITION: CASED MONUMENT (F-10), SOUTHEAST CORNER SEC. 28, T39N, R2E, W.M.
 Y: 675,433.53
 X: 1,226,474.60
 MERIDIAN: SOUTH LINE OF THE SOUTHEAST QUARTER OF SECTION 28, N88°22'49\"/>

LEGEND

	CENTERLINE		ADJACENT PROPERTY LOT NUMBER
	LOT LINES		EXISTING GROUND ELEVATION
	PROPERTY/ROW LINE		PIPE INVERT ELEVATION
	LIMITED ACCESS		ABBREVIATED LAMBERT GRID COORDINATES
	ESTIMATED ROCK		SIDEWALK
	EXISTING GROUND		PAVEMENT

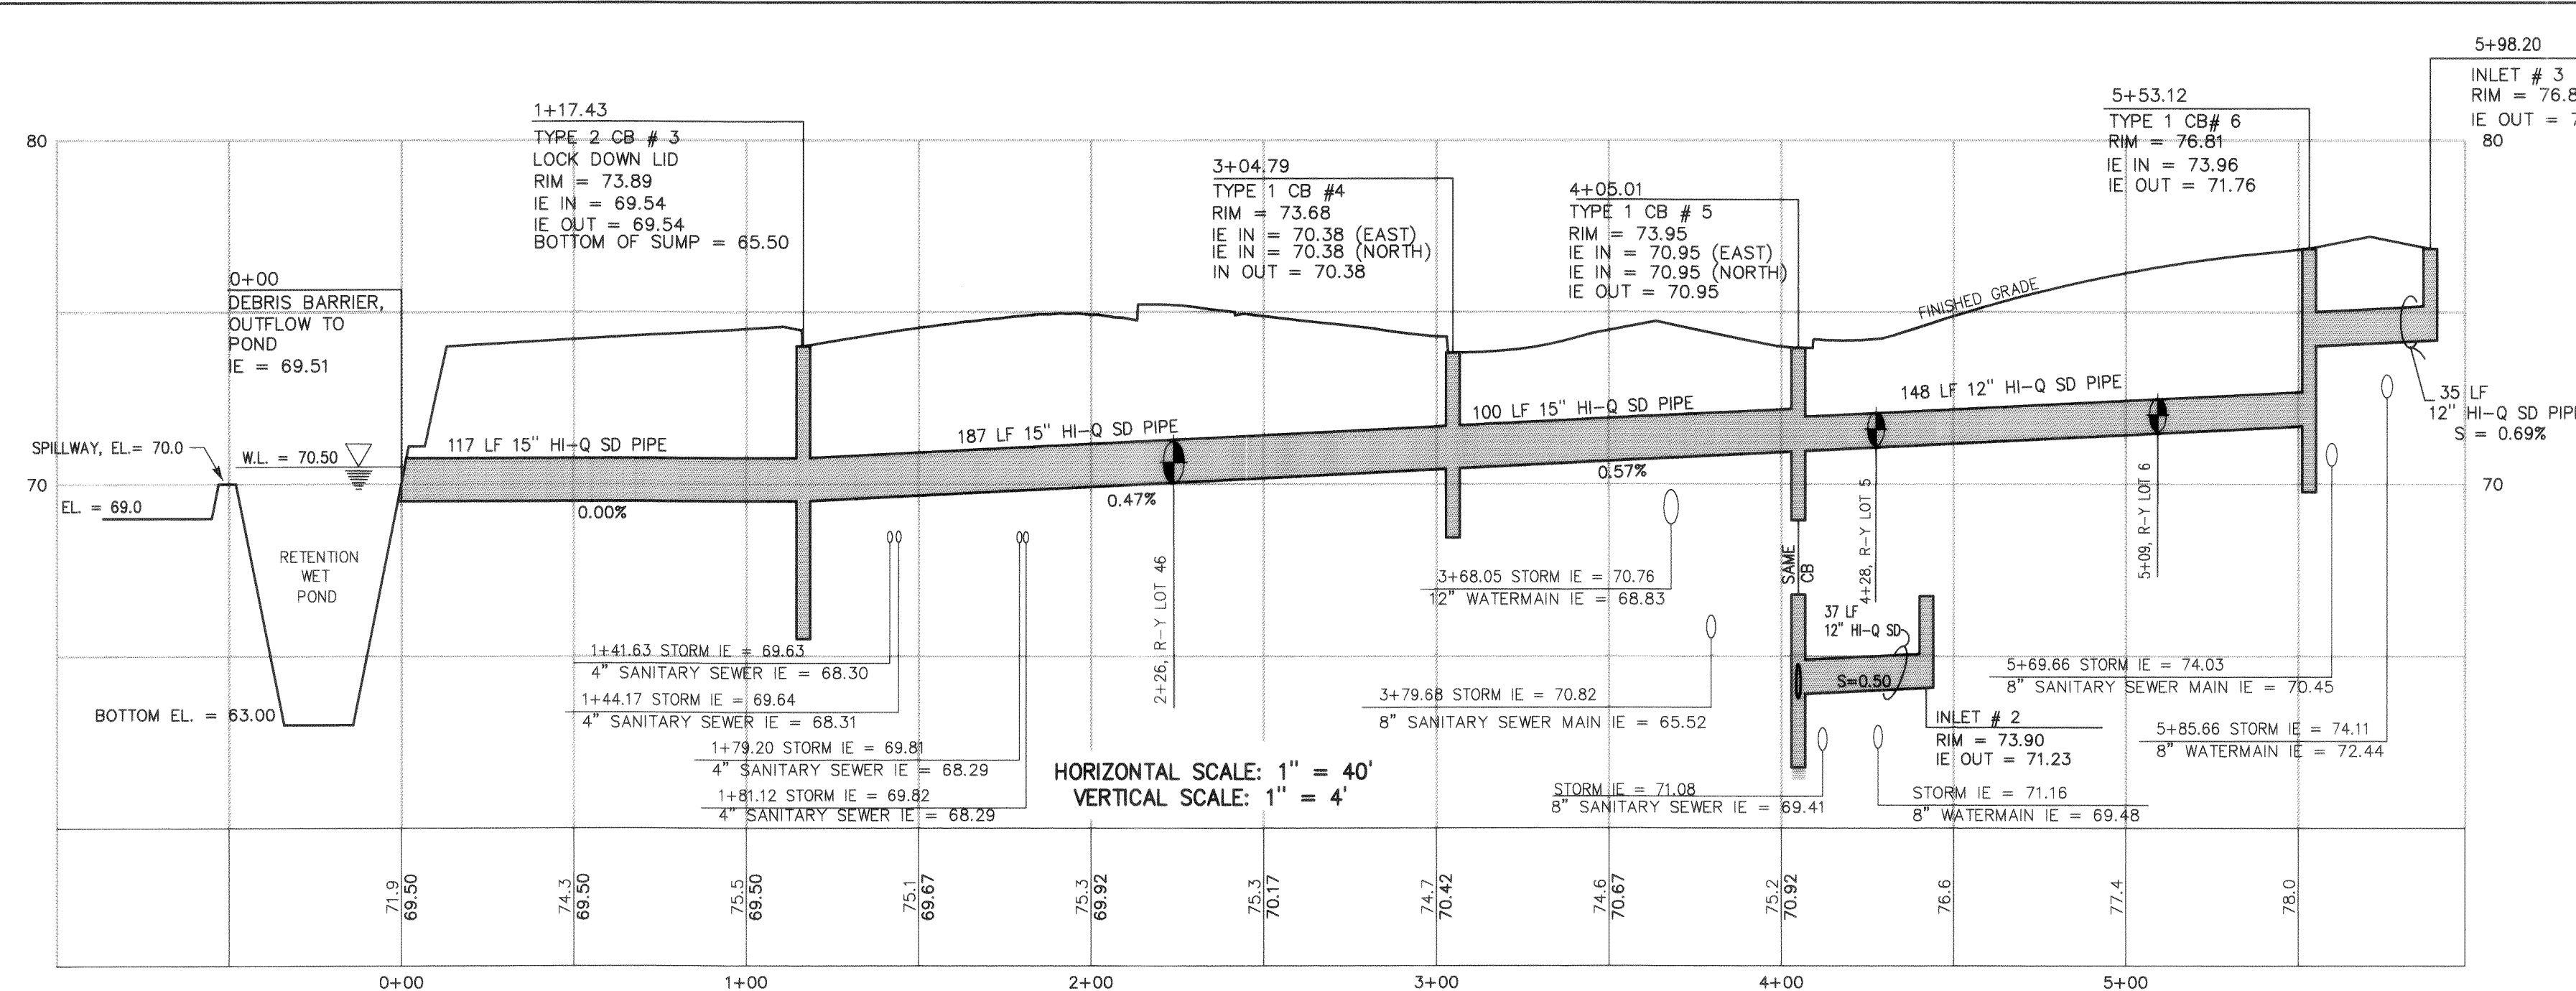

E. RAINIER & W. RAINIER STORM DRAINAGE PROFILE

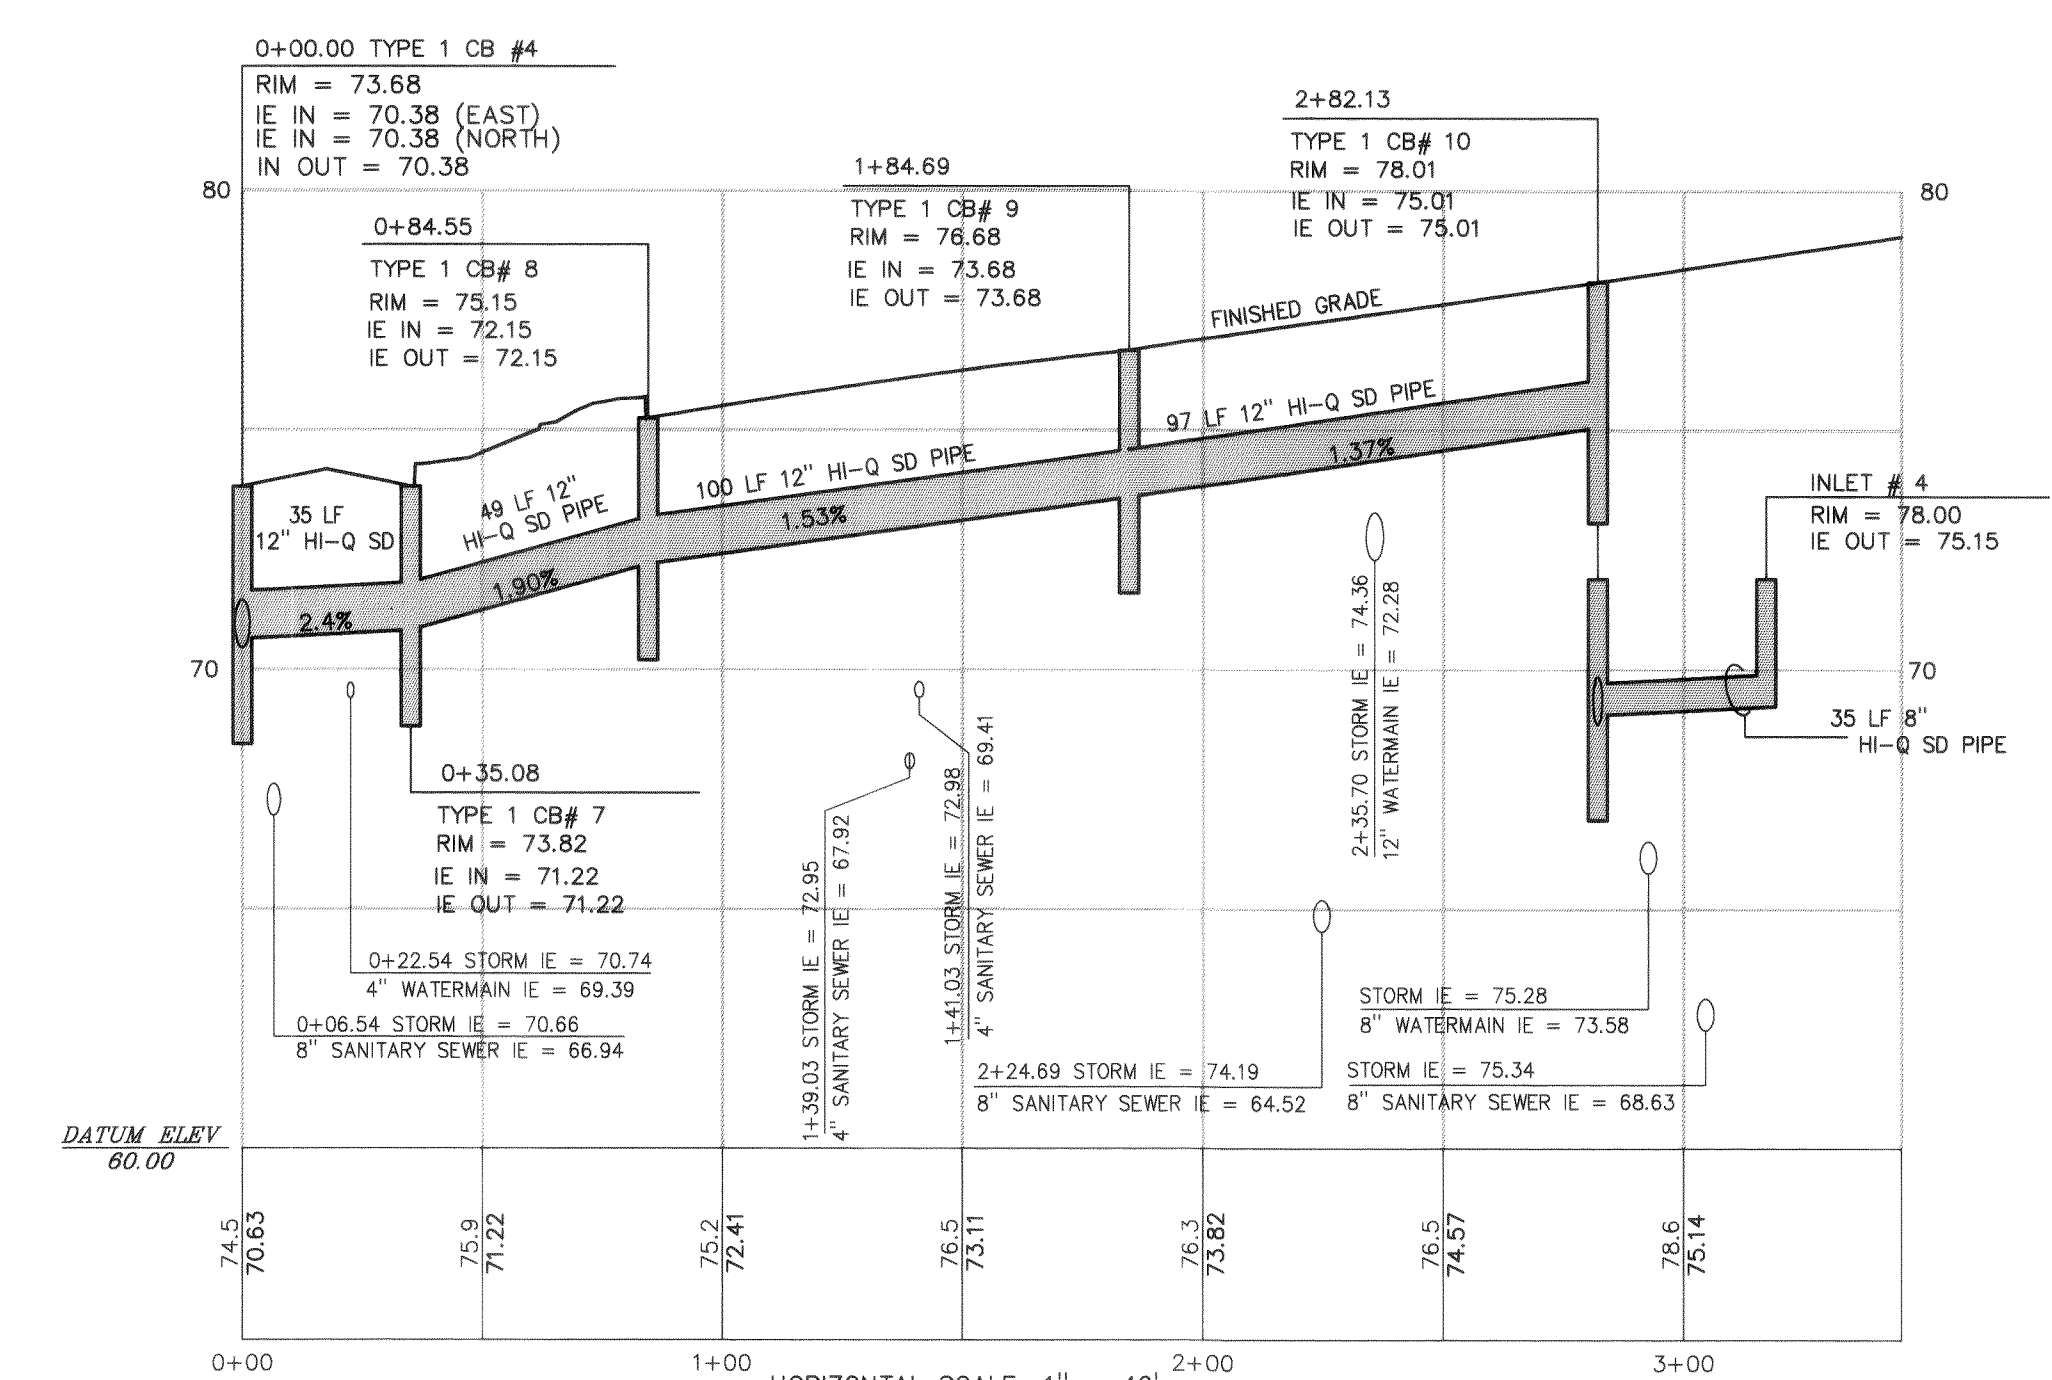

STORM DRAINAGE PROFILE SHIELDS ROAD (NORTH)

DRAWN BY _____ DATE _____

DRAWN BY _____ DATE _____

JOB # 97015


SHIELDS ESTATES

FOR:

TEITGE, WILLIAMS & McCOLLUM INVESTMENTS, INC.

PROFESSIONAL CERTIFICATION
 I HEREBY CERTIFY THAT THIS PLAN ACCURATELY
 DEPICTS THE MATERIALS, TYPES, AND LOCATIONS
 OF THE IMPROVEMENTS SHOWN HEREON AS OF
 THIS DATE.

HARRY P. JONES
 HARRY P. JONES, PE
 DATE _____

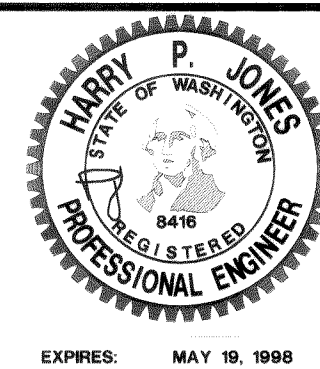

JONES ENGINEERS
 INCORPORATED, P.S.

CONSULTING ENGINEERS

851 COHO WAY, SUITE 307
 BELLINGHAM, WA 98225 (360) 733-8888

AS-BUILT

SHIELDS ESTATES

E. RAINIER & W. RAINIER STORM DRAINAGE PLAN & PROFILE

DEPARTMENT OF PUBLIC WORKS

FERDALE, WASHINGTON

APPROVED

This plan has been reviewed and found to
 be in conformance with department
 standards.



CITY ENGINEER _____ DATE _____

SHEET

15

OF 35

A PORTION OF THE SW 1/4 OF THE SE 1/4 OF SEC 28 TOWNSHIP 39 NORTH , RANGE 2 EAST , W.M.

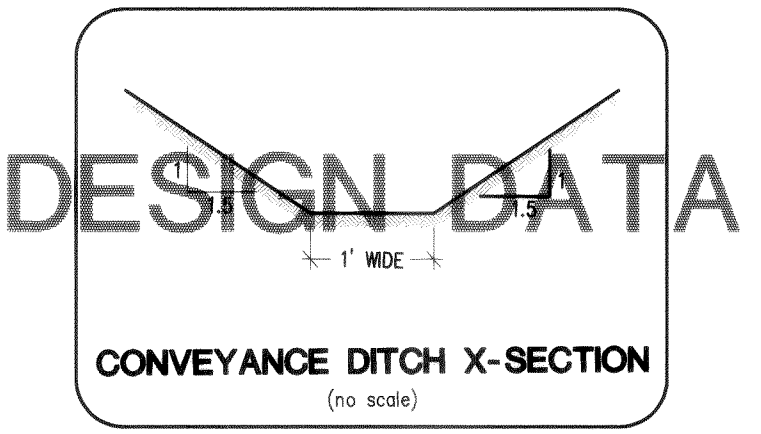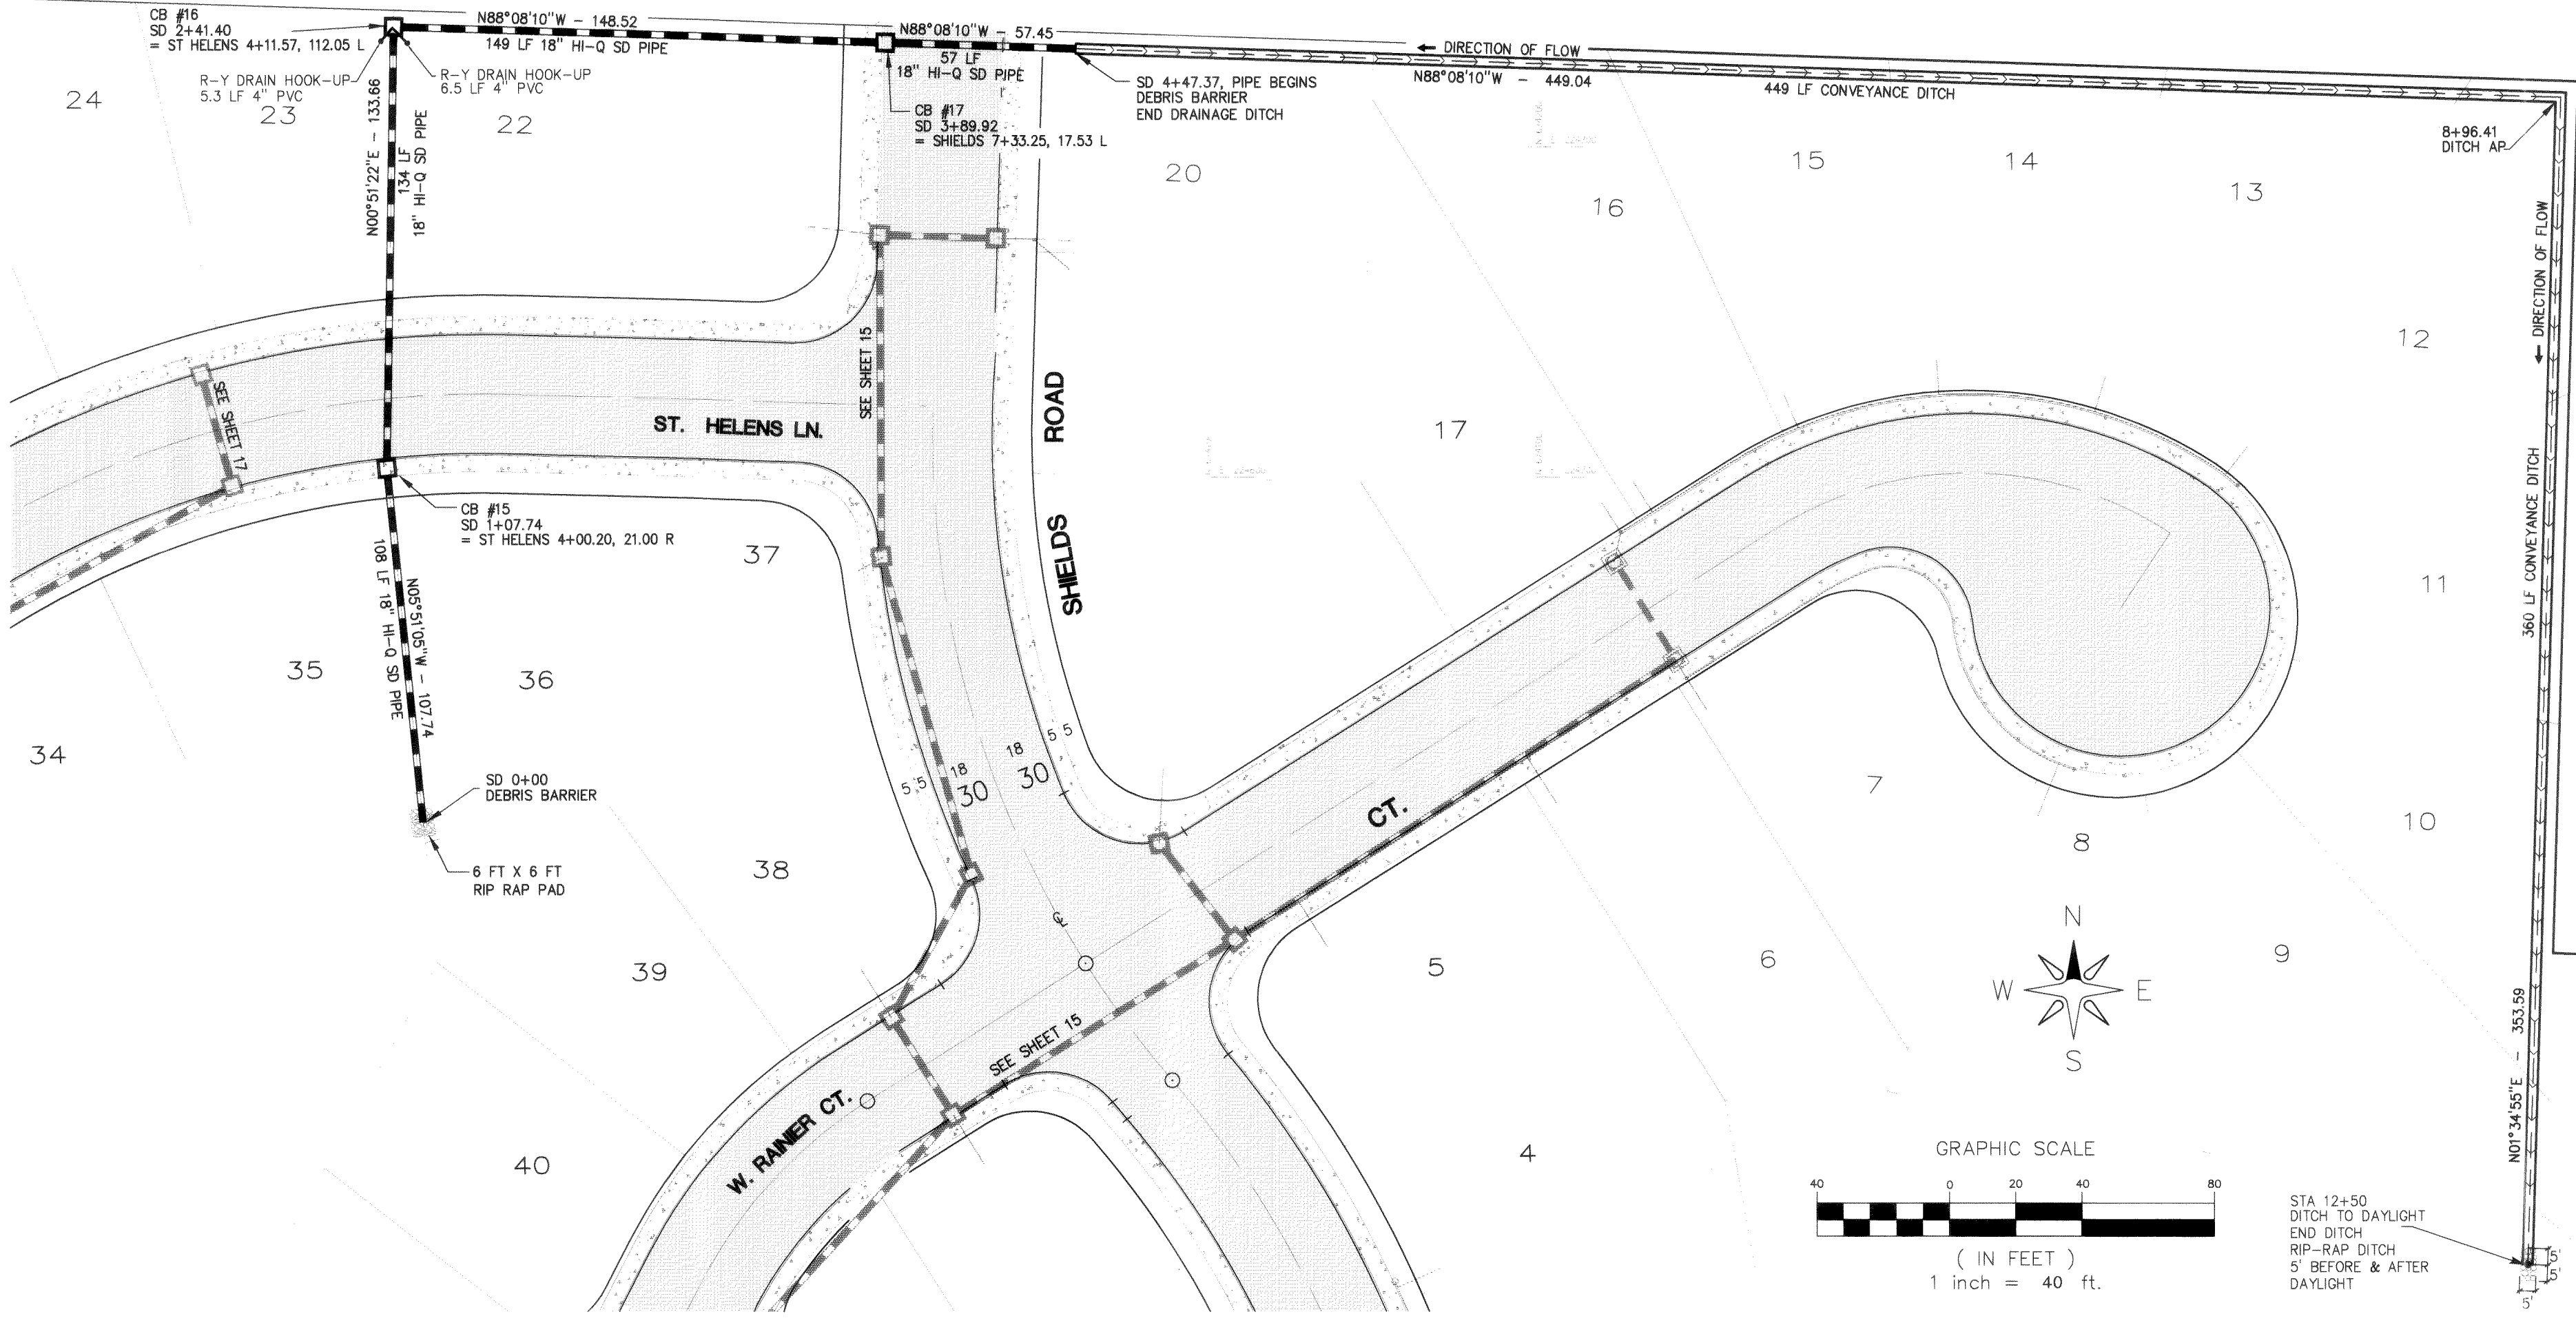


STORM DRAINAGE PLAN
JOB NO. 97015

REVISIONS			
NO	DATE	BY	NOTE
1.			
2.			
3.			
4.			
5.			

CONTROL DATUM
HORIZONTAL: NAD83(91) WASHINGTON STATE LAMBERT GRID, NORTH ZONE
POSITION: CASED MONUMENT (F-10), SOUTHEAST CORNER SEC. 28, T39N, R2E, W.M.
Y: 673,433.53
X: 1,226,474.60
MERIDIAN: SOUTH LINE OF THE SOUTHEAST QUARTER OF SECTION 28, N88°22'49\"/>

LEGEND

	CENTERLINE		ADJACENT PROPERTY LOT NUMBER
	LOT LINES		EXISTING GROUND ELEVATION
	PROPERTY/ROW LINE		PIPE INVERT ELEVATION
	LIMITED ACCESS		ABBREVIATED LAMBERT GRID COORDINATES
	ESTIMATED ROCK		SIDEWALK
	EXISTING GROUND		PAVEMENT
	4\"/>		LOT NUMBER
	CATCH BASIN or INLET		
	CLEAN-OUT		
	J-BOX		
	STORM SEWER PIPE		

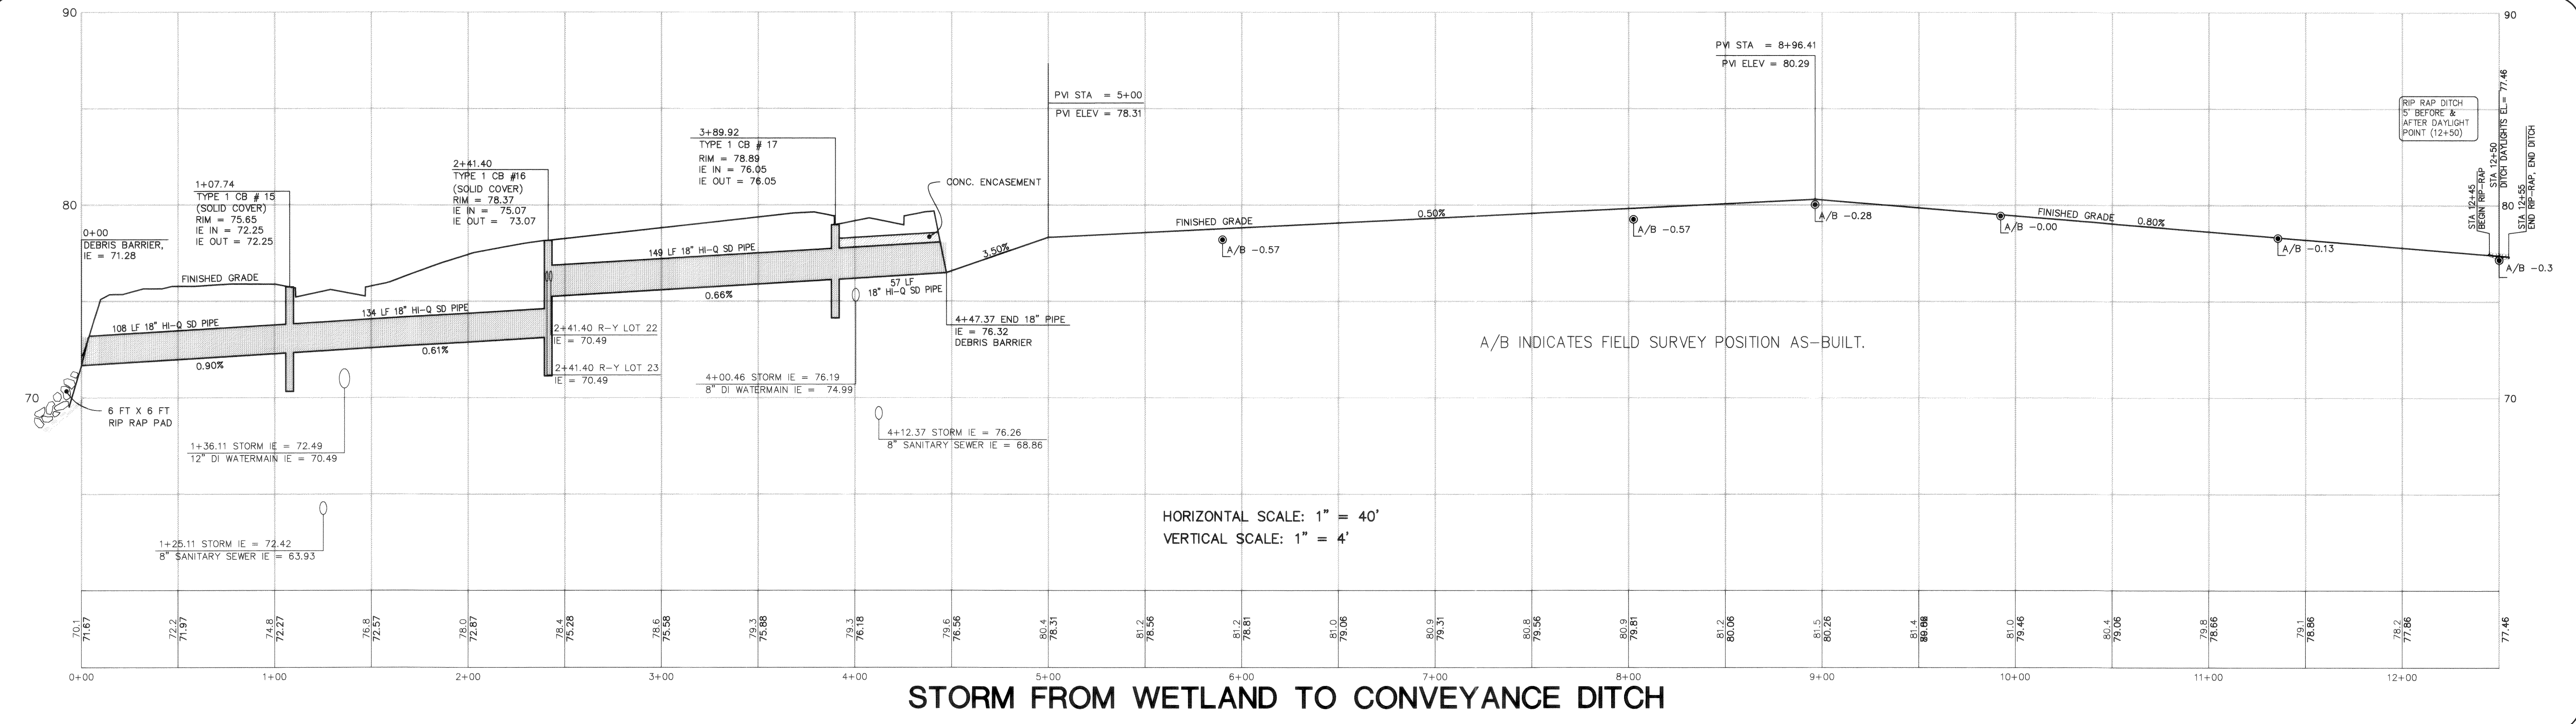

DRAWN BY _____ DATE _____
JOB # 97015

SHIELDS ESTATES
FOR:
TEITGE, WILLIAMS & McCOLLUM INVESTMENTS, INC.

PROFESSIONAL CERTIFICATION
I HEREBY CERTIFY THAT THIS PLAN ACCURATELY DEPICTS THE MATERIALS, TYPES, AND LOCATIONS OF THE IMPROVEMENTS SHOWN HEREON AS OF THIS DATE.

HARRY P. JONES, PE
DATE _____

EXPIRES: MAY 19, 1998

JONES ENGINEERS INCORPORATED, P.S.
CONSULTING ENGINEERS
851 COHO WAY, SUITE 307
BELLINGHAM, WA 98225 (360) 733-8888

AS-BUILT
SHIELDS ESTATES
100 YR CONVEYANCE DITCH PLAN AND PROFILE






DEPARTMENT OF PUBLIC WORKS
FERDALE, WASHINGTON
APPROVED
This plan has been reviewed and found to be in conformance with department standards.
CITY ENGINEER _____ DATE _____

SHEET
16
OF
35

E:\97015\AB-51M3 Wed Apr 08 17:29:50 1998 DALE BUYS

00226.007 2.16.06 KZ

A PORTION OF THE SW 1/4 OF THE SE 1/4 OF SEC 28 TOWNSHIP 39 NORTH , RANGE 2 EAST , W.M.

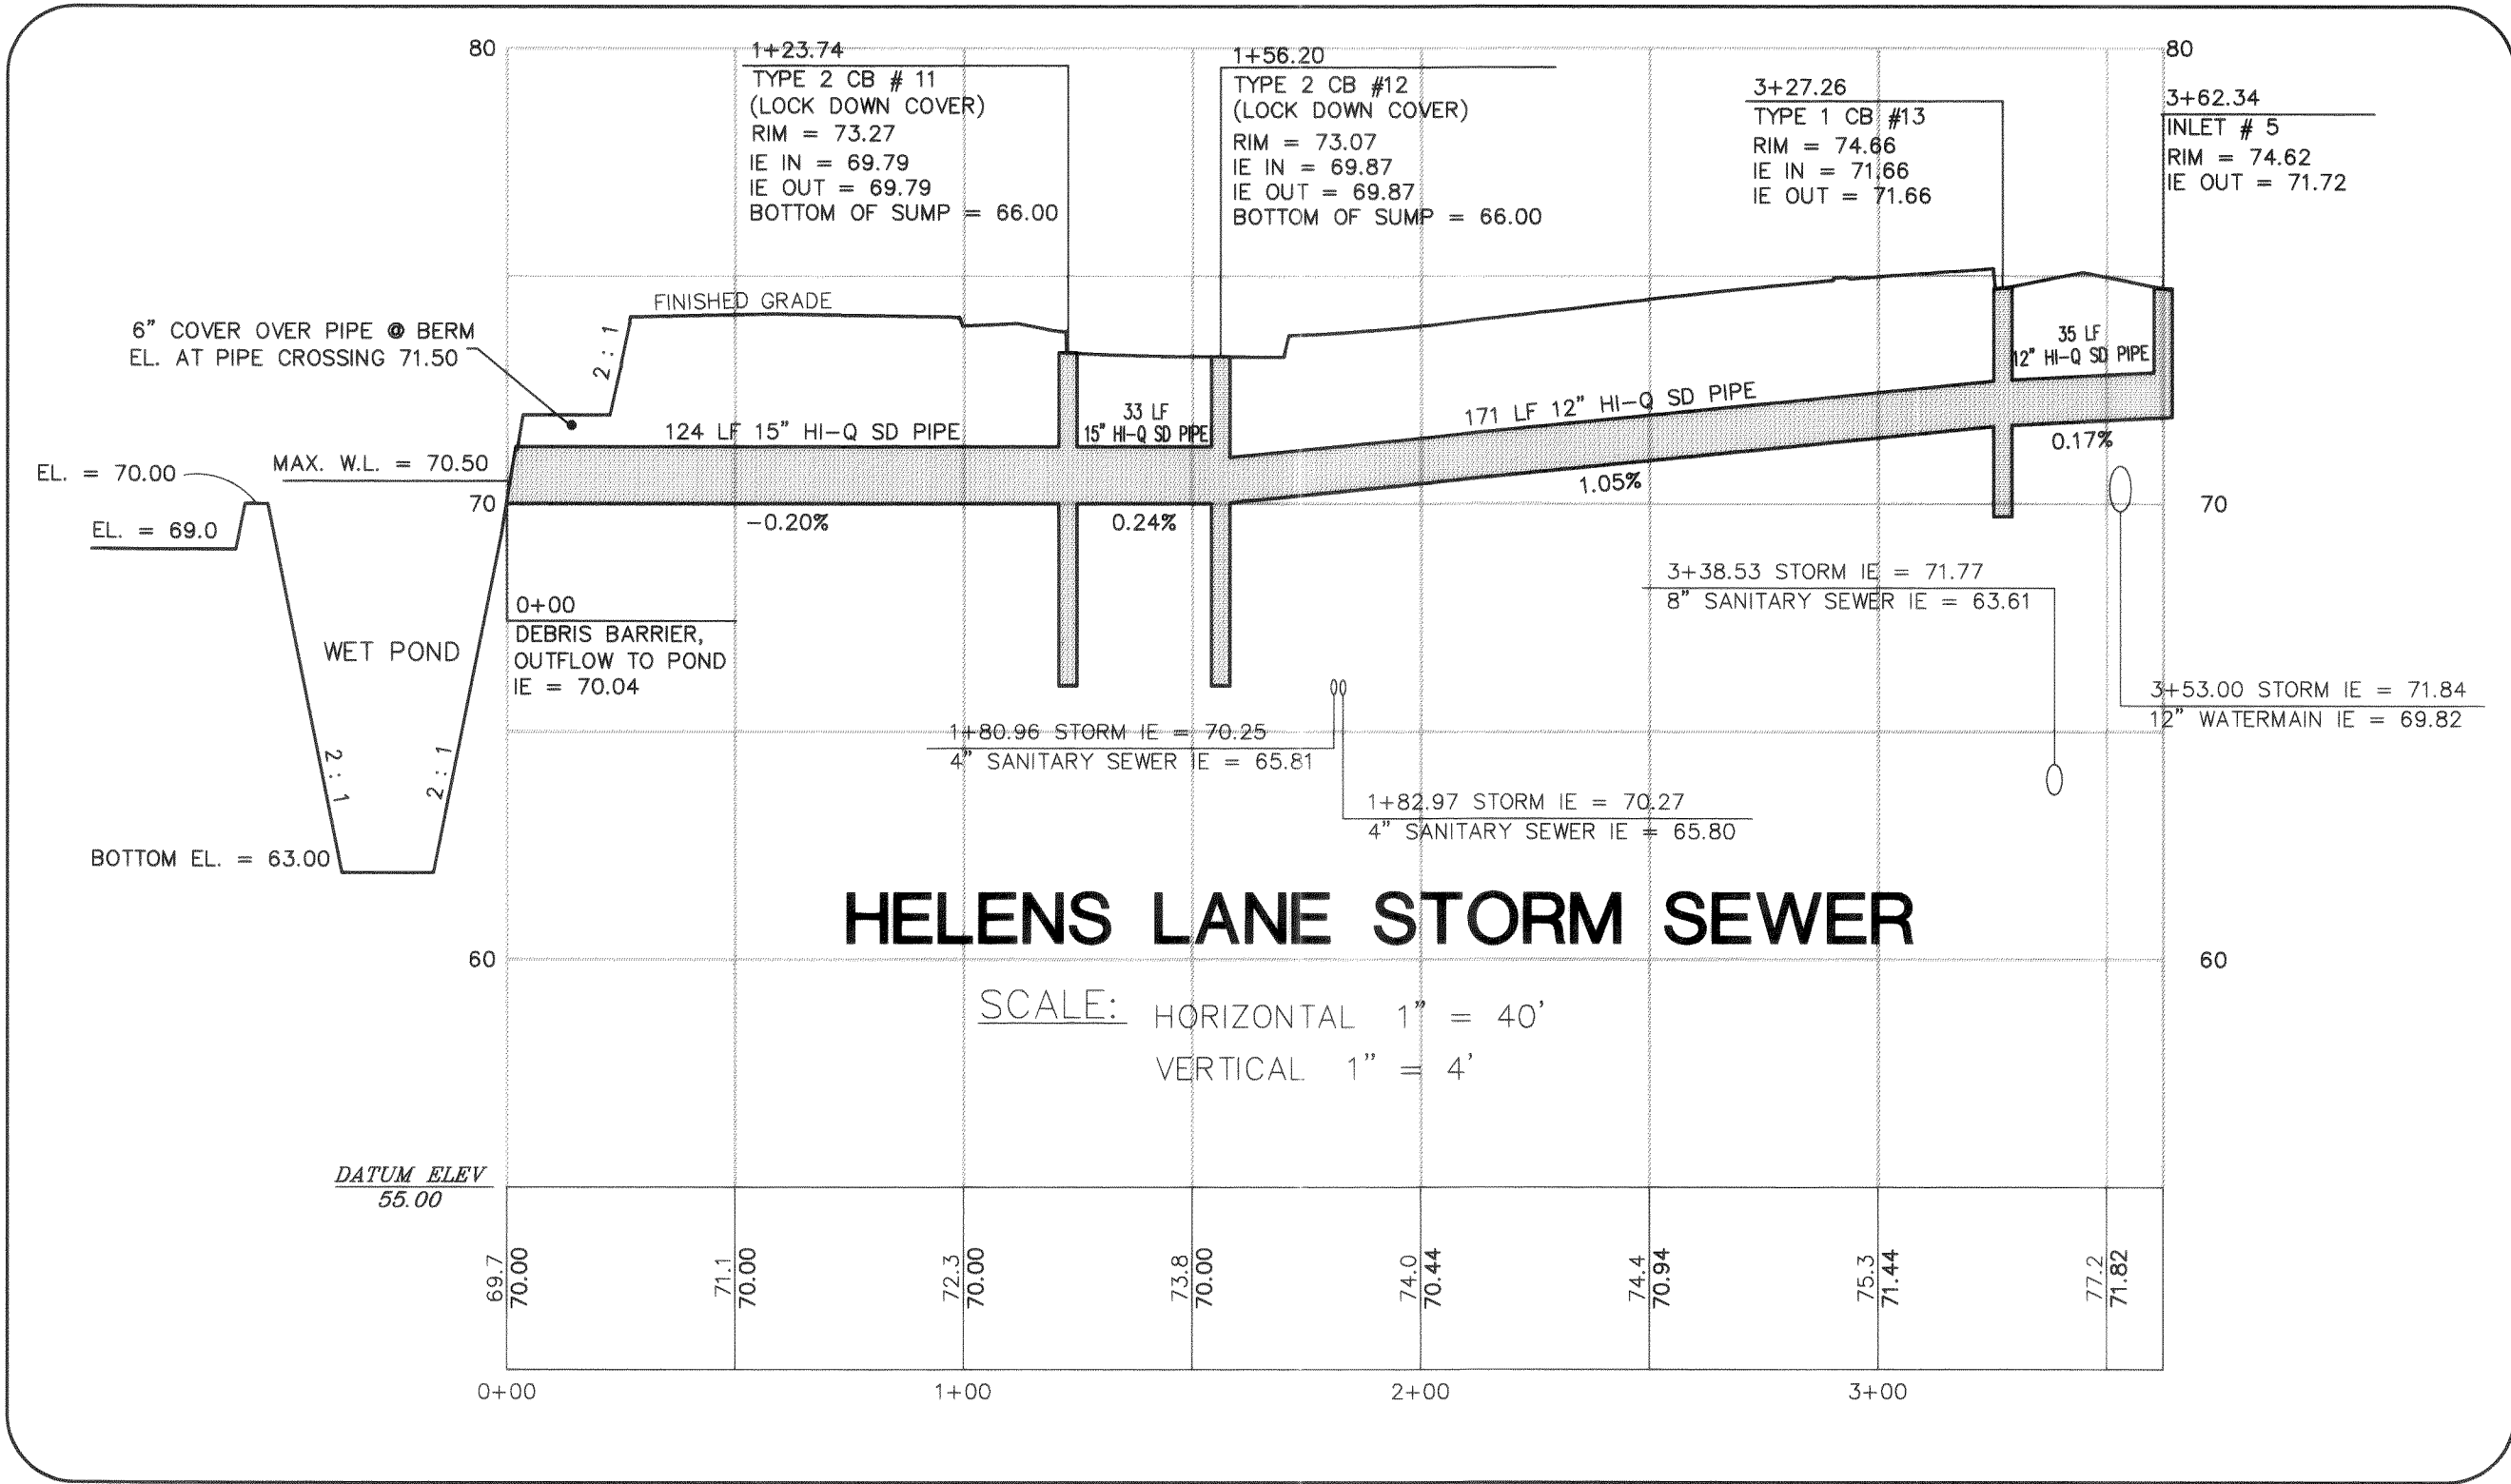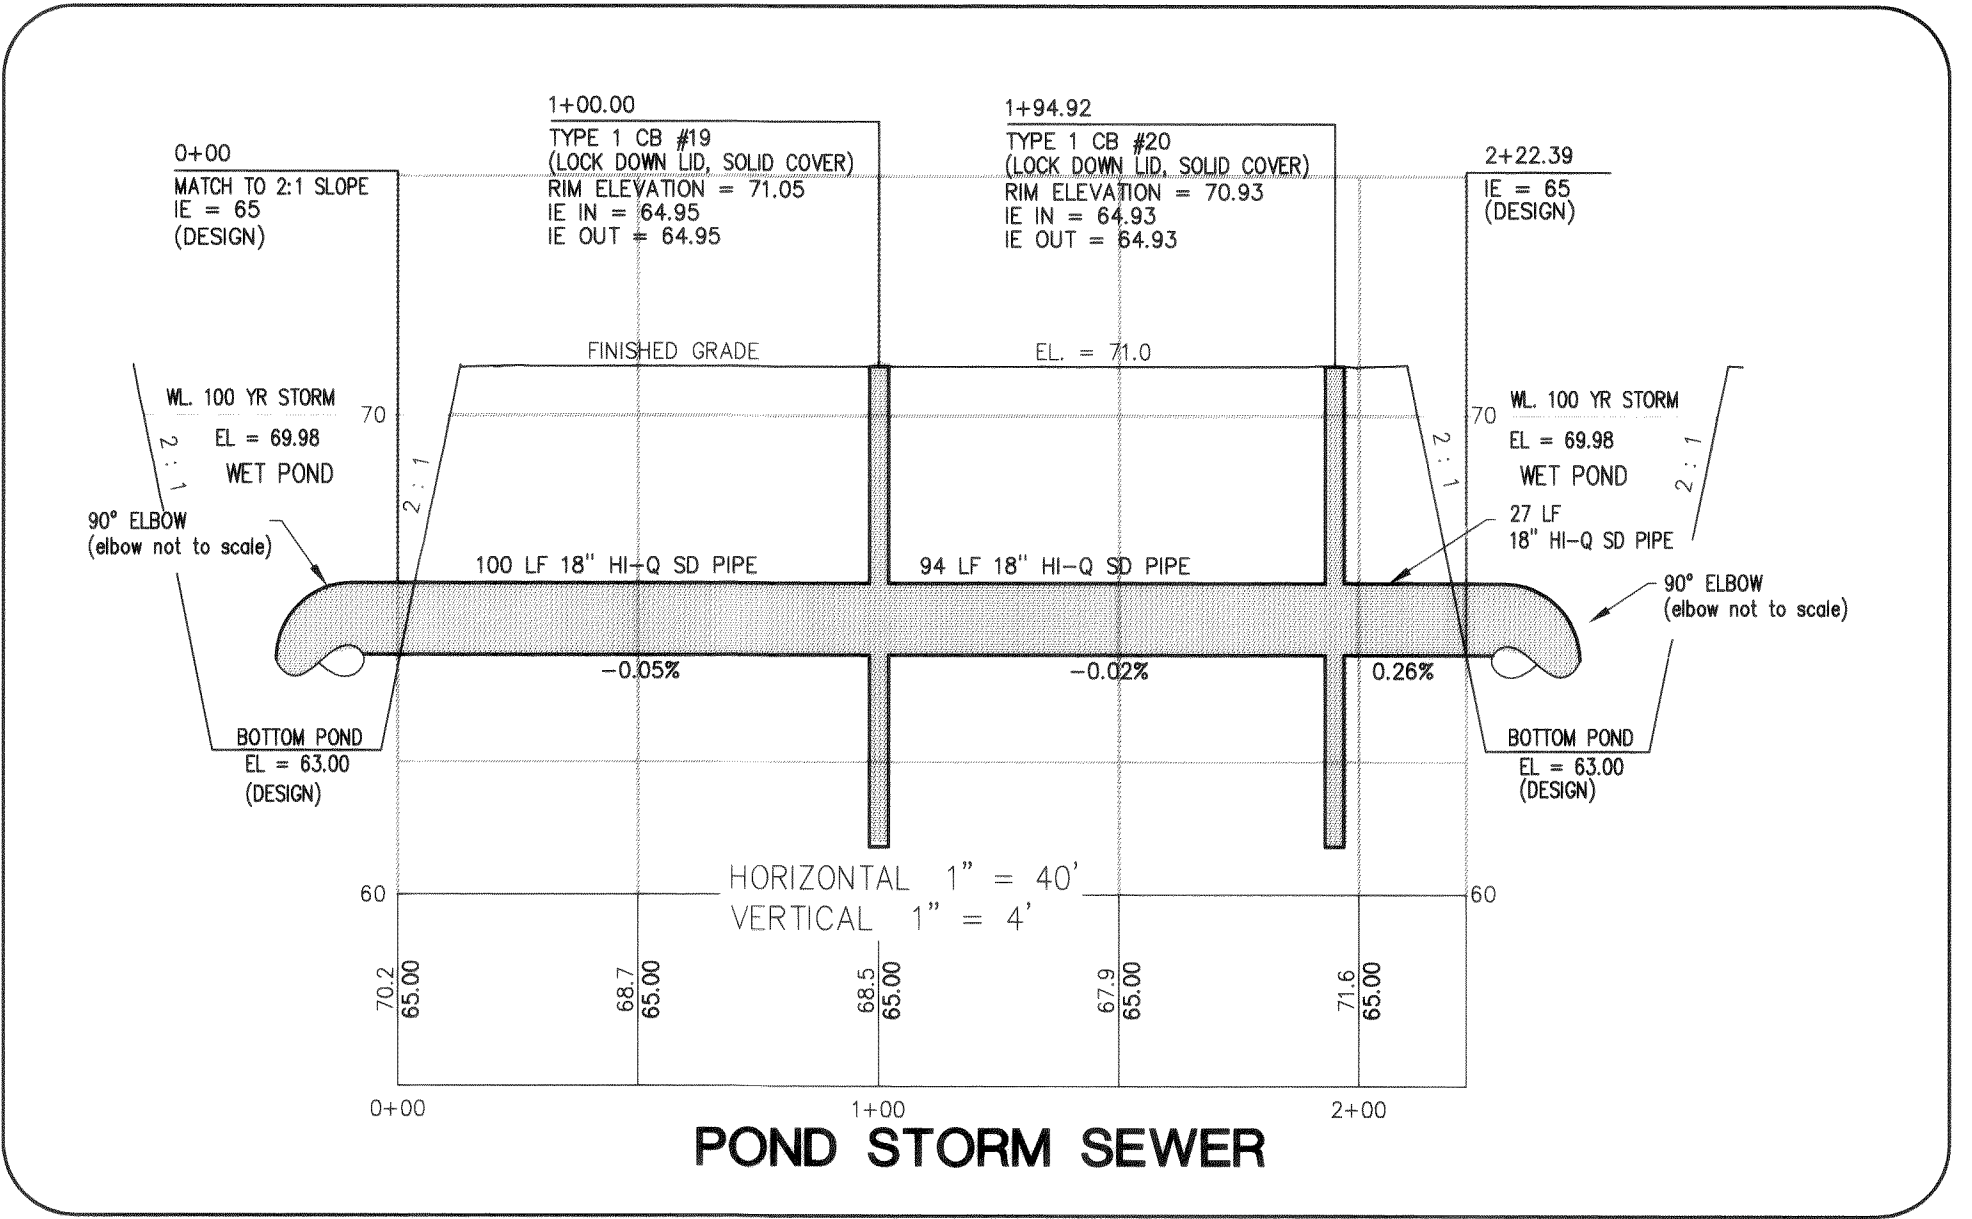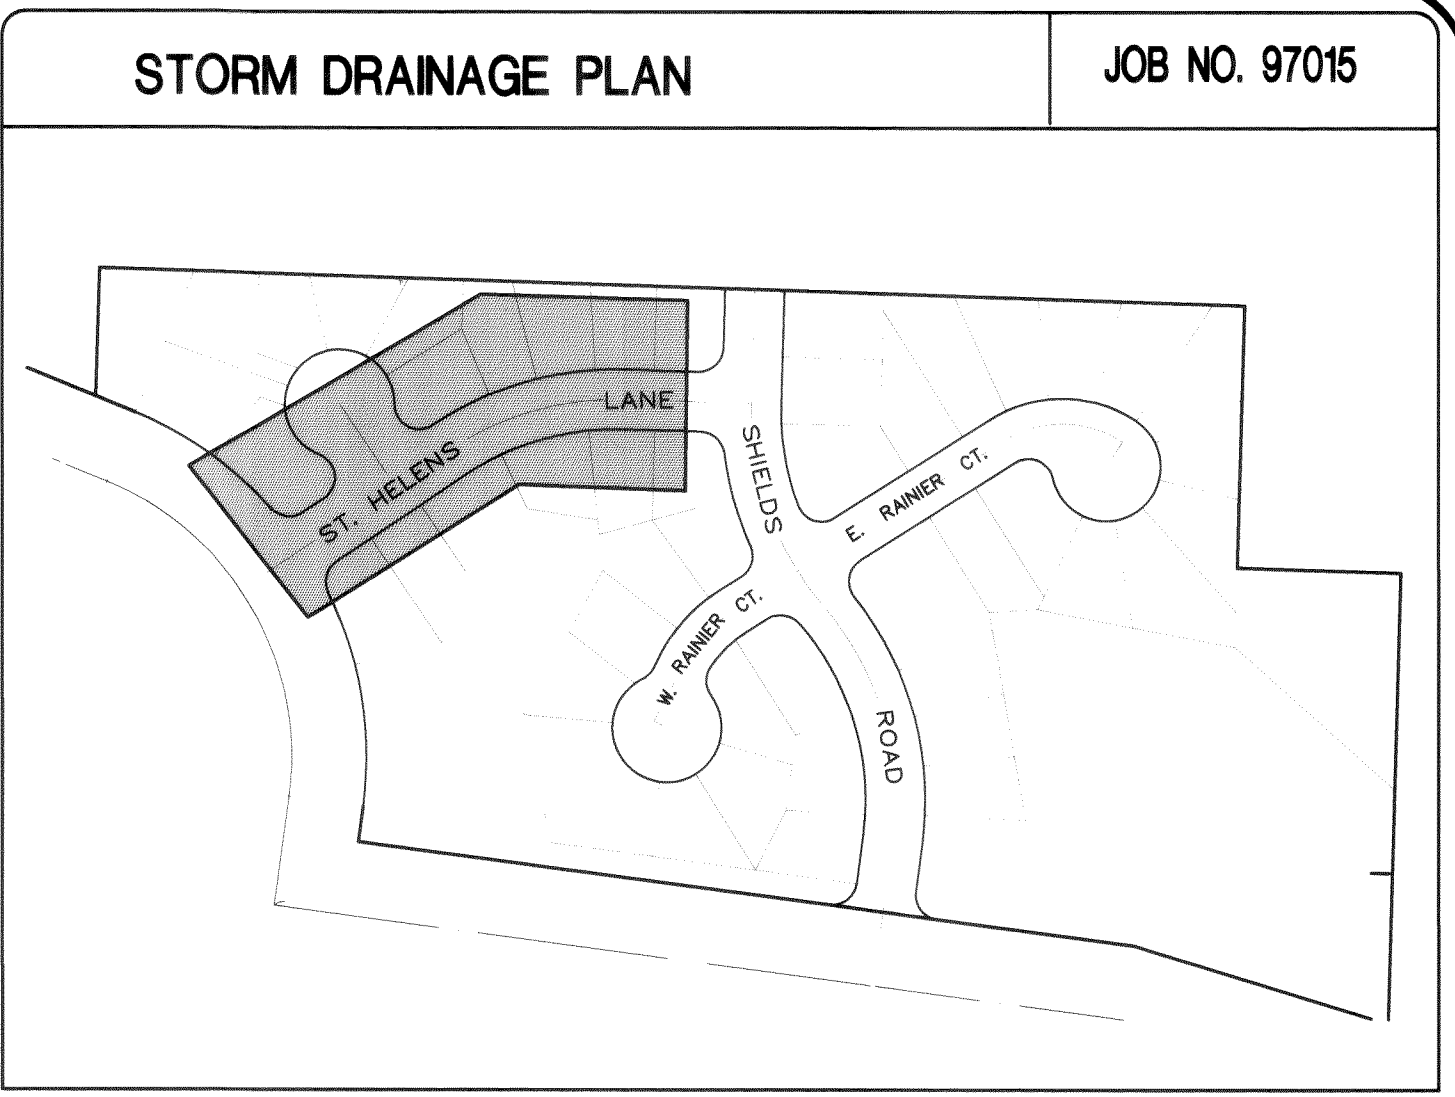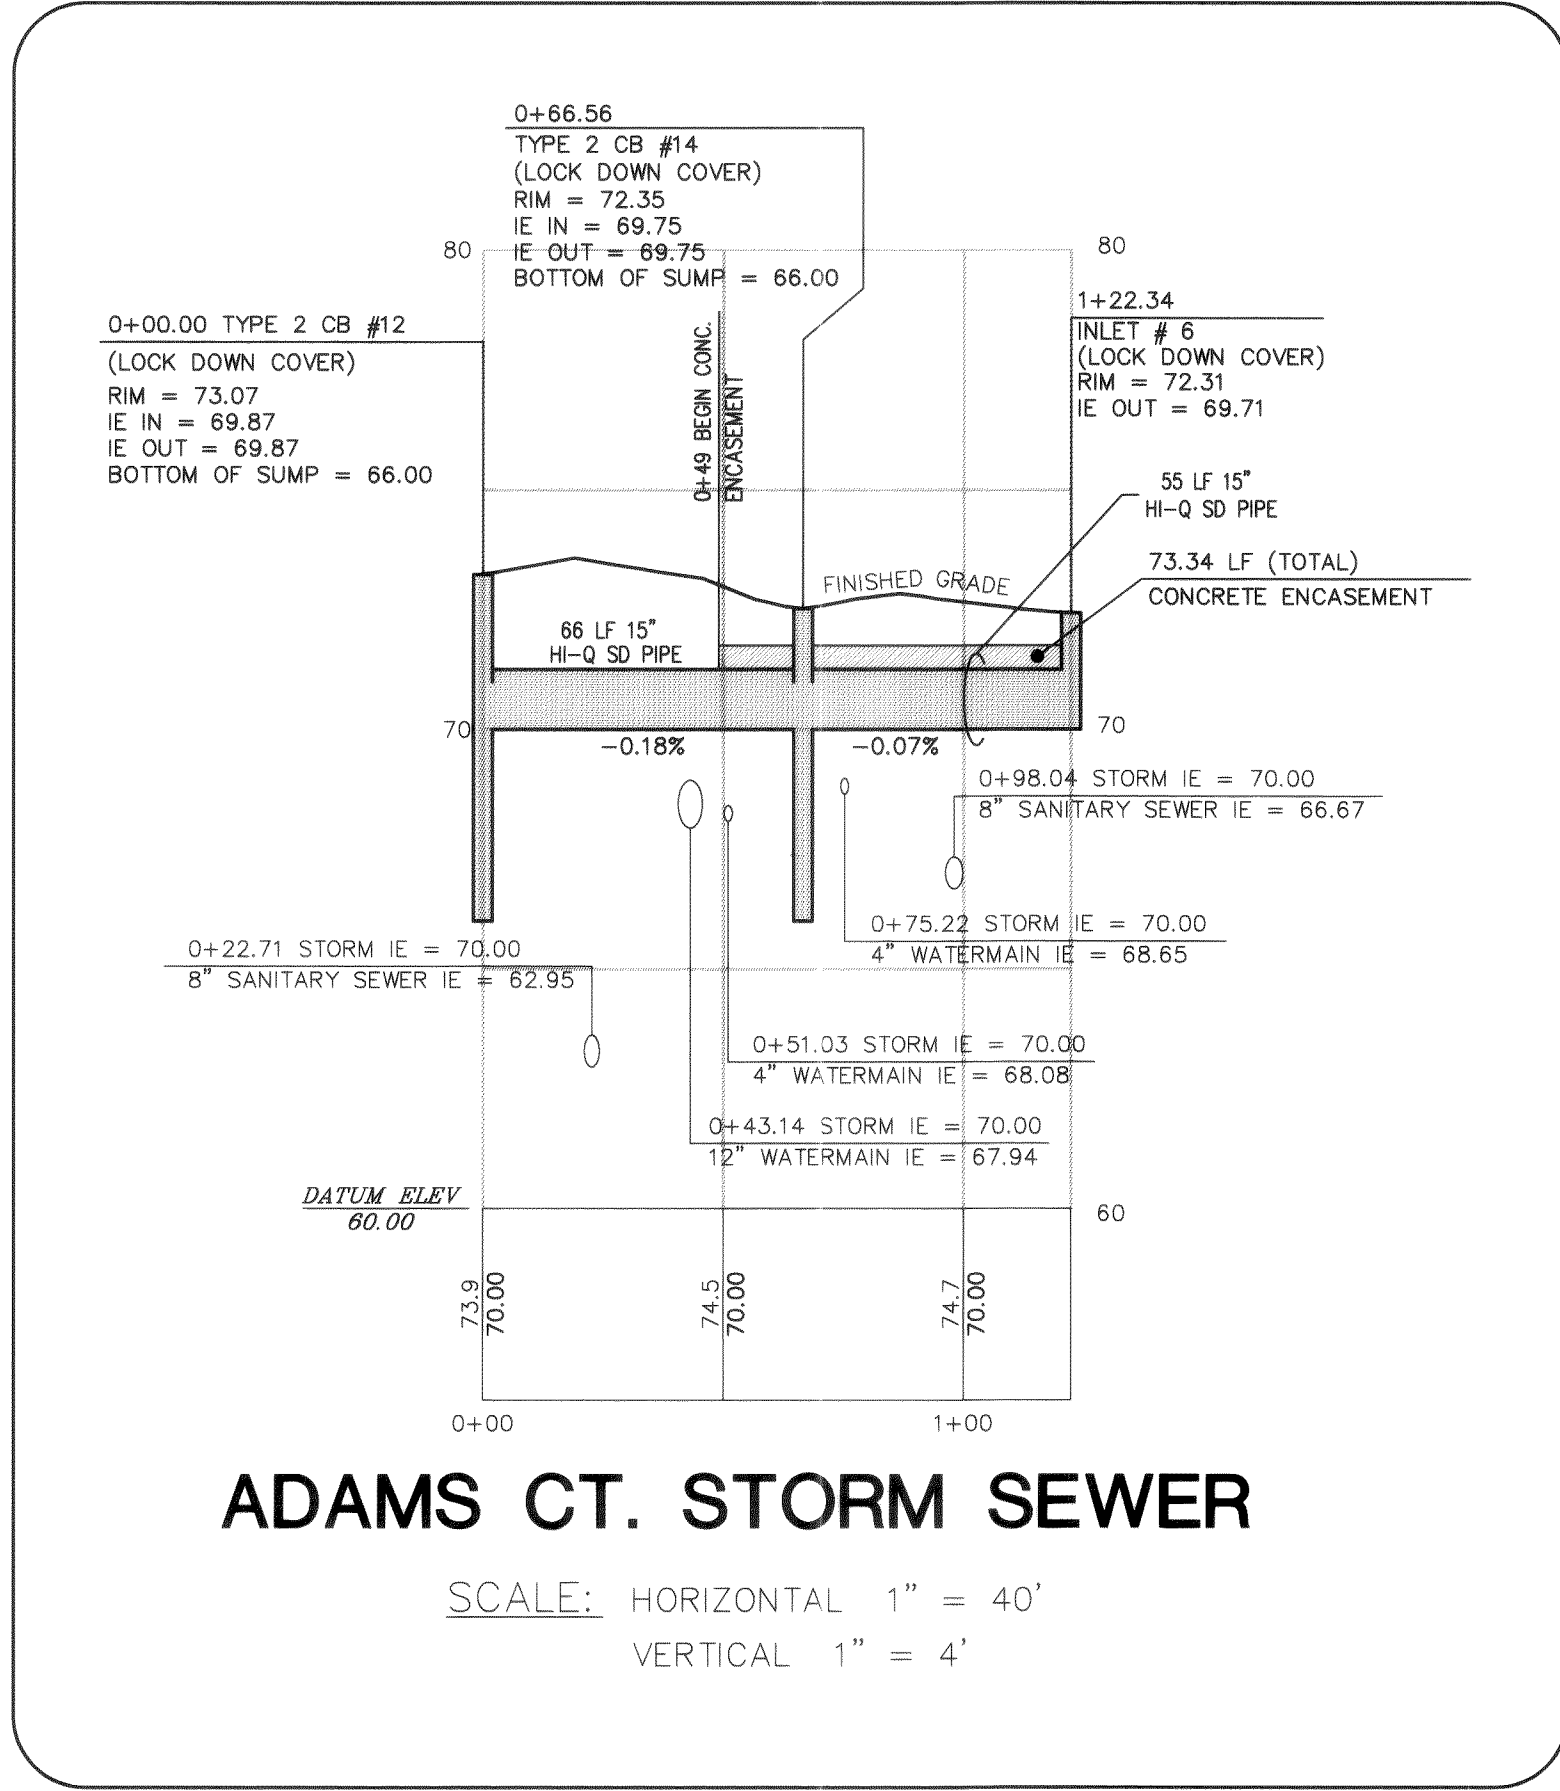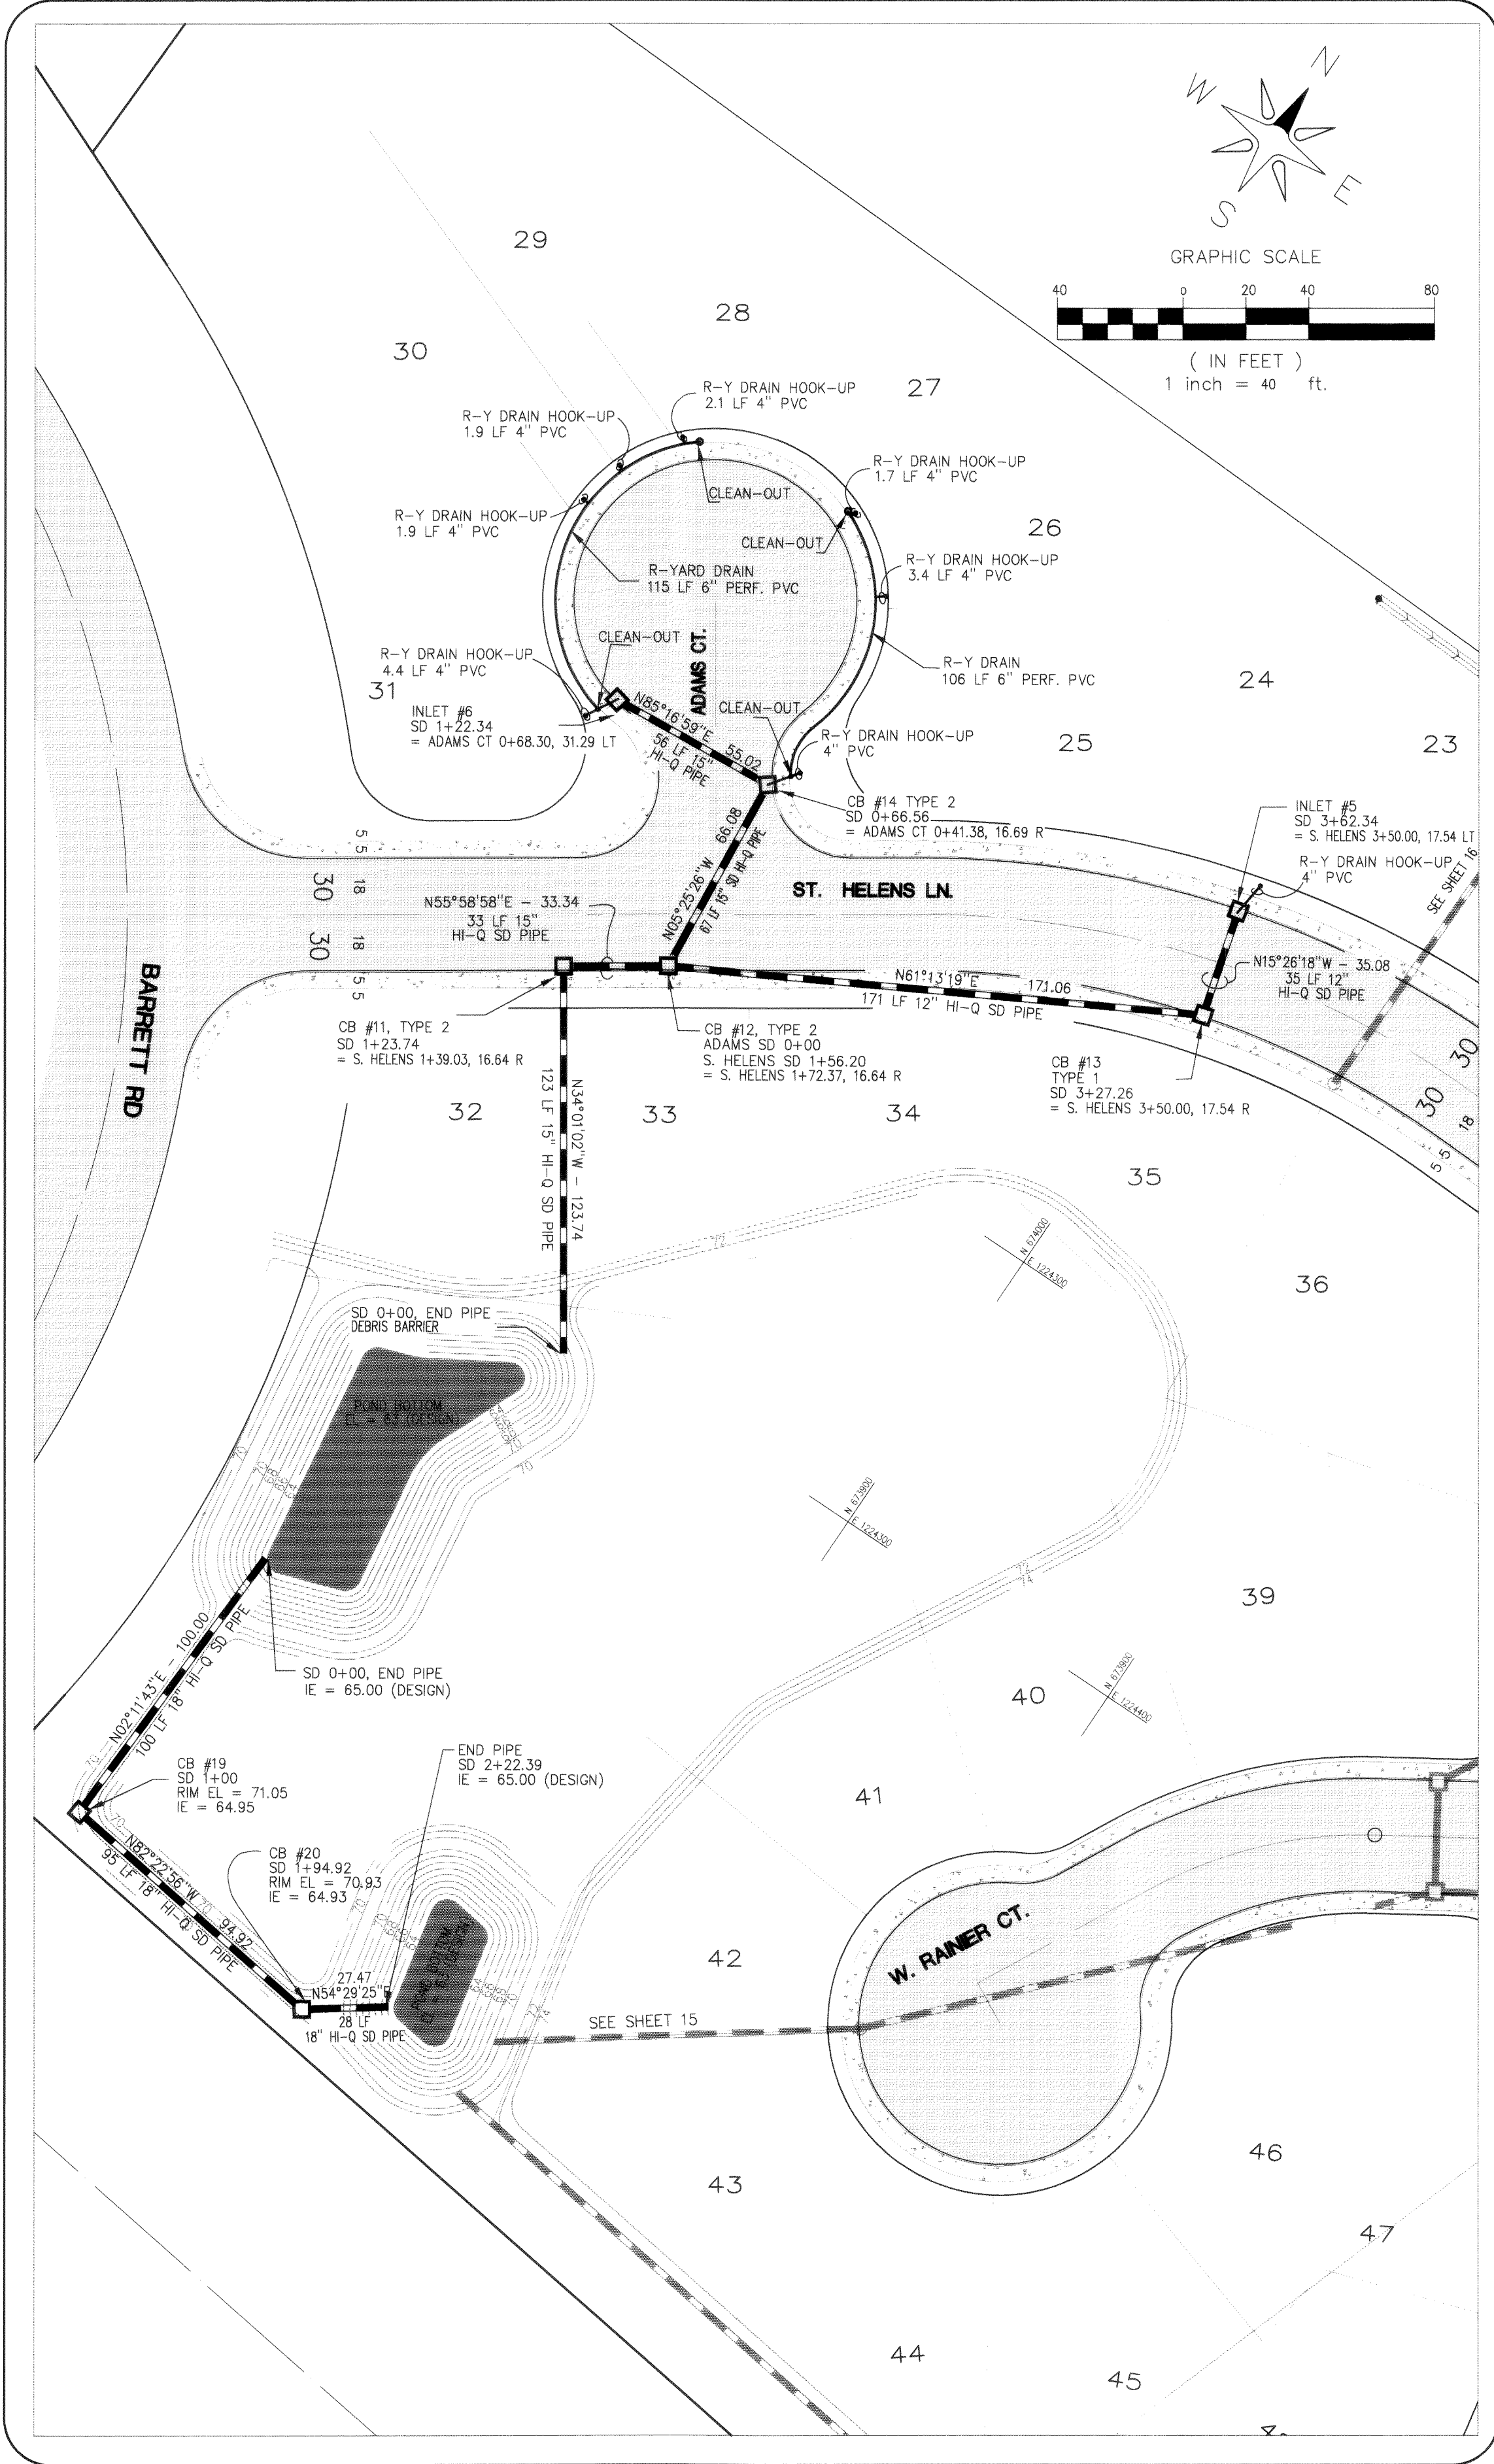

REVISIONS				CONTROL DATUM	
NO	DATE	BY	NOTE		
1	6-18-97	A.K.	REVISE PER AGENCY REVIEW		
2					
3					
4					
5					

LEGEND	
—	CENTERLINE
—	LOT LINES
—	PROPERTY/ROW LINE
—	LIMITED ACCESS
—	ESTIMATED ROCK
—	EXISTING GROUND
—	4" OR 6" ADS ROOF/YARD PIPE
—	CATCH BASIN or INLET
—	CLEAN-OUT
—	J-BOX
—	STORM SEWER PIPE
—	ADJACENT PROPERTY LOT NUMBER
—	EXISTING GROUND ELEVATION
—	PIPE INVERT ELEVATION
—	ABBREVIATED LAMBERT GRID COORDINATES
—	SIDEWALK
—	PAVEMENT
—	LOT NUMBER

DRAWN BY _____ DATE _____

DRAWN BY _____ DATE _____


JOB # 97015

SHIELDS ESTATES

FOR:
TEITGE, WILLIAMS & McCOLLUM INVESTMENTS, INC.

PROFESSIONAL CERTIFICATION
I HEREBY CERTIFY THAT THIS PLAN ACCURATELY
DEPICTS THE MATERIALS, TYPES, AND LOCATIONS
OF THE IMPROVEMENTS SHOWN HEREON AS OF
THIS DATE.

HARRY P. JONES, PE
DATE _____

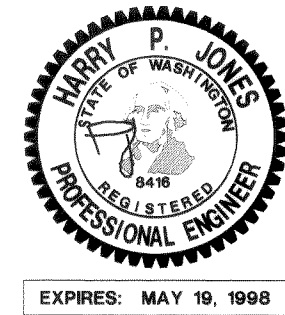

JONES ENGINEERS
INCORPORATED, P.S.
CONSULTING ENGINEERS
881 COHO WAY, SUITE 307
BELLINGHAM, WA 98225 (360) 733-8888







AS-BUILT
SHIELDS ESTATES
STORM PLAN & PROFILE:
ST. HELENS LN / ADAMS CT / POND

DEPARTMENT OF PUBLIC WORKS
FERDALE, WASHINGTON
APPROVED
This plan has been reviewed and found to be in conformance with department standards.
CITY ENGINEER _____ DATE _____

SHEET
17
35
OF

A PORTION OF THE SW 1/4 OF THE SE 1/4 OF SEC 28 TOWNSHIP 39 NORTH, RANGE 2 EAST, W.M.





POINT	BEARING & DISTANCE	NORTHING	EASTING
1	N82°47'35"E - 90.00	N 673913.55	E 1224200.05
2	N08°30'33"W - 95.33	N 673872.40	E 1224120.01
3	N40°50'47"W - 24.00	N 673778.72	E 1224134.12
4	N02°11'43"E - 75.39	N 673759.54	E 1224146.92
5	N82°22'56"W - 143.06	N 673665.67	E 1224288.72
6	N78°09'46"E - 90.00	N 673668.95	E 1224304.38
7	N14°40'36"E - 24.00	N 673692.17	E 1224310.46
8	N12°18'57"E - 73.00	N 673763.49	E 1224294.89
9	N18°47'32"W - 93.00	N 673783.15	E 1224203.99
10	N08°55'41"E - 100.00	N 673882.42	E 1224216.06
11	N27°12'25"W - 35.00		

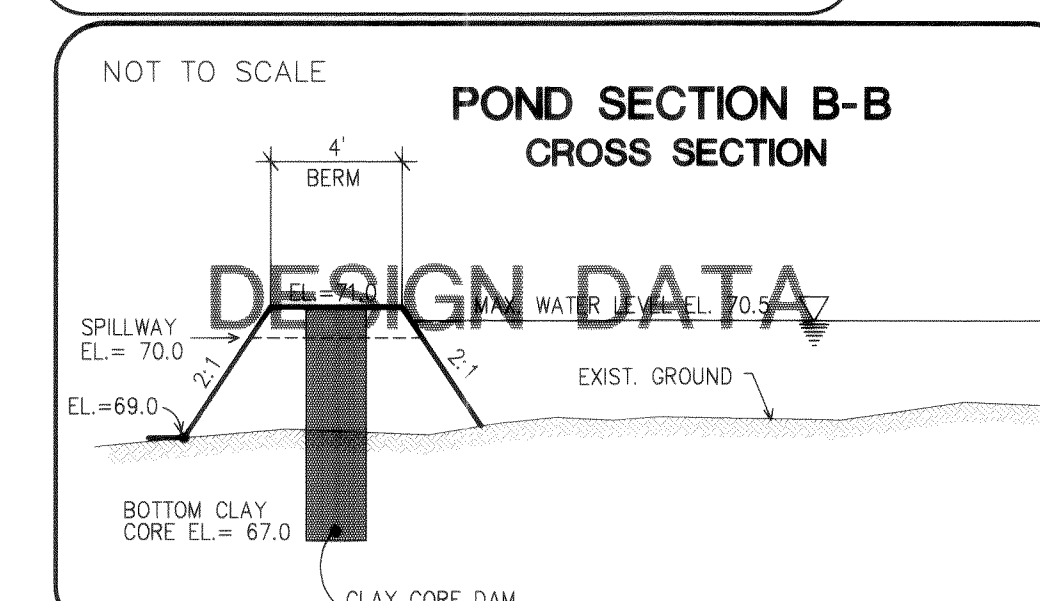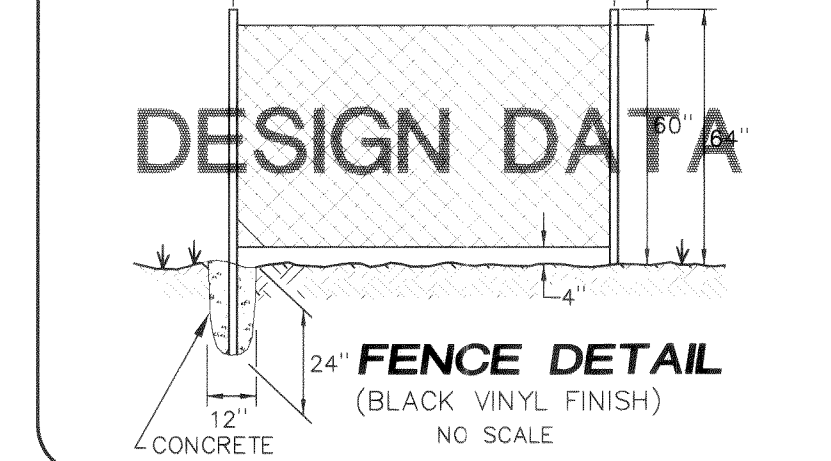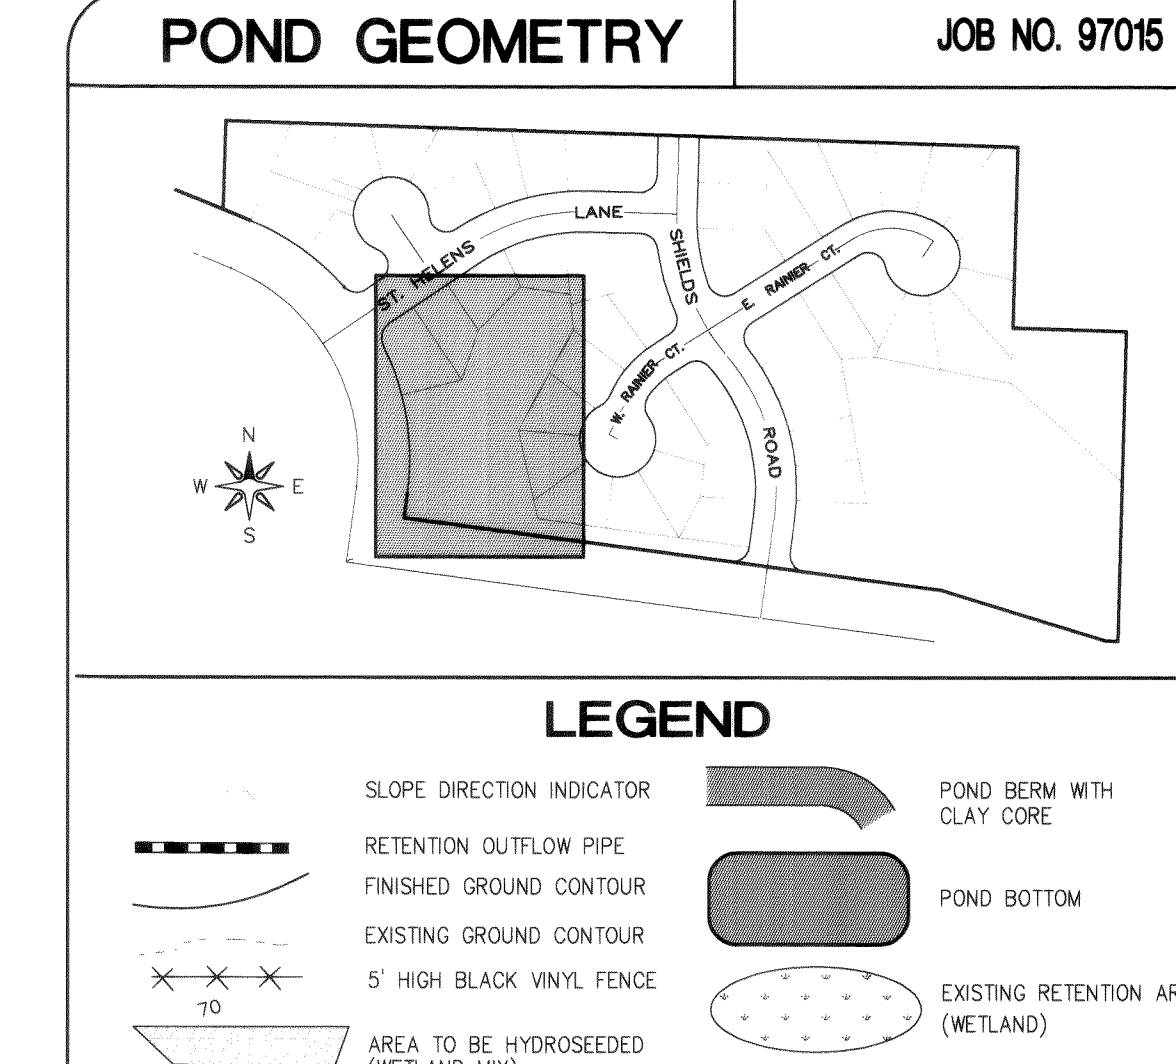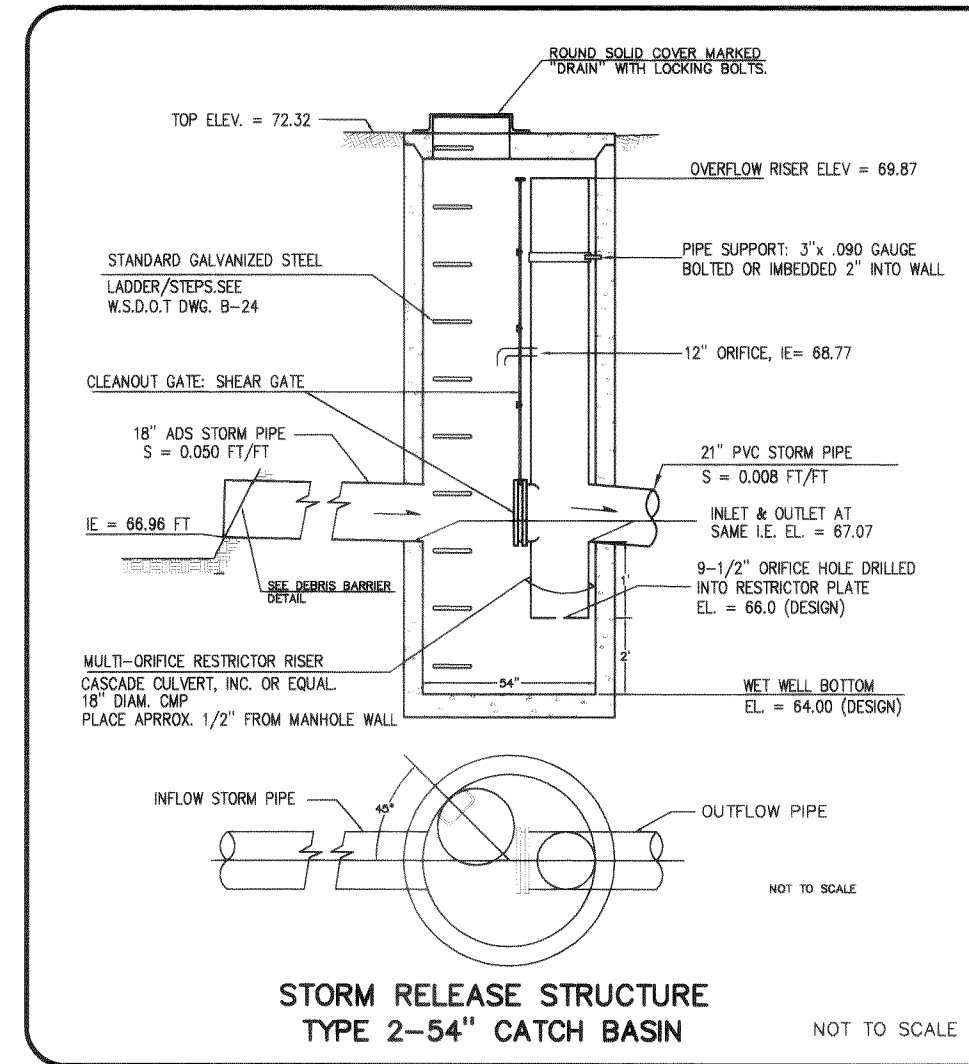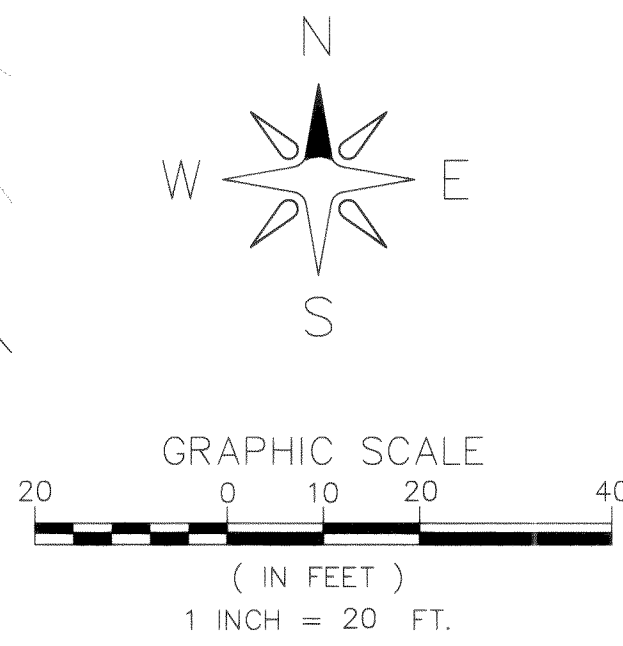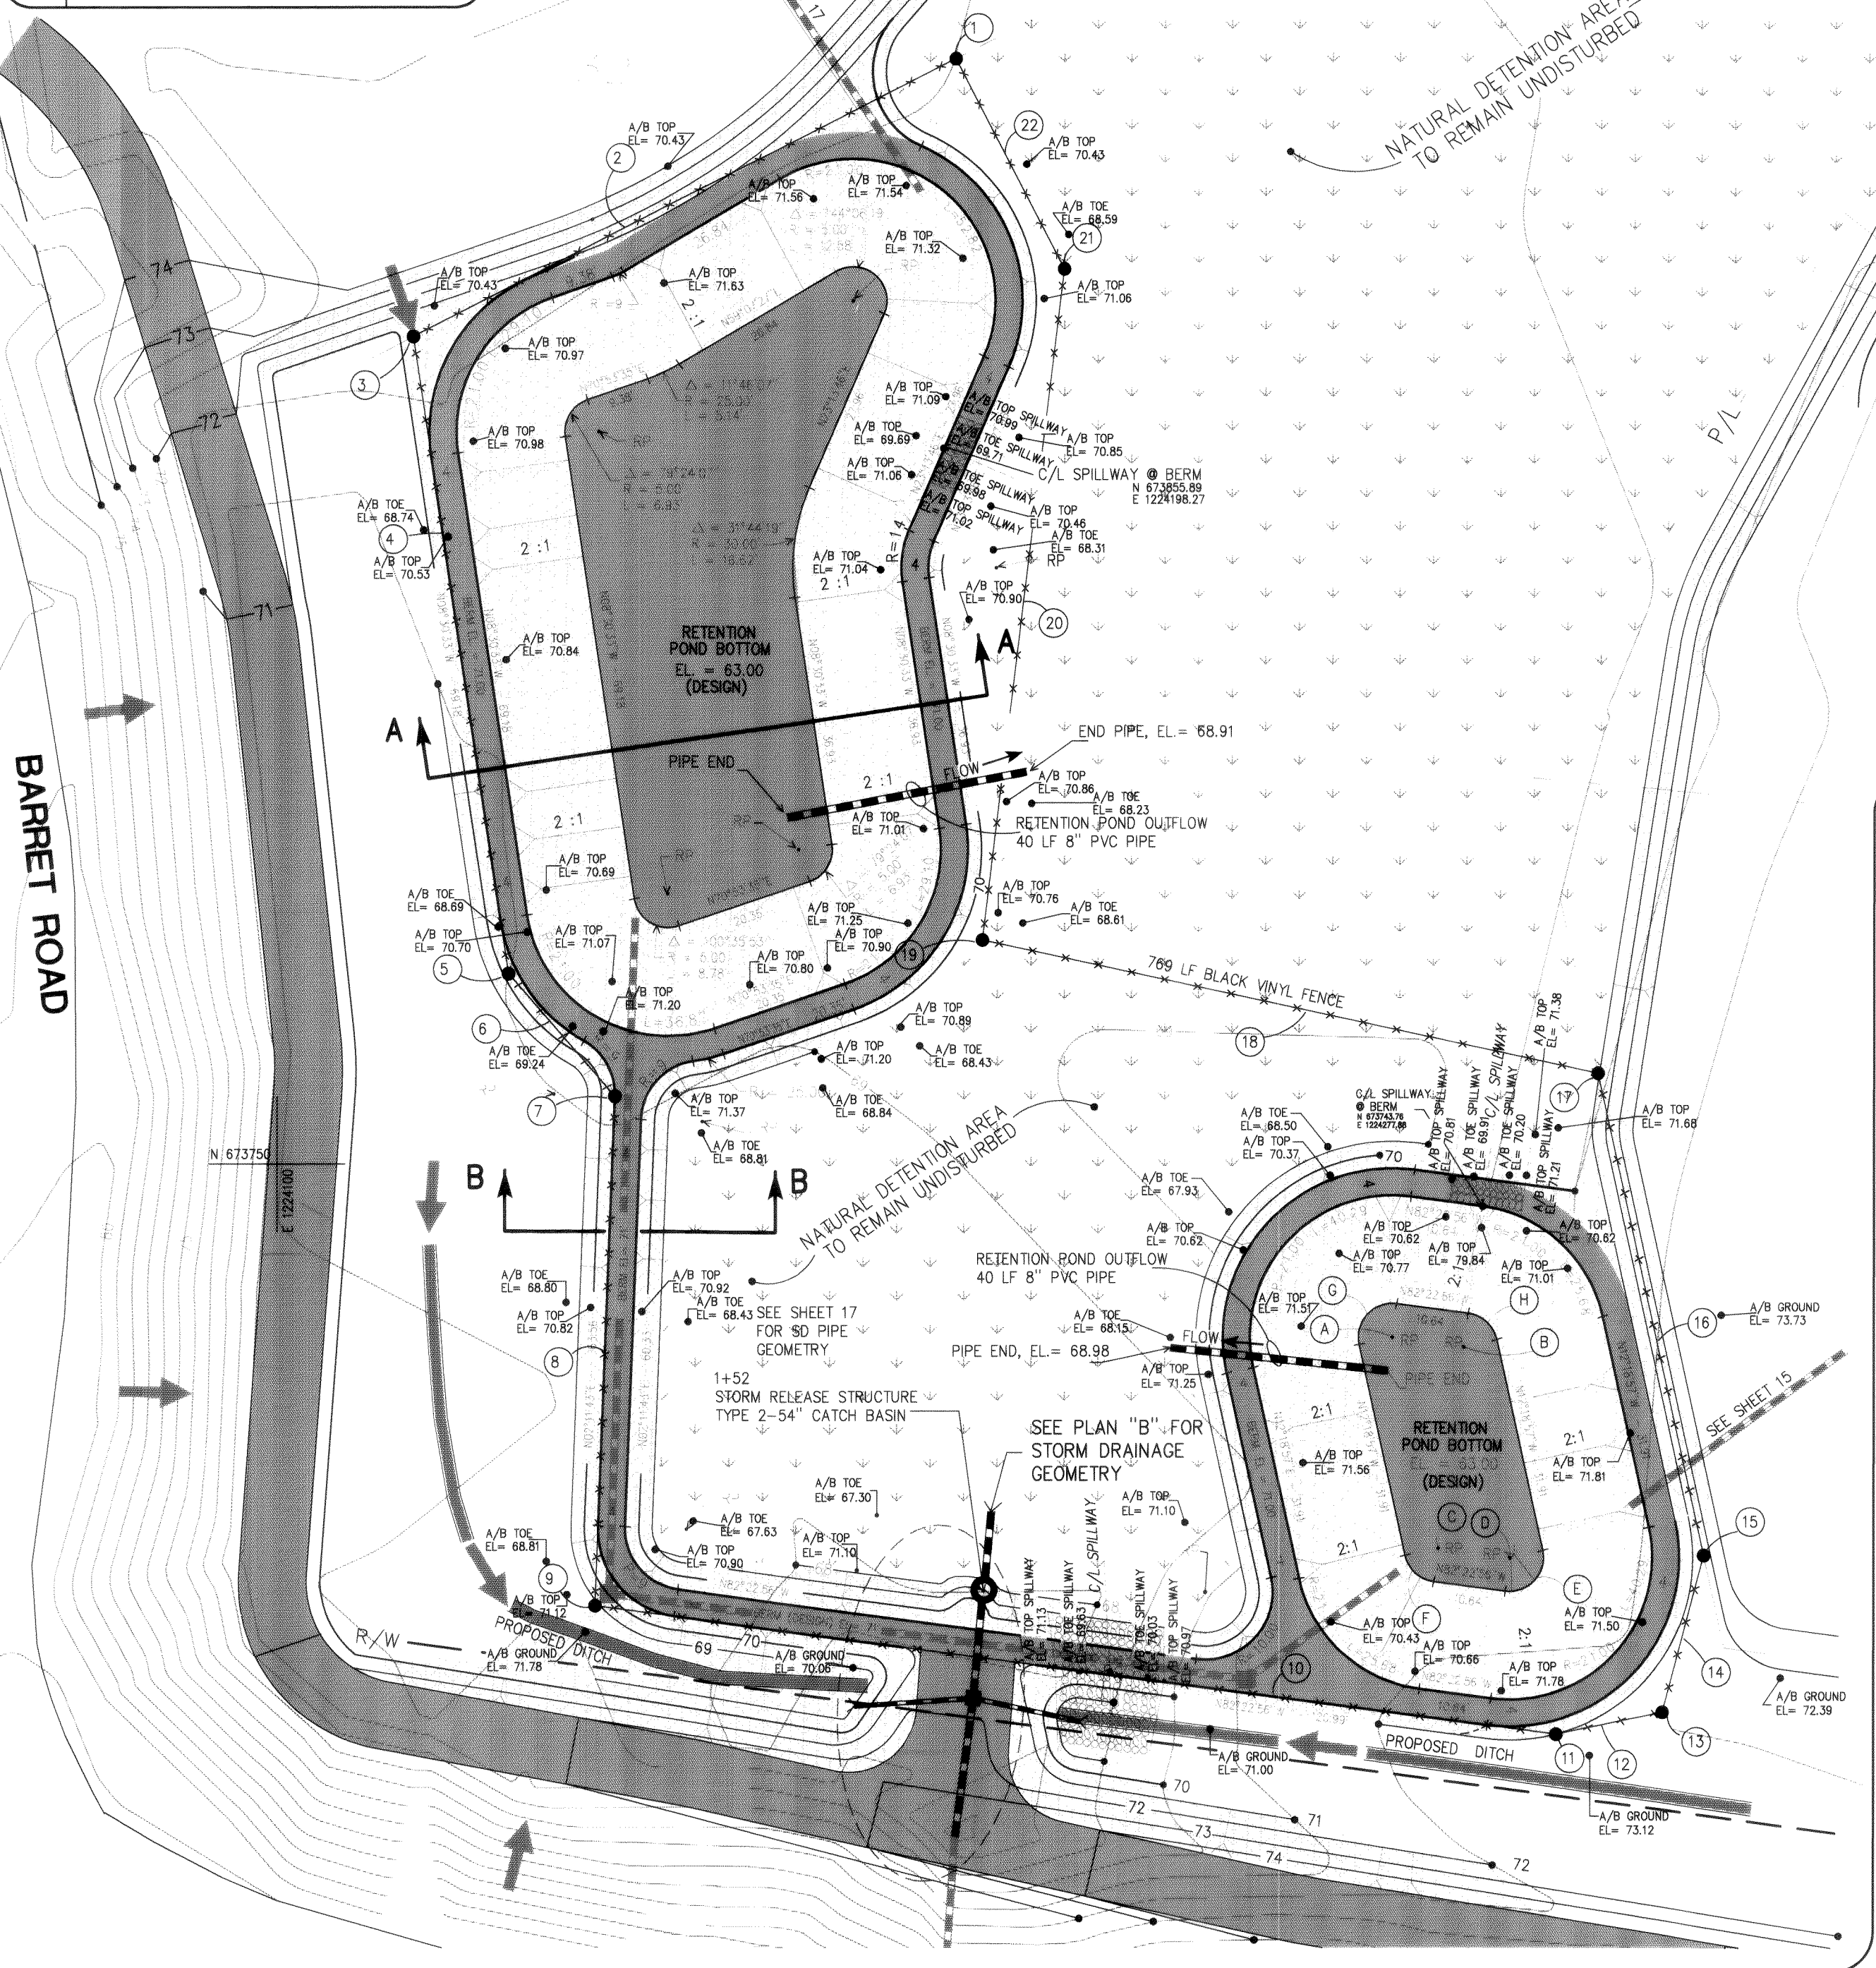

EMERGENCY OVERFLOW SPILLWAY DETENTION POND WEIR SECTION
 THE EMERGENCY OVERFLOW SPILLWAY WEIR SECTION CAN BE DESIGNED TO PASS THE 100-YEAR, 24-HOUR DESIGN STORM EVENT FOR DEVELOPED CONDITIONS THAT FOLLOW:
 1. $L = \frac{Q_{100}}{(3.21)(\frac{H}{2})^{3/2}} - (2.4)H = 11.76$
 $Q_{100} = 14.71 \text{ CFS}$
 $L = 11.76 \text{ FEET MINIMUM, USE 11.8}$
 $H = 0.5 \text{ FEET MINIMUM}$
 * ASSUMING THAT POC 1, 2 & 3 PEAK AT 8.92 MIN. AND POC 4 AT 65.48 MIN. (SEE SHEET 19A). ADDING THE HYDROGRAPHS, USING A TRIANGULAR DESIGN STORM RESULTS IN A 14.71 CFS PEAK @ 8.92 MIN. NOTE: PEAK FLOWS WERE COMPUTED USING MODIFIED RATIONAL METHOD

EMERGENCY OVERFLOW SPILLWAY RETENTION POND WEIR SECTION
 THE EMERGENCY OVERFLOW SPILLWAY WEIR SECTION CAN BE DESIGNED TO PASS THE 100-YEAR, 24-HOUR DESIGN STORM EVENT FOR DEVELOPED CONDITIONS THAT FOLLOW:
 1. $L = \frac{Q_{100}}{(3.21)(\frac{H}{2})^{3/2}} - (2.4)H$
 $Q_{100} = 13.42 \text{ CFS* (FOR BOTH SPILLWAYS)}$
 $Q_{100} = 6.71 \text{ CFS (EACH SPILLWAY)}$
 $L = 4.73 \text{ FEET MINIMUM, USE 4.8 FEET}$
 $H = 0.5 \text{ FEET MINIMUM}$
 * ASSUMING THAT POC 1, 2 & 3 PEAK AT 8.92 MIN. (SEE SHEET 19A). NOTE: PEAK FLOWS WERE COMPUTED USING MODIFIED RATIONAL METHOD


RETENTION POND OUTFLOW
 MAX. WATER LEVEL EL. 70.5
 100 YR. STORM EL. 69.98
 6 MO. STORAGE EL. 67.4
 DEAD STORAGE EL. 65.00
 RETENTION POND BOTTOM EL. 63.00
 BEAM EL. 71.00
 SPILLWAY EL. 70.0
 DETENTION POND BOTTOM EL. 69.00
 IE = 67.4
 8" PVC OUTFLOW PIPE
 EXCESS STORAGE BETWEEN EL. 67.4 AND EL. 69.0 IS 12,094 CF
 STORAGE VOLUME = 20,748 CF

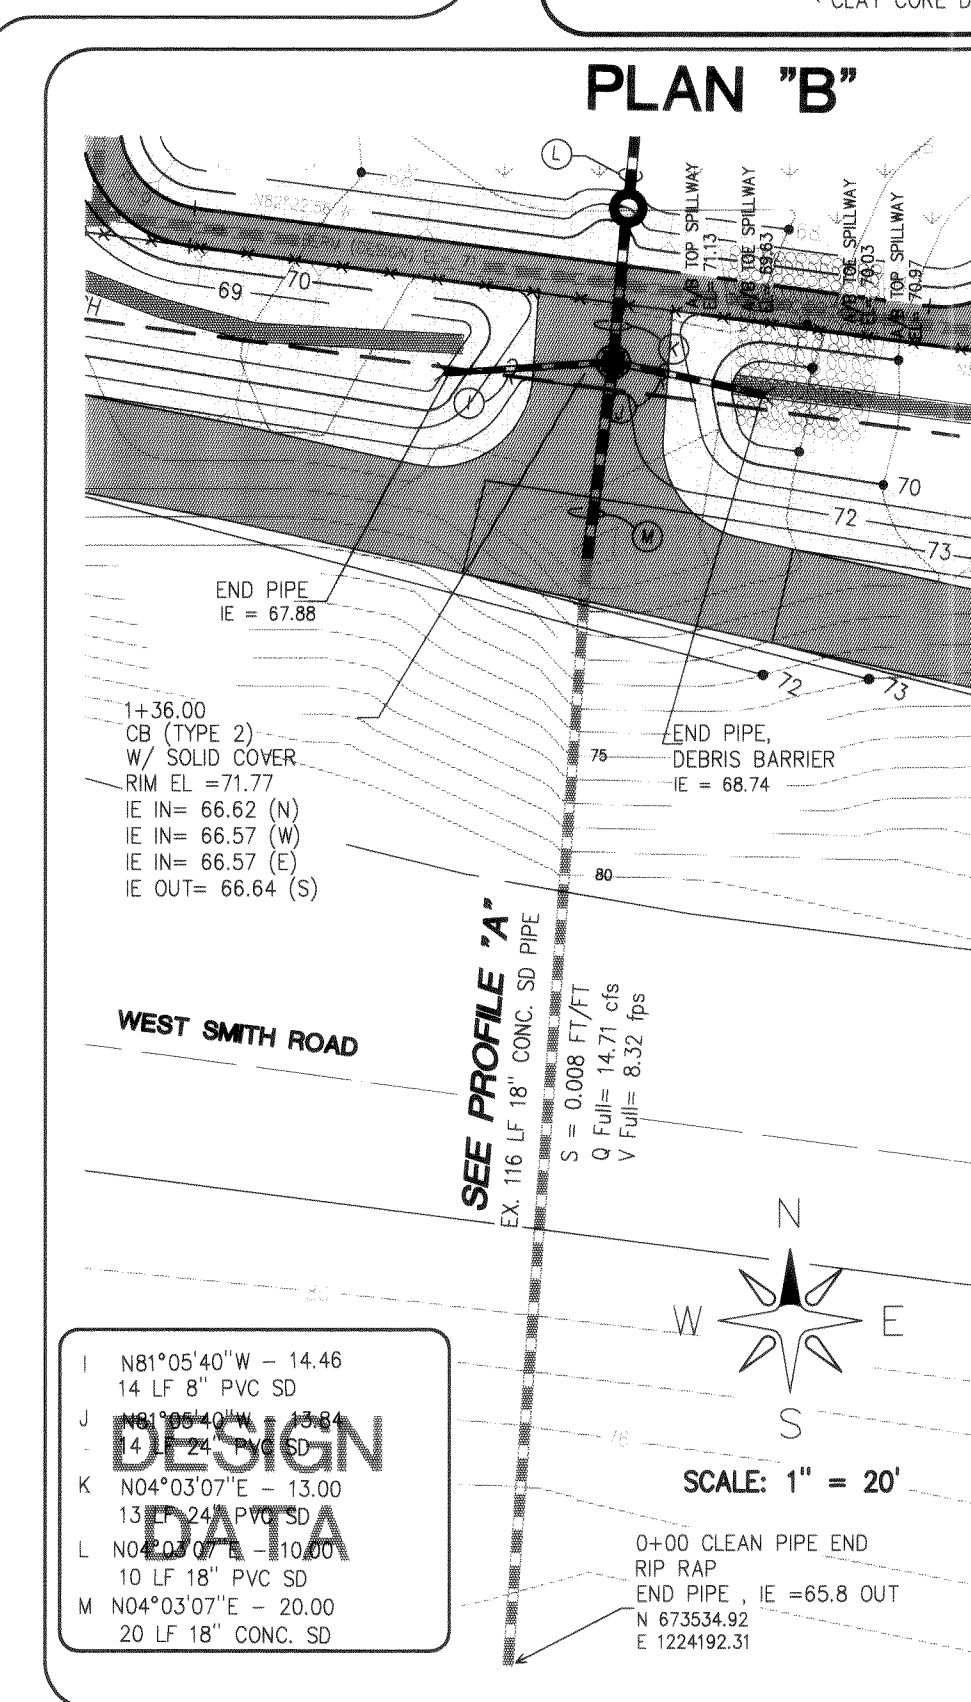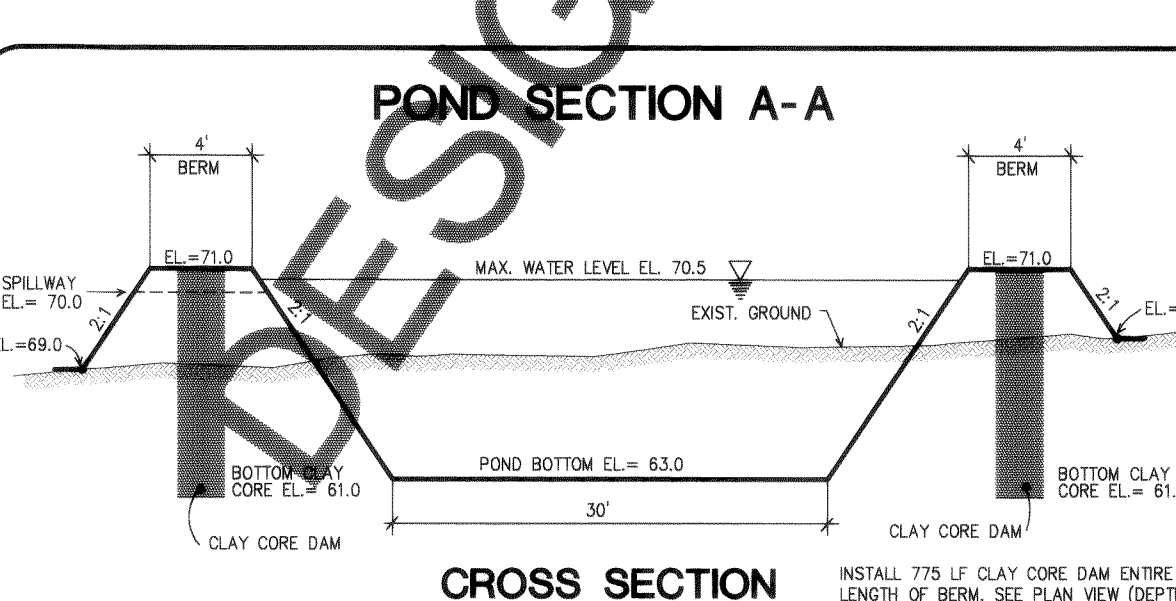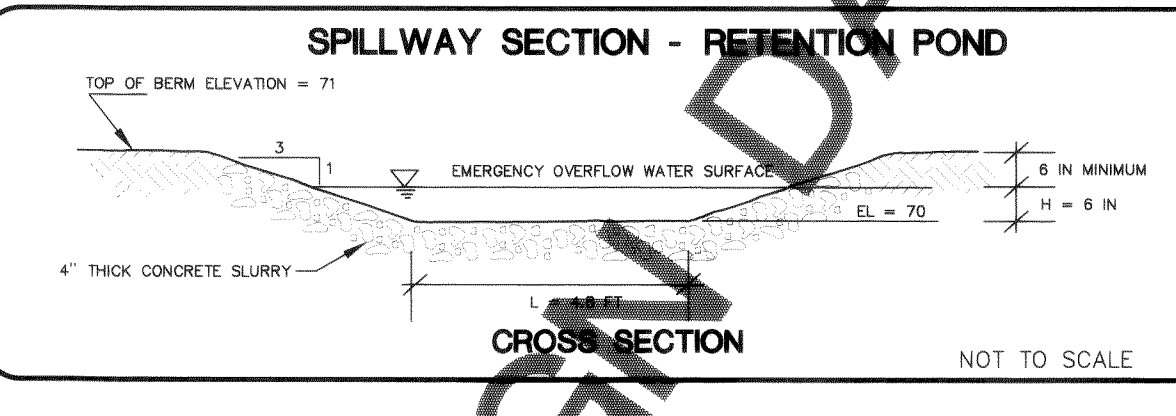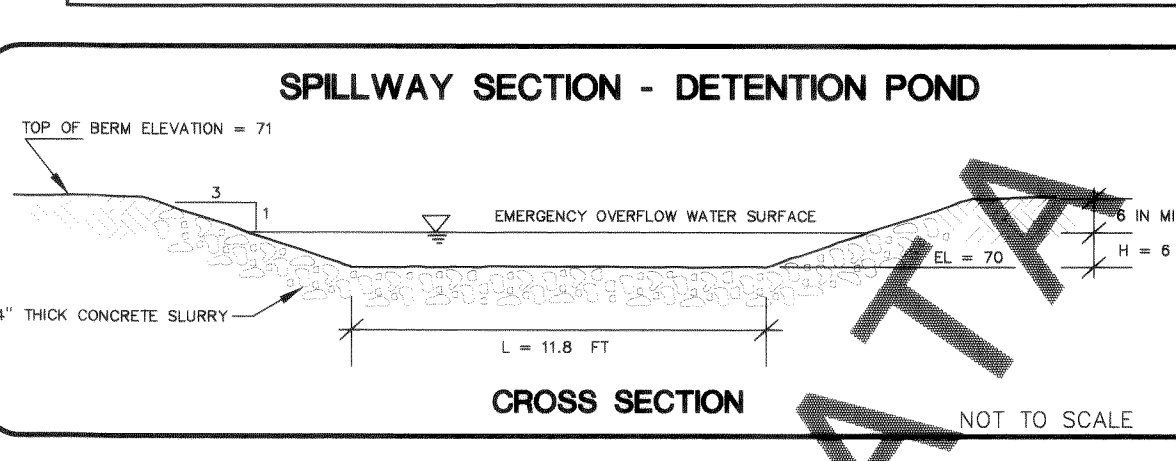


NOTE: SEE HYDRAULIC CALCULATIONS FOR EX. 18" CONCRETE PIPE ON SHEET 19 OF 35.

CONTROL DATUM			
HORIZONTAL: NAD83(11) WASHINGTON STATE LAMBERT GRID, NORTH ZONE POINT: CANNED MONUMENT (7-10), SOUTHEAST CORNER SEC. 28, T39N, R2E, W4E ELEVATION: 624.633.53 X: 1,228,474.80 Y: 1,228,474.80 MERIDIAN: SOUTH LINE OF THE SOUTHEAST QUARTER OF SECTION 28, N88°22'45"W			
REVISIONS			
NO.	DATE	BY	NOTE
1	6/20/97	RL	PER CITY PLAN REVIEW
2			
3			
4			
5			

RETENTION POND COORDINATE POINTS			
A	N 673724.40	E 1224264.53	RP
B	N 673722.99	E 1224275.07	RP
C	N 673693.22	E 1224271.34	RP
D	N 673691.91	E 1224261.81	RP
RETENTION POND GEOMETRY			
E	$\Delta = 109^\circ 56' 01"$	R = 5.00	L = 9.59
F	$\Delta = 70^\circ 03' 59"$	R = 5.00	L = 6.11
G	$\Delta = 109^\circ 56' 01"$	R = 5.00	L = 9.59
H	$\Delta = 70^\circ 03' 59"$	R = 5.00	L = 6.11

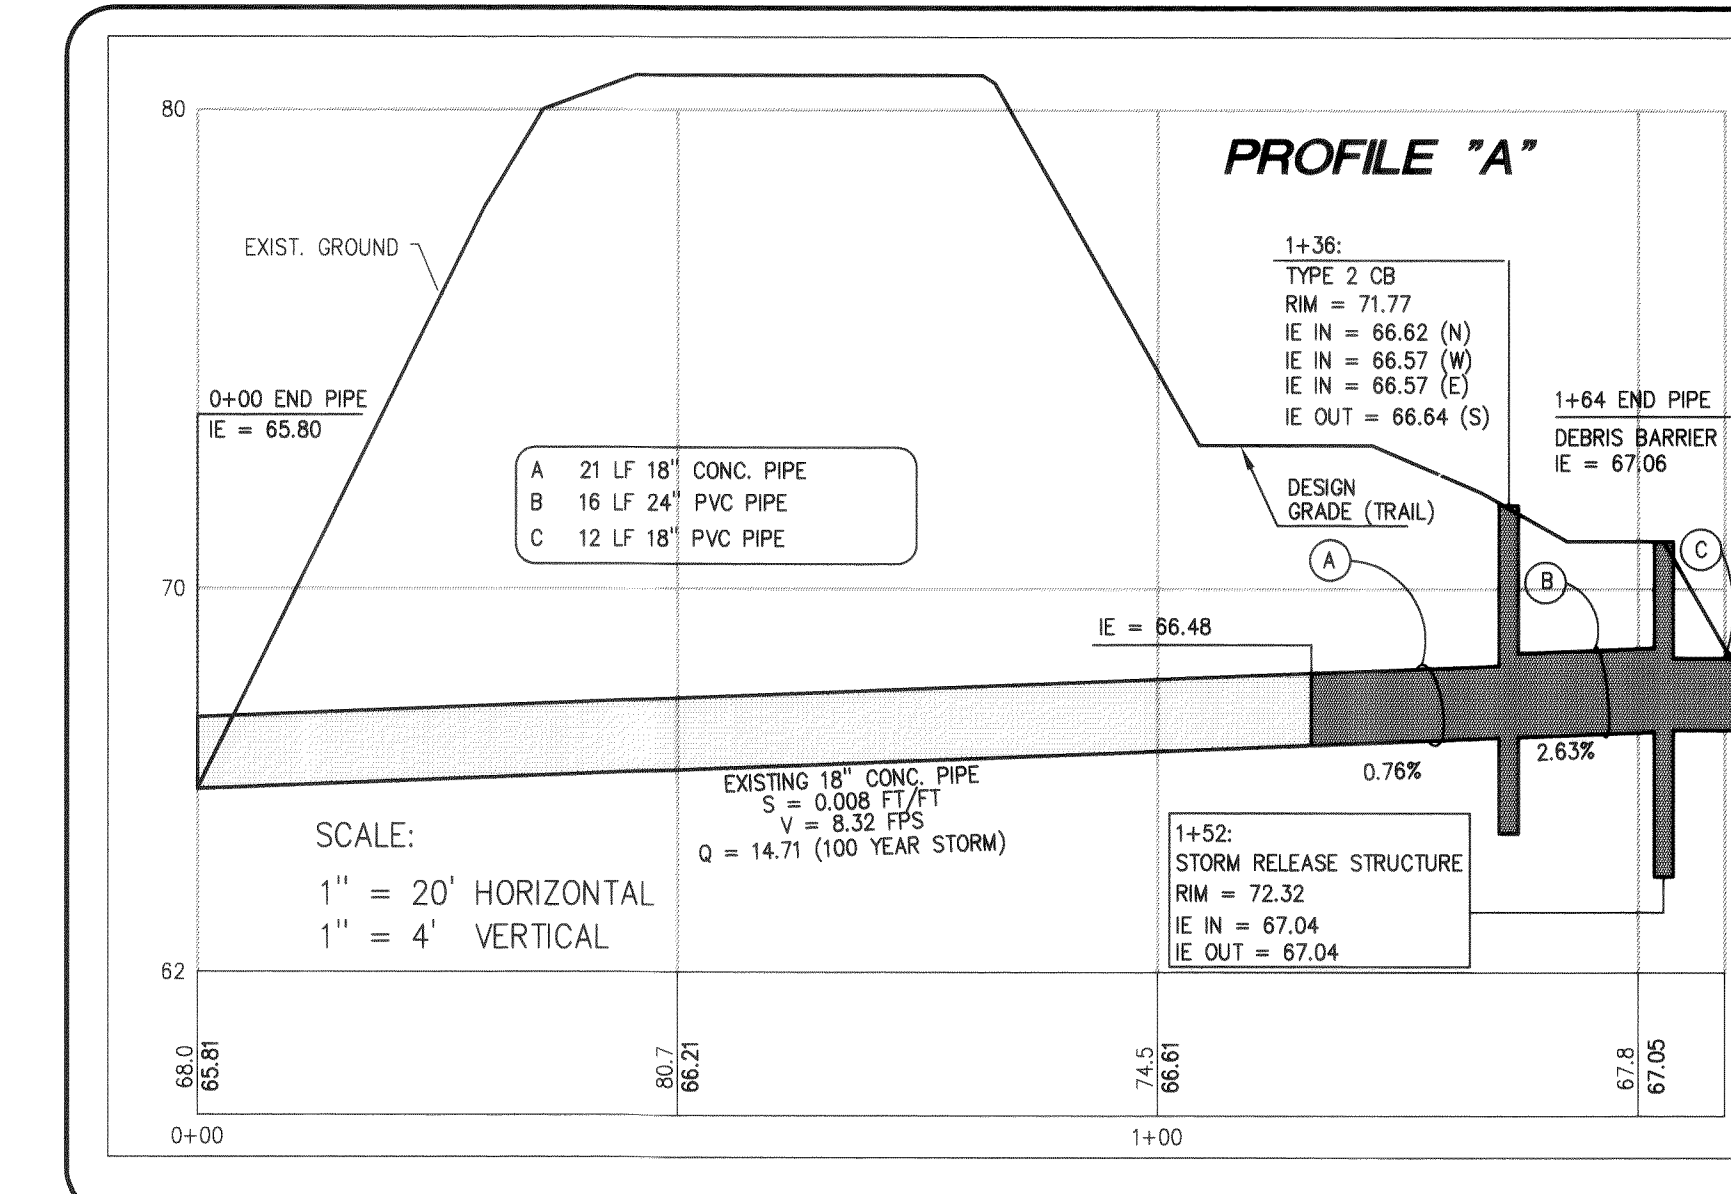

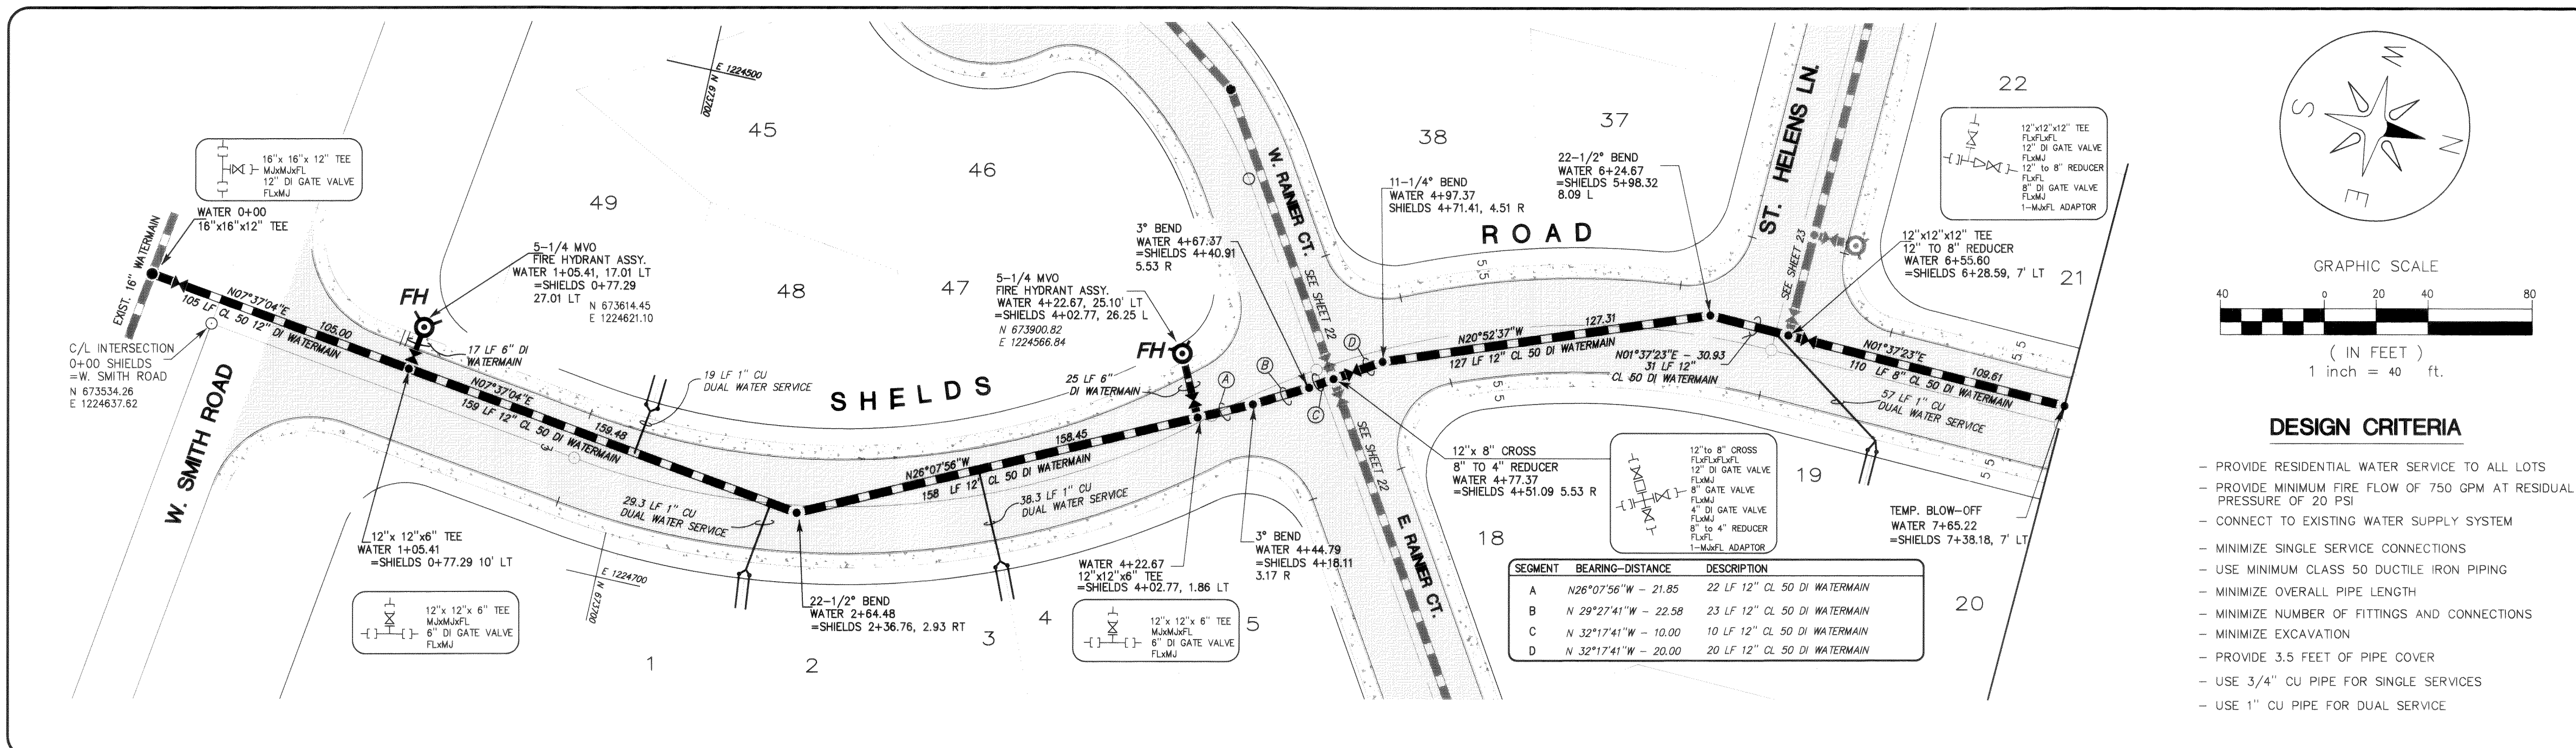

DESIGN CRITERIA


- PROVIDE RESIDENTIAL WATER SERVICE TO ALL LOTS
- PROVIDE MINIMUM FIRE FLOW OF 750 GPM AT RESIDUAL PRESSURE OF 20 PSI
- CONNECT TO EXISTING WATER SUPPLY SYSTEM
- MINIMIZE SINGLE SERVICE CONNECTIONS
- USE MINIMUM CLASS 50 DUCTILE IRON PIPING
- MINIMIZE OVERALL PIPE LENGTH
- MINIMIZE NUMBER OF FITTINGS AND CONNECTIONS
- MINIMIZE EXCAVATION
- PROVIDE 3.5 FEET OF PIPE COVER
- USE 3/4\"/>

REVISIONS

NO	DATE	BY	NOTE
1.			
2.			
3.			
4.			
5.			









CONTROL DATUM

HORIZONTAL: NAD83(91) WASHINGTON STATE LAMBERT GRID, NORTH ZONE
 POSITION: CASED MONUMENT (F-10), SOUTHEAST CORNER SEC. 28, 138N, R2E, W.M.
 Y: 673,433.53
 X: 1,226,474.60
 MERIDIAN: SOUTH LINE OF THE SOUTHEAST QUARTER OF SECTION 28, N88°22'49\"/>

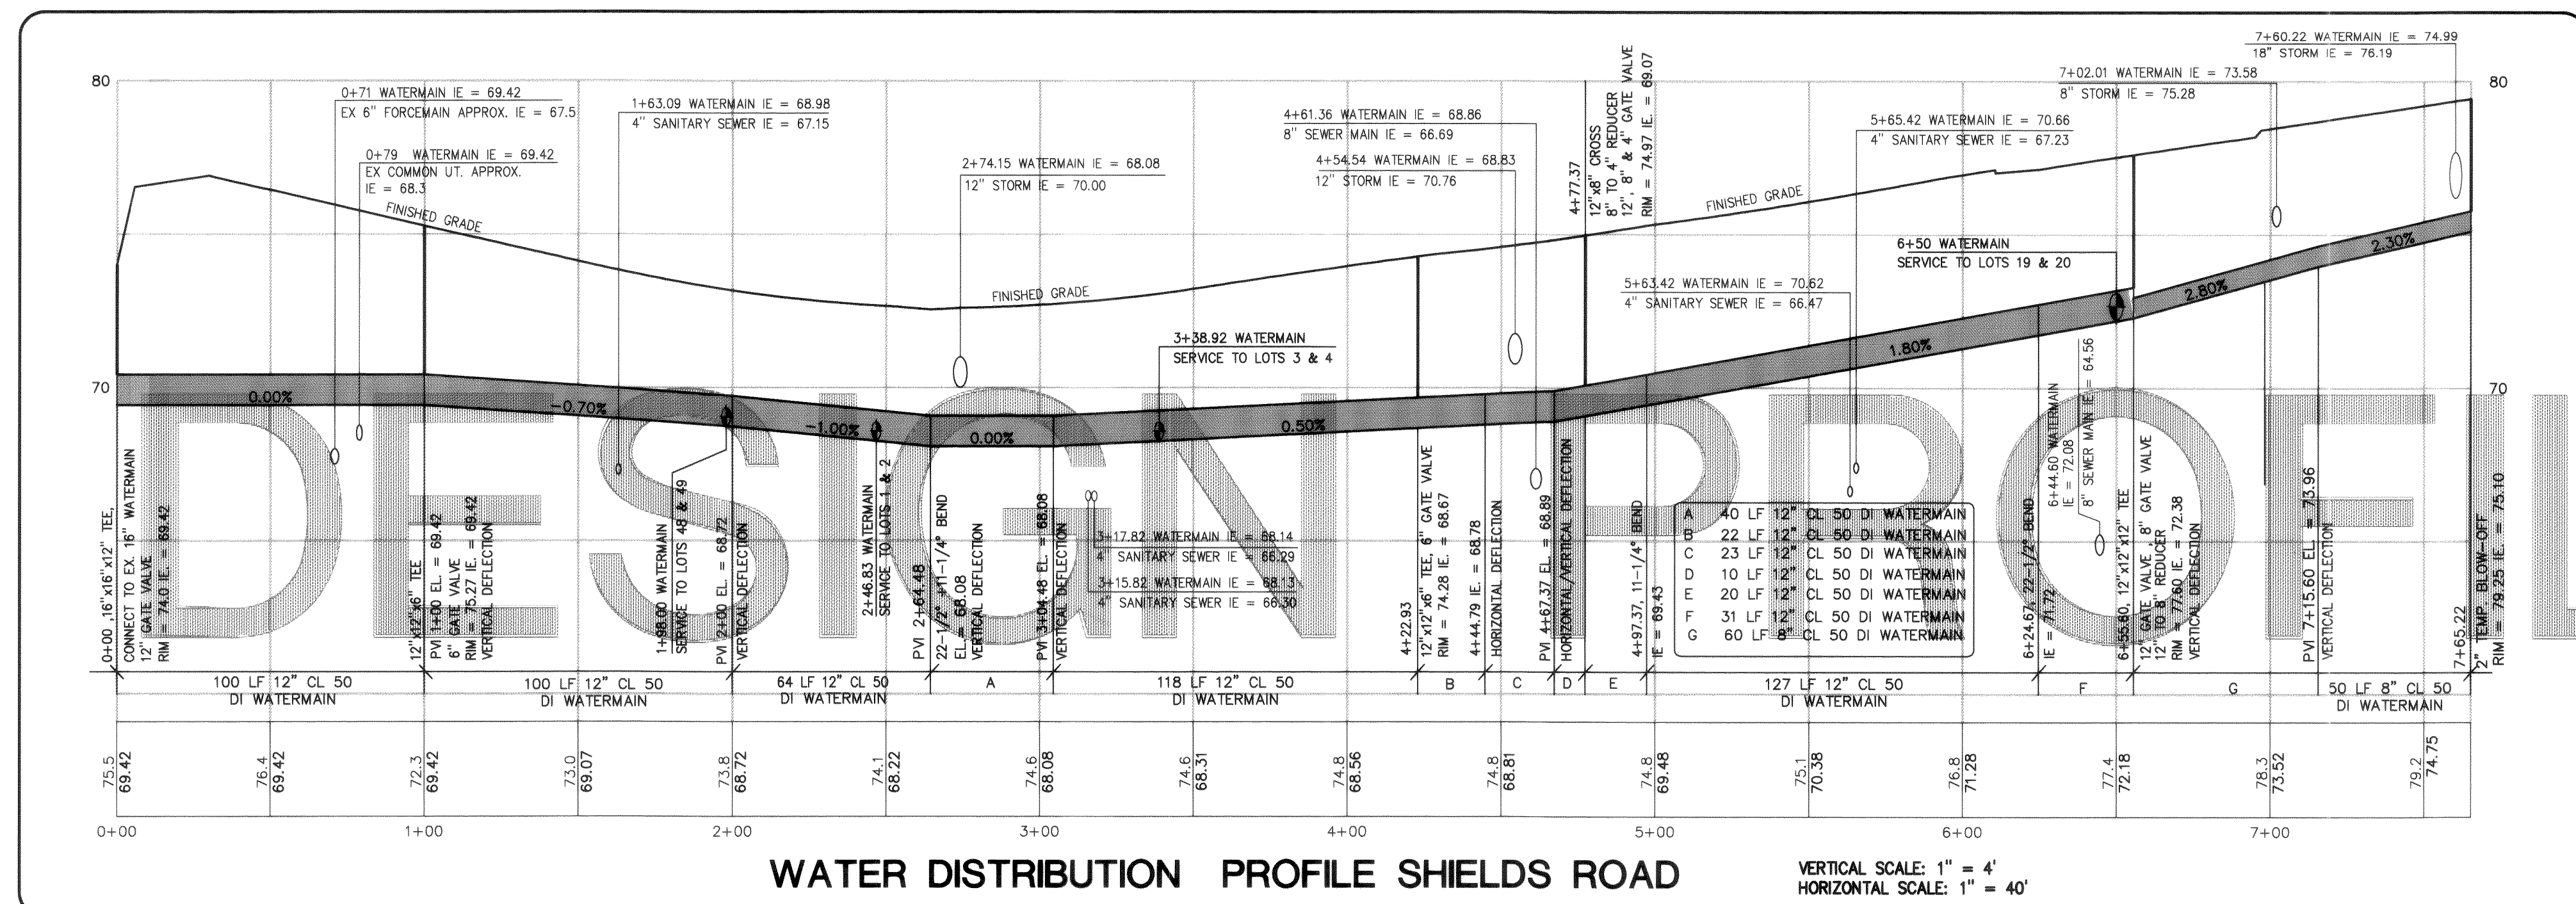

WATER DISTRIBUTION PROFILE SHIELDS ROAD

VERTICAL SCALE: 1\"/>

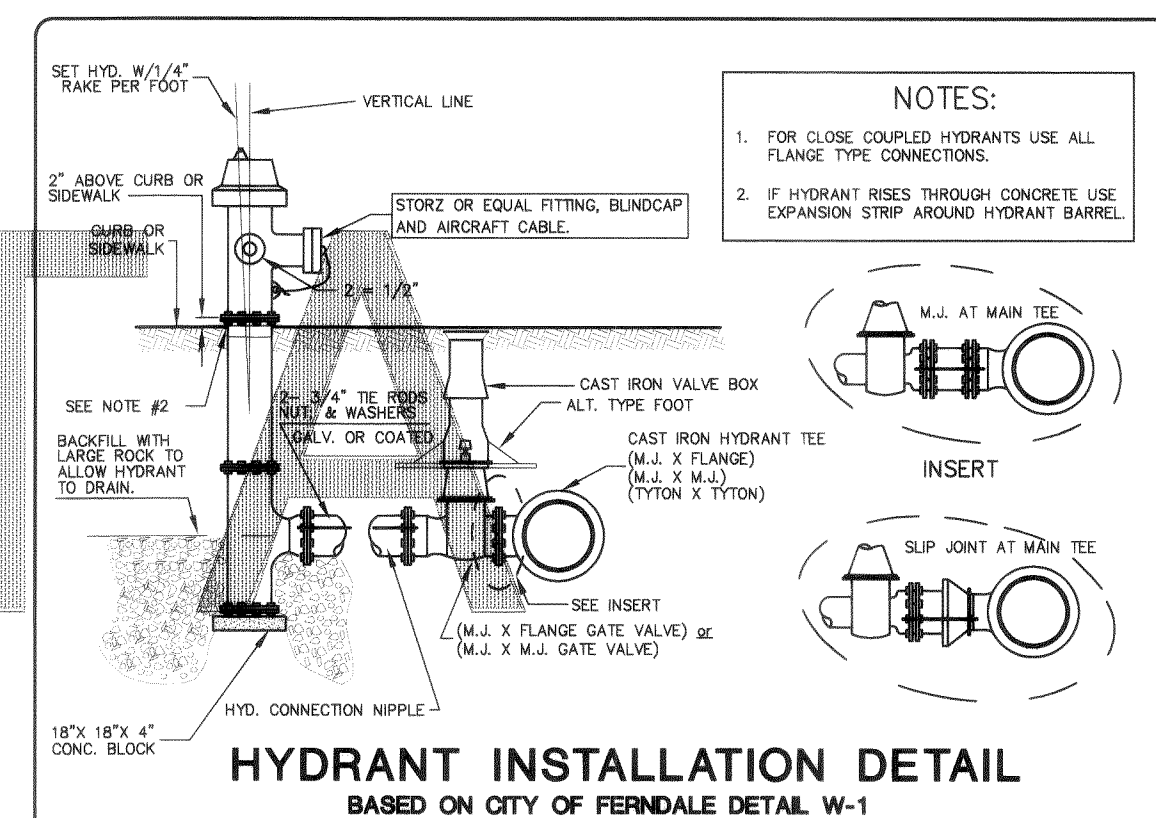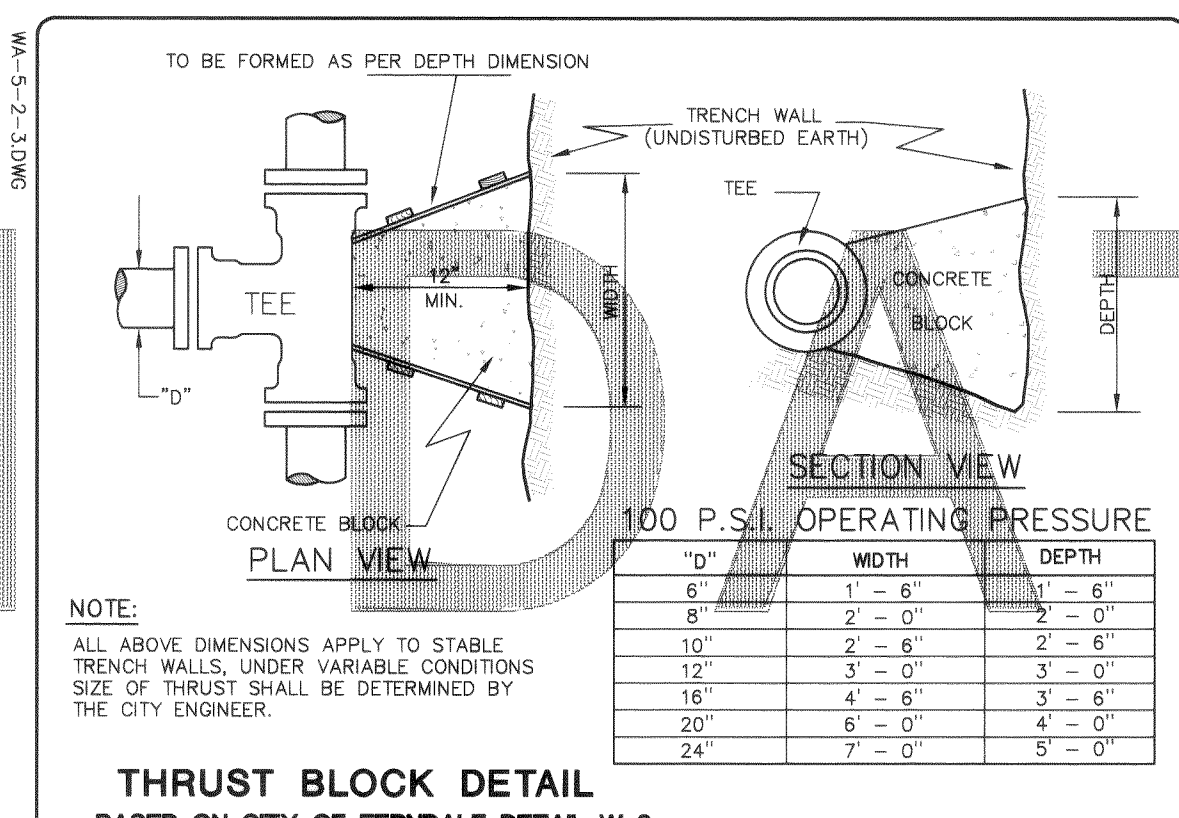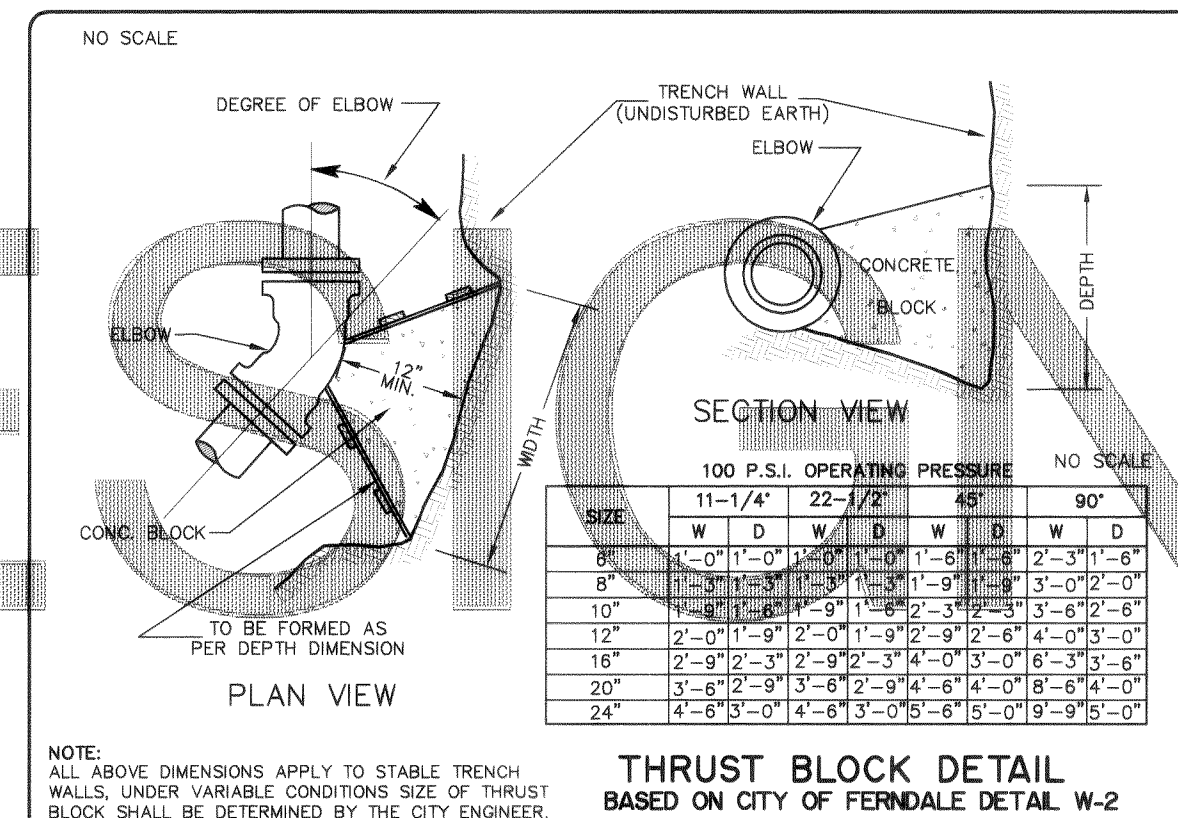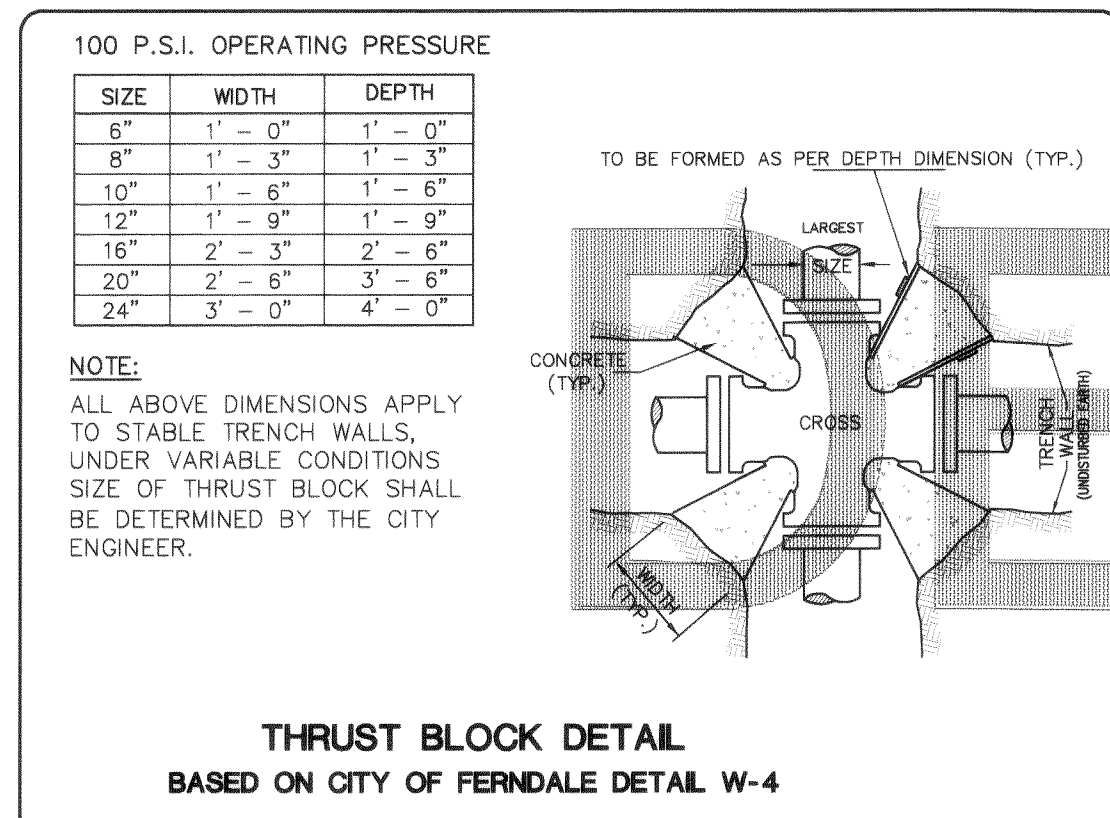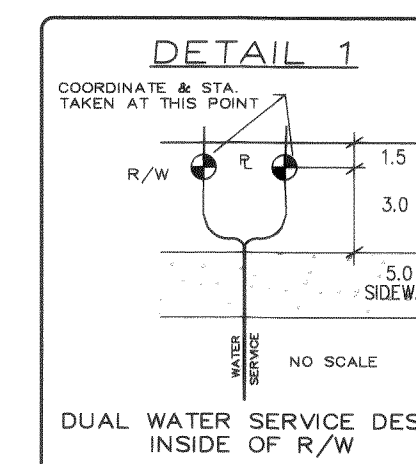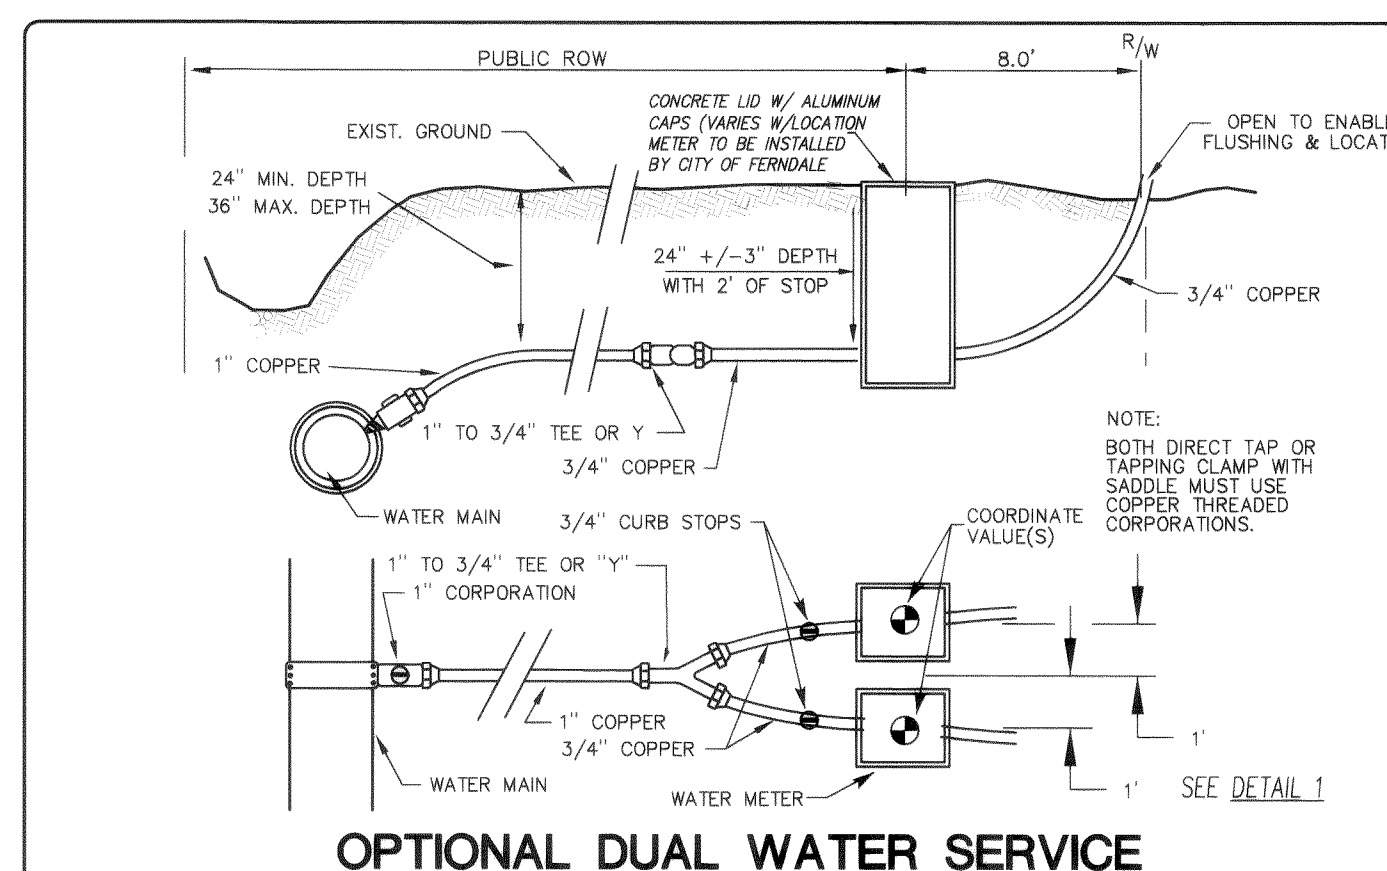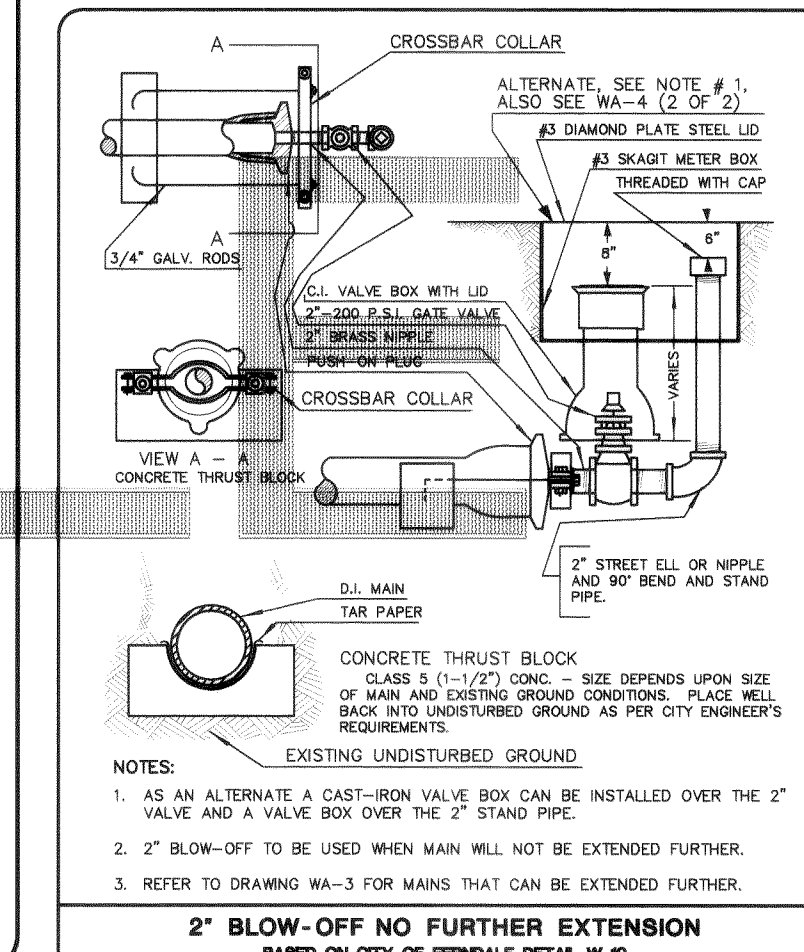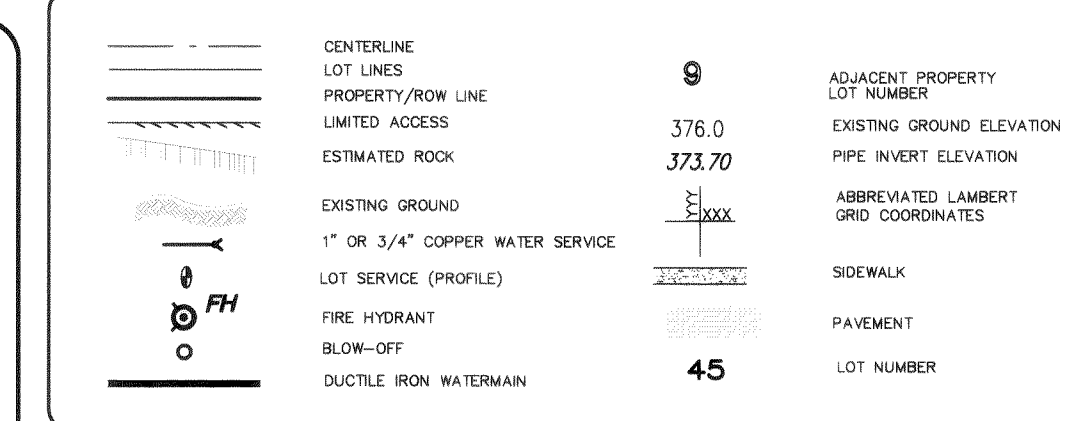

DRAWN BY _____ DATE _____

DRAWN BY _____ DATE _____

JOB # 97015

SHIELDS ESTATES


FOR:

TEITGE, WILLIAMS & McCOLLUM INVESTMENTS, INC.

PROFESSIONAL CERTIFICATION
 I HEREBY CERTIFY THAT THIS PLAN ACCURATELY
 DEPICTS THE MATERIALS, TYPES, AND LOCATIONS
 OF THE IMPROVEMENTS SHOWN HEREON AS OF
 THIS DATE.

Harry P. Jones
 HARRY P. JONES, PE

DATE

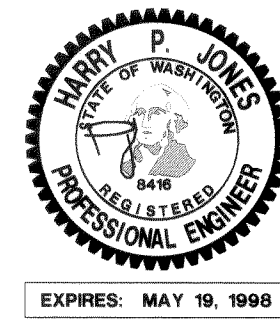

JONES ENGINEERS
 INCORPORATED, P.S.
 CONSULTING ENGINEERS
 851 COHO WAY, SUITE 307
 BELLINGHAM, WA 98225 (360) 733-8888

AS-BUILT

SHIELDS ESTATES
 WATERMAIN PLAN & PROFILE:
 SHIELDS ROAD

DEPARTMENT OF PUBLIC WORKS

FERDALE, WASHINGTON

APPROVED

This plan has been reviewed and found
 to be in conformance with department
 standards.

CITY ENGINEER _____ DATE _____



SHEET

21





35

A PORTION OF THE SW 1/4 OF THE SE 1/4 OF SEC 28 TOWNSHIP 39 NORTH , RANGE 2 EAST , W.M.

WATER DISTRIBUTION - EAST & WEST RAINIER JOB NO. 97015

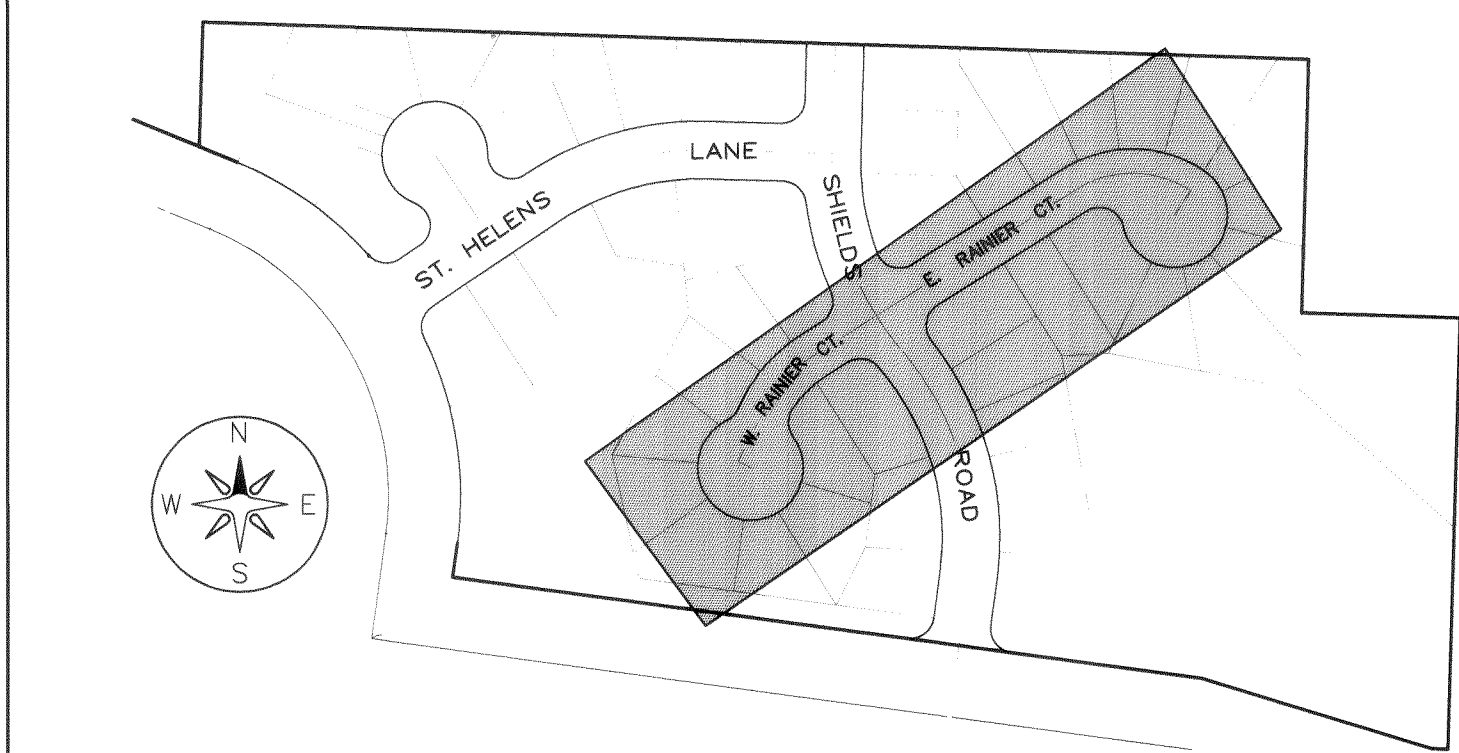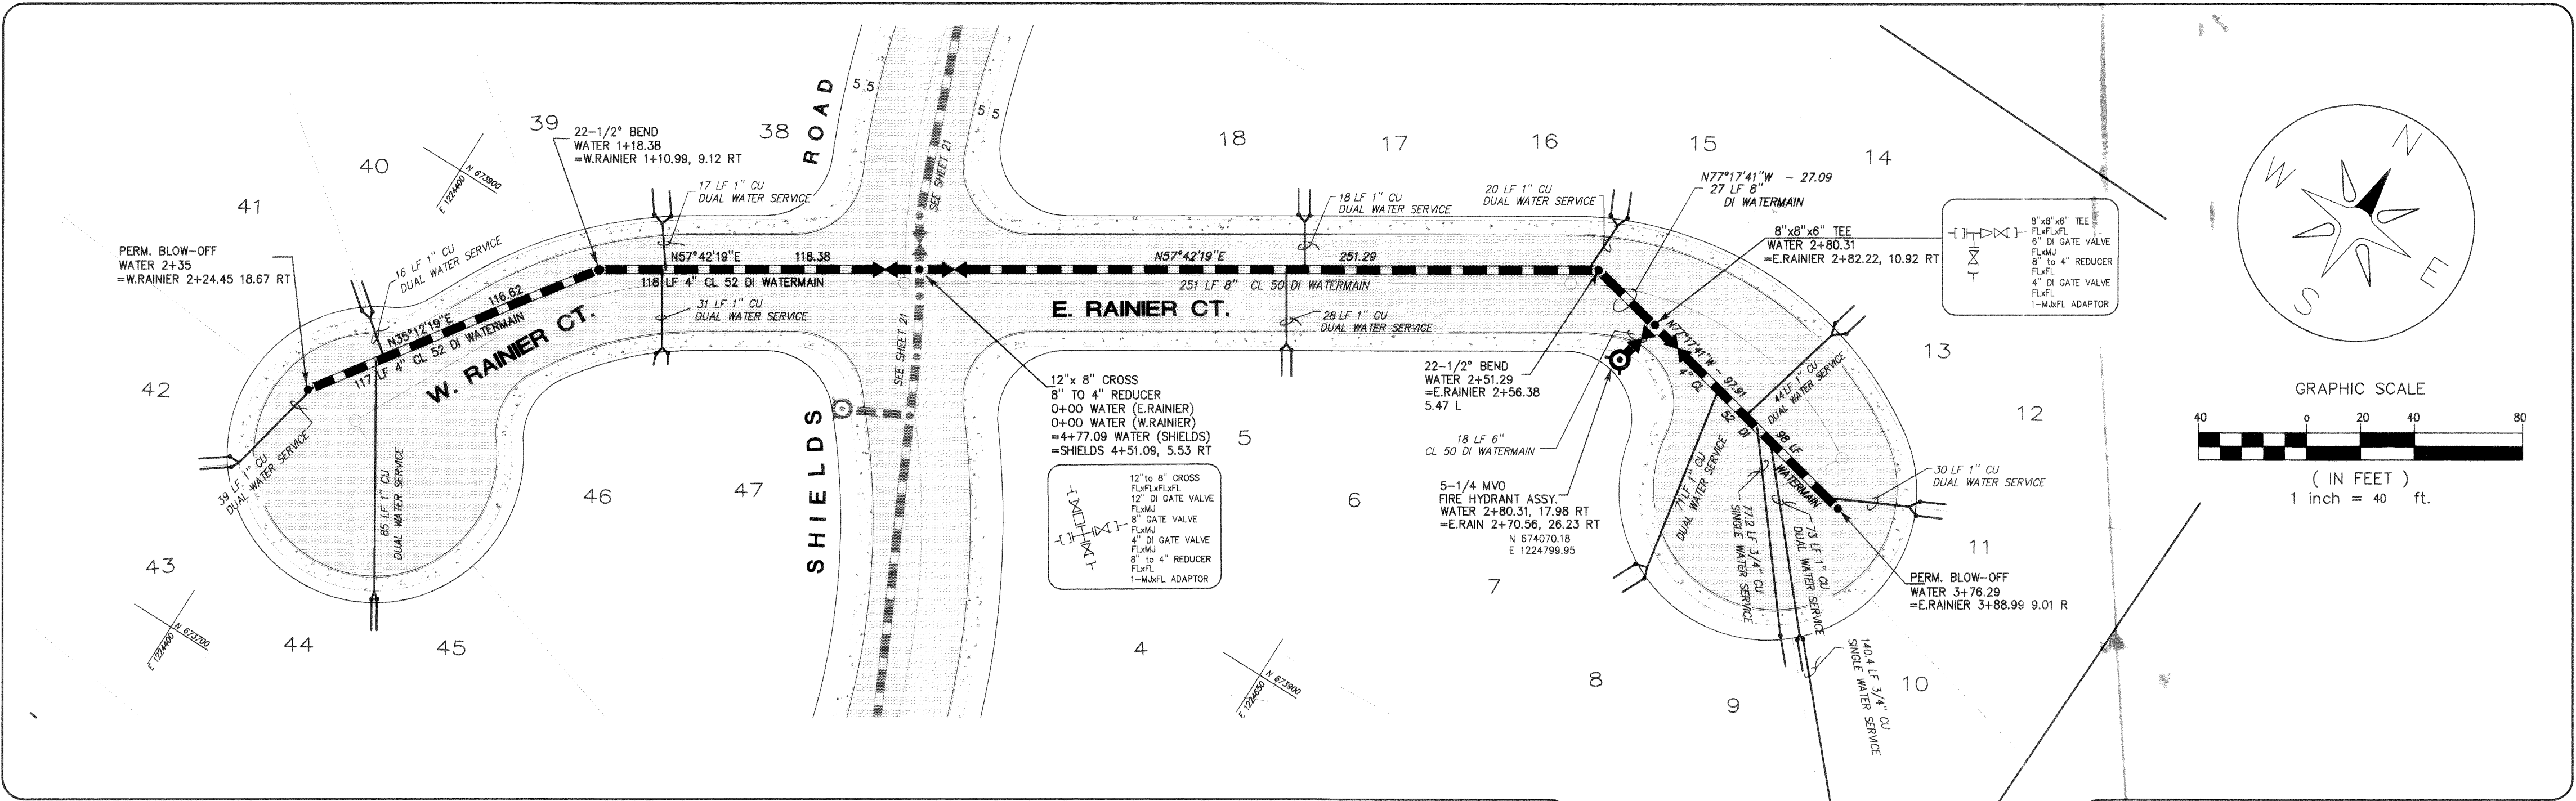

REVISIONS				CONTROL DATUM
NO	DATE	BY	NOTE	
1				
2				
3				
4				
5				
				HORIZONTAL: NAD83(01) WASHINGTON STATE LAMBERT GRID, NORTH ZONE POSITION: CASED MONUMENT (F-10), SOUTHEAST CORNER SEC. 28, T39N, R2E, W.M. E: 673,433.53 N: 1,226,474.60 MERIDIAN: SOUTH LINE OF THE SOUTHEAST QUARTER OF SECTION 28, WA-5 & 6. VERTICAL: NGVD 1929, RAILROAD SPIKE #3, POINT 1050 NORTH OF SMITH ROAD ON THE FRONTAGE ROAD EAST OF I-5 ELEVATION = 81.03

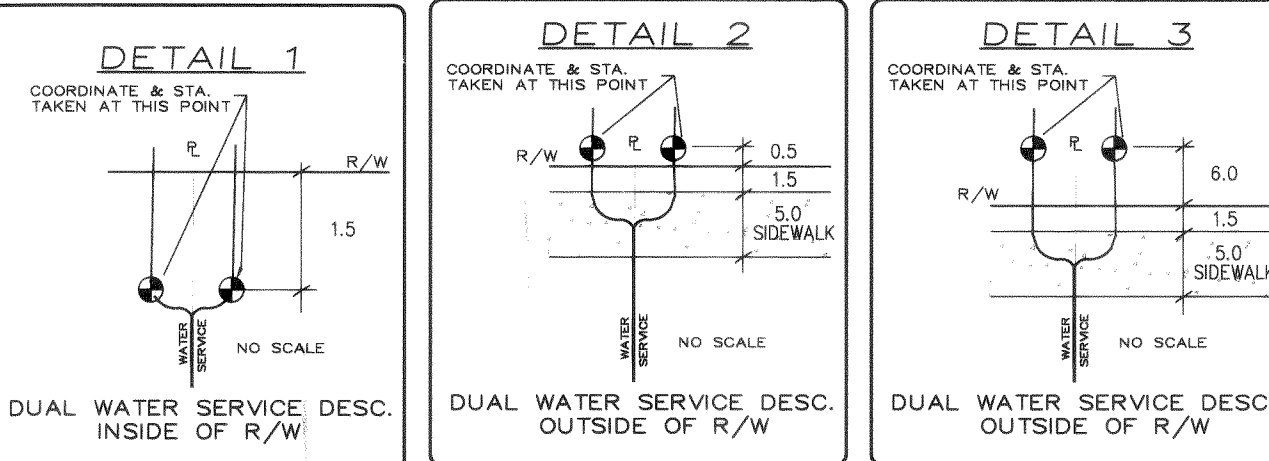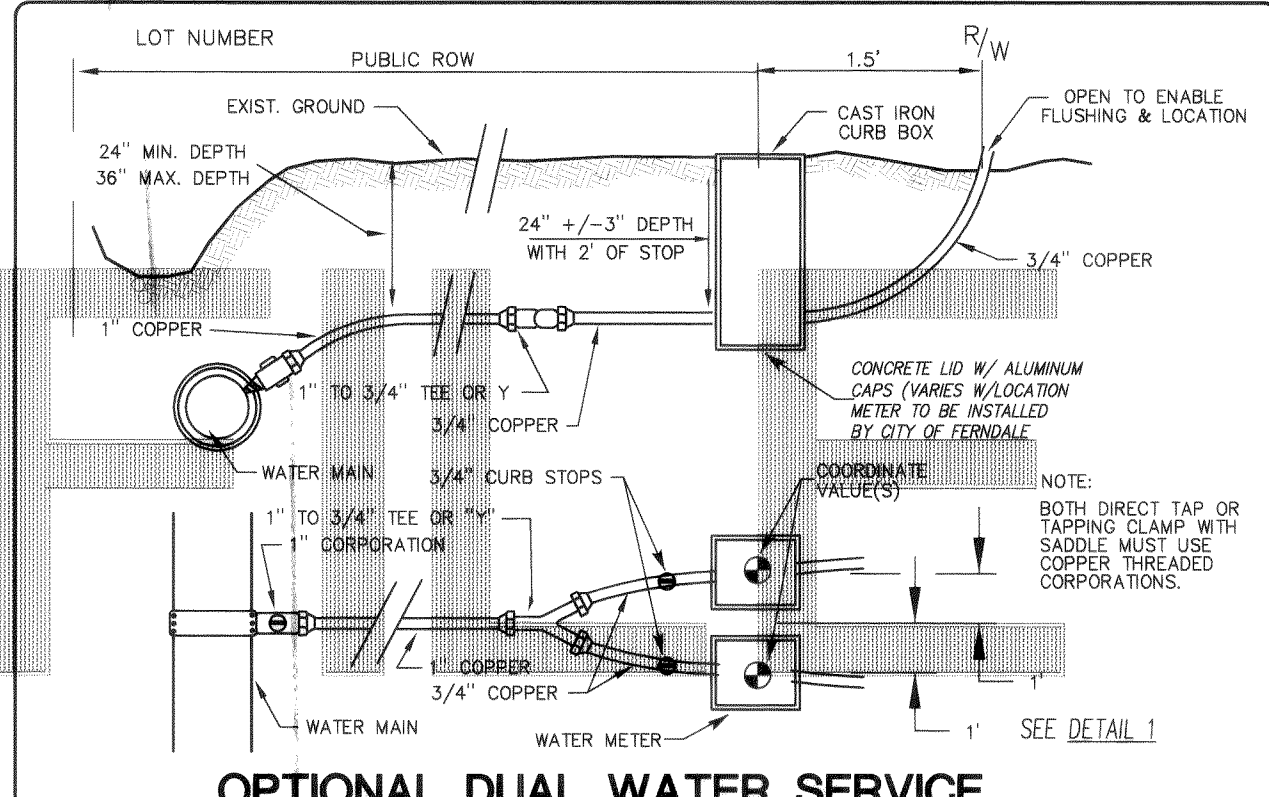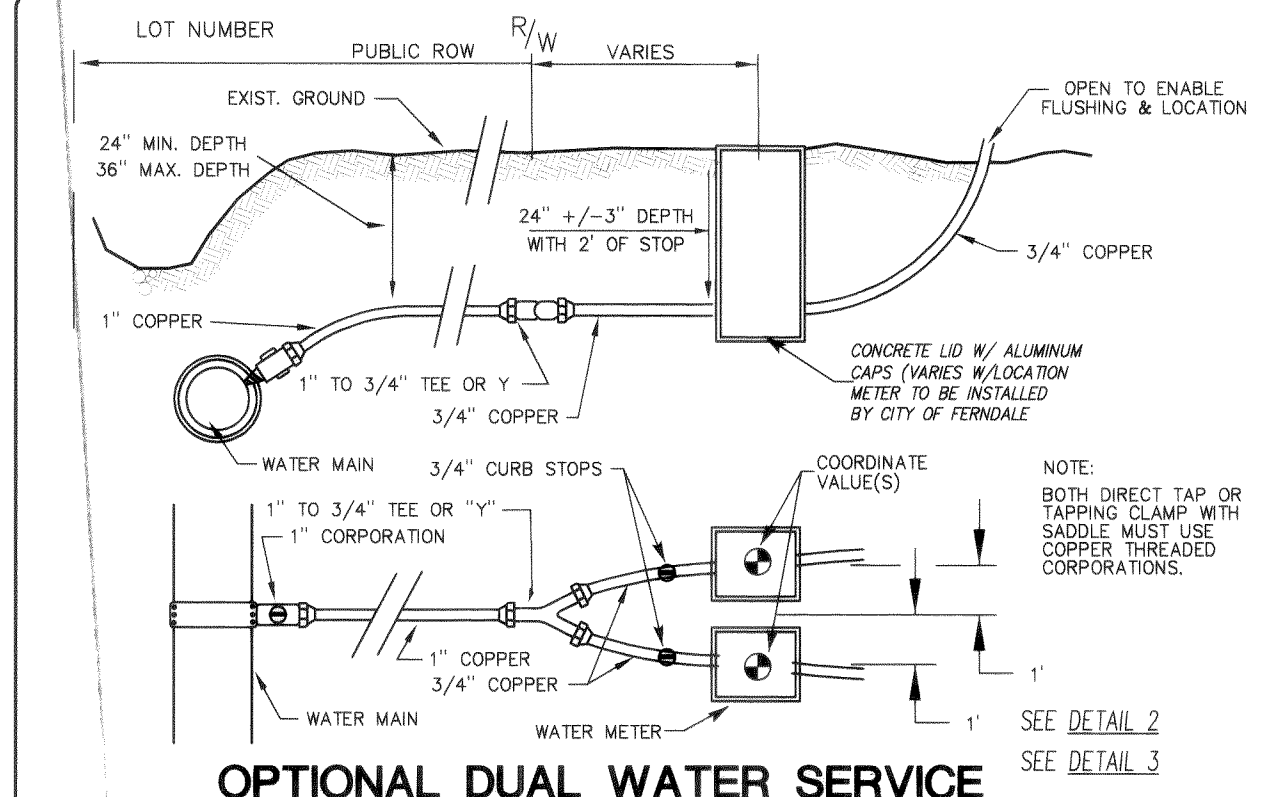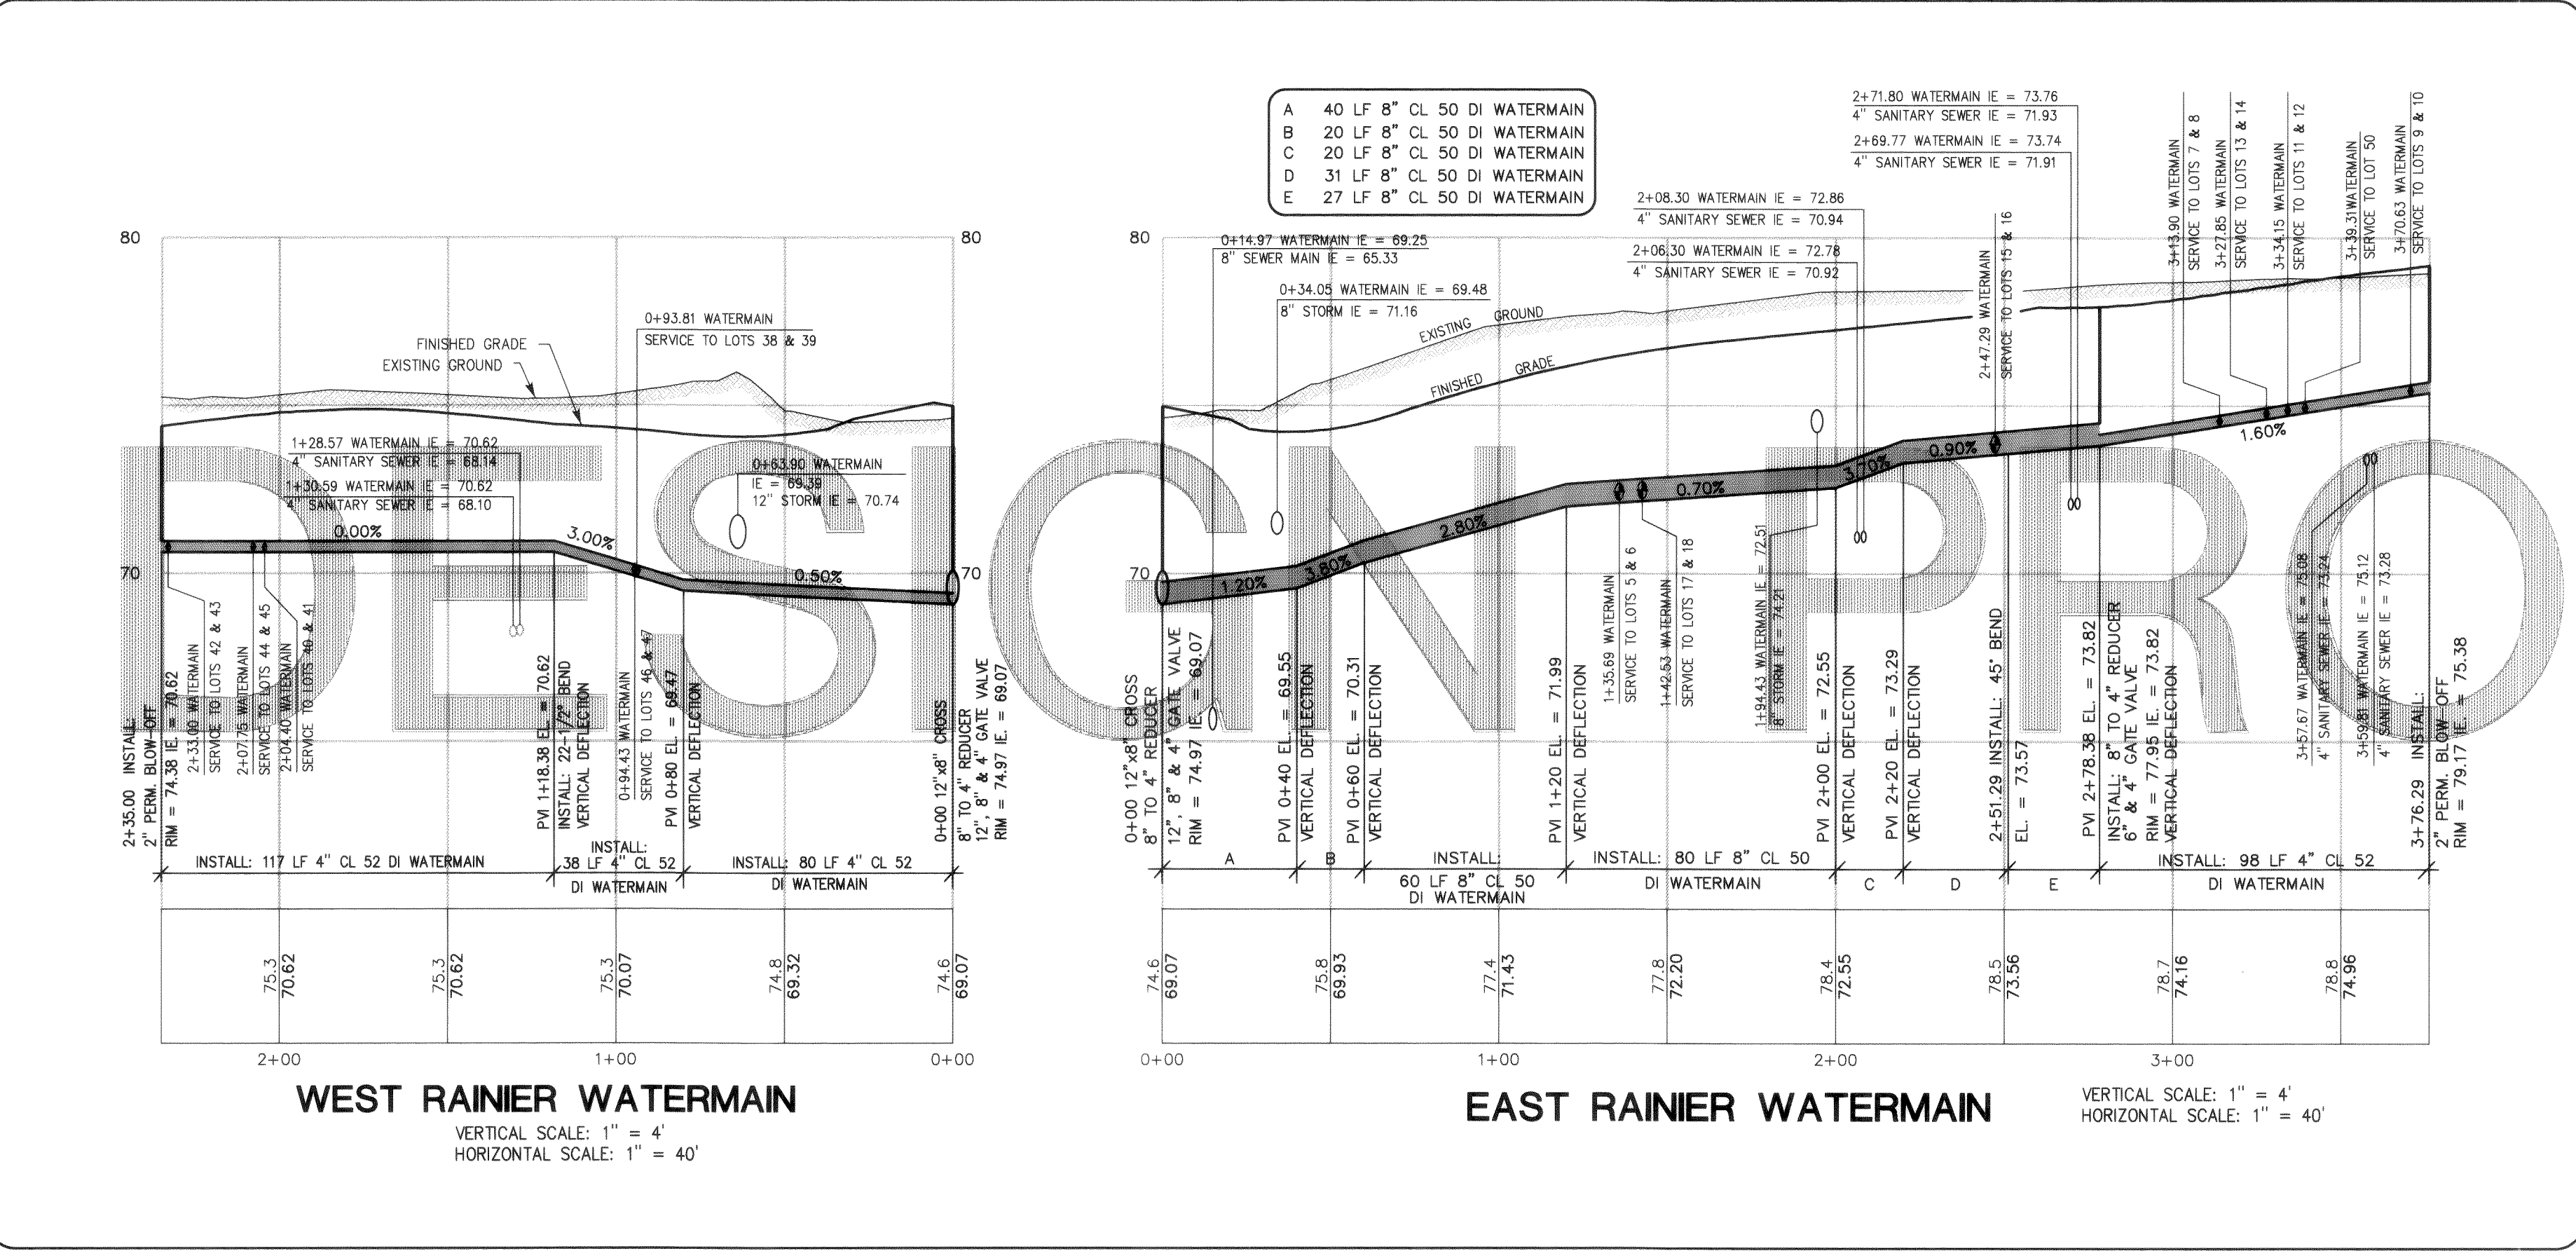

- WATER NOTES**
- ALL WORK AND MATERIALS SHALL BE IN ACCORDANCE WITH A.P.W.A. STANDARD SPECIFICATIONS, 1996 EDITION, AND SHALL BE SUBJECT TO APPROVAL BY THE CITY OF FERNDALE.
 - ALL WATER MAINS SHALL BE DUCTILE IRON, THICKNESS CLASS 50 WITH CEMENT LINING.
 - TEST PRESSURE FOR WATER SHALL BE 200 PSI AND SHALL BE DONE IN THE PRESENCE OF THE CITY.
 - TWO INCH BLOW-OFF SHALL BE CONSTRUCTED IN ACCORDANCE WITH DETAIL WA-3 OR WA-4.
 - ALL WORK MUST BE INSPECTED BY A REPRESENTATIVE OF THE CITY ENGINEERING DIVISION, AND 24-HOURS NOTICE MUST BE GIVEN PRIOR TO STARTING WORK.
 - A MYLAR PRINT SHALL BE PROVIDED TO THE CITY FOR THEIR RECORDS, PER WA-8.
 - CONNECTION TO EXISTING CITY WATER MAIN SHALL BE BY THE CITY UPON SATISFACTORY PRESSURE AND SANITARY TESTING.
 - WATER SERVICES SHALL BE IN ACCORDANCE WITH CITY SPECIFICATIONS, PER WA-5 & 6.
 - CONTRACTOR SHALL CONTACT UTILITY LOCATION SERVICE AT (800)424-5555, 48 HOURS IN ADVANCE OF WORK.
 - CONTRACTOR SHALL RESTORE RIGHT-OF-WAY TO ORIGINAL CONDITIONS.
 - FIRE HYDRANT INSTALLATION SHALL BE IN ACCORDANCE WITH CITY SPEC. WA-1.
 - A REVOCABLE ENCROACHMENT PERMIT SHALL BE OBTAINED PRIOR TO COMMENCING WORK IN THE RIGHT-OF-WAY.
 - NO FINAL TESTING UNTIL ALL UNDERGROUND UTILITIES ARE IN PLACE.
 - SINGLE SERVICES SHALL BE 3/4" COPPER PIPE
 - DUAL SERVICES SHALL BE 1" COPPER PIPE
 - WATER PURIFICATION TESTS-2 TESTS, 24 HOURS APART. ZERO BACTERIA & ZERO ATYPICAL COUNTS FOR BOTH TESTS.

- DESIGN CRITERIA**
- PROVIDE RESIDENTIAL WATER SERVICE TO ALL LOTS
 - PROVIDE MINIMUM FIRE FLOW OF 750 GPM AT RESIDUAL PRESSURE OF 20 PSI
 - CONNECT TO EXISTING WATER SUPPLY SYSTEM
 - MINIMIZE SINGLE SERVICE CONNECTIONS
 - USE MINIMUM CLASS 50 DUCTILE IRON PIPING
 - MINIMIZE OVERALL PIPE LENGTH
 - MINIMIZE NUMBER OF FITTINGS AND CONNECTIONS
 - MINIMIZE EXCAVATION
 - PROVIDE 3.5 FEET OF PIPE COVER
 - USE 3/4" CU PIPE FOR SINGLE SERVICES
 - USE 1" CU PIPE FOR DUAL SERVICE

CENTERLINE	9	ADJACENT PROPERTY LOT NUMBER
LOT LINES	376.0	EXISTING GROUND ELEV
PROPERTY/ROW LINE	373.70	PIPE INVERT ELEVATION
LIMITED ACCESS	2.00	ABBREVIATED LAMBERT GRID COORDINATES
ESTIMATED ROCK	XXX	SIDEWALK
EXISTING GROUND		PAVEMENT
1" OR 3/4" CU H2O SERVICE		
LOT SERVICE (PROFILE)		
FIRE HYDRANT	45	
BLOW-OFF		
DUCTILE IRON WATERMAIN		

DRAWN BY _____ DATE _____

DRAWN BY _____ DATE _____

JOB # 97015

SHIELDS ESTATES

FOR: **TEITGE, WILLIAMS & McCOLLUM INVESTMENTS, INC.**

PROFESSIONAL CERTIFICATION

HARRY P. JONES, PE

EXPIRES: MAY 19, 1999

JONES ENGINEERS INCORPORATED, P.S.

CONSULTING ENGINEERS

851 COHO WAY, SUITE 307

BELLINGHAM, WA 98225 (360) 733-8888

AS-BUILT

SHIELDS ESTATES

WATERMAIN PLAN & PROFILE:

RAINIER COURT

DEPARTMENT OF PUBLIC WORKS

FERNDALE, WASHINGTON

APPROVED

This plan has been reviewed and found to be in conformance with department standards.

CITY ENGINEER _____ DATE _____






SHEET

22


OF

35

A PORTION OF THE SW 1/4 OF THE SE 1/4 OF SEC 28 TOWNSHIP 39 NORTH , RANGE 2 EAST , W.M.

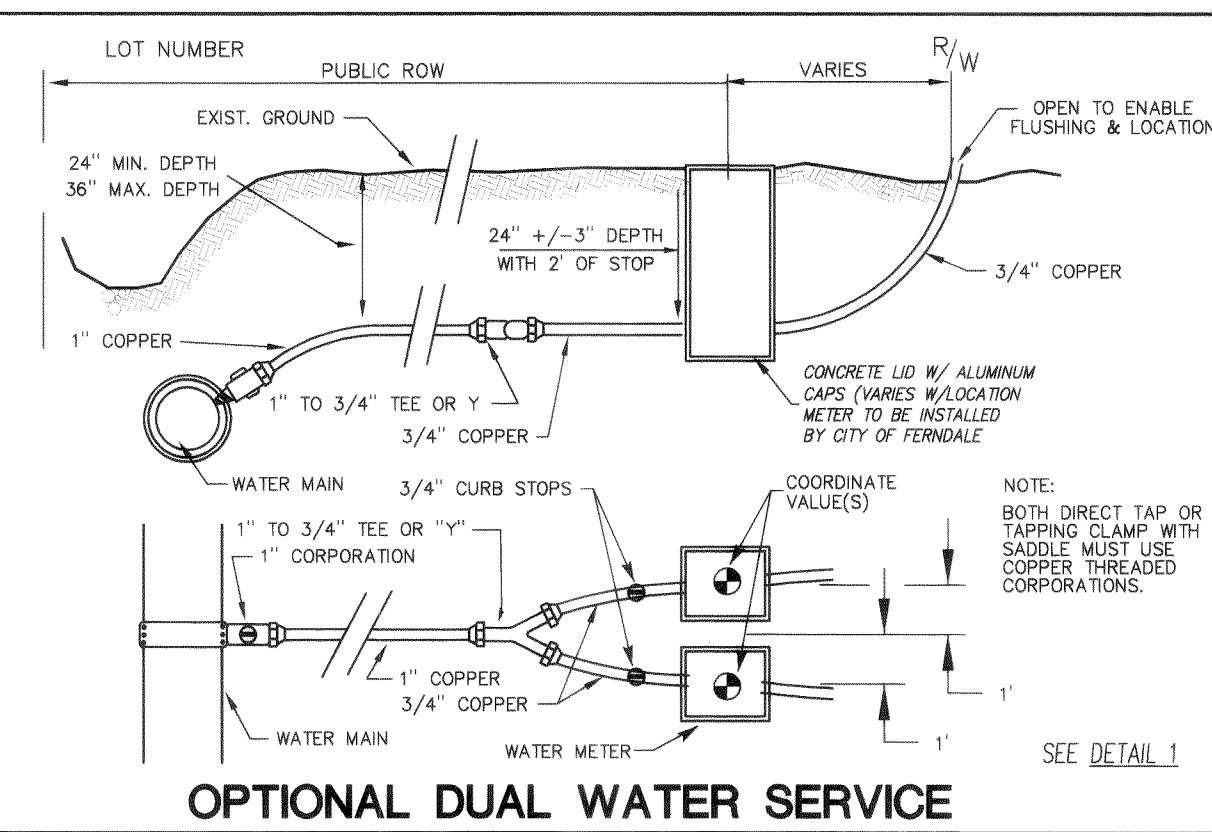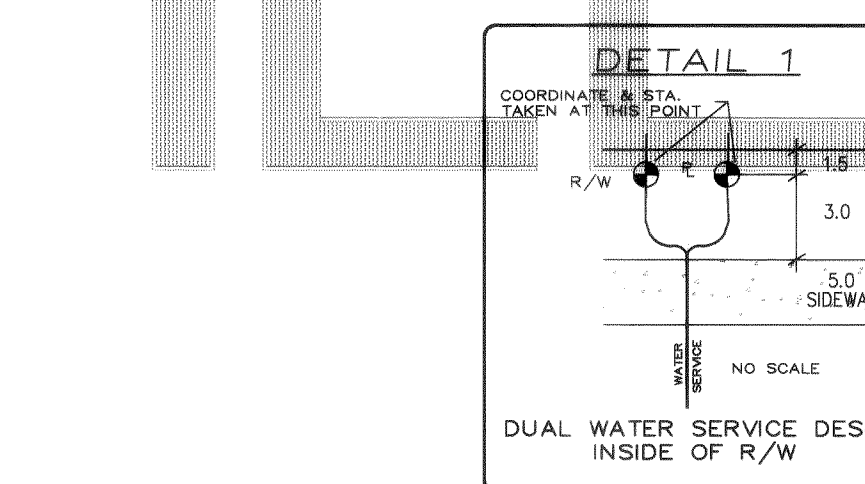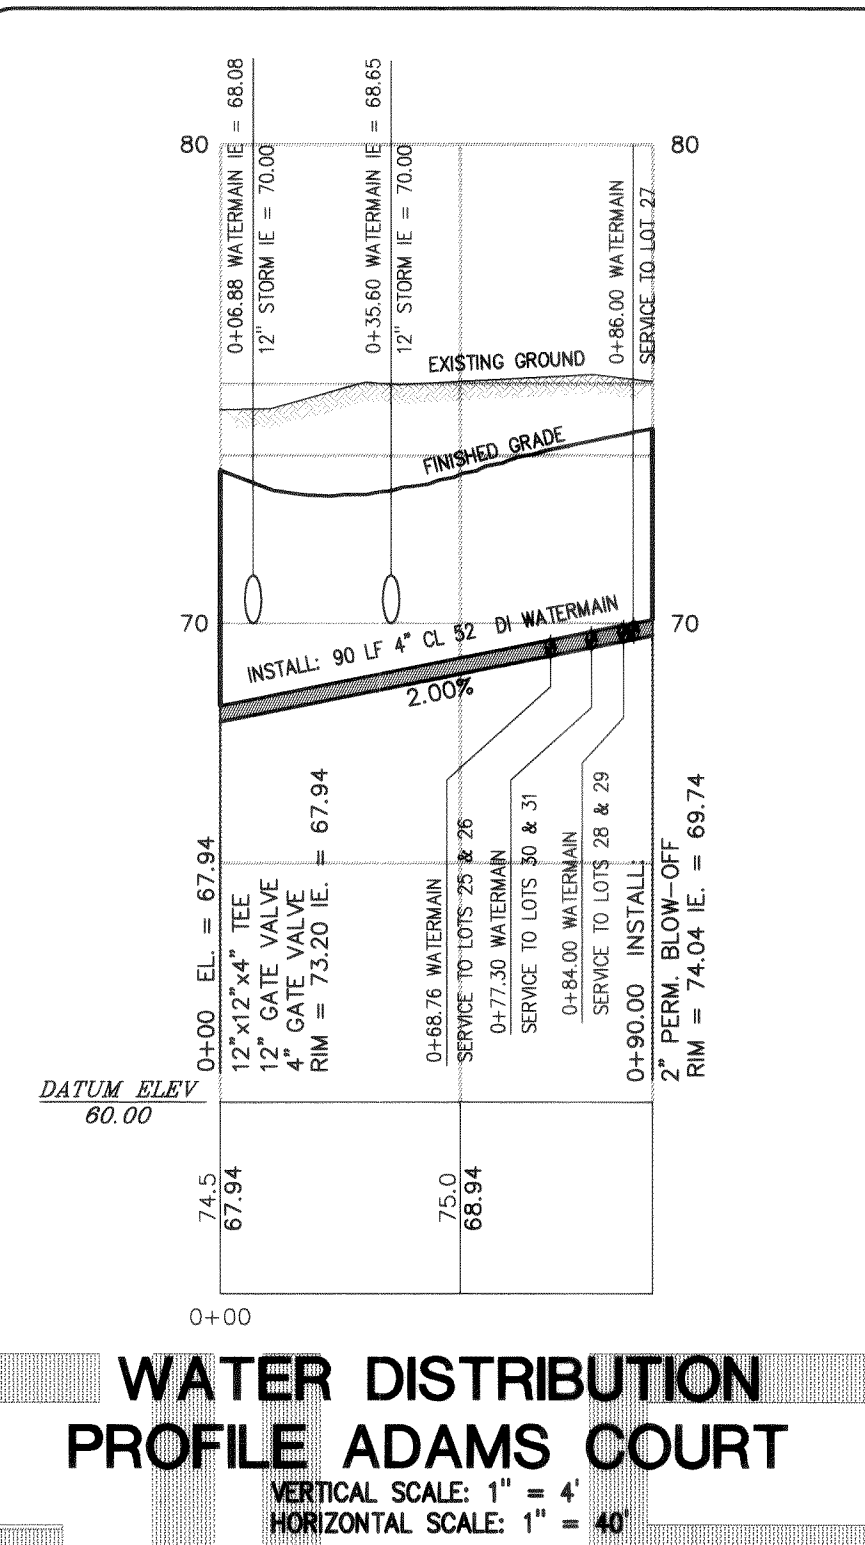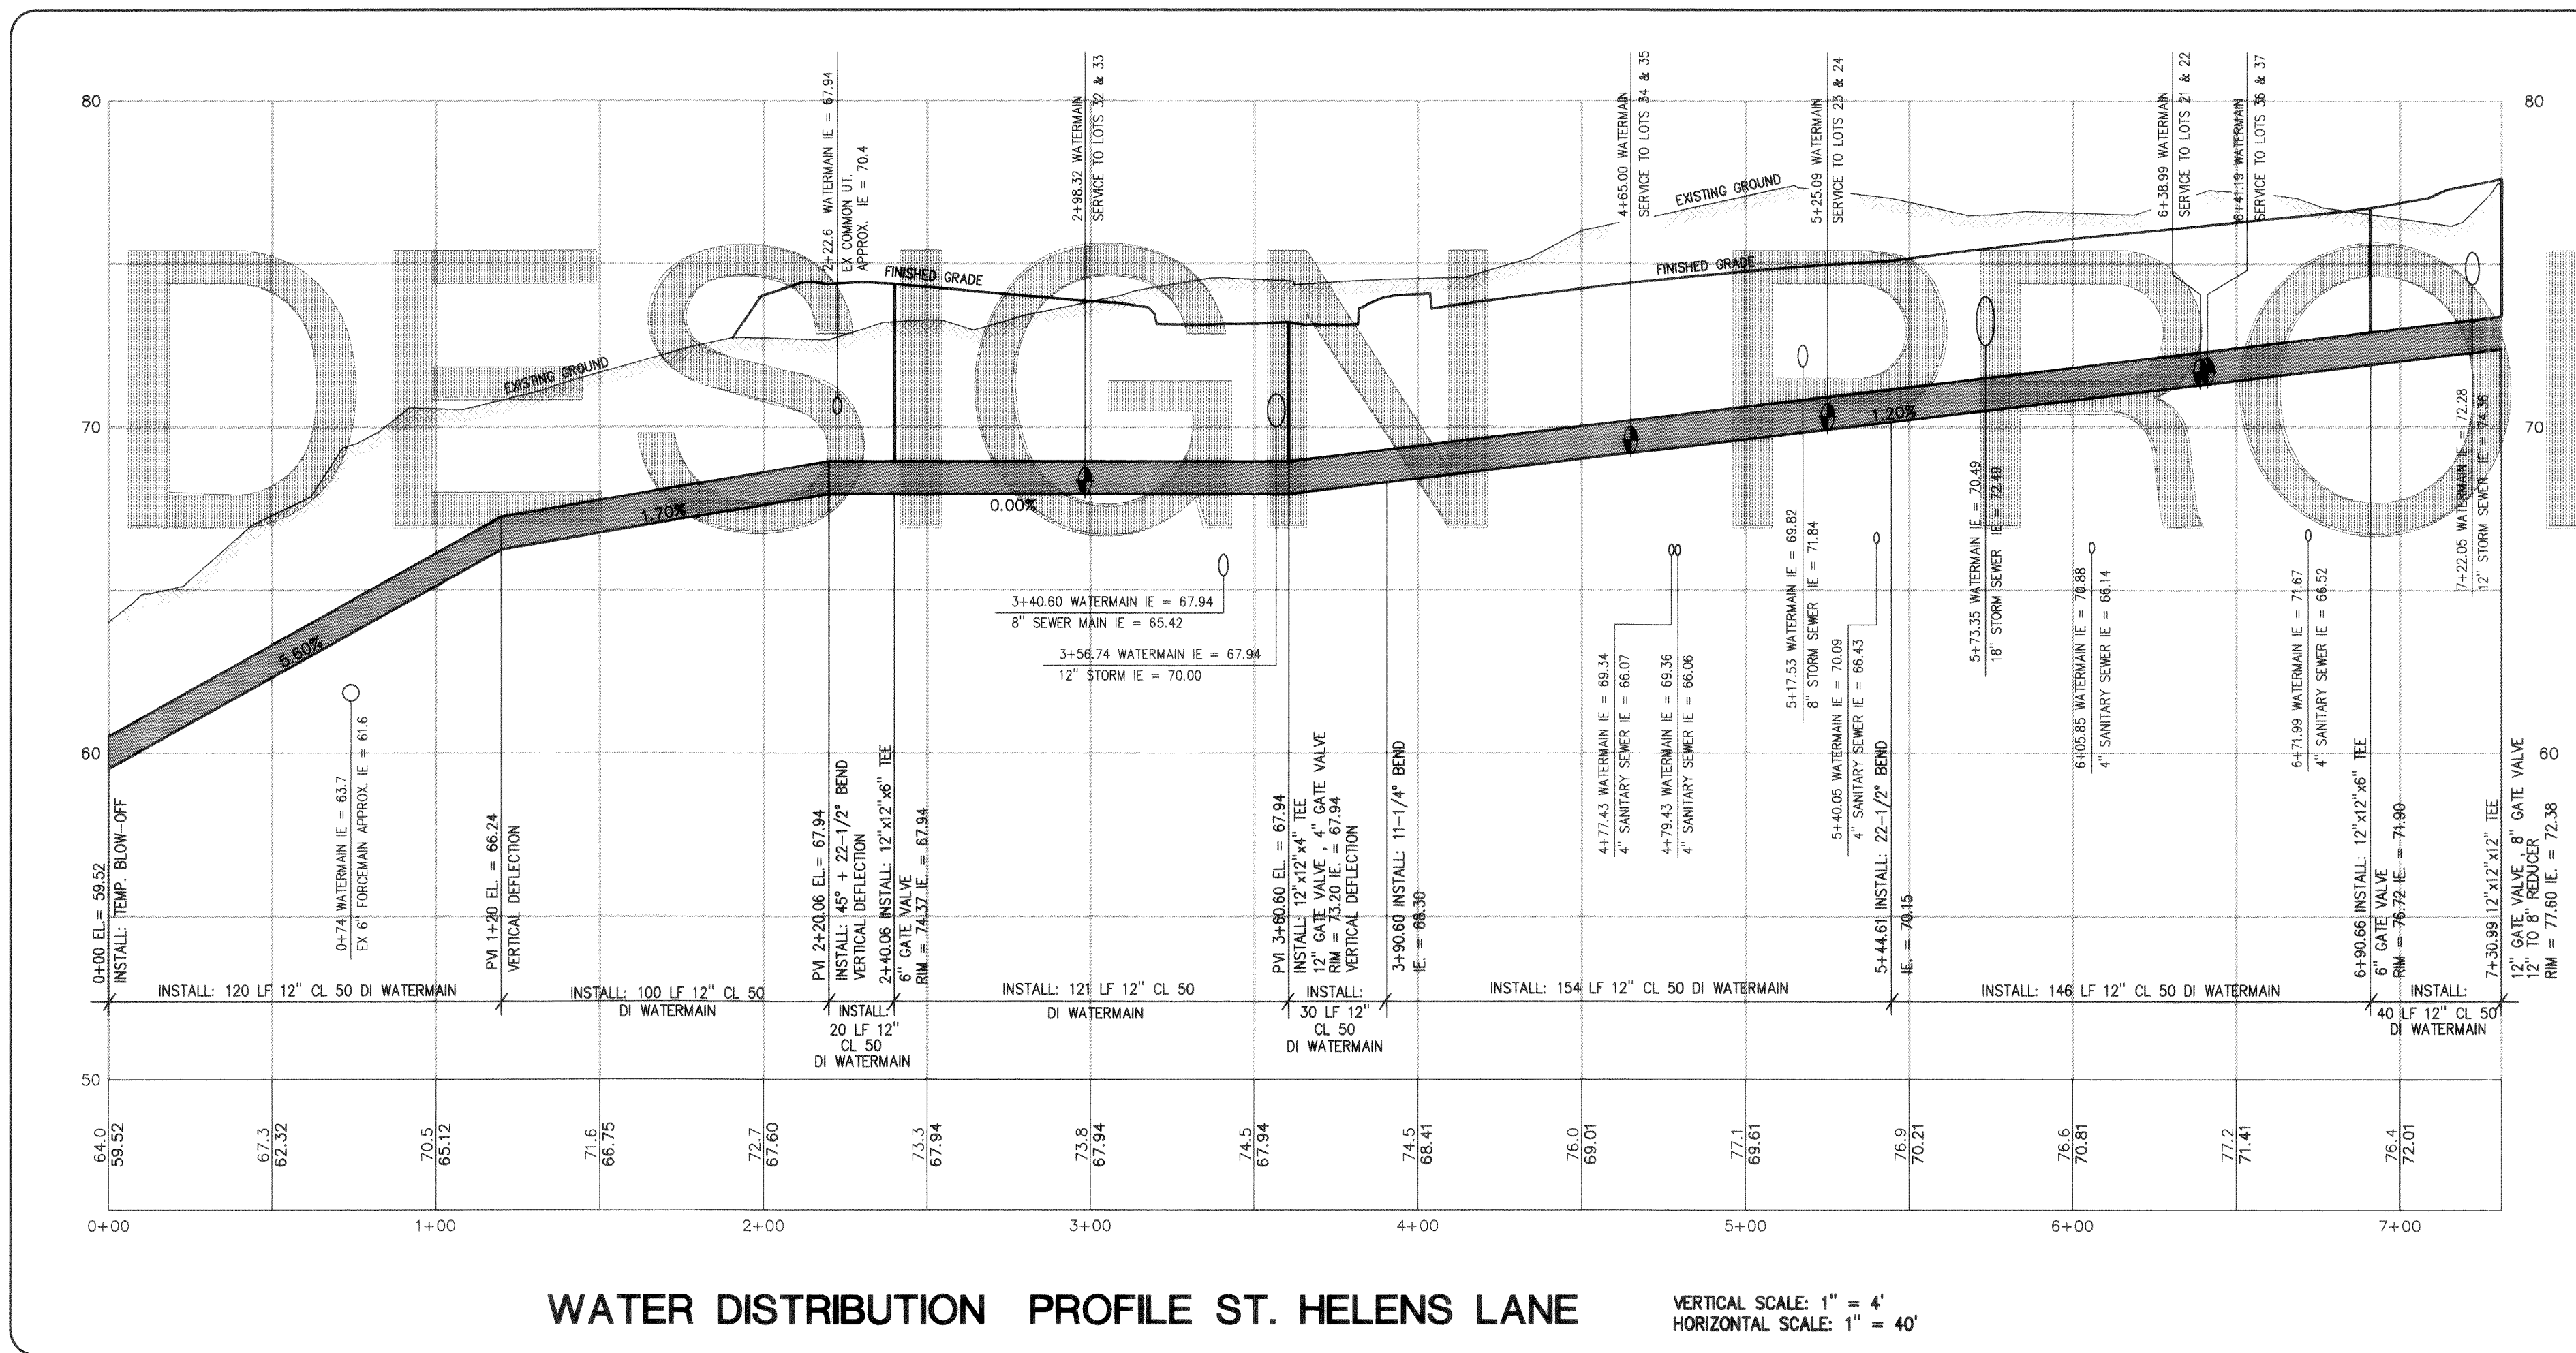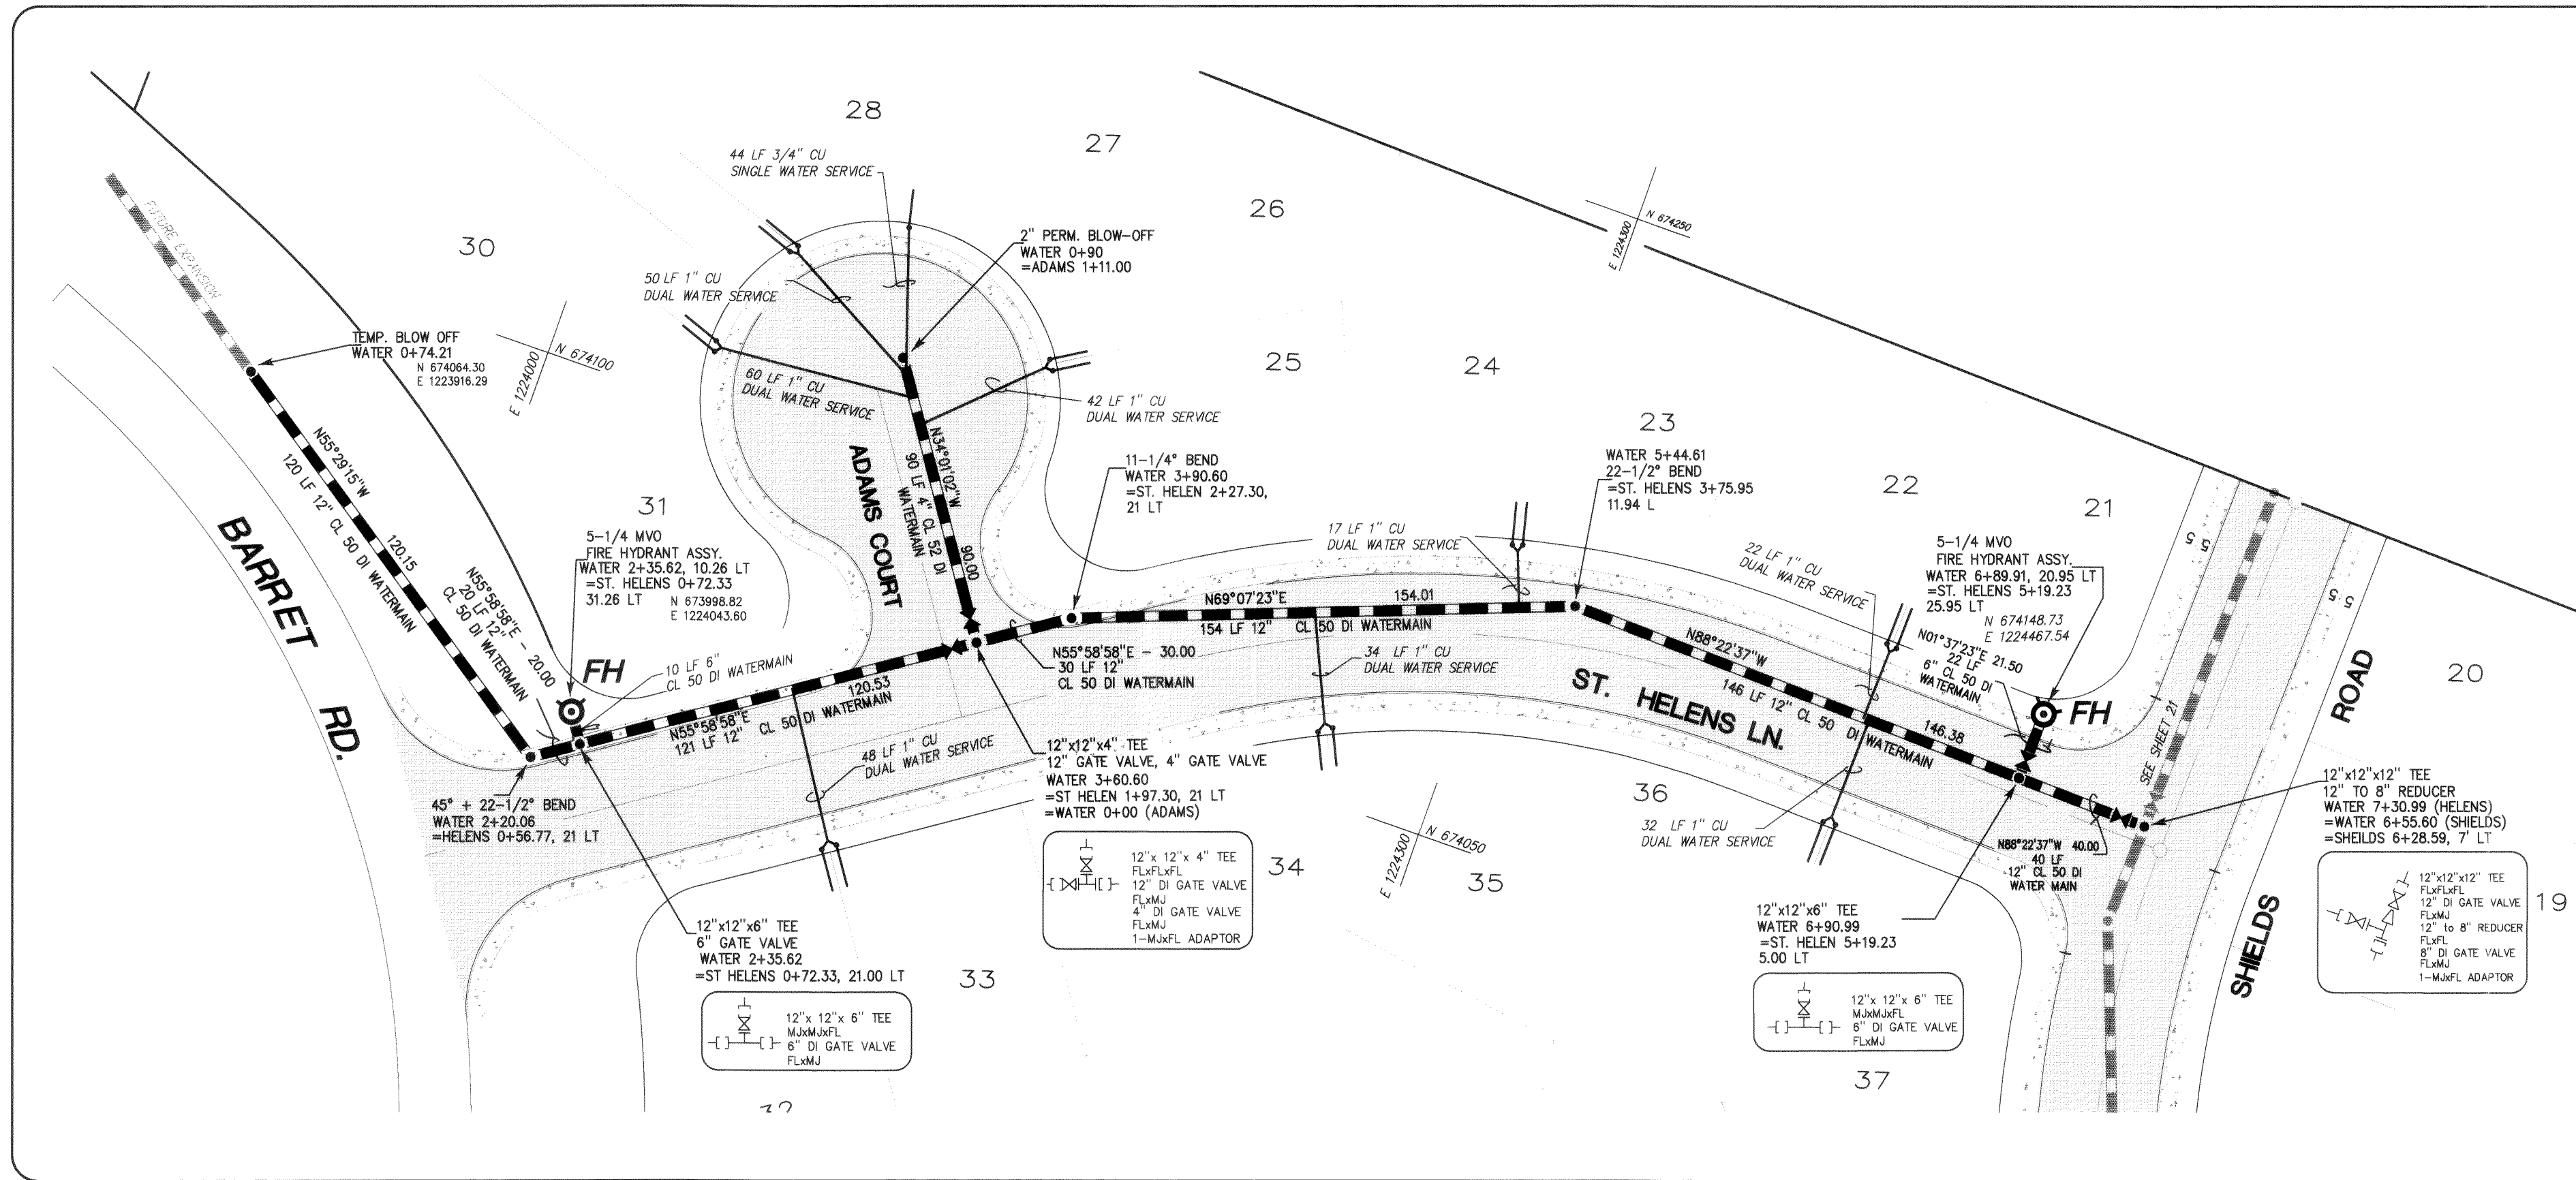

WATER DISTRIBUTION - ST. HELENS / ADAMS JOB NO. 97015

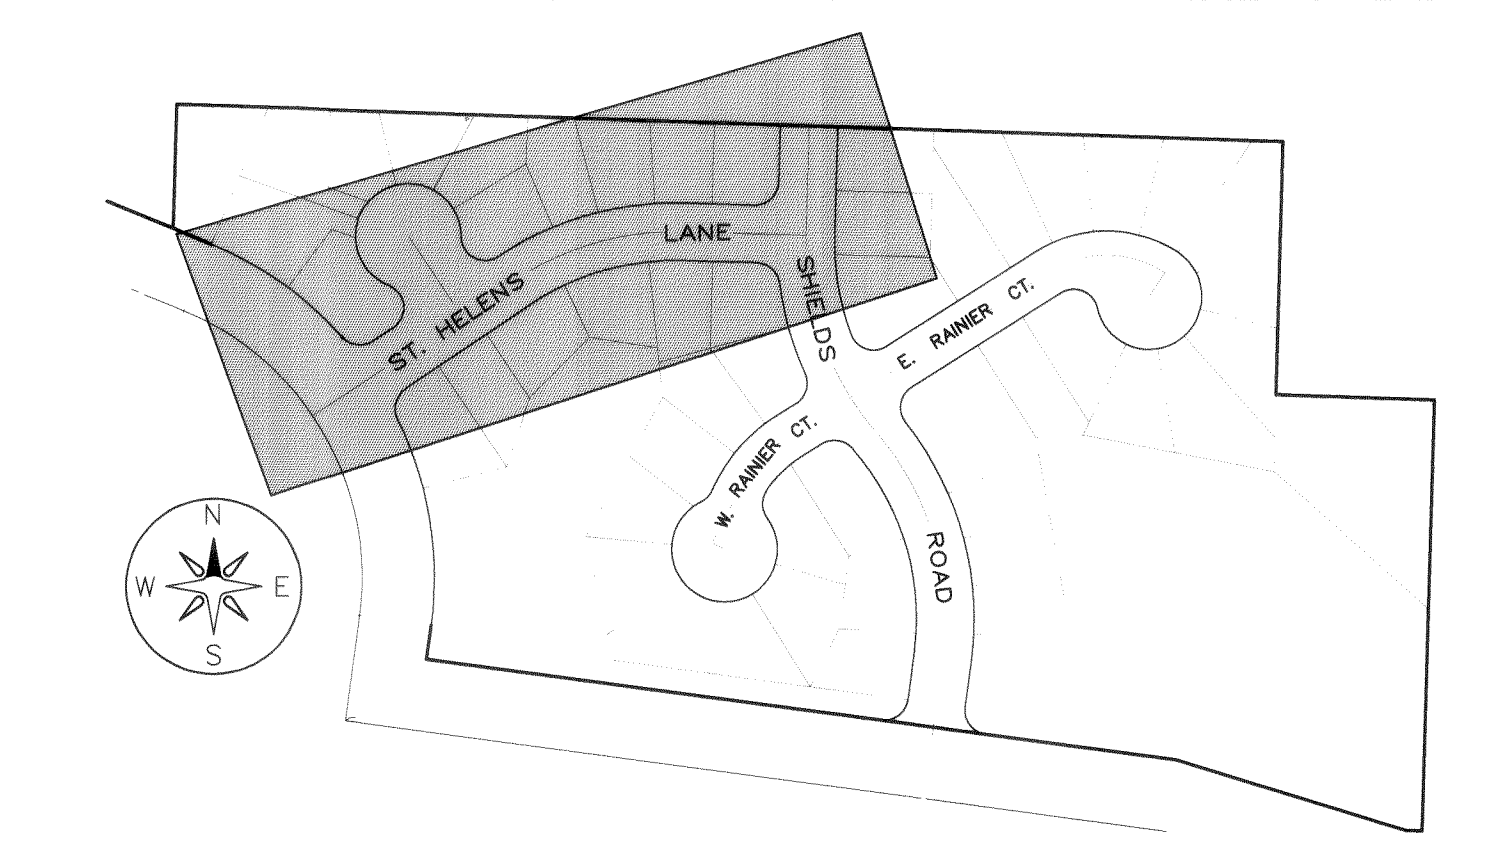

REVISIONS				CONTROL DATUM
NO	DATE	BY	NOTE	
1				
2				
3				

HORIZONTAL: NAD83(91) WASHINGTON STATE LAMBERT GRID, NORTH ZONE
POSITION: CASED MONUMENT (F-10), SOUTHEAST CORNER SEC. 28, T39N, R2E, W.M.
X: 673,433.53
Y: 1,226,474.60
MERIDIAN: SOUTH LINE OF THE SOUTHEAST QUARTER OF SECTION 28, N88°22'49"W
VERTICAL: NGVD 1929, RAILROAD SPIKE #3, POINT 1050 NORTH OF SMITH ROAD ON THE FRONTAGE ROAD EAST OF I-5
ELEVATION = 81.03

- ### WATER NOTES
- ALL WORK AND MATERIALS SHALL BE IN ACCORDANCE WITH A.P.W.A. STANDARD SPECIFICATIONS, 1996 EDITION, AND SHALL BE SUBJECT TO APPROVAL BY THE CITY OF FERNDALE
 - ALL WATER MAINS SHALL BE DUCTILE IRON, THICKNESS CLASS 50 WITH CEMENT LINING.
 - TEST PRESSURE FOR WATER SHALL BE 200 PSI AND SHALL BE DONE IN THE PRESENCE OF THE CITY.
 - TWO INCH BLOW-OFF SHALL BE CONSTRUCTED IN ACCORDANCE WITH DETAIL WA-3 OR WA-4.
 - ALL WORK MUST BE INSPECTED BY A REPRESENTATIVE OF THE CITY ENGINEERING DIVISION, AND 24 HOURS NOTICE MUST BE GIVEN PRIOR TO STARTING WORK.
 - A MYLAR PRINT SHALL BE PROVIDED TO THE CITY FOR THEIR RECORDS, PER WA-8.
 - CONNECTION TO EXISTING CITY WATER MAIN SHALL BE BY THE CITY UPON SATISFACTORY PRESSURE AND SANITARY TESTING.
 - WATER SERVICES SHALL BE IN ACCORDANCE WITH CITY SPECIFICATIONS, PER WA-5 & 6.
 - CONTRACTOR SHALL CONTACT UTILITY LOCATION SERVICE AT (800)424-5555, 48 HOURS IN ADVANCE OF WORK.
 - CONTRACTOR SHALL RESTORE RIGHT-OF-WAY TO ORIGINAL CONDITIONS.
 - FIRE HYDRANT INSTALLATION SHALL BE IN ACCORDANCE WITH CITY SPEC. WA-1.
 - A REVOCABLE ENCROACHMENT PERMIT SHALL BE OBTAINED PRIOR TO COMMENCING WORK IN THE RIGHT-OF-WAY.
 - NO FINAL TESTING UNTIL ALL UNDERGROUND UTILITIES ARE IN PLACE.
 - SINGLE SERVICES SHALL BE 3/4" COPPER PIPE
 - DUAL SERVICES SHALL BE 1" COPPER PIPE
 - WATER PURIFICATION TESTS-2 TESTS, 24 HOURS APART. ZERO BACTERIA & ZERO ATYPICAL COUNTS FOR BOTH TESTS.

CENTERLINE	9	ADJACENT PROPERTY LOT NUMBER
LOT LINES	376.0	EXISTING GROUND ELEVATION
PROPERTY/ROW LINE	373.70	PIPE INVERT ELEVATION
LIMITED ACCESS		ABBREVIATED LAMBERT GRID COORDINATES
ESTIMATED ROCK		SIDEWALK
EXISTING GROUND		PAVEMENT
1" OR 3/4" COPPER WATER SERVICE		LOT NUMBER
LOT SERVICE (PROFILE)		
FIRE HYDRANT		
BLOW-OFF		
DUCTILE IRON WATERMAIN	45	

- ### DESIGN CRITERIA
- PROVIDE RESIDENTIAL WATER SERVICE TO ALL LOTS
 - PROVIDE MINIMUM FIRE FLOW OF 750 GPM AT RESIDUAL PRESSURE OF 20 PSI
 - CONNECT TO EXISTING WATER SUPPLY SYSTEM
 - MINIMIZE SINGLE SERVICE CONNECTIONS
 - USE MINIMUM CLASS 50 DUCTILE IRON PIPING
 - MINIMIZE OVERALL PIPE LENGTH
 - MINIMIZE NUMBER OF FITTINGS AND CONNECTIONS
 - MINIMIZE EXCAVATION
 - PROVIDE 3.5 FEET OF PIPE COVER
 - USE 3/4" CU PIPE FOR SINGLE SERVICES
 - USE 1" CU PIPE FOR DUAL SERVICE

DRAWN BY _____ DATE _____

DRAWN BY _____ DATE _____

JOB # 97015

FOR:

TEITGE, WILLIAMS & McCOLLUM INVESTMENTS, INC.


PROFESSIONAL CERTIFICATION

I HEREBY CERTIFY THAT THIS PLAN ACCURATELY DEPICTS THE MATERIALS, TYPES, AND LOCATIONS OF THE IMPROVEMENTS SHOWN HEREON AS OF THIS DATE.

Harry P. Jones

HARRY P. JONES, P.E.

DATE _____

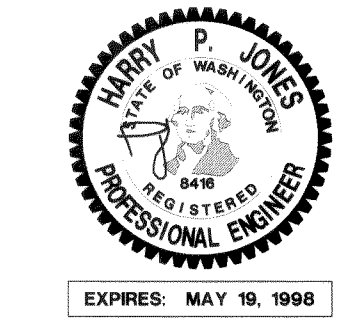

JONES ENGINEERS INCORPORATED, P.S.

CONSULTING ENGINEERS

851 COHO WAY, SUITE 307
BELLINGHAM, WA 98225 (360) 733-8888

AS-BUILT

SHIELDS ESTATES

WATER MAIN PLAN & PROFILE:

ST. HELENS LANE / ADAMS COURT

DEPARTMENT OF PUBLIC WORKS

FERDALE, WASHINGTON

APPROVED

This plan has been reviewed and found to be in conformance with department standards.

CITY ENGINEER _____ DATE _____



SHEET

23

OF

35

A PORTION OF THE SW 1/4 OF THE SE 1/4 OF SEC 28 TOWNSHIP 39 NORTH , RANGE 2 EAST , W.M.

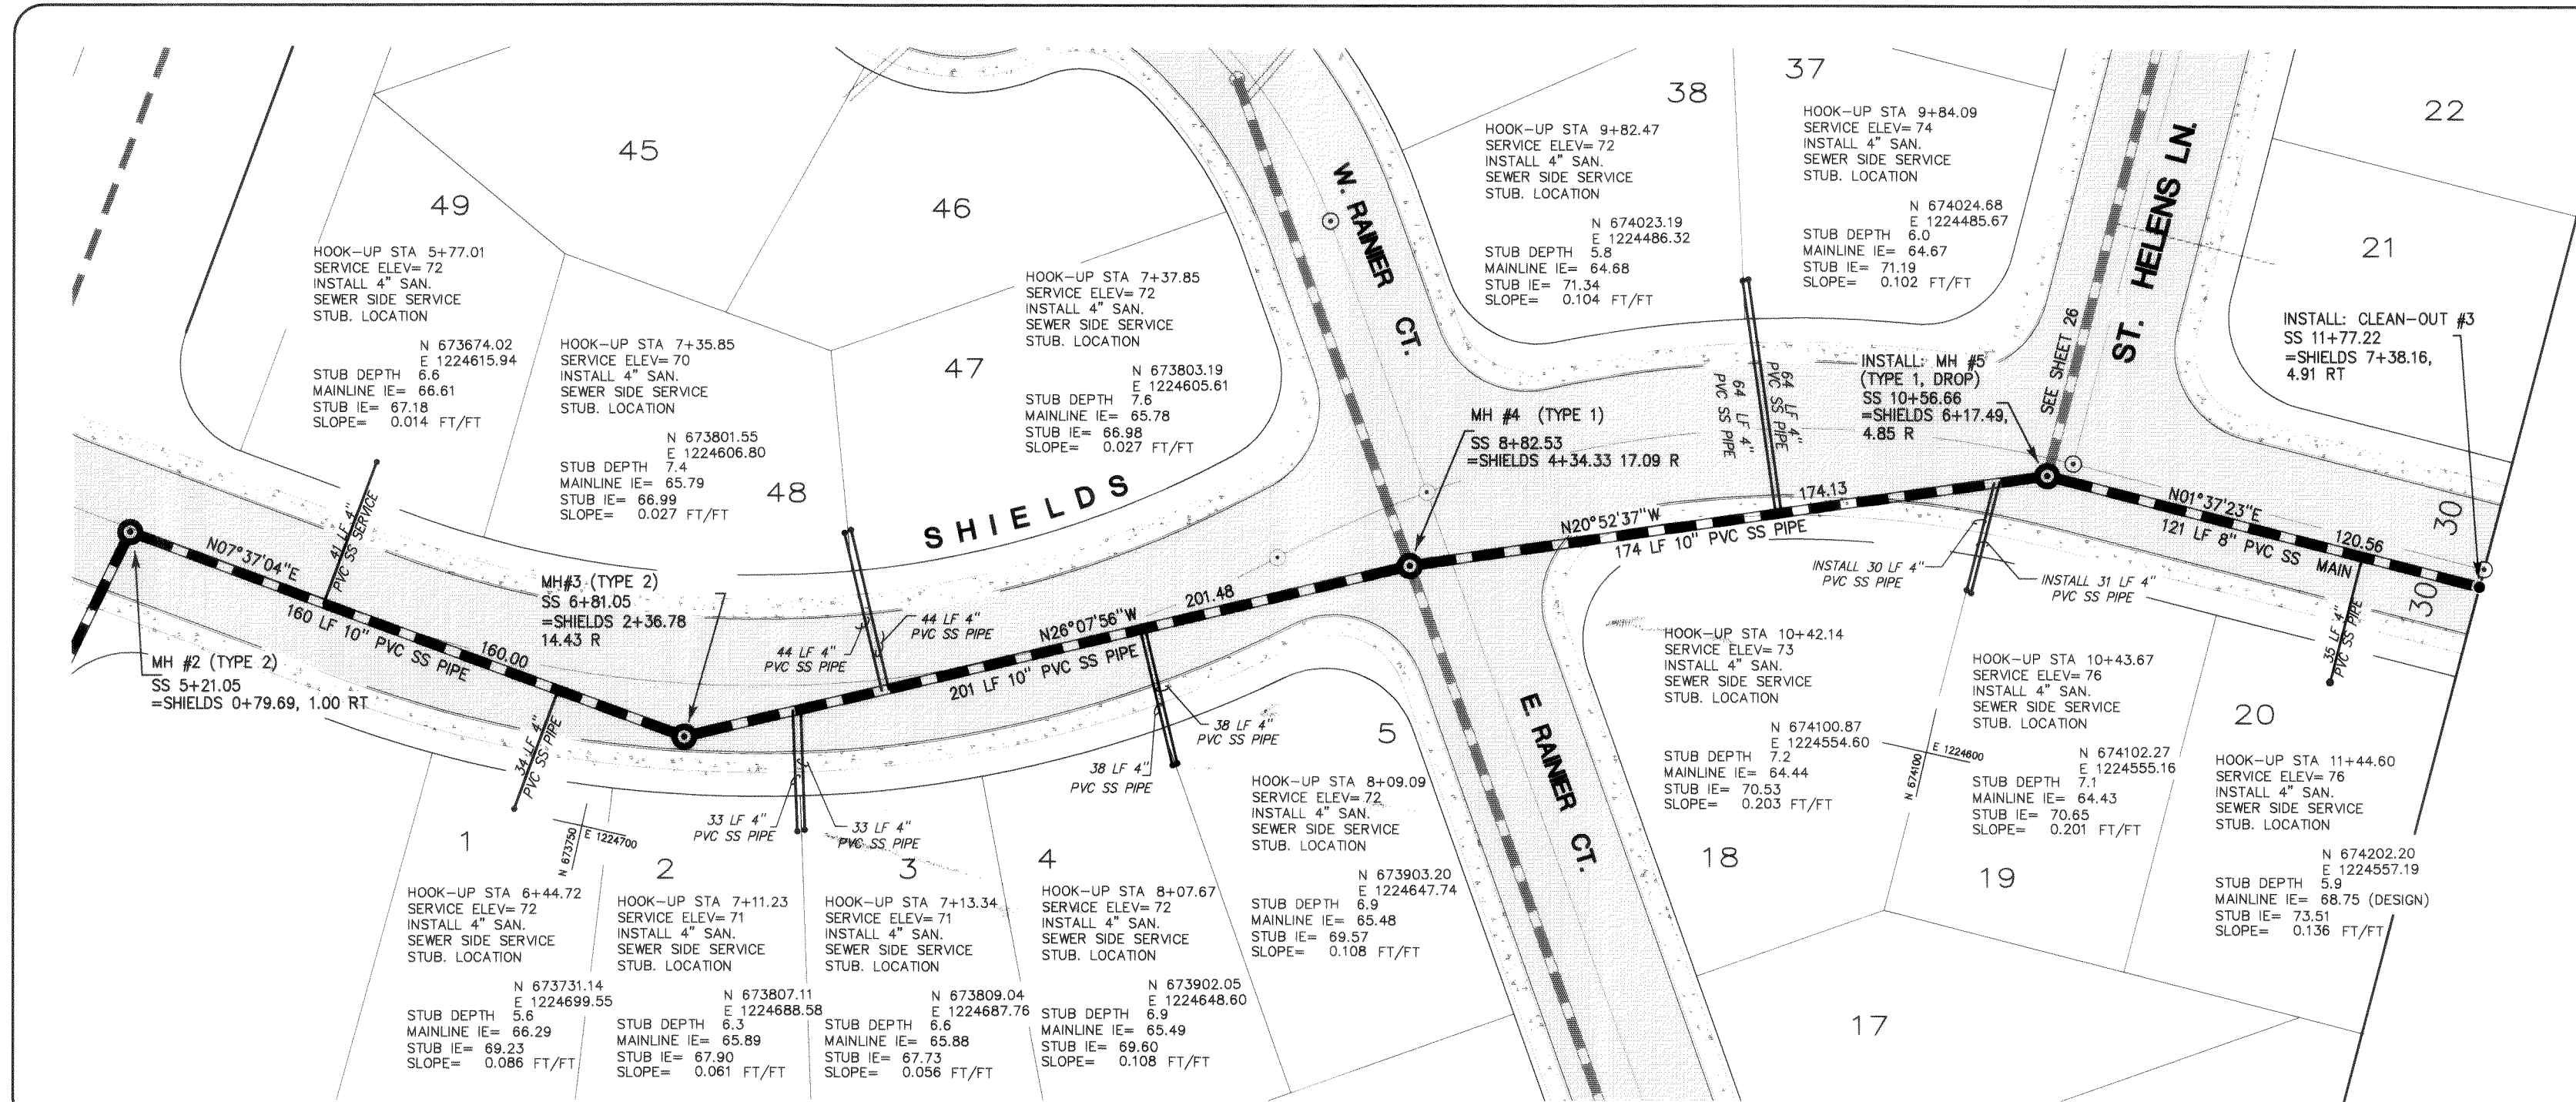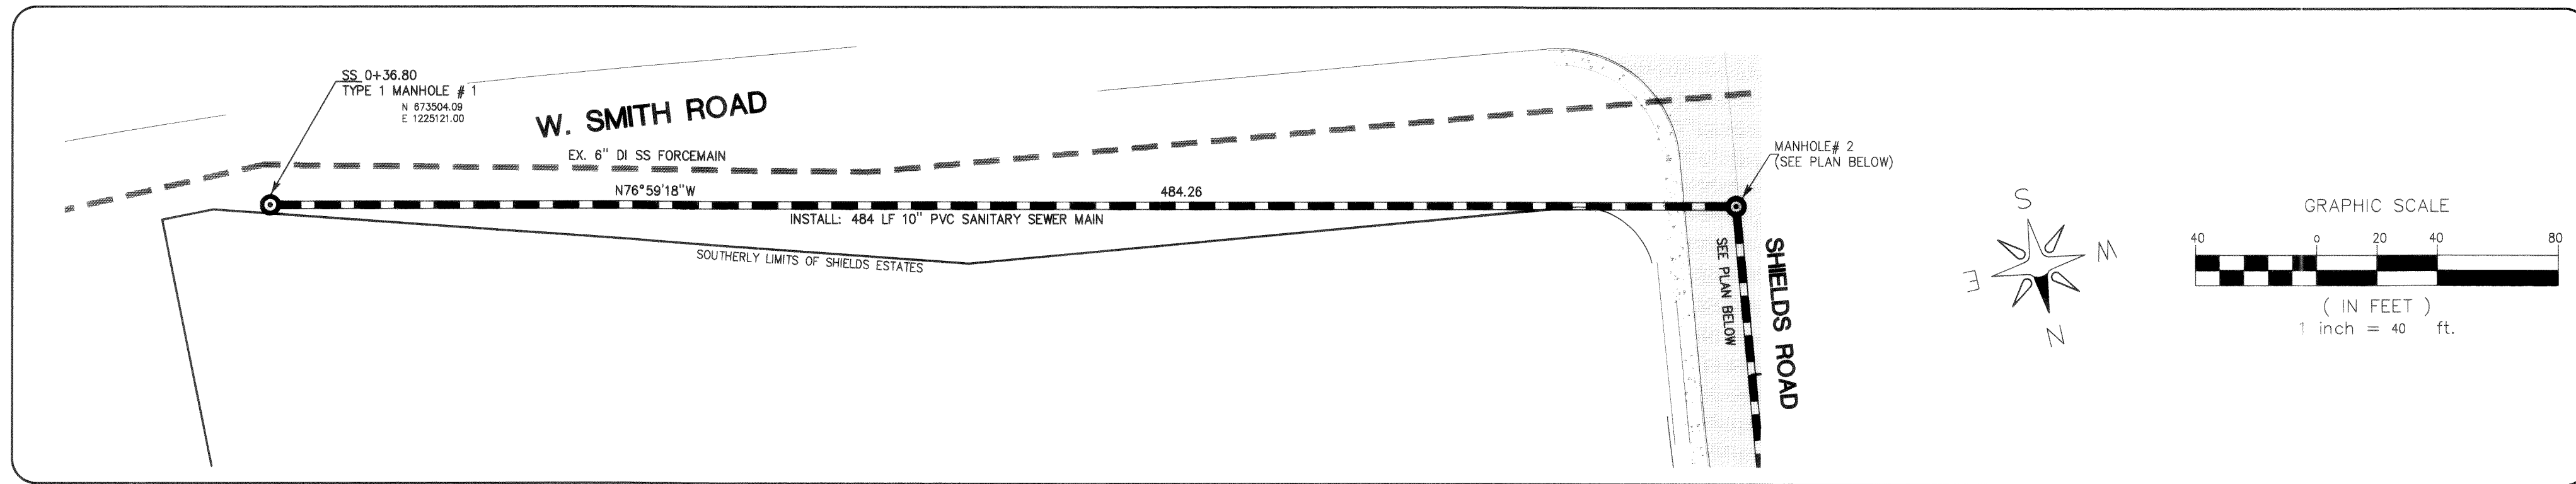

SANITARY SEWER NOTES

- ALL WORK AND MATERIALS SHALL BE IN ACCORDANCE WITH A.P.W.A. STANDARD SPECIFICATIONS, 1996 EDITION, AND SHALL BE SUBJECT TO APPROVAL BY THE CITY OF FERNDALE.
- ALL WORK MUST BE INSPECTED BY A REPRESENTATIVE OF THE CITY ENGINEERING DIVISION AND THE DESIGN ENGINEER, AND 24 HOUR NOTICE MUST BE GIVEN PRIOR TO STARTING WORK.
- SEWER MAIN SHALL BE A MINIMUM 8 INCHES DIAMETER PVC CONFORMING TO THE PROVISIONS OF ASTM D 3034 AND INSTALLED TO CITY SPECIFICATIONS.
- TESTING OF THE SEWER SYSTEM SHALL BE DONE IN THE PRESENCE AND UNDER THE SUPERVISION OF A CITY OF FERNDALE REPRESENTATIVE.
- ALL TRENCHES SHALL BE BACKFILLED WITH CLASS B BANK RUN GRAVEL OR SUITABLE NATURAL MATERIAL AS DIRECTED BY THE ENGINEER, AND COMPACTED TO 95% MODIFIED PROCTOR DENSITY.
- A REVOCABLE ENCROACHMENT PERMIT SHALL BE OBTAINED PRIOR TO COMMENCING WORK IN THE RIGHT-OF-WAY.
- A MYLAR AS-BUILT PRINT SHALL BE PROVIDED TO THE CITY FOR THEIR RECORDS.
- ALL MANHOLES SHALL BE INSTALLED PER CITY OF FERNDALE SS-2, SS-3, & SS-4, AND SHALL BE PRECHANNLED.
- SIDE SEWERS SHALL BE INSTALLED PER CITY OF FERNDALE STANDARDS.
- NO FINAL TESTING UNTIL ALL UNDERGROUND UTILITIES ARE IN PLACE.
- MANHOLES CONES ARE TO BE OFFSET SUCH THAT LADDER RUNGS ARE PARALLEL TO THE FLOW.
- BEDDING SHALL BE PEA GRAVEL PER SS-1.
- SEE SHEET 13 FOR SANITARY SEWER DETAILS.
- ALL CLEANOUTS SHALL BE INSTALLED PER CITY OF FERNDALE SS-5.

SANITARY SEWER - SHIELDS ROAD JOB NO. 97015



REVISIONS


NO	DATE	BY	NOTE
1			
2			
3			
4			
5			

CONTROL DATUM

HORIZONTAL: NAD83(91) WASHINGTON STATE LAMBERT GRID, NORTH ZONE
 POSITION: CASED MONUMENT (F-10), SOUTHEAST CORNER SEC. 28, 139N, R2E, W.M.
 Y: 673,433.53
 X: 1,226,474.60
 MERIDIAN: SOUTH LINE OF THE SOUTHEAST QUARTER OF SECTION 28, N88°22'49"W
 VERTICAL: NGVD 1929, RAILROAD SPIKE #3, POINT 1050 NORTH OF SMITH ROAD ON THE FRONTAGE ROAD EAST OF I-5
 ELEVATION = 81.03

LEGEND

---	CENTERLINE	376.0	EXISTING GROUND ELEVATION
---	LOT LINES	373.70	FINISHED GRADE ELEVATION
---	PROPERTY/ROW LINE	▲	TOP OF ROCK ELEV
---	LIMITED ACCESS	XXXX	AT TEST PIT
---	EXISTING GROUND	46	ABBREVIATED LAMBERT GRID COORDINATES
○	SANITARY SEWER MANHOLE		LOT NUMBER
●	CLEAN-OUT		SANITARY SEWER SERVICE AT MAINLINE I.E. (PROFILE)
---	4" PVC SS SERVICE		
---	PVC SS MAIN		EXISTING 6" DI SS FORCEMAIN

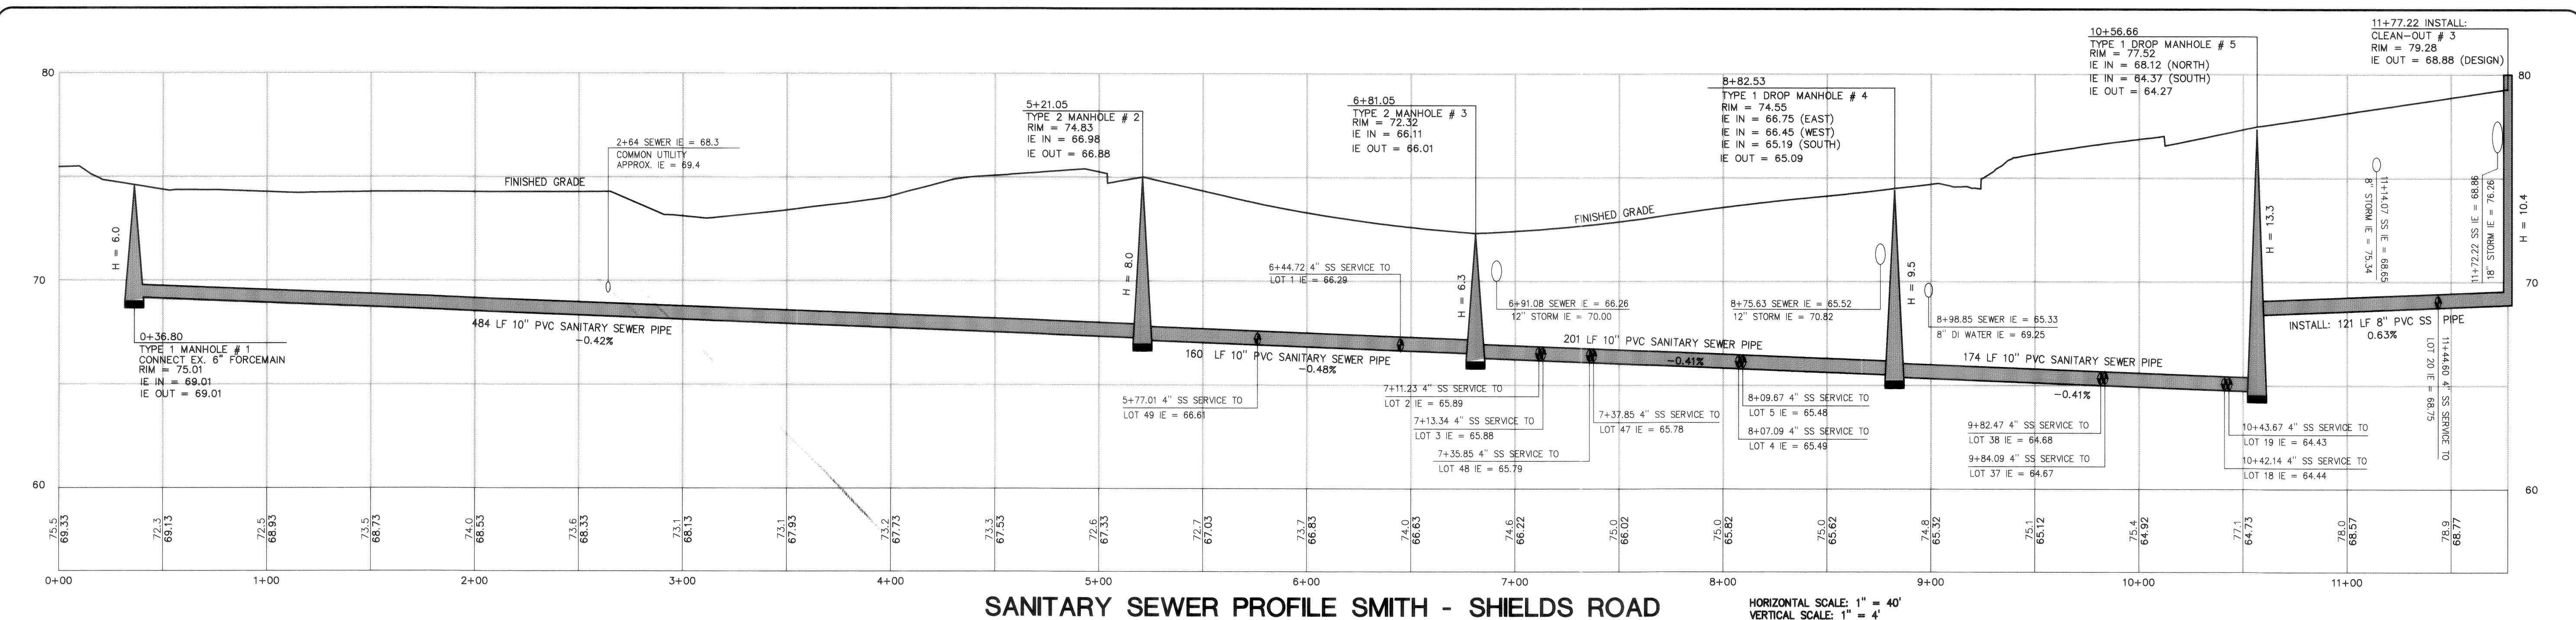

SANITARY SEWER PROFILE SMITH - SHIELDS ROAD


HORIZONTAL SCALE: 1" = 40'
 VERTICAL SCALE: 1" = 4'

DRAWN BY: _____ DATE: _____
 JOB # 97015

SHIELDS ESTATES

FOR: TEITGE, WILLIAMS & McCOLLUM INVESTMENTS, INC.

PROFESSIONAL CERTIFICATION
 I HEREBY CERTIFY THAT THIS PLAN ACCURATELY DEPICTS THE MATERIALS, TYPES, AND LOCATIONS OF THE IMPROVEMENTS SHOWN HEREON AS OF THIS DATE.
 HARRY P. JONES, PE
 DATE: _____

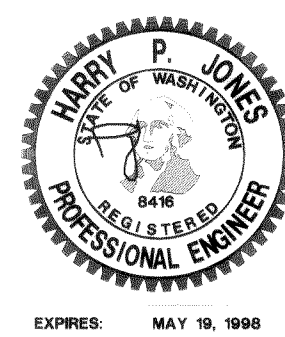



JONES ENGINEERS INCORPORATED, P.S.
 CONSULTING ENGINEERS
 851 COHO WAY, SUITE 307
 BELLINGHAM, WA 98225 (360) 733-8888

AS-BUILT
 SHIELDS ESTATES
 SANITARY SEWER PLAN & PROFILE
 SHIELDS ROAD


DEPARTMENT OF PUBLIC WORKS
 FERNDALE, WASHINGTON
 APPROVED
 CITY ENGINEER: _____ DATE: _____

SHEET
 24
 OF 35

A PORTION OF THE SW 1/4 OF THE SE 1/4 OF SEC 28 TOWNSHIP 39 NORTH , RANGE 2 EAST , W.M.

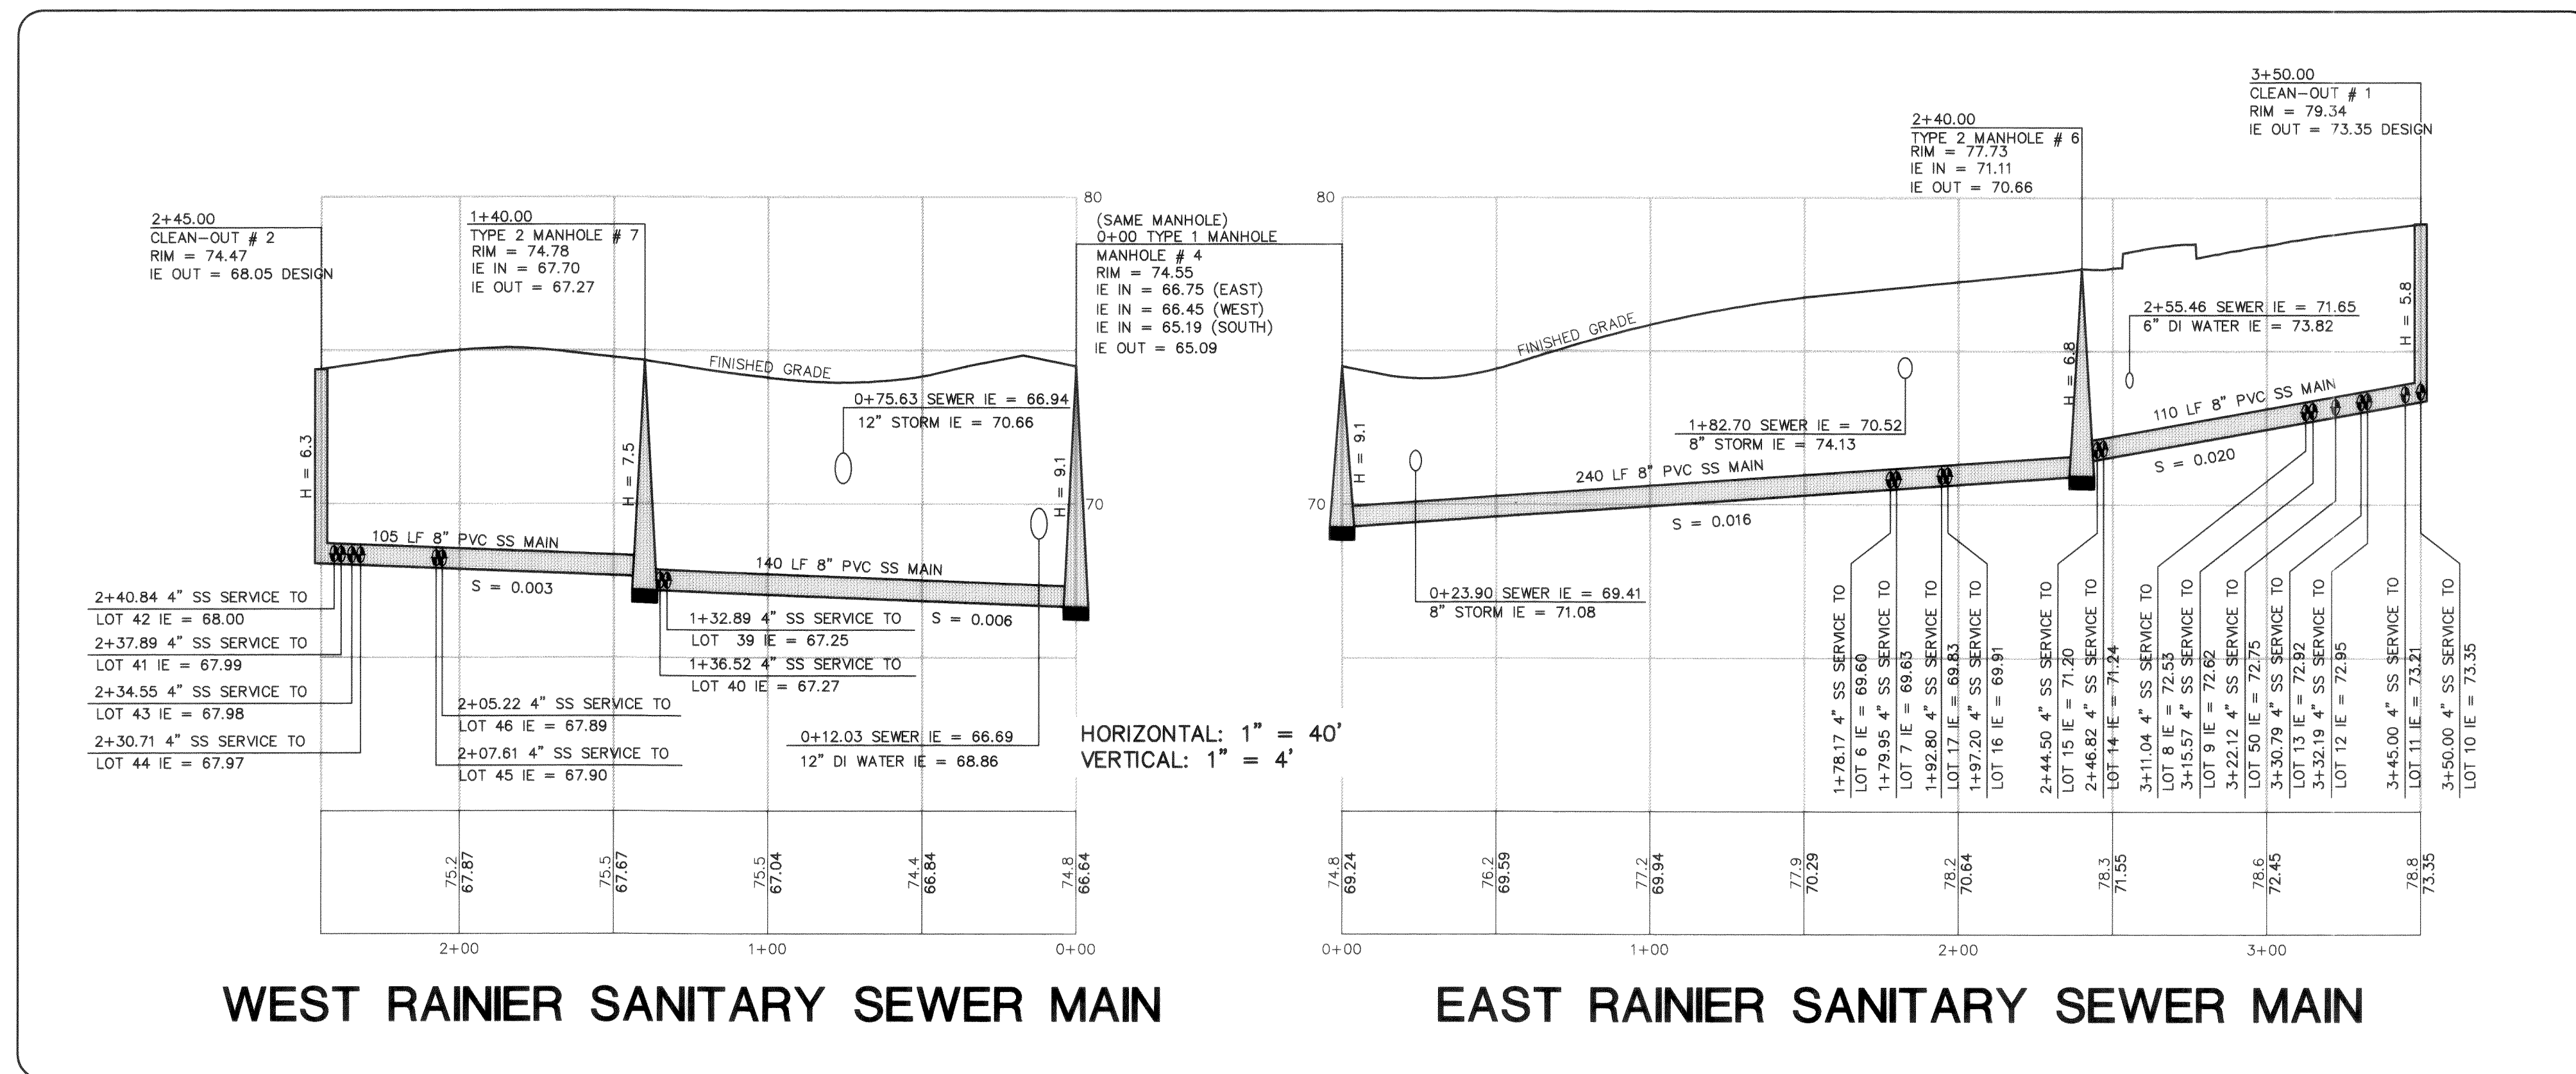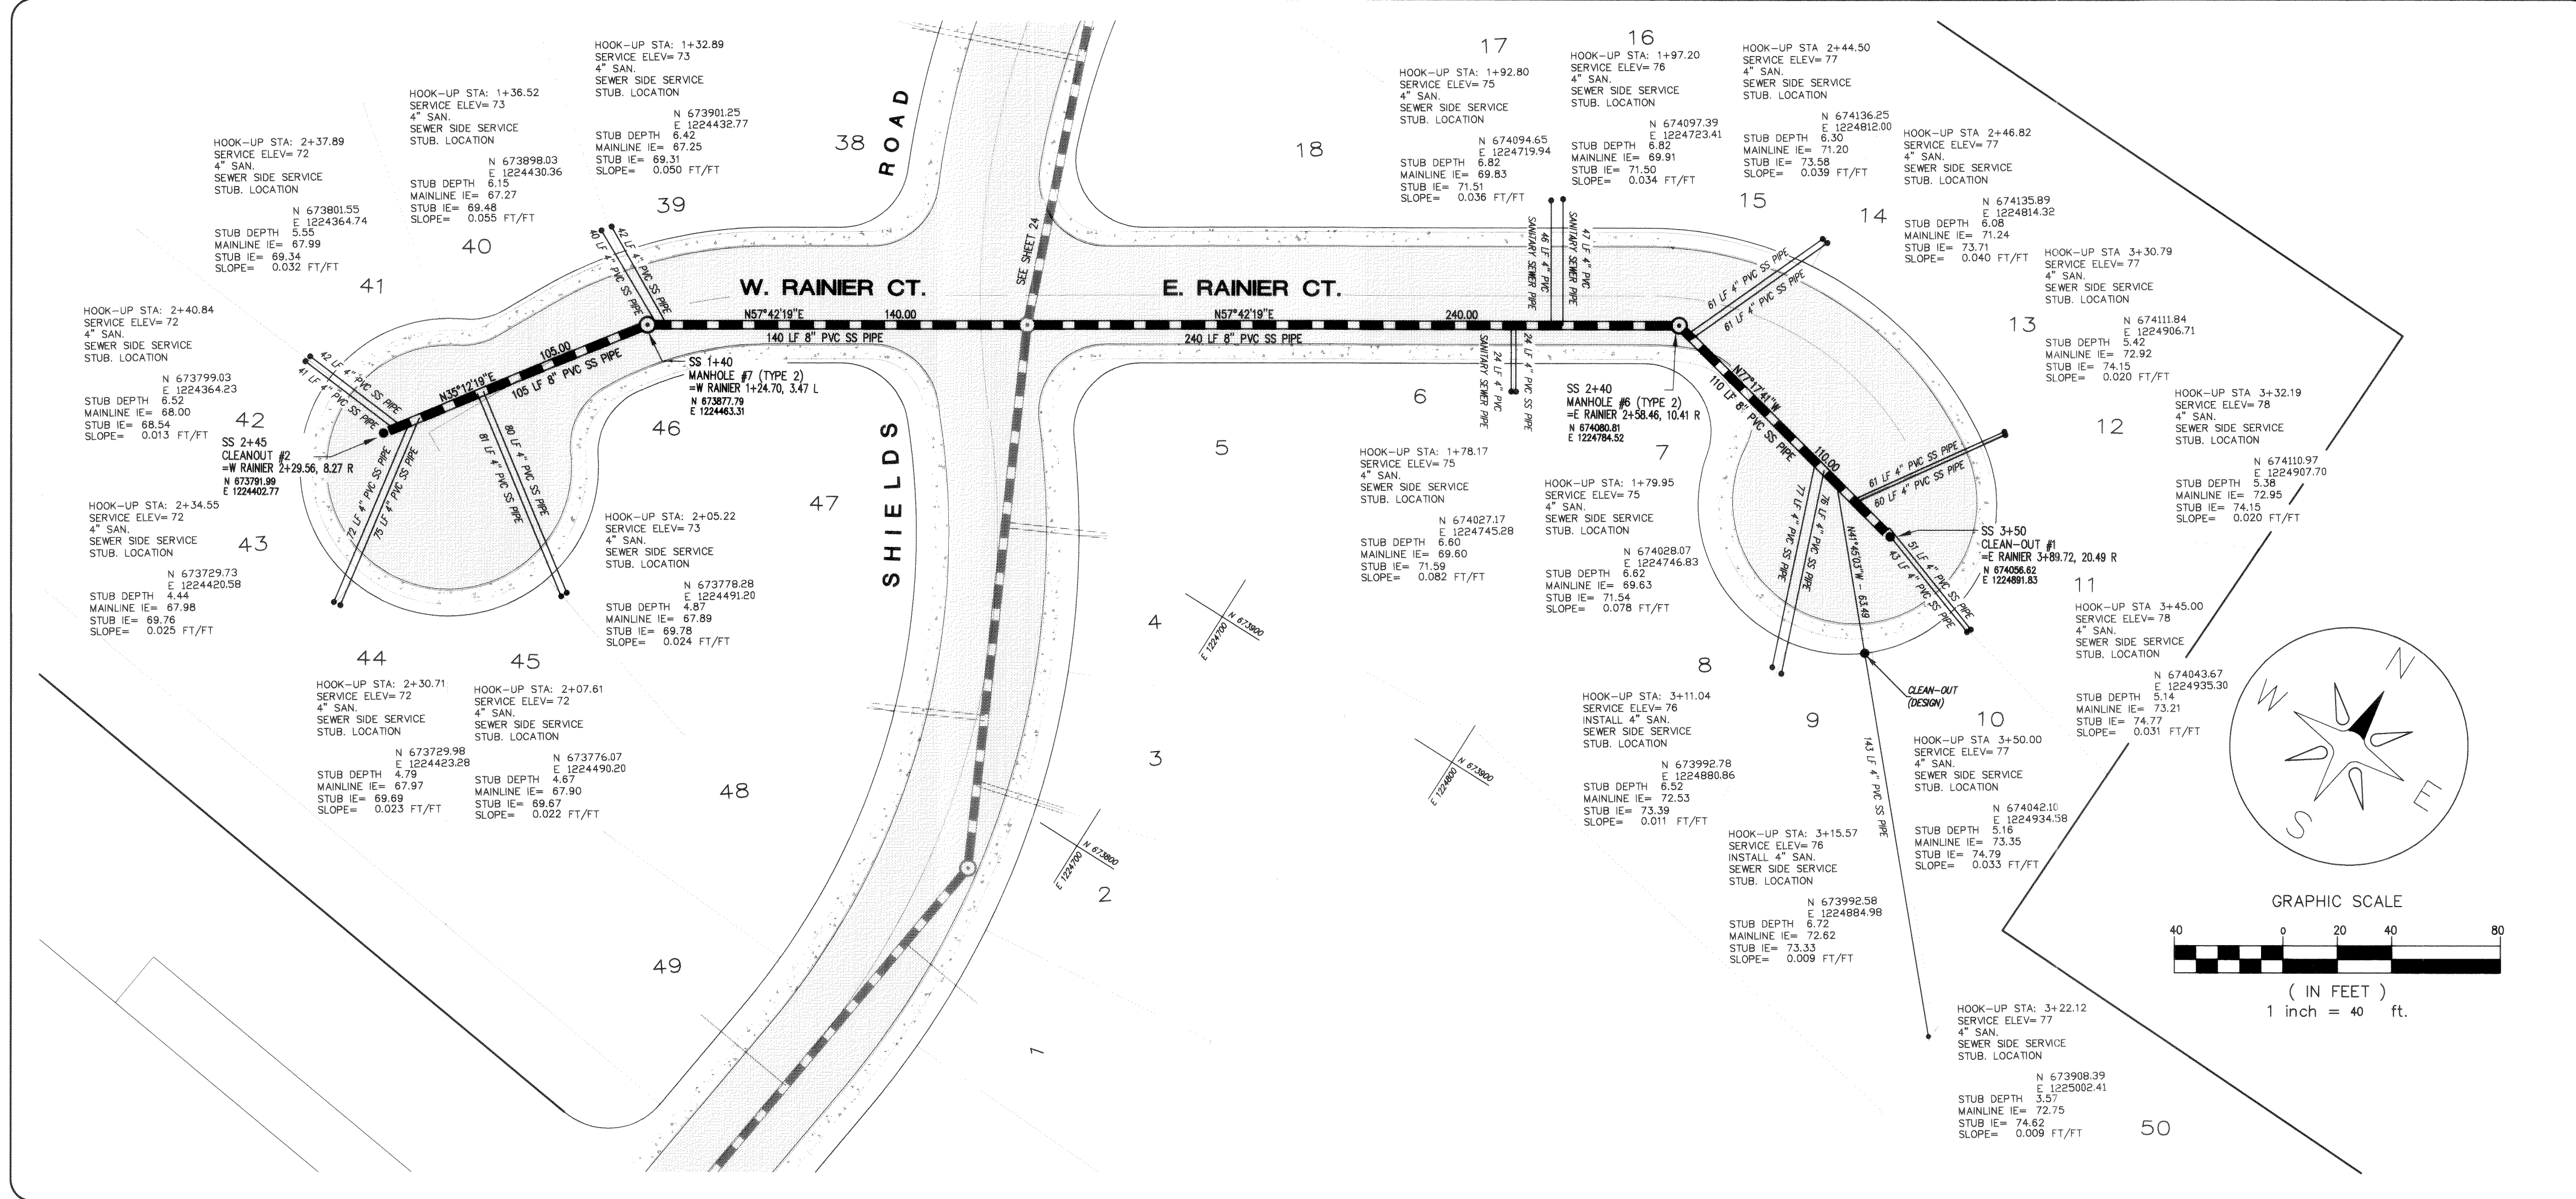

SANITARY SEWER - EAST & WEST RAINIER JOB NO. 97015

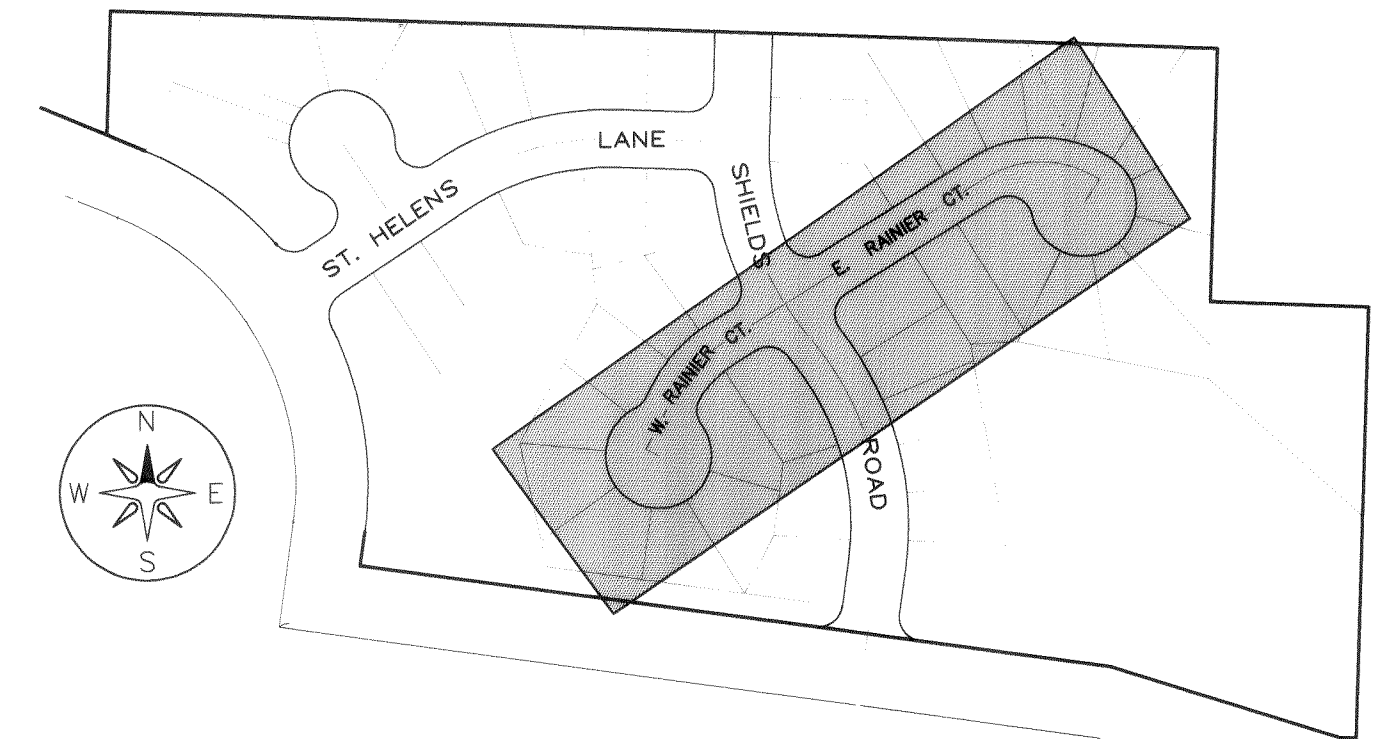

REVISIONS			
NO	DATE	BY	NOTE
1.			
2.			
3.			
4.			
5.			

CONTROL DATUM

HORIZONTAL: NAD83(91) WASHINGTON STATE LAMBERT GRID, NORTH ZONE
 POSITION: CASED MONUMENT (F-10), SOUTHEAST CORNER SEC. 28, T39N, R22E, W.M.
 Y: 673,433.53
 X: 1,226,474.60
 MERIDIAN: SOUTH LINE OF THE SOUTHEAST QUARTER OF SECTION 28, N88°22'49"W
 VERTICAL: NGVD 1928, RAILROAD SPIKE #3, POINT 1050 NORTH OF SMITH ROAD ON THE FRONTAGE ROAD EAST OF I-5
 ELEVATION = 81.03

SANITARY SEWER NOTES

- ALL WORK AND MATERIALS SHALL BE IN ACCORDANCE WITH A.P.W.A. STANDARD SPECIFICATIONS, 1996 EDITION, AND SHALL BE SUBJECT TO APPROVAL BY THE CITY OF FERDALE.
- ALL WORK MUST BE INSPECTED BY A REPRESENTATIVE OF THE CITY ENGINEERING DIVISION AND THE DESIGN ENGINEER, AND 24 HOUR NOTICE MUST BE GIVEN PRIOR TO STARTING WORK.
- SEWER MAIN SHALL BE A MINIMUM 8 INCHES DIAMETER PVC CONFORMING TO THE PROVISIONS OF ASTM D 3034 AND INSTALLED TO CITY SPECIFICATIONS.
- TESTING OF THE SEWER SYSTEM SHALL BE DONE IN THE PRESENCE AND UNDER THE SUPERVISION OF A CITY OF FERDALE REPRESENTATIVE.
- ALL TRENCHES SHALL BE BACKFILLED WITH CLASS B BANK RUN GRAVEL OR SUITABLE NATURAL MATERIAL AS DIRECTED BY THE ENGINEER, AND COMPACTED TO 95% MODIFIED PROCTOR DENSITY.
- A REVOCABLE ENCROACHMENT PERMIT SHALL BE OBTAINED PRIOR TO COMMENCING WORK IN THE RIGHT-OF-WAY.
- A MYLAR PRINT SHALL BE PROVIDED TO THE CITY FOR THEIR RECORDS.
- ALL MANHOLES SHALL BE INSTALLED PER CITY OF FERDALE SS-2, SS-3, & SS-4, AND SHALL BE PRECHANNELED.
- SIDE SEWERS SHALL BE INSTALLED PER CITY OF FERDALE STANDARDS.
- NO FINAL TESTING UNTIL ALL UNDERGROUND UTILITIES ARE IN PLACE.
- MANHOLE CONES ARE TO BE OFFSET SUCH THAT LADDER RUNGS ARE PARALLEL TO THE FLOW.
- BEDDING SHALL BE PEA GRAVEL PER SS-1.
- SEE SHEET 13 FOR SANITARY SEWER DETAILS.
- ALL CLEANOUTS SHALL BE INSTALLED PER CITY OF FERDALE SS-5.

LEGEND

	CENTERLINE	376.0	EXISTING GROUND ELEVATION
	LOT LINES	373.70	FINISHED GRADE ELEVATION
	PROPERTY/ROW LINE		ABBREVIATED LAMBERT GRID COORDINATES
	LIMITED ACCESS		
	EXISTING GROUND		
	SANITARY SEWER MANHOLE	46	LOT NUMBER
	CLEAN-OUT		PAVEMENT
	4" PVC SS SERVICE		
	PVC SS MAIN		SANITARY SEWER SERVICE AT MAINLINE I.E. (PROFILE)

DRAWN BY DATE

DRAWN BY DATE

JOB # 97015


SHIELDS ESTATES

FOR:

TEITGE, WILLIAMS & McCOLLUM INVESTMENTS, INC.

PROFESSIONAL CERTIFICATION
 I HEREBY CERTIFY THAT THIS PLAN ACCURATELY DEPICTS THE MATERIALS, TYPES, AND LOCATIONS OF THE IMPROVEMENTS SHOWN HEREON AS OF THIS DATE.

Harry P. Jones
 HARRY P. JONES, PE DATE

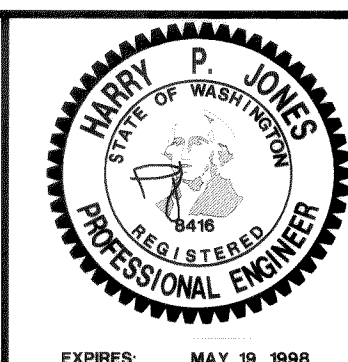

JONES ENGINEERS INCORPORATED, P.S.
 CONSULTING ENGINEERS

851 CONHO WAY, SUITE 307
 BELLINGHAM, WA 98225 (360) 733-8888

AS-BUILT

SHIELDS ESTATES
 EAST & WEST RAINIER COURT
 SANITARY SEWER: PLAN & PROFILE

DEPARTMENT OF PUBLIC WORKS

FERDALE, WASHINGTON

APPROVED

This plan has been reviewed and found to be in conformance with department standards.

CITY ENGINEER DATE




SHEET

25

35


OF

A PORTION OF THE SW 1/4 OF THE SE 1/4 OF SEC 28 TOWNSHIP 39 NORTH , RANGE 2 EAST , W.M.

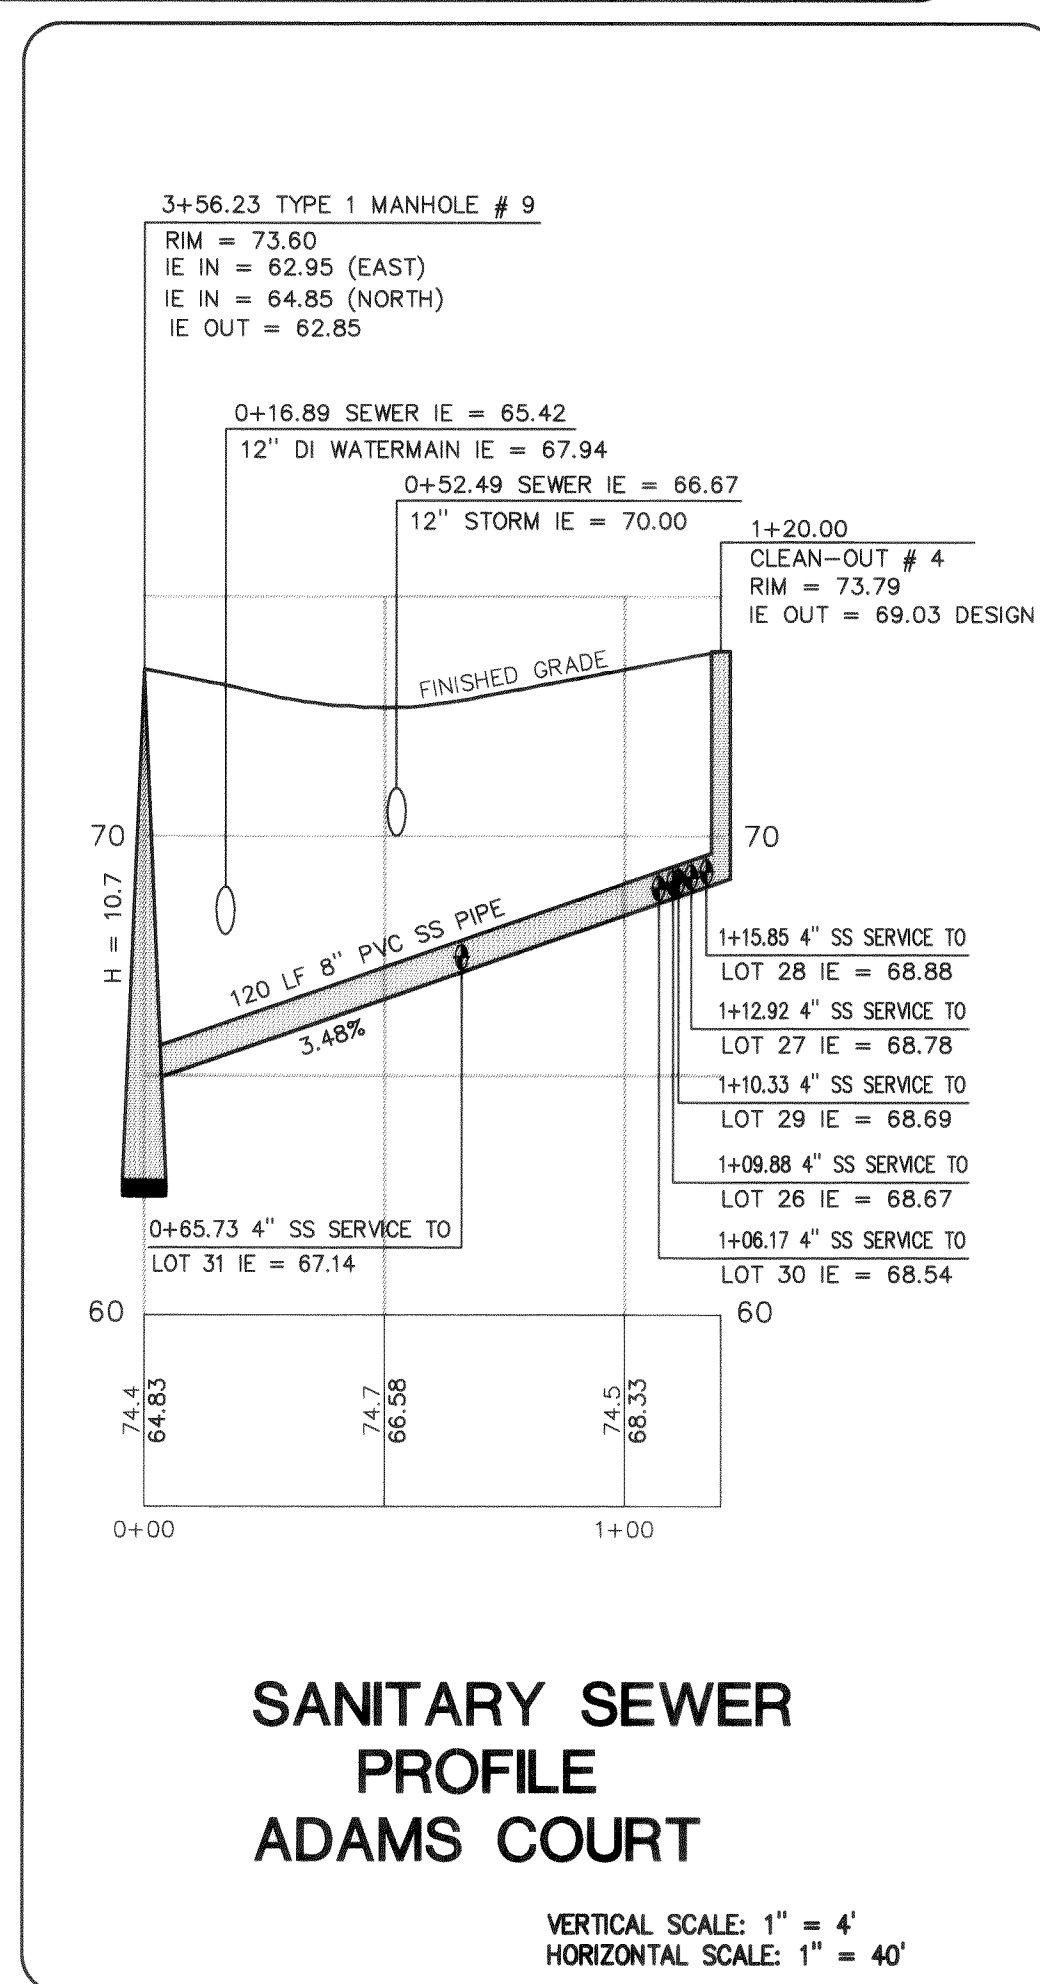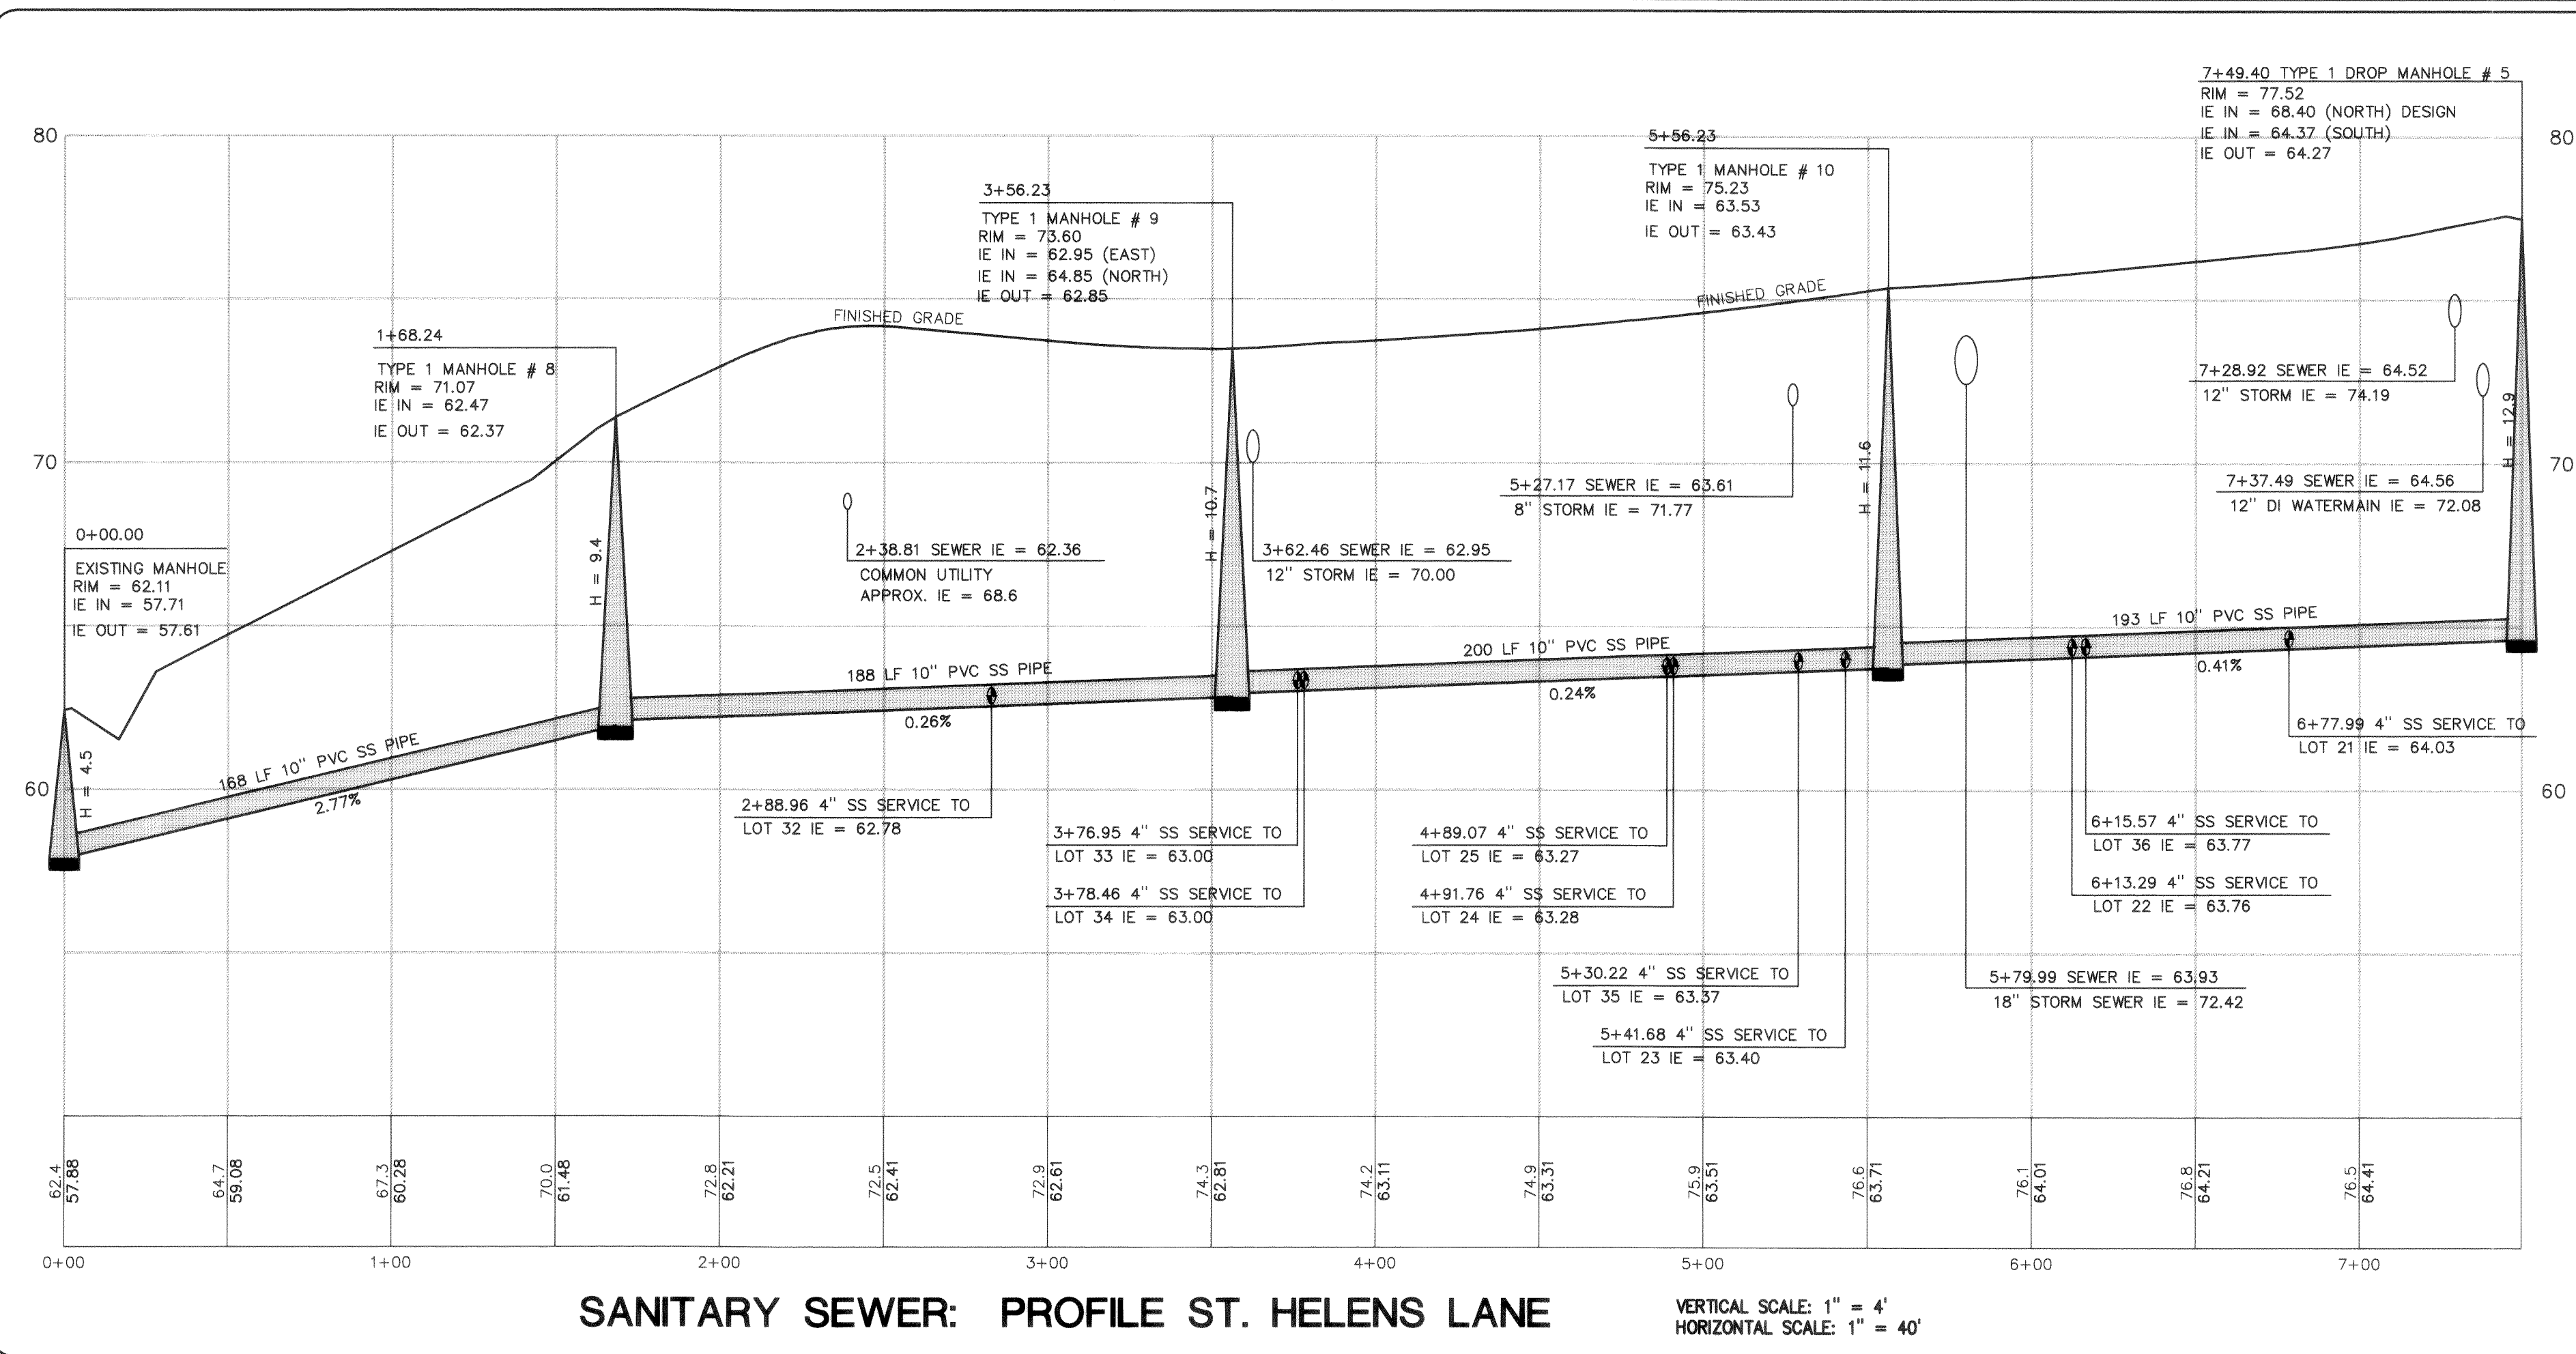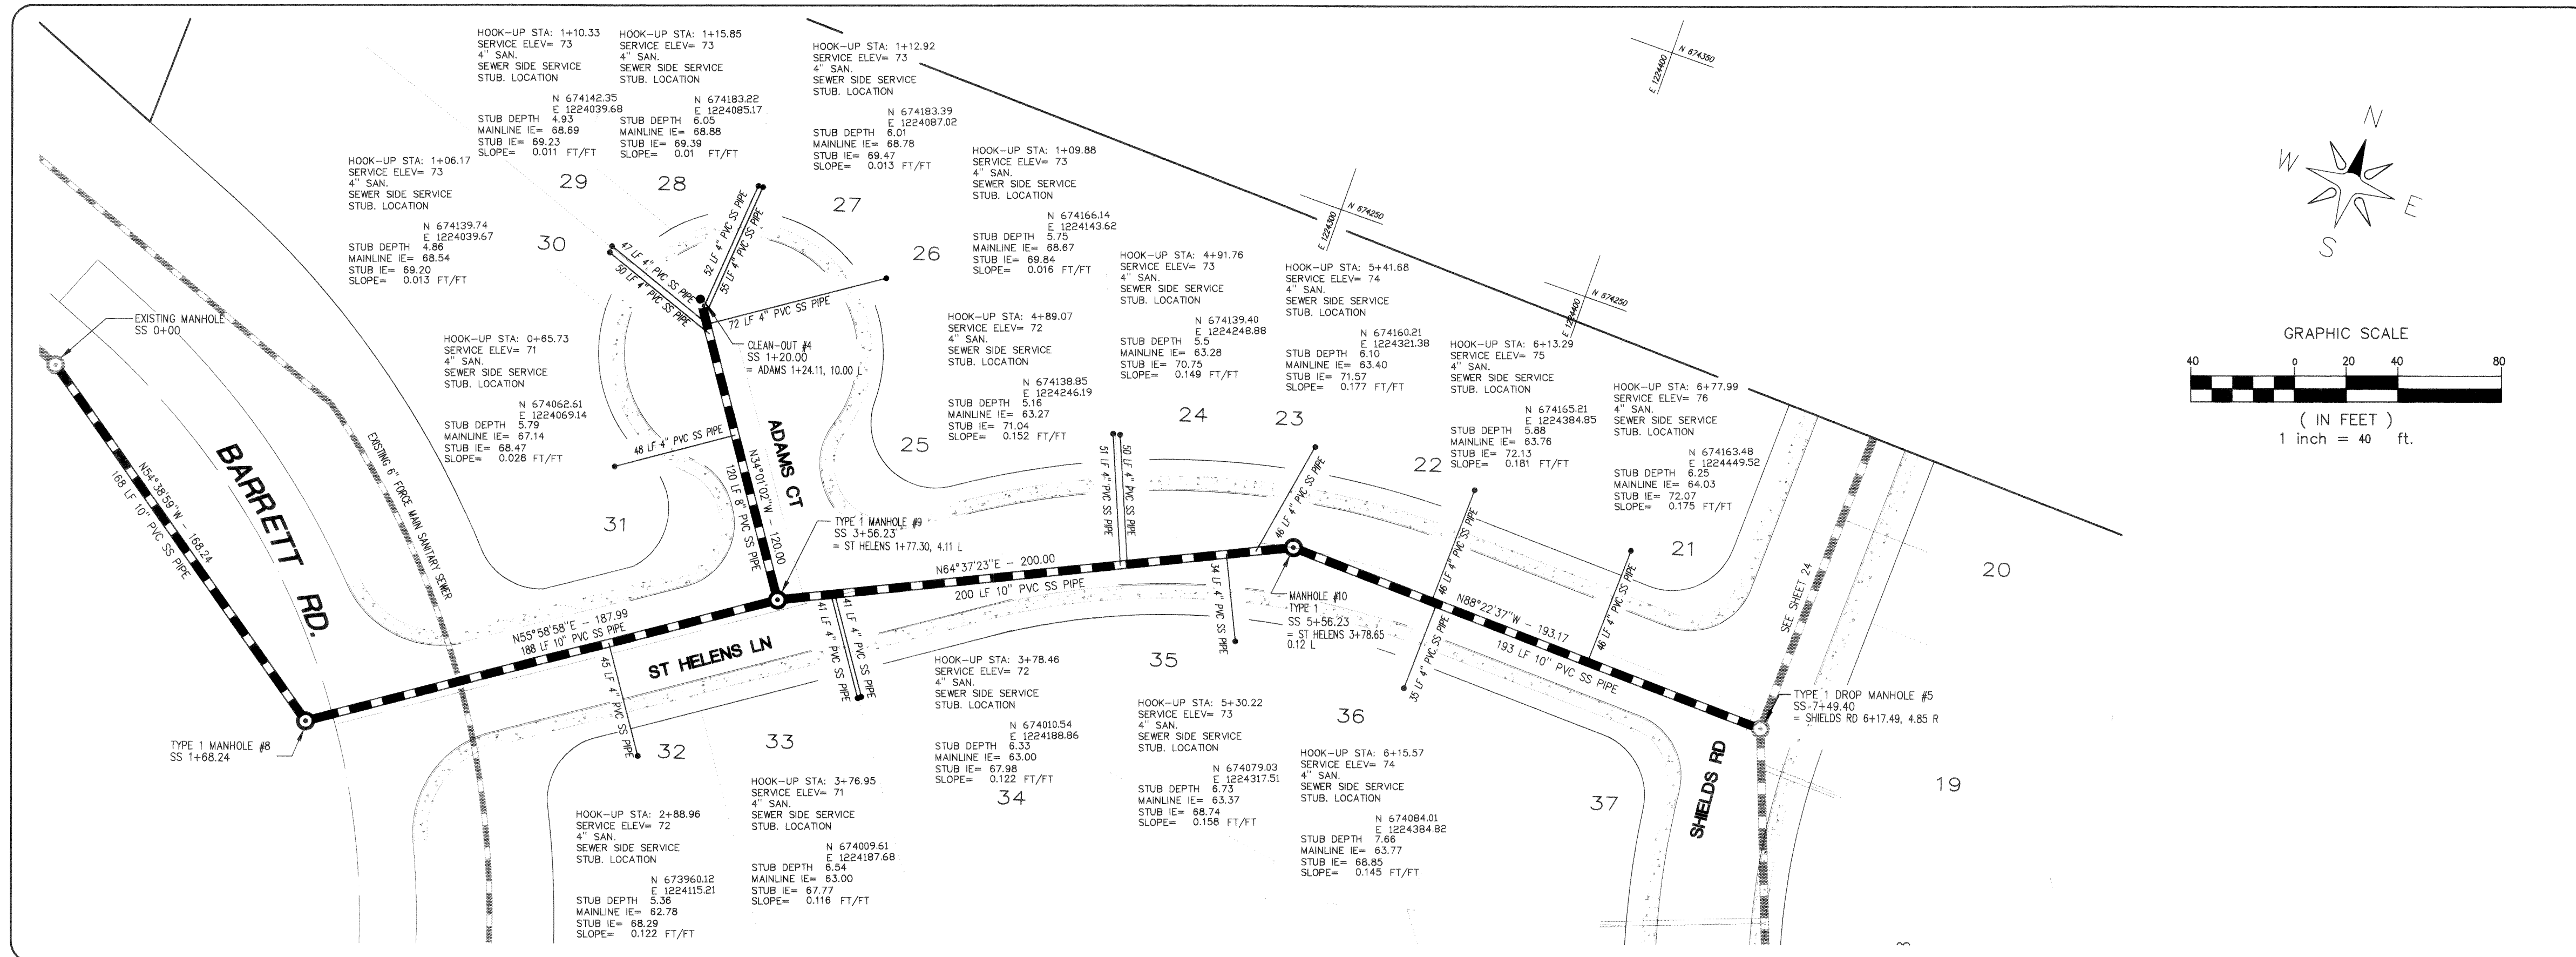

SANITARY SEWER - ST. HELENS / ADAMS

JOB NO. 97015

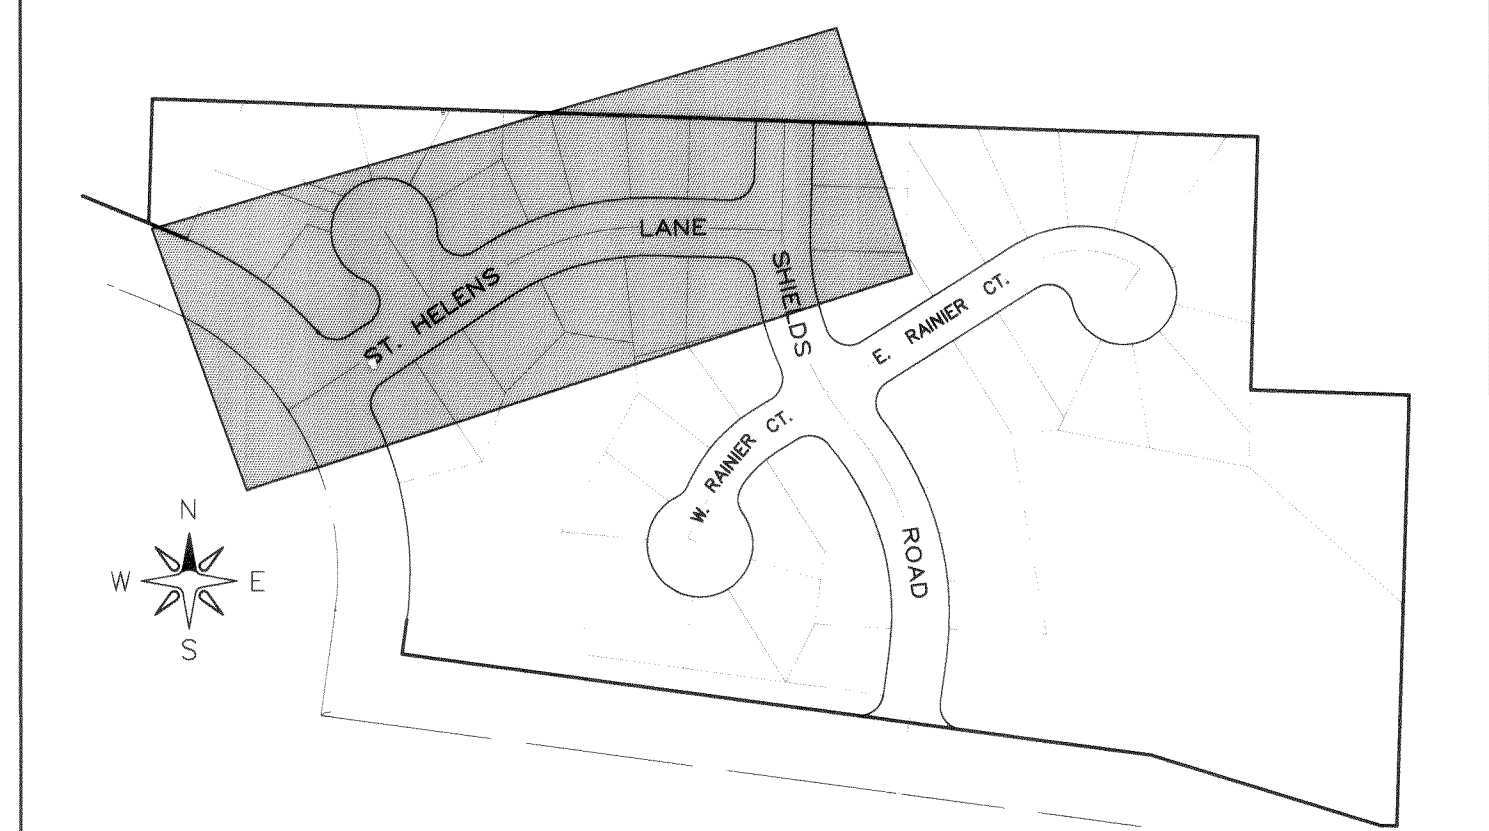

REVISIONS				CONTROL DATUM
NO	DATE	BY	NOTE	
1.	6-19-97	A.K.	REVISE PER AGENCY REVIEW	HORIZONTAL: NAD83(91) WASHINGTON STATE LAMBERT GRID, NORTH ZONE POSITION: CASED MONUMENT (F-10), SOUTHEAST CORNER SEC. 28, T39N, R2E, W.M. Y: 673433.53 X: 1226474.60 MERIDIAN: SOUTH LINE OF THE SOUTHEAST QUARTER OF SECTION 28, 188922.49'W VERTICAL: NVD 1929, RAILROAD SPIKE #3, POINT 1050 NORTH OF SMITH ROAD ON THE FRONTAGE ROAD EAST OF I-5 ELEVATION = 81.03
2.				
3.				
4.				
5.				

- SANITARY SEWER NOTES**
- ALL WORK AND MATERIALS SHALL BE IN ACCORDANCE WITH A.P.W.A. STANDARD SPECIFICATIONS, 1996 EDITION, AND SHALL BE SUBJECT TO APPROVAL BY THE CITY OF FERNDALE.
 - ALL WORK MUST BE INSPECTED BY A REPRESENTATIVE OF THE CITY ENGINEERING DIVISION AND THE DESIGN ENGINEER, AND 24 HOUR NOTICE MUST BE GIVEN PRIOR TO STARTING WORK.
 - SEWER MAIN SHALL BE A MINIMUM 8 INCHES DIAMETER PVC CONFORMING TO THE PROVISIONS OF ASTM D 3034 AND INSTALLED TO CITY SPECIFICATIONS.
 - TESTING OF THE SEWER SYSTEM SHALL BE DONE IN THE PRESENCE AND UNDER THE SUPERVISION OF A CITY OF FERNDALE REPRESENTATIVE.
 - ALL TRENCHES SHALL BE BACKFILLED WITH CLASS B BANK RUN GRAVEL OR SUITABLE NATURAL MATERIAL AS DIRECTED BY THE ENGINEER, AND COMPACTED TO 95% MODIFIED PROCTOR DENSITY.
 - A REVOCABLE ENCROACHMENT PERMIT SHALL BE OBTAINED PRIOR TO COMMENCING WORK IN THE RIGHT-OF-WAY.
 - A MYLAR PRINT SHALL BE PROVIDED TO THE CITY FOR THEIR RECORDS.
 - ALL MANHOLES SHALL BE INSTALLED PER CITY OF FERNDALE SS-2, SS-3, & SS-4, AND SHALL BE PRECHANNLED.
 - SIDE SEWERS SHALL BE INSTALLED PER CITY OF FERNDALE STANDARDS.
 - NO FINAL TESTING UNTIL ALL UNDERGROUND UTILITIES ARE IN PLACE.
 - MANHOLE CONES ARE TO BE OFFSET SUCH THAT LADDER RUNGS ARE PARALLEL TO THE FLOW.
 - BEDDING SHALL BE PEA GRAVEL PER SS-1.
 - SEE SHEET 13 FOR SANITARY SEWER DETAILS.
 - ALL CLEANOUTS SHALL BE INSTALLED PER CITY OF FERNDALE SS-5.


LEGEND			
	CENTERLINE	376.0	EXISTING GROUND ELEVATION
	LOT LINES	373.70	FINISHED GRADE ELEVATION
	PROPERTY/ROW LINE		
	LIMITED ACCESS		ABBREVIATED LAMBERT GRID COORDINATES
	EXISTING GROUND		
	SANITARY SEWER MANHOLE	46	LOT NUMBER
	CLEAN-OUT		
	4" PVC SS SERVICE		PAVEMENT
	PVC SS MAIN		SANITARY SEWER SERVICE AT MAINLINE (I.E. PROFILE)

DRAWN BY _____ DATE _____
 DRAWN BY _____ DATE _____
JOB # 97015

SHIELDS ESTATES
 FOR:
TEITGE, WILLIAMS & McCOLLUM INVESTMENTS, INC.

PROFESSIONAL CERTIFICATION
 I HEREBY CERTIFY THAT THIS PLAN ACCURATELY
 DEPICTS THE MATERIALS, TYPES, AND LOCATIONS
 OF THE IMPROVEMENTS SHOWN HEREON AS OF
 THIS DATE.

 HARRY P. JONES, P.E. DATE _____

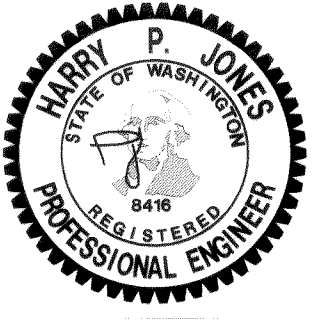

JONES ENGINEERS
 INCORPORATED, P.S.
 CONSULTING ENGINEERS
 851 COHO WAY, SUITE 307
 BELLINGHAM, WA 98225 (360) 733-8888

AS-BUILT
SHIELDS ESTATES
SANITARY SEWER PLAN & PROFILE:
ST. HELENS LN. / ADAMS CT.


DEPARTMENT OF PUBLIC WORKS
 FERNDALE, WASHINGTON
APPROVED
 This plan has been reviewed and found to be in conformance with department standards.
 CITY ENGINEER _____ DATE _____

SHEET
26
 35

E:\97015\AG-5M03 Wed Apr 08 18:13:34 1998 DALE BUYS

00324.015 2.10.04 XE

A PORTION OF THE SW 1/4 OF THE SE 1/4 OF SEC 28 TOWNSHIP 39 NORTH , RANGE 2 EAST , W.M.

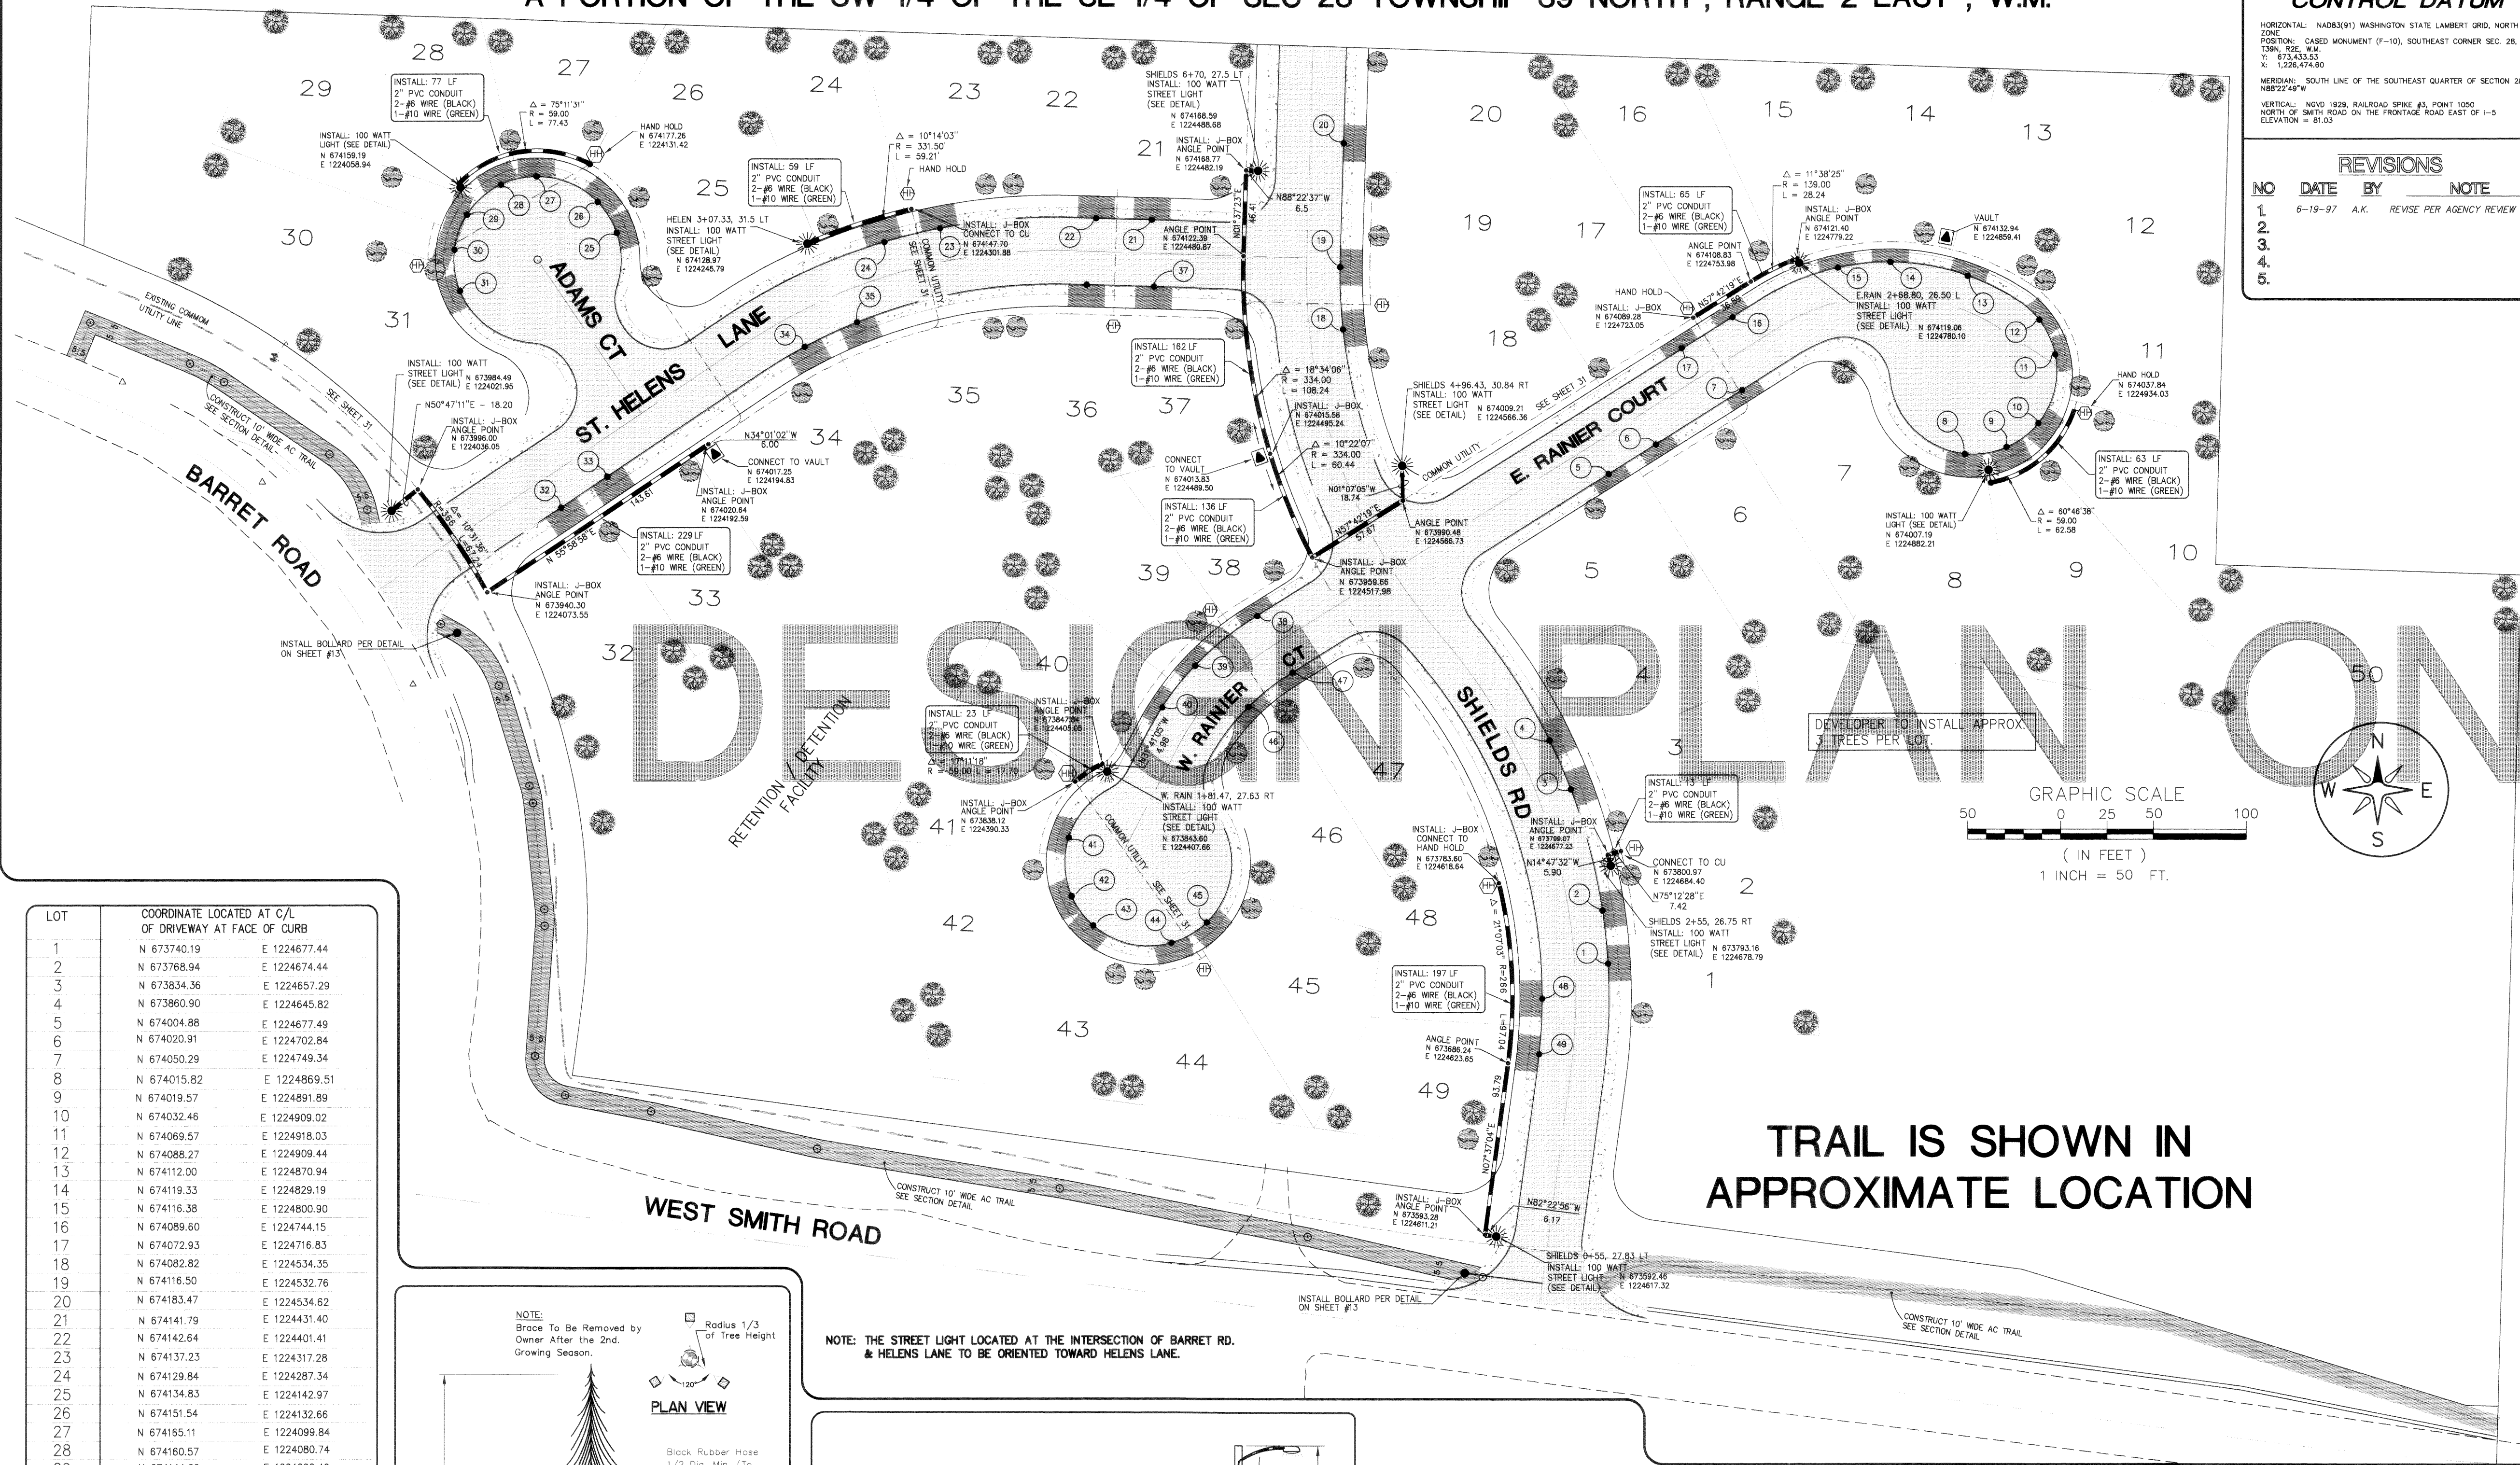

CONTROL DATUM

HORIZONTAL: NAD83(91) WASHINGTON STATE LAMBERT GRID, NORTH
 ZONE: 18N
 POSITION: CASED MONUMENT (7-10), SOUTHEAST CORNER SEC. 28,
 139N, 105E, W.M.
 Y: 673433.25
 X: 1225474.60
 MERIDIAN: SOUTH LINE OF THE SOUTHEAST QUARTER OF SECTION 28,
 N88°22'49"W
 VERTICAL: NAVD 1983, RAILROAD SPIKE #3, POINT 1050
 NORTH OF SMITH ROAD ON THE FRONTAGE ROAD EAST OF I-5
 ELEVATION = 81.03

REVISIONS

NO	DATE	BY	NOTE
1.	6-19-97	A.K.	REVISE PER AGENCY REVIEW
2.			
3.			
4.			
5.			

STREET LIGHTING / LANDSCAPING

LEGEND

1" PVC CONDUIT	
PROPOSED COMMON UTILITY	
EX. COMMON UTILITY	
EX. COMMON UTILITY (TO BE ABANDONED)	
DRIVEWAY	
10' WIDE AC PAVED TRAIL	
PROP. STREET LIGHT	
PROP. PUGET HANDHOLD	
PROP. PUGET VAULT	
DRIVEWAY C/L AT CURB POINT	
WESTERN RED CEDAR (DEVELOPER TO INSTALL)	
DOUGLAS FIR (DEVELOPER TO INSTALL)	

LIGHT STANDARD BASE

Light standard bases shall be as shown on plan. The concrete base shall be 24" x 24" x 23" deep on residential street lamp posts and 36" x 36" x 60" deep on Chandler street lamp posts. The concrete used shall conform to the Standard Specifications.

The top-of-concrete base shall be flush finish grade. Forms shall be used while placing the base, as the concrete must bear against undisturbed earth.

CONDUIT

PVC conduit shall be furnished and installed between junction boxes and standards as detailed on the Plans. All conduit to be a minimum depth of 18 inches below finished grade, at locations shown on the Plans or designated by the Engineer. Fittings shall be the same material as the conduit.

All conduit shall be installed in compliance with National Electric Code (NEC) at locations shown on the Plans or designated by the Engineer.

JUNCTION BOXES

Junction Boxes conforming to WSDOT Standard Plan J-11a (with the exception that lids shall be hot-dipped galvanized and bear the legend "lighting"), shall be furnished and installed at such locations shown on the Plans or designated by the Engineer. Unless otherwise directed by the Engineer, the junction boxes shall be placed on 6 inch gravel/buried cushion. All cover cover plates and metal surfaces for junction boxes shall be hot-dipped galvanized. Conduit into junction boxes shall be no more than 5 inches and no less than 3 inches from the bottom of the box surface. Conduit entering through the bottom of the junction box shall be located near the end walls to leave the major portion clear. At all outlets conduit shall enter through the direction of the run terminating within three inches nearest its entry location and have ball ends. Care shall be taken to ensure a neat and convenient arrangement of conduit as outlined in Section 8-20.3(5) of 1994 APWA Standard Specifications. Junction boxes and lids shall be grounded by a method approved by the Engineer.

STREET LIGHTING STANDARDS

Street Lighting standards shall be furnished and installed on standard bases, shall be set plumb, and the base shall be grouted to cover leveling nuts and to fill the void under base plate with a non-shrinking grout. Top of concrete base shall be flush with finished grade.

Street lighting standards shall be provided and installed where shown on the Plans and/or as designated by the Engineer. The standard shall be square tapered, 18 feet high, prestressed concrete, anchor base spun hollow standards machine made in steel made by the centrifugal process. Prestressing wire, gauging, and other reinforcement shall be SFC - 5.7 meter poles or equal approved by the Engineer with exposed natural aggregate finish #13.

STREET LIGHTING LUMINAIRE

Street lighting luminaires shall be the cutoff type with one piece extruded aluminum rectangular housing. Lens shall be shatterproof glass, flat tempered in an extruded aluminum frame. Reflectors shall be provided and the lamp selection such that the fixture produces an IES/ANSI Short Type 2 distribution with essentially complete light cutoff above 75 degrees from Nadir. The luminaire housing shall be bracket-arm mounted. The ballast shall be rated 240 volts and be of the Autotransformer type. The luminaire shall be suitable for operating a 100-watt high-pressure sodium lamp. The luminaire shall be bolted to the pole by means of cast inserts and this detail shall be coordinated with the pole manufacturer to ensure proper fit. The complete luminaire kit shall have a bronze anodized aluminum baked enamel finish. No fusing shall be located in the luminaire.

WIRING


All wire shall conform to WSDOT Specifications. Conductors above grade and up the poles shall be copper, No. 10 AWG or larger and shall be stranded. Insulation shall be Type THW or better, 800V minimum rated, 75° C, and be color-coded in a consistent manner.

The Contractor shall provide a complete grounding system with grounding continuity throughout the system. Ground rods shall be bare-stranded copper clad 5/8" x 8" providing 15 ohms maximum resistance. Ground wire shall be bare-stranded copper, No. 12 AWG or larger.


All splices below grade shall be watertight. They shall be made using an ESNA, SEC or equal-type splice kit. Splices above grade shall be with solderless connectors and be taped. All wiring in metal luminaire poles shall be fused with breakaway fusing per WSDOT Standard Plan J-1e.

All wiring in concrete poles shall have waterproof breakaway fusing installed in the adjacent J-box as per DETAIL THIS SHEET



LOT	COORDINATE LOCATED AT C/L OF DRIVEWAY AT FACE OF CURB	
1	N 673740.19	E 1224677.44
2	N 673768.94	E 1224674.44
3	N 673834.36	E 1224657.29
4	N 673860.90	E 1224645.82
5	N 674004.86	E 1224677.49
6	N 674020.91	E 1224702.84
7	N 674050.29	E 1224749.34
8	N 674015.82	E 1224869.51
9	N 674019.57	E 1224891.89
10	N 674032.46	E 1224909.02
11	N 674069.57	E 1224918.03
12	N 674088.27	E 1224909.44
13	N 674112.00	E 1224870.94
14	N 674119.33	E 1224829.19
15	N 674116.38	E 1224800.90
16	N 674089.60	E 1224744.15
17	N 674072.93	E 1224716.83
18	N 674082.82	E 1224534.35
19	N 674116.50	E 1224532.76
20	N 674183.47	E 1224534.62
21	N 674141.79	E 1224431.40
22	N 674142.64	E 1224401.41
23	N 674137.23	E 1224317.28
24	N 674129.84	E 1224287.34
25	N 674134.83	E 1224142.97
26	N 674151.54	E 1224132.66
27	N 674165.11	E 1224099.84
28	N 674160.57	E 1224080.74
29	N 674144.29	E 1224062.49
30	N 674125.46	E 1224055.76
31	N 674103.17	E 1224058.75
32	N 673986.35	E 1224113.18
33	N 674003.14	E 1224138.05
34	N 674073.21	E 1224244.28
35	N 674086.56	E 1224272.63
36	N 674106.77	E 1224396.34
37	N 674105.75	E 1224432.59
38	N 673927.99	E 1224488.45
39	N 673900.97	E 1224455.01
40	N 673878.36	E 1224437.30
41	N 673807.96	E 1224386.95
42	N 673776.34	E 1224388.56
43	N 673760.48	E 1224400.13
44	N 673751.05	E 1224442.29
45	N 673762.20	E 1224461.37
46	N 673878.87	E 1224483.72
47	N 673897.43	E 1224507.48
48	N 673721.13	E 1224641.99
49	N 673691.17	E 1224640.36

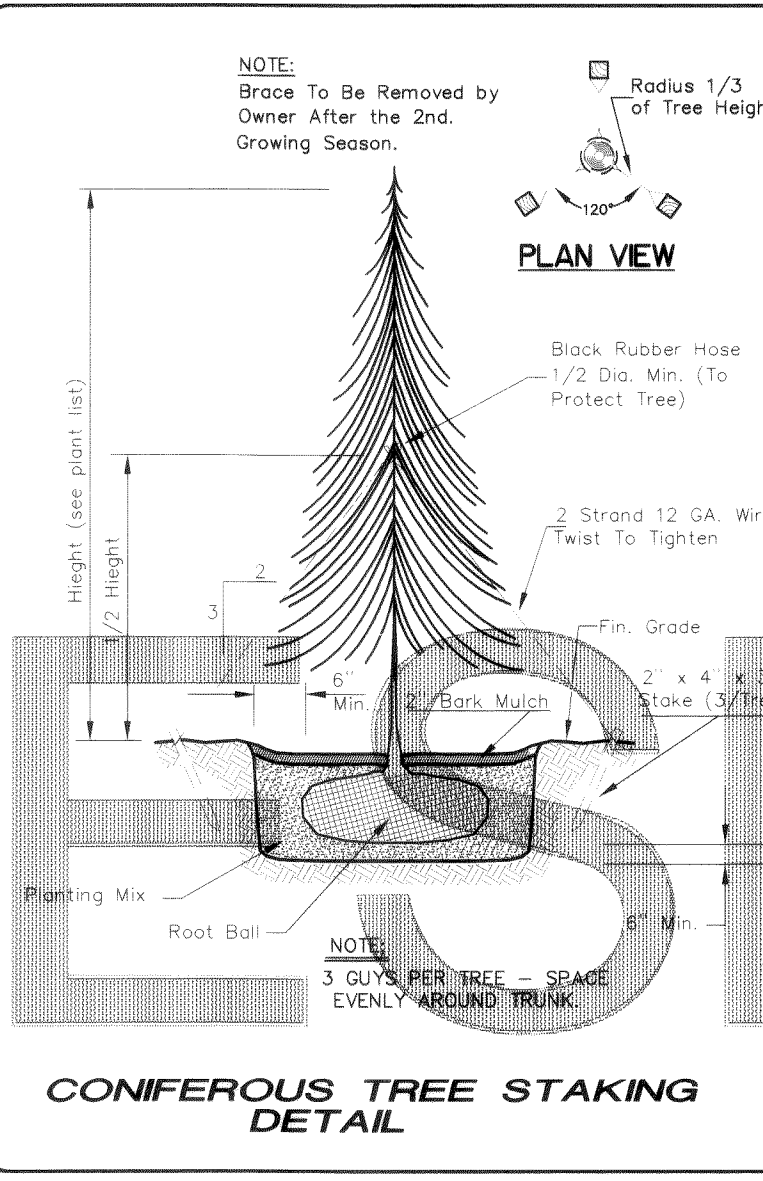

NOTE: THE STREET LIGHT LOCATED AT THE INTERSECTION OF BARRET RD. & HELENS LANE TO BE ORIENTED TOWARD HELENS LANE.

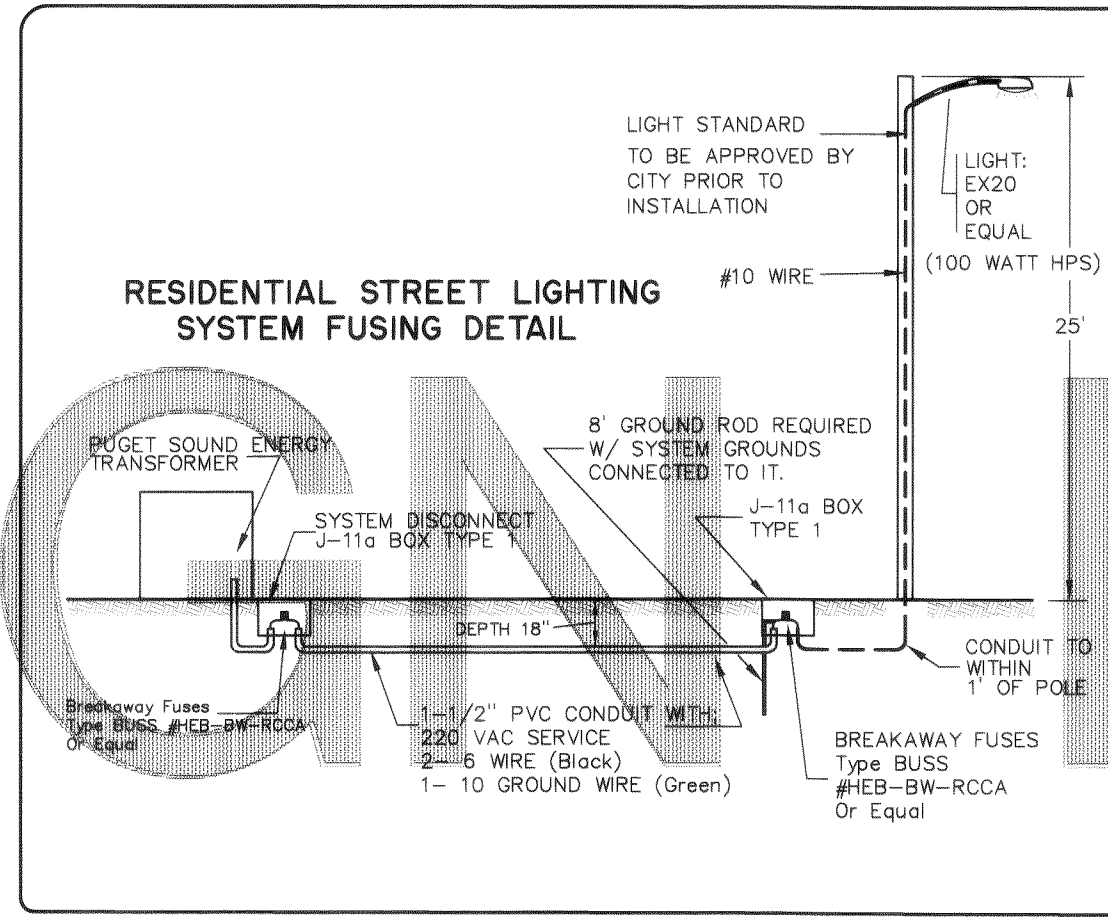

NOTE: APPROVAL OF THESE PLANS DOES NOT CONSTITUTE A GUARANTEE OR WARRANTY OF ANY KIND. THE OWNER SHALL BE RESPONSIBLE FOR THE ACCURACY OF THE INFORMATION PROVIDED HEREON. APPROXIMATE LOCATIONS AND UTILITIES ARE SHOWN. PRECISE LOCATIONS HAVE NOT BEEN FIELD VERIFIED.

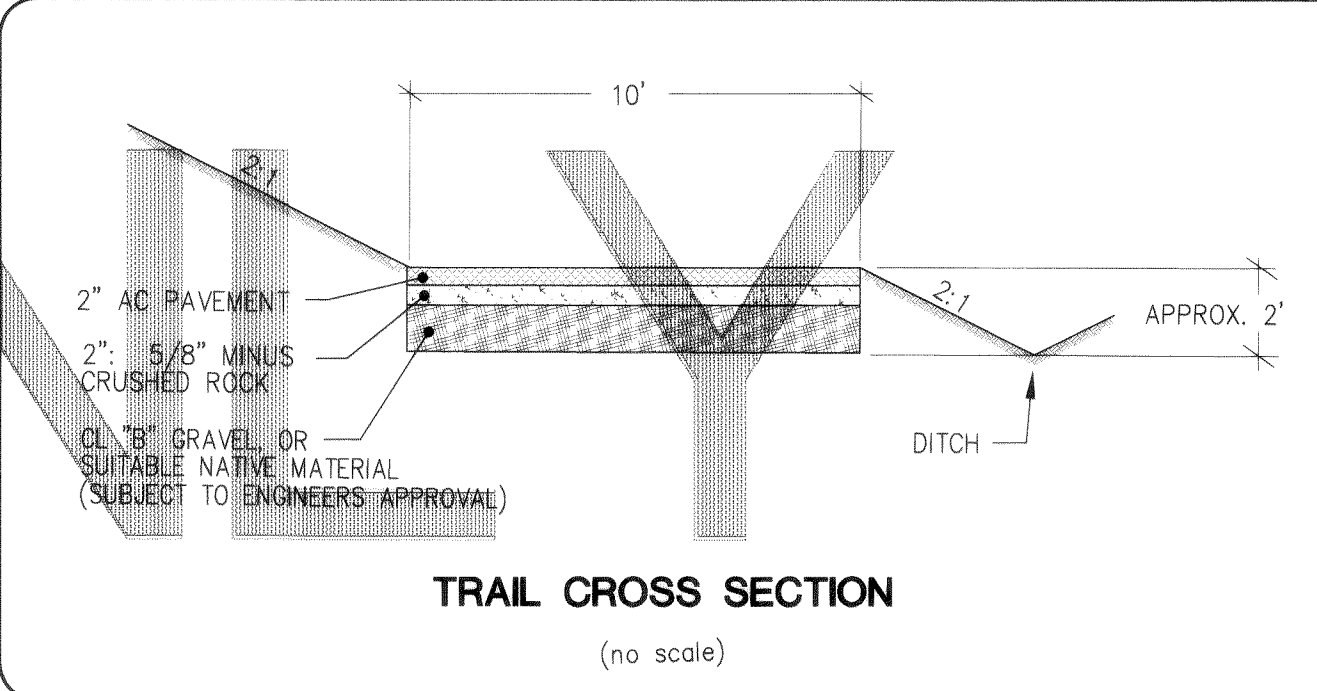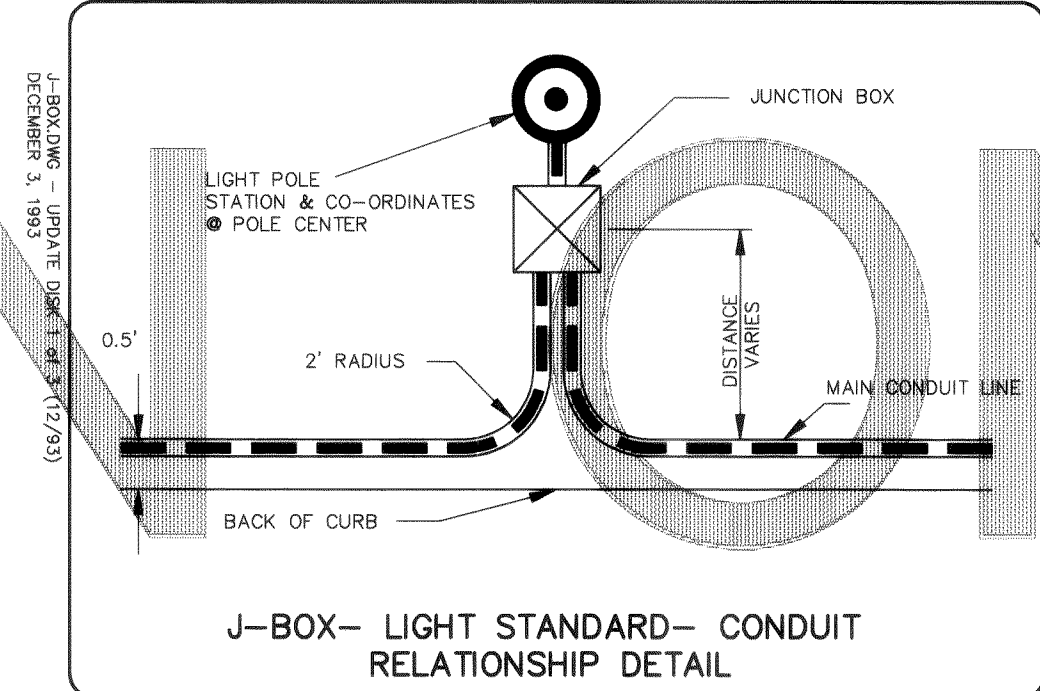

DRAWN BY _____ DATE _____
 DRAWN BY _____ DATE _____
JOB # 97015

SHIELDS ESTATES
 FOR:
TEITGE, WILLIAMS & McCOLLUM INVESTMENTS, INC.

PROFESSIONAL CERTIFICATION
 I HEREBY CERTIFY THAT THIS PLAN IS TO BE
 USED SOLELY FOR GRAPHICAL PURPOSES.
 APPROXIMATE LOCATIONS AND UTILITIES ARE SHOWN.
 PRECISE LOCATIONS HAVE NOT BEEN FIELD VERIFIED.

 HARRY P. JONES, PE
 DATE _____

JONES ENGINEERS INCORPORATED, P.S.
 CONSULTING ENGINEERS
 851 COHO WAY, SUITE 307
 BELLINGHAM, WA 98225 (360) 733-8888

SHIELDS ESTATES
 LANDSCAPING, STREET LIGHTING PLAN & DETAILS
 TRAIL GEOMETRY

DEPARTMENT OF PUBLIC WORKS
 FERNDALE, WASHINGTON
APPROVED
 This plan has been reviewed and found
 to be in conformance with department
 standards.
 CITY ENGINEER _____ DATE _____

SHEET
30
 OF 35

E:\97015\AB-Land Wed Apr 08 16:42:51 1998 DALE BUYS

00826.016 2-16-00 NJ