
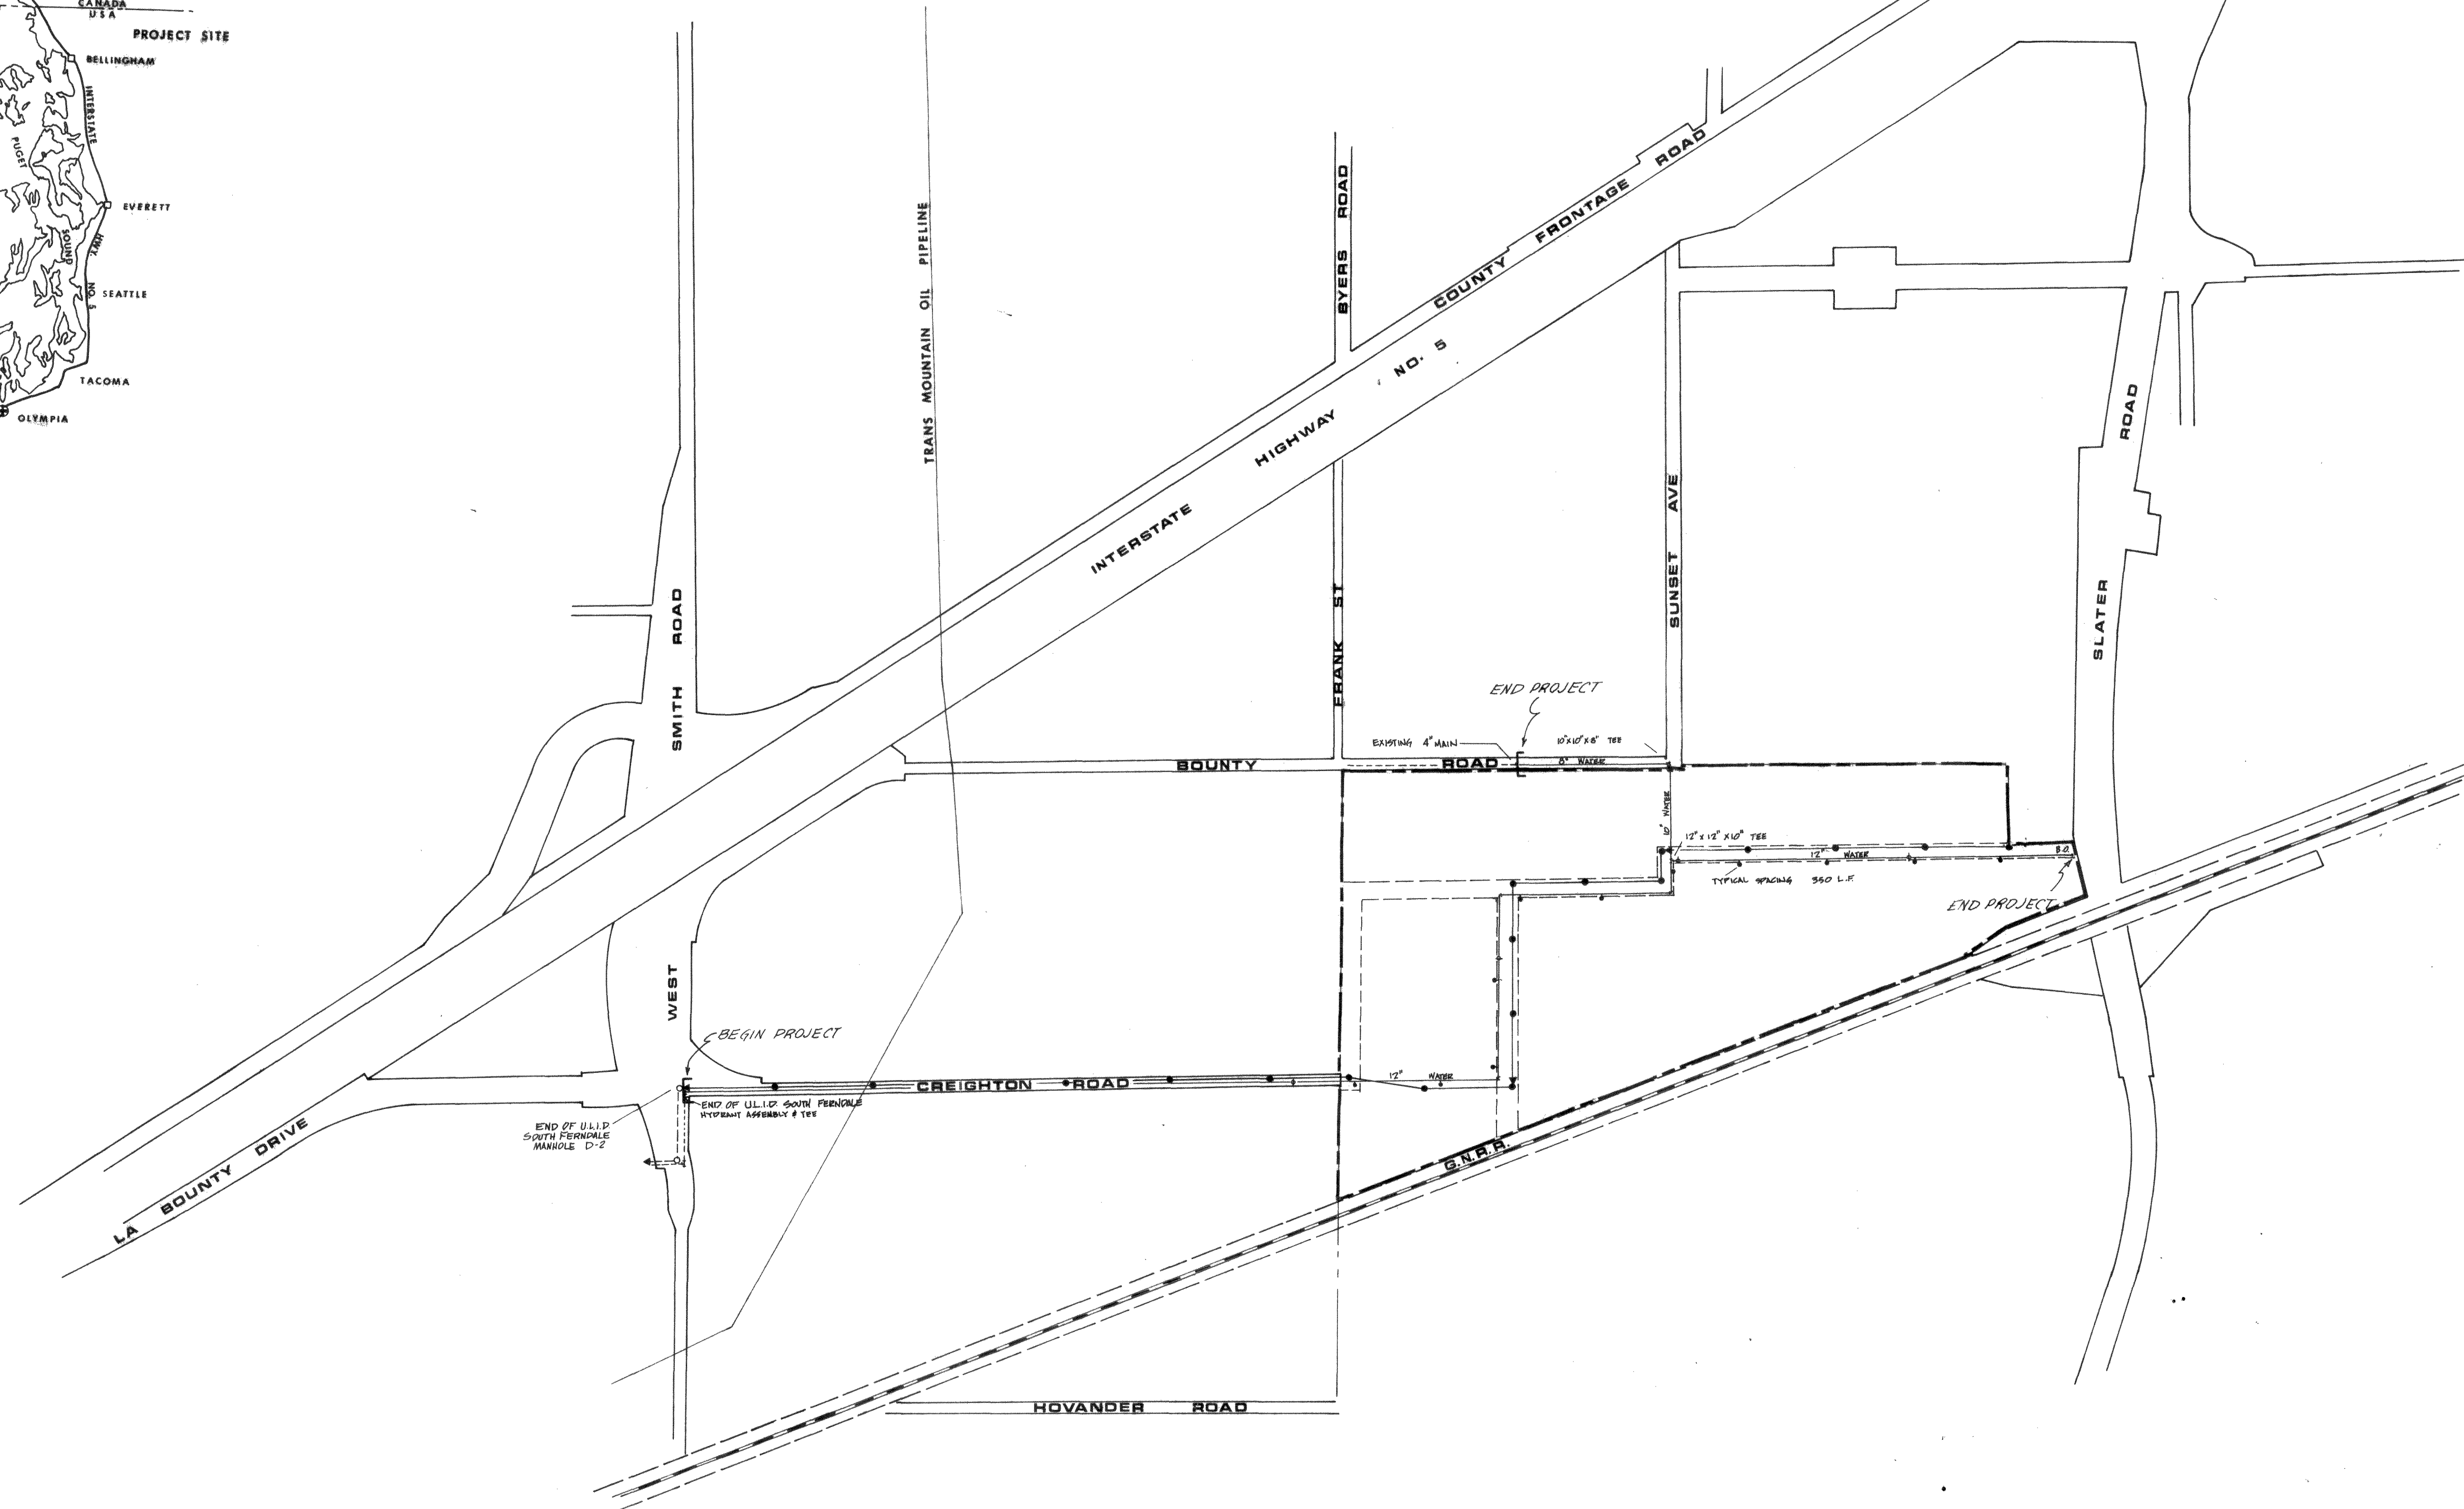


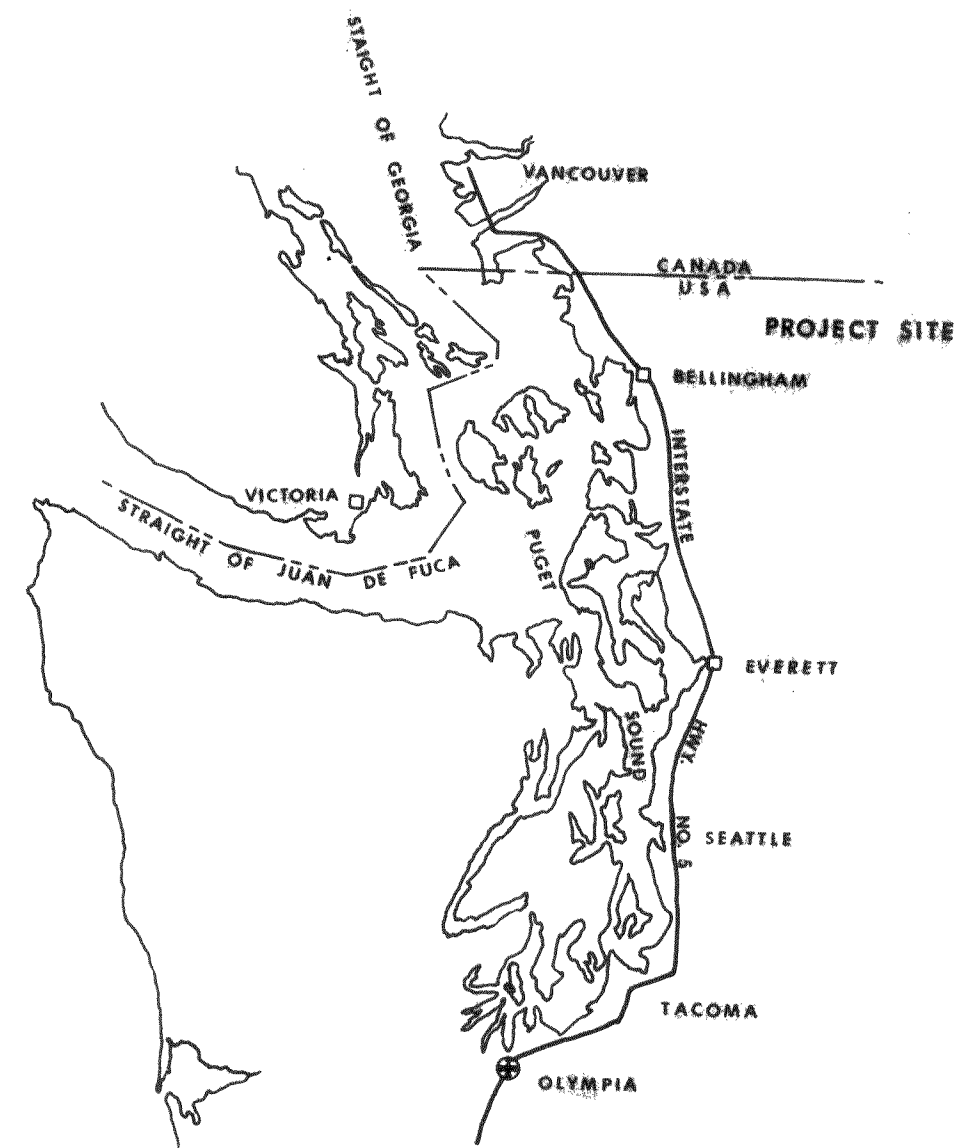

INTERSTATE 5

SMITH ROAD

WEST

TRANS MOUNTAIN OIL PIPELINE
3000' TELEPHONE CABLE

CREIGHTON ROAD

PRIVATE ROAD

SEE SHEET NO. 5
MH W-1
SEE SHEET NO. 3

MH-D2 NOT ON CONTRACT
CONNECT TO EXISTING MANHOLE
45° BENDS
START CONSTRUCTION
CONNECT TO EXISTING WATER
EXISTING 12" SEWER
EXISTING 12" WATER
MH-D1 NOT ON CONTRACT
MH-B1 & PUMP STATION NOT ON CONTRACT


NOTE:
CHANNEL ALL MANHOLES 4-WAY FOR FUTURE CONNECTIONS.

NOTE:
CONCRETE REINFORCED ASTM C-76 CLASS IV
ASBESTOS CEMENT GLASS 3300
POLYVINYL CHLORIDE (P.V.C.) D 3034
TYPE PSM SDR-35 OR DUCTILE IRON PIPE
APWA STANDARDS



GREAT NORTHERN RAILROAD

LINE C

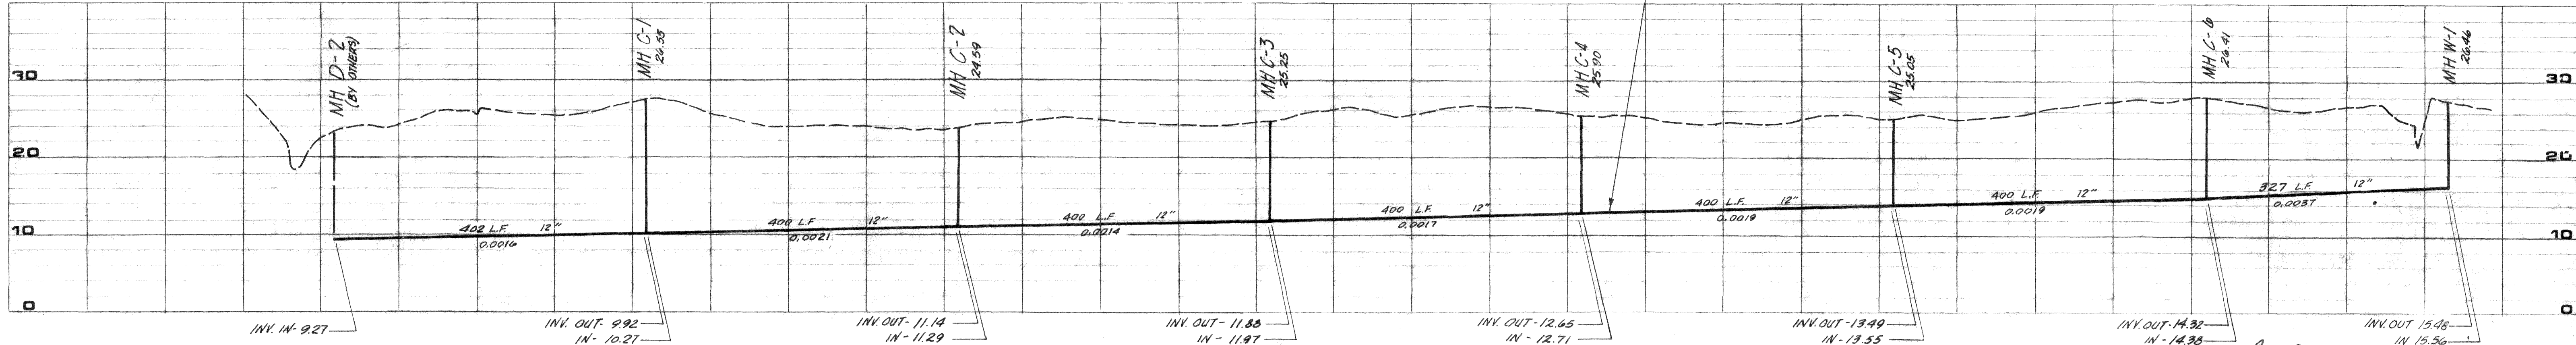

CREIGHTON ROAD PROFILE

AS-BUILT FIELD NOTES 11-7-78

RONALD T. JEPSON &
REGISTERED PROFESSIONAL ENGINEERS AND LAND SURVEYORS


ASSOC., INC.
1509 CORNWALL AVE. BELLINGHAM, WASHINGTON 98225

SCALE 1"=100' DATE March 22, 1978
DRAWN BY: AC
CHECKED BY:
APPROVED:


REVISIONS



WILDER INDUSTRIAL PARK
SEWER & WATER PLANS & PROFILE


SHEET
2
OF
6

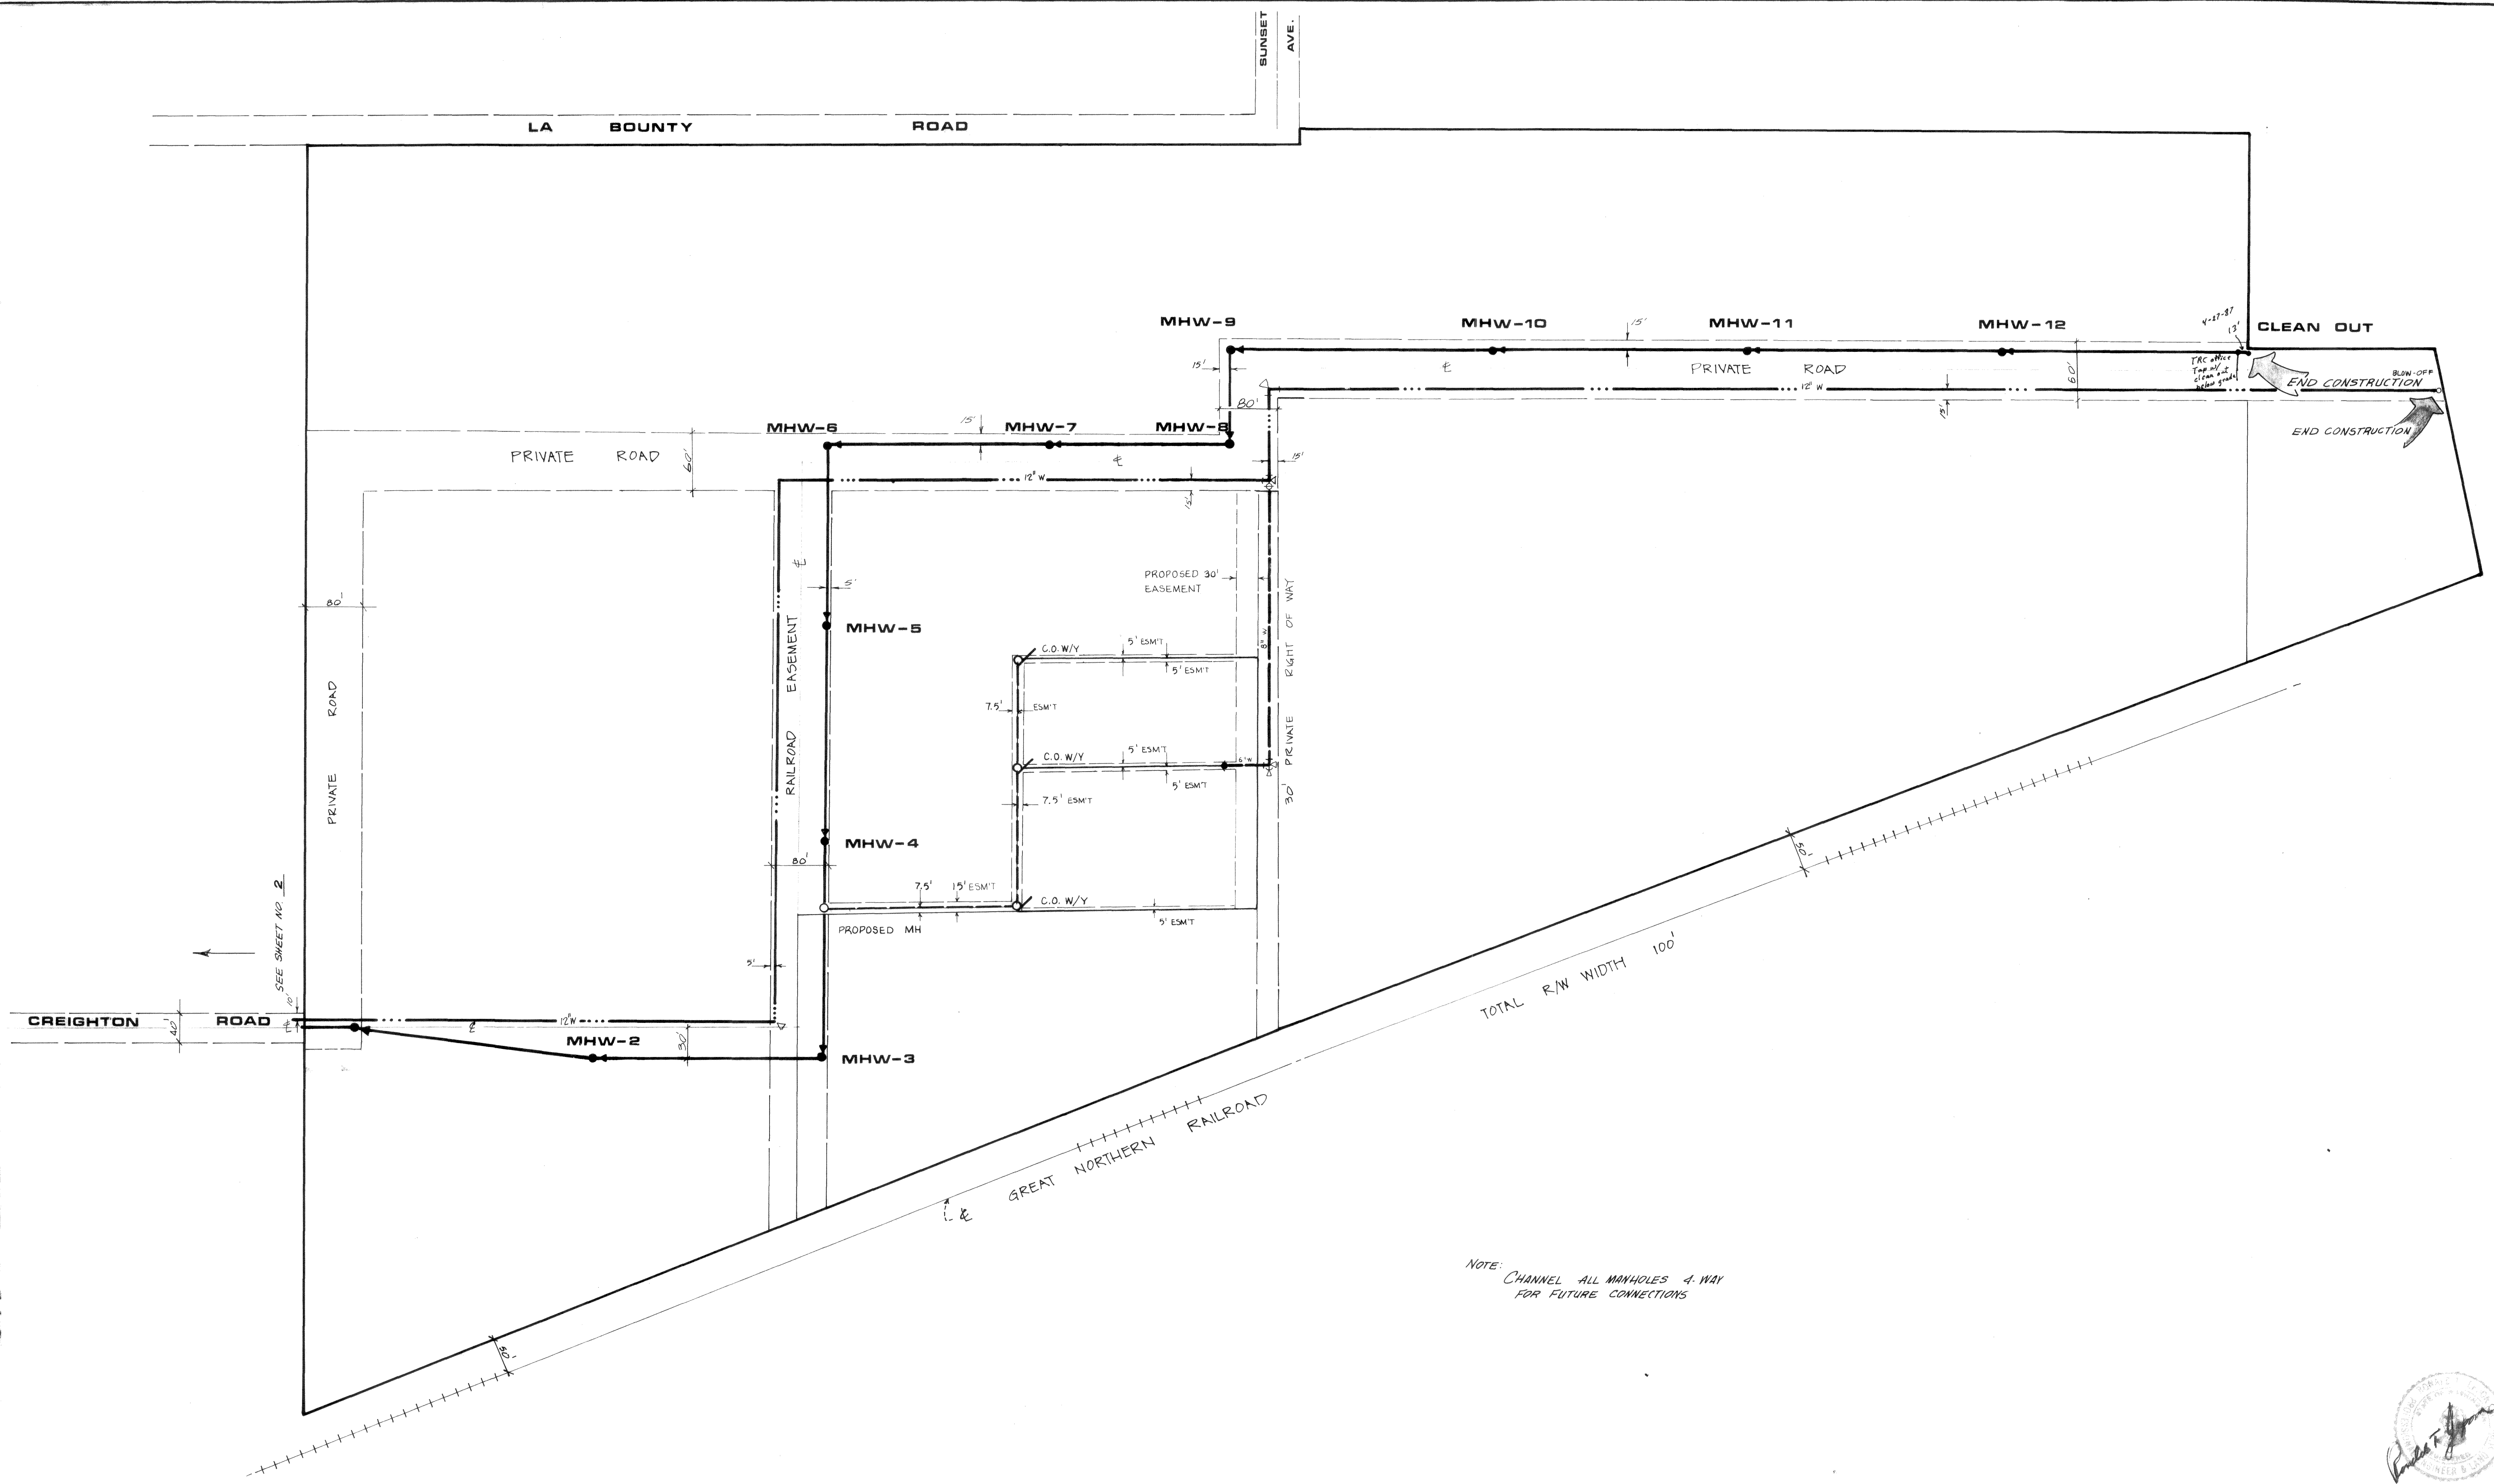

NOTE: CHANNEL ALL MANHOLES 4-WAY
FOR FUTURE CONNECTIONS

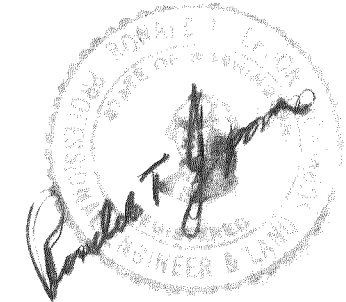

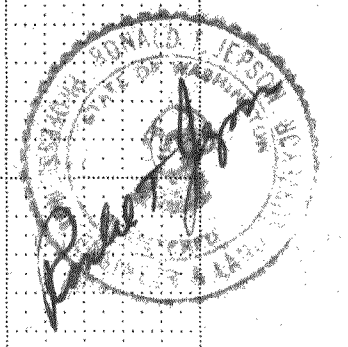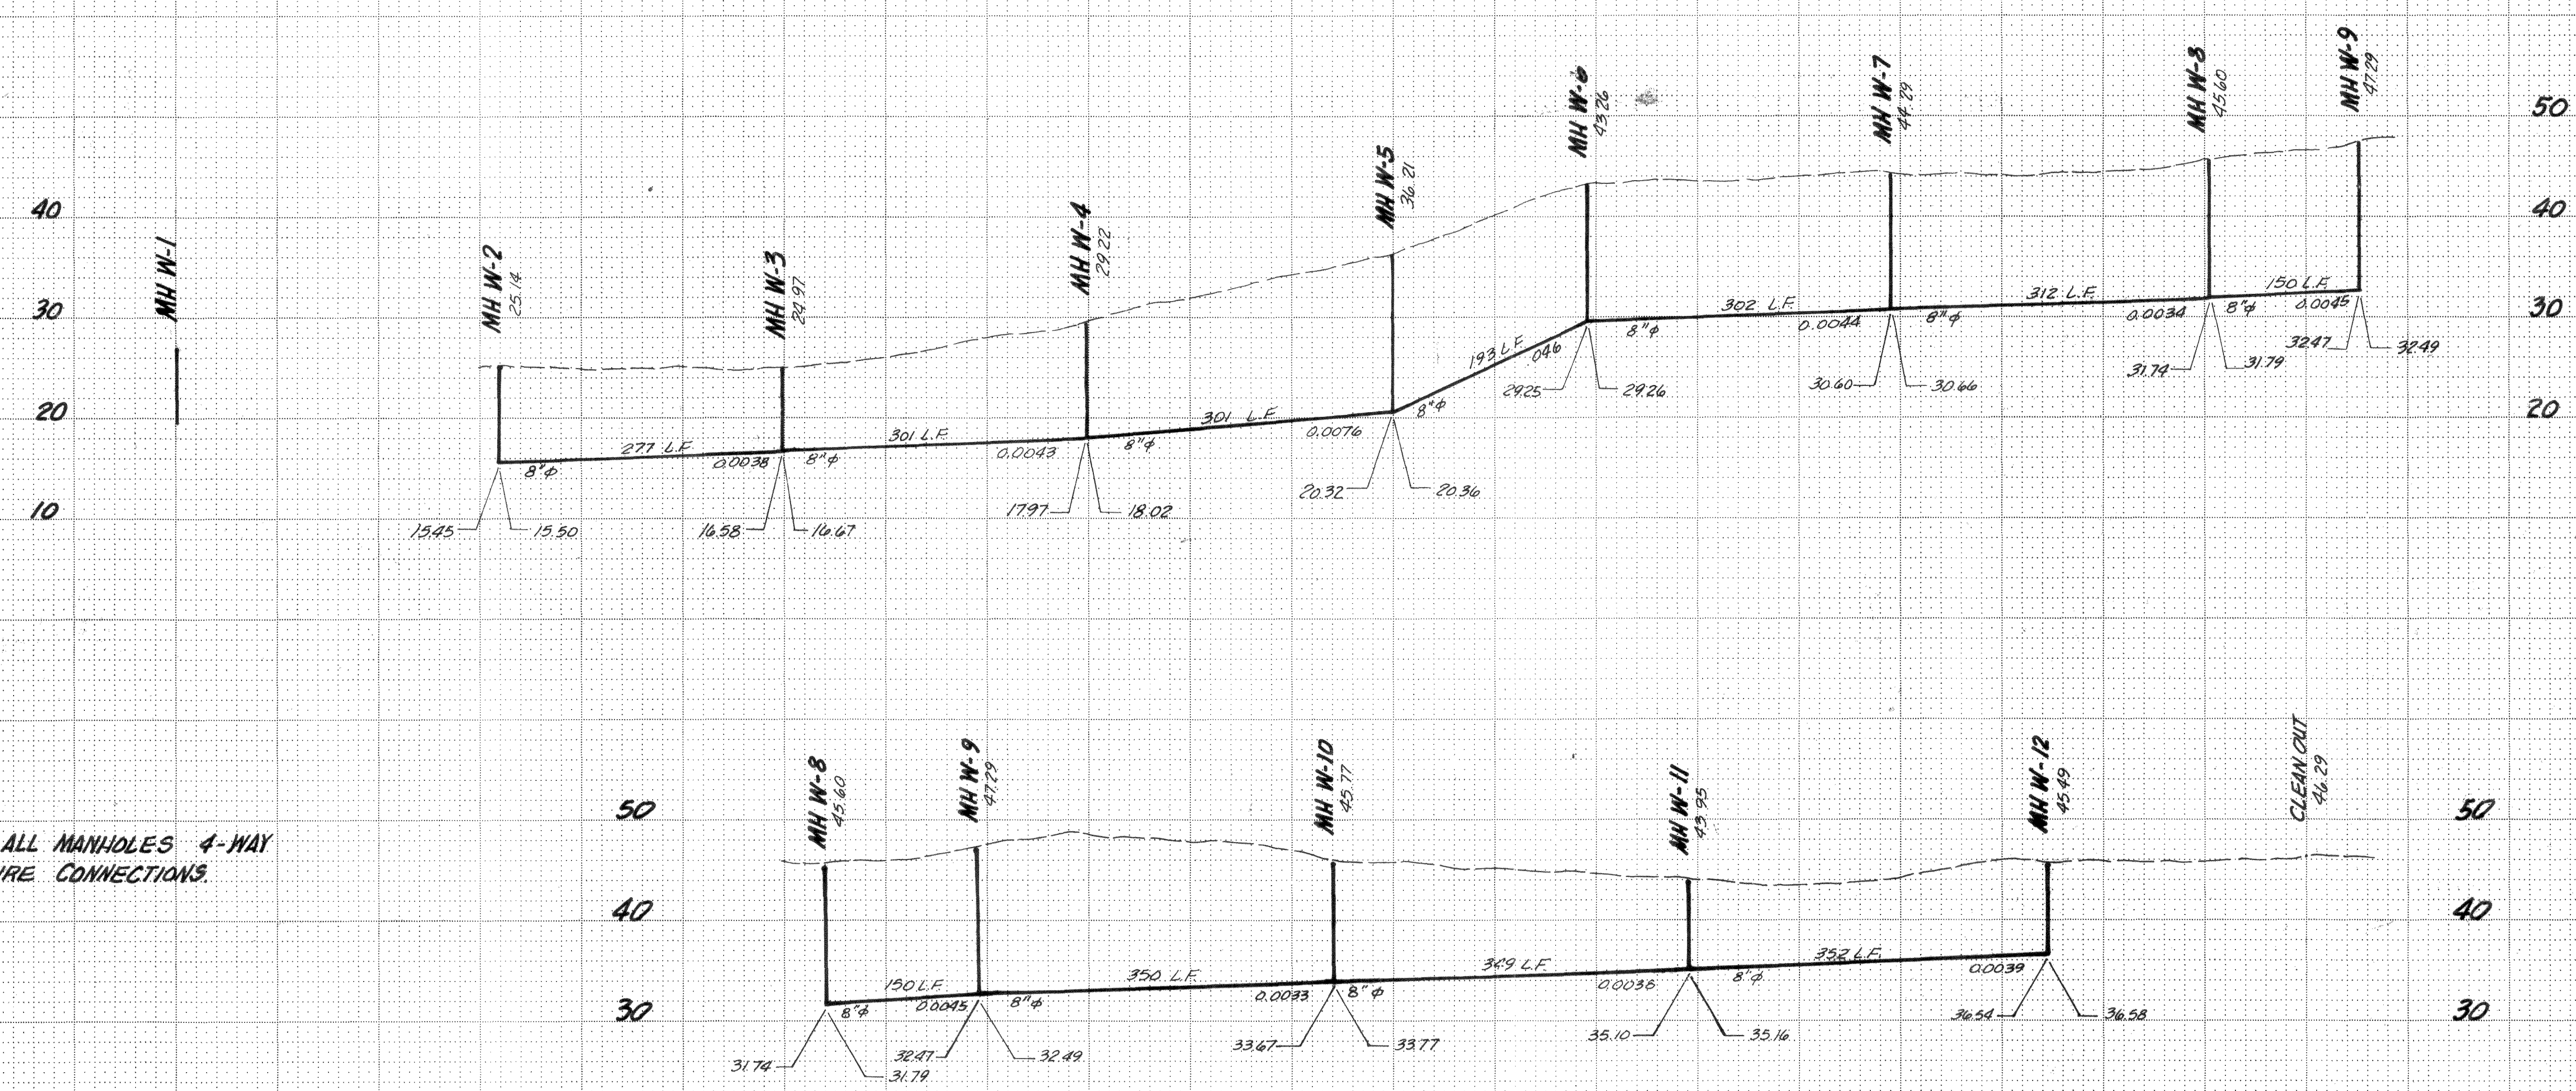

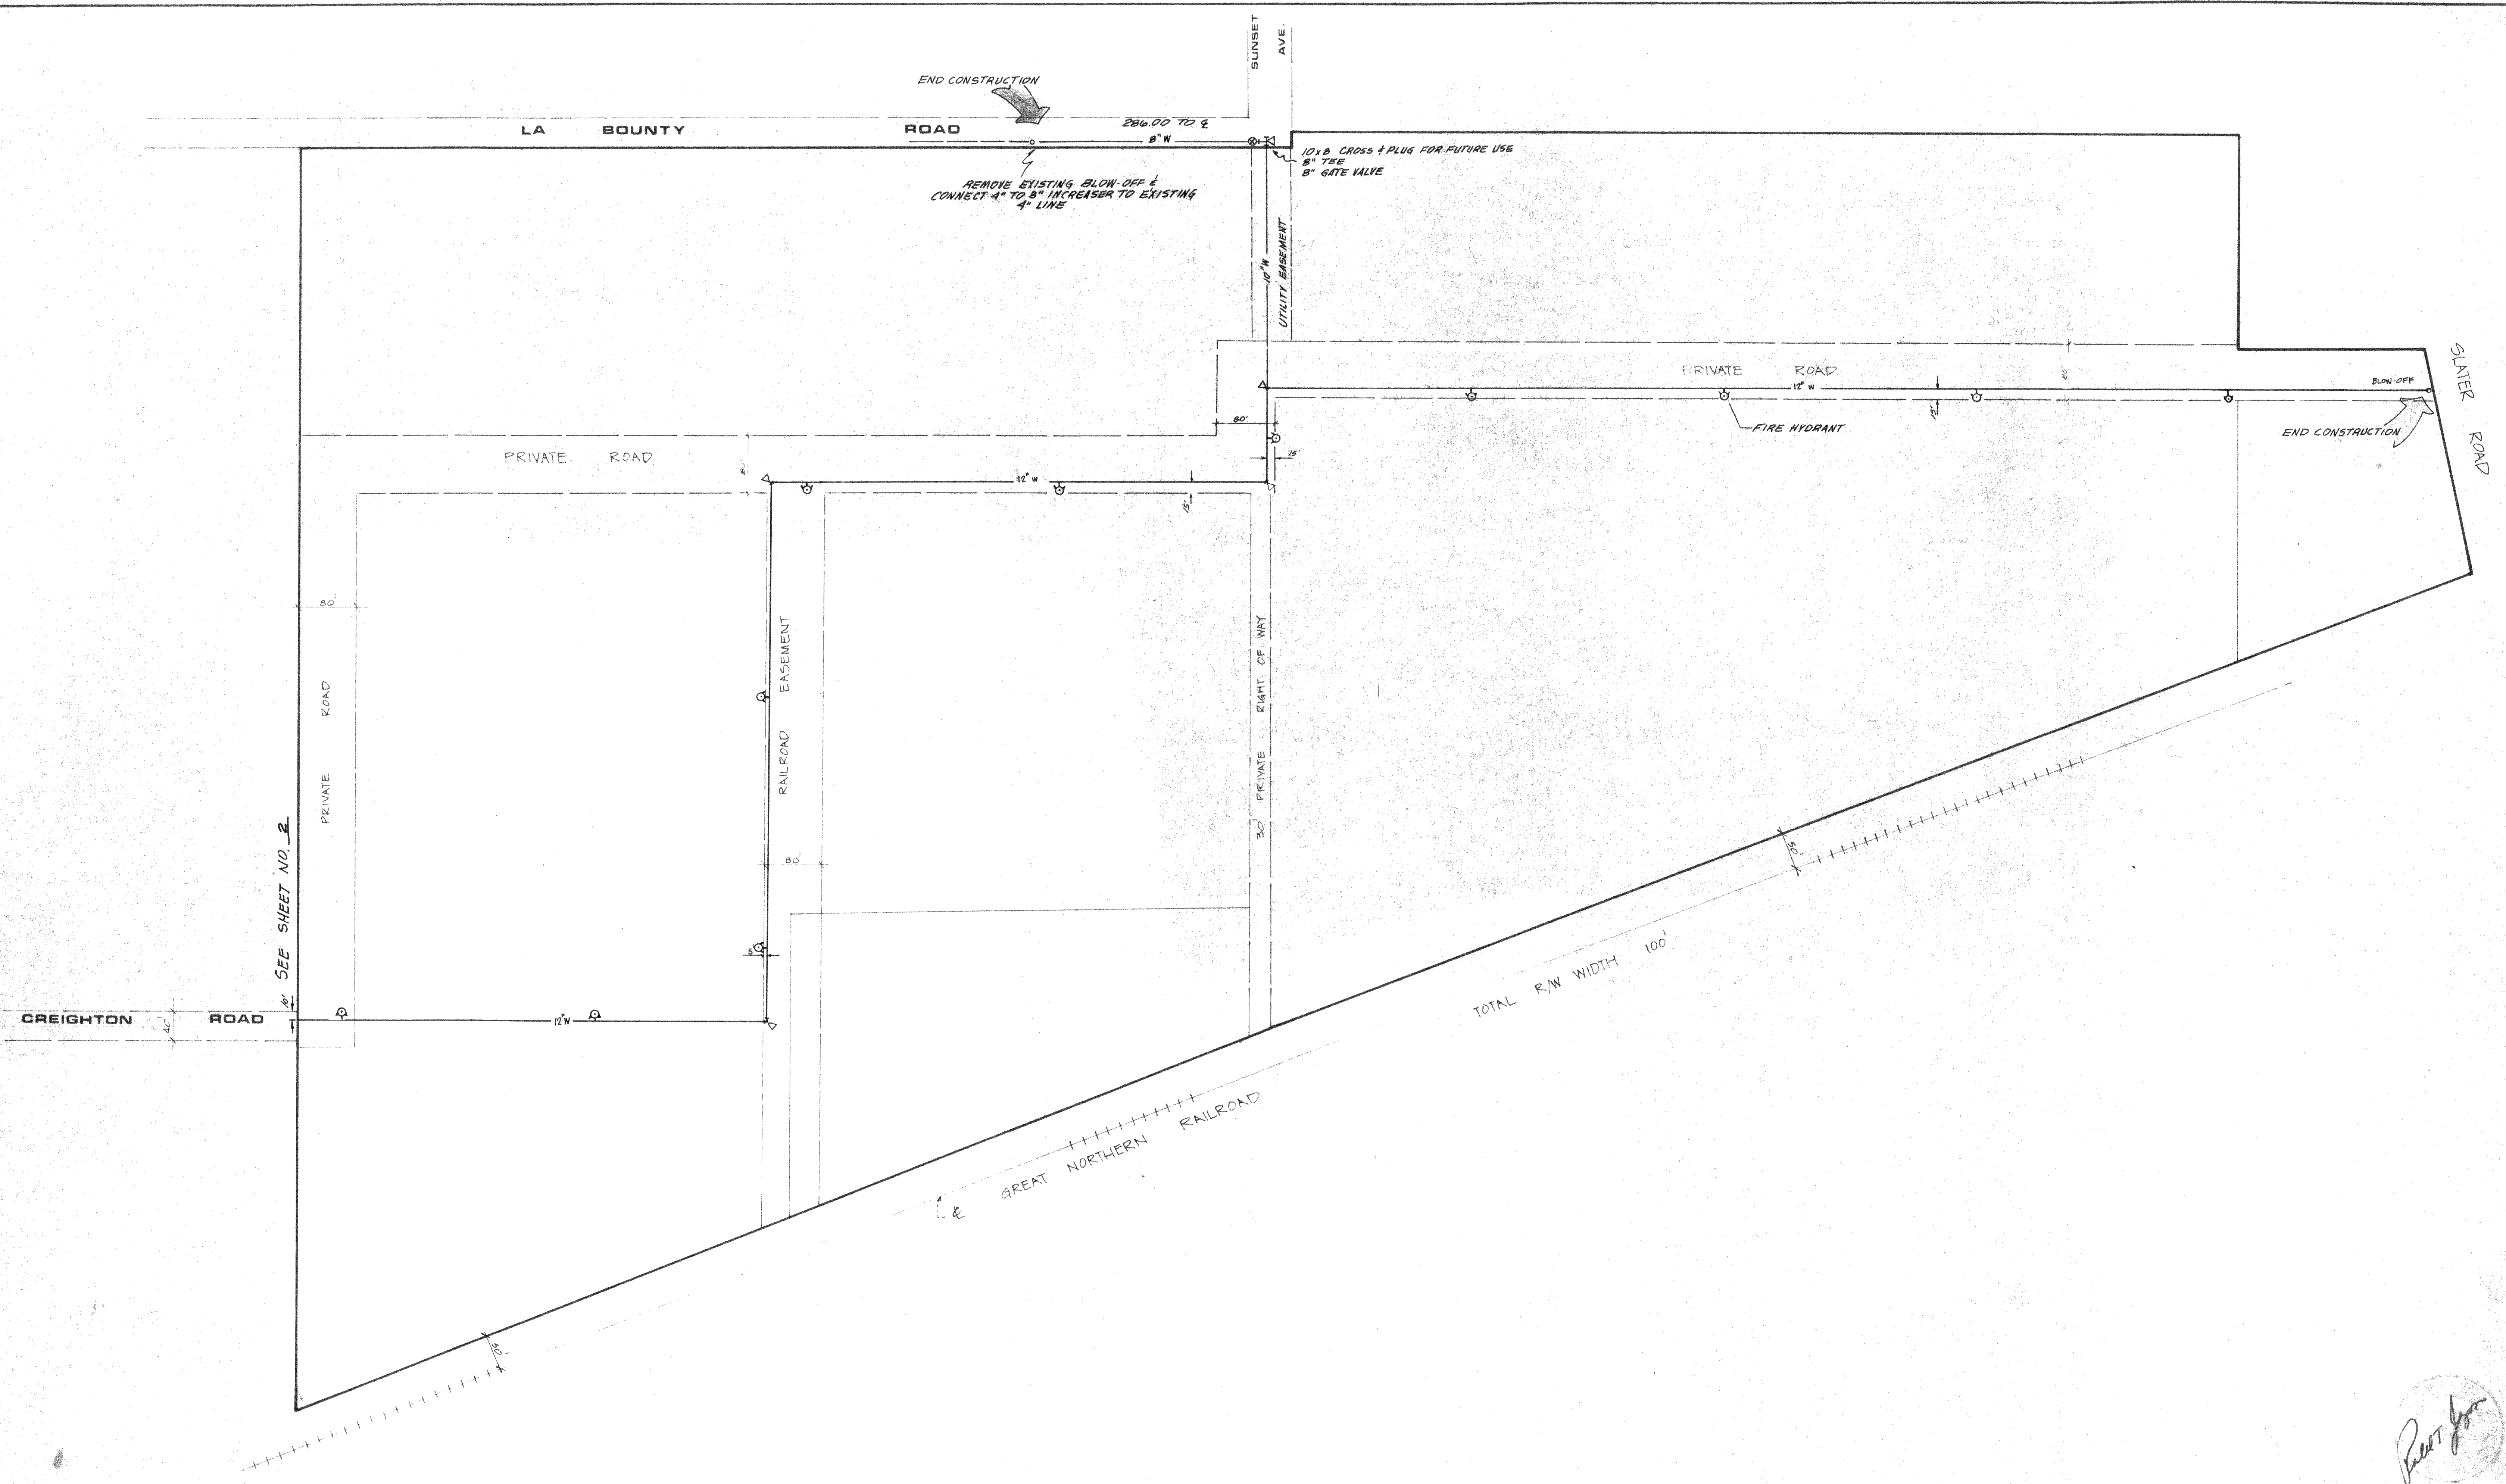

RONALD T. JEPSON & ASSOC., INC.
REGISTERED PROFESSIONAL ENGINEERS AND LAND SURVEYORS
1509 CORNWALL AVE BELLINGHAM, WASHINGTON 98225

SCALE 1"=100'
DATE MARCH 18, 1978
DRAWN BY BJC
CHECKED BY
APPROVED BY

DATE 9/13/78
PROJECT WATER MAIN EXTENSION

**WILDER INDUSTRIAL PARK
WATER DISTRIBUTION SYSTEM**

SHEET
5
OF
6

Robert J. J.

