


00116.001 2-13-06 KR
5-9-06 KR Revision

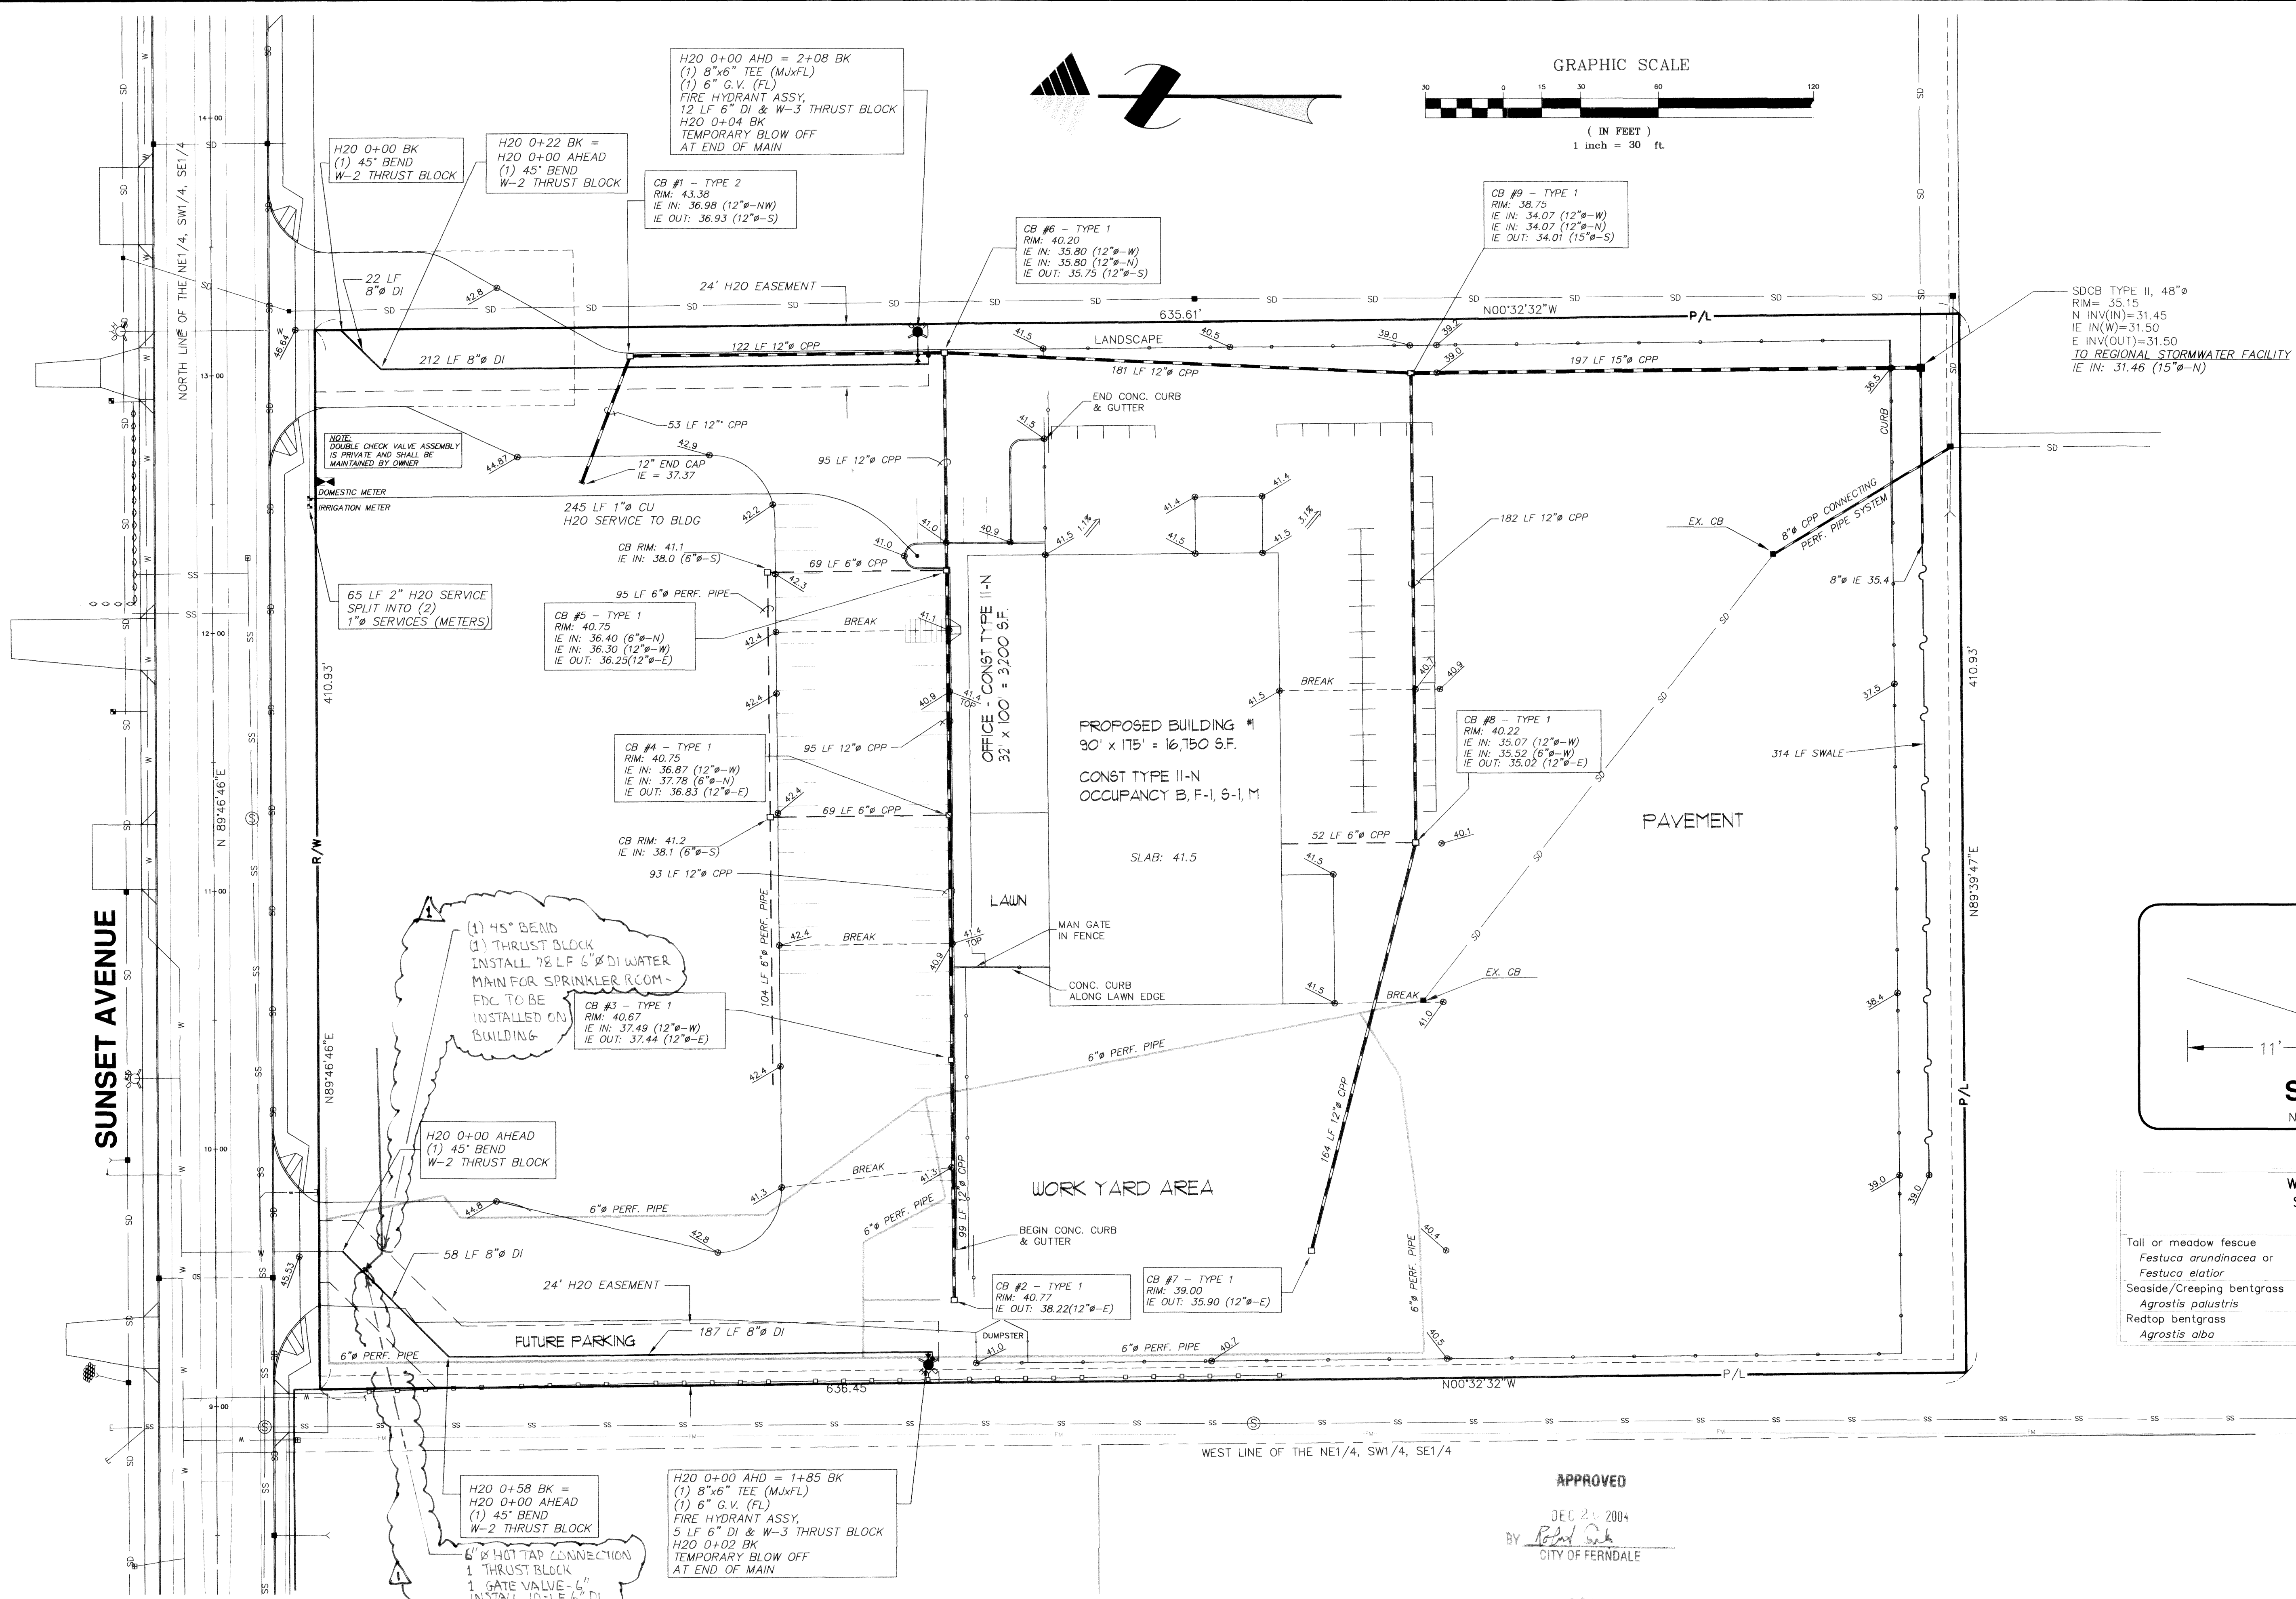

	% Weight	% Purity	% Germination
Tall or meadow fescue <i>Festuca arundinacea</i> or <i>Festuca elatior</i>	75-80	98	90
Seaside/Creeping bentgrass <i>Agrostis palustris</i>	10-15	92	85
Redtop bentgrass <i>Agrostis alba</i>	5-10	90	80

AS-BUILT

CALL BEFORE
YOU DIG
1-800-424-5555


NOTES

1. EXISTING FIELD DATA PER NORTHWEST SURVEYING & GPS SURVEYS PERFORMED JANUARY, 2004 & REICHHARDT & EBE ENGINEERING SUNSET AVE. IMPROVEMENT PLANS.
2. ALL CONSTRUCTION SHALL BE IN ACCORDANCE WITH CITY OF FERNDALE STANDARDS AND CURRENT WSDOT/APWA STANDARD SPECIFICATIONS FOR ROAD, BRIDGE, AND MUNICIPAL CONSTRUCTION.

AS-BUILT DRAWING CERTIFICATION

I hereby certify that a representative sample of the improvements in the Jelco LLC site have been inspected by Millennium Engineering Group, Inc. and constructed in conformance with the plans approved by the Public Works Director for said development and the general specifications adopted by the City of Ferndale Department of Public Works.

DATUM
VERTICAL
CITY OF FERDALE
HORIZONTAL
ASSUMED COORDINATES AT S 1/4 CORNER, SEC. 06
N 4738.63 E 9876.52
BASIS OF BEARINGS
AS PER DMC SUNSET AVE. SHORT PLAT

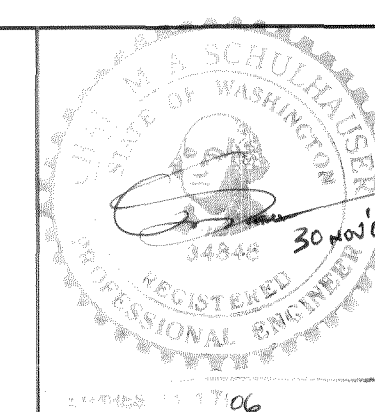

MILLENNIUM
Engineering Group, Inc.

109-6th ST., PO BOX 137, LYNDEN, WA 98264
PH: (360) 354-8141 FAX: (360) 354-3744
mail@2001egi.com www.2001egi.com

LOUIS TRUSS SITE SITE IMPROVEMENTS	SCALE: 1" = 30' DATE: 11/09/04 DRAWN BY: CMAS REVISED:
FOR ROOSEND AAL/HONCOOP	SHEET: 1 OF 1
PTN. SE1/4, SEC.33, T39N, R2E, W.M. CITY OF FERNDALE, WHATCOM COUNTY, WASHINGTON	
JOB NUMBER: 03060	