

PLOT SETTINGS: WE AutoCAD PDF (General Documentation).pc3, WILSON 11X17, Portrait, 1:2, WE APWA\_UNSCREENED.ctb  
W:\2021\2021-091 FERNDAL WATER MAIN INTERTIE\DWG\AS-BUILT\TAB V2019\_2021-091 CO.1 COVER SHEET.DWG - 5/31/2023 11:18 AM - Jeff Smith


# CITY OF FERNDALE

## WATER SYSTEM EMERGENCY INTERTIE


## RECORD DRAWINGS

NO.	REVISIONS	BY	DATE

AREA MAP - NOT TO SCALE

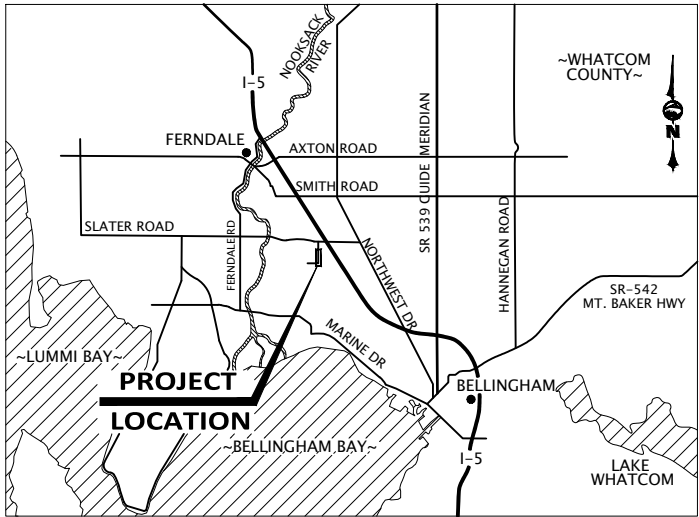

VICINITY MAP - NOT TO SCALE

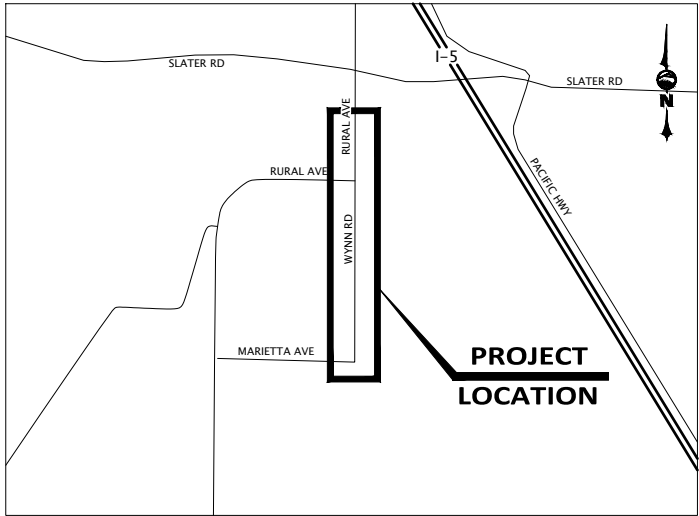

INDEX TO DRAWINGS

Number	Sheet Number	Sheet Title
1	C0.1	COVER SHEET
2	C0.2	LEGEND & ABBREVIATIONS
3	C1.1	W.A.C. 332-130 COMPLIANCE SHEET
4	C2.1	EXISTING CONDITIONS (1)
5	C2.2	EXISTING CONDITIONS (2)
6	C2.3	EXISTING CONDITIONS (3)
7	C2.4	EXISTING CONDITIONS (4)
8	C2.5	TESC NOTES AND DETAILS
9	C2.6	TESC NOTES
10	C3.1	PLAN AND PROFILE STA 0+00 - 5+00
11	C3.2	PLAN AND PROFILE STA 5+00 - 10+00
12	C3.3	PLAN AND PROFILE STA 10+00 - 15+00
13	C3.4	PLAN AND PROFILE STA 15+00 - 20+00
14	C3.5	PLAN AND PROFILE STA 20+00 - 25+00
15	C3.6	PLAN AND PROFILE STA 25+00 - 30+00
16	C3.7	PLAN AND PROFILE STA 30+00 - 33+00
17	C3.8	PLAN AND PROFILE STA 33+00 - 36+20
18	C5.1	VAULT DETAILS
19	C5.2	CIVIL DETAILS (1)
20	C5.3	CIVIL DETAILS (2)
21	C5.4	CIVIL DETAILS (3)
22	C5.5	CIVIL DETAILS (4)
23	C5.6	CIVIL DETAILS (5)
24	C5.7	CIVIL DETAILS (6)
25	C5.8	CIVIL DETAILS (7)

GENERAL NOTES

### WHATCOM COUNTY GENERAL NOTES

- ALL WORK AND MATERIALS SHALL BE IN ACCORDANCE WITH CURRENT WSDOT/APWA STANDARD SPECIFICATIONS, WHATCOM COUNTY DEVELOPMENT STANDARDS (WCDS), AND SHALL BE SUBJECT TO APPROVAL BY WHATCOM COUNTY PUBLIC WORKS DEPARTMENT - ENGINEERING DIVISION - PUBLIC WORKS ENGINEERING SERVICES (PWES).
- DEVELOPER/CONTRACTOR/CONSULTING ENGINEER SHALL SCHEDULE A PRE-CONSTRUCTION CONFERENCE WITH THE PUBLIC WORKS ENGINEERING SERVICES PROJECT MANAGER A MINIMUM OF 3 WORKING DAYS PRIOR TO BEGINNING ANY WORK.
- NORMAL WORKING HOURS ARE 7:30 AM. TO 4:00 PM., MONDAY THROUGH FRIDAY. WORK DURING HOLIDAYS, WEEKENDS, AND OUTSIDE THE NORMAL WORK HOURS REQUIRES PRIOR ARRANGEMENTS AND APPROVAL.
- SIGHT DISTANCE REQUIRED AT ALL INTERSECTIONS PER WCDS CHAPTER 5.
- A REVOCABLE ENCROACHMENT PERMIT SHALL BE OBTAINED PRIOR TO COMMENCING ANY WORK WITHIN COUNTY MAINTAINED ROAD RIGHTS-OF-WAY.
- THE CONTRACTOR SHALL CONTACT UTILITY LOCATION SERVICE 48 HOURS PRIOR TO STARTING WORK AT (800)424-5555 OR 811.
- A COPY OF THE COUNTY-APPROVED DRAWINGS MUST BE ON THE JOB SITE WHENEVER WORK IS IN PROCESS.
- WHATCOM COUNTY RESERVES THE RIGHT TO INSPECT ALL WORK. THE CONTRACTOR SHALL CALL THE CONSULTING ENGINEER AND THE PUBLIC WORKS ENGINEERING SERVICES PROJECT MANAGER AT (360)778-6220 AT LEAST 24 HOURS IN ADVANCE OF THE FOLLOWING WORK ITEMS:
  - PLACEMENT OF TEMPORARY EROSION AND SEDIMENTATION CONTROL MEASURES.
  - PLACEMENT OF WATER, SANITARY SEWER, AND STORM DRAINAGE LINES AND BACKFILLING OF THESE LINES WITHIN COUNTY MAINTAINED ROAD RIGHTS-OF-WAY.
  - PLACEMENT OF UNDERGROUND UTILITIES AND BACKFILLING WITHIN COUNTY MAINTAINED ROAD RIGHTS-OF-WAY.
  - ROADWAY GRADING AT THE COMPLETION OF THE SUBGRADE, BALLAST, AND OF CRUSHED SURFACING.
  - POURING OF CURB/GUTTER AND SIDEWALK.
  - ASPHALT PAVING, AT THE BEGINNING OF PAVING.
  - PRIOR TO PAVEMENT MARKING.
  - OVERALL INSPECTION OF FINISHED SHOULDERS, DITCHES, PERMANENT SEEDING, ROAD SIGNAGE, MONUMENT PLACEMENT, CLEANING OF DRAINAGE SYSTEM AND CONSTRUCTION DEBRIS.
  - ALL WORK REQUIRED TO RELEASE OF ANY POSTED SECURITY.

CONTACT INFORMATION

**CIVIL ENGINEER**  
WILSON ENGINEERING, LLC  
805 DUPONT STREET, BELLINGHAM, WA 98225  
BRIAN SMITH, PE  
BSMITH@WILSONENGINEERING.COM  
PHONE 360.733.6100 EXT. 1216  
ANDY LAW, PE  
PHONE 360.733.6100 EXT. 1225  
EMAIL: ALAW@WILSONENGINEERING.COM

**SURVEYOR**  
WILSON ENGINEERING, LLC  
805 DUPONT STREET, BELLINGHAM, WA 98225  
PAUL DARROW, PLS  
PHONE 360.733.6100 EXT. 243  
EMAIL: PDARROW@WILSONENGINEERING.COM

### PUGET SOUND ENERGY

ROBERT LEE  
PROJECT MANAGER  
PHONE: 360.599.9775  
EMAIL: ROBERT.LEE@PSE.COM

**CITY OF FERNDALE**  
KEVIN RENZ  
PUBLIC WORKS DIRECTOR  
2095 MAIN ST, FERNDALE, WA 98248  
PHONE: 360.685.2375  
EMAIL: KEVINRENZ@CITYOFFERNDALE.ORG

**CITY OF BELLINGHAM**  
CHAD SCHULHAUSER, P.E.  
CITY ENGINEER  
2221 PACIFIC STREET  
BELLINGHAM, WA 98229  
PHONE: 360.778.7910  
EMAIL: CMSCHULHAUSER@COB.ORG

I HEREBY DECLARE THAT THESE DOCUMENTS WERE PREPARED UNDER MY DIRECT SUPERVISION AND THAT THE PLANS, SPECIFICATIONS AND DESIGN SHOWN HEREIN GENERALLY CONFORM TO ACCEPTED ENGINEERING STANDARDS AND MEET THE REQUIREMENTS SET FORTH UNDER THE WHATCOM COUNTY DEVELOPMENT STANDARDS.

SIGNED: \_\_\_\_\_

- THE CONTRACTOR MUST PROVIDE THE FOLLOWING TESTS:
  - CURB/GUTTER, SIDEWALK, ROADWAY BASE COMPACTION - MINIMUM 1 TEST EVERY 1-3 STATIONS, VARIES WITH LENGTH, MINIMUM OF 2 TESTS PER CATEGORY OR AT THE DIRECTION OF COUNTY INSPECTOR.
  - PROOF ROLL OF BASE MATERIAL WITH COUNTY INSPECTOR PRESENT BEFORE CRUSHED TOP SURFACING IS PLACED.
  - CONCRETE CYLINDER COMPRESSION - 1 CYLINDER EVERY THIRD LOAD - MINIMUM OF 2 SAMPLES/DAY.
  - HMA PAVING DENSITY - PER WSDOT STANDARD SPECIFICATIONS.
- ALL TESTING REQUIRED FOR THE WORK SHALL BE THE RESPONSIBILITY OF THE OWNER AND SHALL BE IN CONFORMANCE WITH WCDS WITH RESPECT TO THE CONSULTING ENGINEER.
- THE CONTRACTOR SHALL RIP RAP ALL CULVERT INLETS AND OUTLETS.
- THE CONTRACTOR SHALL RESTORE ALL PRIVATE AND PUBLIC PROPERTY DISTURBED BY THE WORK IMMEDIATELY AFTER CONSTRUCTION. THE CONTRACTOR SHALL NOT LEAVE ANY PART OF THE ROAD USED BY OTHERS UN-PASSABLE WITHOUT NOTIFICATIONS AND AGREEMENT OF OTHER USERS.
- ALL CUT AND FILL SLOPES SHALL BE MULCHED AND SEEDED FOR EROSION CONTROL. THE CONTRACTOR SHALL BE RESPONSIBLE FOR SLOPE EROSION UNTIL VEGETATION IS FIRMLY ESTABLISHED.
- CONTRACTOR SHALL SWEEP AND REMOVE ALL DEBRIS TRACKED ONTO EXISTING ROADS DURING ALL PHASES OF CONSTRUCTION.
- ANY TREE, WHERE 1/3 OF THE ROOT SYSTEM IS DAMAGED BY WORK, SHALL BE REMOVED.
- THE CONTRACTOR SHALL INFORM THE CONSULTING ENGINEER AND OBTAIN APPROVAL FROM WHATCOM COUNTY ENGINEERING DIVISION OF ANY PROPOSED CHANGES IN PLANS PRIOR TO IMPLEMENTATION OF THE CHANGE. THE CONTRACTOR SHALL KEEP RECORDS OF DEVIATIONS AND FORWARD TO THE ENGINEER OF RECORD AND WHATCOM COUNTY ENGINEERING DIVISION.
- TRAFFIC CONTROL IS TO BE MAINTAINED IN ACCORDANCE WITH WSDOT/APWA STANDARD SPECIFICATIONS.
- THE DEVELOPER/CONTRACTOR SHALL POST A WARRANTY SECURITY AS REQUIRED BY THE WHATCOM COUNTY DEVELOPMENT STANDARDS.
- AN ENGINEER SHALL PROVIDE RECORD DRAWINGS PER WCDS 507.D.
- REFER TO SPECIFICATIONS FOR WATER MAIN TESTING REQUIREMENTS.



RECORD DRAWINGS

WILSON  
ENGINEERING

WILSONENGINEERING.COM

BRAND SMITH  
WASHINGTON  
REGISTERED PROFESSIONAL  
17/51/23

DESIGNED BY  
BMS

DRAWN BY  
JGS

CHECKED BY  
AWL

CITY OF FERNDALE

WASHINGTON

FERNDALE

DATE  
5-31-23

SCALE  
AS SHOWN

JOB NUMBER  
2021-091

SHEET  
C0.1

PAGE  
1

OF  
25

COVER SHEET

LEGEND & ABBREVIATIONS— SIZE & SCALE MAY VARY	
<b>EXISTING HATCH PATTERNS</b>	
	EXIST. CONCRETE
	EXIST. BUILDING
	EXIST. EARTH
	EXIST. GRAVEL
	EXIST. SAND
<b>PROPOSED HATCH PATTERNS</b>	
	PROP. CONCRETE
	PROP. TOP COURSE GRAVEL
	PROP. GRAVEL
	PROP. ASPHALT
	PROP. QUARRY SPALLS
	WETLAND HATCH
<b>SURFACE FEATURES</b>	
<b>EXISTING PLAN LINETYPES</b>	
	BRIDGE
	BUILDING LINE
	BUILDING COLUMN
	BUILDING OVERHANG
	BULKHEAD
	CONCRETE EDGE
	CREEK EDGE
	CROWN OF ROAD
	CURB
	DITCH CENTERLINE
	DECK
	DOCK
	EDGE OF SAWCUT
	EDGE OF PAVEMENT
	FENCE
	GATE
	GRADE
	GRAVEL
	GUARDRAIL
	JERSEY BARRIER
	LAKE/POND WATER EDGE
	LIP OF CURB
	MISC SURFACE FEATURE
	MISC TRAFFIC
	PLANTER
	PATH
	RAILROAD
	RAMP (WOOD)
	HANDRAIL
	RETAINING WALL
	ROAD STRIPING
	ROCKERY
	RIVERBANK/ShORELINE
	THALWAG LINE
	TOP OF BANK/SLOPE
	TOE OF BANK/SLOPE
	VEGETATION/SHRUB LINE
	WETLAND/SWAMP PERIMETER
	WETLAND BUFFER
<b>SURFACE FEATURES</b>	
<b>PROPOSED PLAN LINETYPES</b>	
	BRIDGE
	BUILDING LINE
	CONCRETE
	CURB
	DITCH CENTERLINE
	EDGE OF BIKE LANE
	EDGE OF PAVEMENT
	FENCE
	GATE
	GRAVEL
	GUARDRAIL
	JERSEY BARRIER
	LIP OF CURB
	REBAR
	RETAINING WALL
	ROCKERY
	ROAD STRIPING
	HANDRAIL
	EDGE OF SAWCUT

UTILITIES		DESCRIPTION
EXISTING PLAN LINETYPES		
-----TV-----TV-----		CABLE TELEVISION (AERIAL)
-----TV-----TV-----		CABLE TELEVISION (BURIED)
-----C-----		SURVEILLANCE CAMERA (BURIED)
-----FO-----FO-----		FIBER OPTIC/COMMUNICATIONS LINE (AERIAL)
-----FO-----FO-----		FIBER OPTIC/COMMUNICATIONS LINE (BURIED)
-----OHT-----OHT-----		TELEPHONE/COMMUNICATIONS (AERIAL)
-----T-----T-----		TELEPHONE/COMMUNICATIONS (BURIED)
-----SC-----SC-----		TRAFFIC SIGNAL CONDUIT LINE
-----OHP-----OHP-----		POWER (AERIAL)
-----P-----P-----		POWER (BURIED)
-----UT-----UT-----		UTILITY (AERIAL)
-----UT-----UT-----		UTILITY (BURIED)
-----PDB-----PDB-----		POWER DUCT BANK (BURIED)
-----DF-----DF-----		DRAIN FIELD
-----S-----S-----		SANITARY SEWER
-----S-----S-----S-----S-----S-----S-----		APPROXIMATE SANITARY SEWER
-----FM-----FM-----		SANITARY SEWER (FORCE MAIN)
-----FM-----FM-----FM-----FM-----FM-----FM-----		APPROXIMATE SANITARY SEWER (FORCE MAIN)
-----SD-----SD-----		STORM DRAINAGE
-----SD-----SD-----SD-----SD-----SD-----SD-----		APPROXIMATE STORM DRAINAGE
=====		CULVERT (Ø WIDTH)
>-----<		CULVERT
-----RW-----RW-----		RECLAIMED WATER
-----IRR-----IRR-----		IRRIGATION
-----W-----W-----		WATER
-----W-----W-----W-----W-----W-----W-----		APPROXIMATE WATER
-----8W-----8W-----		8" WATER
-----OF-----OF-----		OVERFLOW
-----STE-----STE-----		STEAM
-----G-----G-----		GAS
-----		GAS TANK/STRUCTURE
-----O-----O-----		OIL
-----AIR-----AIR-----		AIR LINE
-----		BURIED UTILITY APPROX. EXTENTS
-----		MISC UTILITY (BURIED)
PROPOSED PLAN UTILITY LINETYPES		DESCRIPTION
WATER		
-----W-----W-----		WATER
-----8W-----8W-----		8" WATER
-----IRR-----IRR-----		IRRIGATION
-----RW-----RW-----RW-----RW-----RW-----RW-----		RECLAIMED WATER
-----PW-----PW-----PW-----PW-----PW-----PW-----		POTABLE WATER
-----W-----W-----W-----W-----W-----W-----		WATER SERVICE
-----		WATER STRUCTURE
-----FDC-----FDC-----		FIRE DEPARTMENT CONNECTION
-----FP-----FP-----		FIRE PROTECTION LINE
SANITARY SEWER		
-----S-----S-----		SEWER
-----8S-----8S-----		8" SEWER
-----FM-----FM-----		FORCE MAIN
-----DF-----DF-----		DRAIN FIELD
-----S-----S-----S-----S-----S-----S-----		SEWER SERVICE
-----		SEWER STRUCTURE
STORM DRAIN		
-----D-----D-----		STORM DRAIN
-----SD-----SD-----		STORM DRAIN
=====		STORM DRAIN
-----D-----D-----D-----D-----D-----D-----		STORM SERVICE
-----FD-----FD-----FD-----FD-----FD-----FD-----		FOOTING DRAIN
-----		STORM STRUCTURE
MISC. UTILITIES		
-----G-----G-----		GAS
-----P-----P-----		POWER
-----T-----T-----		TELEPHONE/COMMUNICATIONS
EROSION CONTROL		DESCRIPTION
-----TSD-----TSD-----		EROSION TRIANGULAR SILT DIKE
-----CB-----CB-----		EROSION CONTROL COMPOST BERM
-----100-----		EROSION CONTROL MINOR CONTOUR
-----OB-----OB-----		EROSION CONTROL MAJOR CONTOUR
-----SF-----SF-----		ORANGE BARRIER FENCE
-----SW-----SW-----		SILT FENCE
----->----->-----		STRAW WATTLE
----->----->-----		EROSION CONTROL FLOWLINE
SB		STRAW BALE
IP		INLET PROTECTION
CD		CHECK DAM

SURVEY PLAN LINETYPES	DESCRIPTION
	CENTERLINE (EXISTING)
	CENTERLINE (CONSTRUCTION)
	CENTERLINE (PROPOSED)
	CONTOUR (EXISTING MINOR)
	CONTOUR (EXISTING INDEX)
	HYDRO CONTOUR (EXISTING INDEX)
	CONTOUR (PROPOSED INDEX)
	CONTOUR (PROPOSED MINOR)
	DONATION LAND CLAIM (EXIST.)
	EASEMENT (PROPOSED)
	EASEMENT (EXISTING)
	MEANDER LINE
	ORDINARY HIGH WATER LINE
	MEAN LOW LEVEL WATER LINE
	OWNERSHIP LINE
	PROPERTY LINE (RECORD OR ADJACENT)
	PROPERTY LINE
	QUARTER SECTION LINE
	RANGE/TOWNSHIP LINE
	RESERVATION/PARK/FOREST (EX)
	RIGHT-OF-WAY (EXISTING)
	RIGHT-OF-WAY (EXISTING)
	RIGHT-OF-WAY (EXISTING USED)
	RIGHT-OF-WAY (PROPOSED)
	RIGHT-OF-WAY (EX. RECORD) (RECORD OR ADJACENT)
	RIGHT-OF-WAY (LIMITED ACCESS)
	RIGHT-OF-WAY (LIMITED ACCESS)
	SECTION LINE
	SETBACK LINE (EXISTING)
	SIXTEENTH SECTION LINE
	STATE/COUNTY/CORPORATE LIMIT
	VACATED RIGHT-OF-WAY
	EASEMENT (RECORD)
	RIGHT-OF-WAY CENTER (RECORD)
	DONATION LAND CLAIM (RECORD)
	MEANDER LINE (RECORD)
	PARK LINE (RECORD)
	SECTION LINE (RECORD)
	QUARTER SECTION LINE (RECORD)
	SIXTEENTH SECTION LINE (RECORD)
	STATE LINE (RECORD)
	RANGE LINE (RECORD)
<b>PROFILE LINETYPES</b>	<b>DESCRIPTION</b>
	PROFILE EX. GRND
	PROFILE FINISH GRND
	PROFILE GRID
	PROFILE VERTICAL GRID
	PROFILE EX. GROUND LEFT
	PROFILE EXISTING GROUND RIGHT
	FIBER OPTIC PROFILE (EXISTING)
	GAS PROFILE (EXISTING)
	POWER PROFILE (EXISTING)
	RAILROAD PROFILE (EXISTING)
	SANITARY PROFILE (EXISTING)
	SANITARY PROFILE (PROPOSED)
	STORM PROFILE (EXISTING)
	TELEPHONE PROFILE (EXISTING)
	STORM PROFILE (PROPOSED)
	TV PROFILE (EXISTING)
	UTILITY PROFILE (EXISTING)
	WATER PROFILE (EXISTING)
	WATER PROFILE (PROPOSED)
<b>DEMOLITION</b>	<b>DESCRIPTION</b>
	SURFACE FEATURE OR UTILITY TO BE REMOVED
	SAWCUT
	CLEARING LIMIT
	TREE OR BUSH TO BE REMOVED
<b>GRADING</b>	
	GRADE BREAK
	CATCHLINE
	CUT LINE
	FILL LINE
	SLOPE ARROWS
<b>SECTION/DETAIL CALL-OUTS</b>	
	<b>SECTION CALL-OUTS:</b> (A) REPRESENTS THE SECTION LABEL, (B) INDICATES THE SHEET ON WHICH THE SECTION APPEARS.
	<b>DETAIL CALL-OUTS:</b> (A) REPRESENTS THE DETAIL LABEL, (B) INDICATES THE SHEET ON WHICH THE DETAIL APPEARS.

MISC. SYMBOLS		
EXISTING	PROPOSED	DESCRIPTION
		SOIL BORING
		MONITORING WELL
		TEST WELL
		TEST PIT
		EMBANKMENT
		MAIL BOX
		SIGN
		RIP RAP
		BOULDER
		SHRUB
		TREE (Conifer)*
		TREE (Deciduous)*
		STUMP—PLAN VIEW
		YARD LIGHT
		WELL
		PILE
		ROCKERY
		WHEEL STOP
		SPLASH BLOCK
		GAS METER
		GAS VALVE
		PAD MOUNTED TRANSFORMER
		POWER VAULT
		TRANSMISSION TOWER
		POWER CABINET OR PANEL
		POWER METER
		GUY POLE
		UTILITY POLE
		UTILITY POLE ANCHOR
		TELE RISER
		CABLE RISER
		FIBER OPTIC RISER
		FIBER OPTIC MANHOLE
		TELEPHONE MANHOLE
		TELEPHONE VAULT
		STEAM MANHOLE
		PARKING METER
		POST
		PUMP

SANITARY SEWER SYMBOLS		
EXISTING	PROPOSED	DESCRIPTION
		SAN. SEWER CLEAN OUT
		SAN. SEWER MANHOLE

STORM DRAIN SYMBOLS		
EXISTING	PROPOSED	DESCRIPTION
		STORM DRAIN CB TYPE 1
		STORM DRAIN CB TYPE 2
		STORM DRAIN CB TYPE 2 W/CB LID
		STORM DRAIN WITH OVERFLOW GRATE
		STORM DRAIN CLEAN-OUT
		STORM DOWNSPOUTS

PIPE CALL-OUT	
	<b>PIPE CALL-OUTS:</b> (B) INDICATES THE LENGTH IN LINEAL FEET.

SPOT ELEVATIONS	
	(1) = ELEVATION (2) = DESCRIPTION—SEE DEFINED ABBREVIATIONS


SECTION SHEET LABELS:	
	(A) REPRESENTS THE SHEET ON WHICH THE SECTION BEGINS. (B) REPRESENTS THE SHEET ON WHICH THE SECTION ENDS.


DETAIL SHEET LABELS:	
	(A) REPRESENTS THE SHEET(S) ON WHICH THE DETAIL IS LOCATED. (B) REPRESENTS THE SHEET(S) ON WHICH THE DETAIL IS LOCATED.

EXISTING


PROPOSED


DESCRIPTION







ARV VALVE







GLOBE VALVE, FL



 



BALL CHECK VALVE, FL







BLOW-OFF VALVE







SWING CHECK VALVE, FL







BUTTERFLY VALVE, FL







HOSE BIB/SPIGOT







DOUBLE LEAF CHECK VALVE



 



PLUG VALVE







BALL VALVE







FLOAT VALVE







PINCH VALVE







PRESSURE & VACUUM RELIEF VALVE







VACUUM RELIEF VALVE



 



PRESSURE RELIEF VALVE







PRESSURE REGULATING VALVE (SELF CONTAINED)







BACK PRESSURE REGULATING VALVE (SELF CONTAINED)







IN-LINE SPRING LOADED RELIEF VALVE







CAP/PLUG







GUARD POST







THRUST BLOCK







WATER METER







FIRE DEPARTMENT CONNECTION







WATER VALVE







FIRE HYDRANT







WATER MANHOLE







POST INDICATOR VALVE







11-1/4 BEND, MJ-FL







22-1/2 BEND, MJ-FL







45 BEND, MJ-FL







90 BEND, MJ-FL



 



FLxMJ ADAPTER







COUPLER







BLIND FLANGE







GATE VALVE, FLxMJ







GATE VALVE, MJ







REDUCER, MJxFL







REDUCER, MJ







TEE, FL







TEE, MJ







TEE, MJxFL



 


 
TEE, FLxMJ






CROSS, FL






CROSS, MJ


SURVEY SYMBOLS




BRASS SURFACE MONUMENT




CONCRETE MONUMENT




FOUND REBAR



SET REBAR



MONUMENT IN CASE



TRAVERSE POINT

NOTE TO USER:  
CONTENT SHOWN ON THIS PAGE IS SUBJECT  
TO CHANGE AND MAY DIFFER THROUGHOUT  
THE PLAN SET.

A) REPRESENTS THE PIPE SIZE IN INCHES,  
UTILITY TYPE (C) REPRESENTS THE PIPE  
FEET

DIRECTIONAL ABBREVIATIONS

①

②

N  
NE  
E  
SE  
S  
SW  
W  
NW



=NORTH  
=NORTHEAST  
=EAST  
=SOUTHEAST  
=SOUTH  
=SOUTHWEST  
=WEST  
=NORTHWEST

CTIONS ABOVE

IS THE SECTION LABEL, (B)  
SECTION IS CALLED OUT.

THE DETAIL LABEL, (B)  
DETAIL IS CALLED OUT.

ABBREVIATIONS	
AB	=AS-BUILT (RECORD)
AC	=ASBESTOS CEMENT
AL	=ALIGNMENT
ANC	=ANILITY POLE ANCHOR
APPROX.	=APPROXIMATE
ASPH or AC	=ASPHALT
ASSY	=ASSEMBLY
ASTM	=AMERICAN SOCIETY FOR TESTING & MATERIALS
BUILDING	=BUILDING
BMP	=BEST MANAGEMENT PRACTICE
BVCS	=BEGIN VERTICAL CURVE STATION
BVCE	=BEGIN VERTICAL CURVE ELEVATION
CB	=CATCH BASIN
CK	=CHECK VALVE
C/L, $\odot$	=CENTERLINE
CESCL	=CERTIFIED EROSION SEDIMENT CONTROL LEAD
COL	=COLUMN
CMP	=CORRUGATED METAL PIPE
CMU	=CONCRETE MASONRY UNIT
C.O. or CO	=CLEAN OUT
CONC. c	=CONCRETE
COR	=CORNER
CRSI	=CONCRETE REINFORCING STEEL INSTITUTE
CPP	=CORRUGATED POLYETHYLENE PIPE
CSBC	=CRUSHED SURFACING BASE COURSE
CSTC	=CRUSHED SURFACING TOP COURSE
DCVA	=DOUBLE CHECK VALVE ASSEMBLY
D, DIP	=DUCTILE IRON
DIAM	=DIAMETER
DO	=DISSOLVED OXYGEN
DR	=DIMENSION RATIO
DS	=DOWNSPOUT
EFFL	=EFFLUENT
EGM	=EXISTING GRADE
ELEV. EL	=ELEVATION
EOG	=EDGE OF GRAVEL
EOP	=EDGE OF PAVEMENT
EP	=EXPLORATION PIT
EXIST. EX	=EXISTING
EVCS	=END VERTICAL CURVE STATION
EVCE	=END VERTICAL CURVE ELEVATION
FDC	=FIRE DEPARTMENT CONNECTION
FF	=FINISH FLOOR
FG	=FINISH GRADE
FL	=FLOWLINE OR FLANGE (CONNECTION)
$\bar{L}$	=FLOWLINE
FLC	=FLOWLINE OF CURB
FM	=FOREMAIN
FNC	=FENCE
FRP	=FIBERGLASS REINFORCED PIPE
GB	=GRADE BREAK
GMET	=GAS METER
GP	=GUY POLE
GPM	=GALLONS PER MINUTE
GRVL. G	=GRAVEL
GV	=GATE VALVE
HB	=HOSE BB
HDG	=HOT-DIP GALVANIZED
HDPE	=HIGH DENSITY POLYETHYLENE
HSS	=HOLLOW STRUCTURAL SECTION
HV	=HORIZONTAL-VERTICAL
HWL	=HIGH WATER LEVEL
HYD	=HYDRANT
IBC	=INTERNATIONAL BUILDING CODE
IE	=INVERT ELEVATION
INFO	=INFORMATION
INV	=INVERT
IPS	=IRON PIPE SIZE
LF	=LINEAR FEET
LUM	=LUMINAIRE
LT	=LEFT
MAX	=MAXIMUM
MB	=MAIL BOX
MBR	=MEMBRANE BIO-REACTOR
MC	=MAINTENANCE CLEANING
MFR	=MANUFACTURER
MH	=MANHOLE
MIN	=MINIMUM
MISC	=MISCELLANEOUS
MJ	=MECHANICAL JOINT
MLSS	=MIXED LIQUOR SUSPENDED SOLIDS
MV	=MOVING WELL
NPDES	=NATIONAL POLLUTANT DISCHARGE ELIMINATION SYSTEM
O.C.	=ON CENTER
O.C.E.W	=ON CENTER EACH WAY
OD	=OUTSIDE DIAMETER
OHP	=OVERHEAD POWER
OHT	=OVERHEAD TELEPHONE
OSHA	=OCCUPATIONAL SAFETY AND HEALTH ADMINISTRATION
P	=POINT OF CURVATURE
PCC	=POINT OF CONTINUING CURVATURE
PE	=POLYETHYLENE OR PLAIN END
PIV	=POST INDICATOR VALVE
P/L, $\bar{L}$	=PROPERTY LINE
PLC	=PROGRAMMABLE LOGIC CONTROLLER
PLTR	=PLANTER
POL	=POINT ON LINE
PROP	=PROPOSED
PS	=PUMP STATION
PSI	=POUNDS PER SQUARE INCH
PT	=POINT OF TANGENCY
PVC	=POLYVINYL CHLORIDE
PI	=POINT OF VERTICAL INTERSECTION
PW	=POTABLE WATER
R	=RADIUS
RCK	=ROCK/BOULDER
RET	=RETAINING
REC	=RECORD
REINF	=REINFORCEMENT
REQ'D	=REQUIRED
RI	=RAPID INFILTRATION
RPBA	=REDUCED PRESSURE BACKFLOW ASSEMBLY
RR	=RAILROAD
RT	=RIGHT
R/W or ROW	=RIGHT-OF-WAY
RW	=REUSE WATER
SCADA	=SUPERVISORY CONTROL AND DATA ACQUISITION
SCH	=SCHEDULE
SDCB	=STORM DRAIN CATCH BASIN
SD	=STORM DRAIN
SDMH	=STORM DRAIN MANHOLE
SFH	=SINGLE FAMILY HOUSING
SN	=SIGN
SPD	=STANDARD PROCTOR DENSITY
SPK	=SPIKE
SS	=SANITARY SEWER
SSCO	=SANITARY SEWER CLEAN-OUT
SSMH	=SANITARY SEWER MANHOLE
SST	=STAINLESS STEEL
STA	=STATION
STEP	=SEPTIC TANK EFFLUENT PUMP
S/W	=SIDEWALK
SYMM	=SYMMETRY/SYMMETRICAL
TBC	=TOP BACK OF CURB
TBD	=TO BE DETERMINED
TBM	=TEMPORARY BENCH MARK
T.O.W.	=TOP OF WALL
TYP	=TYPICAL
UNKN	=UNKNOWN
UP	=UTILITY POLE
VAC	=VACATED
VC	=VERTICAL CURVE
VEG	=VEGETATION
VFD	=VARIABLE FREQUENCY DRIVE
WA	=WATER
WAS	=WASTE ACTIVATED SLUDGE
WL	=WATERLINE
WM	=WATER METER
WS	=WATER SURFACE
WSDOT	=WASHINGTON STATE DEPARTMENT OF TRANSPORTATION
WV	=WASHING VALVE
YD	=YARD DRAIN
YL	=YARD LIGHT


SHEET <b>C0.2</b>	DATE 5-31-23	CITY OF FERNDALE	DESIGNED BY		
	SCALE AS SHOWN		DRAWN BY		
PAGE 2 OF 25	JOB NUMBER 2021-091	FERNDALE	JCS	WASHINGTON WATER SYSTEM EMERGENCY INTERTIE	WILSONENGINEERING.COM
		LEGEND & ABBREVIATIONS 2021	CHECKED BY AWL		

PLOT SETTINGS: WE AutocAD PDF (General Documentation).pc3, WILSON 11X17, Portrait, 1:2, WE APWA\_UNSCREENED.ctb  
W:\2021\2021-091 FERNDAL WATER MAIN INTERTIE\DWG\AS-BUILT\TAB V2019\_2021-091 C1.1 WAC.DWG - 5/31/2023 11:18 AM - Jeff Smith

# CITY OF FERNDALE

## WATER SYSTEM EMERGENCY INTERTIE W.A.C. 332-130 COMPLIANCE SHEET

### SECTIONAL INDEX DATA

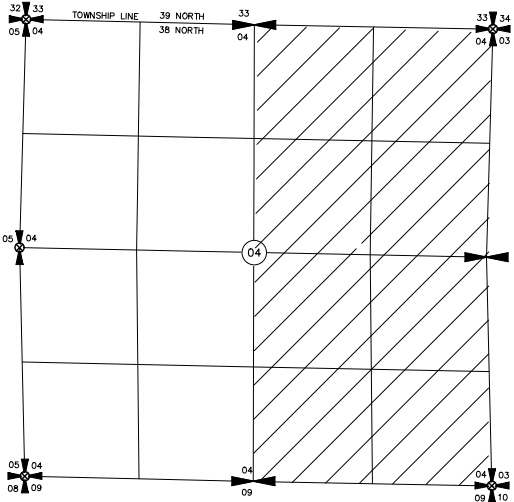

NE QTR & SE QTR, SEC. 04, TWP 38 NORTH, RGE 2 EAST, W.M.

### NOTICE TO USER

EFFECTIVE JANUARY 13, 2019, ALL TOPOGRAPHIC MAPS PREPARED BY A LICENSED SURVEYOR IN THE STATE OF WASHINGTON, AND SUBJECT TO THE LICENSURE AND PRACTICE REQUIREMENTS ESTABLISHED BY THE WASHINGTON STATE BOARD OF REGISTRATION FOR ENGINEERS AND LAND SURVEYORS, MUST INCLUDE THE DESCRIPTIVE NOTES AND METADATA ENUMERATED UNDER W.A.C 332-130-145 AND ITS APPURTENANT SECTIONS OF 332-130. THIS EXHIBIT IS INTENDED TO ADDRESS THE STATUTORY REQUIREMENTS STIPULATED BY THIS W.A.C DIRECTIVE.

### W.A.C. 332-130-145 REQUIRED DATA

THIS SURVEY WAS PREPARED UNDER THE DIRECT SUPERVISION OF:

PAUL J. DARROW, WA PLS #50697  
SR. PROJECT SURVEYOR  
WILSON ENGINEERING LLC  
805 DUPONT STREET, SUITE 7  
BELLINGHAM, WA 98225  
360-733-6100 (EXT. 243)  
pdarrow@wilsonengineering.com

- BASIS OF ELEVATIONS: ELEVATION VALUES AND CONTOURS DEPICTED ON THIS SURVEY ARE BASED UPON HOLDING AS FIXED THE CITY OF FERNDALE NGVD BENCHMARK MONUMENT FERN 15, HAVING AN ELEVATION OF 89.31'.
- PURPOSE OF SURVEY: WILSON ENGINEERING PERFORMED THIS SURVEY DURING JUNE, JULY, AND SEPTEMBER OF 2021, AT THE REQUEST OF THE CITY OF FERNDALE PURSUANT TO WATERMAIN DESIGN.
- SOURCE OF CONTOURS: ONE-FOOT CONTOURS DEPICTED ON THIS SURVEY ARE BASED ON DIRECT FIELD OBSERVATIONS USING A TRIMBLE S-7 ROBOTIC TOTAL STATION AND UAV DRONE PICTOMETRY.
- ELEVATIONS WERE ESTABLISHED ON SITE USING REDUNDANT GPS TIES TO THE FERNDALE CONTROL NETWORK. SITE BENCHMARK IS WSE#100, SHOWN HEREON. ELEVATION=181.51'.
- ELEVATION AND/OR CONTOUR ACCURACY: CONTOURS DEPICTED ON THE FACE OF THIS SURVEY, IF OBSERVED RELATIVE TO THE CONTROL POINTS SPECIFICALLY ENUMERATED IN THE ACCOMPANYING CONTROL TABLE, WILL BE, IN FACT, WITHIN ONE-HALF OF THE MINOR-CONTOUR INTERVAL DEPICTED HEREON. SPECIFIC ELEVATIONS DEPICTED HEREON, IF ANY, ARE EXPECTED TO BE WITHIN ONE INTEGRAL VALUE OF THE FINAL DEPICTED SIGNIFICANT FIGURE. FURTHERMORE, 90% OF ELEVATIONS EXPRESSED TO THE TENTH-FOOT, SHOULD BE WITHIN 0.1 FEET OF THAT VALUE, IF OBSERVED RELATIVE TO THE SURVEY CONTROL SPECIFICALLY ENUMERATED IN THE ACCOMPANYING CONTROL TABLE. IF OFF-SITE CONTROL IS EMPLOYED, EVEN CONTROL PURPORTING TO BE ON THE SAME DATUM OR BASED ON THE SAME OFF-SITE BENCHMARK, THEN NO ABSOLUTE STATEMENT REGARDING THE ACCURACY OF THE DEPICTED POINTS CAN BE MADE, AND VALUES SO OBSERVED ARE OUTSIDE OF THIS SURVEY'S AUTHORITY OR INTEREST.
- STATEMENT OF USE: AS NOTED IN SECTION 2.B, THIS SURVEY WAS PREPARED FOR THE SPECIFIC PURPOSE OF WATERMAIN DESIGN. IN THE COURSE OF PREPARING THIS SURVEY, PURSUANT TO THIS PURPOSE, ANCILLARY DATA NECESSARY TO ACCOMPLISH THIS SURVEYS INTENDED PURPOSE MAY HAVE BEEN CAPTURED. IN THE CASE OF THIS SURVEY PARCEL BOUNDARIES ARE DEPICTED, BUT THE DEPICTION OF SAME SHOULD NOT BE CONSIDERED AUTHORITATIVE AND THIS TOPOGRAPHIC SURVEY DOES NOT CONSTITUTE A RECORD OF SURVEY.
- SOURCE OF CONTROLLING BOUNDARY INFORMATION: THE OWNERSHIP BOUNDARIES DEPICTED ON THIS SURVEY ARE BASED UPON THE DOCUMENTS ENUMERATED IN THE ACCOMPANYING "REFERENCE DOCUMENTS". BEARINGS HAVE BEEN ROTATED FROM THE RECORD VALUES IF NECESSARY TO COHERE TO THE CITY OF FERNDALE CONTROL NETWORK.
- SOURCE OF DEPICTED UTILITY INFORMATION: UTILITY LINES DEPICTED ON THIS SURVEY ARE BASED UPON PAINT MARKS SET BY FRANCHISE UTILITY OWNERS RESPONDING TO WASHINGTON ONE-CALL DIG TICKET #550004484 ISSUED ON SEPTEMBER 13, 2021 AND PRIVATE UTILITY LOCATES PERFORMED BY APPLIED PROFESSIONAL SERVICES. THE FOLLOWING UTILITY PROVIDERS ARE IDENTIFIED AS HAVING FACILITIES IN THE AREA: CASCADE NATURAL GAS, CITY OF FERNDALE, CITY OF BELLINGHAM, COMCAST, CENTURYLINK, ZIPLY FIBER, BP/OLYMPIC PIPELINE, AND PUGET SOUND ENERGY.
- ACCURACY OF DEPICTED UTILITY INFORMATION: WILSON ENGINEERING DOES NOT PROVIDE FOR-HIRE UTILITY LOCATION AND/OR MARKING SERVICES, AND CAN NOT INDEPENDENTLY ASCERTAIN THE ACCURACY OF ANY DEPICTED UTILITY THAT WAS NOT DIRECTLY OBSERVED IN THE COURSE OF THIS SURVEY.
- STATEMENT OF LIMITATIONS REGARDING UTILITY-DEPICTION ACCURACY: USER HAS BEEN NOTIFIED THAT WILSON CAN NOT, AND DOES NOT, GUARANTEE THE ACCURACY, AT ANY LEVEL, OF DEPICTED UTILITIES BASED ON THIRD-PARTY PAINT MARKS OR RECORD INFORMATION.

### SURVEYOR'S CERTIFICATE

I HEREBY CERTIFY THAT I AM A LICENSED LAND SURVEYOR IN THE STATE OF WASHINGTON, THAT THIS MAP IS BASED ON AN ACTUAL FIELD SURVEY DONE BY ME OR UNDER MY DIRECT SUPERVISION AND THAT ALL DATA SHOWN HEREON ACTUALLY EXISTS IN THE LOCATIONS SHOWN AT THE TIME OF THIS SURVEY. THIS EXISTING CONDITIONS MAP WAS DONE AT THE REQUEST OF CITY OF FERNDALE IN 2021.

PAUL JONATHAN DARROW, P.L.S. NO. 50697

DATE

### ON-SITE SURVEY CONTROL TABLE

POINT #	NORTHING	EASTING	ELEVATION	DESCRIPTION
100	663438.23	1225693.31	181.51	ASPHALT SURFACE MONUMENT
101	665577.42	1225677.30	96.30	ASPHALT SURFACE MONUMENT
102	663976.02	1225700.53	155.22	REBAR & PLASTIC CAP
103	664468.42	1225697.89	126.45	REBAR & PLASTIC CAP
104	664817.32	1225675.27	111.45	MAG NAIL
105	665378.69	1225670.98	104.51	REBAR & PLASTIC CAP
106	666015.10	1225704.04	80.59	REBAR & PLASTIC CAP
107	665577.42	1225677.31	96.28	ASPHALT SURFACE MONUMENT
108	666015.10	1225704.02	80.56	REBAR & PLASTIC CAP
109	666655.71	1225682.22	70.41	MAG NAIL
110	667671.92	1225729.49	65.49	REBAR & PLASTIC CAP
FERN 12	673760.11	1222546.51	31.27	BRASS MONUMENT
FERN 14	668540.03	1215874.62	11.60	BRASS MONUMENT
FERN 15	667222.30	1226895.75	89.31	BRASS MONUMENT

### CONTROL NOTES

#### HORIZONTAL DATUM:

NAD83/91

**BASIS OF COORDINATES:** COORDINATION AND MENSURATION ARE LOCAL GROUND VALUES, BASED UPON HOLDING THE PUBLISHED POSITION FOR THE CITY OF FERNDALE MONUMENT FERN 15, SAID MONUMENT HAS THE FOLLOWING PUBLISHED POSITION:

NORTHING = 667,222.30 USFT  
EASTING = 1,226,895.75 USFT


**BASIS OF BEARINGS:** BEARINGS ARE BASED UPON HOLDING THE PUBLISHED POSITIONS OF CITY OF FERNDALE MONUMENTS #15 AND #12 PER THE DATA SHEETS THEREOF.  
THE DERIVED INVERSE BETWEEN SAID MONUMENTS # 15 AND # 12 IS **NORTH 33° 38' 00" WEST**, AT A DISTANCE OF **7852.33 USFT**. THE PUBLISHED POSITION FOR THE MONUMENT # 12 IS:

NORTHING = 673,760.11 USFT  
EASTING = 1,222,546.51 USFT

#### VERTICAL DATUM:

NGVD29 CITY OF FERNDALE

### NAD 83/91 SURVEY CONTROL DIAGRAM N.T.S.

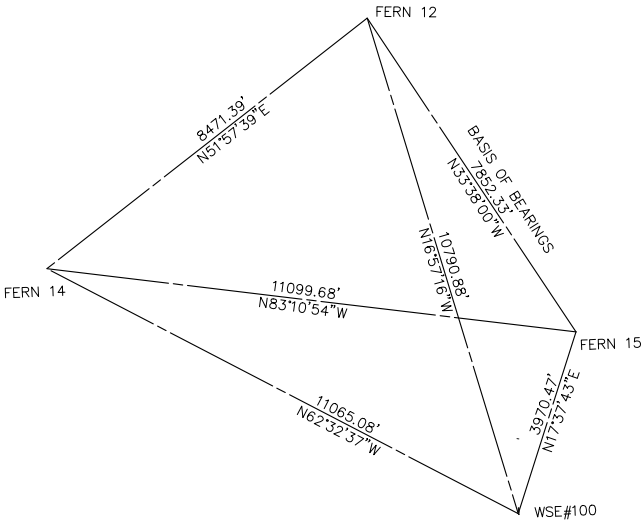

DESIGNED BY: BMS  
DRAWN BY: JGS  
CHECKED BY: AWL

CITY OF FERNDALE

WASHINGTON  
FERNDAL  
WATER SYSTEM EMERGENCY INTERTIE



W.A.C. 332-130 COMPLIANCE SHEET

DATE: 5-31-23  
SCALE: AS SHOWN  
JOB NUMBER: 2021-091

SHEET: C1.1  
PAGE: 3 OF 25



RECORD DRAWINGS

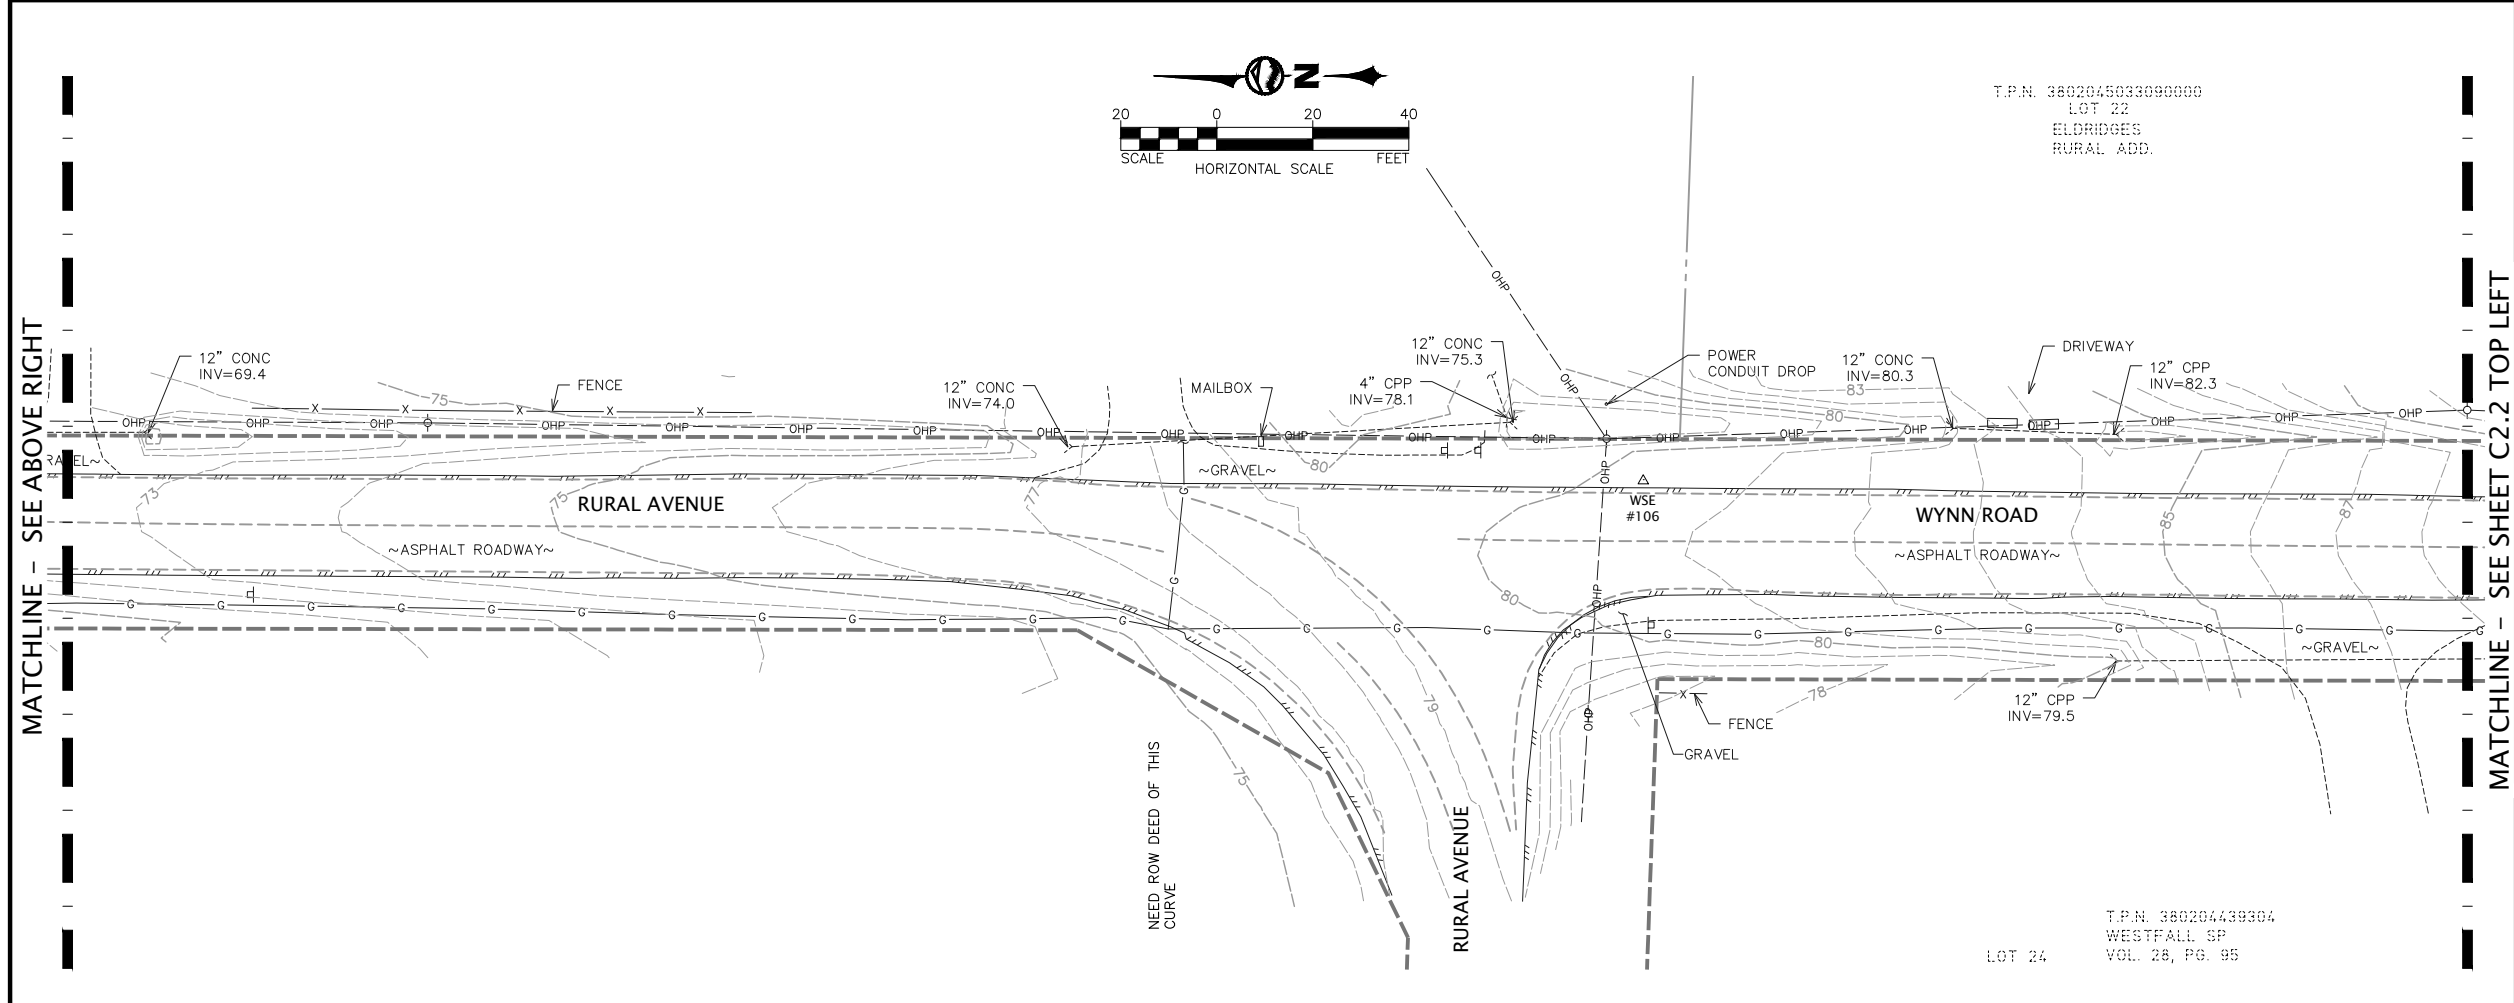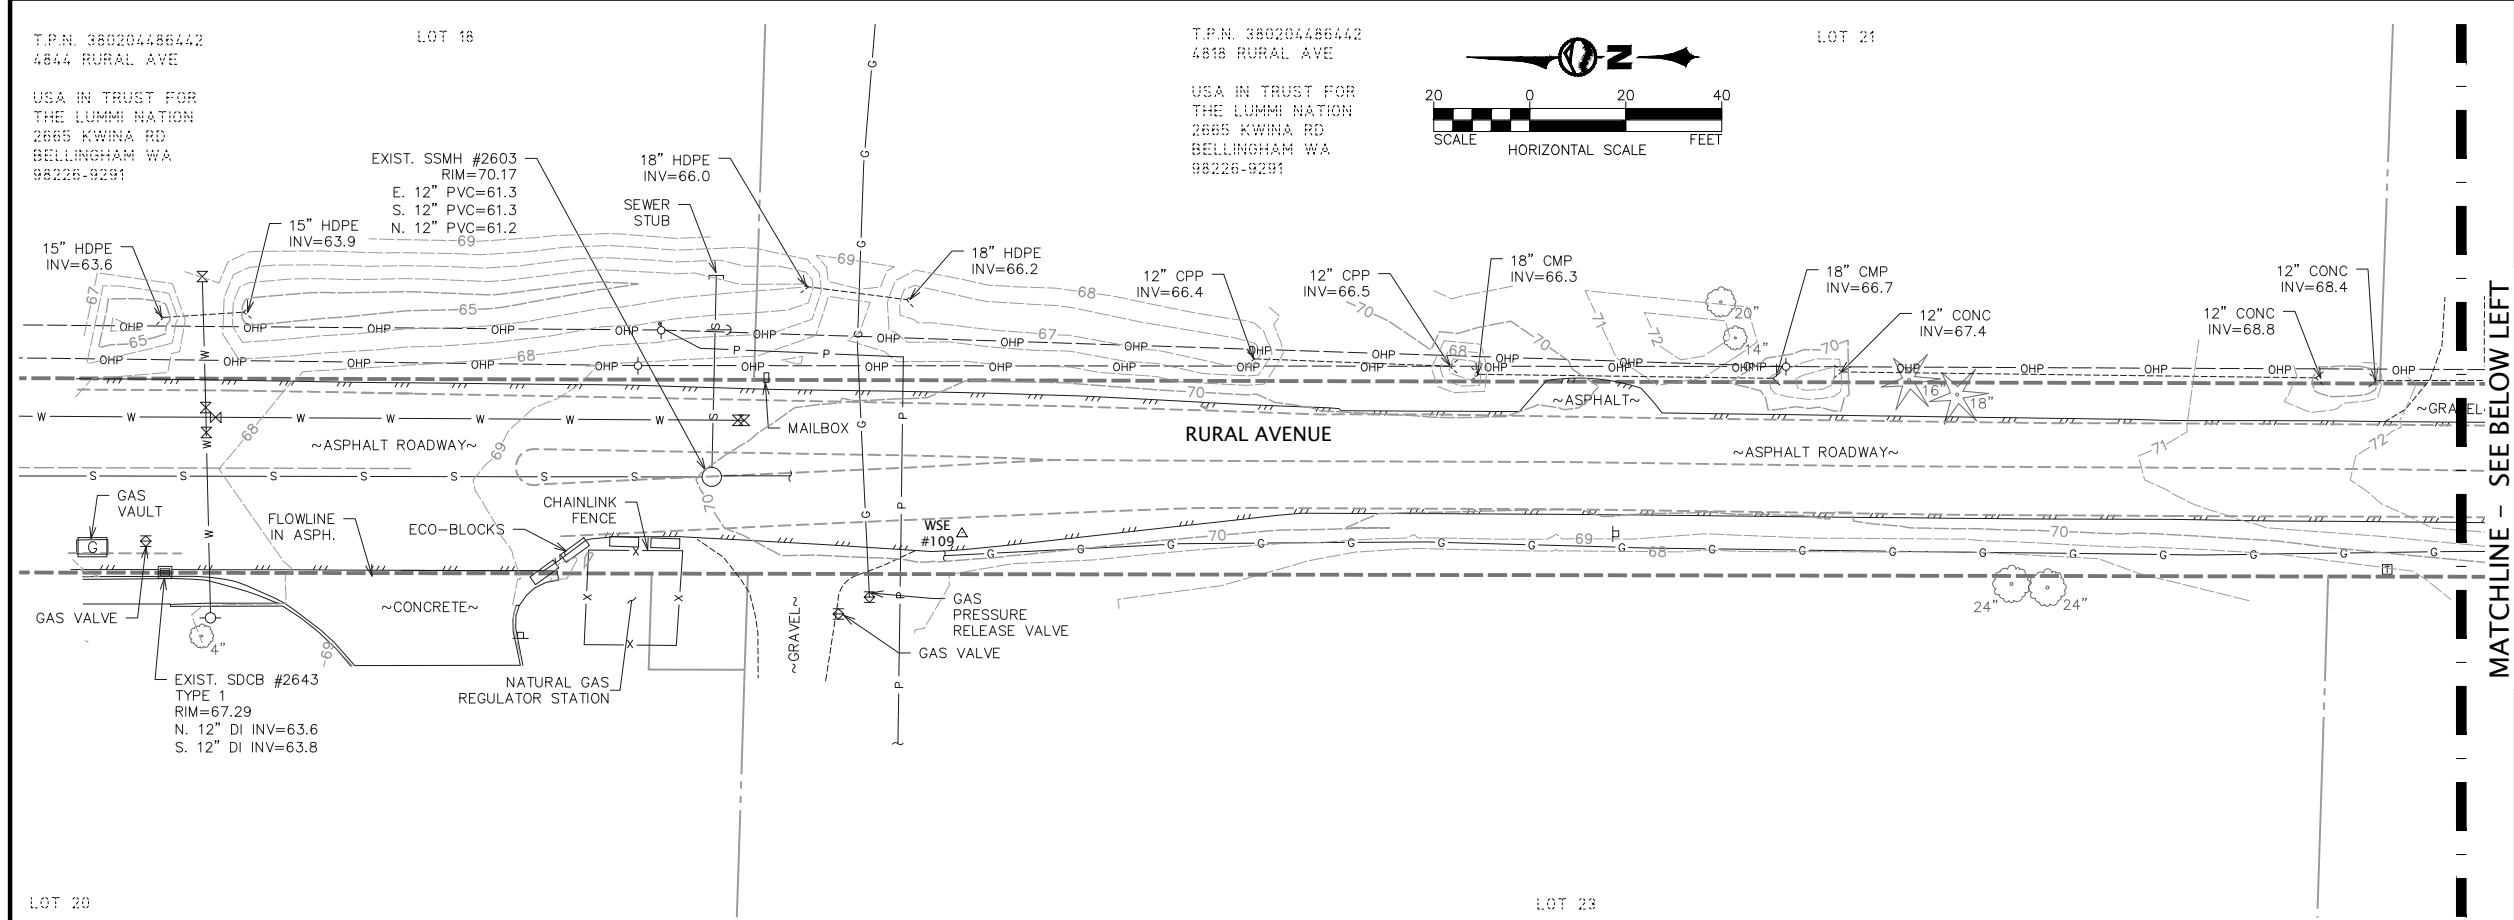

NO.	REVISIONS	BY	DATE



DESIGNED BY	
BMS	
DRAWN BY	
JGS	
CHECKED BY	
AWL	

CITY OF FERNDALE

WATER SYSTEM EMERGENCY INTERTIE

## EXISTING CONDITIONS (1)

SHEET	C2.1	DATE	5-31-23
		SCALE	AS SHOWN
PAGE	4 OF 25	JOB NUMBER	2021-091



**811** Call 811  
two business days  
before you dig

---

**RECORD DRAWINGS**



PLOT SETTINGS: WE AutoCAD PDF (General Documentation).pc3, WILSON 11X17, Portrait, 1:2, WE APWA\_UNSCREENED.ctb  
W:\2021\2021-091 FERDALE WATER MAIN INTERTIE.DWG AS-BUILT\TAB V2019\_2021-091 C2.1-C2.4 EXISTING CONDITIONS.DWG - 5/31/2023 11:19 AM - Jeff Smith

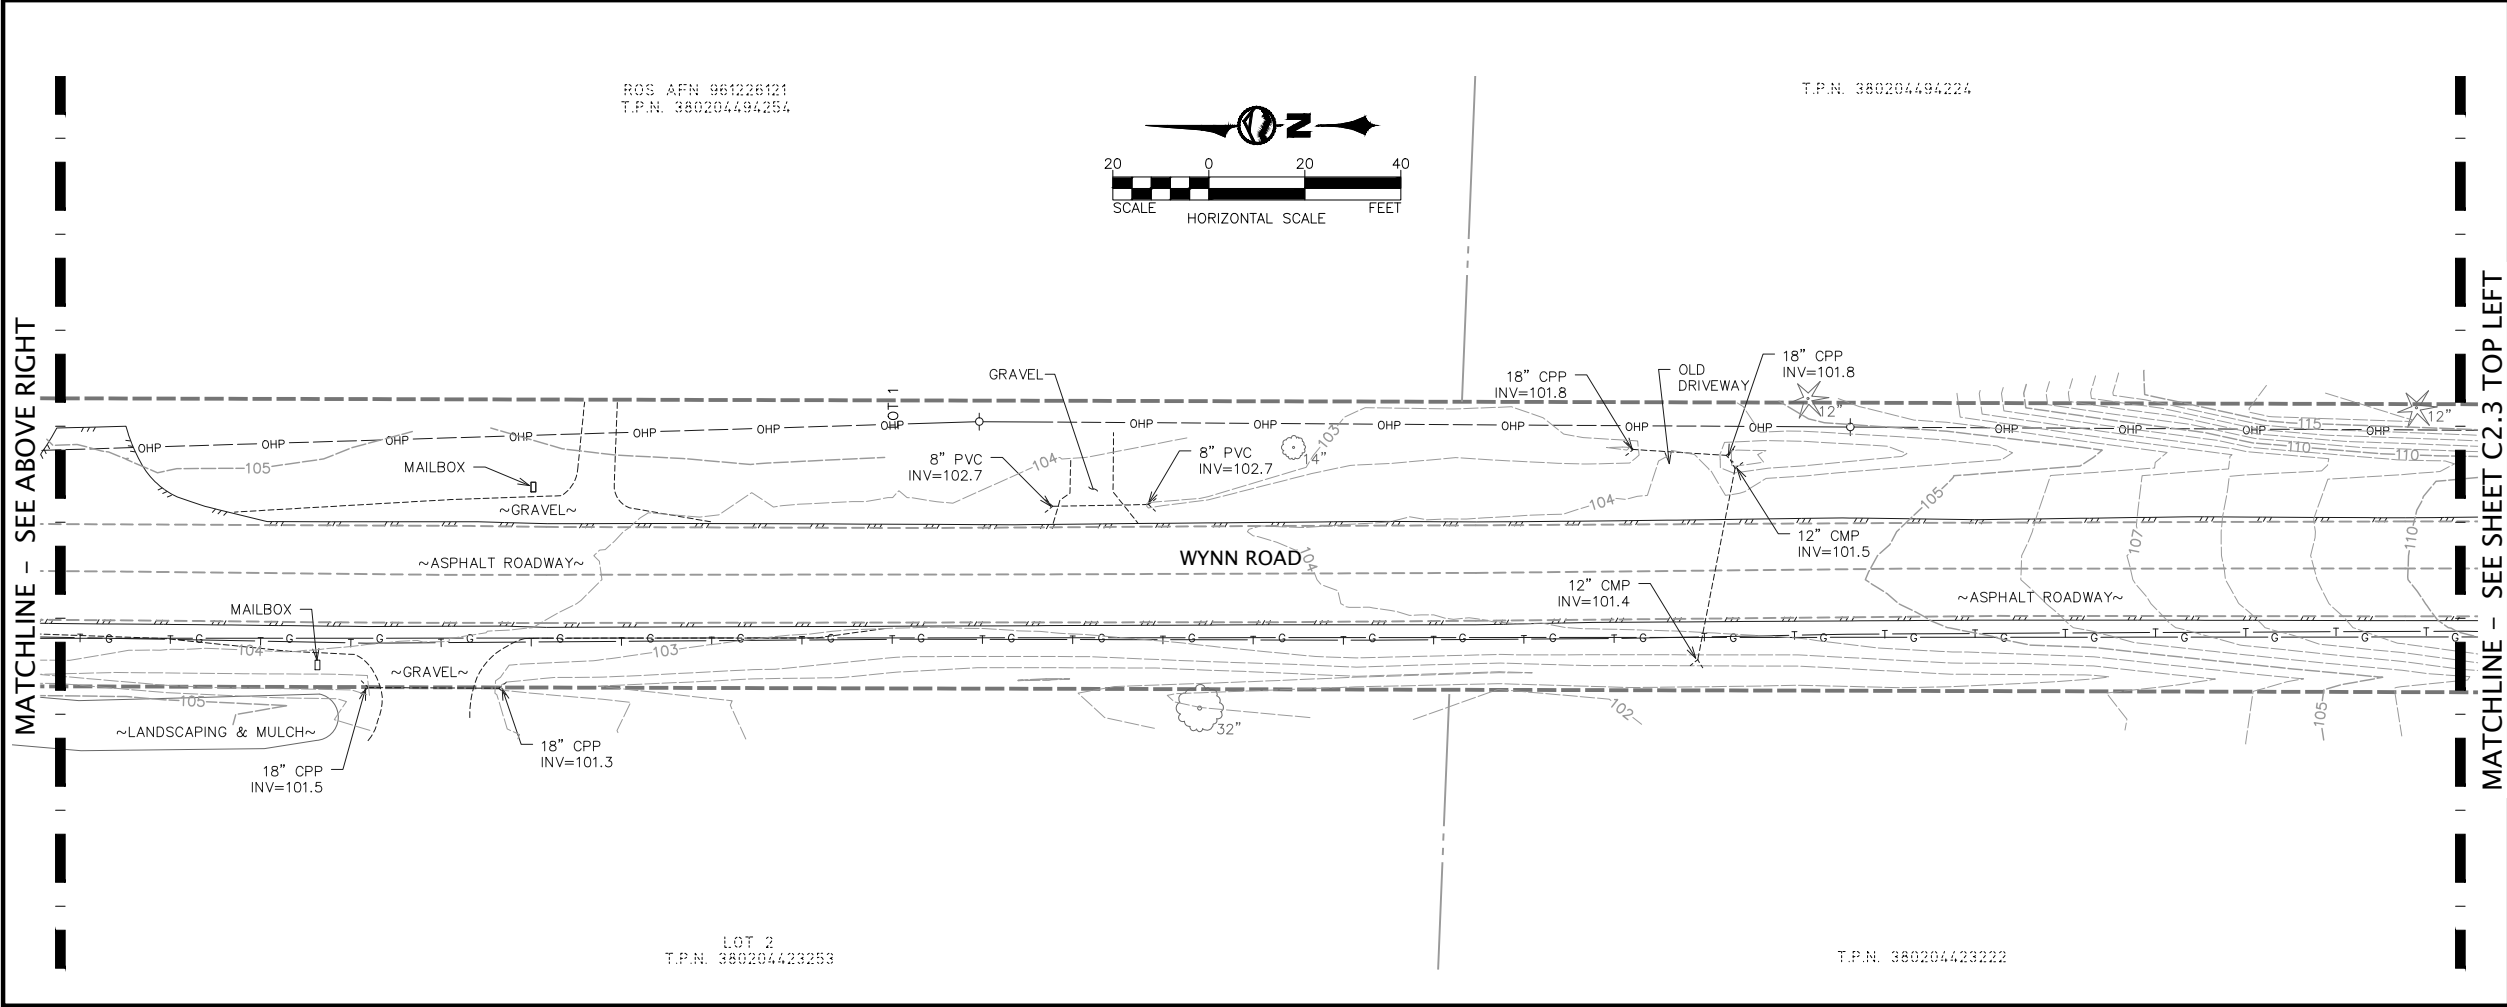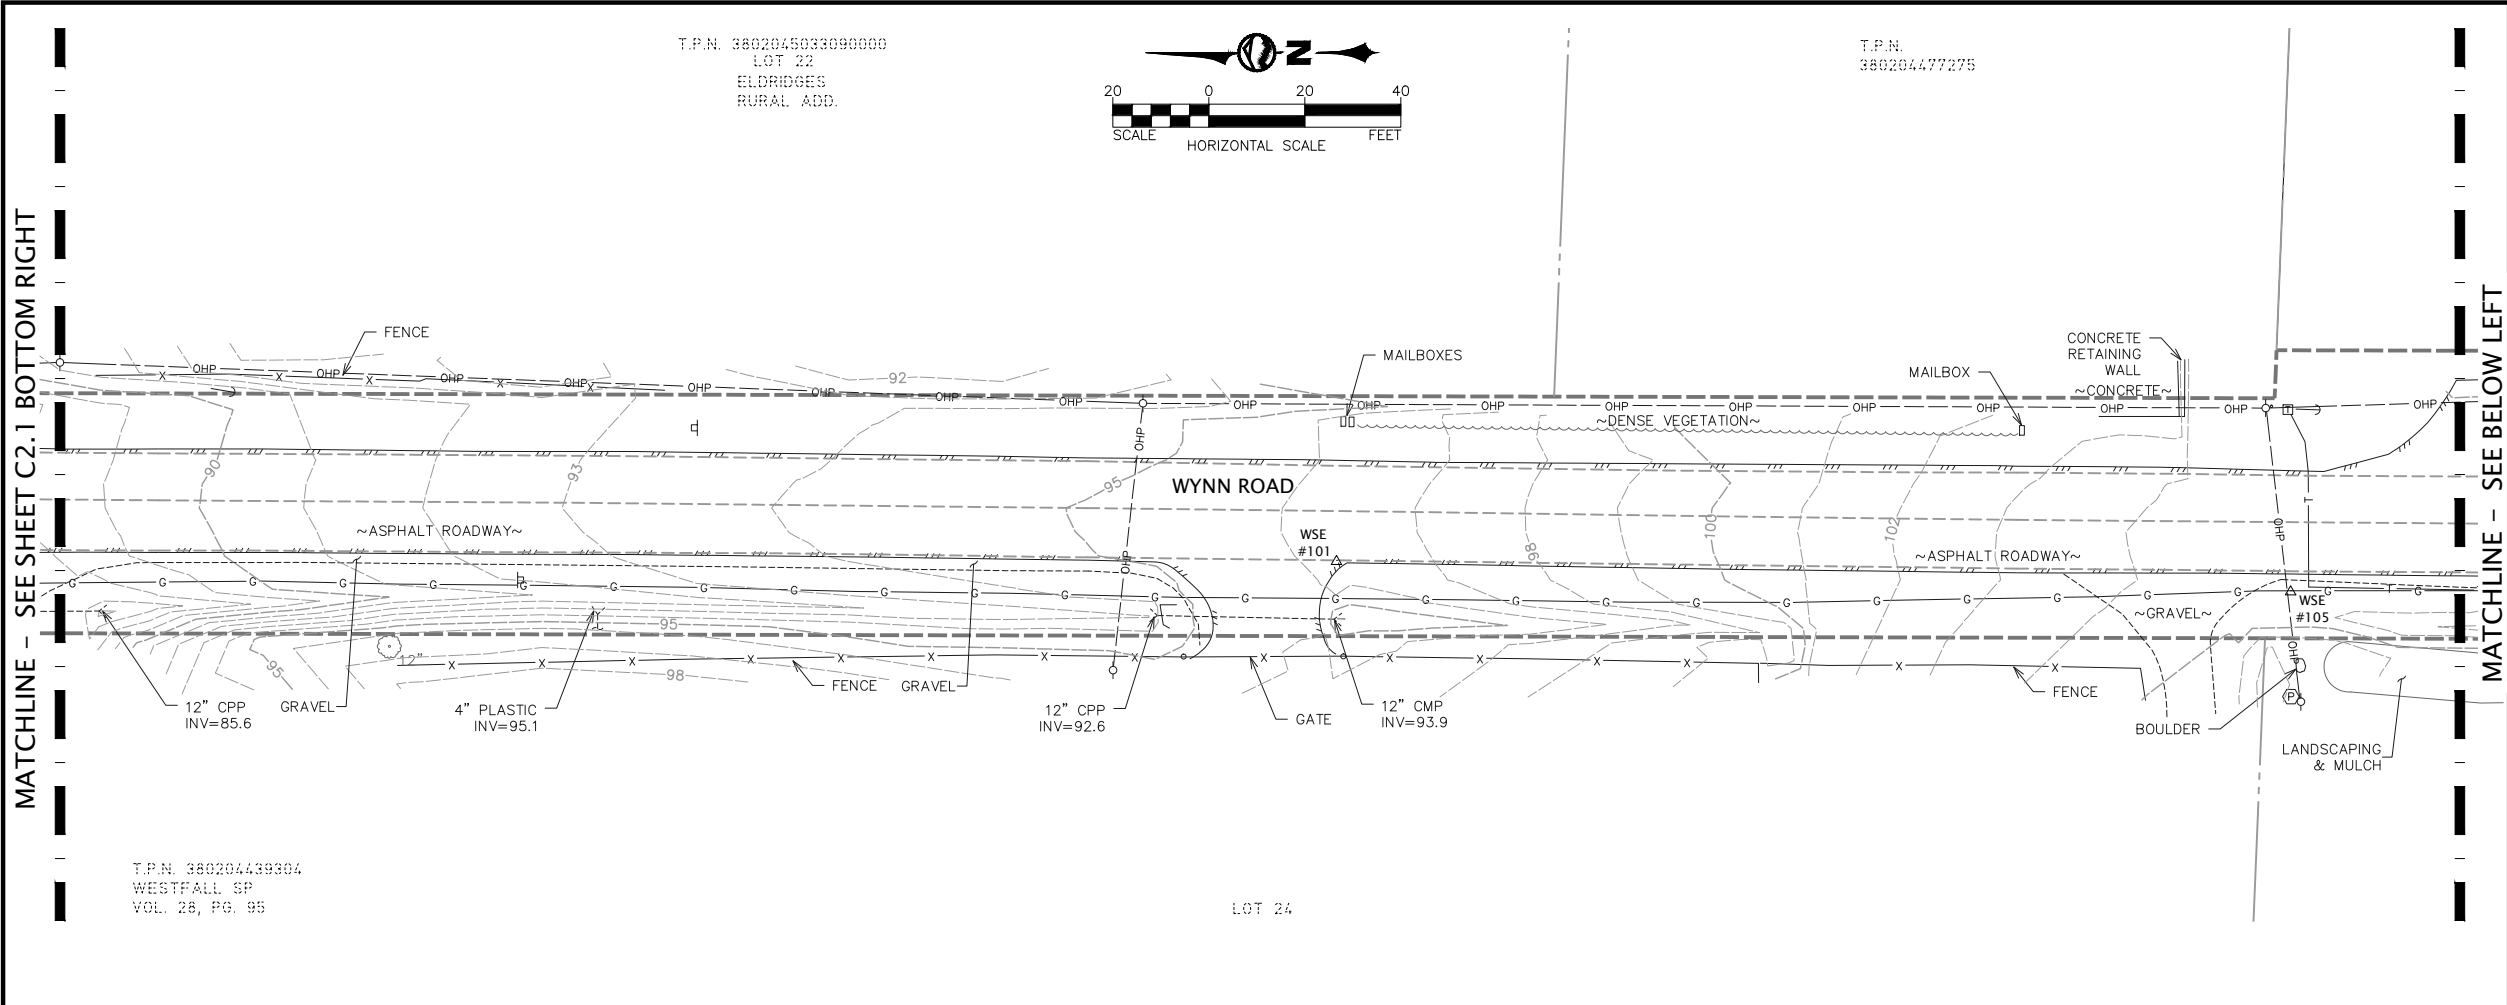

NO.		REVISIONS		BY	DATE



811 Call 811  
two business days  
before you dig

RECORD DRAWINGS

SHEET	DATE	SCALE	AS SHOWN	JOB NUMBER
C2.2	5-31-23	AS SHOWN	AS SHOWN	2021-091

CITY OF FERDALE	
WATER SYSTEM EMERGENCY INTERTIE	
FERDALE	WASHINGTON
EXISTING CONDITIONS (2)	

DESIGNED BY	BMS
DRAWN BY	JGS
CHECKED BY	AWL

 <b>WILSON</b> ENGINEERING	
WILSONENGINEERING.COM	
	

DESIGNED BY	BMS
DRAWN BY	JGS
CHECKED BY	AWL

CITY OF FERDALE	
WATER SYSTEM EMERGENCY INTERTIE	
FERDALE	WASHINGTON
EXISTING CONDITIONS (2)	



SHEET	DATE	SCALE	AS SHOWN	JOB NUMBER
C2.2	5-31-23	AS SHOWN	AS SHOWN	2021-091

5 OF 25	
---------	--

PLOT SETTINGS: WE AutoCAD PDF (General Documentation).pc3, WILSON 11X17, Portrait, 1:2, WE APWA\_UNSCREENED.ctb  
W:\2021\2021-091 FERDALE WATER MAIN INTERTIE.DWG AS-BUILT\TAB V2019\_2021-091 C2.1-C2.4 EXISTING CONDITIONS.DWG - 5/31/2023 11:19 AM - Jeff Smith

MATCHLINE - SEE ABOVE RIGHT

MATCHLINE - SEE SHEET C2.2 BOTTOM RIGHT

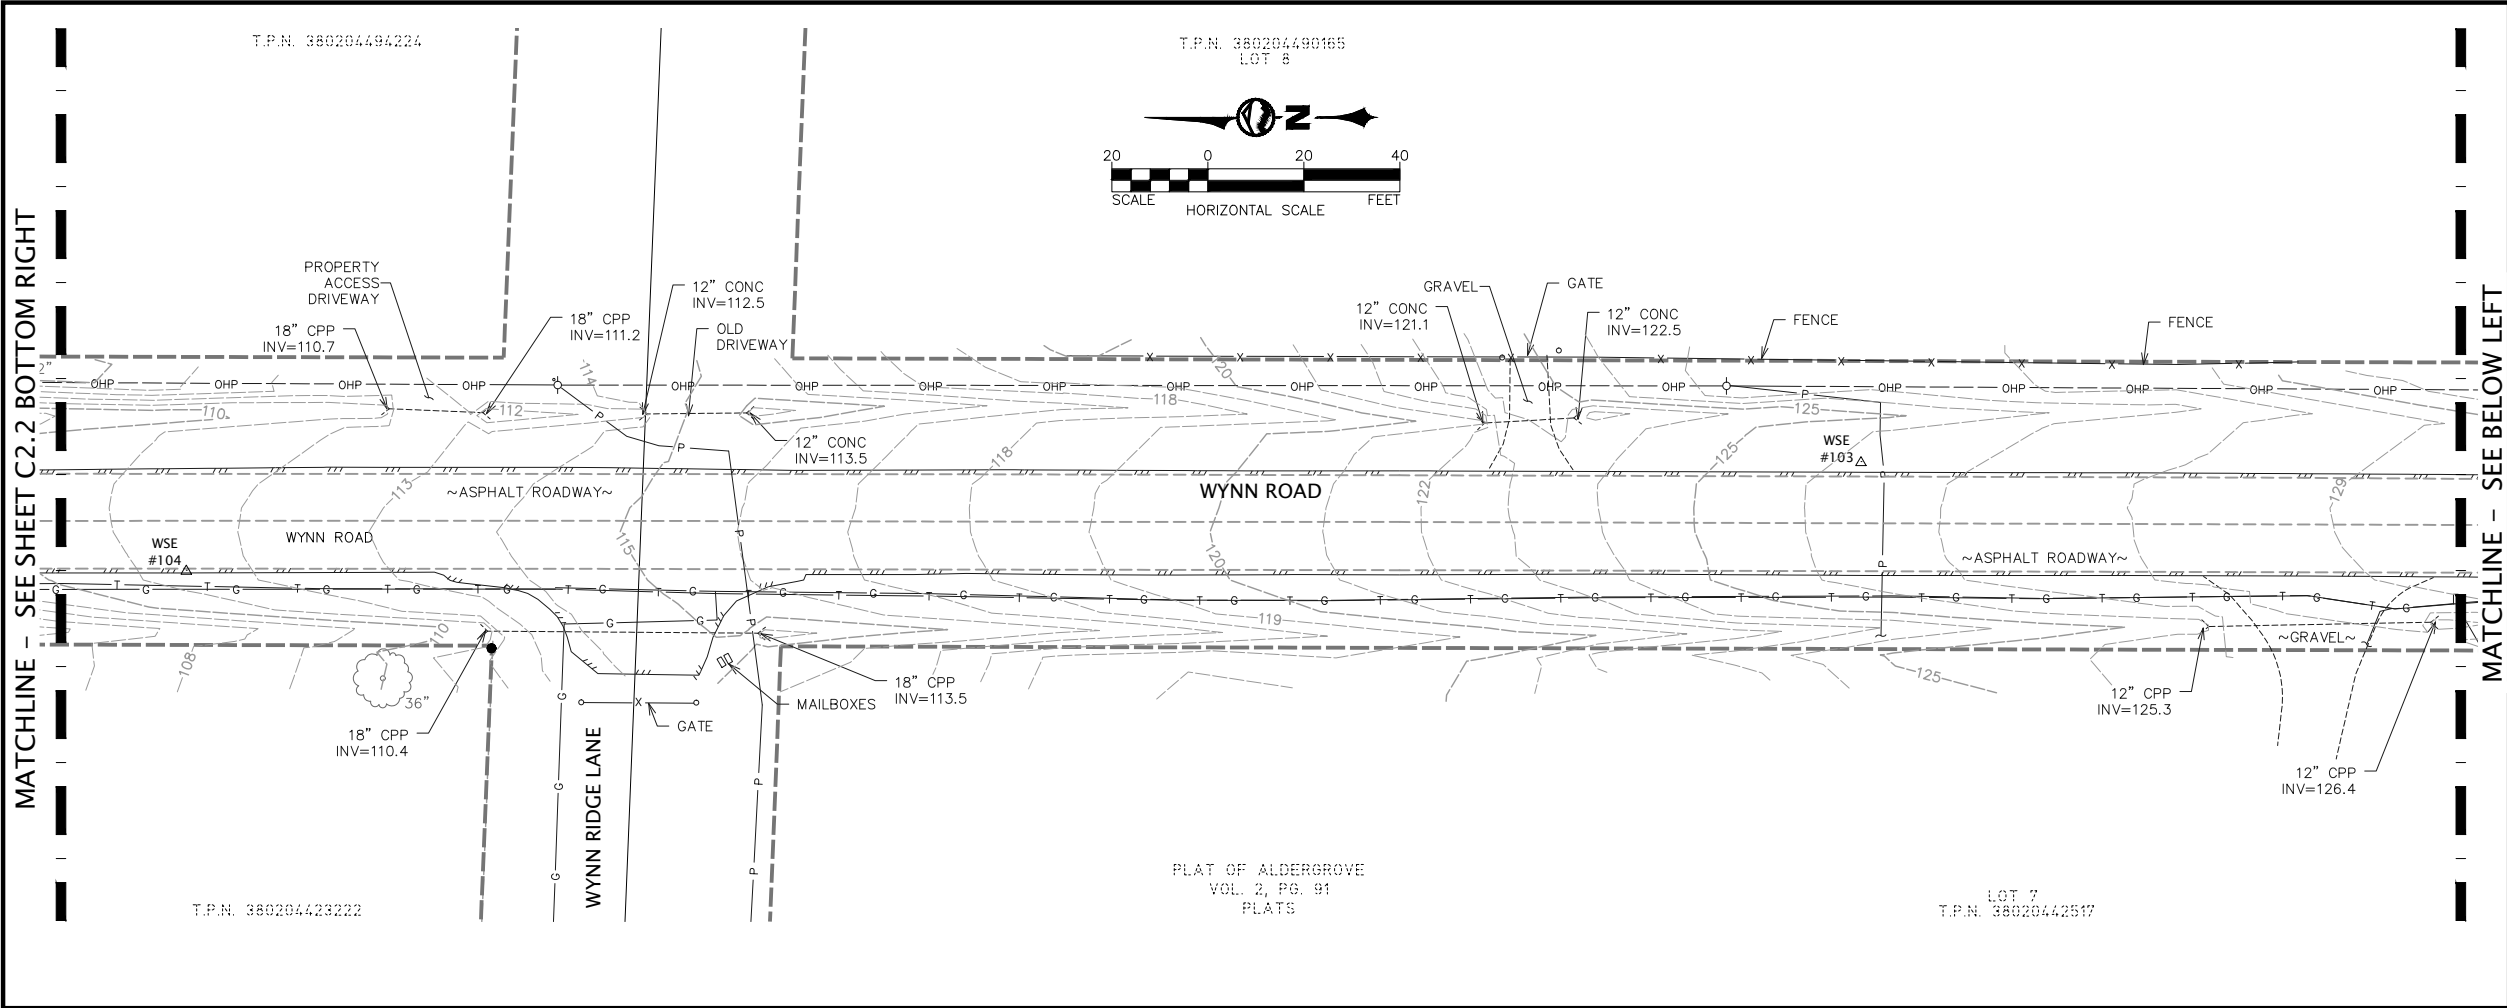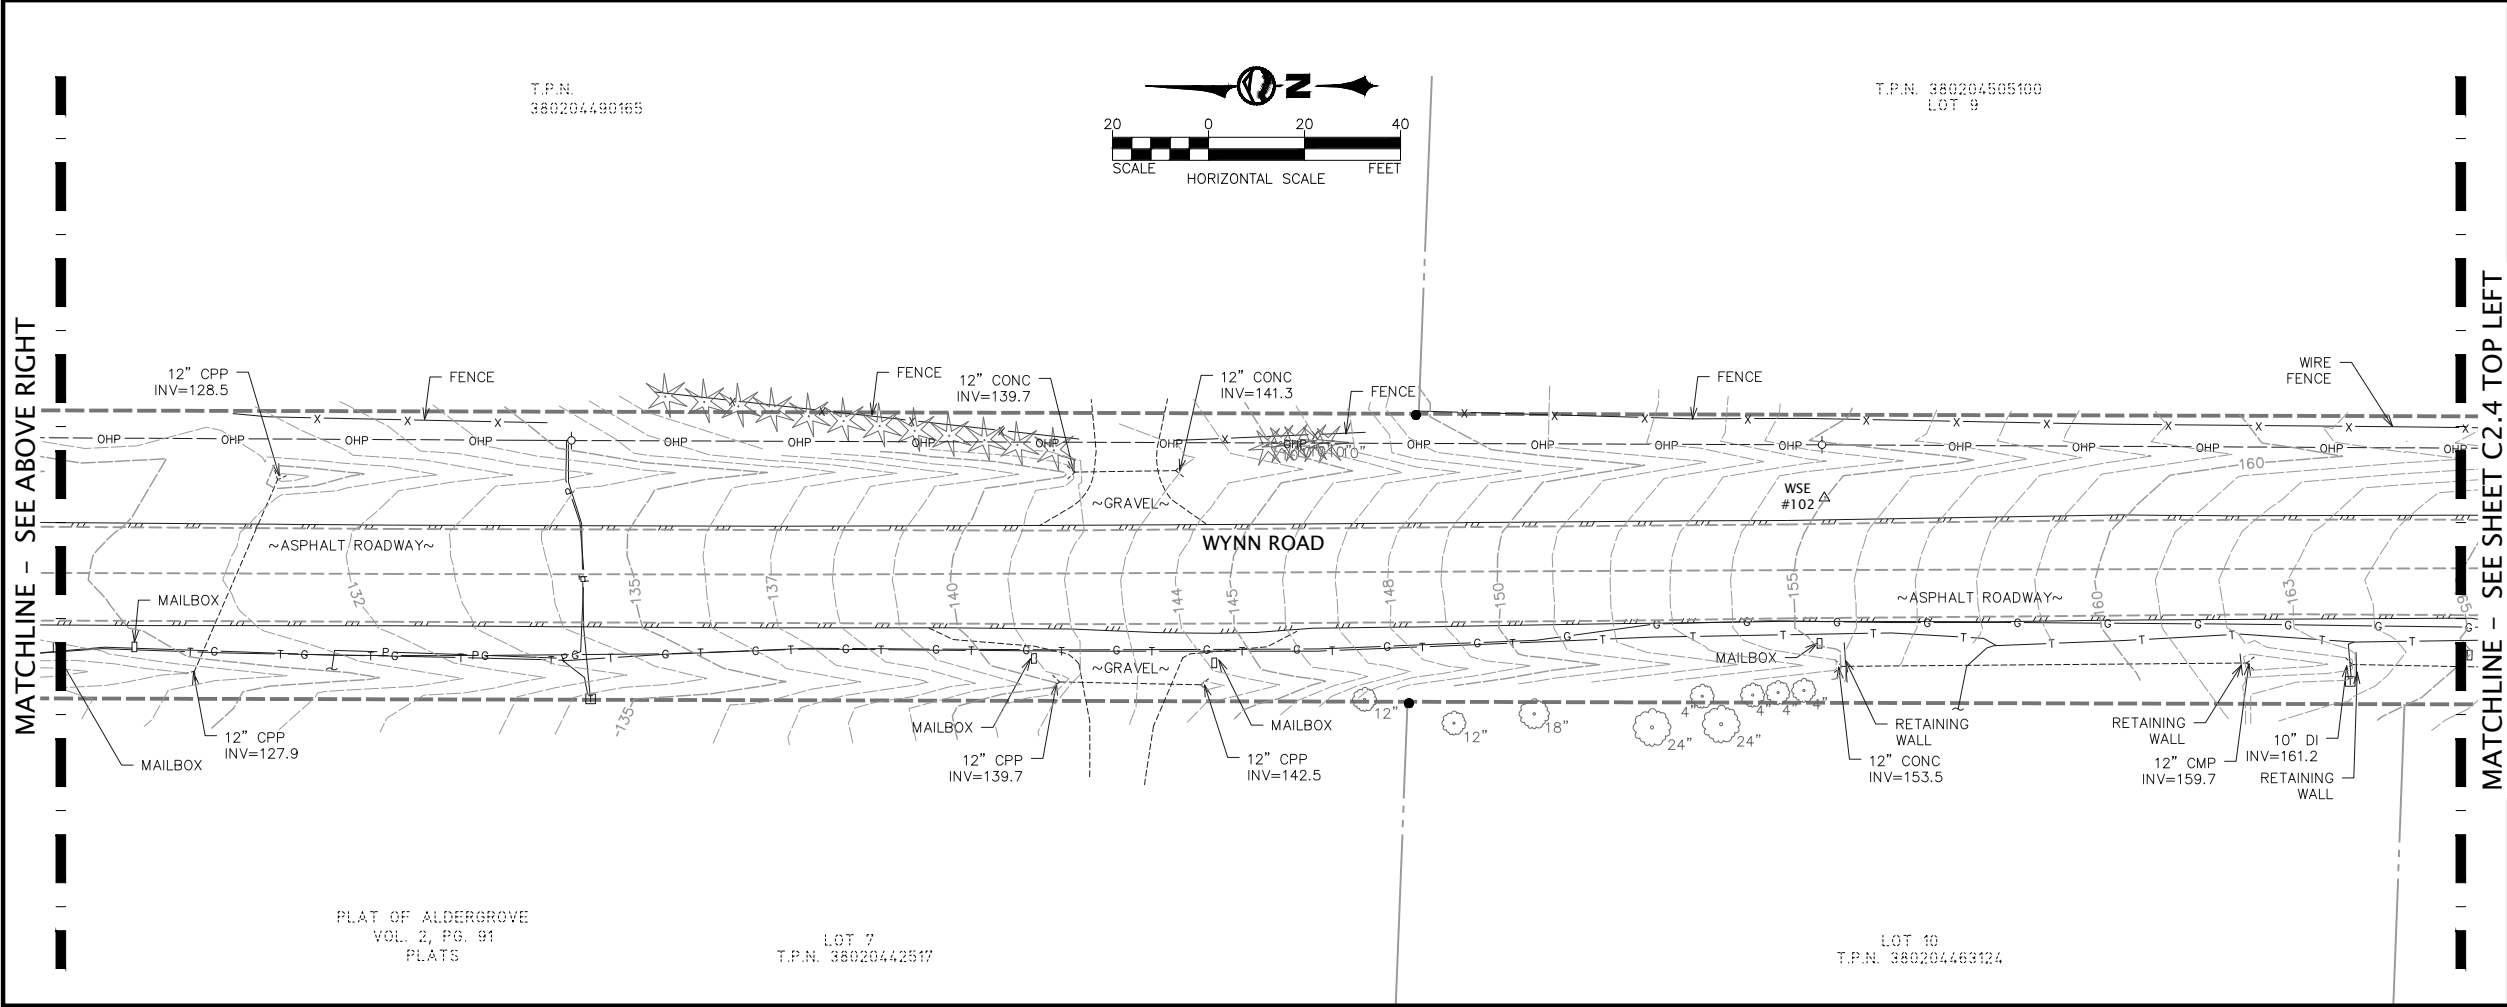

MATCHLINE - SEE SHEET C2.4 TOP LEFT

MATCHLINE - SEE BELOW LEFT




Call 811  
two business days  
before you dig


RECORD DRAWINGS

NO.		REVISIONS		BY	DATE

CITY OF FERDALE		C2.3		DATE 5-31-23	SCALE AS SHOWN
WATER SYSTEM EMERGENCY INTERTIE		LOT 9			
EXISTING CONDITIONS (3)		LOT 7			
FERDALE		WASHINGTON		DESIGNED BY BMS	JOB NUMBER 2021-091
				DRAWN BY JGS	
				CHECKED BY AWL	







**WILSON**  
ENGINEERING



JEFF SMITH  
PROFESSIONAL ENGINEER  
STATE OF WASHINGTON  
LICENSE # 16015

WILSONENGINEERING.COM

PLOT SETTINGS: WE AutoCAD PDF (General Documentation).pc3, WILSON 11X17, Portrait, 1:2, WE APWA\_UNSCREENED.ctb  
W:\2021\2021-091 FERNDAL WATER MAIN INTERTIE.DWG AS-BUILT\TAB V2019\_2021-091 C2.1-C2.4 EXISTING CONDITIONS.DWG - 5/31/2023 11:19 AM - Jeff Smith

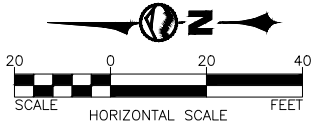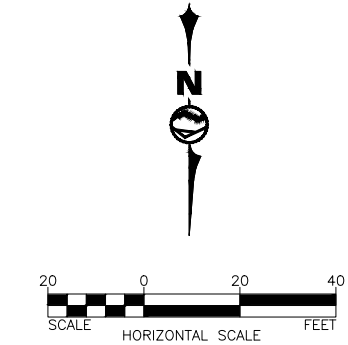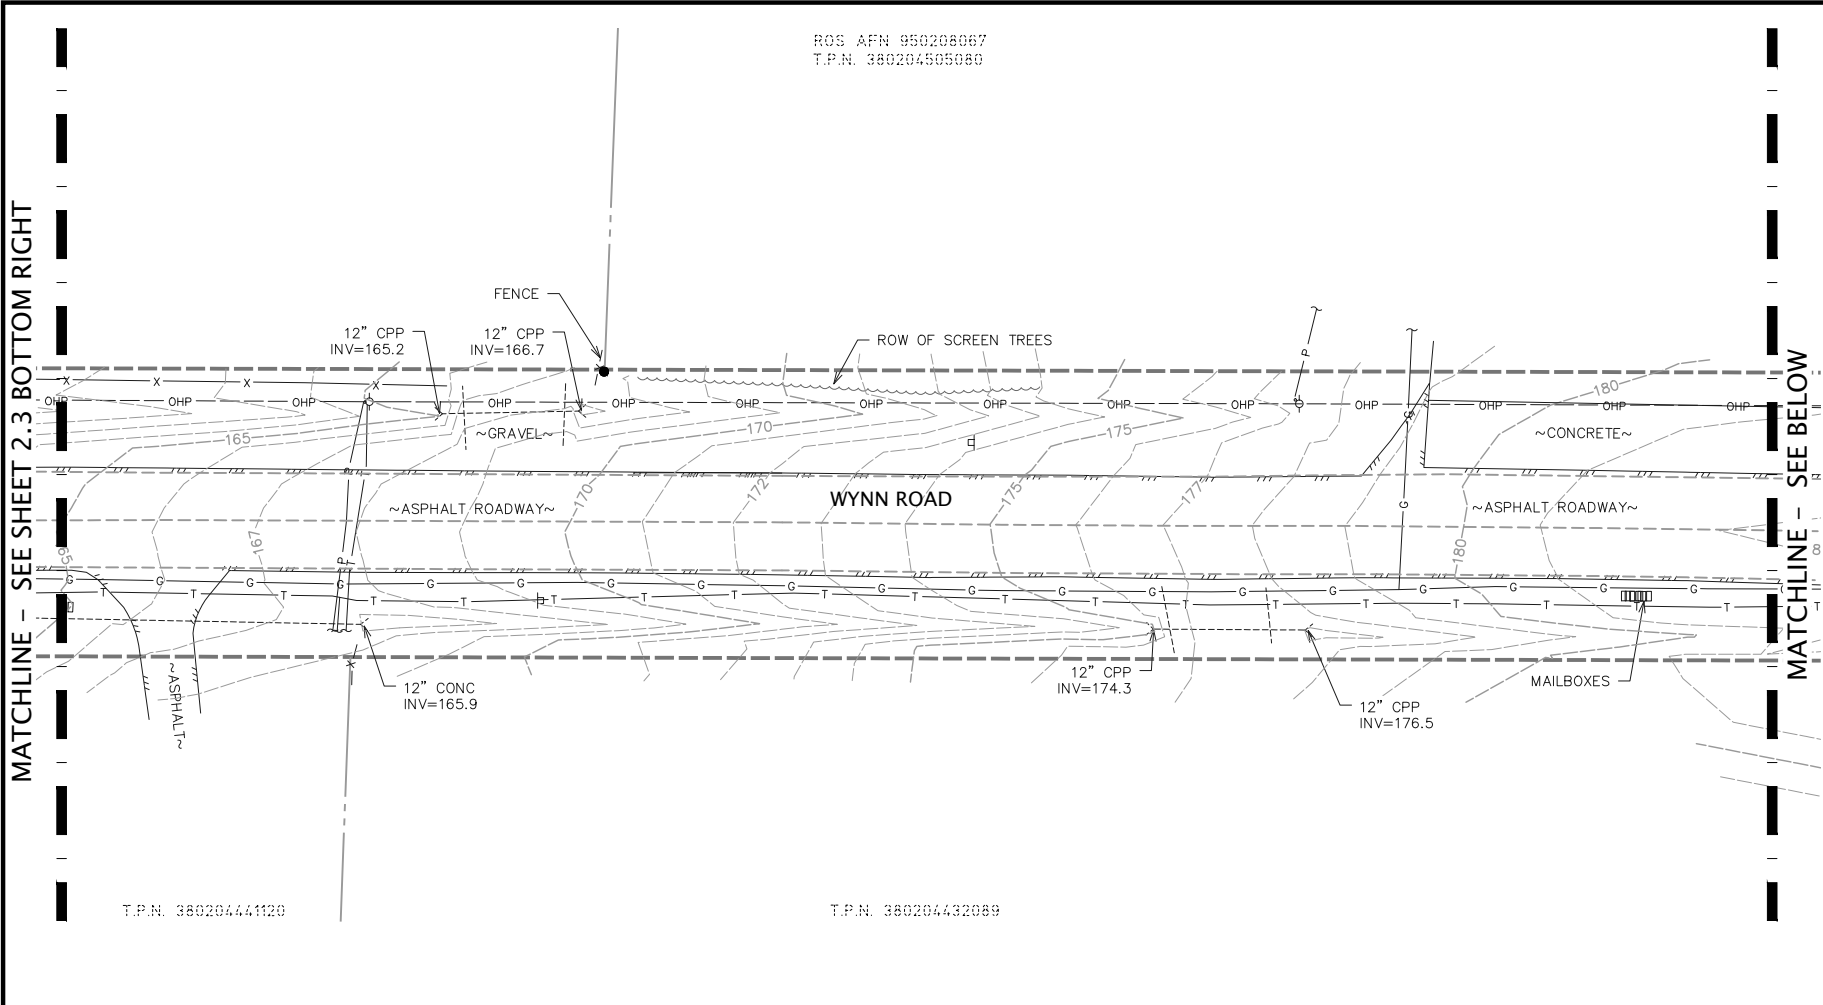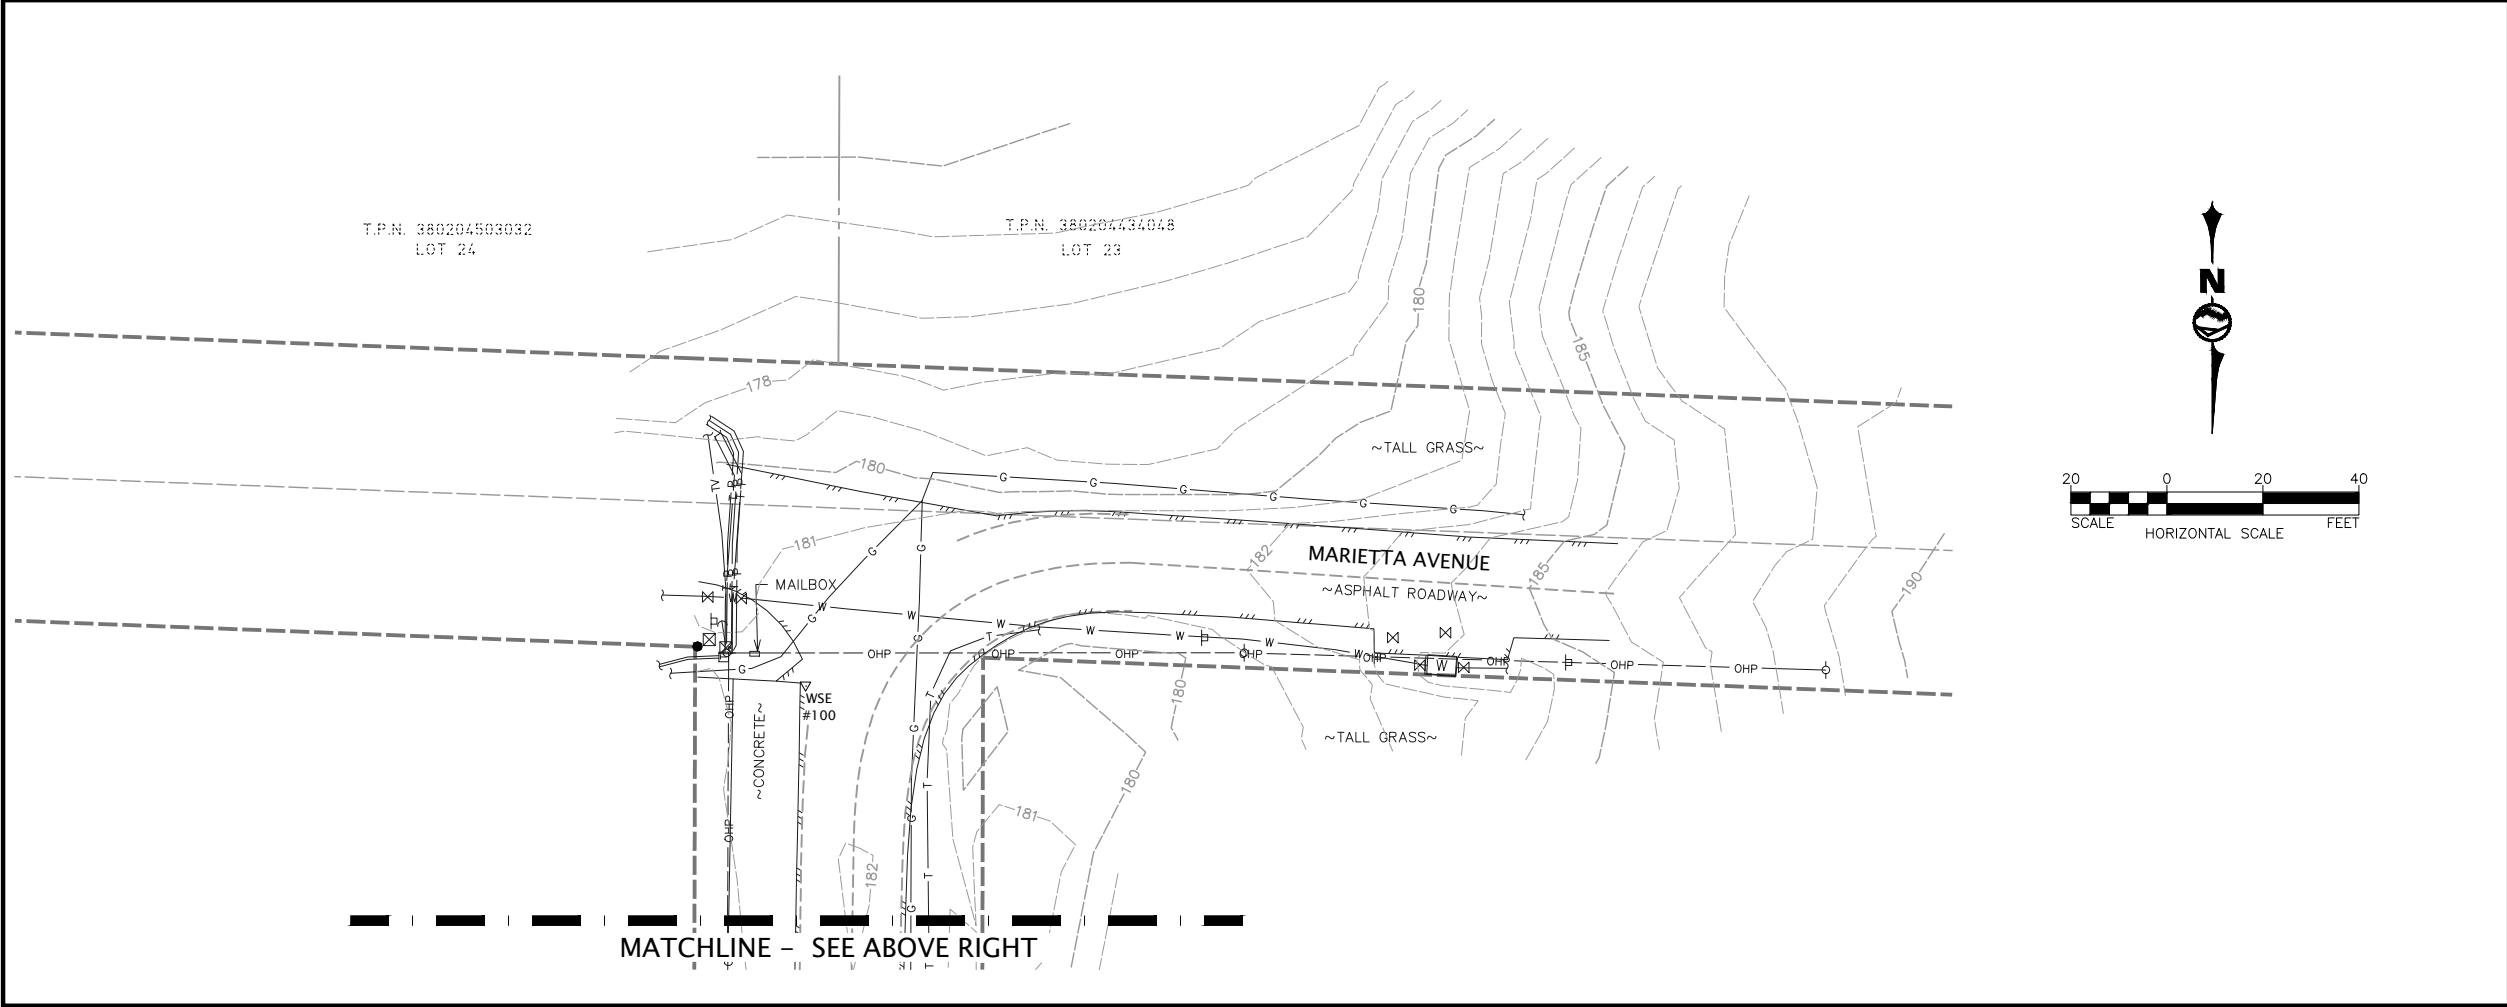

RECORD DRAWINGS

NO.	REVISIONS	BY	DATE

SHEET <b>C2.4</b>	DATE 5-31-23	CITY OF FERNDAL		DESIGNED BY BMS
	SCALE AS SHOWN	FERNDAL		DRAWN BY JGS
	PAGE 7 OF 25	WATER SYSTEM EMERGENCY INTERTIE		CHECKED BY AWL
	JOB NUMBER 2021-091	EXISTING CONDITIONS (4)		

**WILSON**  
ENGINEERING  
WILSONENGINEERING.COM

PLOT SETTINGS: WE AutoCAD PDF (General Documentation).pc3, WILSON 11X17, Portrait, 1:2, WE APWA\_UNSCREENED.ctb  
W:\2021\2021-091 FERNDAL WATER MAIN INTERTIE\DWG\AS-BUILT\YAB V2019\_2021-091 C2.5-C2.6 TESC DETAILS.DWG - 5/31/2023 11:19 AM - Jeff Smith

BMP C233 – SILT FENCE

PURPOSE: Use of a silt fence reduces the transport of coarse sediment from a construction site by providing a temporary physical barrier to sediment and reducing the runoff velocities of overland flow.

INSTALLATION: Use down slope of disturbed areas as shown on the plan and as needed to respond to site specific conditions. Geotextile shall meet the following standards: Polymetric Mesh AOS (ASTM D4751) = 0.60 mm maximum for silt film wovens, 0.30 mm maximum for all other geotextiles types, and 0.15 mm for all fabric types, Water Permittivity (ASTM D4491) = 0.2 sec(-1) minimum, Grab Tensile Strength (ASTM D4632) = 180 pounds minimum for extra strength fabric, 100 pounds minimum for standard strength fabric, Grab Tensile Elongation (ASTM D4632) = 30% maximum, Ultraviolet Resistance (ASTM D4355) = 70% minimum.

Standard strength fabrics shall be supported with wire mesh, chicken wire, 2–inch x 2–inch wire, safety fence, or jute mesh to increase the strength of the fabric. Silt fence materials are available that have synthetic mesh backing attached.

The minimum height of the top of the silt fence shall be 2 feet and the maximum height shall be 2.5 feet.

MAINTENANCE. Inspect the fence after rainfall events for sediment deposits upstream of the fence. Remove sediment deposits when they reach a depth of approximately 8 inches deep. Replace filter fabric fences damaged by construction equipment or ultraviolet breakdown.

BMP C123 – PLASTIC COVERING

PURPOSE: Plastic covering provides immediate, short–term erosion protection for emergency protection of slopes during heavy rains.

INSTALLATION: Place plastic up and down, not across slope with a minimum 8–inch overlap at seams. Place plastic end in a small (12–inch wide by 6–inch deep) slot trench at the top of the slope and backfill with soil to keep water from flowing underneath. Sandbags shall be placed ever 3 to 6 feet along seams and a wooden stake pounded in each to hold in place. If erosion of the toe is likely, a gravel berm riprap, or on the suitable protection shall be installed at the toe of the slope in order to reduce the velocity of runoff. Plastic sheeting shall have a minimum thickness of 0.06 millimeters.

MAINTENANCE. Torn sheet must be replaced and open seams repaired. When plastic is no longer needed, it shall be completely removed.

BMP C152: SAWCUTTING AND SURFACING POLLUTION PREVENTION

Purpose: Sawcutting and surfacing operations generate slurry and process water that contains fine particles and high pH (concrete cutting), both of which can violate the water quality standards in the receiving water. This BMP is intended to minimize and eliminate process water and slurry from entering waters of the State.

- Conditions of Use: Anytime sawcutting or surfacing operations take place, these management practices shall be utilized. Sawcutting and surfacing operations include, but are not limited to: sawing, coring, grinding, roughening, hydro–demolition, and bridge and road surfacing.

Design and Installation Specifications:

- Slurry and cuttings shall not remain on permanent concrete or asphalt pavement overnight.
- Slurry and cuttings shall not drain to any natural or constructed drainage conveyance.
- Collected slurry and cuttings shall be disposed of in a manner that does not violate groundwater or surface water quality standards.
- Process water that is generated during hydro–demolition, surface roughening or similar operations shall not drain to any natural or constructed drainage conveyance and shall be disposed of in a manner that does not violate groundwater or surface water quality standards.

Cleaning waste material and demolition debris shall be handled and disposed of in a manner that does not cause contamination of water. If the area is swept with a pick–up sweeper, the material must be hauled out of the area to an appropriate disposal site.

Maintenance Standards: Continually monitor operations to determine whether slurry, cuttings, or process water could enter waters of the state. If inspections show that a violation of water quality standards could occur, stop operations and immediately implement preventive measures such as berms, barriers, secondary containment, and vacuum trucks.

BMP C121 – MULCHING

PURPOSE: Mulching provides immediate temporary protection from erosion. Mulch also enhances plant establishment by conserving moisture, holding fertilizer, seed, and topsoil in place, and moderating soil temperatures.

INSTALLATION: Apply as needed to areas subject to higher risks of erosion such as all slopes steeper than 4H:1V. Mulch with straw that is air–dried and free from seed and coarse material. Apply straw 2”–3” in thickness or application rate of 5 bales per 100 sf or 2–3 tons per acre.

MAINTENANCE. Thickness of cover must be maintained. Any areas that experience erosion shall be remulched and/or protected with a net or blanket. If the erosion problem is drainage related, then the problem shall be fixed and the eroded material remulched.

BMP C130 – SURFACE ROUGHENING

PURPOSE: Surface roughening aids in the establishment of vegetative cover, reduces runoff velocity, increases infiltration, and provides for sediment trapping through the provision of a rough soil surface. Horizontal depressions are created by operating a tiller or other suitable equipment on the contour.

INSTALLATION: All slopes steeper than 3H:1V and greater than 5 vertical feet require surface roughening. Areas steeper than 3H:1V shall be roughened to a depth of 2 to 4 inches prior to seeding. Areas that will not be stabilized immediately may be roughened to reduce runoff velocity until seeding takes place.

Areas that will be mowed (slopes 3H:1V or shallower) shall have small furrows left by disking, harrowing, raking, or seed–planting machinery operated on the contour.

Graded areas with slopes greater than 3H:1V but less than 2H:1V shall be roughened before seeding. This can be accomplished in a variety of ways, including “track walking,” or driving a crawler tractor up and down the slope leaving a pattern of cleat prints parallel to the slope contours.

MAINTENANCE: Areas that are graded in this manner shall be seeded as quickly as possible. Regular inspections should be made of the area. If rills appear, they shall be regraded and re–seeded immediately.

BMP C151: CONCRETE HANDLING


Purpose: Concrete work can generate process water and slurry that contain fine particles and high pH, both of which can violate water quality standards in the receiving water. This BMP is intended to minimize and eliminate concrete process water and slurry from entering waters of the state.

- Conditions of Use: Any time concrete is used, these management practices shall be utilized. Concrete construction projects include, but are not limited to: curbs, sidewalks, roads, bridges, foundations, floors, and runways.


Design and Installation Specifications:

- Concrete truck chutes, pumps, and internals shall be washed out only into formed areas awaiting installation of concrete or asphalt.
- Unused concrete remaining in the truck and pump shall be returned to the originating batch plant for recycling.
- Hand tools including, but not limited to, screeds, shovels, rakes, floats, and trowels shall be washed off only into formed areas awaiting installation of concrete or asphalt.
- Equipment that cannot be easily moved, such as concrete pavers, shall only be washed in areas that do not directly drain to natural or constructed stormwater conveyances.
- Washdown from areas such as concrete aggregate driveways shall not drain directly to natural or constructed stormwater conveyances.
- When no formed areas are available, washwater and leftover product shall be contained in a lined container. Contained concrete shall be disposed of in a manner that does not violate groundwater or surface water quality standards.

Maintenance Standards: Containers shall be checked for holes in the liner daily during concrete pours and repaired the same day.

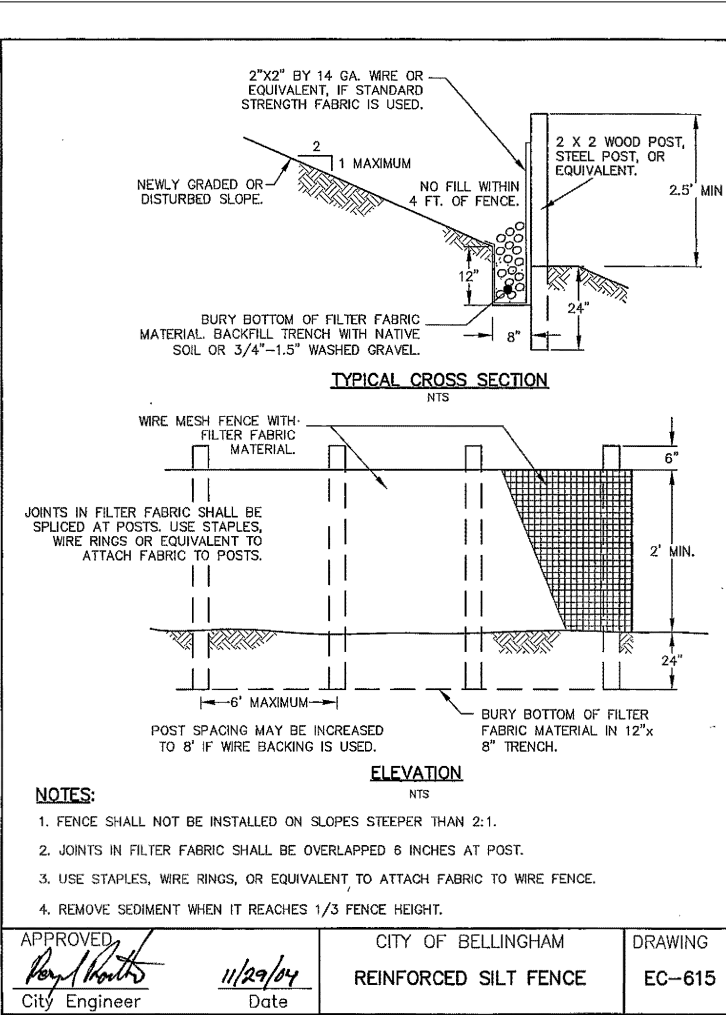

1 REINFORCED SILT FENCE NOT TO SCALE

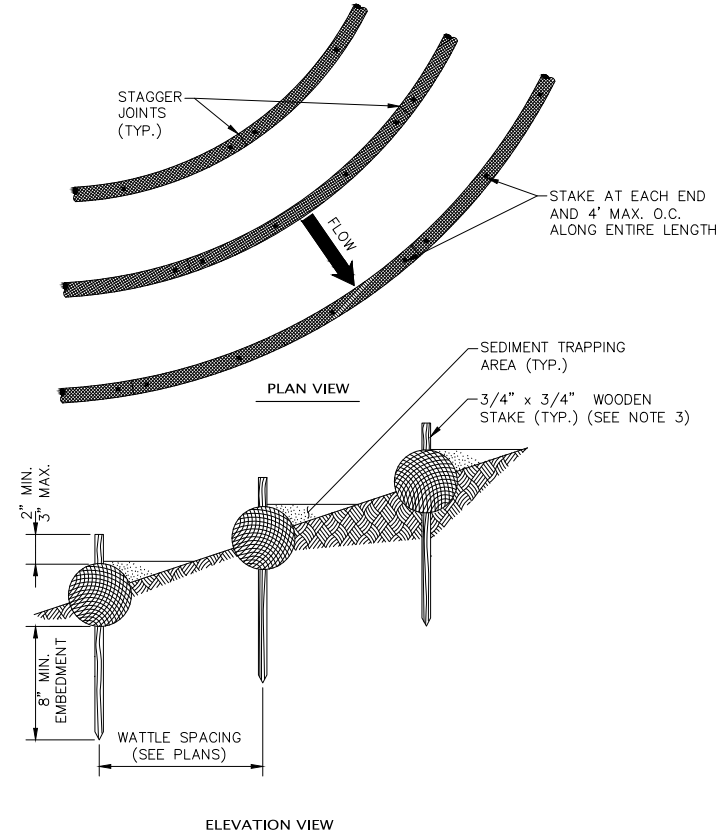

- NOTES:**
1. INSTALL WATTLES ALONG CONTOURS (SEE STANDARD SPECIFICATION 8–01.3(10)).
  2. WATTLES SHALL BE INSPECTED REGULARLY, AND IMMEDIATELY AFTER A RUNOFF PRODUCING RAINFALL, TO ENSURE THEY REMAIN THOROUGHLY ENTRENCHED AND IN CONTACT WITH THE SOIL.
  3. LIVE STAKES MAY BE USED FOR PERMANENT INSTALLATIONS.
  4. PERFORM MAINTENANCE IN ACCORDANCE WITH STANDARD SPECIFICATION 8–01.3(15).
  5. INSTALL WATTLES SNUGLY INTO THE TRENCH. ABUT ADJACENT WATTLES TIGHTLY, END TO END, WITHOUT OVERLAPPING THE ENDS.
  6. PILOT HOLES MAY BE DRIVEN THROUGH THE WATTLE AND INTO THE SOIL, WHEN SOIL CONDITIONS REQUIRE.

2 STRAW WATTLE CHECK DAM NOT TO SCALE

WILSON  
ENGINEERING

WILSONENGINEERING.COM

17/31/23

DESIGNED BY BMS	DRAWN BY PMT	CHECKED BY AWL
CITY OF FERNDAL		
FERNDAL		
WASHINGTON		
WATER SYSTEM EMERGENCY INTERTIE		
TESC NOTES AND DETAILS		
DATE 5-31-23	SCALE AS SHOWN	JOB NUMBER 2021-091
SHEET C2.5	PAGE 8	OF 25

RECORD DRAWINGS







LOT 21

USA IN TRUST FOR  
THE LUMMI NATION  
2685 KWINA RD  
BELLINGHAM WA  
98226-0291


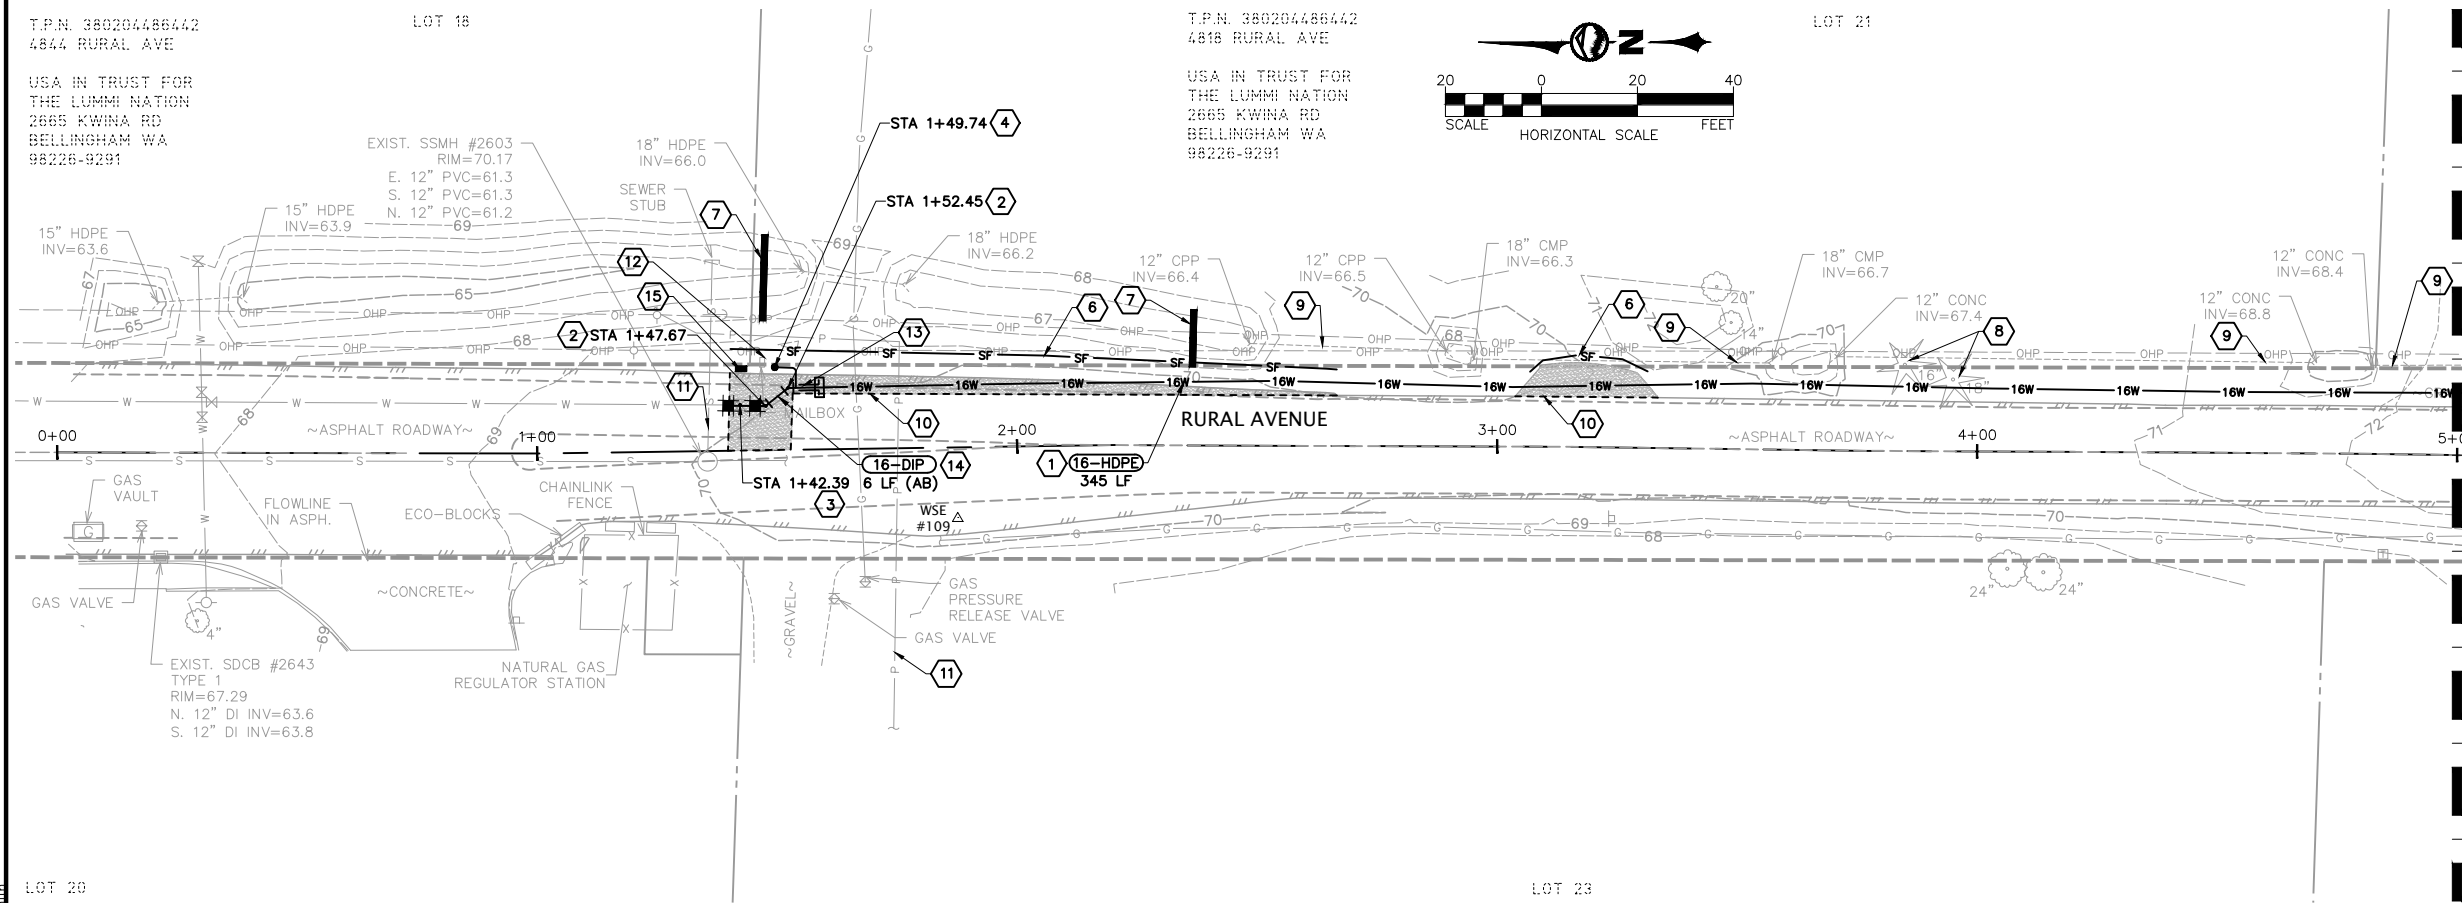
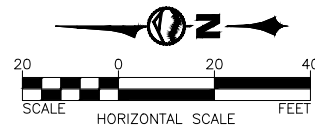




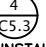
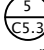
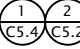

USA IN TRUST FOR  
THE LUMMI NATION  
2665 KWINA RD  
BELLINGHAM WA  
98226-9291



MATCHLINE - STA 5+00 - SEE SHEET C3.2 TOP LEFT


NO.	REVISIONS	BY	DATE
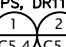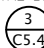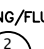
### KEYED NOTES

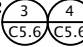
- 1 = PROPOSED 16"Ø HDPE, IPS, DR11  
WATER LINE INTERTIE PER 
- 2 = 16" 45° HORIZONTAL BEND -  
DUCTILE IRON.  
THRUST BLOCK PER 
- 3 = TIE INTO EXISTING CITY OF FERNDALE  
WATER LINE. CONTRACTOR TO VERIFY  
LOCATION & ELEVATION PRIOR TO  
CONSTRUCTION
- 4 = PRESSURE TESTING/FLUSHING  
CONNECTION PER 
- 5 = NOT USED
- 6 = INSTALL SILT FENCE PER 
- 7 = INSTALL STRAW WATTLE  
CHECK DAM PER 
- 8 = EXISTING TREES TO BE REMOVED
- 9 = PROTECT EXISTING CULVERT  
IN PLACE
- 10 = SAWCUT, REMOVE, AND REPLACE  
ASPHALT PER   
TOTAL SAWCUTTING, THIS SHEET: 185 LF  
TOTAL ASPHALT, THIS SHEET: 665 SF
- 11 = PROTECT EXISTING UTILITY IN  
PLACE
- 12 = REMOVE AND REINSTALL  
MAILBOX PER 
- 13 = TRANSITION FROM 16" DUCTILE  
IRON TO 16" HDPE WATER MAIN  
PER   
AND INSTALL REVERSE THRUST  
BLOCK PER 
- 14 = PROPOSED 16" DIP WATER  
MAIN INTERTIE PER 
- 15 = TRACER WIRE PEDESTAL PER 

## NOTES

1. ALL SOILS ON SITE ARE  
WHATCOM/WHATCOM-LABOUNTY SILT  
LOAM.
2. EXISTING VEGETATIVE COVER OF  
ROADSIDE DITCHES ARE GRASSES AND  
NATIVE COVER PLANTS.
3. ALL DISTURBED AREA TO BE  
PERMANENTLY SEEDED WITH NATIVE SEED  
MIX AFTER CONSTRUCTION IS COMPLETE
4. ALL WATER MAIN JOINTS SHALL BE  
RESTRAINED

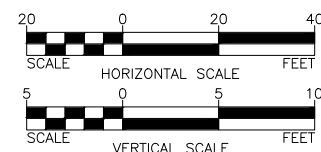

## RECORD DRAWINGS

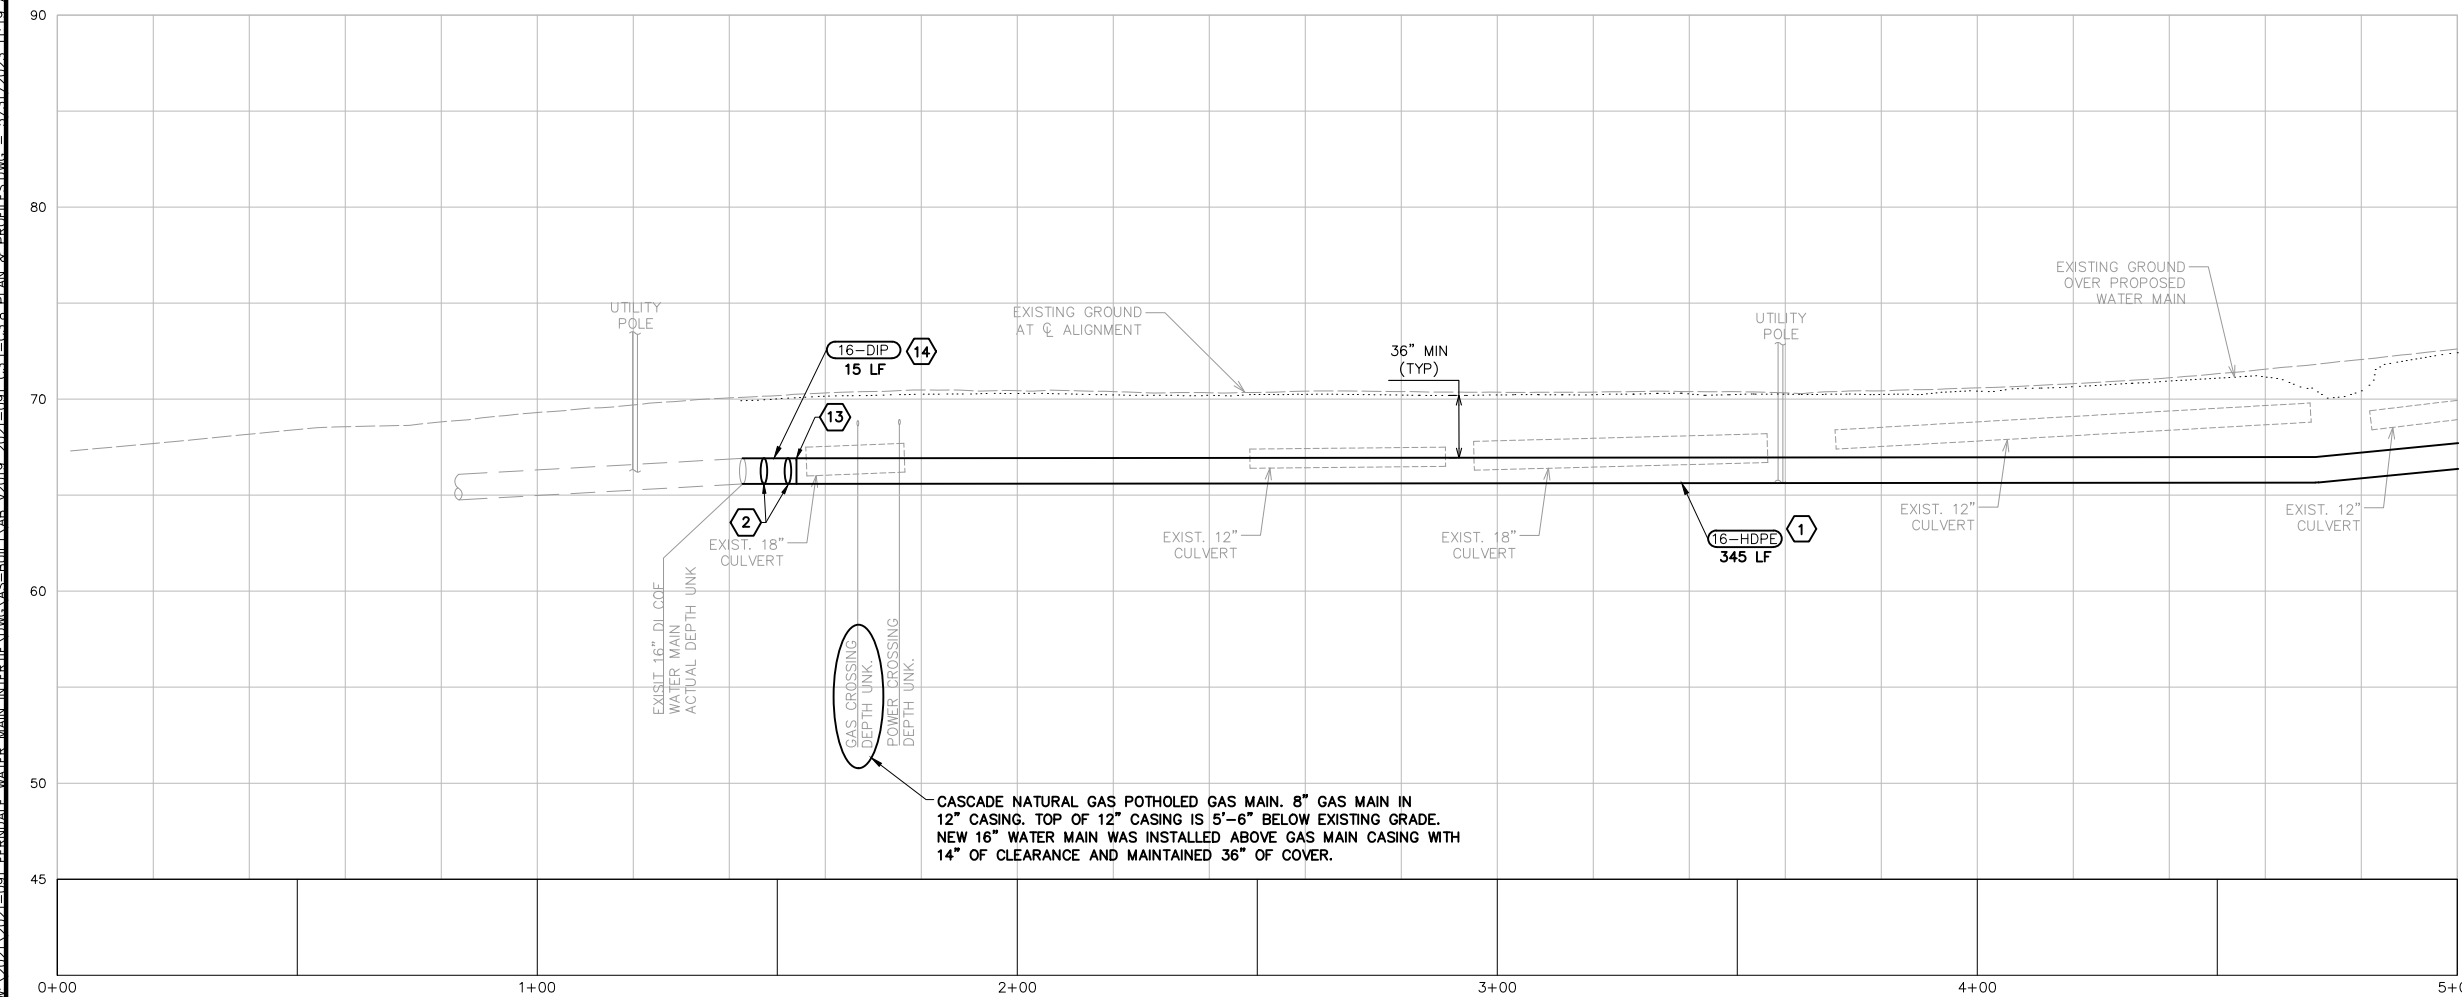

CITY OF FERNDALE

# WATER SYSTEM EMERGENCY INTERTIE

PLAN AND PROFILE STA 0+00 - 5+00

DESIGNED BY

BMS

DRAWN BY

JCS

CHECKED BY

--	--

---

WASHINGTON

---

---

DATE \_\_\_\_\_

5-31-20

SCALE


AS SHOW

**JOB NUMB**

C31  
SHEET

PAGE

L  
 C  
 L  
 C

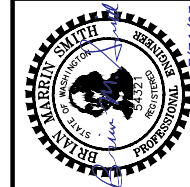

**WILSON**  
ENGINEERING

**WILSONENGINEERING.COM**


PLOT SETTINGS: WE AutoCAD PDF (General Documentation).pc3, WILSON 11x17, Portrait, 1:2, WE APIWA\_UNSCREENED.ctb





PLOT SETTINGS: WE AutoCAD PDF (General Documentation)pc3, WILSON 11X17, Portrait, 1:2, WE APWA\_UNSCREENED.ctb  
W:\2021\2021-091 FERNDAL WATER MAIN INTERTIE\DWG\AS-BUILT\TAB V2019\_2021-091 C3.1-C3.8 PLAN & PROFILES.DWG - 5/31/2023 11:20 AM - Jeff Smith


MATCHLINE - STA 10+00 - SEE SHEET C3.2 TOP RIGHT

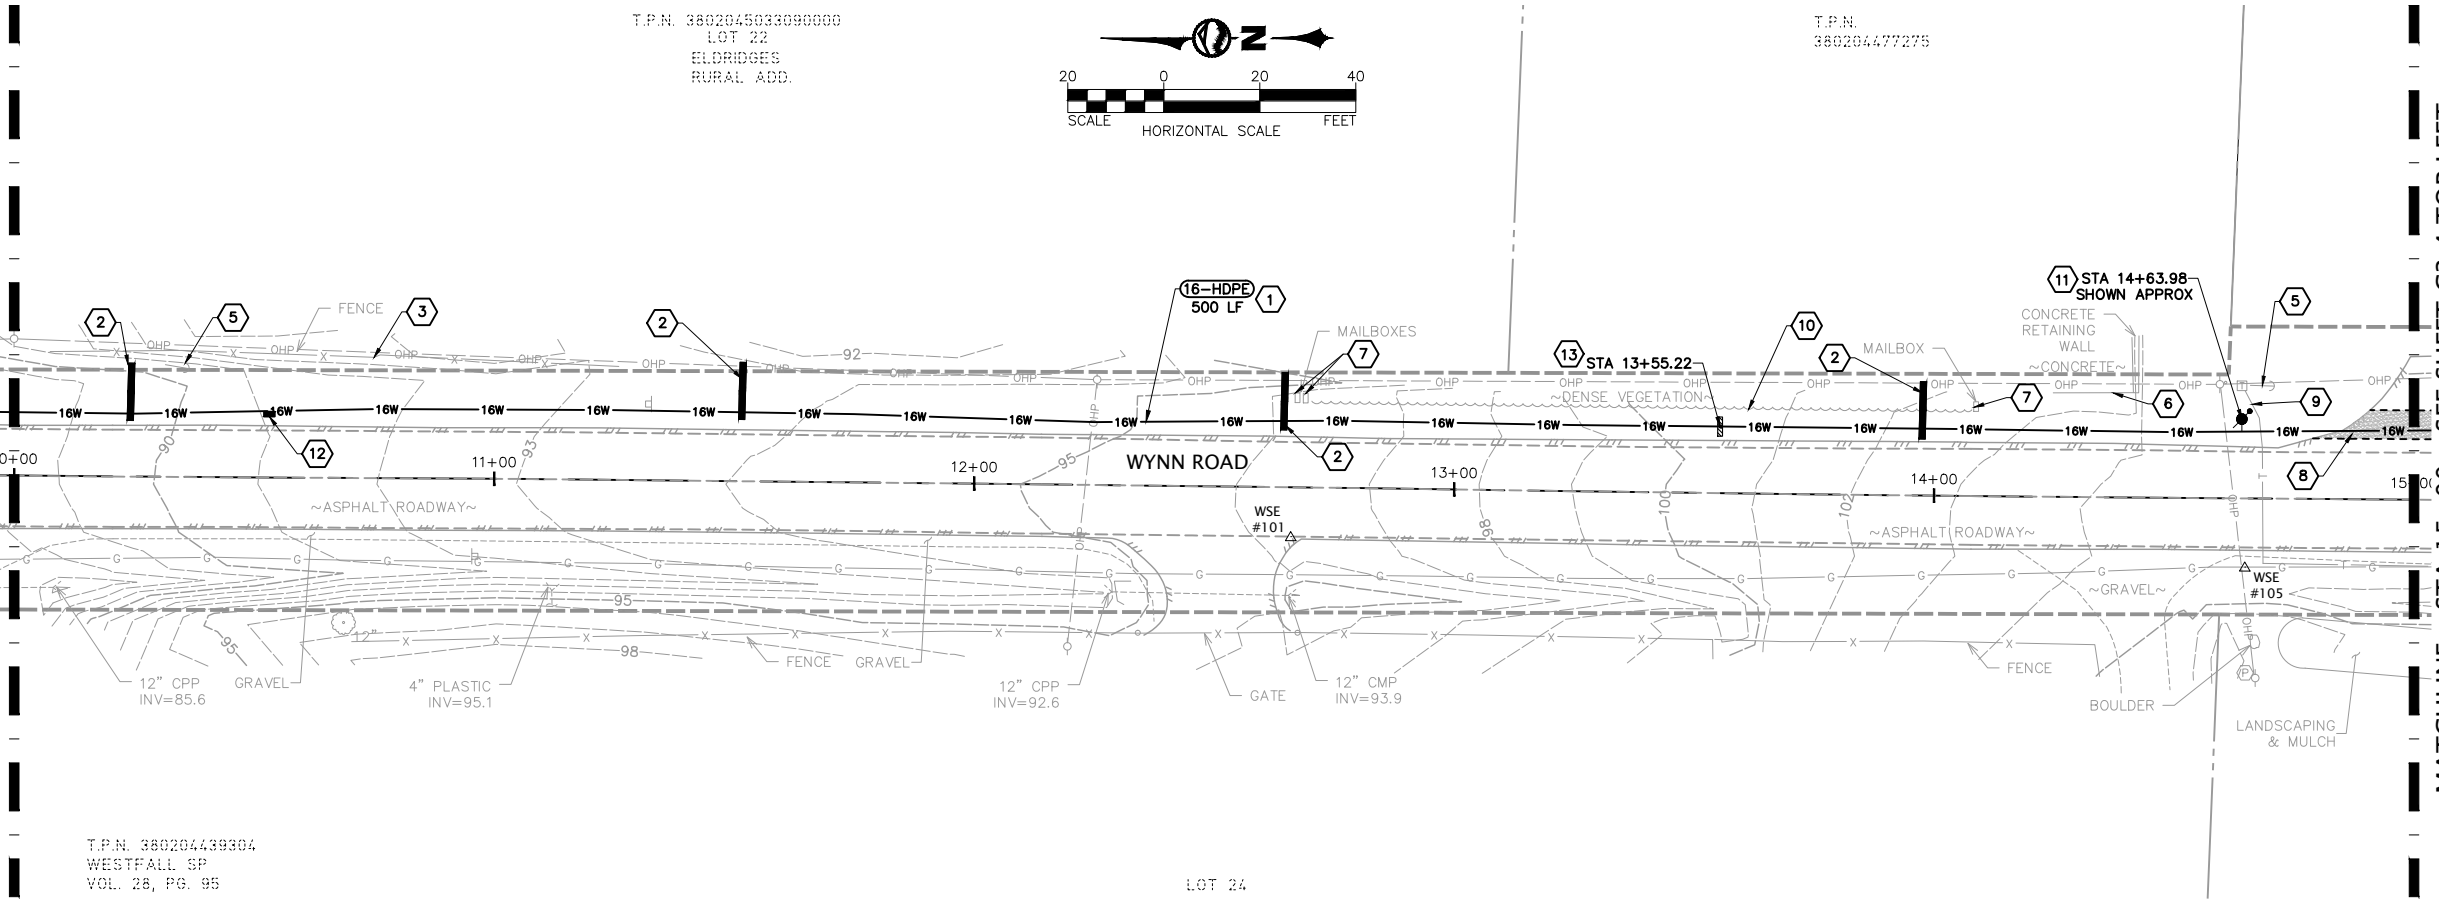

MATCHLINE - STA 15+00 - SEE SHEET C3.4 TOP LEFT

- KEYED NOTES**
- 1 = PROPOSED 16"ø HDPE, IPS, DR11 WATER MAIN INTERTIE PER (1 C5.4, 2 C5.2)
  - 2 = INSTALL STRAW WATTLE CHECK DAM PER (2 C2.5)
  - 3 = PROTECT EXISTING FENCE IN PLACE
  - 4 = NOT USED
  - 5 = PROTECT EXISTING GUY LINE ANCHOR IN PLACE
  - 6 = PROTECT EXISTING CONCRETE/WALL IN PLACE
  - 7 = REMOVE AND REINSTALL MAILBOX PER (2 C5.6)
  - 8 = SAWCUT, REMOVE, AND REPLACE ASPHALT PER (3 C5.6)
  - 9 = PROTECT EXISTING UTILITY IN PLACE
  - 10 = CLEAR DENSE VEGETATION AS NECESSARY
  - 11 = 2" COMBINATION AIR/VACUUM RELIEF ASSEMBLY. LOCATE AT THE APPROXIMATE HIGH POINT, PER (1 C5.5)
  - 12 = TRACER WIRE PEDESTAL PER (2 C5.2)
  - 13 = TRENCH DAM PER (4 C5.2)
- TOTAL SAWCUTTING BETWEEN THIS SHEET AND NEXT: 85 LF  
TOTAL ASPHALT BETWEEN THIS SHEET AND NEXT: 235 SF

- NOTES**
- ALL SOILS ON SITE ARE WHATCOM/WHATCOM-LABOUNTY SILT LOAM.
  - EXISTING VEGETATIVE COVER OF ROADSIDE DITCHES ARE GRASSES AND NATIVE COVER PLANTS.
  - ALL DISTURBED AREA TO BE PERMANENTLY SEEDED WITH NATIVE SEED MIX AFTER CONSTRUCTION IS COMPLETE
  - ALL WATER MAIN JOINTS SHALL BE RESTRAINED

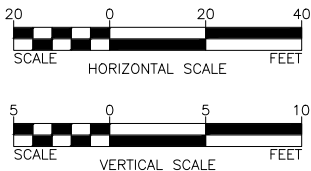

RECORD DRAWINGS

CITY OF FERNDAL

WATER SYSTEM EMERGENCY INTERTIE

PLAN AND PROFILE STA 10+00 - 15+00


DESIGNED BY  
BMS

DRAWN BY  
JGS

CHECKED BY  
AWL

WASHINGTON

FERNDAL

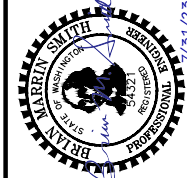

**WILSON**  
ENGINEERING

WILSONENGINEERING.COM

SHEET  
C3.3

DATE  
5-31-23

SCALE  
AS SHOWN



JOB NUMBER  
2021-091

PAGE  
12 OF 25





PLOT SETTINGS: WE AutoCAD PDF (General Documentation)pc3, WILSON 11X17, Portrait, 1:2, WE APWA\_UNSCREENED.ctb  
W:\2021\2021-091 FERNDAL WATER MAIN INTERTIE.DWG AS-BUILT\TAB V2019\_2021-091 C3.1-C3.8 PLAN & PROFILES.DWG - 5/31/2023 11:20 AM - Jeff Smith

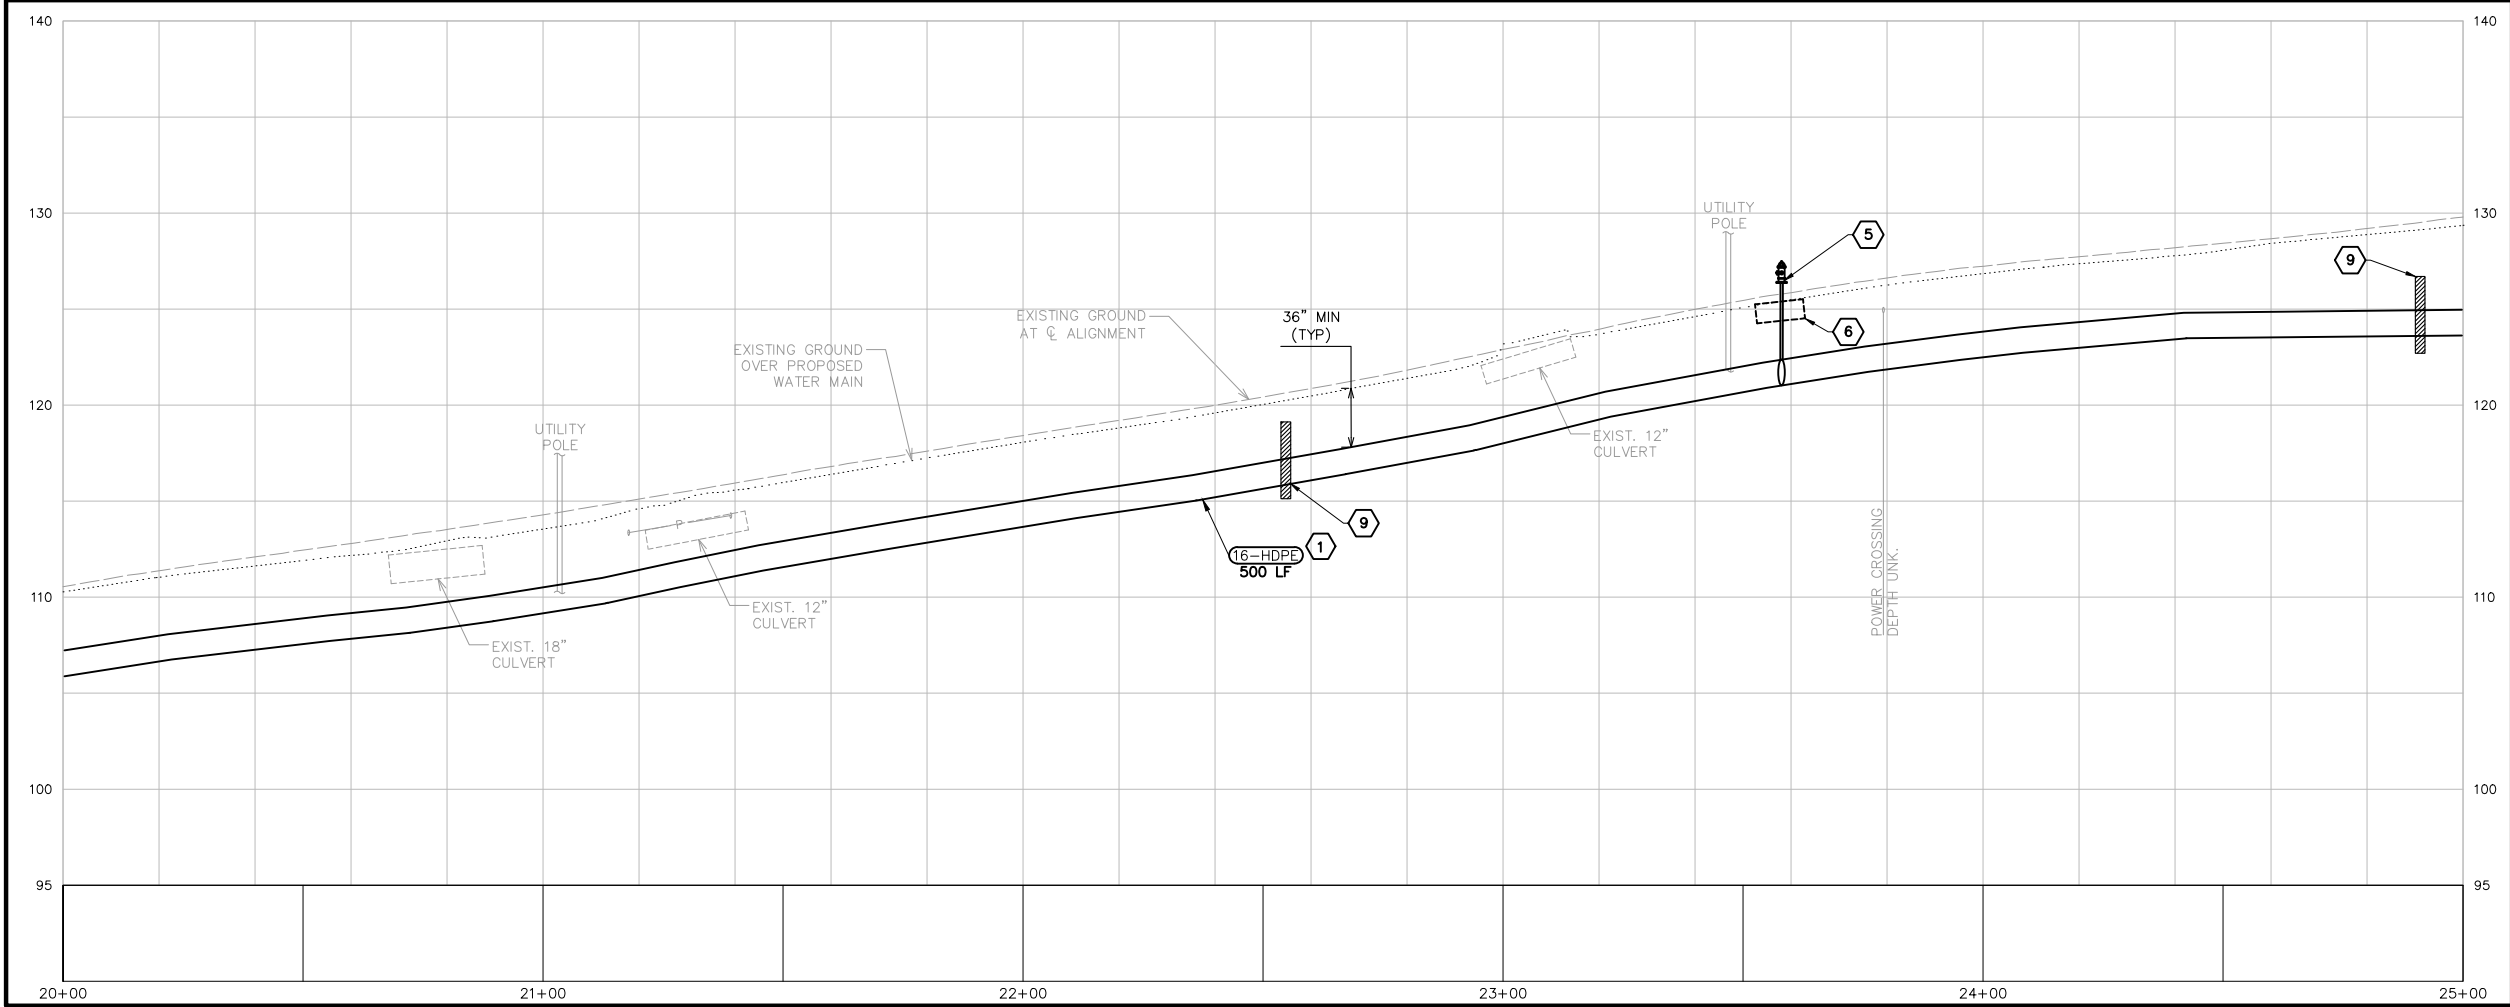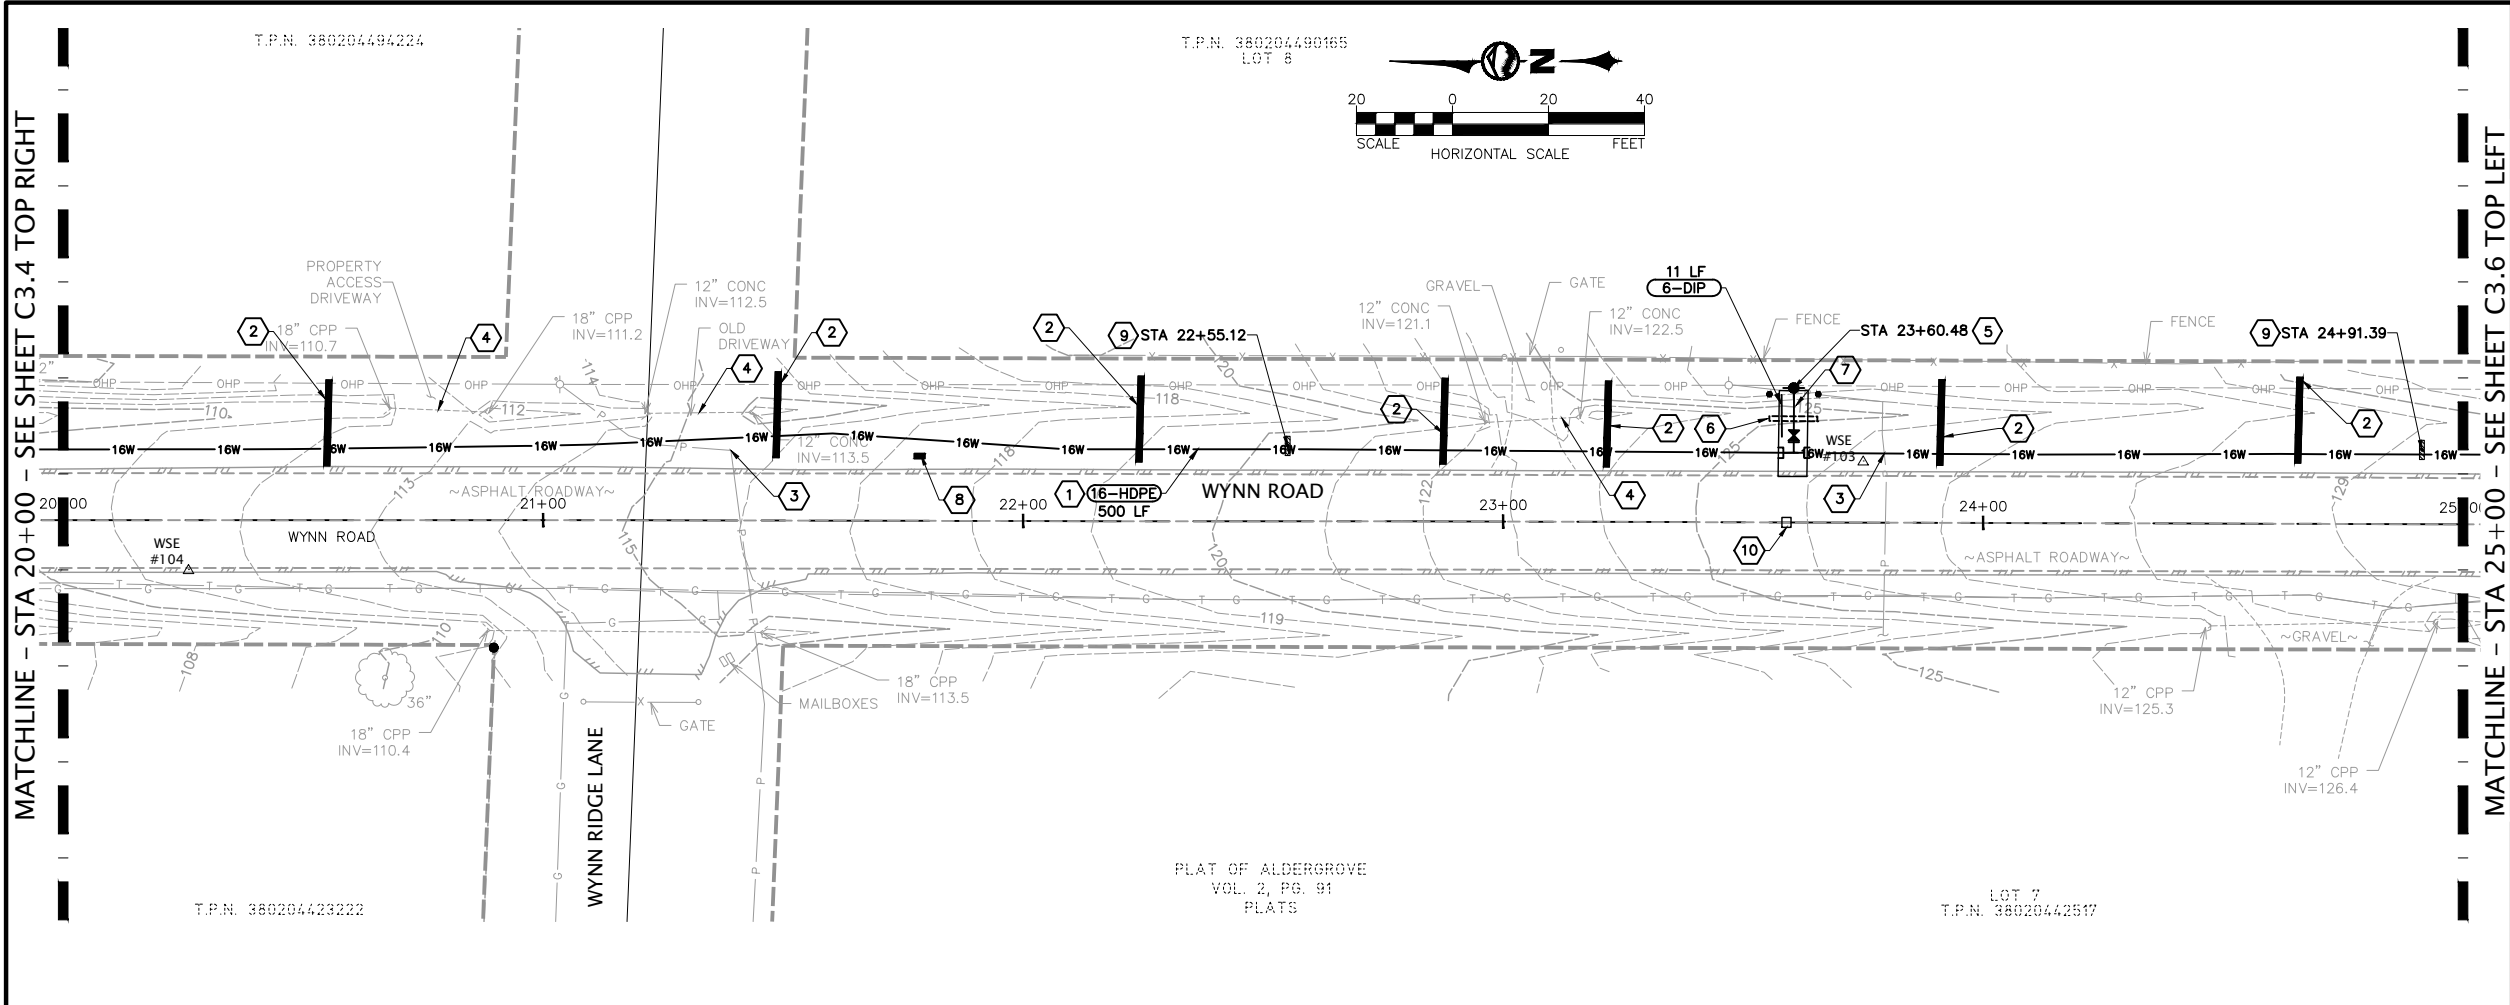

NO.	REVISIONS	BY	DATE

**KEYED NOTES**

1 = PROPOSED 16"Ø HDPE, IPS, DR11 WATER MAIN INTERTIE PER 1 2 C5.4 C5.2

2 = INSTALL STRAW WATTLE CHECK DAM PER 2 C2.5

3 = PROTECT EXISTING UTILITY IN PLACE

4 = PROTECT EXISTING CULVERT IN PLACE

5 = INSTALL HYDRANT ASSEMBLY AND BOLLARDS PER 3 2 C5.3 C5.5

6 = INSTALL 12" DIA CULVERT AND BACKFILL WITH CSBC INLET/OUTLET PROTECTION PER 1 C5.6

7 = 6' WIDE FLAT CSBC ACCESS PATH PER 1 C5.6

8 = TRACER WIRE PEDESTAL PER 2 C5.2

9 = TRENCH DAM PER 4 C5.2

10 = BLUE-RETROREFLECTOR 2 C5.5

**NOTES**

1. ALL SOILS ON SITE ARE WHATCOM/WHATCOM-LABOUNTY SILT LOAM.

2. EXISTING VEGETATIVE COVER OF ROADSIDE DITCHES ARE GRASSES AND NATIVE COVER PLANTS.

3. ALL DISTURBED AREA TO BE PERMANENTLY SEEDED WITH NATIVE SEED MIX AFTER CONSTRUCTION IS COMPLETE

4. ALL WATER MAIN JOINTS SHALL BE RESTRAINED

SCALE  
HORIZONTAL SCALE  
FEET

20 0 20 40

SCALE  
VERTICAL SCALE  
FEET

5 0 5 10

**811 Call 811**  
two business days before you dig

**RECORD DRAWINGS**

**WILSON ENGINEERING**  
WILSONENGINEERING.COM

**CITY OF FERNDAL**

WATER SYSTEM EMERGENCY INTERTIE

PLAN AND PROFILE STA 20+00 - 25+00



DESIGNED BY BMS  
DRAWN BY JGS  
CHECKED BY AWL

DATE 5-31-23  
SCALE AS SHOWN  
JOB NUMBER 2021-091

**C3.5**  
PAGE 14 OF 25



PLOT SETTINGS: WE AutoCAD PDF (General Documentation).pc3, WILSON 11X17, Portrait, 1:2, WE APUA\_UNSCREENED.ctb  
W:\2021\2021-091 FERNDAL WATER MAIN INTERTIE.DWG AS-BUILT\TAB V2019\_2021-091 C3.1-C3.8 PLAN & PROFILES.DWG - 5/31/2023 11:20 AM - Jeff Smith

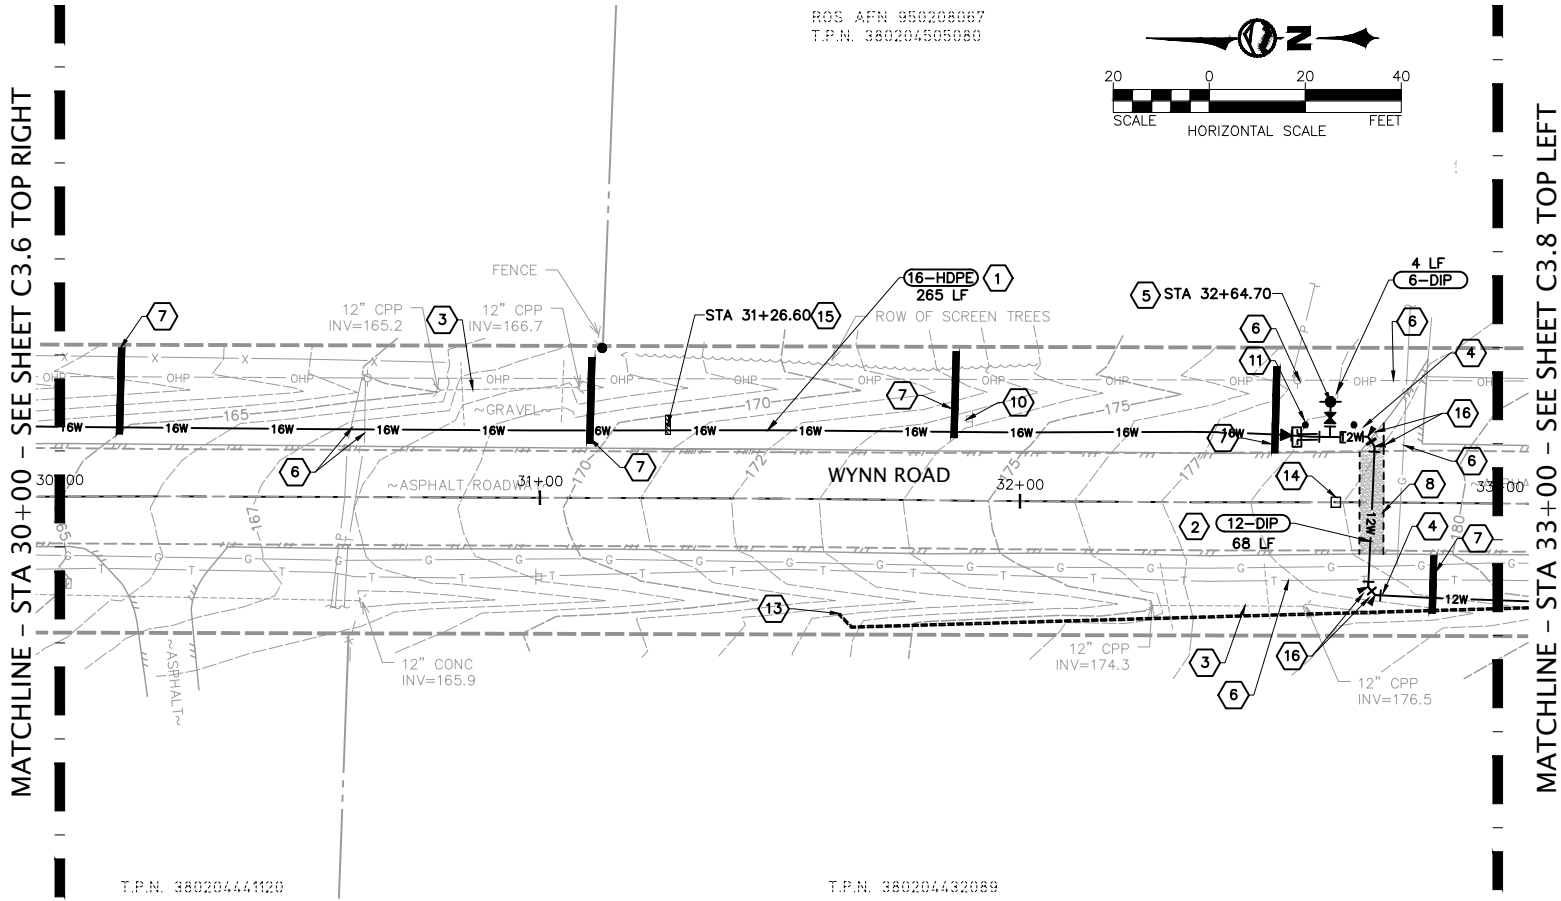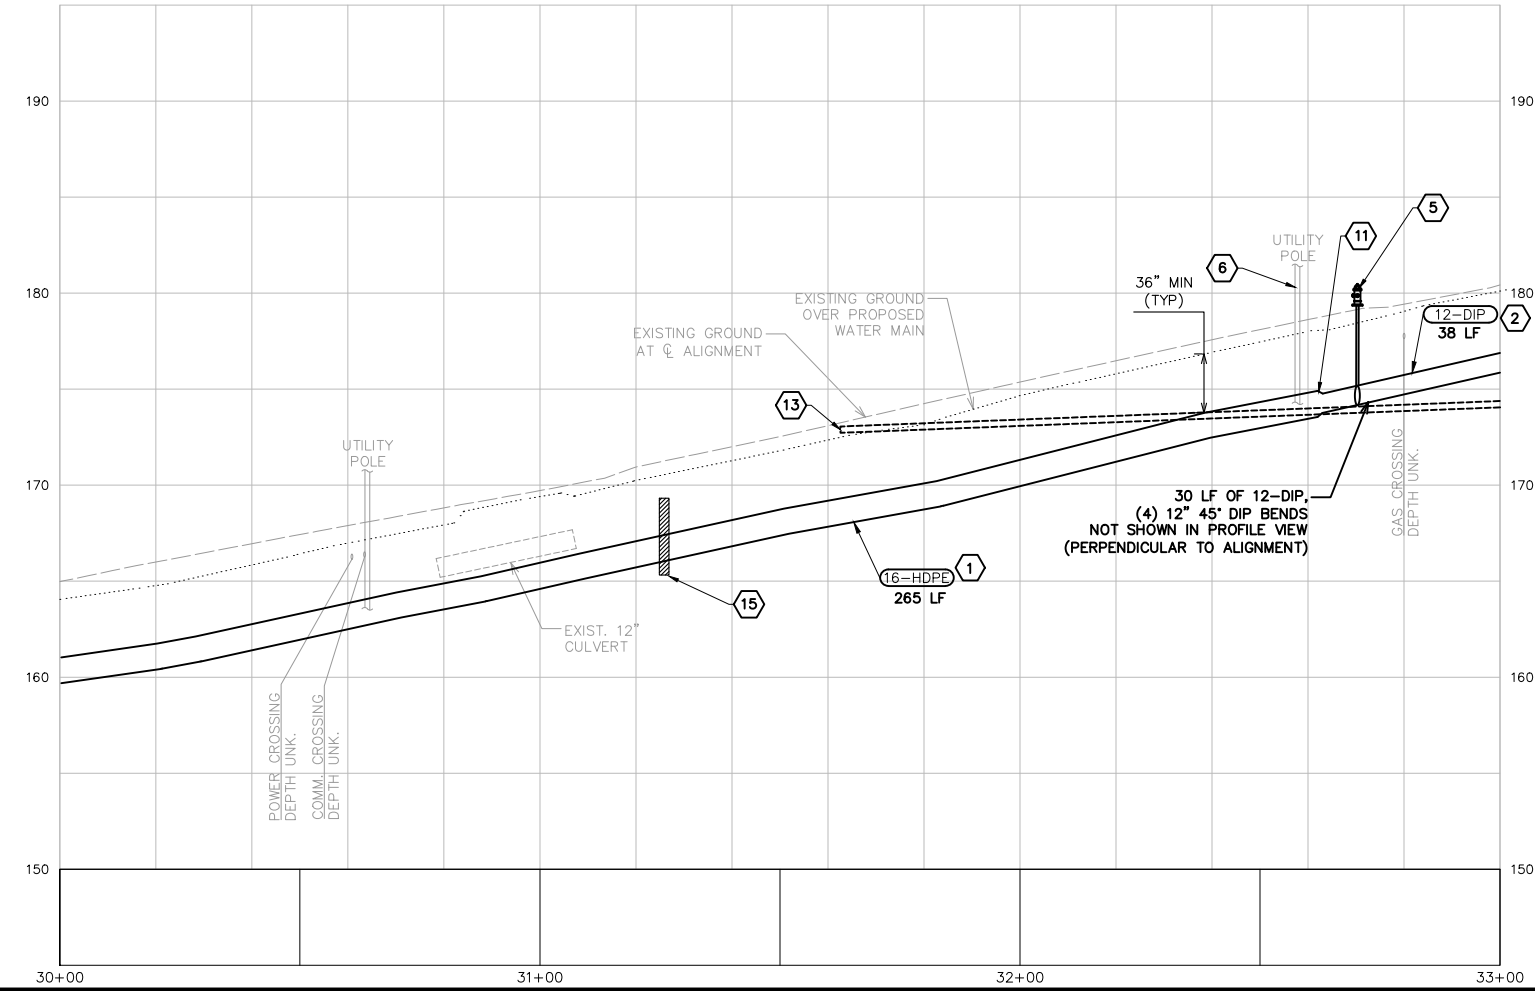

NO.	REVISIONS	BY	DATE
1	PROPOSED 16" HDPE, IPS, DR11 WATER MAIN INTERTIE PER	CS.4	CS.2
2	PROPOSED 12" DIP, IPS, DR11 WATER LINE INTERTIE PER	CS.4	
3	PROTECT EXISTING CULVERT IN PLACE		
4	(2) DIP 12" 45° HORIZONTAL BENDS		
5	INSTALL HYDRANT ASSEMBLY AND BOLLARDS PER	CS.3	CS.5
6	PROTECT EXISTING UTILITY IN PLACE		
7	INSTALL STRAW WATTLE CHECK DAM PER	CS.5	
8	SAWCUT, REMOVE, AND REPLACE ASPHALT TOTAL SAWCUTTING, THIS SHEET: 48 LF TOTAL ASPHALT, THIS SHEET: 121 SF PER	CS.6	
9	NOT USED		
10	REMOVE AND REINSTALL SIGN AS NECESSARY FOR CONSTRUCTION. ENSURE TEMPORARY OR PERMANENT SIGN SERVING THIS PURPOSE IS IN PLACE AT ALL TIMES ROAD IS OPEN TO TRAFFIC.		
11	TRANSITION FROM 16" HDPE TO 12" DUCTILE IRON WATER MAIN PER	CS.3	
	AND INSTALL REVERSE THRUST BLOCK PER	CS.3	
13	ROUTE 4" PVC VAULT DRAINS NORTH TO ROADSIDE DITCH AT 1% PER DETAIL PER	CS.2	CS.2
	INV. OUT: 172.89		
14	BLUE RETRO-REFLECTOR	CS.5	
15	TRENCH DAM PER	CS.2	
16	STANDARD CONCRETE THRUST BLOCKS PER COF DETAIL W-2 (AB)		

**KEYED NOTES**

1. ALL SOILS ON SITE ARE WHATCOM/WHATCOM-LABOUNTY SILT LOAM.

2. EXISTING VEGETATIVE COVER OF ROADSIDE DITCHES ARE GRASSES AND NATIVE COVER PLANTS.

3. ALL DISTURBED AREA TO BE PERMANENTLY SEEDED WITH NATIVE SEED MIX AFTER CONSTRUCTION IS COMPLETE

4. ALL WATER MAIN JOINTS SHALL BE RESTRAINED

SCALE HORIZONTAL SCALE FEET

SCALE VERTICAL SCALE FEET

811 Call 811 two business days before you dig

**RECORD DRAWINGS**

CITY OF FERNDAL		WATER SYSTEM EMERGENCY INTERTIE		PLAN AND PROFILE STA 30+00 - 35+00	
DESIGNED BY	BMS	DRAWN BY	JGS	CHECKED BY	AWL
WASHINGTON		FERNDAL			
SHEET	C3.7	PAGE	16	OF	25
DATE	5-31-23	SCALE	AS SHOWN	JOB NUMBER	2021-091

**WILSON ENGINEERING**


WILSONENGINEERING.COM

17/31/23



PLOT SETTINGS: WE AutoCAD PDF (General Documentation).pc3, WILSON 11X17, Portrait, 1:2, WE APWA\_UNSCREENED.ctb  
W:\2021\2021-091 FERNDAL WATER MAIN INTERTIE.DWG AS-BUILT\TAB V2019\_2021-091 C3.1-C3.8 PLAN & PROFILES.DWG - 5/31/2023 11:21 AM - Jeff Smith

MATCHLINE - STA 33+00 - SEE SHEET C3.7 TOP RIGHT

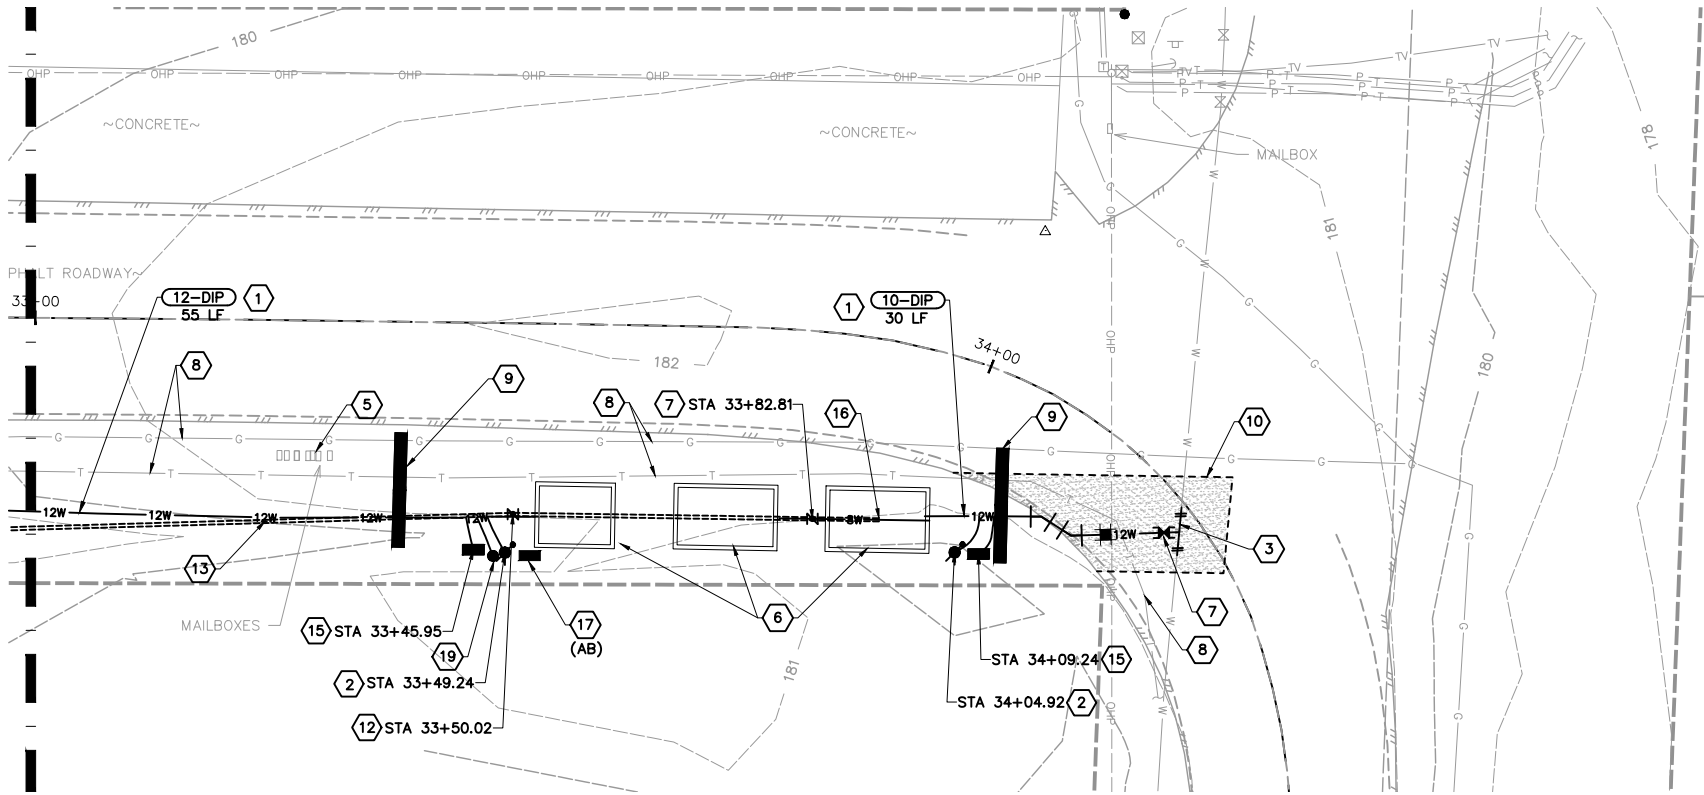


NOTE: CONTRACTOR TO POTHOLE AT THE BEGINNING OF CONSTRUCTION AND EXPOSE EXISTING COB 16 INCH WATER MAIN.

ANTICIPATED DEPTH TO TOP OF MAIN IS 9 FT.

FOR BOTH INITIAL POTHOLING AND EXCAVATION DURING CONNECTION TO EXISTING SYSTEM, CONTRACTOR SHALL EXCAVATE AND PROVIDE SUFFICIENT TRENCH SAFETY AND SHORING TO SAFELY ENTER EXCAVATION.


EXCAVATION FOR CONNECTION TO EXISTING SYSTEM SHALL FOLLOW COB STANDARD DETAIL WA-872.

CONTRACTOR TO CONTACT ENGINEER IF CONDITIONS VARY SIGNIFICANTLY FROM THE CONDITIONS SHOWN ON THE PLANS

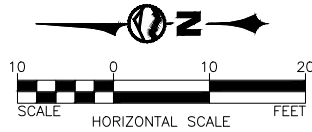

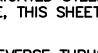
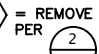
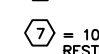
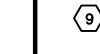






Ferndale - Water System Emergency Intertie - HDPE Weld Location Asbuilts

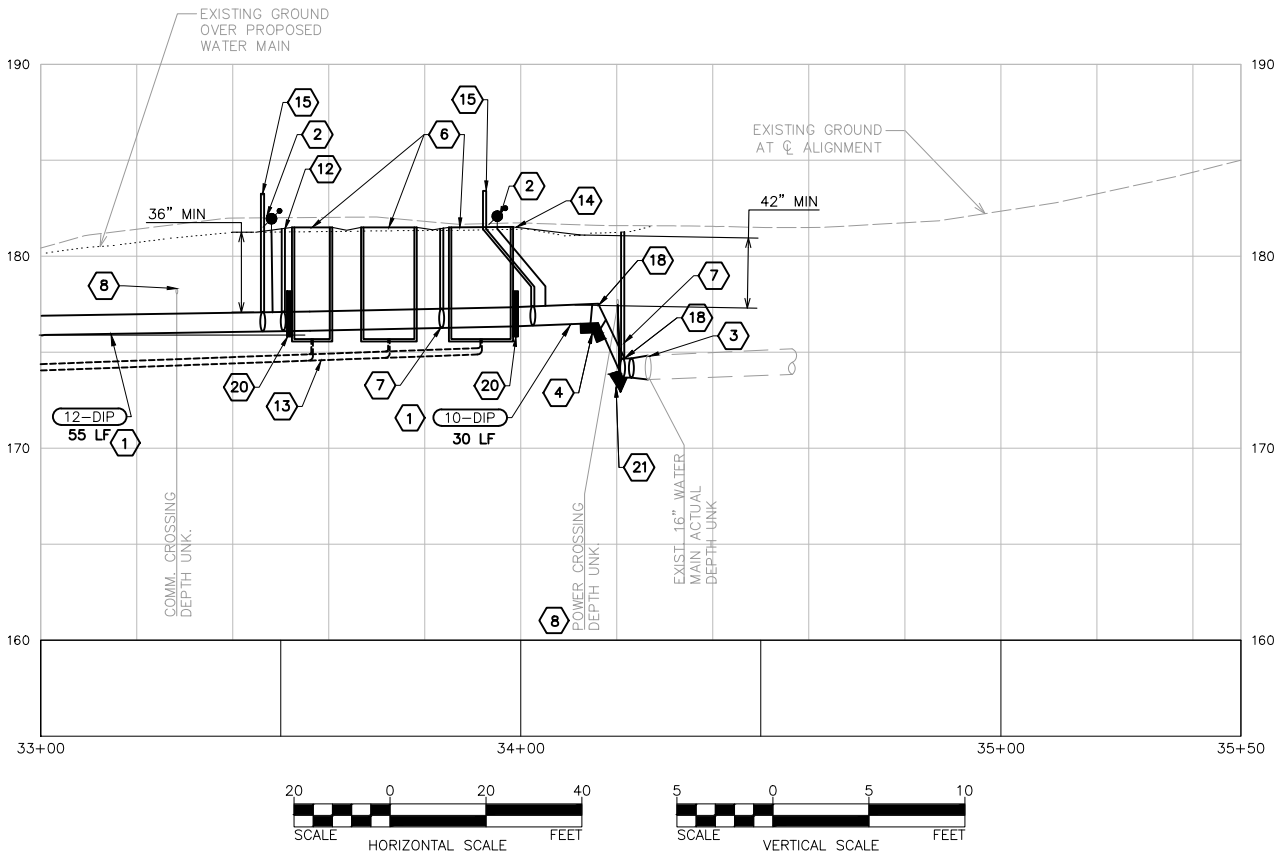Weld # per Data Logger	Northing	Easting	Elevation	Description
1	664946.03	1225700.12	102.5	TOP PIPE @ WELD
2	664995.11	1225699.40	100.9	TOP PIPE @ WELD
3	665043.08	1225699.19	100.9	TOP PIPE @ WELD
4	665092.90	1225698.64	100.9	TOP PIPE @ WELD
5	665142.58	1225698.77	100.6	TOP PIPE @ WELD
6	665294.75	1225699.80	101.3	TOP PIPE @ WELD
7	665344.60	1225699.40	101.6	TOP PIPE @ WELD
8	665394.48	1225699.10	101.3	TOP PIPE @ WELD
9	665444.82	1225699.81	99.4	TOP PIPE @ WELD
11	665868.05	1225703.54	84.1	TOP PIPE @ WELD
12	665917.38	1225705.54	81.8	TOP PIPE @ WELD
13	665967.33	1225705.35	79.4	TOP PIPE @ WELD
14	666017.18	1225703.49	78.0	TOP PIPE @ WELD
15	666066.77	1225704.20	76.4	TOP PIPE @ WELD
16	665568.46	1225701.46	93.7	TOP PIPE @ WELD
17	665618.21	1225701.17	92.1	TOP PIPE @ WELD
18	665668.40	1225702.83	91.2	TOP PIPE @ WELD
19	665718.48	1225703.67	90.8	TOP PIPE @ WELD
20	665768.21	1225703.88	89.6	TOP PIPE @ WELD
21	666390.32	1225708.37	68.3	TOP PIPE @ WELD
22	666440.18	1225709.07	67.7	TOP PIPE @ WELD
23	666490.18	1225710.11	67.1	TOP PIPE @ WELD
24	666540.13	1225709.38	66.9	TOP PIPE @ WELD
25	666589.81	1225710.65	67.3	TOP PIPE @ WELD
26	666640.86	1225710.10	67.3	TOP PIPE @ WELD
35	666188.64	1225699.07	73.1	TOP PIPE @ WELD
36	666238.12	1225699.96	72.1	TOP PIPE @ WELD
39	666288.24	1225699.74	70.9	TOP PIPE @ WELD
40	666346.22	1225708.16	69.2	TOP PIPE @ WELD
41	665817.98	1225702.93	87.0	TOP PIPE @ WELD
42	663645.04	1225699.04	171.7	TOP PIPE @ WELD
43	663694.93	1225699.49	168.9	TOP PIPE @ WELD
44	663744.84	1225699.45	167.2	TOP PIPE @ WELD
45	663794.80	1225699.76	164.9	TOP PIPE @ WELD
46	663844.64	1225700.21	161.8	TOP PIPE @ WELD
47	664534.44	1225699.94	120.2	TOP PIPE @ WELD
48	664584.26	1225700.33	117.7	TOP PIPE @ WELD
49	664634.19	1225700.31	115.6	TOP PIPE @ WELD
50	664683.11	1225703.61	x	TOP PIPE @ WELD
51	664733.67	1225701.29	111.5	TOP PIPE @ WELD
52	664796.73	1225700.34	109.1	TOP PIPE @ WELD
53	664846.72	1225700.28	107.0	TOP PIPE @ WELD
55	665244.92	1225699.79	101.1	TOP PIPE @ WELD
56	665194.17	1225700.38	x	TOP PIPE @ WELD
57	665519.22	1225700.56	96.5	TOP PIPE @ WELD
58	665191.49	1225700.16	x	TOP PIPE @ WELD
59	664896.15	1225700.45	104.8	TOP PIPE @ WELD
60	664484.54	1225699.59	121.4	TOP PIPE @ WELD
61	664747.14	1225701.01	110.7	TOP PIPE @ WELD
63	664481.15	1225699.54	121.4	TOP PIPE @ WELD
64	664431.46	1225699.23	123.9	TOP PIPE @ WELD
65	664381.46	1225699.34	125.2	TOP PIPE @ WELD
66	664331.52	1225699.16	126.4	TOP PIPE @ WELD
67	664282.72	1225698.68	128.3	TOP PIPE @ WELD
68	664232.77	1225698.70	131.2	TOP PIPE @ WELD
69	663992.05	1225700.14	151.0	TOP PIPE @ WELD
70	663942.33	1225700.29	154.5	TOP PIPE @ WELD
75	663995.23	1225700.19	150.8	TOP PIPE @ WELD
78	663894.42	1225701.02	158.3	TOP PIPE @ WELD
80	663589.01	1225698.55	174.8	TOP PIPE @ WELD
81	663601.62	1225699.08	174.1	TOP PIPE @ WELD
82	663607.88	1225699.17	173.7	TOP PIPE @ WELD

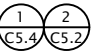

NO.	REVISIONS	BY	DATE

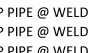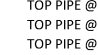- KEYED NOTES**
- 1 = PROPOSED 12" DIP WATER MAIN INTERTIE PER 
  - 2 = 2" COMBINATION AIR/VACUUM RELIEF ASSEMBLY. LOCATE AT HIGH POINTS, EITHER SIDE OF VAULTS, PER 
  - 3 = TIE INTO EXISTING CITY OF BELLINGHAM WATER LINE WITH 16x10 FABRICATED STEEL TAPPING SLEEVE SEE NOTE, THIS SHEET
  - 4 = REVERSE THRUST BLOCK PER COF DETAIL W-5 BUT WITH BENT #4 REBAR INSTEAD OF PIPE CLAMP (AB)
  - 5 = REMOVE AND REINSTALL MAILBOX PER 
  - 6 = PROPOSED VAULTS PER 
  - 7 = 10" GATE VALVE WITH RESTRAINED JOINTS
  - 8 = PROTECT EXISTING UTILITIES IN PLACE
  - 9 = INSTALL STRAW WATTLE CHECK DAM PER 
  - 10 = SAWCUT, REMOVE, AND REPLACE ASPHALT TOTAL SAWCUTTING, THIS SHEET: 52 LF TOTAL ASPHALT, THIS SHEET: 195 SF PER 
  - 11 = INSTALL (1) BOLLARD PER (NOT INSTALLED, AB) 
  - 12 = 12" BUTTERFLY VALVE
  - 13 = ROUTE 4" PVC VAULT DRAINS NORTH TO ROADSIDE DITCH AT 2% PER 
  - 14 = TOP OF VAULTS AT ELEV. 181.50. GRADE AWAY FROM VAULTS AT 3:1 SLOPE TO EXISTING GRADE (TYP)
  - 15 = WATER SAMPLING STATION PER 
  - 16 = CONTRACTOR TO INSTALL VAULT WITH PIPING. CITY CREW TO CUT IN METER AFTER APPROVAL FOR SERVICE
  - 17 = TRACER WIRE PEDESTAL PER 
  - 18 = DIP 10" VERTICAL 45° BENDS
  - 19 = AUTOMATIC FLUSHING UNIT, MUELLER HYDRO-GUARD FC100, INSTALLED PER MANUFACTURER INSTALLATION INSTRUCTIONS, WITH 2" SADDLE & 2" BURIED GATE VALVE WITH VALVE BOX FOR ISOLATION (AB)
  - 20 = PIPE ANCHOR & CONCRETE (AB)
  - 21 = STANDARD CONCRETE THRUST BLOCK PER COF DETAIL W-2 (AB)

- NOTES**
1. ALL SOILS ON SITE ARE WHATCOM/WHATCOM-LABOUNTY SILT LOAM.
  2. EXISTING VEGETATIVE COVER OF ROADSIDE DITCHES ARE GRASSES AND NATIVE COVER PLANTS.
  3. ALL DISTURBED AREA TO BE PERMANENTLY SEEDED WITH NATIVE SEED MIX AFTER CONSTRUCTION IS COMPLETE
  4. ALL WATER MAIN JOINTS SHALL BE RESTRAINED



RECORD DRAWINGS

**WILSON**  
ENGINEERING



DESIGNED BY: BMS  
DRAWN BY: JGS  
CHECKED BY: AWL


CITY OF FERNDAL

WATER SYSTEM EMERGENCY INTERTIE

PLAN AND PROFILE STA 33+00 - 36+20


DATE: 5-31-23  
SCALE: AS SHOWN  
JOB NUMBER: 2021-091

SHEET: C3.8  
PAGE: 17 OF 25

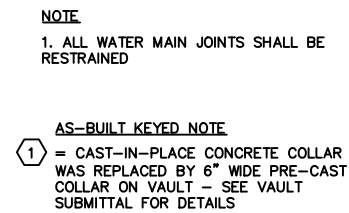


## RECORD DRAWINGS

PLOT SETTINGS: WE AutoCAD PDF (General Documentation)pc3, WILSON 11X17, Portrait, 1:2, WE APWA\_UNSCREENED.ctb  
W:\2021\2021-091 FERNDAL WATER MAIN INTERTIE\DWG\AS-BUILT\TAB V2019\_2021-091 C5.2 CIVIL DETAILS.DWG - 5/31/2023 11:21 AM - Jeff Smith

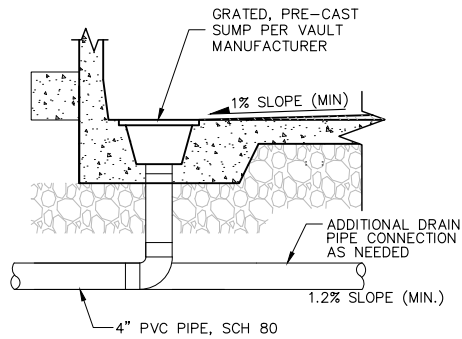


1 TYPICAL VAULT/FLOOR DRAIN  
NOT TO SCALE

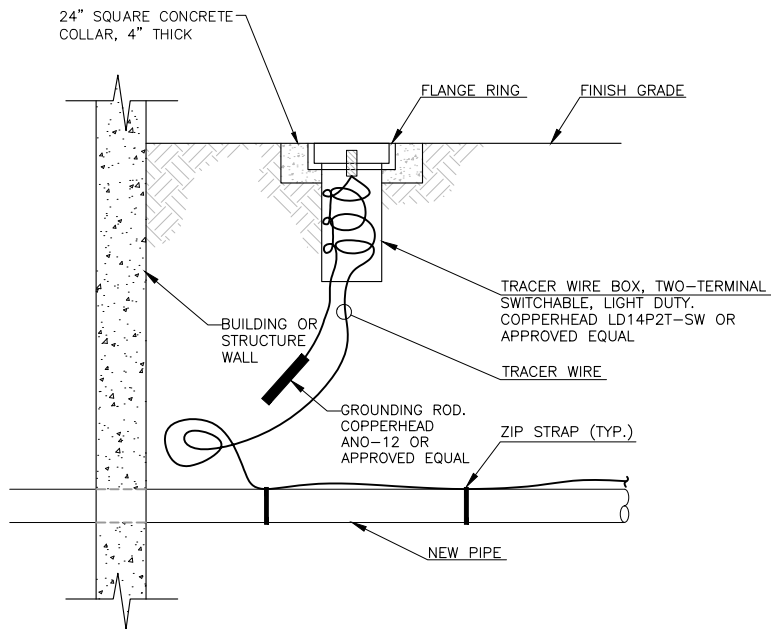


1. TRACER WIRE SHALL BE ZIP-STRAPPED TO THE PIPE AT 6-FOOT INTERVALS
2. TRACER WIRE SHALL BE CONTINUOUS WITH NO SPLICES UNLESS AUTHORIZED BY THE ENGINEER. IF WIRE REQUIRES SPLICING, SPLICES SHALL BE WITH A SPLICE CONNECTOR DESIGNED FOR DIRECT BURY APPLICATION FILLED WITH MOISTURE DISPLACING SILICONE FOR CORROSION RESISTANCE PROTECTION, COPPERHEAD MAINLINE-TO-SERVICE CONNECTOR, PART NUMBER 3WB-01 OR APPROVED EQUAL
3. TRACER WIRE CONNECTIONS AT THE TRACER WIRE BOX SHALL BE WRAPPED WITH CORROSION RESISTANT TAPE.
4. LOOP 18"-24" OF EXTRA TRACER WIRE AT BOTH THE PIPE AND THE TRACER WIRE BOX.
5. CONTRACTOR SHALL PERFORM A CONDUCTIVITY/LOCATE UPON COMPLETION OF THE INSTALLATION.
6. TRACER WIRE IS TO BE PROVIDED FOR ALL NEW PIPING, AS SHOWN ON PLANS. BOXES TO BE LOCATED NEXT TO ALL BUILDINGS OR STRUCTURES WHERE PIPE ENTERS. FINAL LOCATIONS TO BE SUBMITTED TO THE ENGINEER.
7. TRACER WIRE SHALL BE COPPERHEAD SOLOSHOT 1245EHS OR APPROVED EQUAL FOR HORIZONTAL DIRECTIONAL DRILLING APPLICATIONS. JACKET COLOR PURPLE.

2 TRACER WIRE SYSTEM DETAILS  
NOT TO SCALE

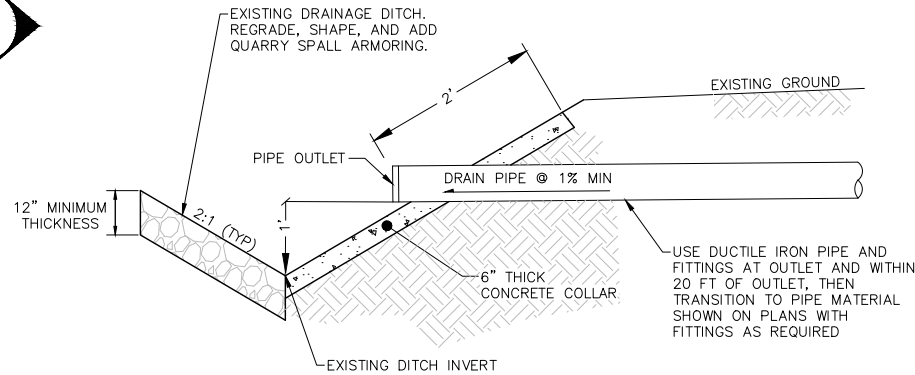


3 PIPE OUTLET PROTECTION  
NOT TO SCALE

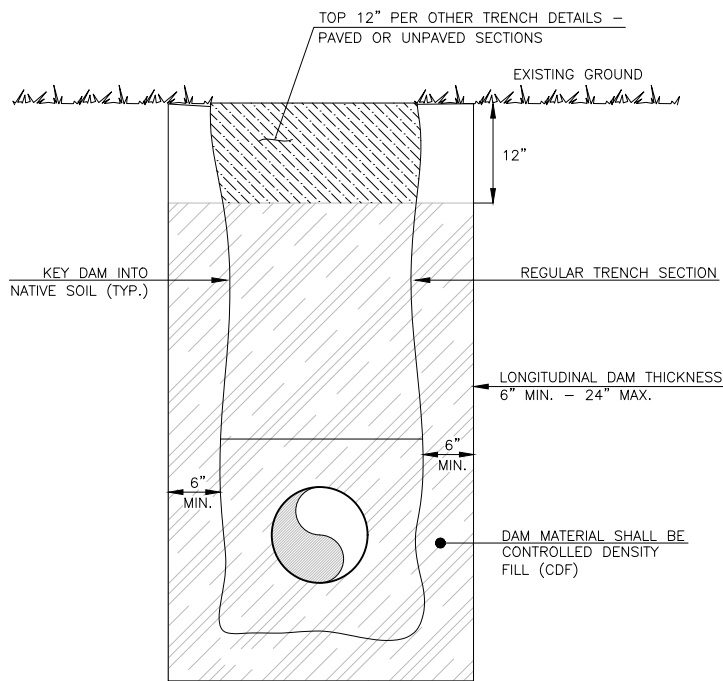


- NOTES:
1. SEE PLAN AND PROFILE SHEETS FOR LOCATIONS OF DAMS.

4 TRENCH DAM  
NOT TO SCALE

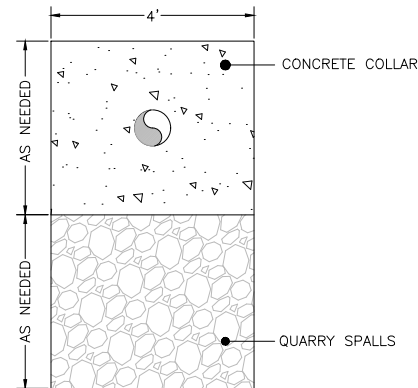

SECTION B

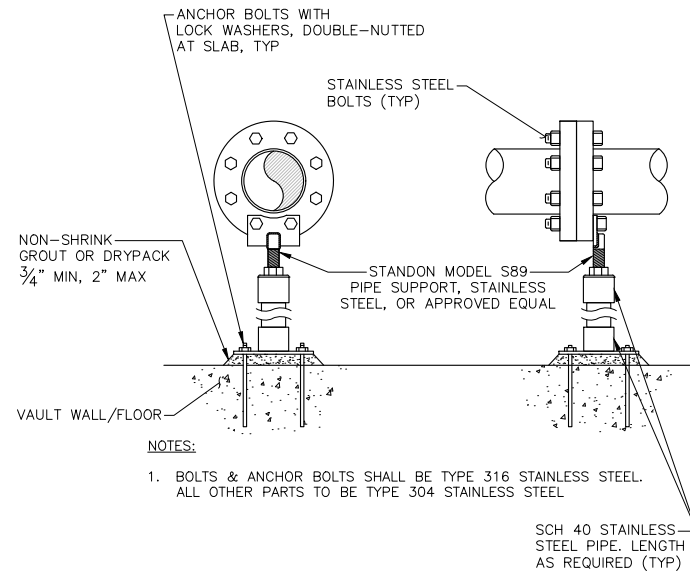

- NOTES:
1. BOLTS & ANCHOR BOLTS SHALL BE TYPE 316 STAINLESS STEEL. ALL OTHER PARTS TO BE TYPE 304 STAINLESS STEEL

SCH 40 STAINLESS STEEL PIPE. LENGTH AS REQUIRED (TYP)


5 SUPPORT DETAIL  
NOT TO SCALE

RECORD DRAWINGS

NO.		REVISIONS	BY	DATE
<b>WILSON</b> ENGINEERING				
WILSONENGINEERING.COM				
DESIGNED BY	BMS	DRAWN BY	JGS	CHECKED BY
				AWL
CITY OF FERNDAL		WASHINGTON		
FERNDAL		WATER SYSTEM EMERGENCY INTERTIE		
DATE		CIVIL DETAILS (1)		
5-31-23				
SCALE				
AS SHOWN				
JOB NUMBER				
2021-091				
SHEET				
C5.2				
PAGE				
19				
OF				
25				




PLOT SETTINGS: WE Autocad PDF (General Documentation).pc3, WILSON 11X17, Portrait, 1:2, WE APWA\_UNSCREENED.ctb  
W:\2021\2021-091 FERNDAL WATER MAIN INTERIE.DWG AS-BUILT\TAB V2019\_2021-091 C5.2 CIVIL DETAILS.DWG - 5/31/2023 11:21 AM - Jeff Smith

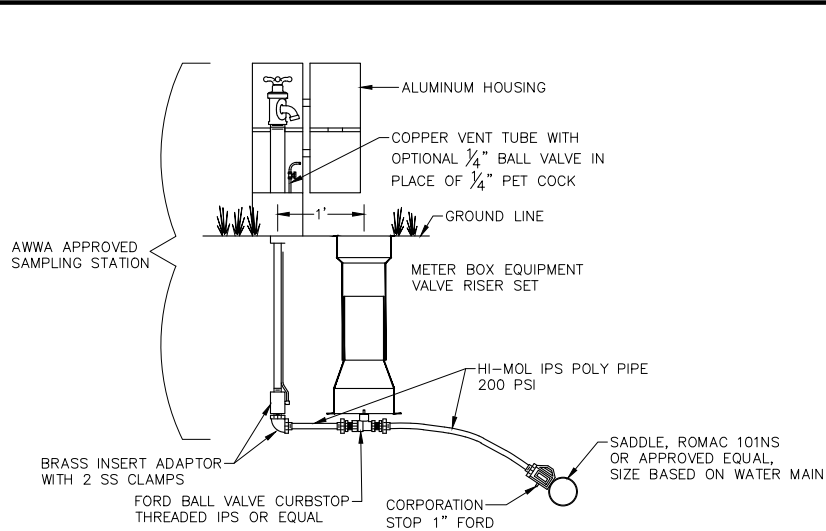

1. SAMPLING STATIONS SHALL BE A 2.5' BURY, WITH A 3/4" FIP INLET, AND A (3/4" HOSE OR UNTHREADED) NOZZLE.
2. ALL STATIONS SHALL BE ENCLOSED IN A LOCKABLE, NONREMOVABLE, ALUMINUM-CAST HOUSING. HOUSING SHALL BE PAINTED GREEN.
3. WHEN OPENED, THE STATION SHALL REQUIRE NO KEY FOR OPERATION, AND THE WATER WILL FLOW IN AN ALL BRASS WATERWAY.
4. ALL WORKING PARTS WILL ALSO BE OF BRASS AND BE REMOVABLE FROM ABOVE GROUND WITH NO DIGGING. EXTERIOR PIPING SHALL BE GALVANIZED STEEL (BRASS PIPE ALSO AVAILABLE).
5. A COPPER VENT TUBE WILL ENABLE EACH STATION TO BE PUMPED FREE OF STANDING WATER TO PREVENT FREEZING AND TO MINIMIZE BACTERIA GROWTH.
6. SAMPLING STATION SHALL BE ECLIPSE NO. 88, MANUFACTURED BY KUPFERLE FOUNDRY, ST. LOUIS, MO 63102.


## 1 WATER SAMPLING STATION

NOT TO SCALE

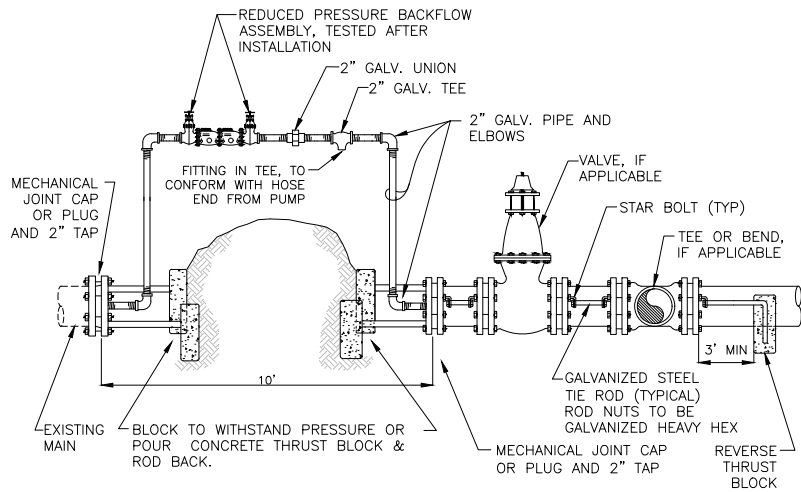


## 2 PRESSURE TESTING / FLUSHING CONNECTION

NOT TO SCALE

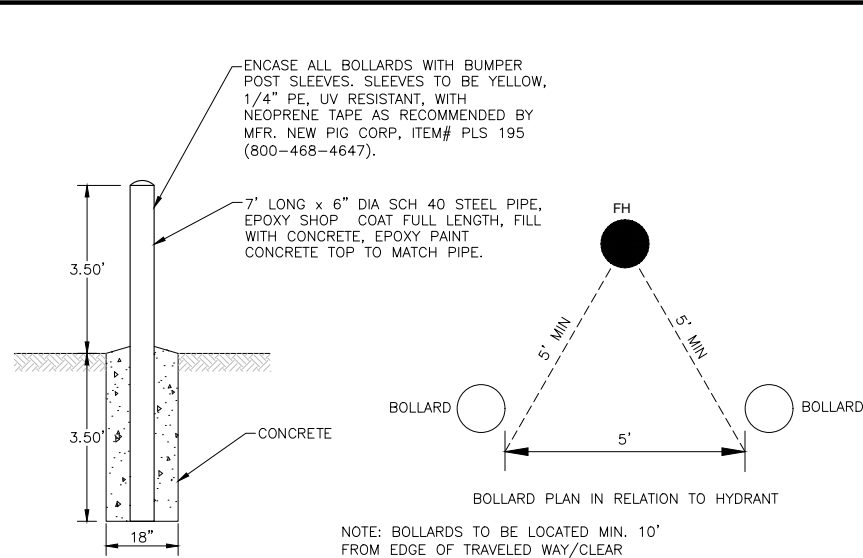



## 3 BOLLARD DETAIL

NOT TO SCALE

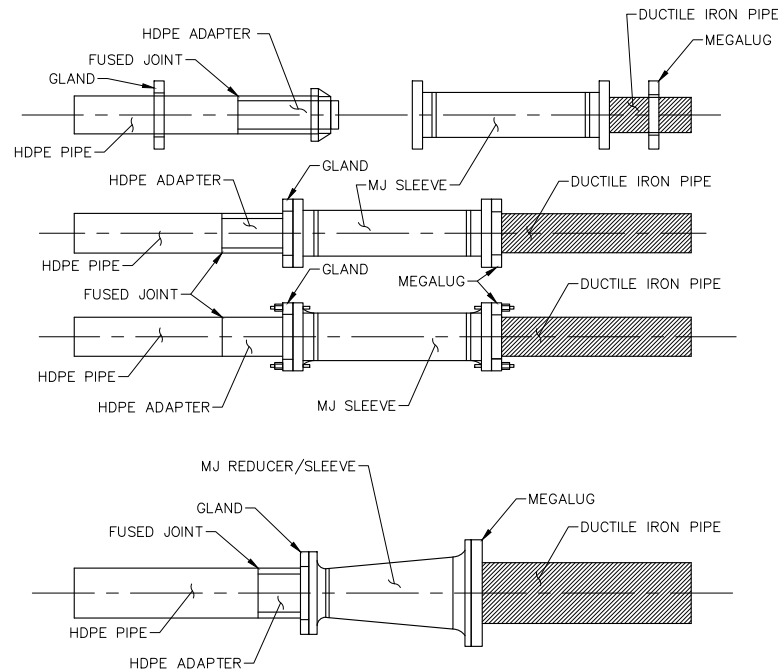

## 4 HDPE TO DIP TRANSITION DETAIL

NOT TO SCALE

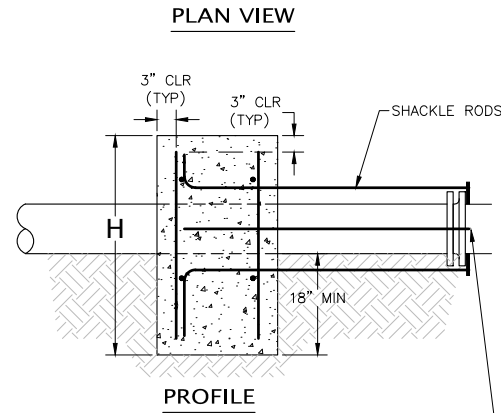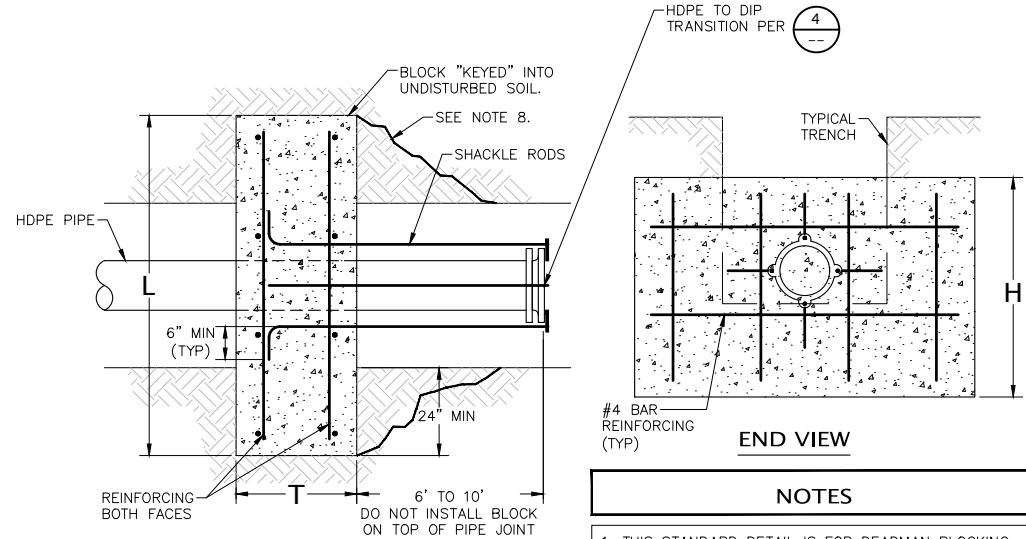

SIZING TABLE				
PIPE DIA	T (min)	H (min)	SHACKLE RODS	REINFORCING
6"	18"	36"	(4) 5/8" dia	#4 @ 10" OC EW
8"	18"	42"	(4) 3/4" dia	#4 @ 12" OC EW
10"	24"	52"	(6) 3/4" dia	#4 @ 12" OC EW
12"	24"	54"	(6) 7/8" or (8) 3/4" dia	#4 @ 8" OC EW
14"	24"	56"	(8) 7/8" or (10) 3/4" dia	#4 @ 6" OC EW
16"	30"	58"	(10) 7/8" dia	#4 @ 5" OC EW

BLOCK SIZES GOOD TO MAXIMUM 300psi TEST PRESSURE

- ### NOTES
1. THIS STANDARD DETAIL IS FOR DEADMAN BLOCKING ONLY.
  2. CONCRETE BLOCK SHALL BE PER APWA SPECIFICATION 7-11.3(13), CURRENT EDITION.
  3. MAINTAIN 18" MINIMUM COVER OVER THE TOP OF BLOCK.
  4. BOTTOM OF BLOCK IS TO BE ON UNDISTURBED SOIL.
  5. TRENCH TO BE BACKFILLED WITH CRUSHED ROCK, COMPACTED TO FIRM AND UNYIELDING CONDITION ON ALL SIDES OF BLOCK AND A DISTANCE OF 4' MIN. IN FRONT OF BLOCK TO FULL DEPTH OF BLOCK.
  6. UPON EXTENSION OF WATER MAIN, SHACKLE RODS ARE TO BE CUT, REMOVE PLUG. CONCRETE BLOCK TO REMAIN IN PLACE.
  7. FOR SOIL CONDITIONS NOT SHOWN, BLOCK IS TO BE DESIGNED BY ENGINEER.
  8. IF BLOCK CANNOT BE KEYED INTO UNDISTURBED SOIL TO THE SATISFACTION OF THE ENGINEER,
    - a) THE BLOCK LENGTH SHALL BE EXTENDED TO PROVIDE AN ADEQUATE KEY OR
    - b) CDF SHALL BE USED TO FILL BACK TO NATIVE SOIL OR
    - c) THE TRENCH SHALL BE BACKFILLED AND COMPACTED TO FIRM AND UNYIELDING CONDITION A MINIMUM DISTANCE OF 15 FEET IN FRONT OF THE BLOCK TO THE SATISFACTION OF THE DISTRICT ENGINEER.
  9. SHACKLE RODS AND NUTS TO BE STAINLESS STEEL OR HOT DIP GALVANIZED WITH ASPHALTIC COATING APPLIED AFTER INSTALLATION.

MIN. BLOCK LENGTH (L)						
SOIL CONDITION						
PIPE Ø	SOFT CLAY	SILT	SANDY SILT	SAND	SANDY CLAY	HARD CLAY
6"	84"	72"	72"	72"	72"	72"
8"	108"	84"	75"	75"	75"	75"
10"	132"	104"	77"	77"	77"	77"
12"	180"	138"	82"	80"	80"	80"
14"	228"	174"	102"	82"	82"	82"
16"	288"	216"	126"	100"	84"	84"


## 5 REVERSE THRUST BLOCK DETAIL

NOT TO SCALE


RECORD DRAWINGS




PLOT SETTINGS: WE AutoCAD PDF (General Documentation).pc3, WILSON 11X17, Portrait, 1:2, WE APWA\_UNSCREENED.ctb  
W:\2021\2021-091 FERNDAL WATER MAIN INTERTIE.DWG AS-BUILT\TAB V2019\_091 CS.2 CIVIL DETAILS.DWG - 5/31/2023 11:21 AM - Jeff Smith

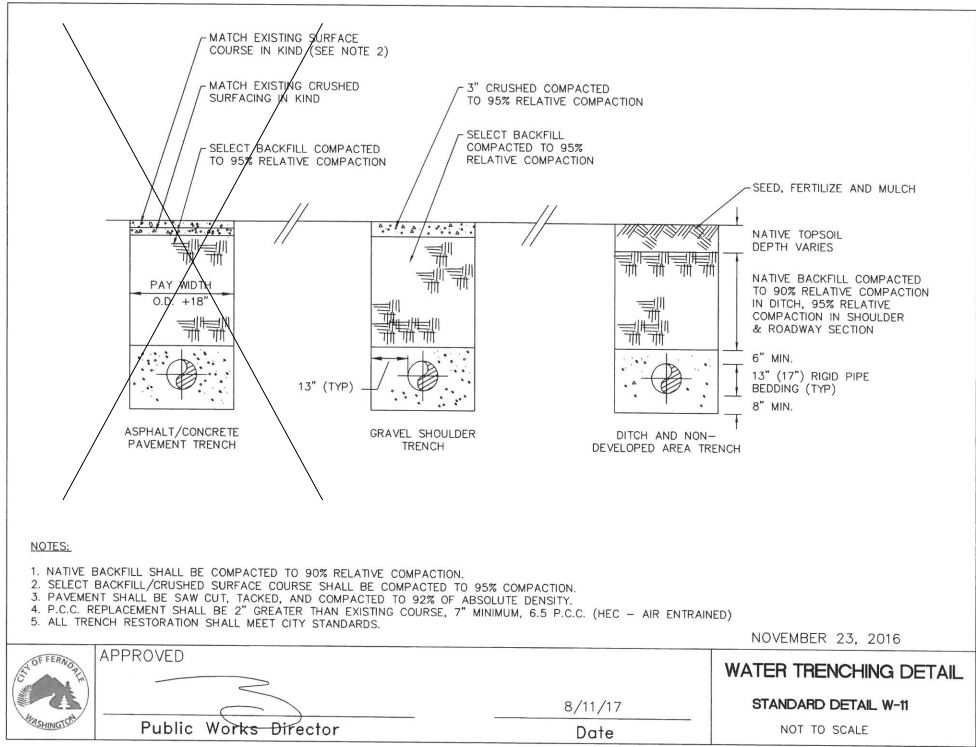

1 WATER TRENCHING DETAIL  
NOT TO SCALE

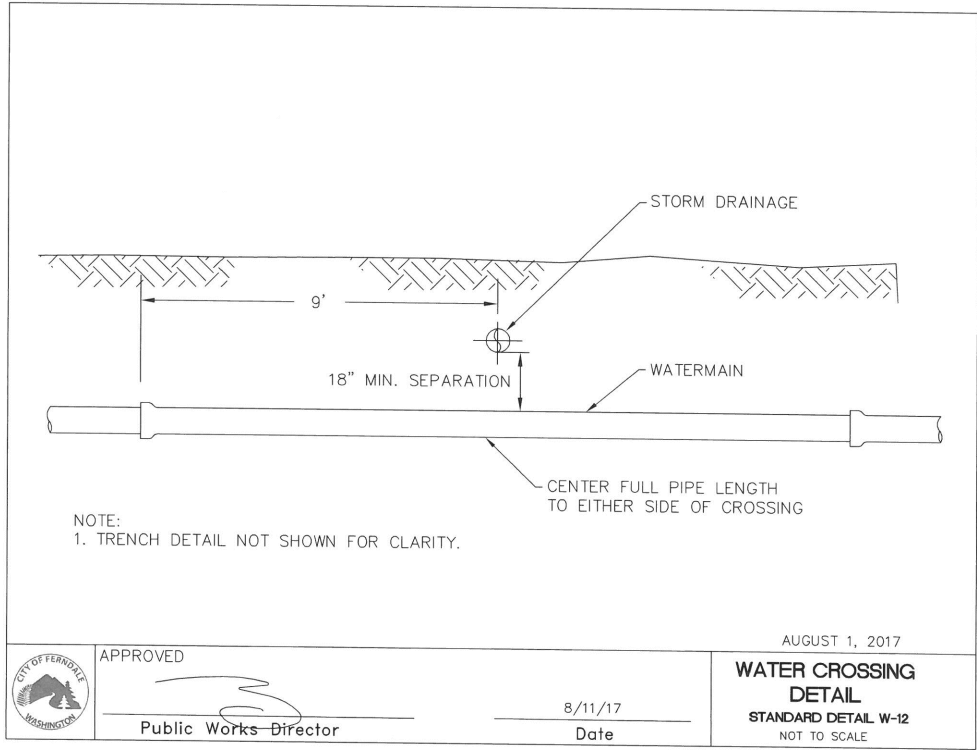

2 WATER CROSSING DETAIL  
NOT TO SCALE

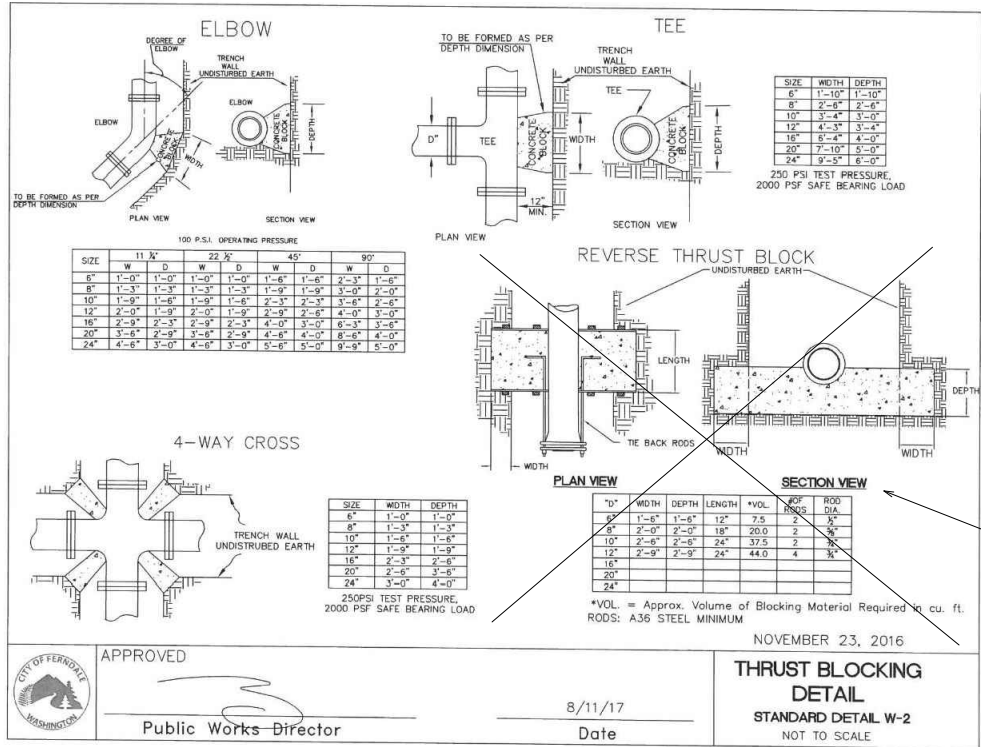

3 THRUST BLOCKING DETAIL  
NOT TO SCALE

RECORD DRAWINGS


NO.		REVISIONS		BY	DATE

**WILSON**  
ENGINEERING  
WILSONENGINEERING.COM


DESIGNED BY	BMS	DRAWN BY	JGS	CHECKED BY	AWL
CITY OF FERNDAL					
WASHINGTON					
FERNDAL					
WATER SYSTEM EMERGENCY INTERTIE					
CIVIL DETAILS (3)					
SHEET	C5.4	DATE	5-31-23	SCALE	AS SHOWN
PAGE	21	JOB NUMBER	2021-091		
	OF				
	25				

PLOT SETTINGS: WE AutoCAD PDF (General Documentation)pc3, WILSON 11X17, Portrait, 1:2, WE APWA\_UNSCREENED.ctb  
W:\2021\2021-091 FERNDAL WATER MAIN INTERTIE\DWG\AS-BUILT\TAB V2019\_081 05.2 CIVIL DETAILS.DWG - 5/31/2023 11:21 AM - Jeff Smith

NO.	REVISIONS	BY	DATE

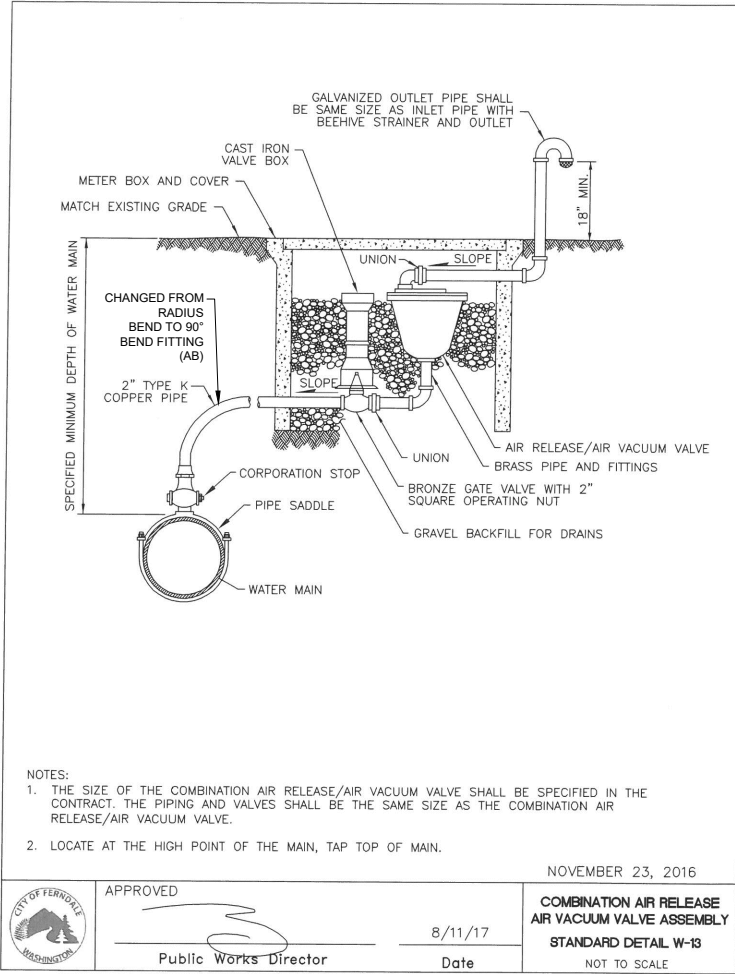


**1** COMBINATION AIR RELEASE/AIR VACUUM VALVE ASSEMBLY  
NOT TO SCALE

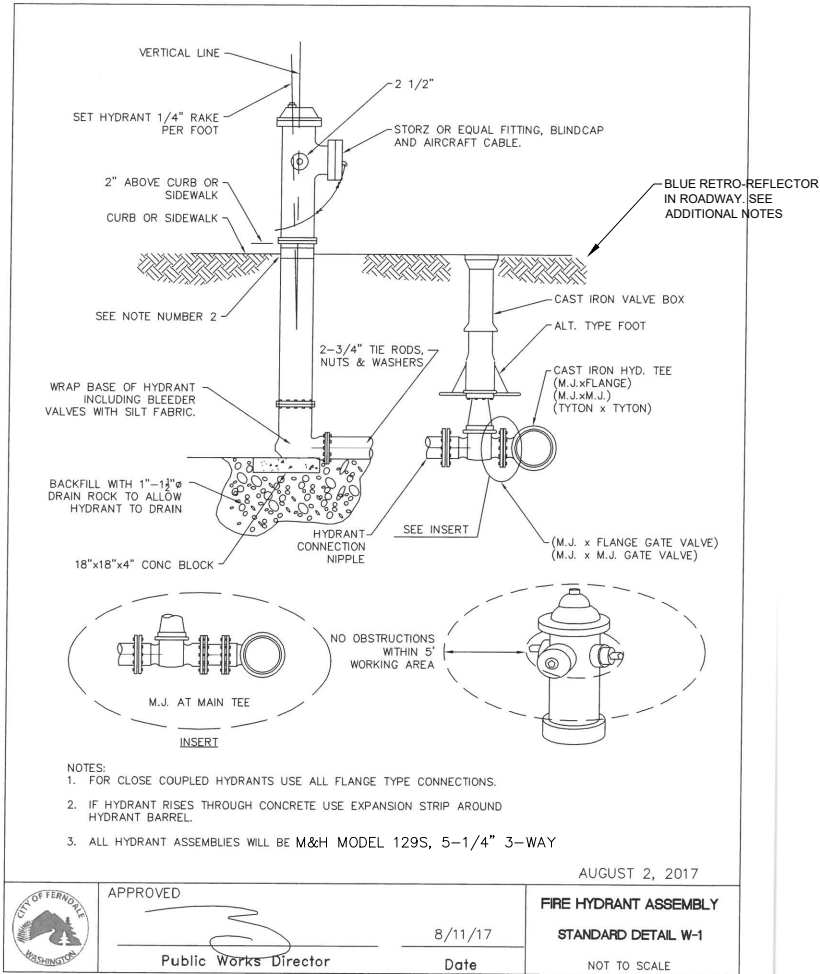

**ADDITIONAL NOTES**  
1. A BLUE-RETROREFLECTORS RPM SHALL BE INSTALLED WHERE A FIRE HYDRANT IS LOCATED WITHIN THE ROADWAY OR STREET RIGHT-OF-WAY.  
2. ALL BLUE-RETROREFLECTORS RPMS SHALL BE TWO-WAY MARKERS VISIBLE IN BOTH DIRECTIONS OF TRAVEL.  
3. A BLUE-RETROREFLECTORS RPM SHALL BE PLACED AT AN APPROXIMATELY RIGHT ANGLE TO THE FIRE HYDRANT LOCATION.

**2** FIRE HYDRANT ASSEMBLY  
NOT TO SCALE

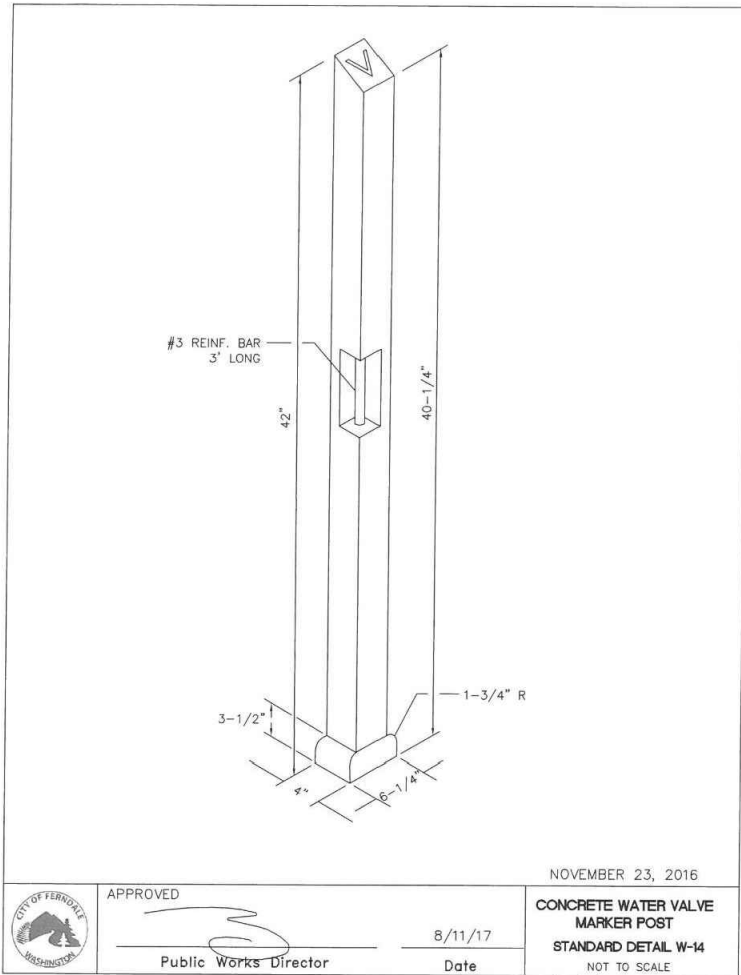

**3** CONCRETE WATER VALVE MARKER POST  
NOT TO SCALE


RECORD DRAWINGS

SHEET <b>C5.5</b>	DATE 5-31-23	CITY OF FERNDAL  FERNDAL  WATER SYSTEM EMERGENCY INTERTIE  CIVIL DETAILS (4)	DESIGNED BY BMS	NO. 1
	SCALE AS SHOWN		REVISIONS	
	JOB NUMBER 2021-091		BY	
	PAGE 22 OF 25		DATE	


**WILSON**  
ENGINEERING  
WILSONENGINEERING.COM




PLOT SETTINGS: WE AutoCAD PDF (General Documentation).pc3, WILSON 11X17, Portrait, 1:2, WE APWA\_UNSCREENED.ctb  
W:\2021\2021-091 FERNDAL WATER MAIN INTERTIE.DWG AS-BUILT.VAB V2019\_081 05.2 CIVIL DETAILS.DWG - 5/31/2023 11:21 AM - Jeff Smith

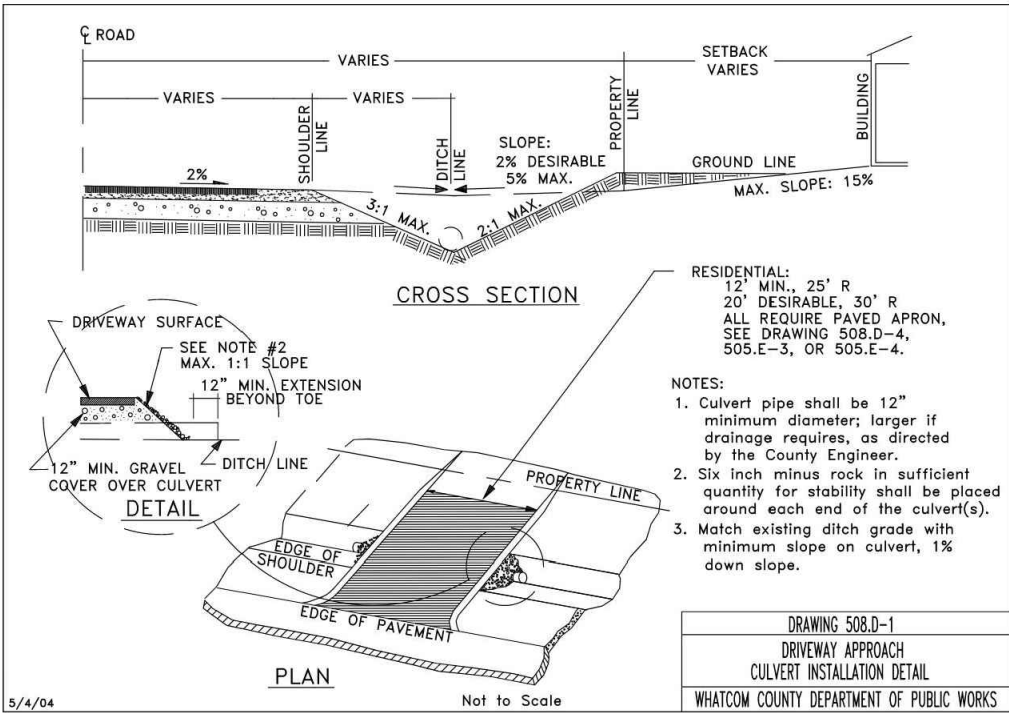


1 DRIVEWAY APPROACH CULVERT INSTALLATION  
NOT TO SCALE

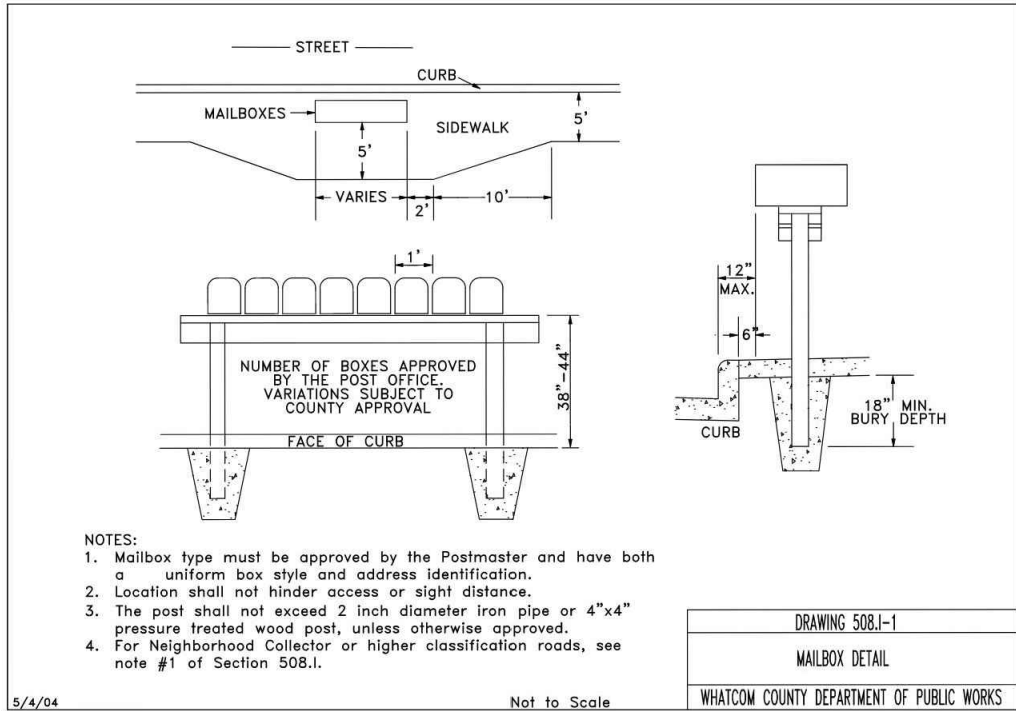

2 MAILBOX DETAIL  
NOT TO SCALE

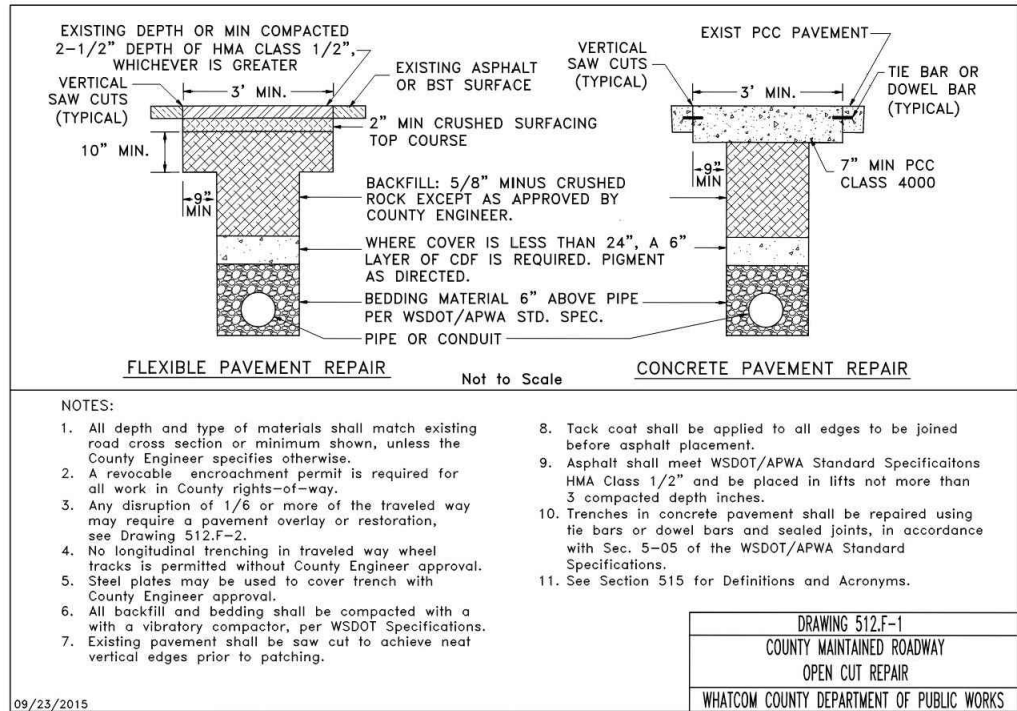

3 ROADWAY OPEN CUT REPAIR  
NOT TO SCALE

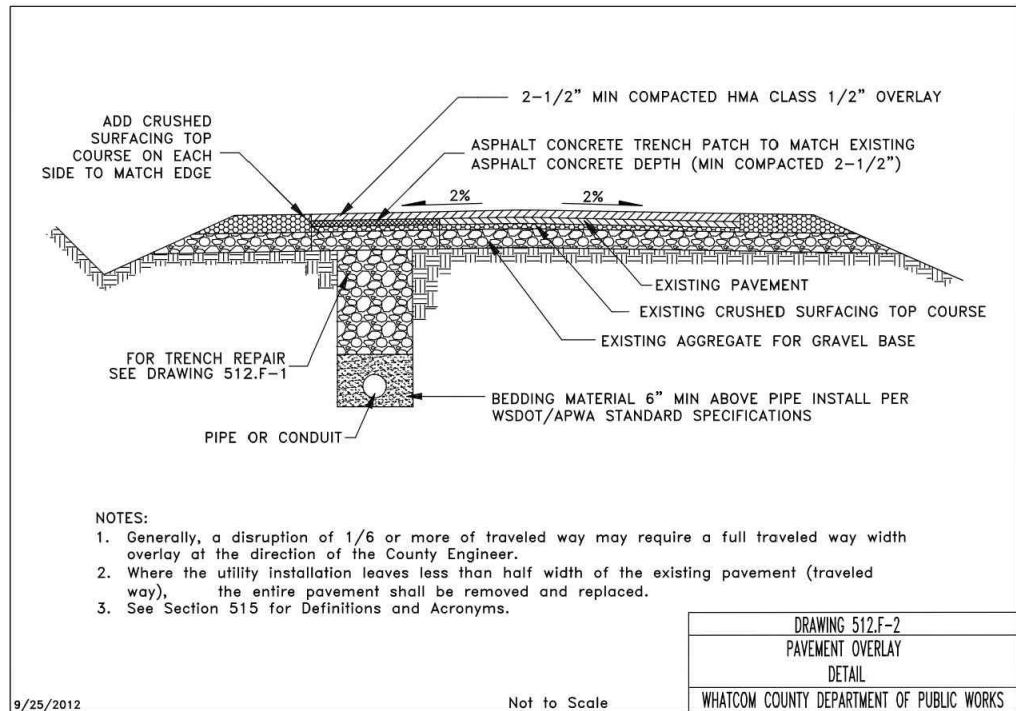

4 PAVEMENT OVERLAY DETAIL  
NOT TO SCALE


RECORD DRAWINGS

NO.		REVISIONS		BY	DATE


**WILSON**  
ENGINEERING  
WILSONENGINEERING.COM

DESIGNED BY	BMS	DRAWN BY	JGS	CHECKED BY	AWL
CITY OF FERNDAL					
WATER SYSTEM EMERGENCY INTERTIE					
FERNDAL					
DATE	5-31-23	SCALE	AS SHOWN	JOB NUMBER	2021-091
SHEET	C5.6	PAGE	23	OF	25

PLOT SETTINGS: WE AutoCAD PDF (General Documentation)pc3, WILSON 11X17, Portrait, 1:2, WE APWA\_UNSCREENED.ctb  
W:\2021\2021-091 FERNDAL WATER MAIN INTERTIE\DWG\AS-BUILT\TAB V2019\_2021-091 05.2 CIVIL DETAILS.DWG - 5/31/2023 11:21 AM - Jeff Smith

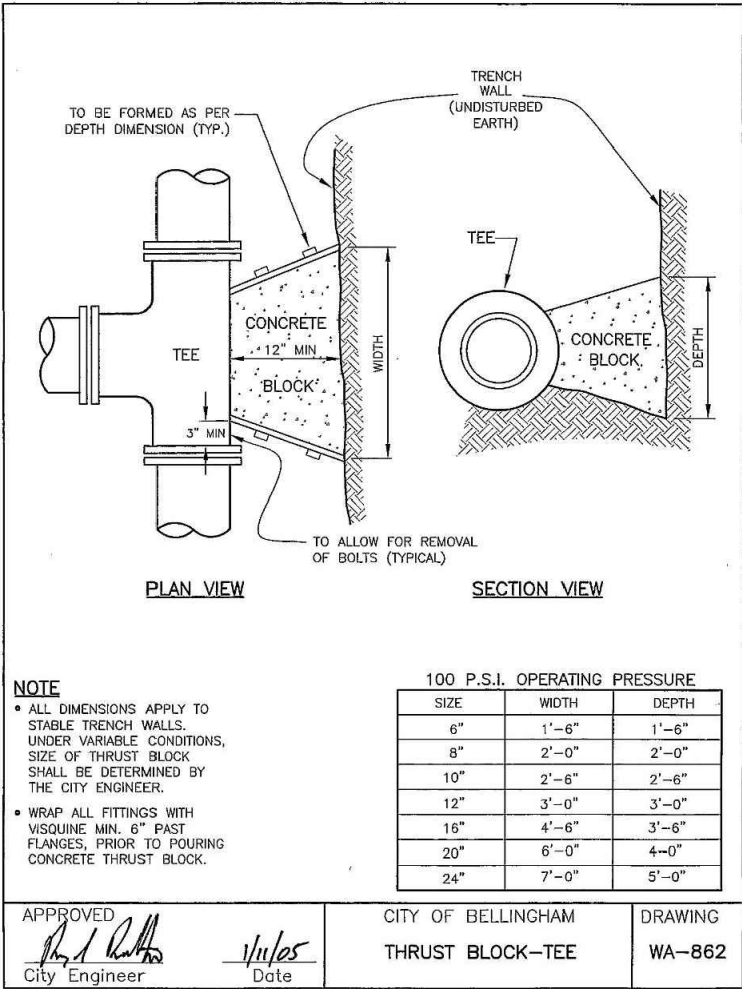

1 THRUST BLOCK - TEE  
NOT TO SCALE

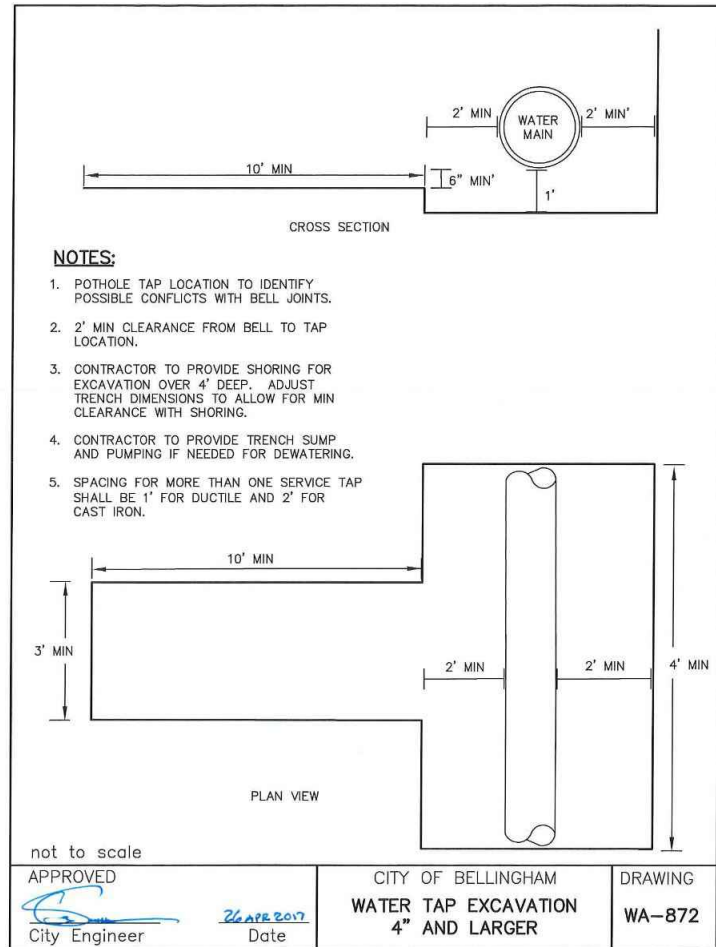


2 WATER TAP EXCAVATION  
NOT TO SCALE

NO.	REVISIONS	BY	DATE

WILSON  
ENGINEERING

WILSONENGINEERING.COM



DESIGNED BY  
BMS

DRAWN BY  
JGS

CHECKED BY  
AWL

CITY OF FERNDAL

FERNDAL

WATER SYSTEM EMERGENCY INTERTIE

CIVIL DETAILS (6)

DATE  
5-31-23

SCALE  
AS SHOWN

JOB NUMBER  
2021-091

SHEET  
C5.7

PAGE  
24 OF 25

RECORD DRAWINGS

PLOT SETTINGS: WE AutoCAD PDF (General Documentation).pc3, WILSON 11X17, Portrait, 1:2, WE APWA\_UNSCREENED.ctb  
W:\2021\2021-091 FERNDAL WATER MAIN INTERIE.DWG AS-BUILT.VAB V2019\_2021-091 C5.2 CIVIL DETAILS.DWG - 5/31/2023 11:21 AM - Jeff Smith

STRUCTURAL NOTES

01000 GENERAL

- EMPLOY GOOD STANDARDS OF WORKMANSHIP THROUGHOUT. PROVIDE ALL MATERIALS AND PERFORM ALL CONSTRUCTION AS INDICATED. SECURE THE APPROVAL OF THE ENGINEER OF RECORD FOR SUBSTITUTIONS.
- SEE THE SPECIFICATIONS FOR DETAILED MATERIAL AND METHODS NOT CALLED OUT HERE. IN CASE OF CONFLICT BETWEEN APPLICABLE CODES, THESE NOTES, THE SPECIFICATIONS, AND THE DRAWINGS, THE MOST SPECIFIC WILL GOVERN. IN CASES WHERE CONFLICTS EXIST BETWEEN EQUALLY SPECIFIC PROVISIONS, THE MOST STRINGENT WILL GOVERN.
- VERIFY ALL DIMENSIONS IN THE FIELD, AND UPON DISCOVERY OF ANY DISCREPANCY BETWEEN THE STRUCTURAL DRAWINGS AND FIELD CONDITIONS OR OTHER DRAWINGS, NOTIFY THE PROJECT MANAGER.
- USE THESE DRAWINGS IN CONJUNCTION WITH THE OTHER DISCIPLINES DRAWINGS. THEY ARE NOT TO STAND ALONE. THESE DRAWINGS AND THE DESIGNS HEREIN ARE FOR USE ON THIS PROJECT ONLY.
- DO NOT SCALE DRAWINGS.
- USE TYPICAL DETAILS AND SCHEDULES WHEREVER APPLICABLE. SPECIFIC NOTES AND DETAILS SHALL GOVERN OVER TYPICAL DETAILS, BUT ANY PARTS OF TYPICAL DETAILS NOT SO ALTERED WILL STILL APPLY.
- THE STRUCTURE AS SHOWN ON THESE DRAWINGS IS DESIGNED TO BE STABLE AND TO RESIST IT'S LOADS IN THE COMPLETED CONDITION. THE DRAWINGS DO NOT INDICATE THE METHOD OR SEQUENCE OF CONSTRUCTION. THE CONTRACTOR IS SOLELY RESPONSIBLE FOR TEMPORARY BRACING AND SHORING, AND FOR SAFETY PROGRAMS, METHODS, AND PROCEDURES OF OPERATION FOR THE CONSTRUCTION OF THE DESIGN.

03100 FORMWORK

- BUILD FORMWORK TO STANDARDS CALLED OUT IN THE SPECIFICATIONS SO AS TO MINIMIZE FINS OR BULGES.

03200 REINFORCING


- REINFORCING BARS SHALL BE ASTM A615, GRADE 60
- BAR DETAILING AND SUPPORT OF REINFORCING BARS SHALL CONFORM TO THE CONCRETE REINFORCING STEEL INSTITUTE (CRSI) MANUAL OF STANDARD PRACTICE. REBAR WHICH IS MARKED "CONTINUOUS" ON DRAWINGS SHALL EXTEND AS FAR AS POSSIBLE AND TERMINATE IN A 12-DIAMETER BEND OR PER TYPICAL DETAILS. SHOP-FABRICATE ALL BENDS.
- WELDING OF REINFORCING IS NOT PERMITTED.
- PROVIDE THE MINIMUM COVER FROM FACE OF BAR TO FACE OF CONCRETE, AS DETAILED; PROVIDE NECESSARY ACCESSORIES TO MAINTAIN CLEARANCES.

03300 CONCRETE


- MATERIALS SHALL BE:  
AGGREGATE: STONE (NOT GRAVEL) AGGREGATE PER ASTM C33  
CEMENT: TYPE I OR II PER ASTM C150  
ADMIXTURES: AIR: ASTM C260 HRWDA: ASTM C494 TYPE A  
ALL CONCRETE SHALL BE READY-MIX. COMPLY WITH ASTM C 94 AND AS SPECIFIED.
- PROPERTIES INCLUDING 28-DAY STRENGTHS SHALL BE AS FOLLOWS:  
APPLICATION F'C W/C AGG  
(PSI) (MAX) (MAX)  
CONCRETE VAULT COLLAR: 3000 0.55 1"
- DRYPACK: PORTLAND CEMENT, ASTM C150, TYPE I, AND CLEAN, NATURAL SAND, ASTM C404. MIX AT RATIO OF 1.0 PART CEMENT TO 3.0 PARTS SAND, BY VOLUME, WITH MINIMUM WATER REQUIRED FOR PLACEMENT AND HYDRATION. MINIMUM STRENGTH OF GROUT, 5000 PSI AT 28 DAYS.
- ALL CONSTRUCTION JOINTS, INCLUDING CONNECTIONS TO PRE-EXISTING CONCRETE, SHALL BE CLEAN AND FREE FROM FOREIGN SUBSTANCES, LOOSE MATERIAL OR LAITANCE. WHERE NOTED ON DRAWINGS AS "ROUGHENED," MECHANICALLY ROUGHEN TO FRACTURE COARSE AGGREGATE ON THE ENTIRE SURFACE TO AT LEAST 1/4" AMPLITUDE AND REMOVE ALL LOOSE MATERIAL. DAMPEN JOINTS FOR AT LEAST ONE-HALF HOUR PRIOR TO CONCRETE PLACEMENT BUT LEAVE NO STANDING WATER.
- PLACE CONSTRUCTION JOINTS PERPENDICULAR TO MAIN REINFORCEMENT. CONTINUE REINFORCEMENT ACROSS CONSTRUCTION JOINTS. DO NOT PLACE CONSTRUCTION JOINTS IN HORIZONTAL PLANE IN SLABS.
- HOLD BOLTS, ANCHORS, DOWELS, REINFORCING, AND METAL INSERTS FIRMLY AND ACCURATELY IN PLACE BEFORE CONCRETE IS PLACED; DO NOT INSERT ("STAB") AFTER PLACING CONCRETE.

03150 POST-INSTALLED CONCRETE & REINFORCING

- POST-INSTALLED ADHESIVE REINFORCING SHALL BE OF STEEL CONFORMING TO THE REQUIREMENTS OF THE APPLICABLE ICC-ES REPORT FOR THE ADHESIVE SYSTEM. MAKE AND CLEAN HOLES WITH EQUIPMENT PER THE ICC-ES REPORT. DO NOT PLACE ANY ANCHOR WITHIN SIX INCHES (6") OF A FREE EDGE OF CONCRETE. SEE THE DRAWINGS FOR EMBEDMENT.  
ACCEPTED ADHESIVE PRODUCTS INCLUDE:  
A. ITW-RAMSET COMPANY: EPCON C6 SYSTEM  
B. HILTI INC: RE-500 SD SYSTEM  
C. SIMPSON STRONG-TIE COMPANY: SET-XP EPOXY  
D. OTHER SYSTEMS WITH WRITTEN APPROVAL OF THE ENGINEER OF RECORD

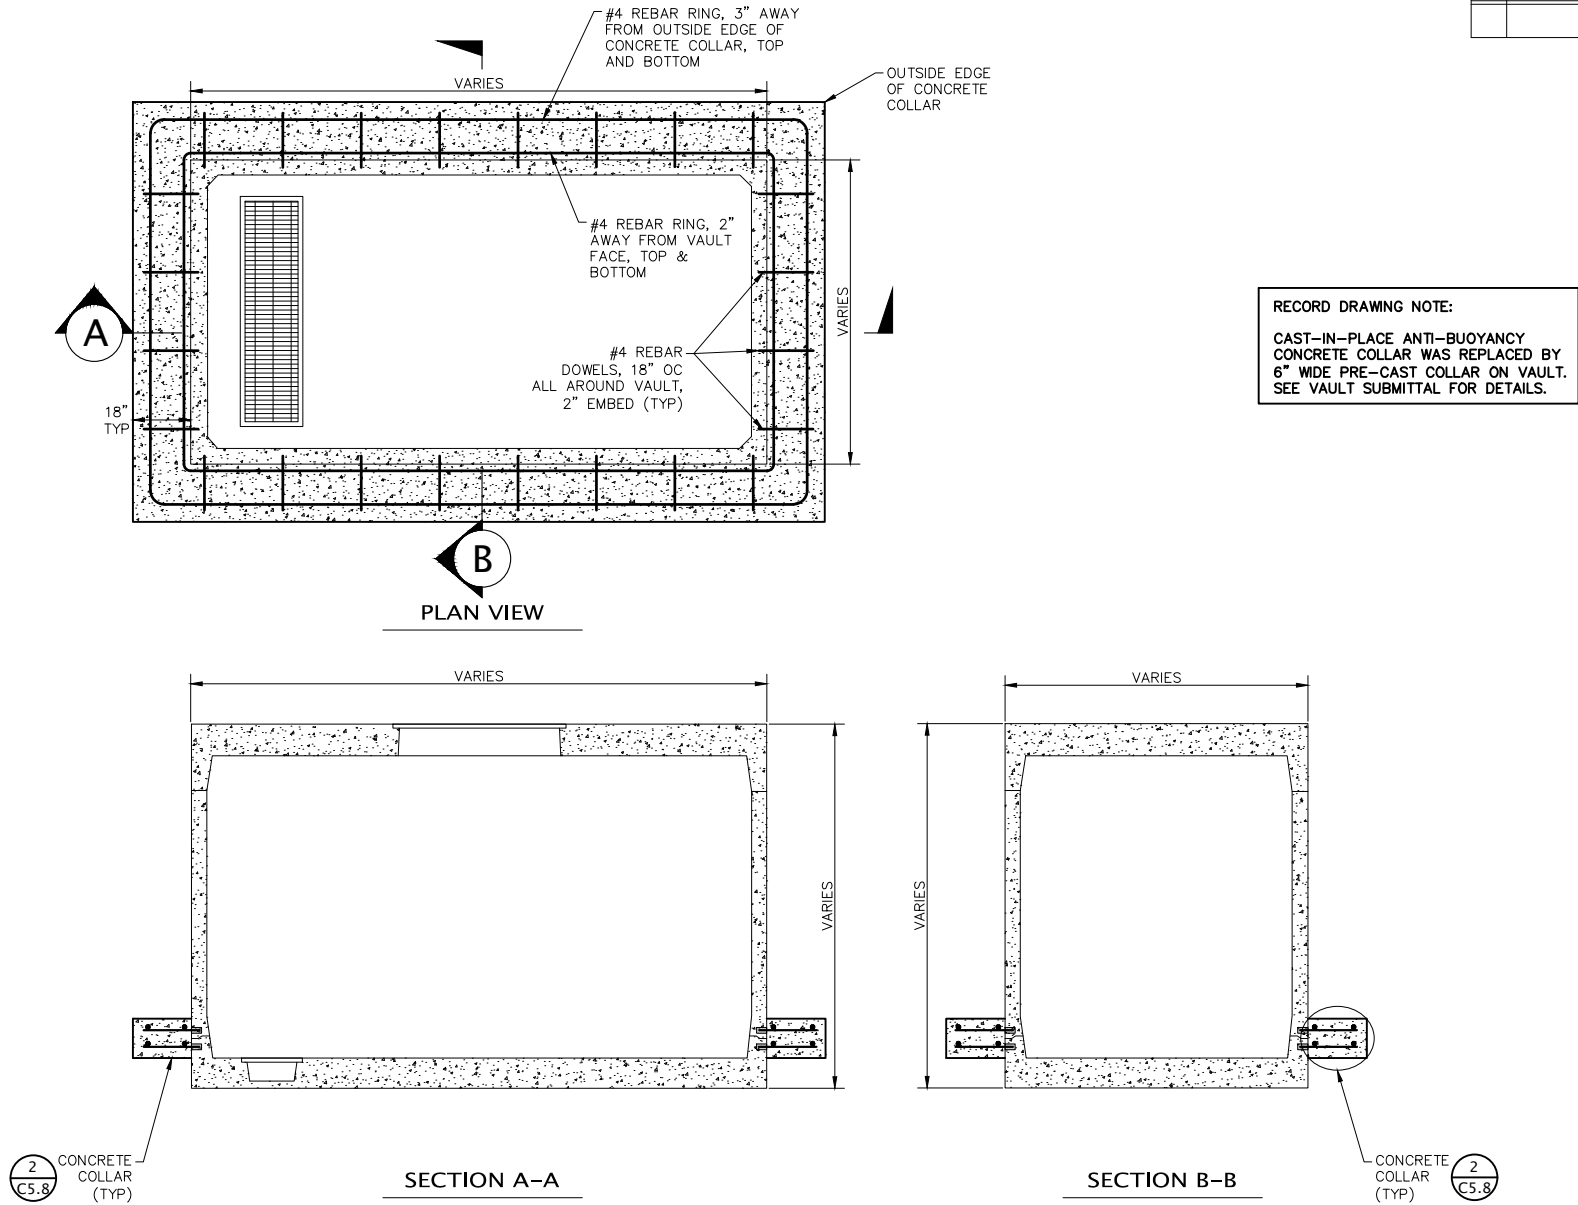

RECORD DRAWING NOTE:  
CAST-IN-PLACE ANTI-BUOYANCY  
CONCRETE COLLAR WAS REPLACED BY  
6" WIDE PRE-CAST COLLAR ON VAULT.  
SEE VAULT SUBMITTAL FOR DETAILS.

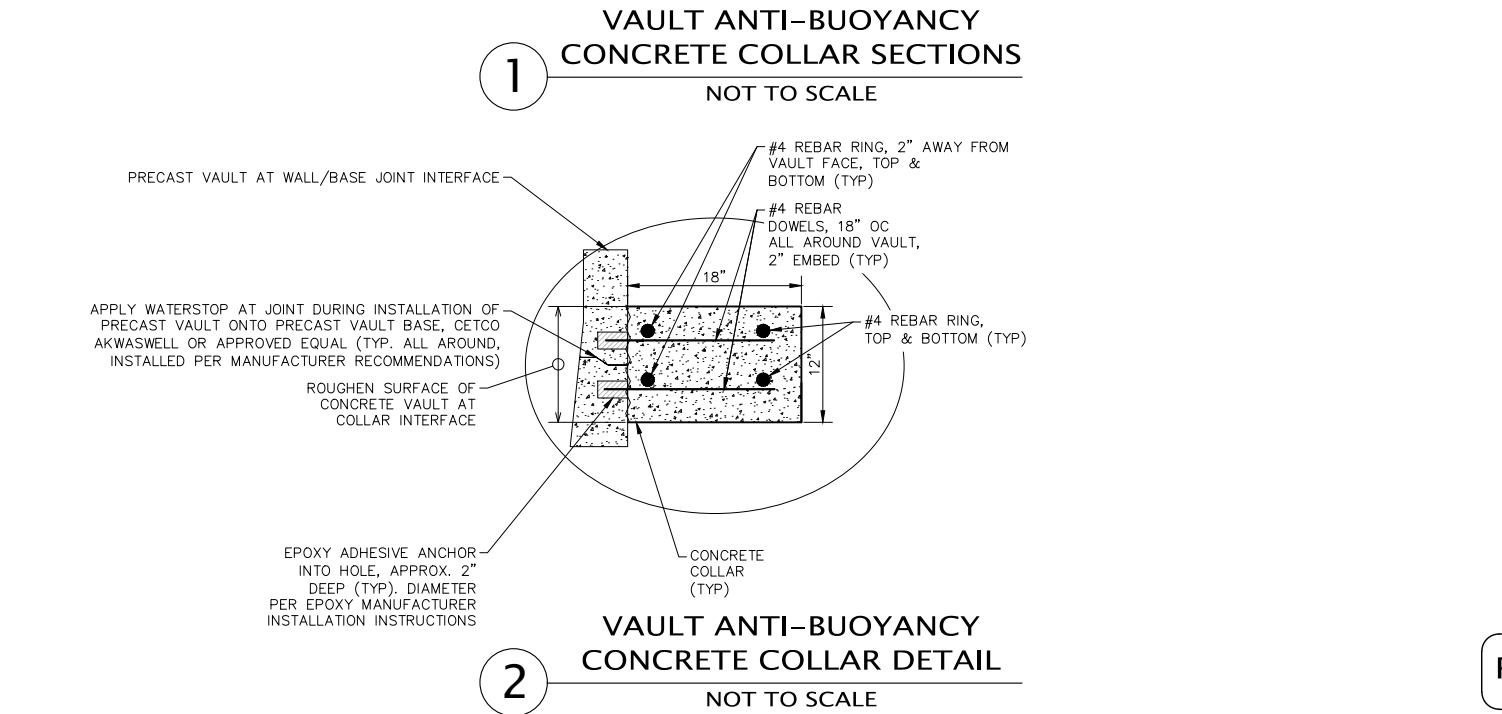

RECORD DRAWINGS

NO.

REVISIONS

BY

DATE

WILSON  
ENGINEERING

WILSONENGINEERING.COM

BRAD MARRIN SMITH  
WASHINGTON  
REGISTERED PROFESSIONAL  
1751/23

DESIGNED BY  
BMS

DRAWN BY  
JGS

CHECKED BY  
AWL

CITY OF FERNDAL

FERNDAL

WATER SYSTEM EMERGENCY INTERTIE

CIVIL DETAILS (7)

DATE  
5-31-23

SCALE  
AS SHOWN

JOB NUMBER  
2021-091

SHEET  
C5.8

PAGE  
25 OF 25