
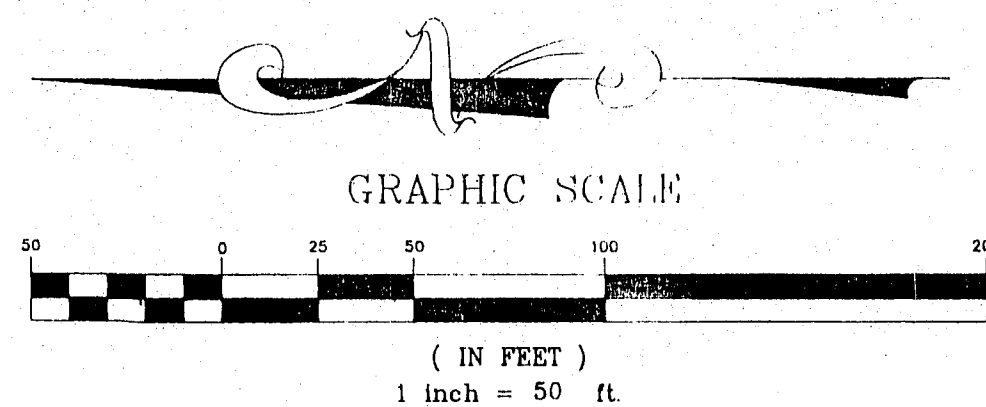


LEGEND

- - DENOTES W.S.D.T. MONUMENT FND
- - SET BR CAP IN CONCRETE
- - FND REBAR AND CAP
- - DENOTES REBAR WITH PLASTIC CAP FND
- - FND IRON PIPE
- - FND HUB AND TACK
- - SET HUB AND TACK
- ▲ - FND PK NAIL
- ▲ - SET 60D SPIKE
- - FND NAIL AND BR TAG
- - DENOTES REBAR WITH PLAS. CAP FND LS#24218
- - FND NAIL AND SHINER
- - SET NAIL AND SHINER
- ⊗ - WATER METER BOX
- ⊗ - WATER WELL (48" DIA. TOP)
- - - - - UNDERGROUND TELEPHONE LINE LOCATION
- - - - - UNDERGROUND GAS LINE LOCATION
- ⊕ T. - EXISTING TELEPHONE PEDASTAL
- PP - EXISTING POWER POLE
- - EXISTING GROUND GUY

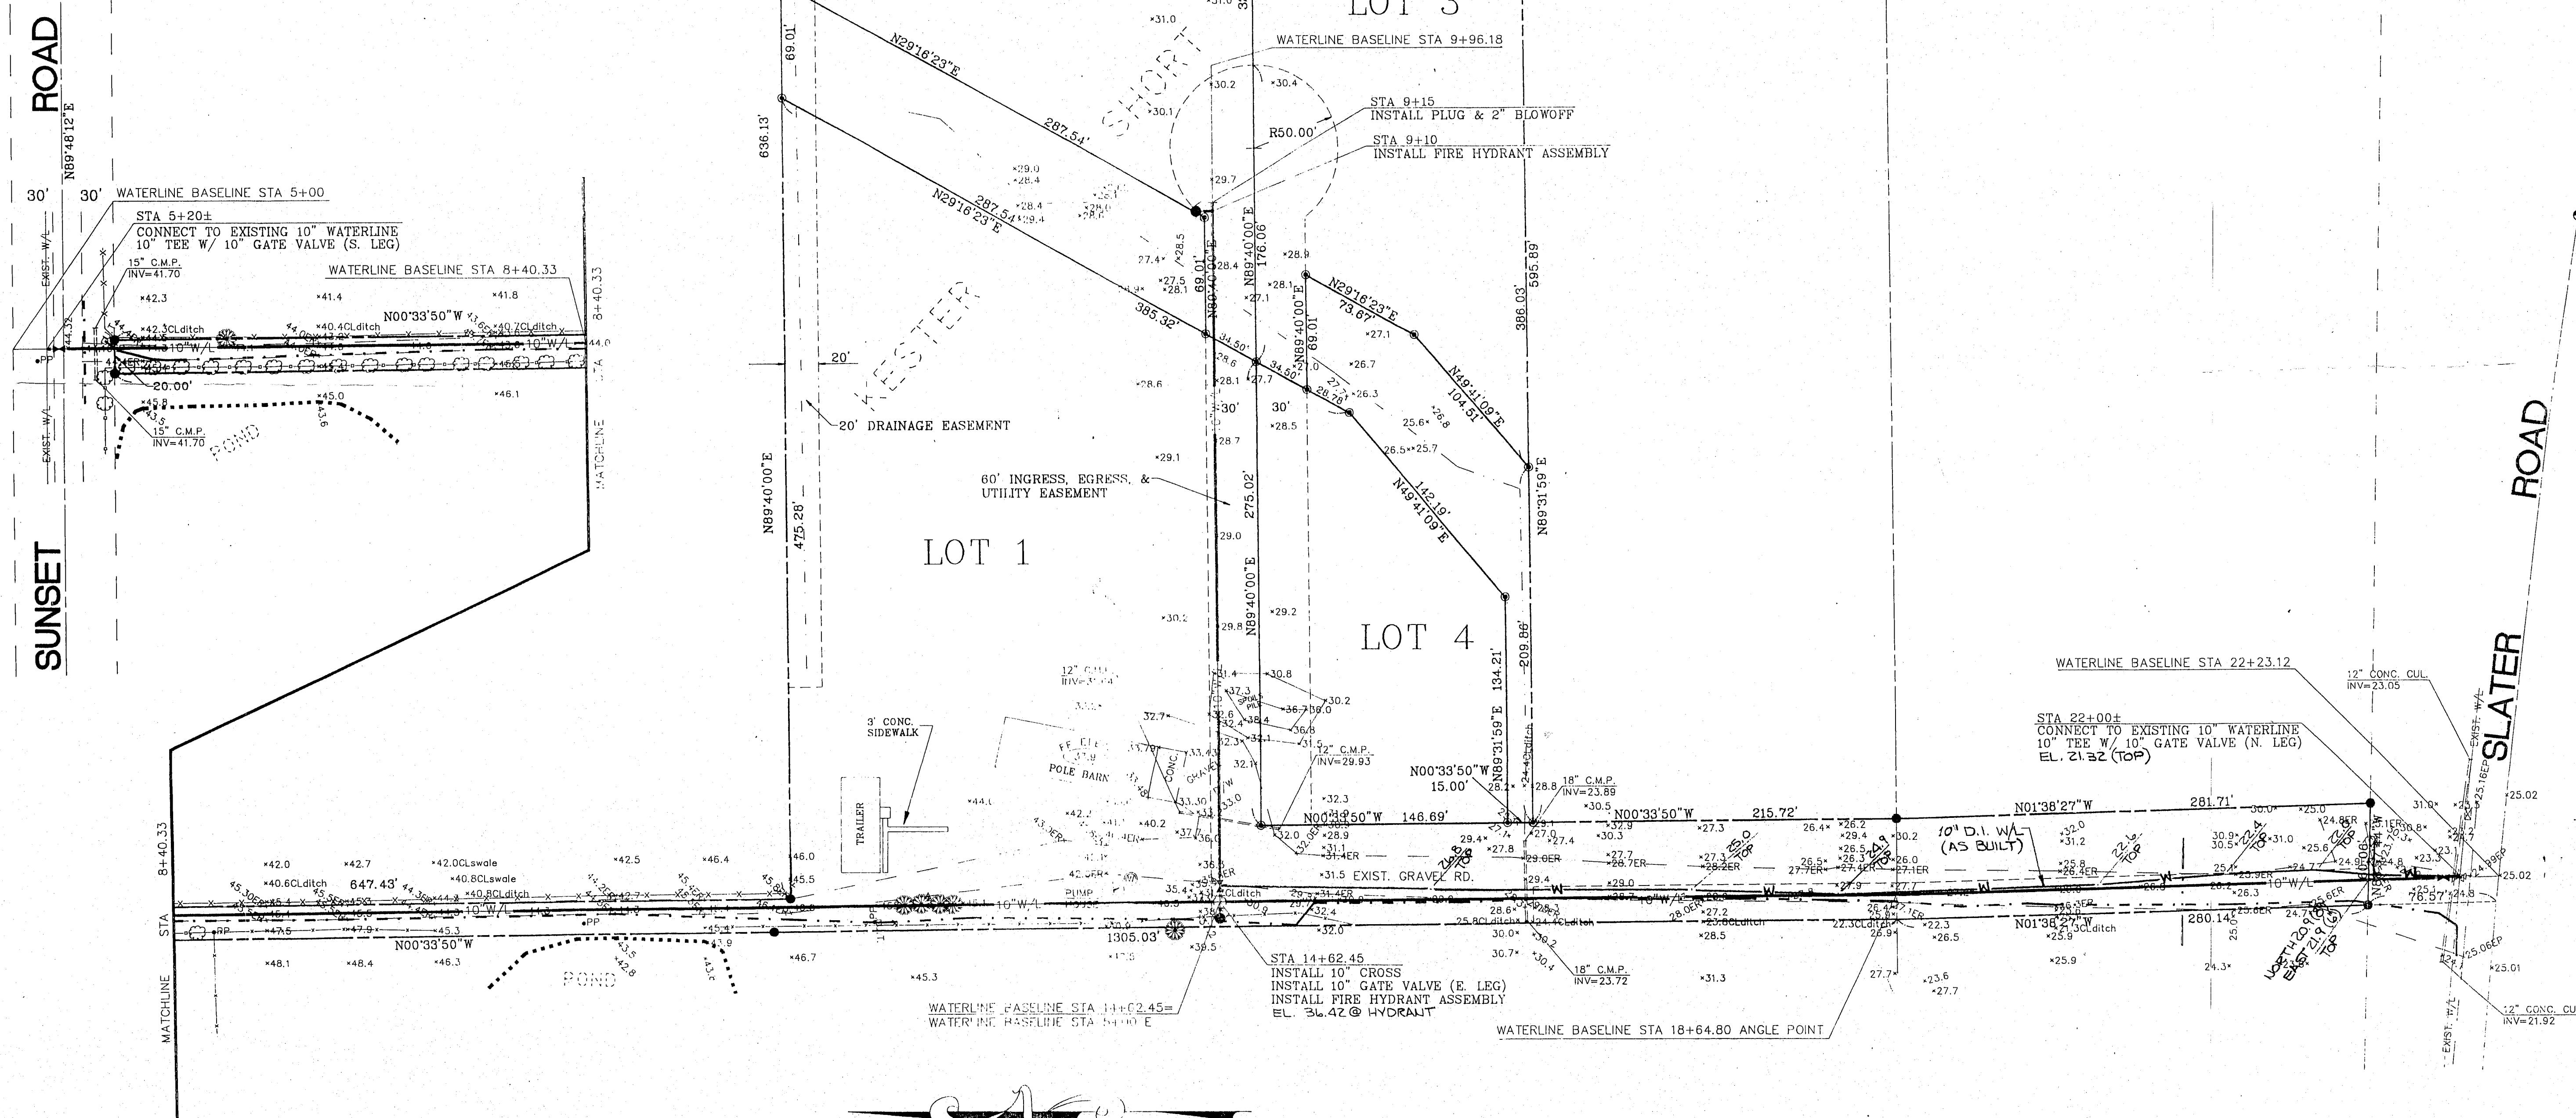

PACIFIC
SURVEYING/ENGINEERING
INCORPORATED
215 WEST HOLLY, SUITE B-25 (BAY ST.)
BELLINGHAM, WASHINGTON 98225
PHONE 671-7387
FAX LINE 671-4885

"KESTER SHORT PLAT" WATER IMPROVEMENTS

DRAWN BY AMM.	DATE 07/01/91	JOB # 90088	DWG. # 90088TOP
CHECKED BY MJK.	FIELD BOOK 27.30	SHEET 1 OF 1	

00415.000 9/13/16 DS

KESTER SHORT PLAT
WATER IMPROVEMENTS