


A PORTION OF THE NORTHEAST QUARTER OF SECTION 33, T39N, R2E, W.M.

PACIFIC INDUSTRIAL PARK LOT 15 & 16

AS-BUILT DRAWINGS

00364.001 1-30-08 NR

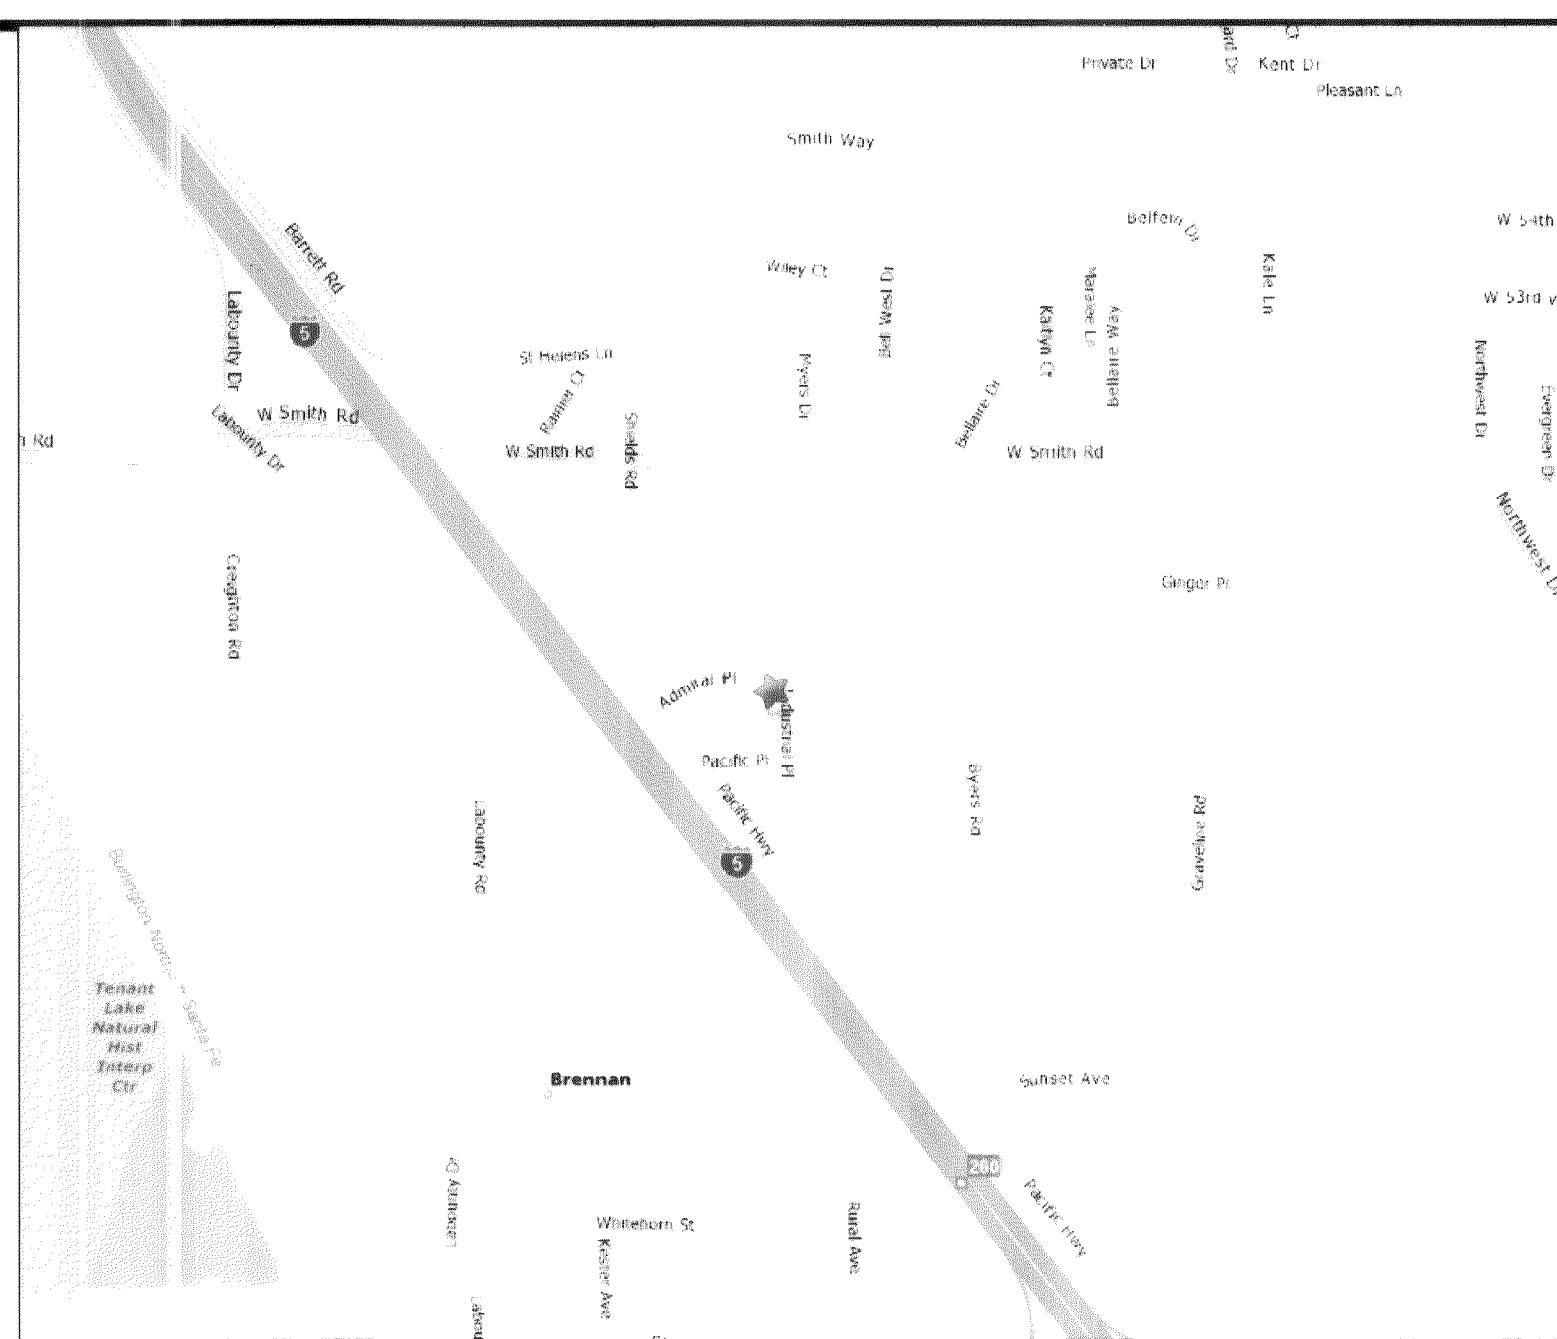

1. COVER SHEET
2. STORM DRAINAGE
3. SANITARY SEWER AND WATER DISTRIBUTION PLAN
4. COMPOSITE UTILITY PLAN

LEGEND:

- | | | | |
|---|---|--------|-----------------------------|
| ● | = FND REBAR AND CAP | — W — | = EXIST WATER LINE |
| ○ | = EXIST SD CATCH BASIN (TYPE 1) | — SS — | = EXIST SANITARY SEWER LINE |
| □ | = EXIST SD CONTROL STRUCTURE | — SD — | = EXIST STORM DRAIN LINE |
| ■ | = AS-BUILT STORM DRAIN CATCH BASIN | — F — | = EXIST FENCE |
| ● | = AS-BUILT STORM DRAIN MANHOLE (TYPE 2) | — C — | = EXIST CONC. WALL |
| ○ | = EXIST SANITARY SEWER MANHOLE | — SD — | = AS-BUILT STORM DRAIN LINE |
| ○ | = AS-BUILT SANITARY SEWER SERVICE | — SS — | = AS-BUILT SAN. SEWER LINE |
| □ | = EXISTING WATER METER BOX | — W — | = AS-BUILT WATER LINE |
| ○ | = EXISTING WATER VALVE | | |
| ○ | = EXISTING FIRE HYDRANT | | |
| ■ | = AS-BUILT METER BOX | | |



APPROVED

MAR 16 2007
BY *Robert G. Galt*
CITY OF FERNDAL

DRAWN BY SR DATE 2/1/2007
CHECKED BY RL DATE 2/1/2007

PACIFIC INDUSTRIAL PARK LOT 15 & 16
1373 AND 1385 ADMIRAL PLACE

AS-BUILT DRAWING CERTIFICATION
I HEREBY CERTIFY THAT THE IMPROVEMENTS IN LOTS 15 AND 16 HAVE BEEN AS BUILT BY LAND DEVELOPMENT ENGINEERING AND SURVEYING AND CONSTRUCTED IN CONFORMANCE WITH THE PLANS APPROVED BY THE PUBLIC WORKS DIRECTOR FOR THE SAID DEVELOPMENT AND THE GENERAL SPECIFICATIONS ADOPTED BY THE CITY OF FERNDAL DEPARTMENT OF PUBLIC WORKS.
Ramon Llanos 2/1/07
RAMON LLANOS, PE DATE


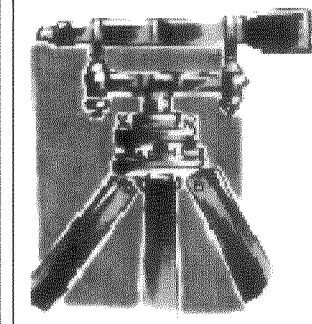
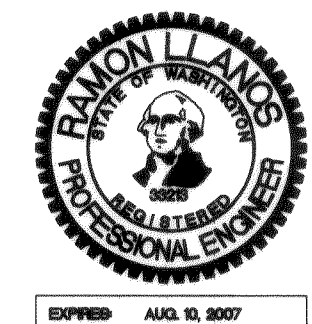


LDES, INC.
1350 SLATER RD. SUITE 9
FERNDAL, WA 98248
PHONE 360-383-0620
FAX 360-383-0639



SAM BOULOS
1440 ADMIRAL PLACE
FERNDAL, WASHINGTON 98248

PACIFIC INDUSTRIAL PARK
SPECIFIC BINDING SITE PLAN No. 6, LOTS 15 & 16
SITE DEVELOPMENT PLANS
COVER SHEET
AS-BUILT DRAWINGS

SHEET
1
OF
4

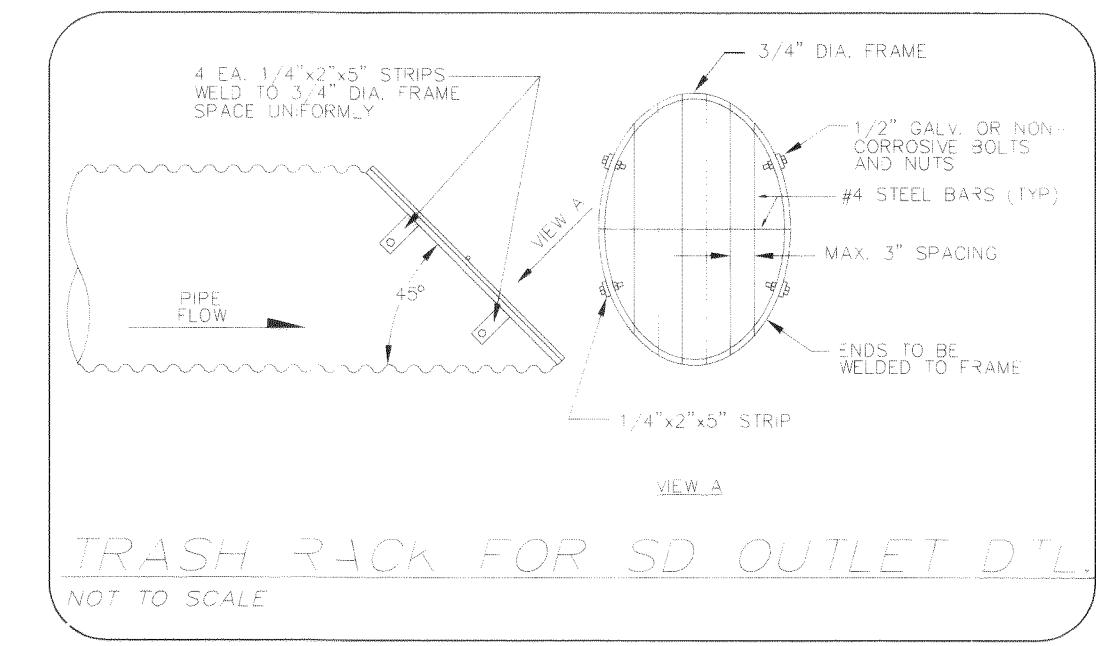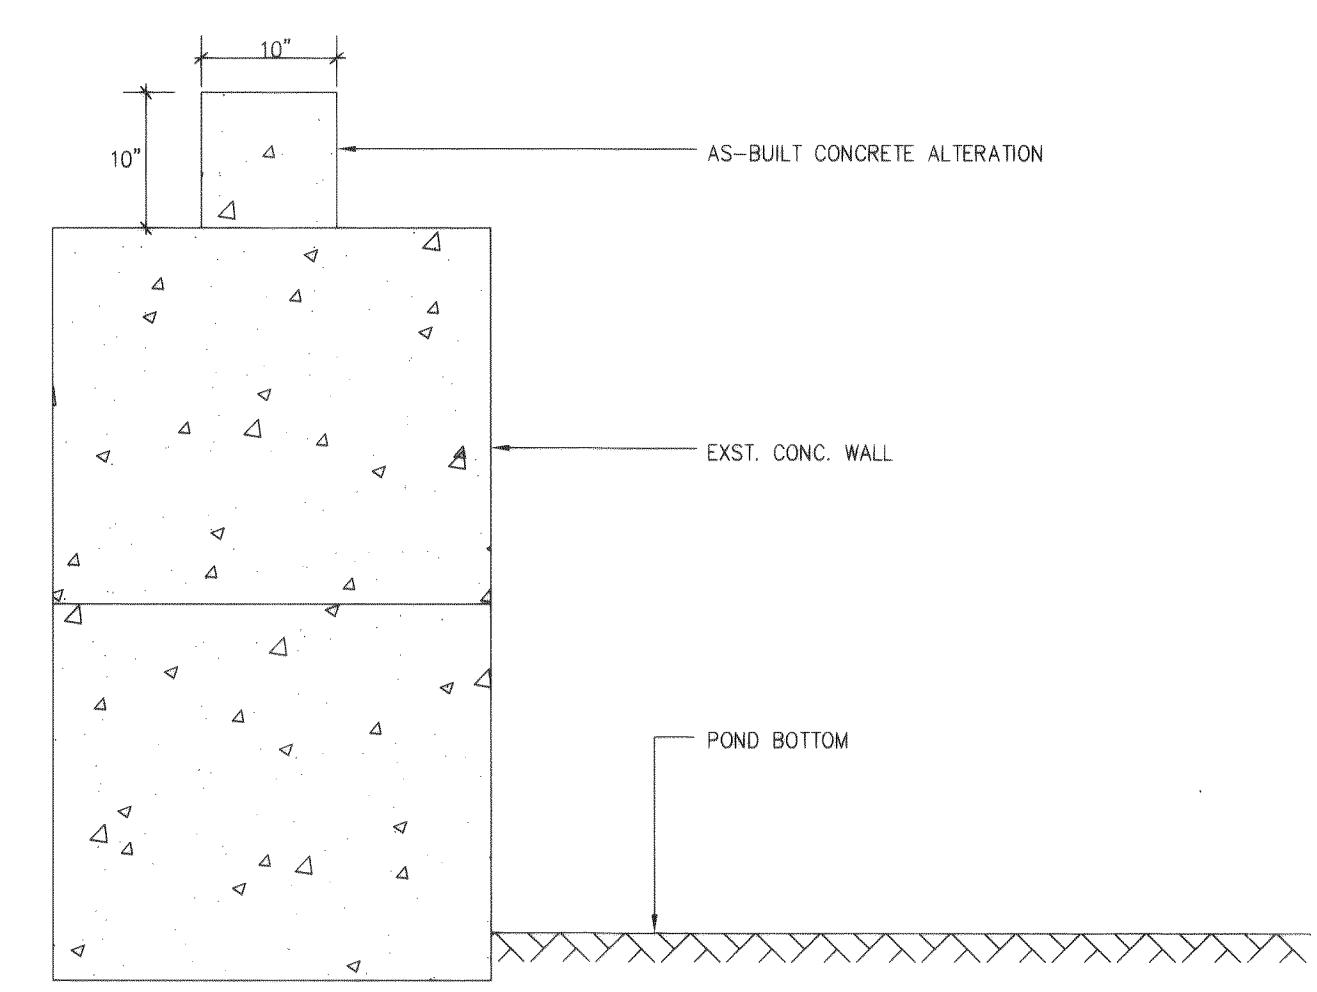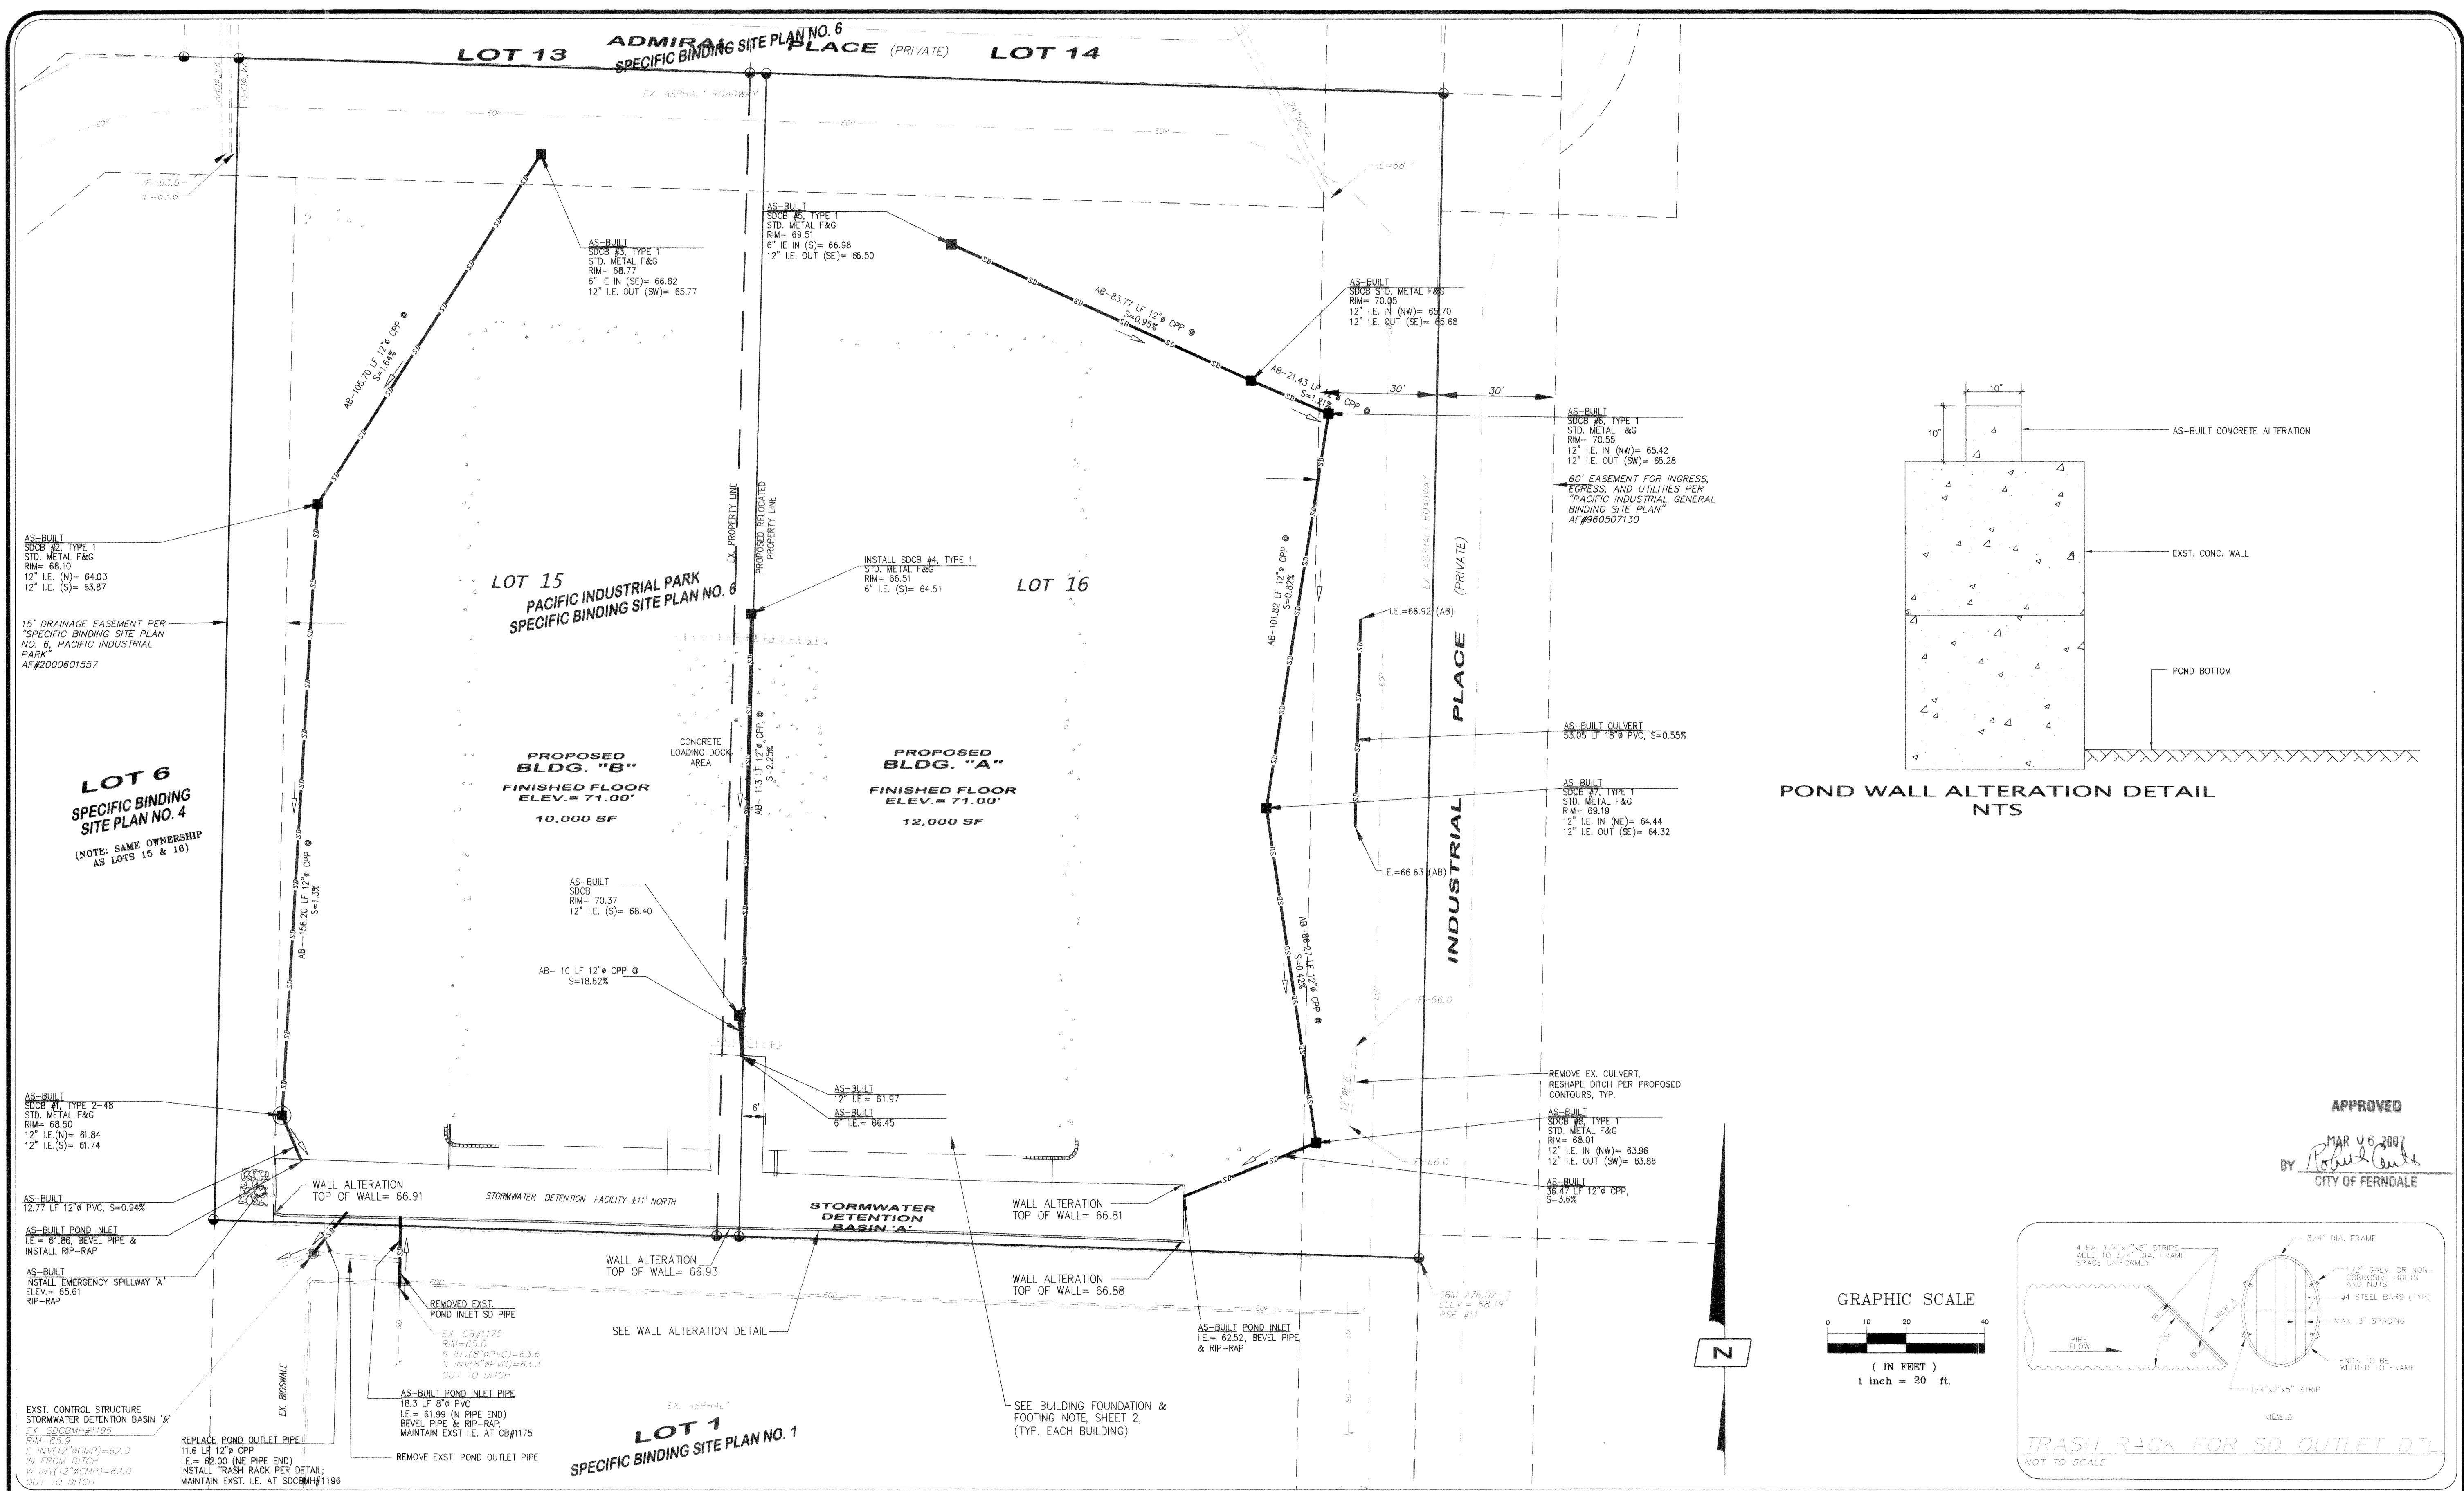


APPROVED
MAR 06 2007
BY *Robert Cant*
CITY OF FERNDALE

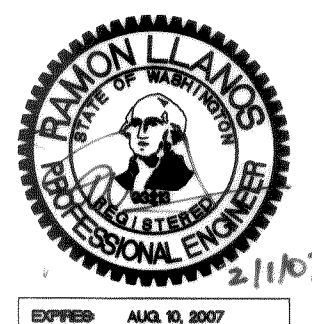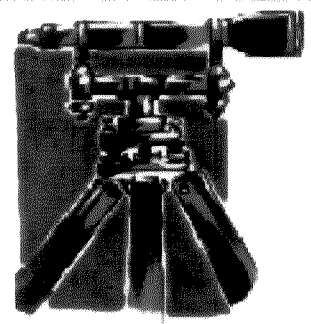
DRAWN BY SR DATE 2/1/2007 CHECKED BY RL DATE 2/1/2007	PACIFIC INDUSTRIAL PARK LOT 15 & 16 1373 AND 1385 ADMIRAL PLACE		 LDES, INC. 1350 SLATER RD. SUITE 9 FERNDAL, WA 98248 PHONE 360-383-0620 FAX 360-383-0639	SAM BOULOS 1440 ADMIRAL PLACE FERNDAL, WASHINGTON 98248	PACIFIC INDUSTRIAL PARK SPECIFIC BINDING SITE PLAN No. 6, LOTS 15 & 16 SITE DEVELOPMENT PLANS STORM DRAINAGE PLAN AS-BUILT DRAWINGS	SHEET 2 OF 4
JOB # 4579	FOR: SAM BOULOS					



00364-002 1-20-08 KLR

00264.003 1:20.08 4P.

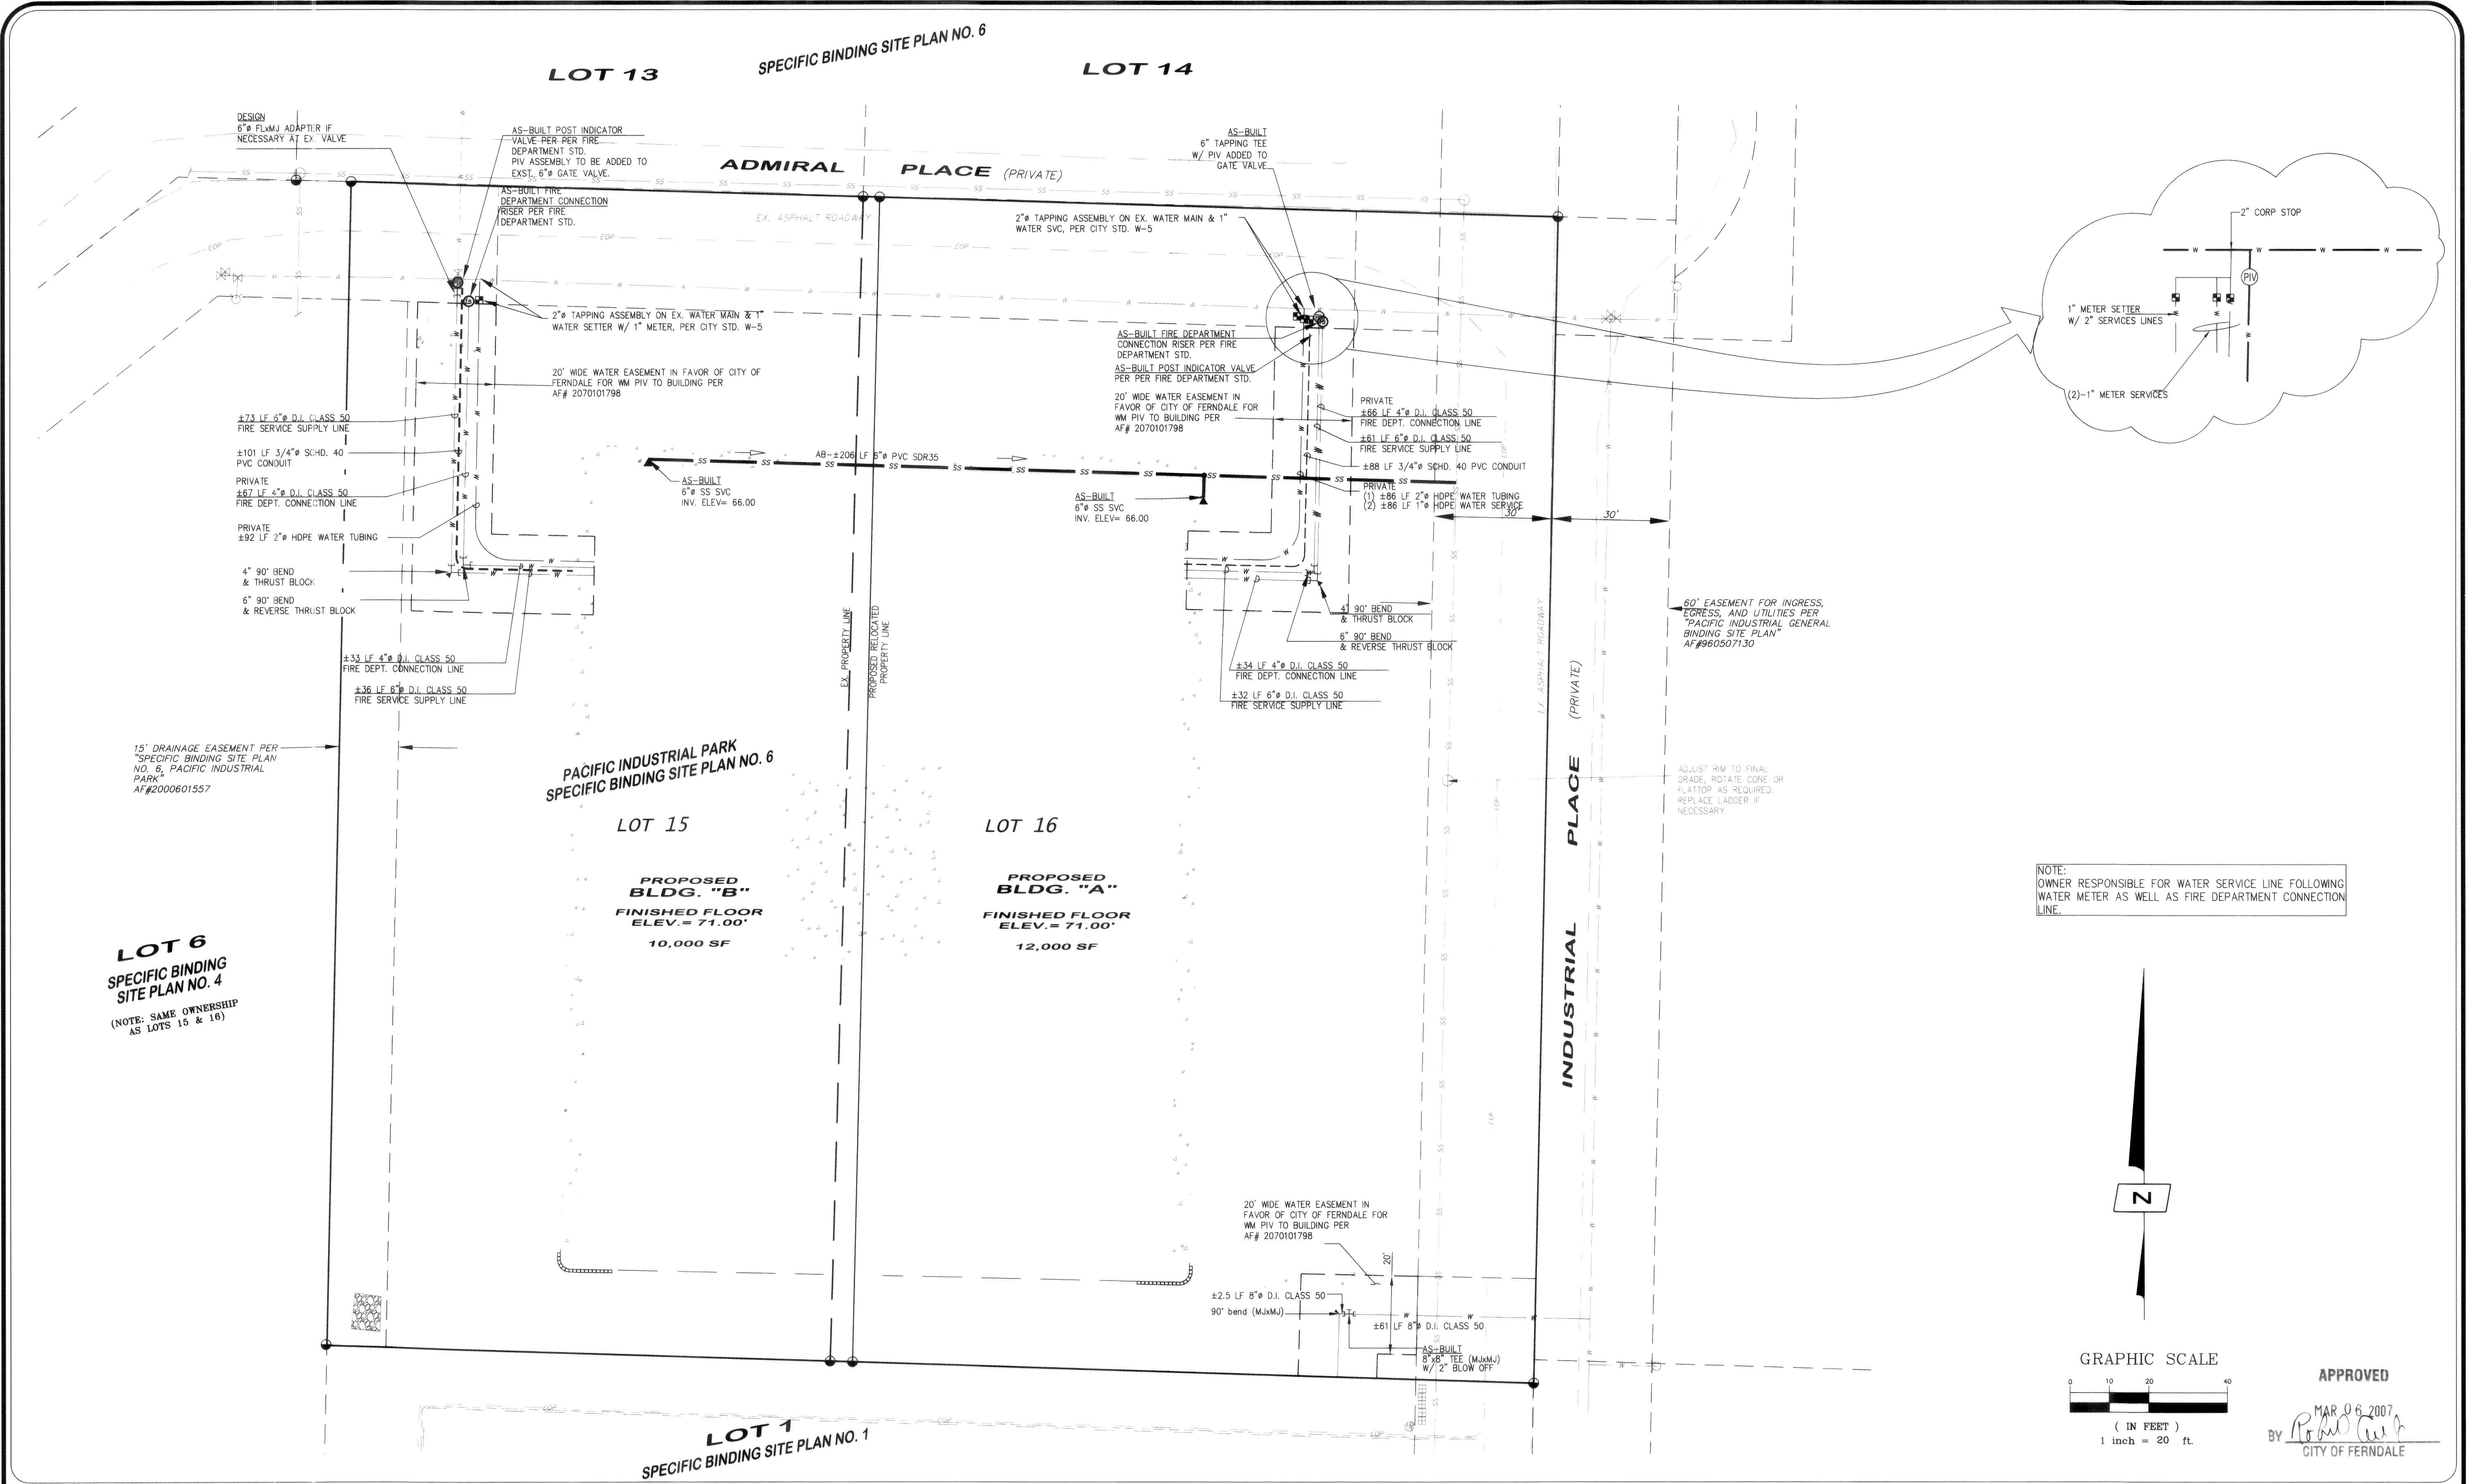

30.03.1 100.19200

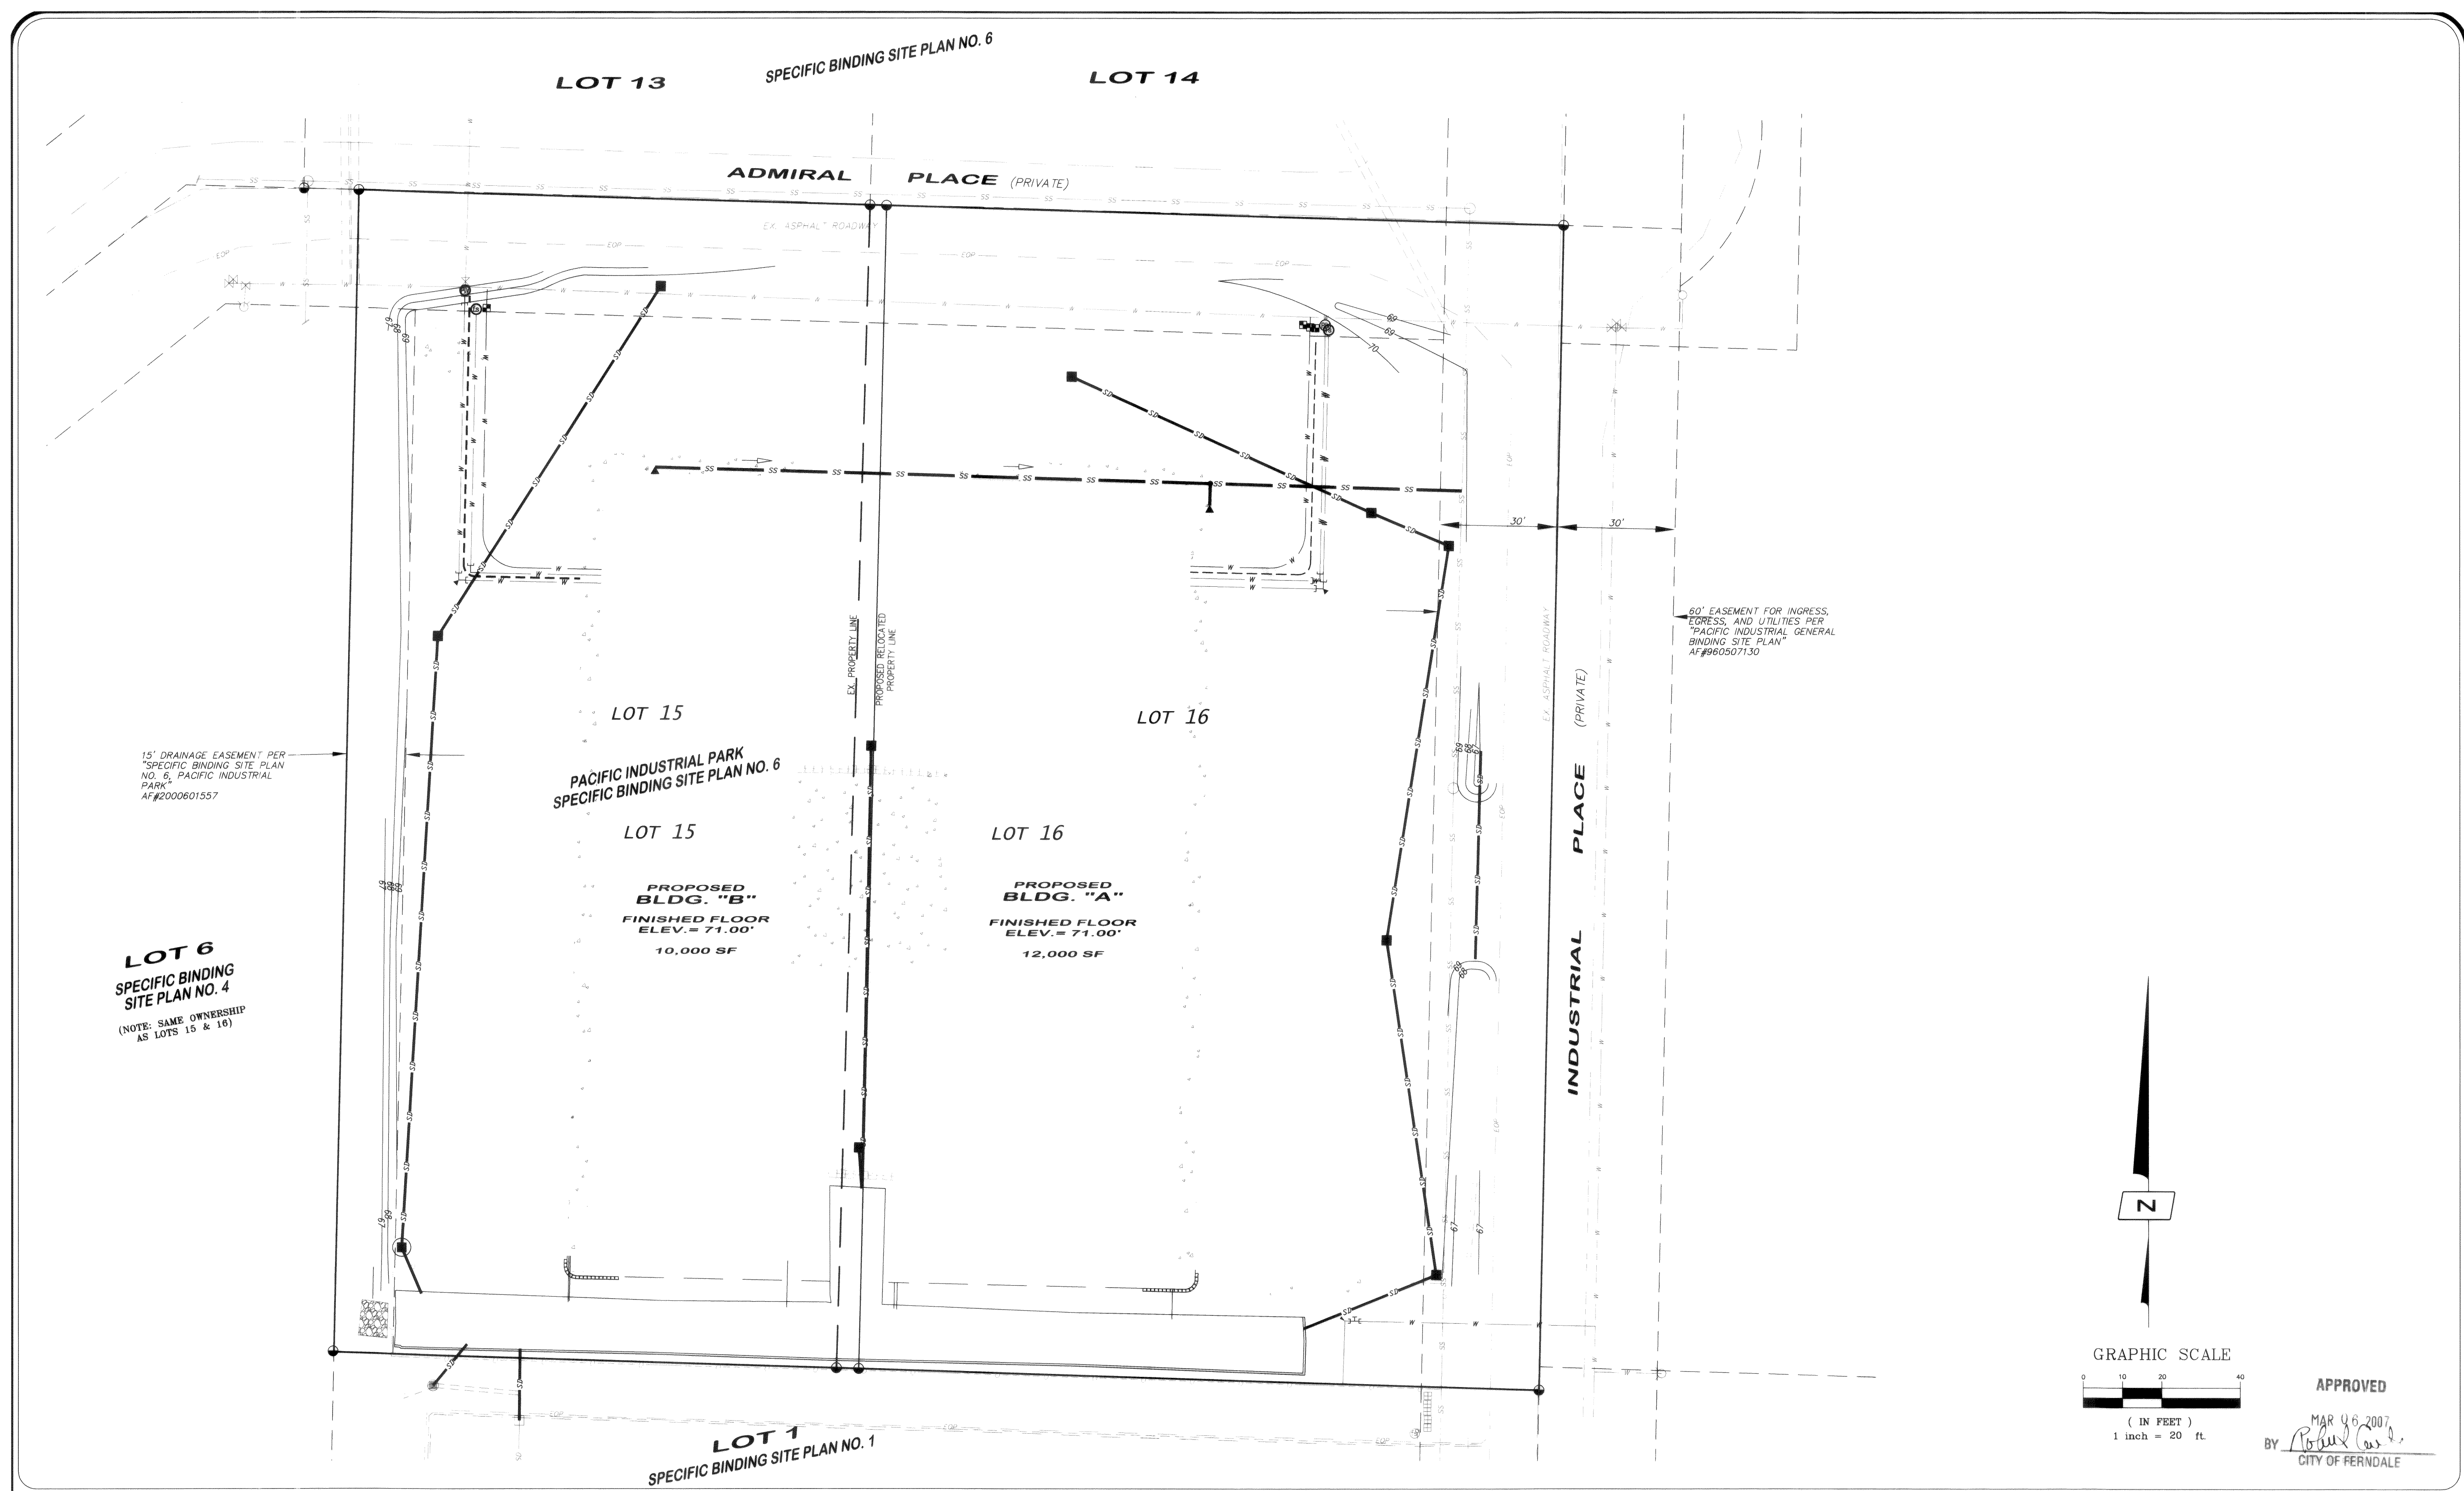

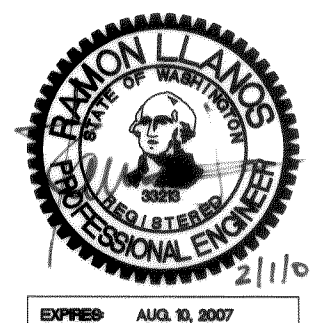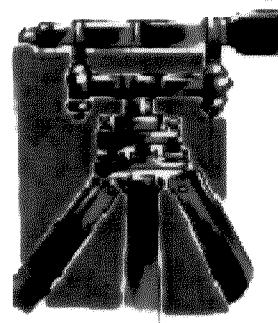DRAWN BY SR DATE 2/1/2007 CHECKED BY RL DATE 2/1/2007	PACIFIC INDUSTRIAL PARK LOT 15 & 16 1373 AND 1385 ADMIRAL PLACE		 LDES, INC. 1350 SLATER RD. SUITE 9 FERNDAL, WA 98248 PHONE 360-383-0620 FAX 360-383-0639	SAM BOULOS 1440 ADMIRAL PLACE FERNDAL, WASHINGTON 98248	PACIFIC INDUSTRIAL PARK SPECIFIC BINDING SITE PLAN No. 6, LOTS 15 & 16 SITE DEVELOPMENT PLANS COMPOSITE UTILITY PLAN AS-BUILT DRAWINGS	SHEET 4 OF 4
JOB # 4579	FOR: SAM BOULOS					

APPROVED
MAR 06 2007
BY *[Signature]*
CITY OF FERNDAL