


THIRD AVENUE STREET AND SEWER IMPROVEMENTS PROJECT

CITY OF FERNDALE

00341.001 3.22.07 KR


VICINITY MAP

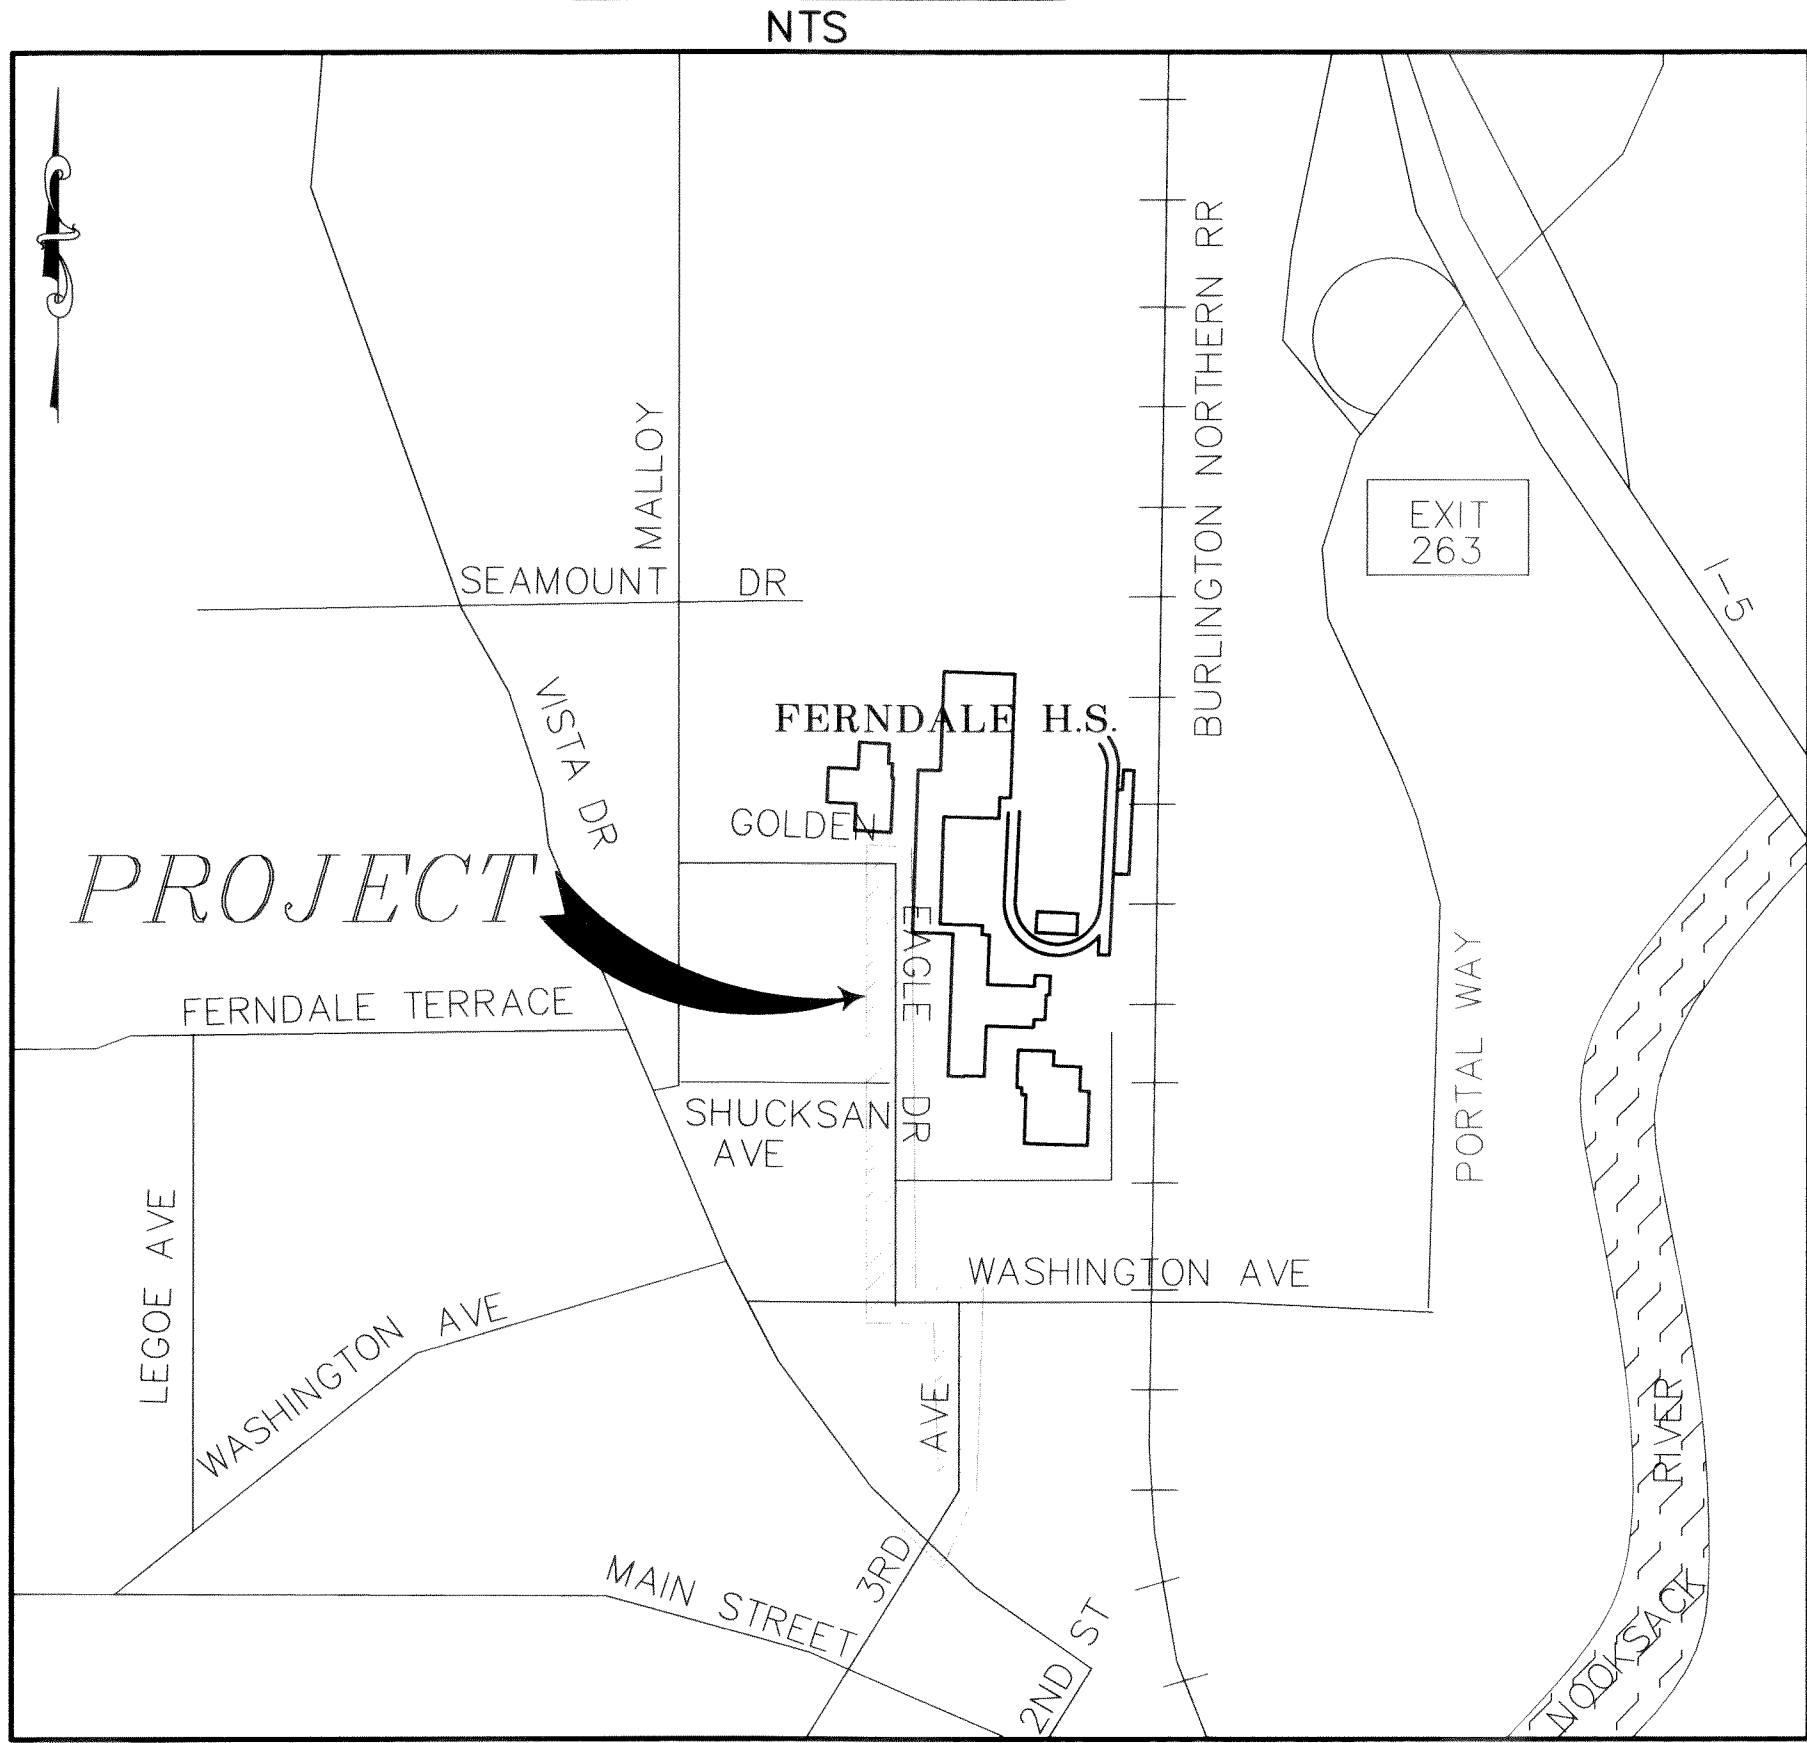

SHEET INDEX

- 1.) COVER SHEET
- 2.) STREET IMPROVEMENTS, VISTA DR
STREET & STORM
STA 0+00 TO 3+50
- 3.) STREET IMPROVEMENTS, THIRD ST
STREET & STORM
STA 5+00 TO 11+00
- 4.) STREET IMPROVEMENTS, THIRD ST
STREET & STORM
STA 11+00 TO 15+00
- 5.) STREET IMPROVEMENTS, VISTA DR
WATER & SEWER
STA 0+00 TO 3+50
- 6.) STREET IMPROVEMENTS, THIRD ST
WATER & SEWER
STA 5+00 TO 11+00
- 7.) STREET IMPROVEMENTS, THIRD ST
WATER & SEWER
STA 11+00 TO 15+00
- 8.) STREET IMPROVEMENTS, WASHINGTON
STA 20+50 TO 26+00
- 9.) STREET IMPROVEMENTS, GOLDEN EAGLE
STA 30+50 TO 36+50
- 10.) STREET IMPROVEMENTS, GOLDEN EAGLE
STA 36+50 TO 42+50
- 11.) DETAIL SHEET
- 12.) DETAIL SHEET
- 13.) EROSION CONTROL SHEET

LEGEND

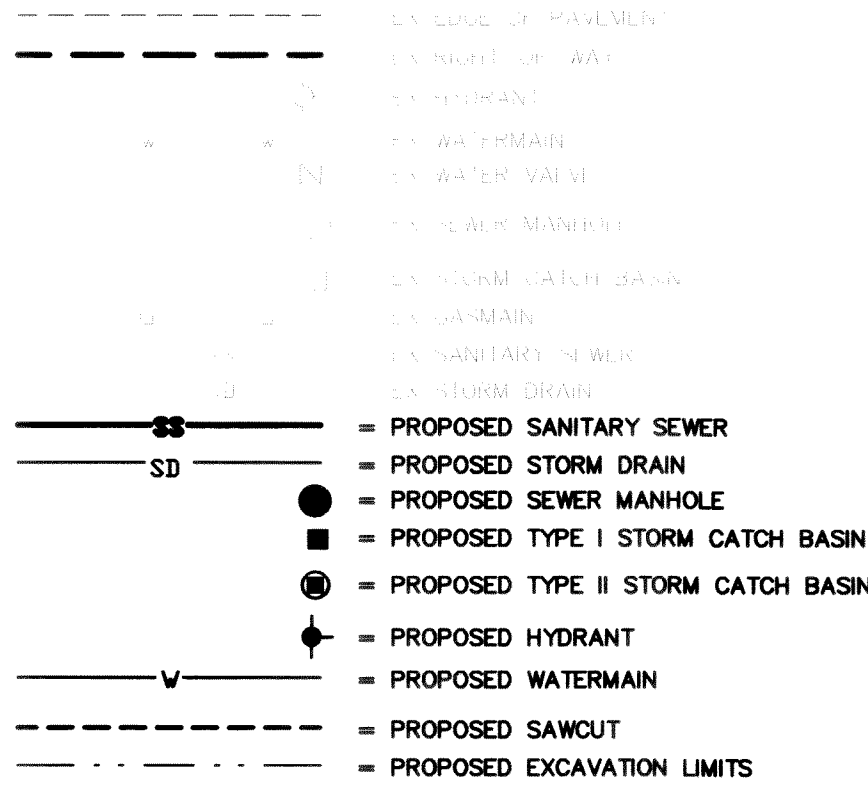

GENERAL NOTES

ALL WORK SHALL CONFORM TO THE STANDARD PLANS AND SPECIFICATIONS OF THE WASHINGTON STATE DEPARTMENT OF TRANSPORTATION (WSDOT) AND CITY OF FERNDALE STANDARDS UNLESS INDICATED OTHERWISE BY THE CONTRACT DOCUMENTS.

PLUG ALL CULVERTS, SEWERS AND CONDUITS PRIOR TO ABANDONMENT. ANY PIPE WITH LESS THAN TWO FEET OF PROPOSED COVER SHALL BE REMOVED.

THE LOCATION OF EXISTING UTILITIES SHOWN IS APPROXIMATE. IT IS THE RESPONSIBILITY OF THE CONTRACTOR TO FIELD VERIFY THESE LOCATIONS PRIOR TO CONSTRUCTION.

THE CONTRACTOR SHALL BE RESPONSIBLE FOR CONTACTING ANY AND ALL UTILITIES IN THE AREA PRIOR TO BEGINNING ANY WORK ON THIS PROJECT. THE ONE-CALL NUMBER FOR UNDERGROUND UTILITIES IS 1-800-424-5555.


THE CONTRACTOR SHALL NOTIFY RESIDENTS AND BUSINESSES 48 HOURS IN ADVANCE OF ANY WORK AFFECTING ACCESS OR SERVICE AND SHALL MINIMIZE INTERRUPTIONS TO DRIVEWAYS ADJACENT TO THE PROJECT.

DRIVEWAYS SHALL NOT BE CLOSED MORE THAN 4 HOURS WITHOUT OWNER'S CONSENT. CONCRETE POURS SHALL BE STAGGERED SUCH THAT ACCESS IS PROVIDED WHENEVER POSSIBLE. PARKING SHALL BE PROVIDED ON ONE SIDE OF THE ROAD WHENEVER DRIVEWAY ACCESS IS LIMITED.

EXISTING CONCRETE DRIVEWAYS SHALL BE REPLACED WITH CONCRETE TO THE LIMITS SHOWN ON THE PLANS OR AS DIRECTED BY THE ENGINEER. EXISTING ASPHALT OR GRAVEL DRIVEWAYS SHALL BE REPLACED WITH ASPHALT TO THE LIMITS SHOWN ON THE PLANS OR AS DIRECTED BY THE ENGINEER. ASPHALT DRIVEWAY APPROACHES SHALL EXTEND A MINIMUM OF 5 FEET BEHIND THE SIDEWALK.

THE CITY WILL PROVIDE ALL CONSTRUCTION STAKING ON THIS PROJECT.

DATE: 1-26-07
AS-BUILT

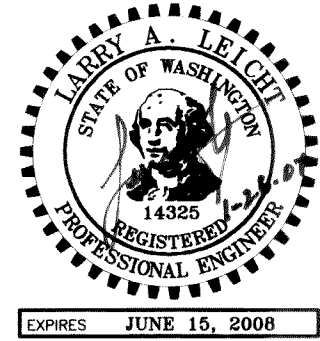

DESIGNED BY
LL
DRAWN BY
LMC
CHECKED BY



REICHHARDT & EBE
ENGINEERING, INC.
CONSULTING ENGINEERS


PO Box 978 423 Front St., Ste 201 Ph (360) 354-3687
Lynden, Washington 98264 Fax (360) 354-0407

NO.	DATE	REVISION	BY

CITY OF FERNDALE
2005 MAIN STREET
FERNDALE, WASHINGTON 98248

**THIRD AVENUE
STREET IMPROVEMENTS**
COVER SHEET

JOB# / DWG	DATE
03010.1 SP1.20SC.AB	4-13-06
SCALE	SHEET
H: N/A V: N/A	1 of 13

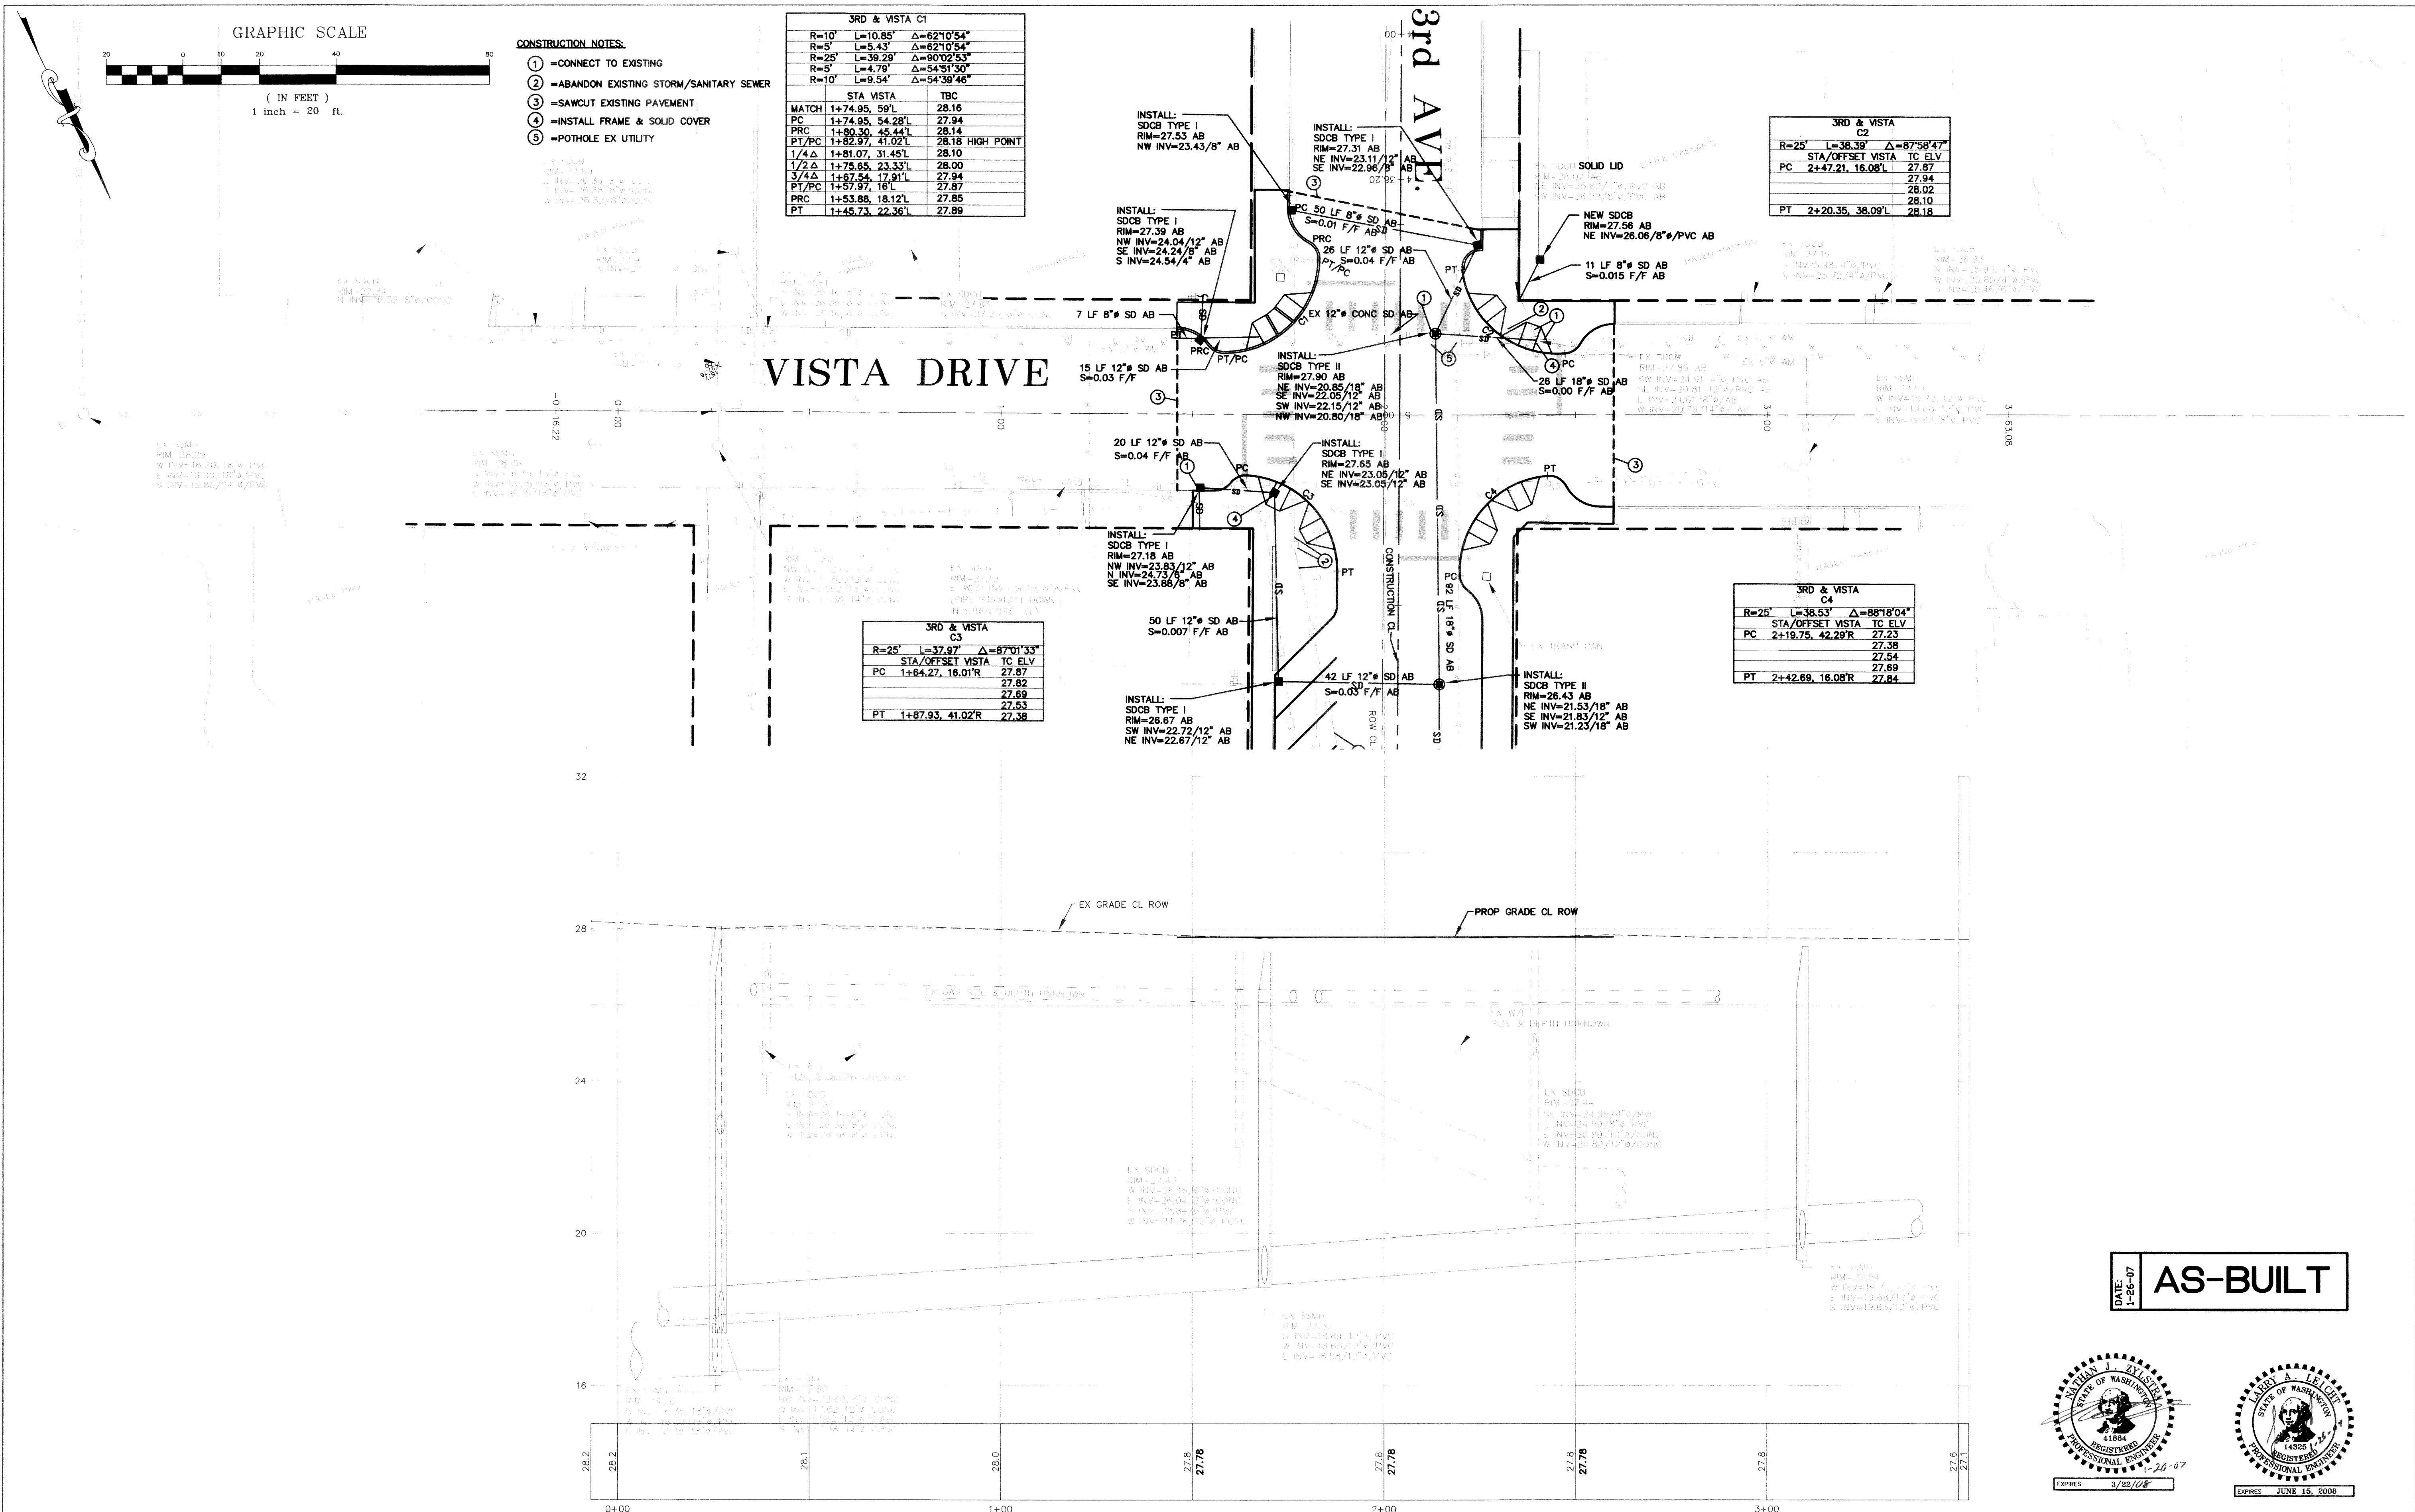



00341.002 3-22-07 K2

DESIGNED BY LL	REICHARDT & EBE ENGINEERING, INC. CONSULTING ENGINEERS PO Box 978 423 Front St., Ste 201 Lynden, Washington 98264 Ph (360) 354-3687 Fax (360) 354-0407	3	8-22-06	REVISE CURB RETURN C1. RELOCATE SDCB IN SE QUAD	NZ
DRAWN BY LMC		2	8-17-06	ADD AND RECONFIGURE SIDEWALK RAMPS IN ALL QUADRANTS	LL
CHECKED BY		1	8-9-06	MOVE SDCB E QUAD VISTA & THIRD REPLACE STORM PIPE CROSSING THIRD AVE	LL
		NO.	DATE	REVISION	BY

CITY OF FERDALE 2095 MAIN STREET FERDALE, WASHINGTON 98248		THIRD AVENUE STREET IMPROVEMENTS VISTA DRIVE STA 0+00 TO 3+50 STREET AND STORM	
---	--	--	--


JOB# / DWG 03010.1 SP1.20SC.AB	DATE 8-22-06
SCALE H:1"=20' V:1"=2'	SHEET 2 of 13

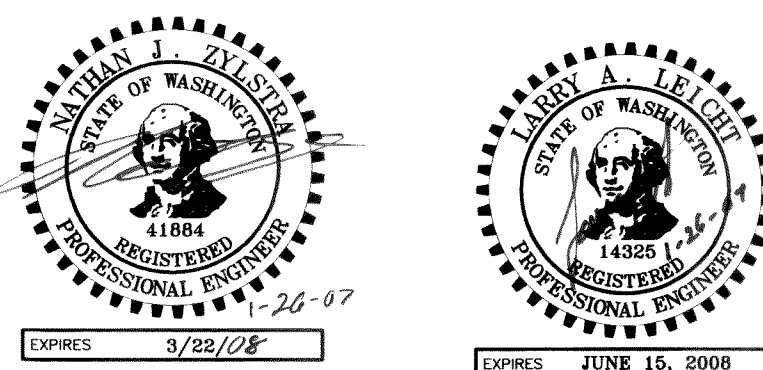

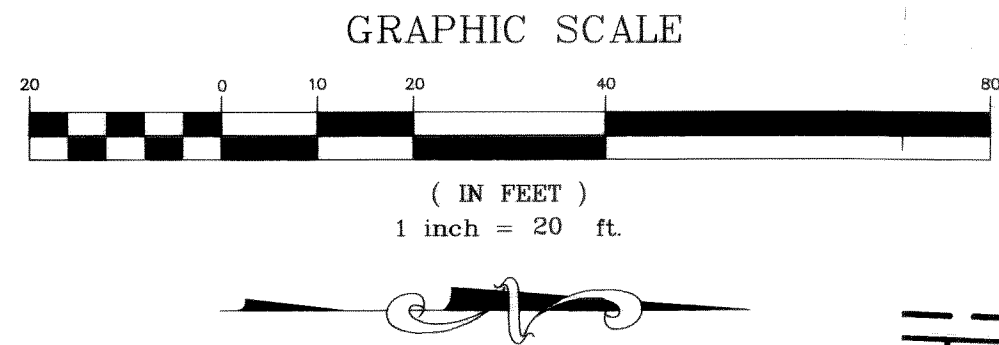


CONSTRUCTION NOTES:

- 1 =CONNECT TO EXISTING
- 2 =ABANDON EXISTING STORM/SANITARY SEWER
- 3 =SAWCUT EXISTING PAVEMENT
- 4 =INSTALL FRAME & SOLID COVER
- 5 =POTHOLE EX UTILITY

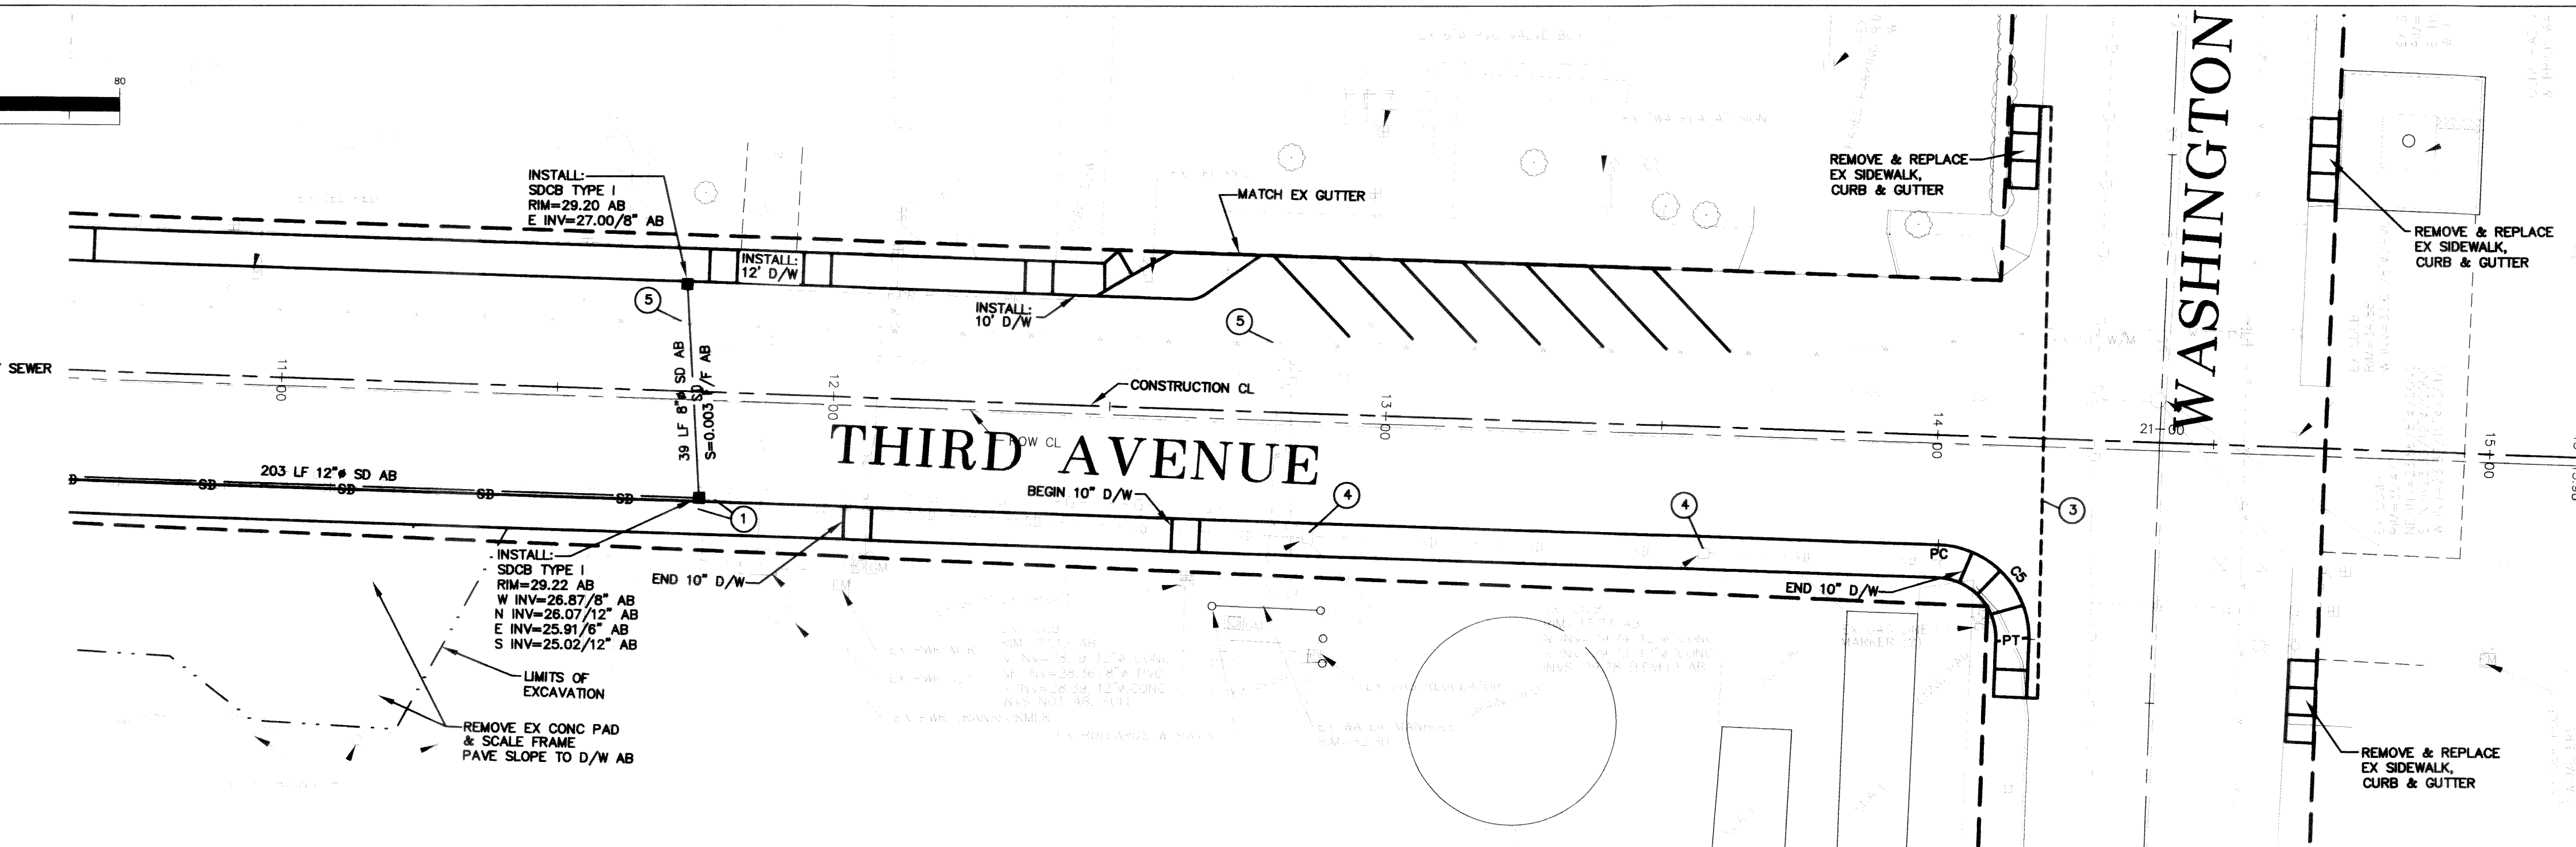


3RD & WASHINGTON CS			
R=17'	L=26.82'	Δ=90°23'25"	
STA/OFFSET	3RD	TO ELV	
PC	14+03.52, 18.5'R	35.03	
		35.20	
		35.36	
		35.53	
PT	14+20.52, 35.12'R	35.70	

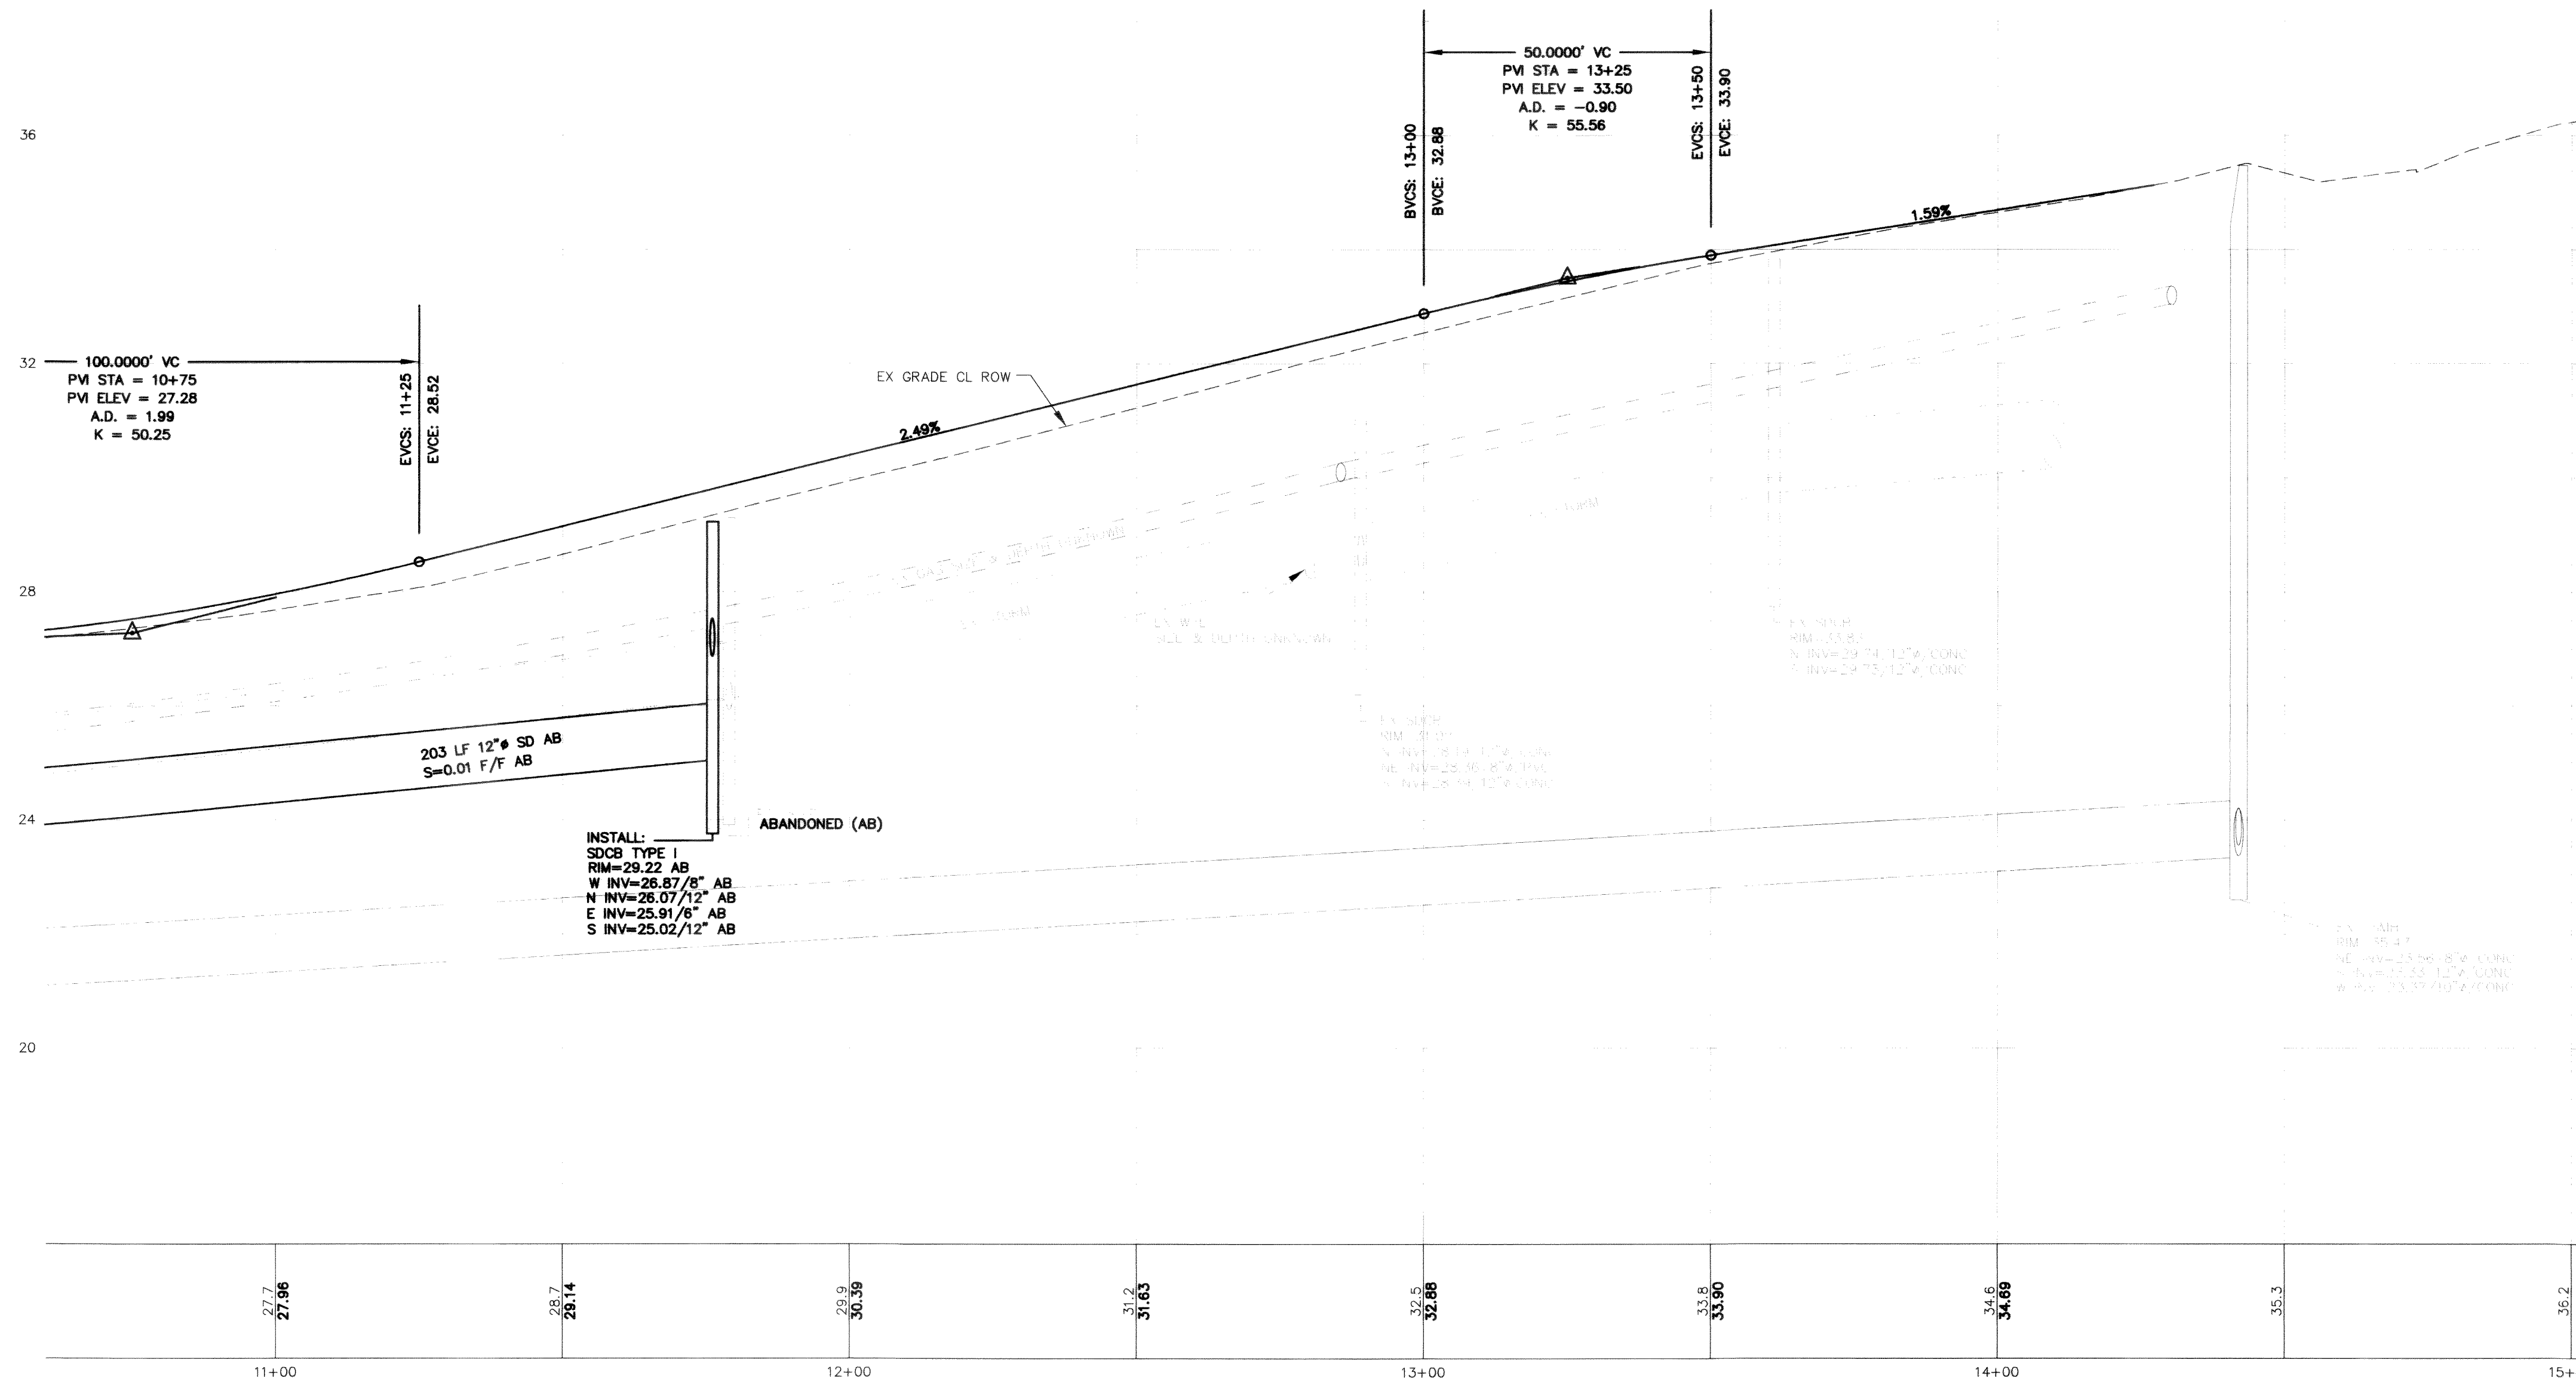

DATE: 1-26-07

AS-BUILT

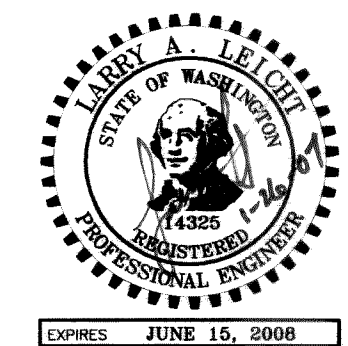

DESIGNED BY
LL

DRAWN BY
LMC

CHECKED BY



REICHARDT & EBE
ENGINEERING, INC.
CONSULTING ENGINEERS
PO Box 978 423 Front St., Ste 201 Ph (360) 354-3687
Lynden, Washington 98264 Fax (360) 354-0407

NO.	DATE	REVISION	BY

CITY OF FERDALE
2085 MAIN STREET
FERDALE, WASHINGTON 98248

THIRD AVENUE
STREET IMPROVEMENTS
3RD AVE STA 11+00 TO 15+00
STREET AND STORM

JOB# / DWG
03010.1 SP1.20SC.AB


SCALE
H: 1"=20' V: 1"=2'

DATE
4-13-06


SHEET
4 of 13

00841.004 3-22-07 RLB



00341.00S 3-22-07 KK

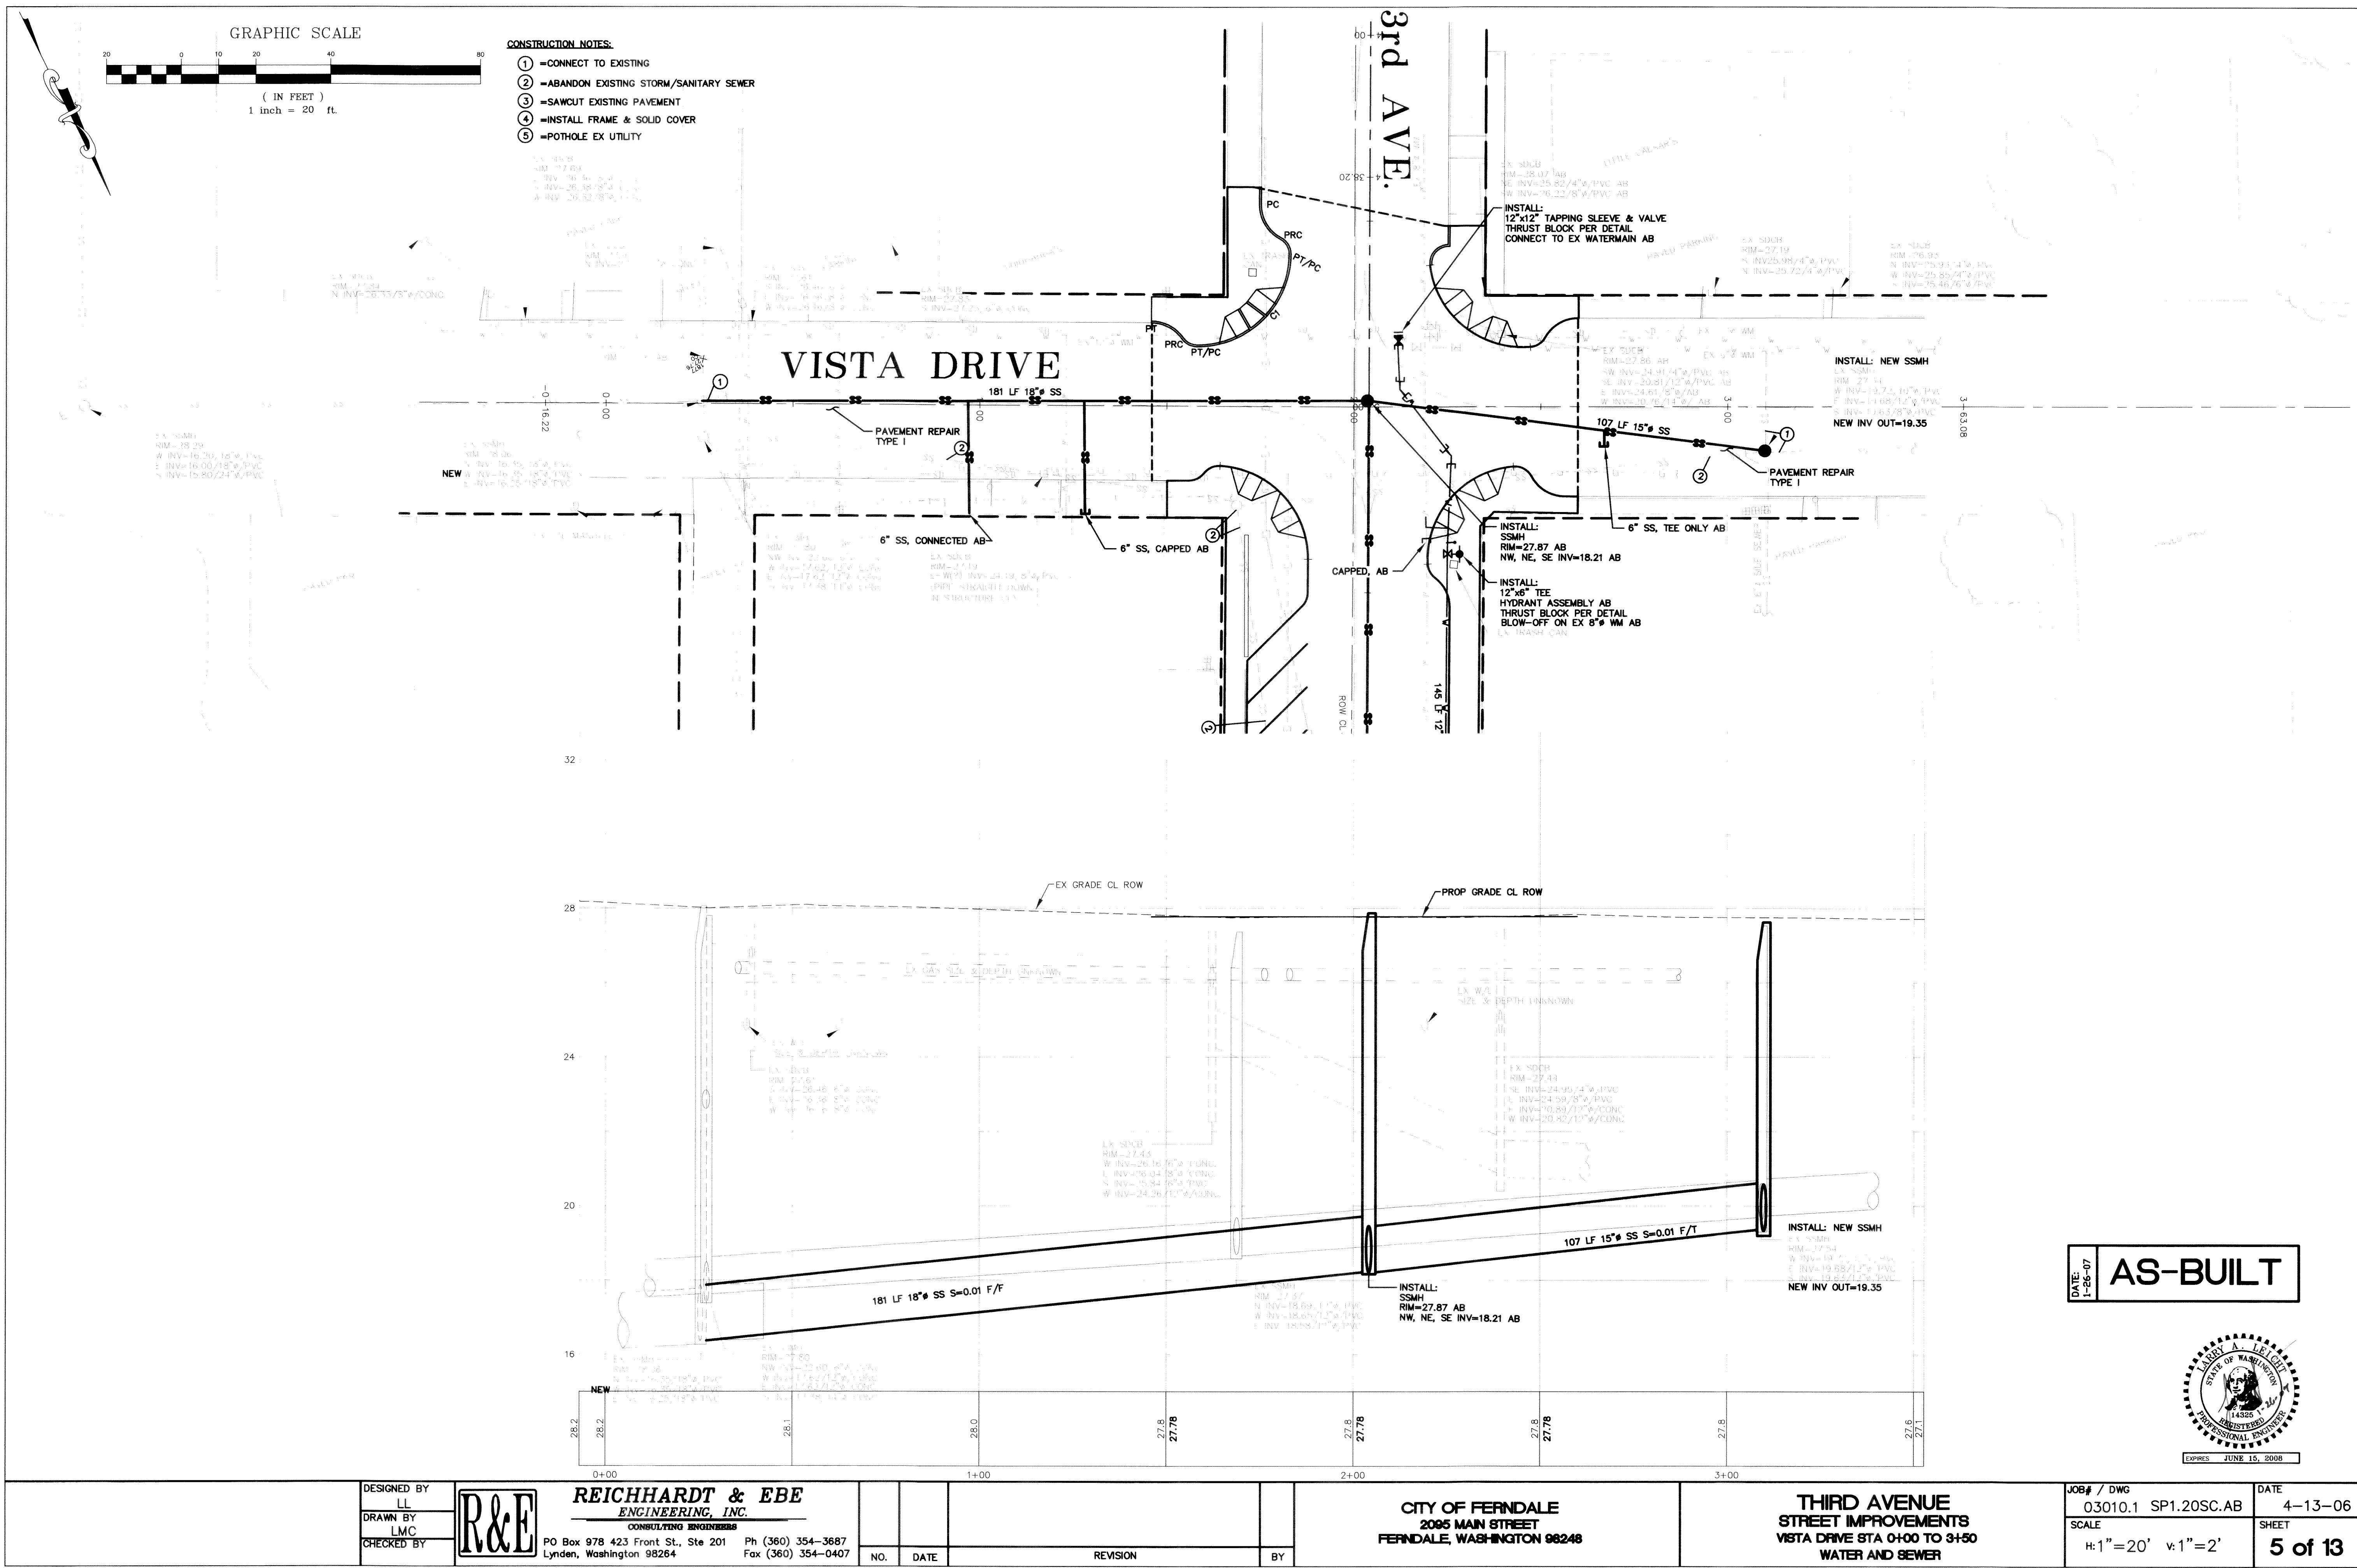


P:\Projects\03010.1\map\030103P1_20SC.AB.dwg, WASHINGTON, 02/02/2007 09:55:52 AM

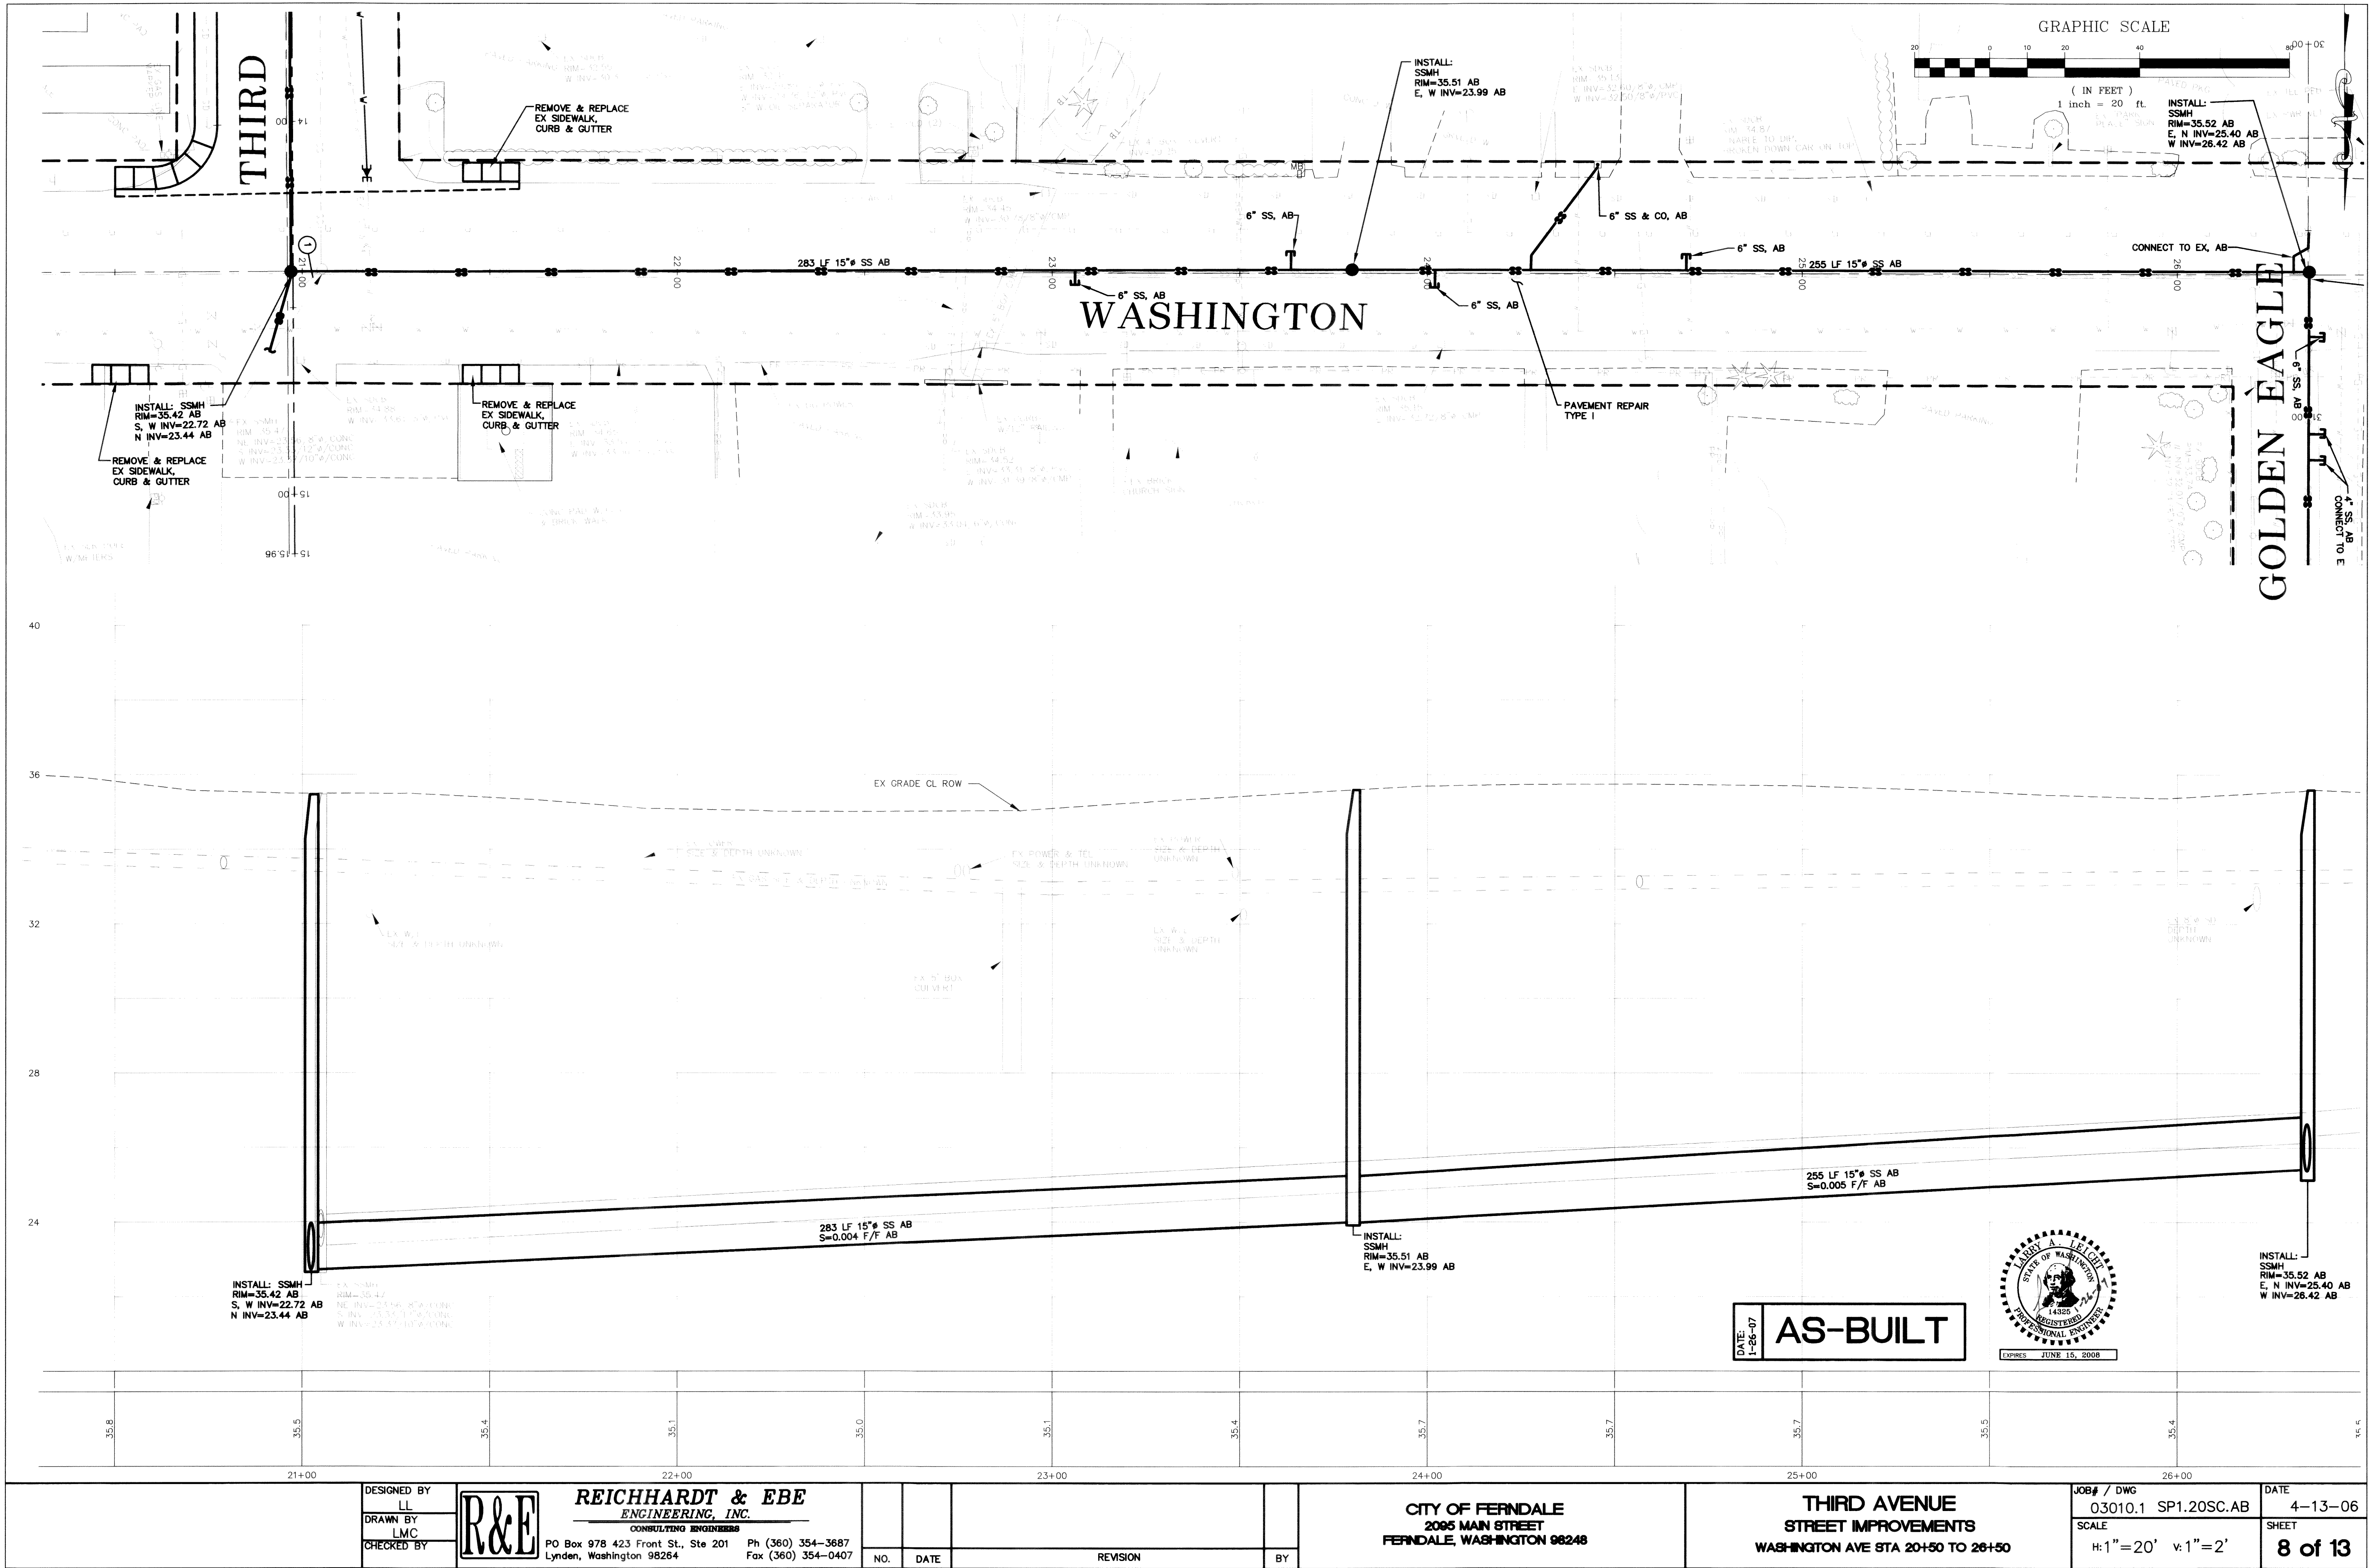

00341.008 3:22.07 KR

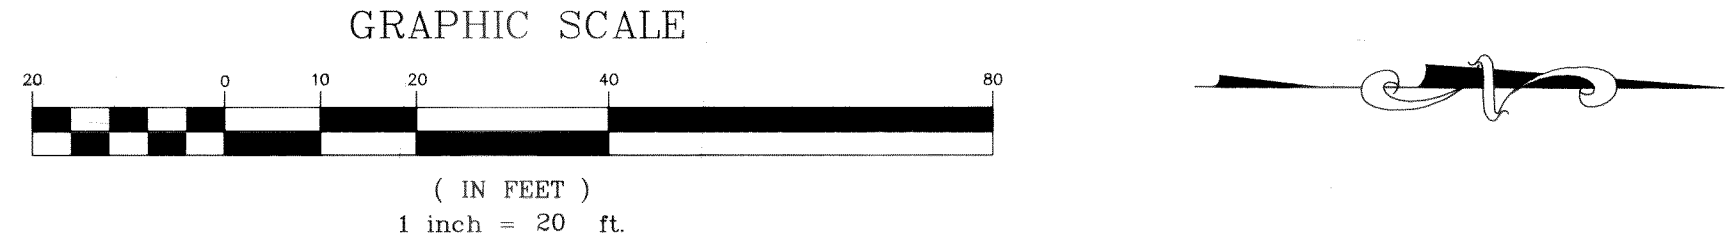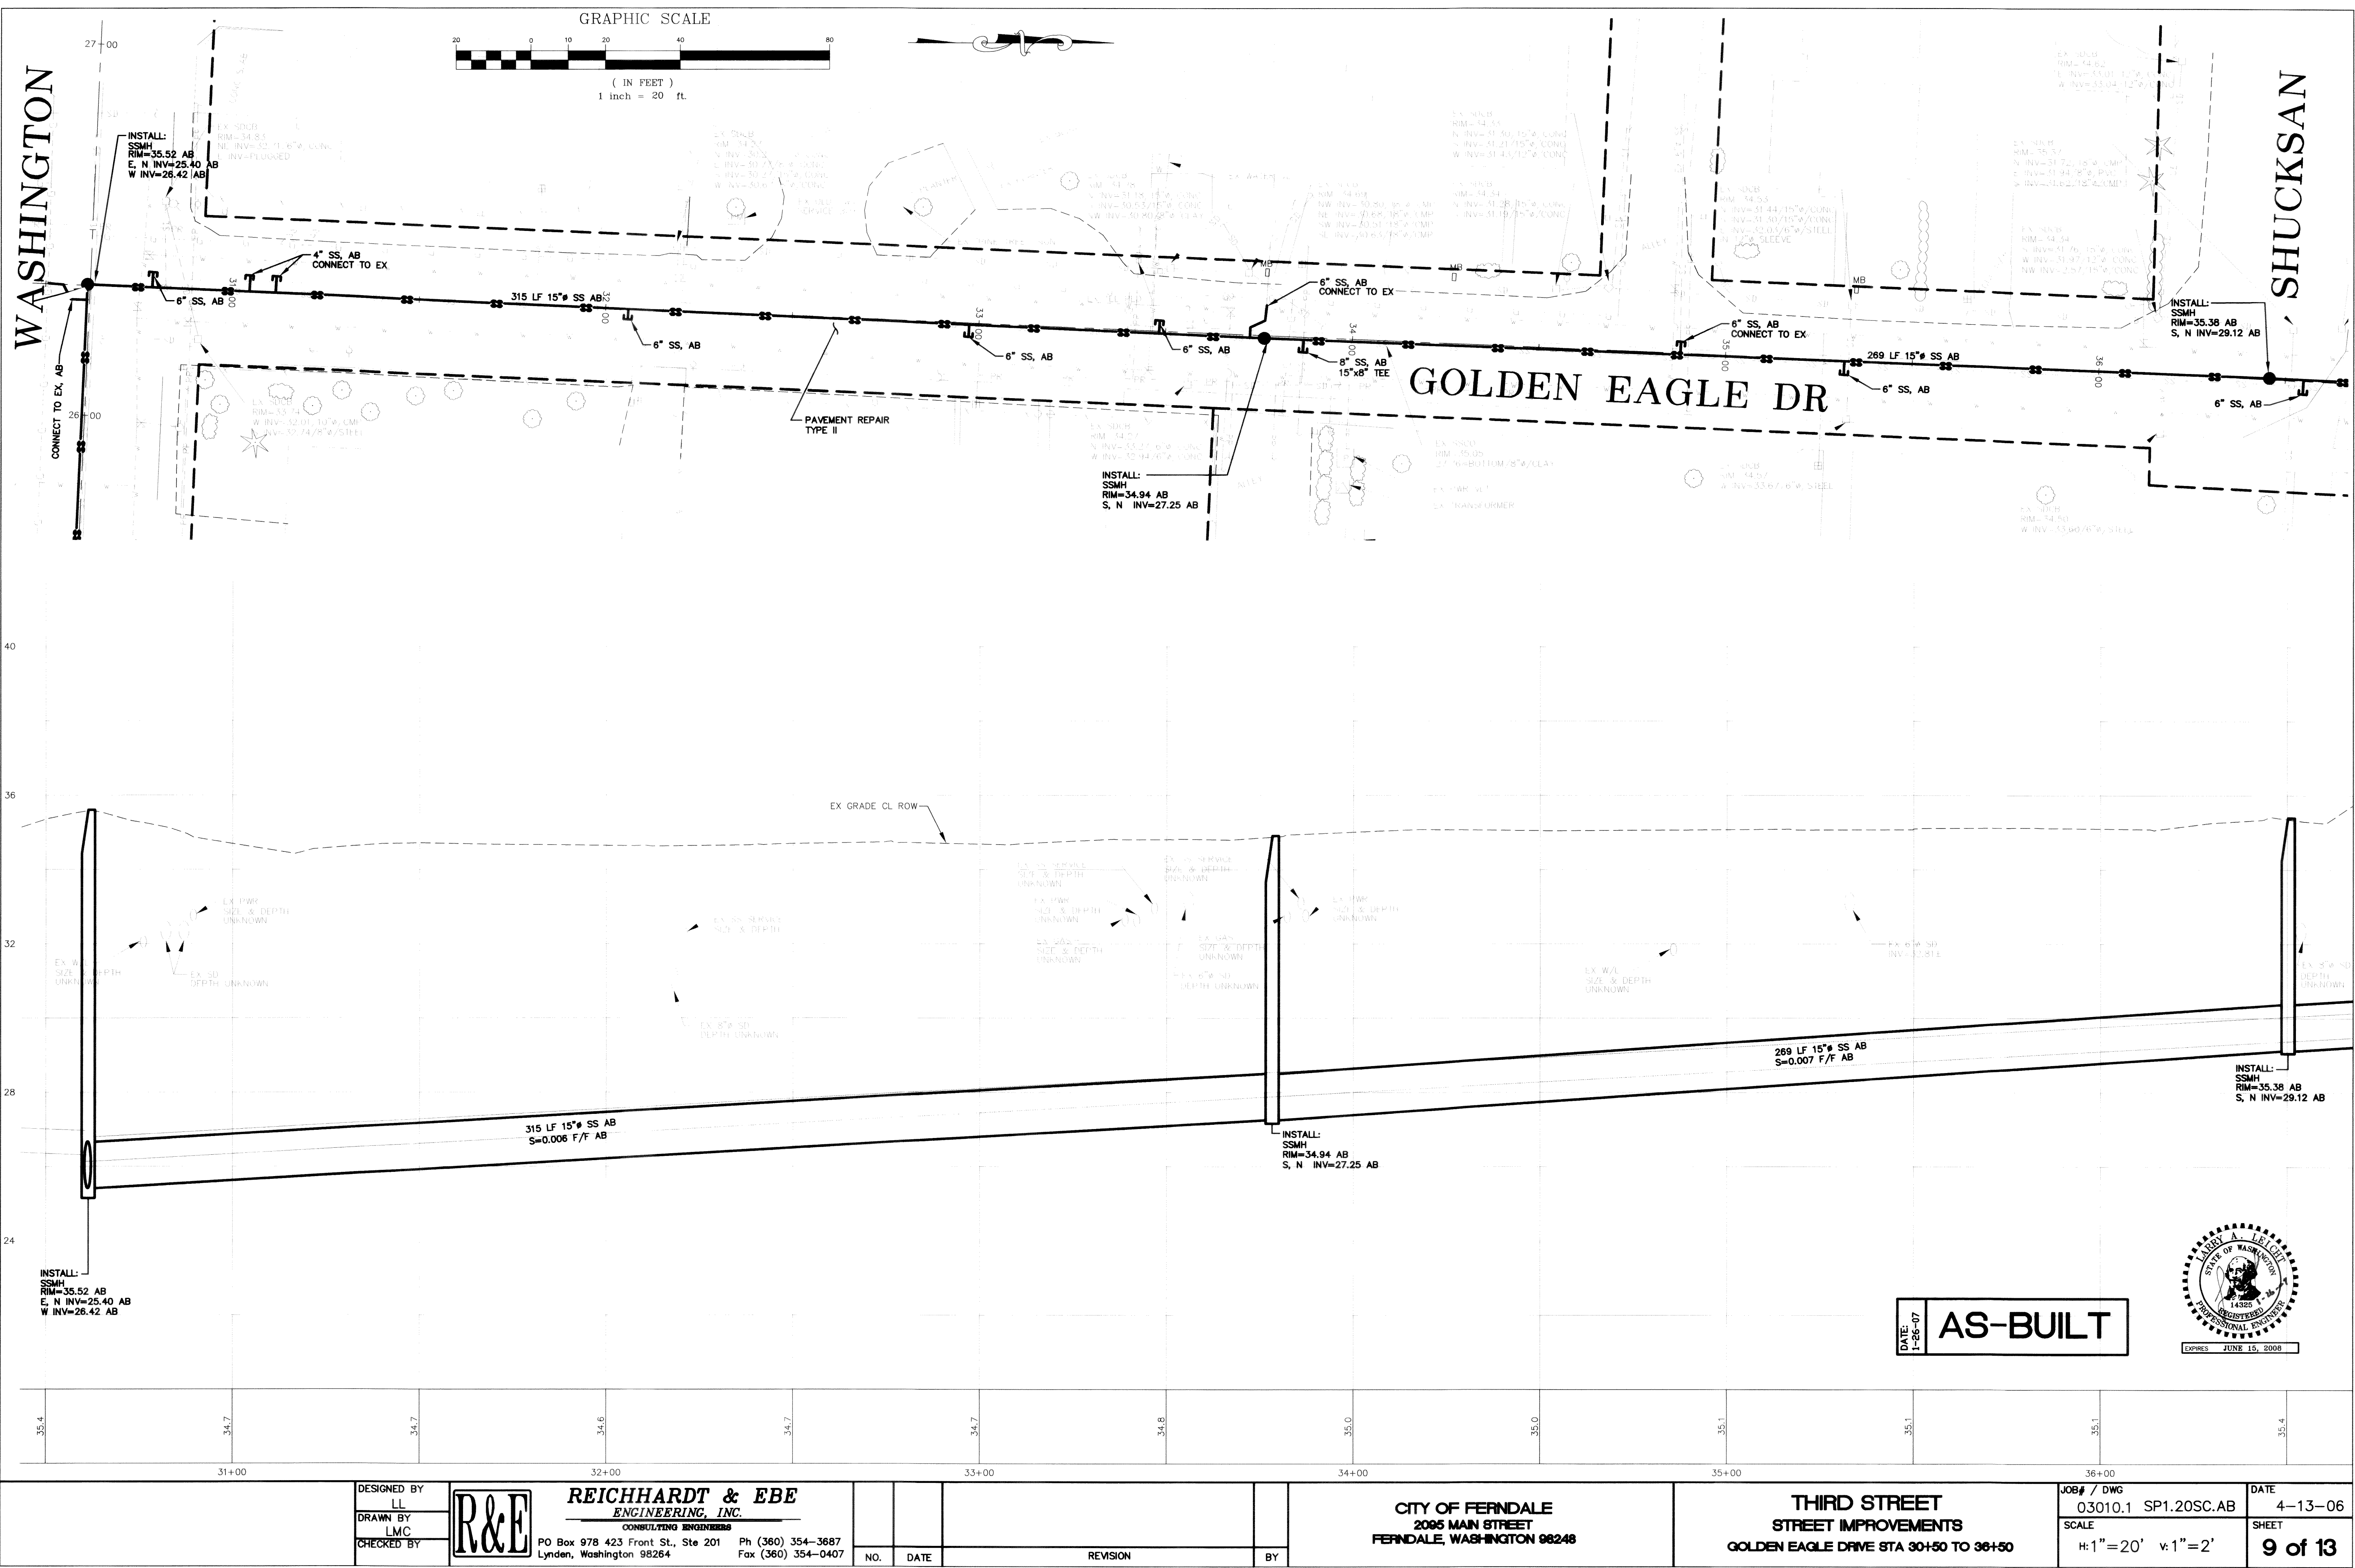


DATE: 1-26-07
AS-BUILT

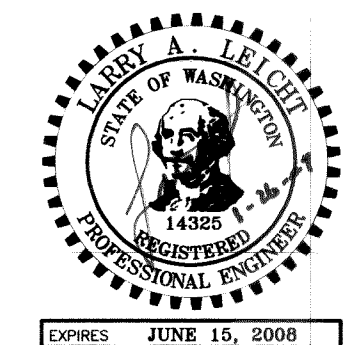


DESIGNED BY LL	 REICHHARDT & EBE ENGINEERING, INC. CONSULTING ENGINEERS PO Box 978 423 Front St., Ste 201 Lynden, Washington 98264	Ph (360) 354-3687 Fax (360) 354-0407	NO.	DATE	REVISION	BY	CITY OF FERNDALE 2095 MAIN STREET FERNDALE, WASHINGTON 98248	THIRD STREET STREET IMPROVEMENTS GOLDEN EAGLE DRIVE STA 30+50 TO 36+50	JOB# / DWG 03010.1 SP1.20SC.AB	DATE 4-13-06
DRAWN BY LMC									SCALE H: 1" = 20' V: 1" = 2'	SHEET 9 of 13
CHECKED BY										

00341.009 322.07 RL

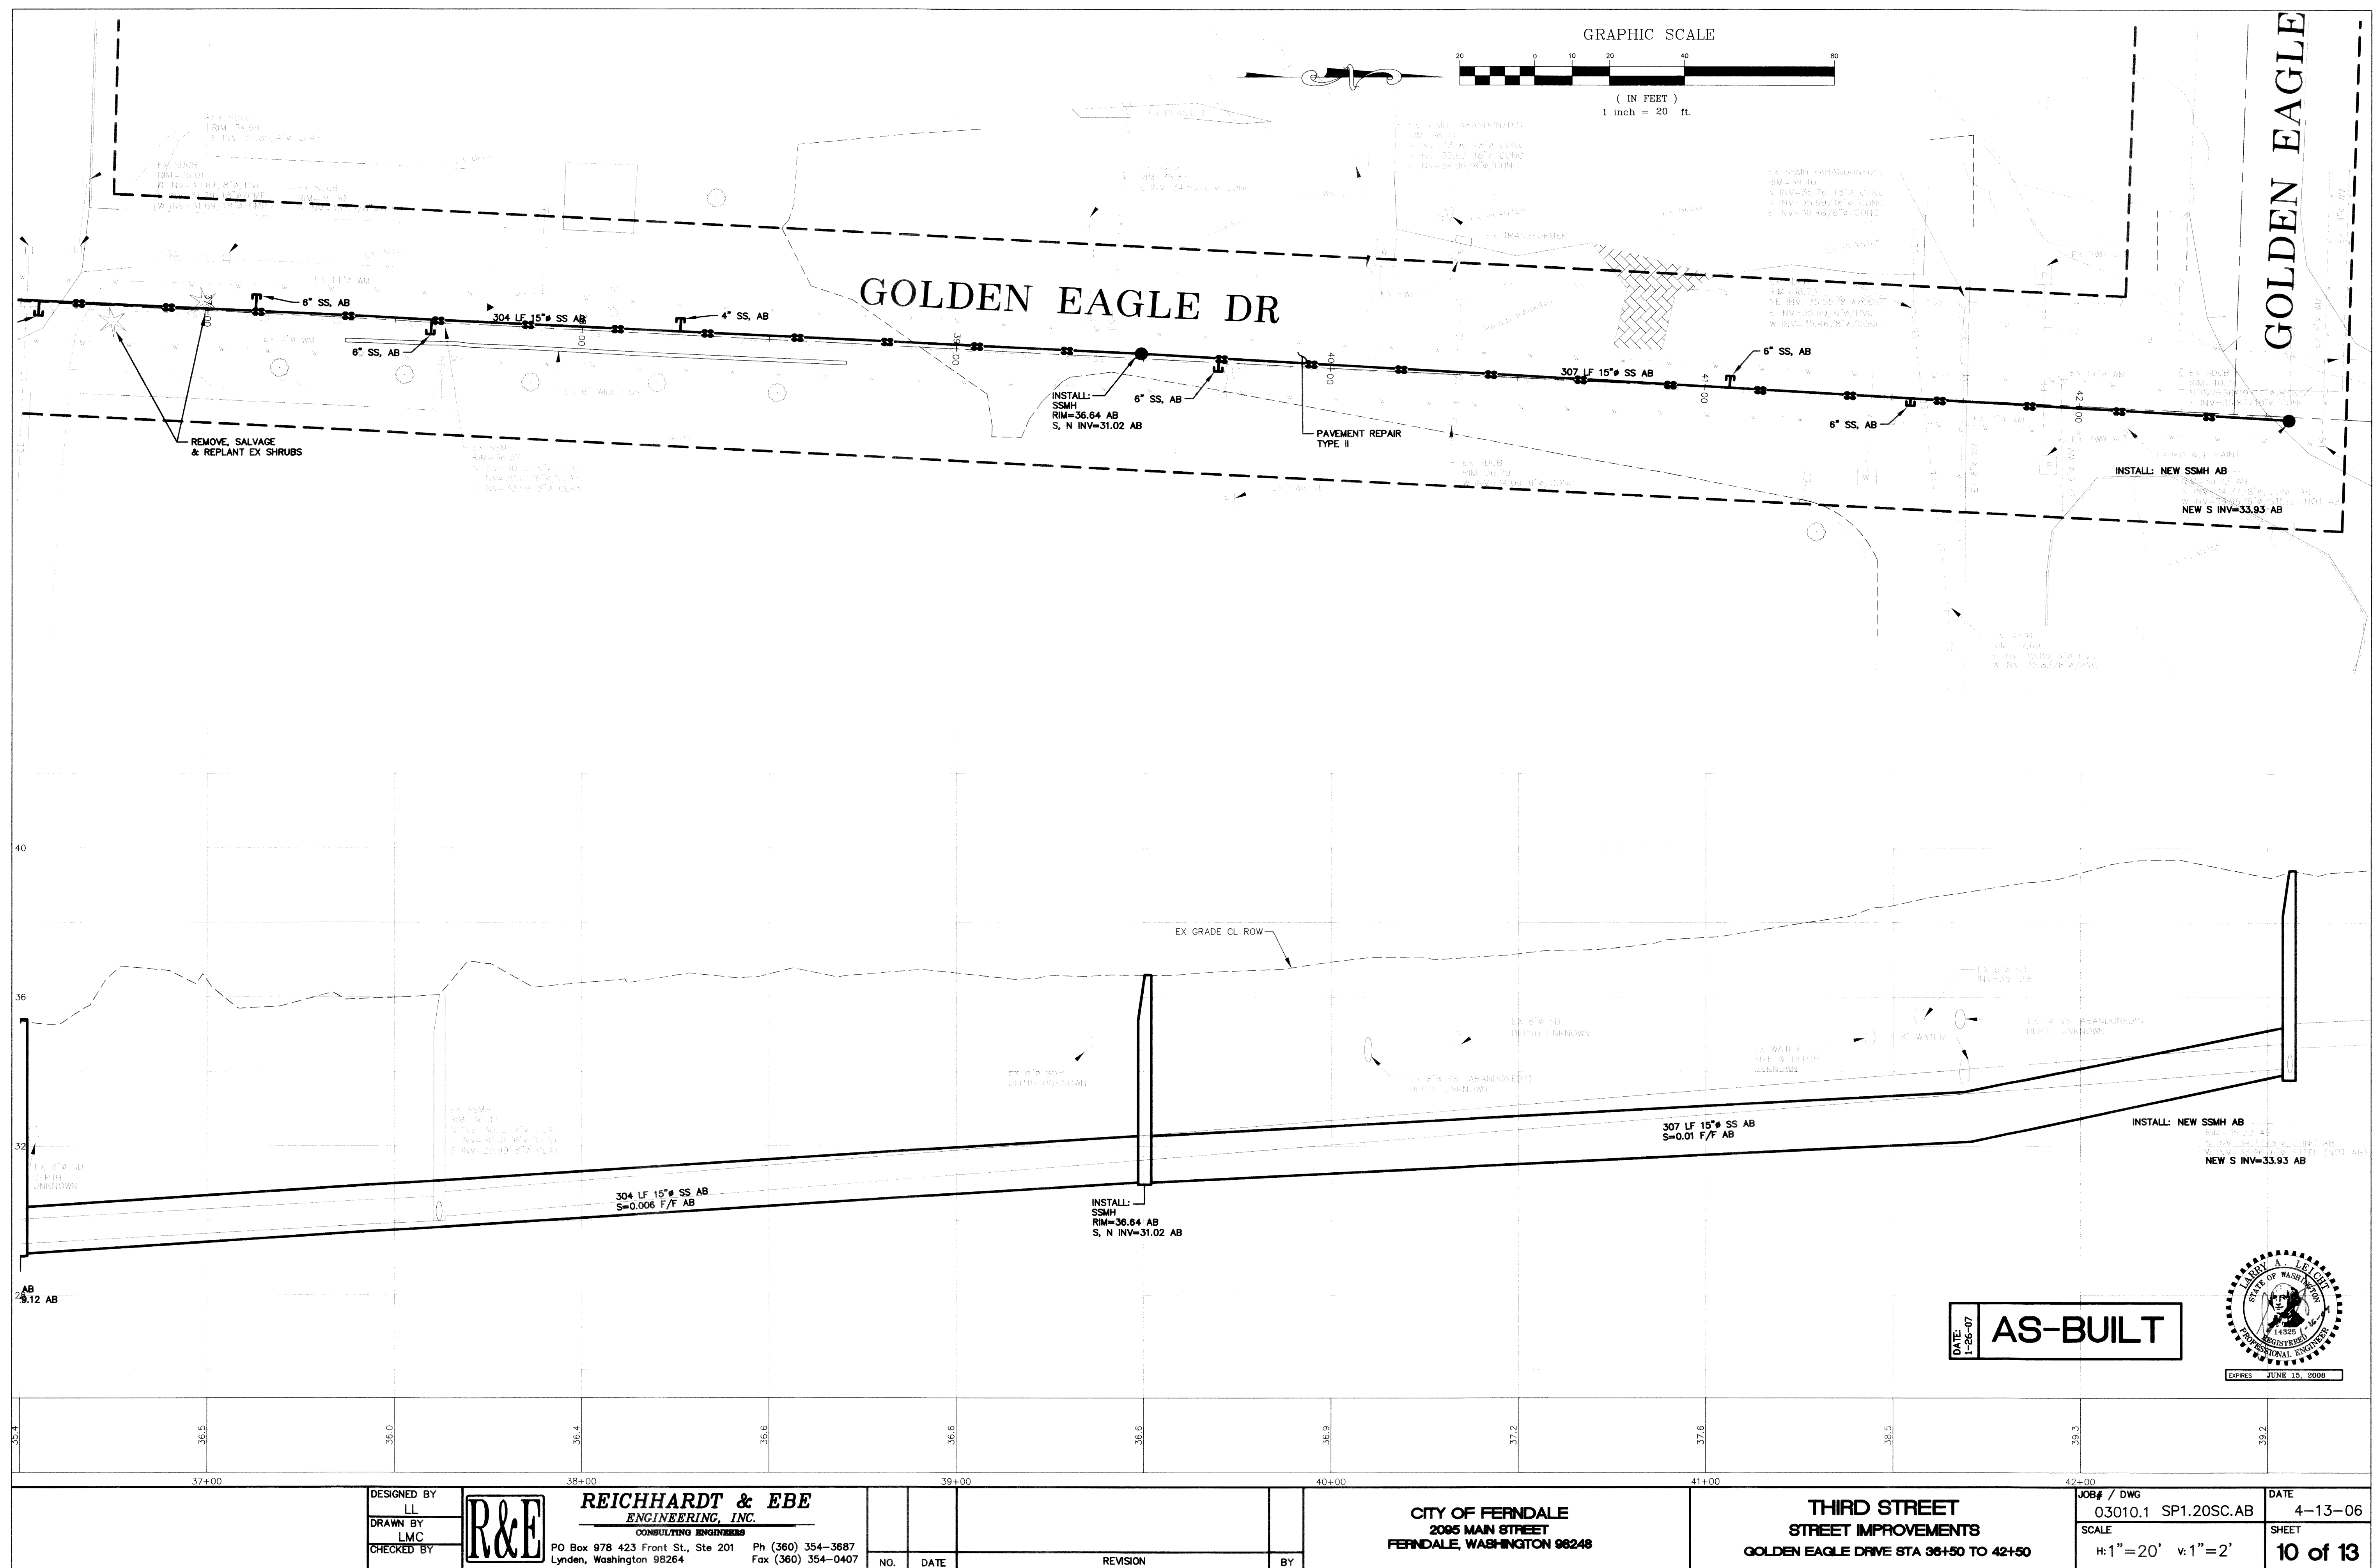

P:\Projects\030101\030101\030101SP1_20SC.AB.dwg, EC, 02/02/2007 09:52:44 AM

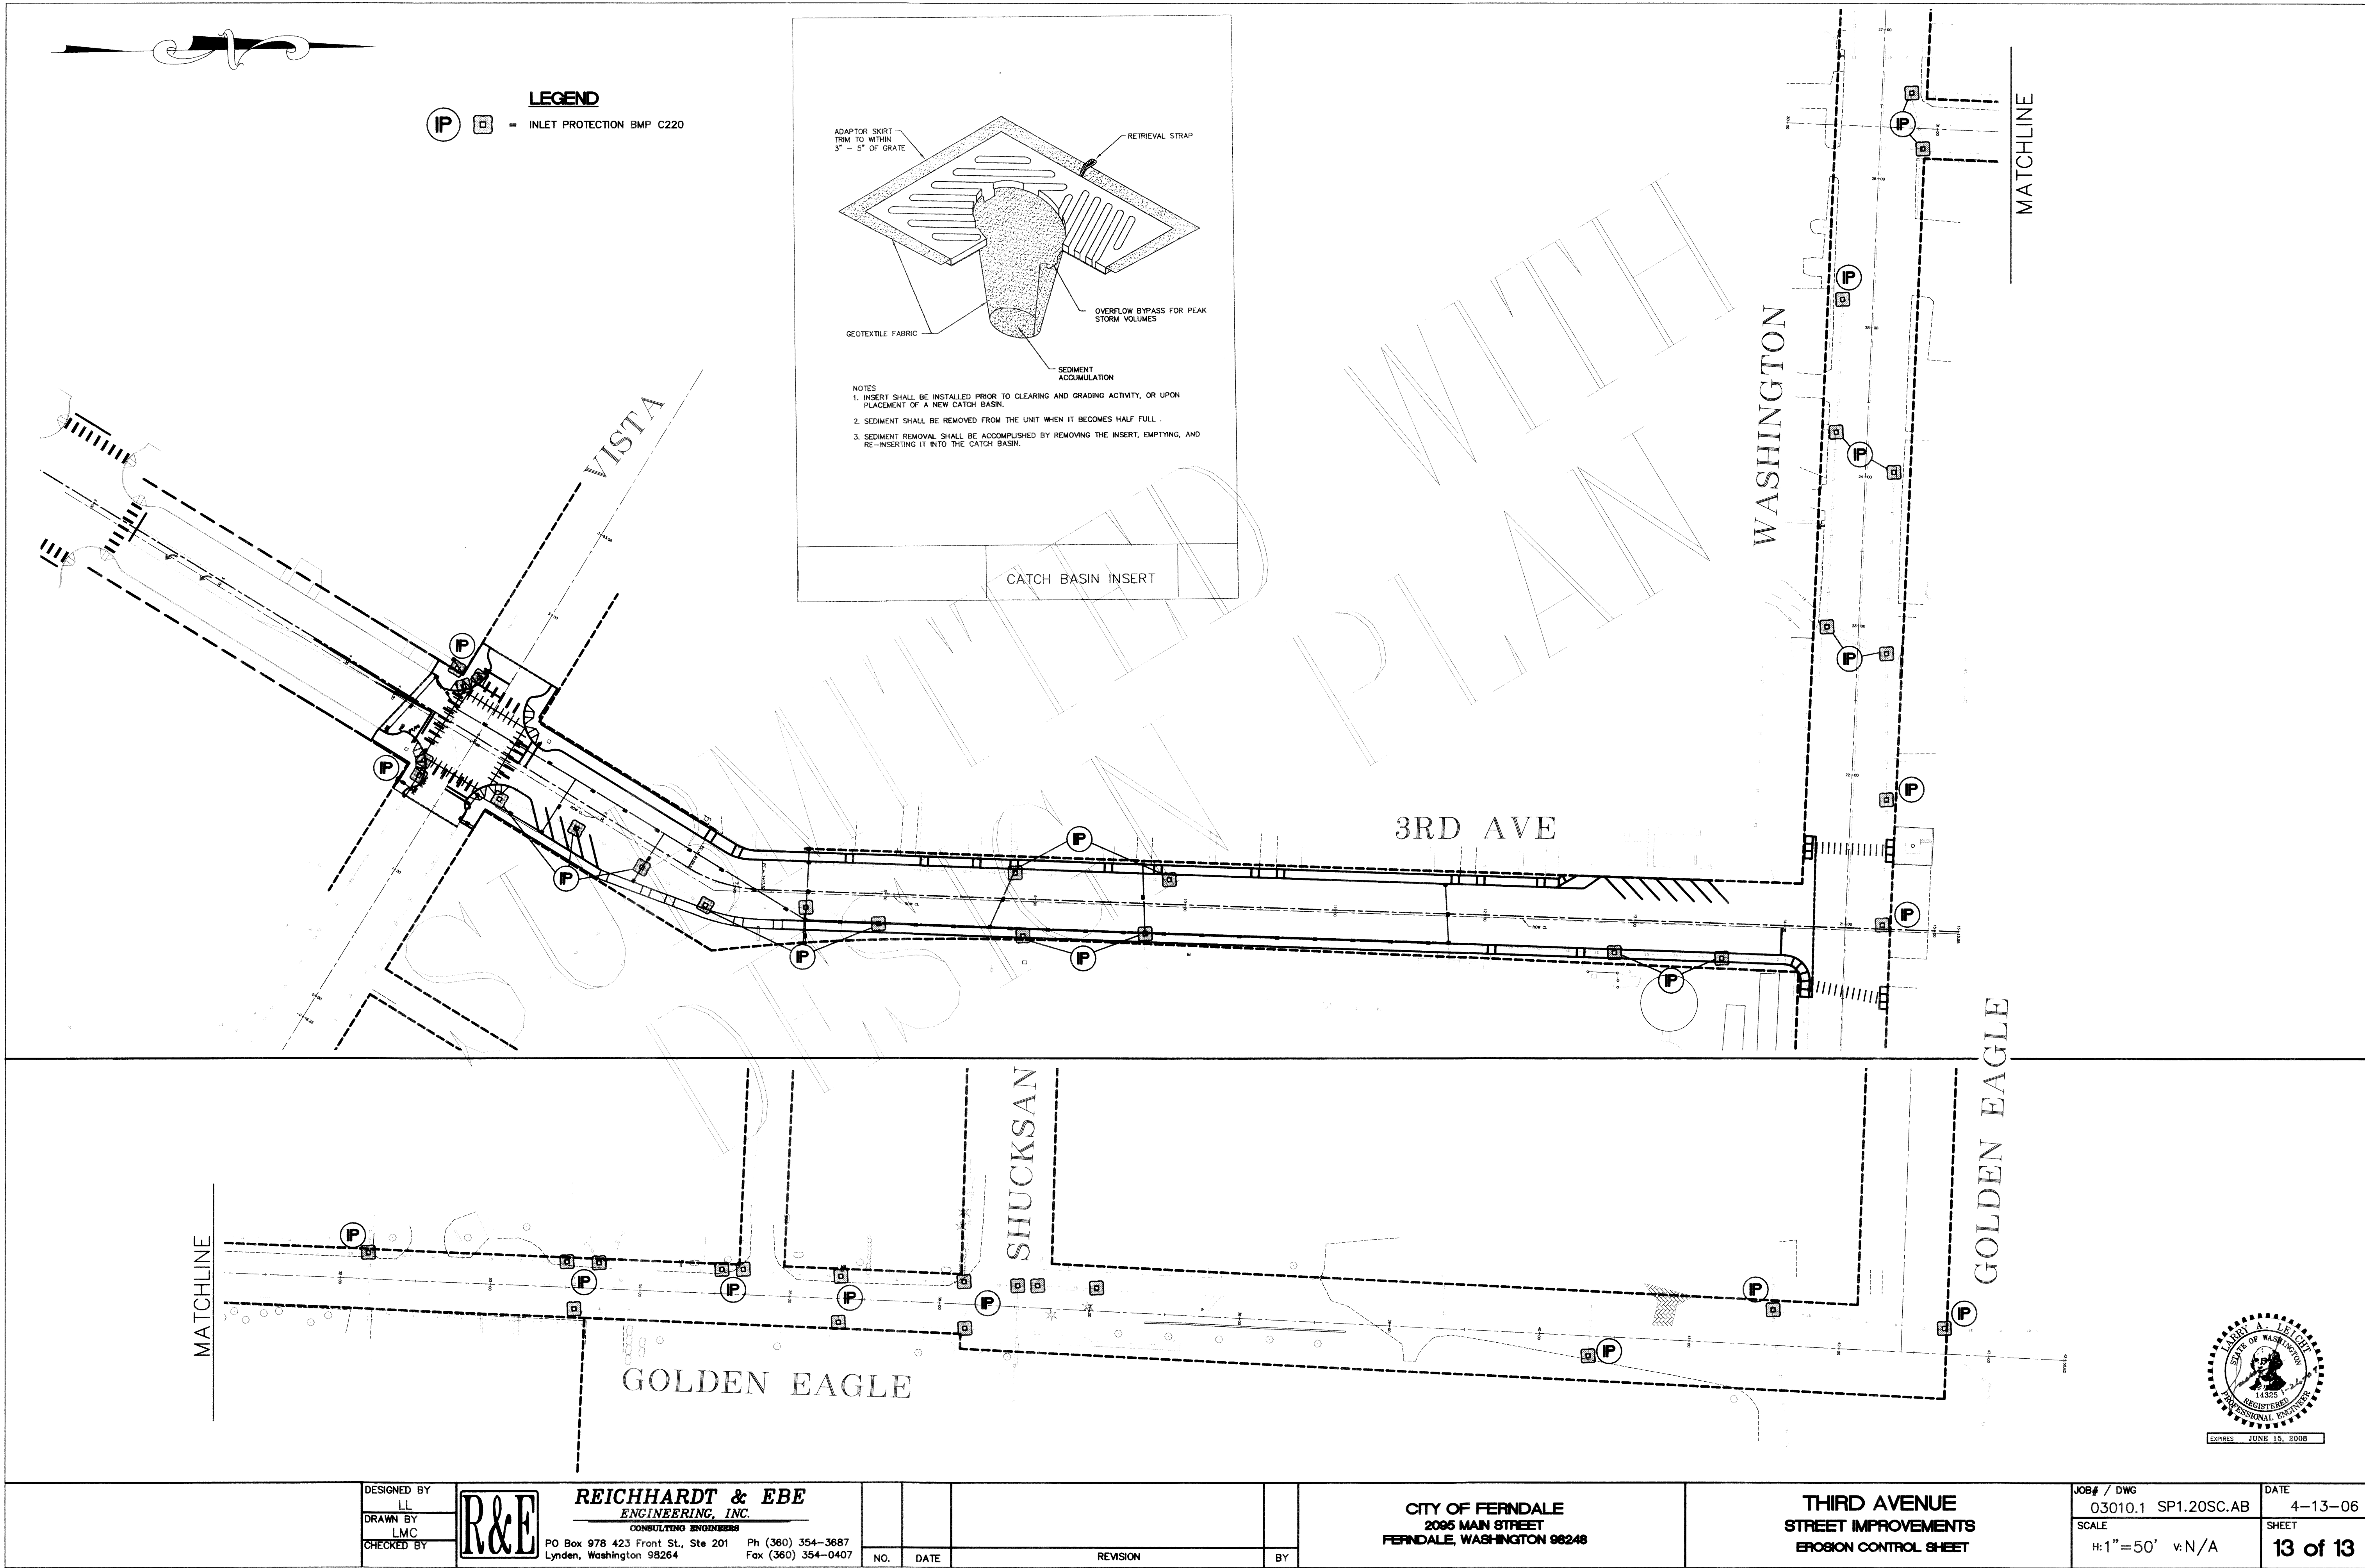

DESIGNED BY
LL
DRAWN BY
LMC
CHECKED BY



REICHHARDT & EBE
ENGINEERING, INC.
CONSULTING ENGINEERS

PO Box 978 423 Front St., Ste 201 Ph (360) 354-3687
Lynden, Washington 98264 Fax (360) 354-0407

NO.

DATE

REVISION

BY

CITY OF FERNDALE
2085 MAIN STREET
FERNDALE, WASHINGTON 98248

THIRD AVENUE
STREET IMPROVEMENTS
EROSION CONTROL SHEET

JOB# / DWG
03010.1 SP1.20SC.AB

SCALE
H:1"=50' V:N/A

DATE
4-13-06

SHEET
13 of 13

00841.013 3.22.07 NK