
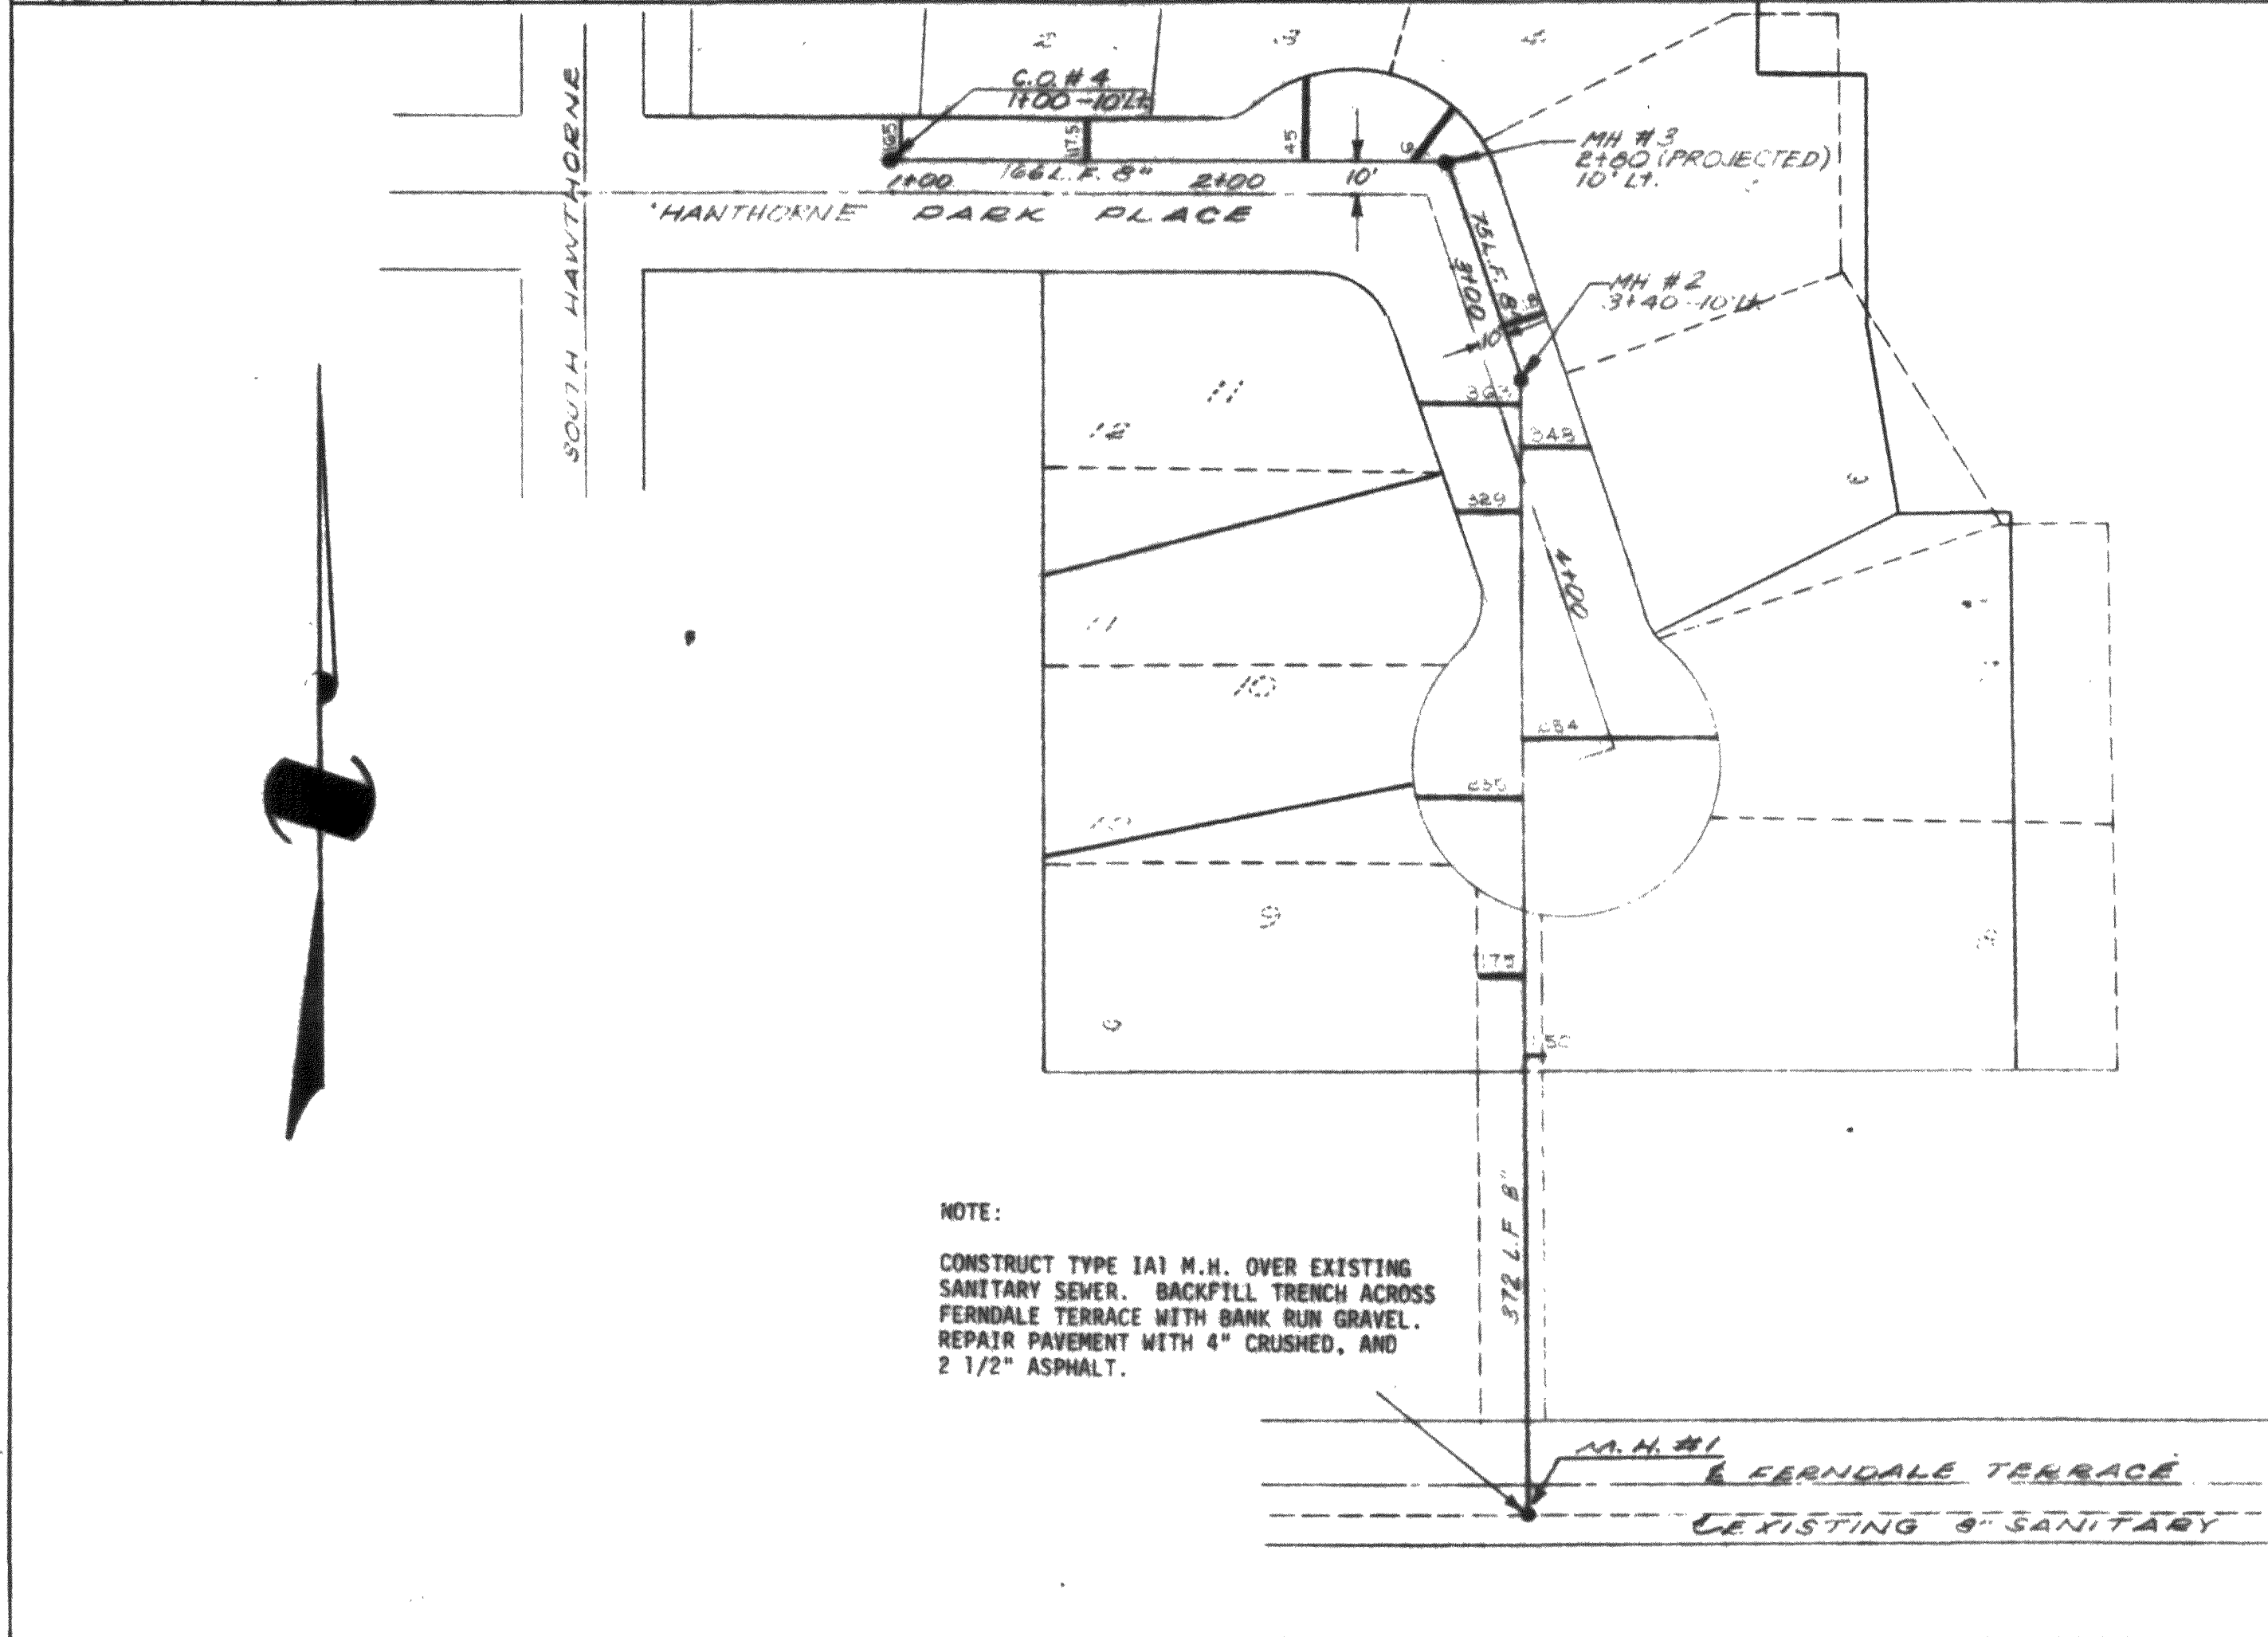


PROFILE	
BY	DATE
SURVEYED PLOTTED GRADES CHECKED ALIGNED CHECKED STRUCTURE NOTATION OK'D	



PLAN	
BY	DATE
SURVEYED PLOTTED GRADES CHECKED ALIGNED CHECKED STRUCTURE NOTATION OK'D	

2-13-00 10018000

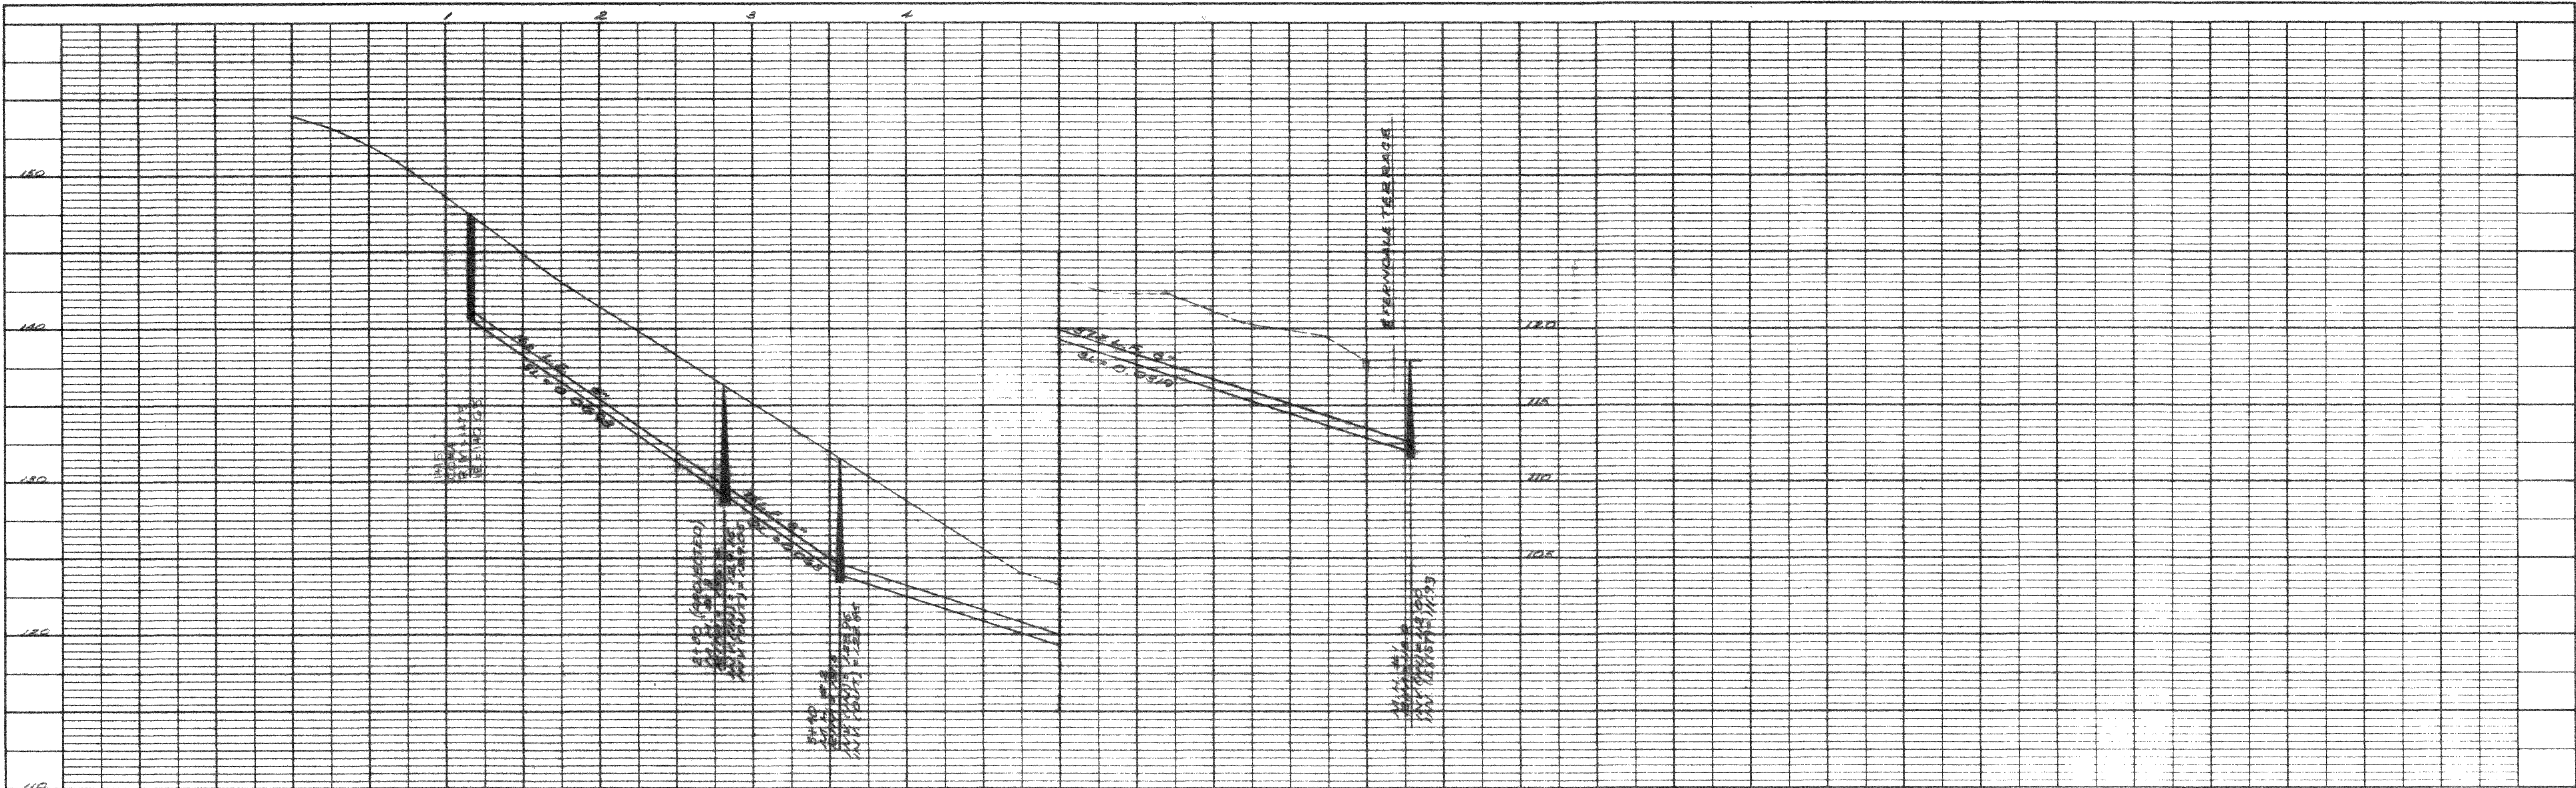




NOTE:

CONSTRUCT TYPE 1A1 M.H. OVER EXISTING
SANITARY SEWER. BACKFILL TRENCH ACROSS
FERNDAL TERRACE WITH BANK RUN GRAVEL.
REPAIR PAVEMENT WITH 4" CRUSHED, AND
2 1/2" ASPHALT.

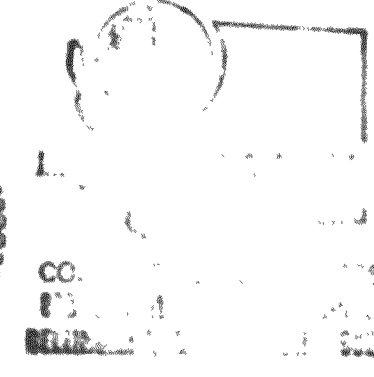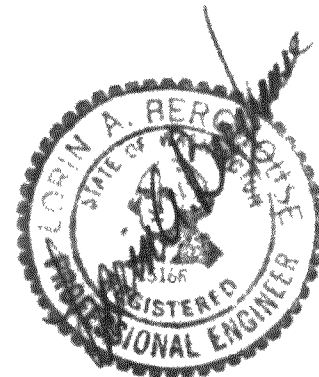


CLIENT	JOHN BRIGHT		
PROJECT	HANTHORNE PARK PLACE SANITARY SEWER DESIGN		
DRAWN BY	DATE	SCALE	SHEET
L.S.	AUG '78	1" = 50' HORIZ. 1" = 5'	2

AS-BUILT

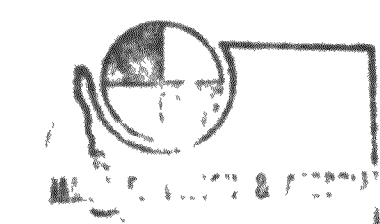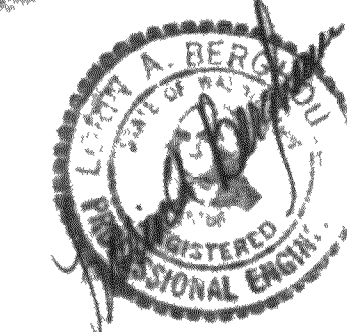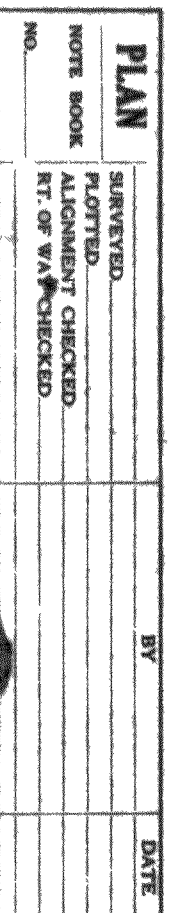

CONFIDENTIAL
805 211 1111 104-8100
RECEIVED 104-8100 80225

CLIENT	JOHN BRIGHT		
PROJECT	HAWTHORNE PARK PLACE ROAD AND STORM DESIGN		
DRAWN BY	SCALE	SHEET	
4. S.	1"=30'-HORIZ, 1"=5'-VERT		
APPROVED	DATE	P. BOOK	JOB
	AUG. '78		07078

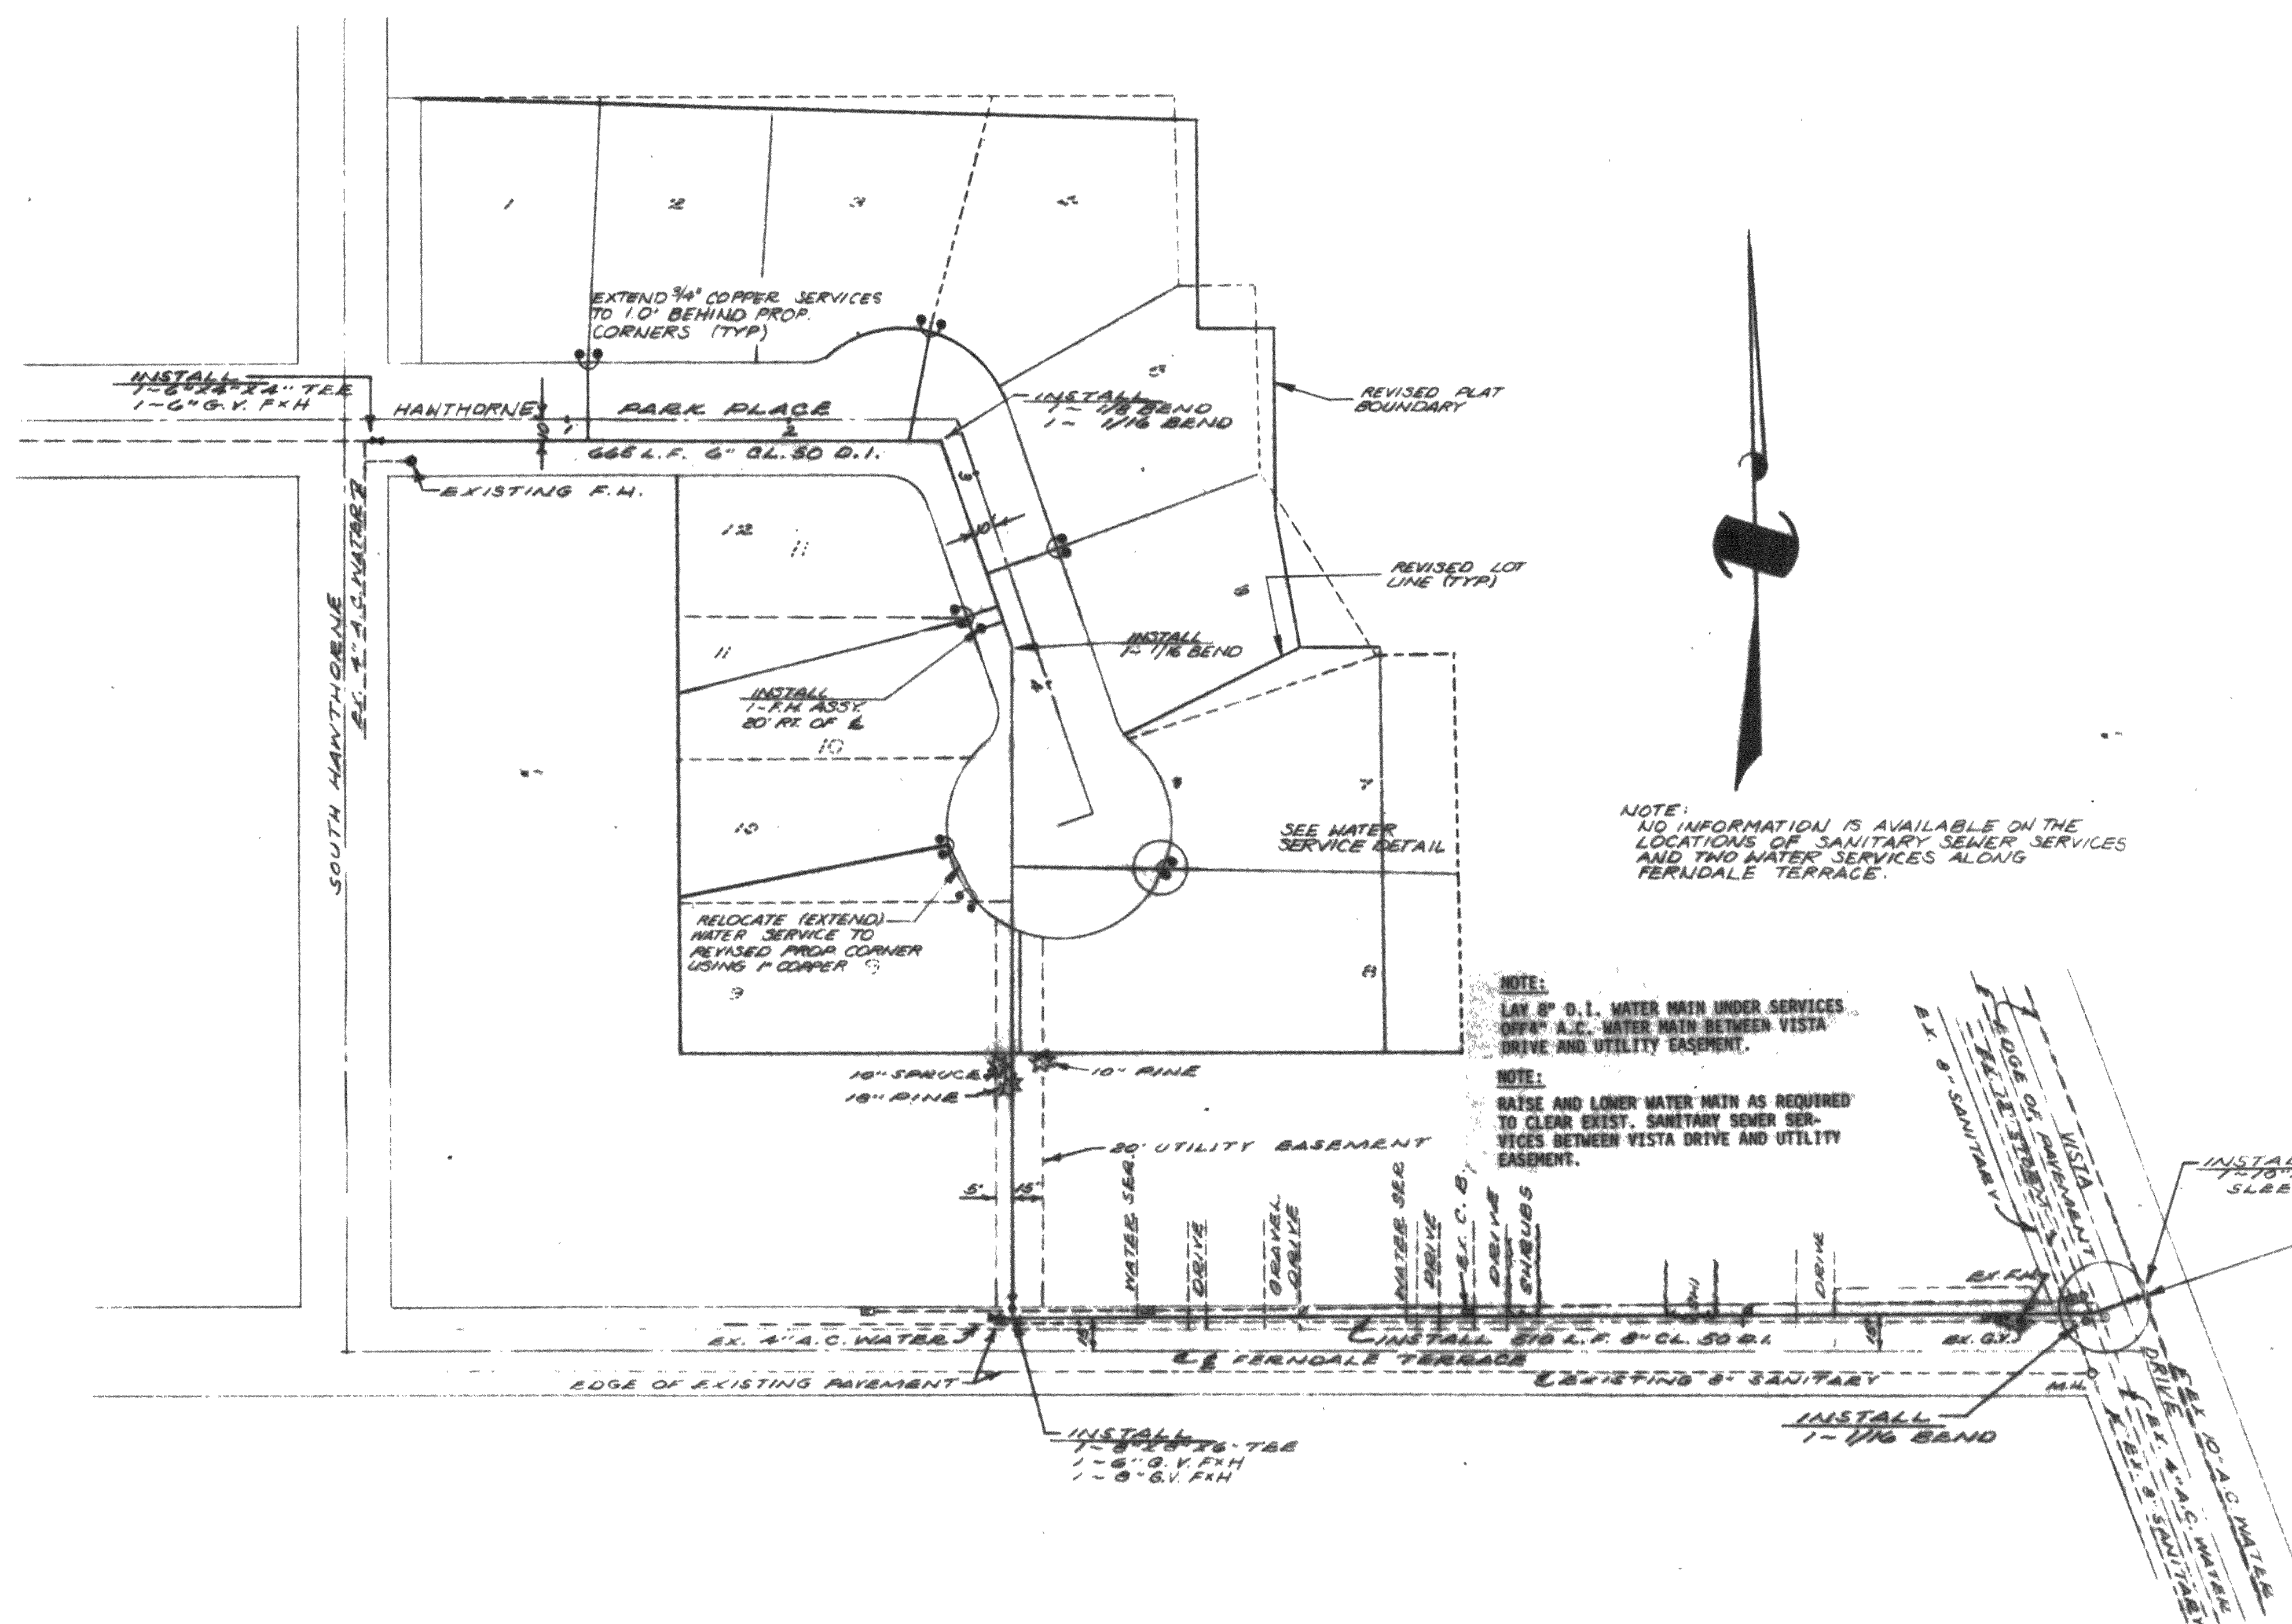

NOTE:
NO INFORMATION IS AVAILABLE ON THE
LOCATIONS OF SANITARY SEWER SERVICES
AND TWO WATER SERVICES ALONG
FERNDAL TERRACE.

NOTE:
LAY 8" D.I. WATER MAIN UNDER SERVICES
OFF 4" A.C. WATER MAIN BETWEEN VISTA
DRIVE AND UTILITY EASEMENT.

NOTE:
RAISE AND LOWER WATER MAIN AS REQUIRED
TO CLEAR EXIST. SANITARY SEWER SER-
VICES BETWEEN VISTA DRIVE AND UTILITY
EASEMENT.

SCALE: 1" = 10'

INSTALL
1" TO 10" X 10" X 8" TAPPING
SLEEVE WITH 8" G. V.

SEE DETAIL.

2.	PLAT BOUNDARY AND LOT LINES WATER SERVICE TO LOTS 9 AND 10	MAR. '79
1.	ADD 5" GV. ON 5" x 6" TEE	DEC. '78
REV. NO.	REVISION	DATE
JOHN BRIGHT		
SCALE: 1" = 50'	APPROVED BY:	DRAWN BY L. B.
DATE: AUG '78		REVISED
HAWTHORNE PARK PLACE		
WATER DESIGN		DRAWING NUMBER 07978 4/3

