

PLAN	DATE	BY
NO.		
NOTE BOOK	ALIGNMENT CHECKED	
NO.	RT. OF WAY CHECKED	


MADE BY	DATE	BY
CHECKED BY	DATE	BY
LOC. ENGR.	DATE	BY
SIGN.	DATE	BY

PROFILE	DATE	BY
NO.		
NOTE BOOK	GRADES CHECKED	
NO.	STRUCTURE NOTATIONS CHKD	

T.39N,R.2E.W.M.

Railroad Right-of-way
Along Main Street

FED. ROAD DIST. NO.	STATE	FED. AID PROJ. NO.	FISCAL YEAR	SHEET NO.	TOTAL SHEETS
1	WASH.	137 B	1925	3	28

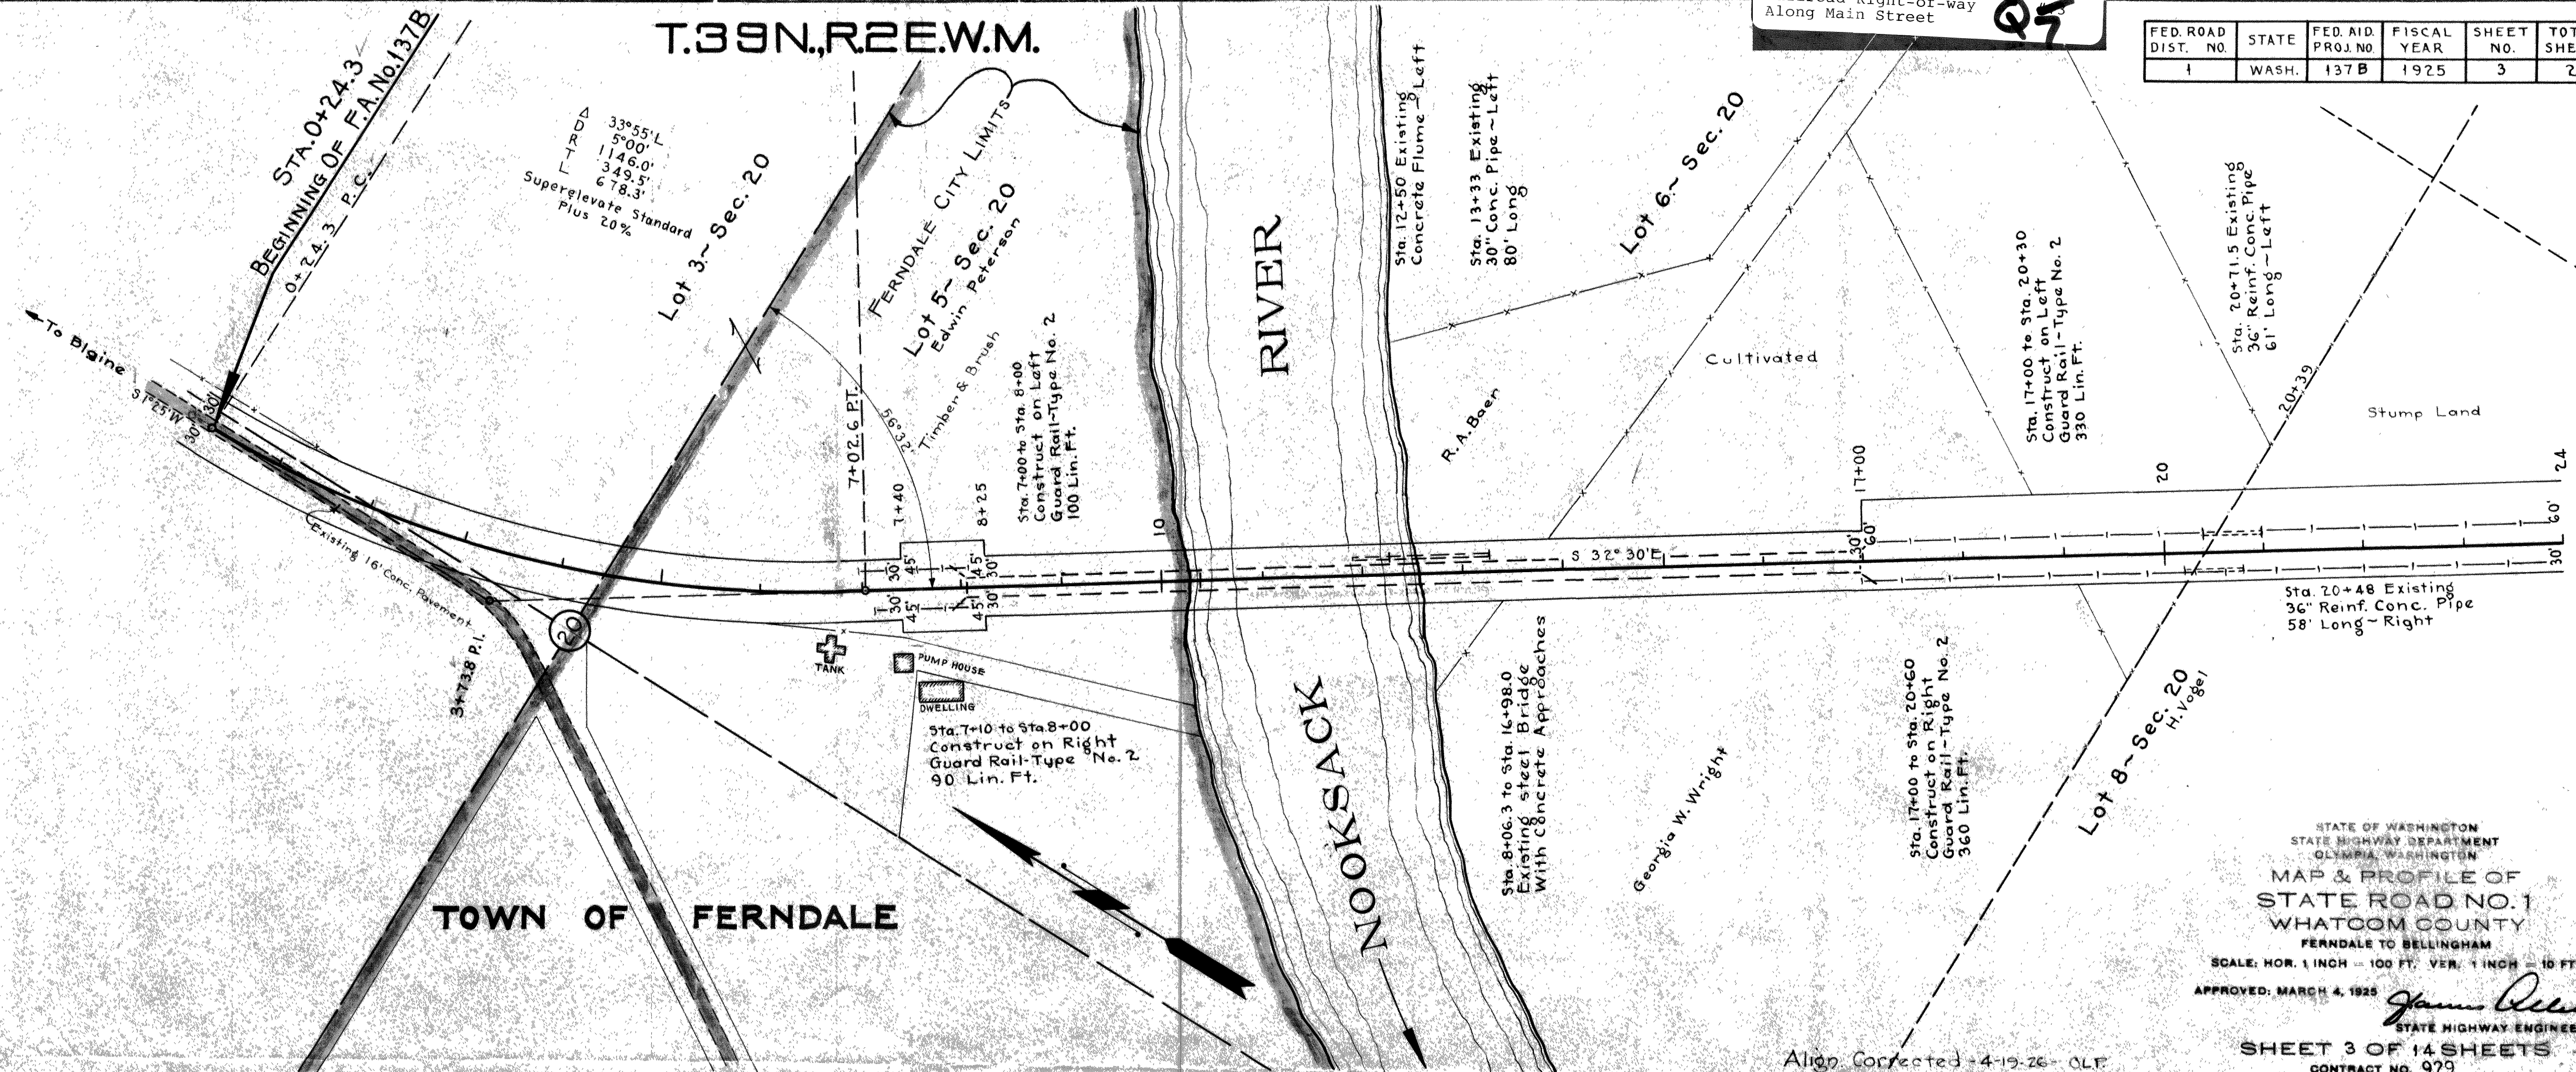

STATE OF WASHINGTON
STATE HIGHWAY DEPARTMENT
OLYMPIA, WASHINGTON
MAP & PROFILE OF
STATE ROAD NO. 1
WHATCOM COUNTY
FERNDALE TO BELLINGHAM
SCALE: HOR. 1 INCH = 100 FT. VER. 1 INCH = 10 FT.
APPROVED: MARCH 4, 1925
SHEET 3 OF 14 SHEETS
CONTRACT NO. 929

