


\\FERDALE\Share\Common\Land Projects\2017\1714-WaterMain Extension Nordic Way.dwg 1714-Water-AB.dwg PLOT DATE: 2/6/2018 1:46 PM

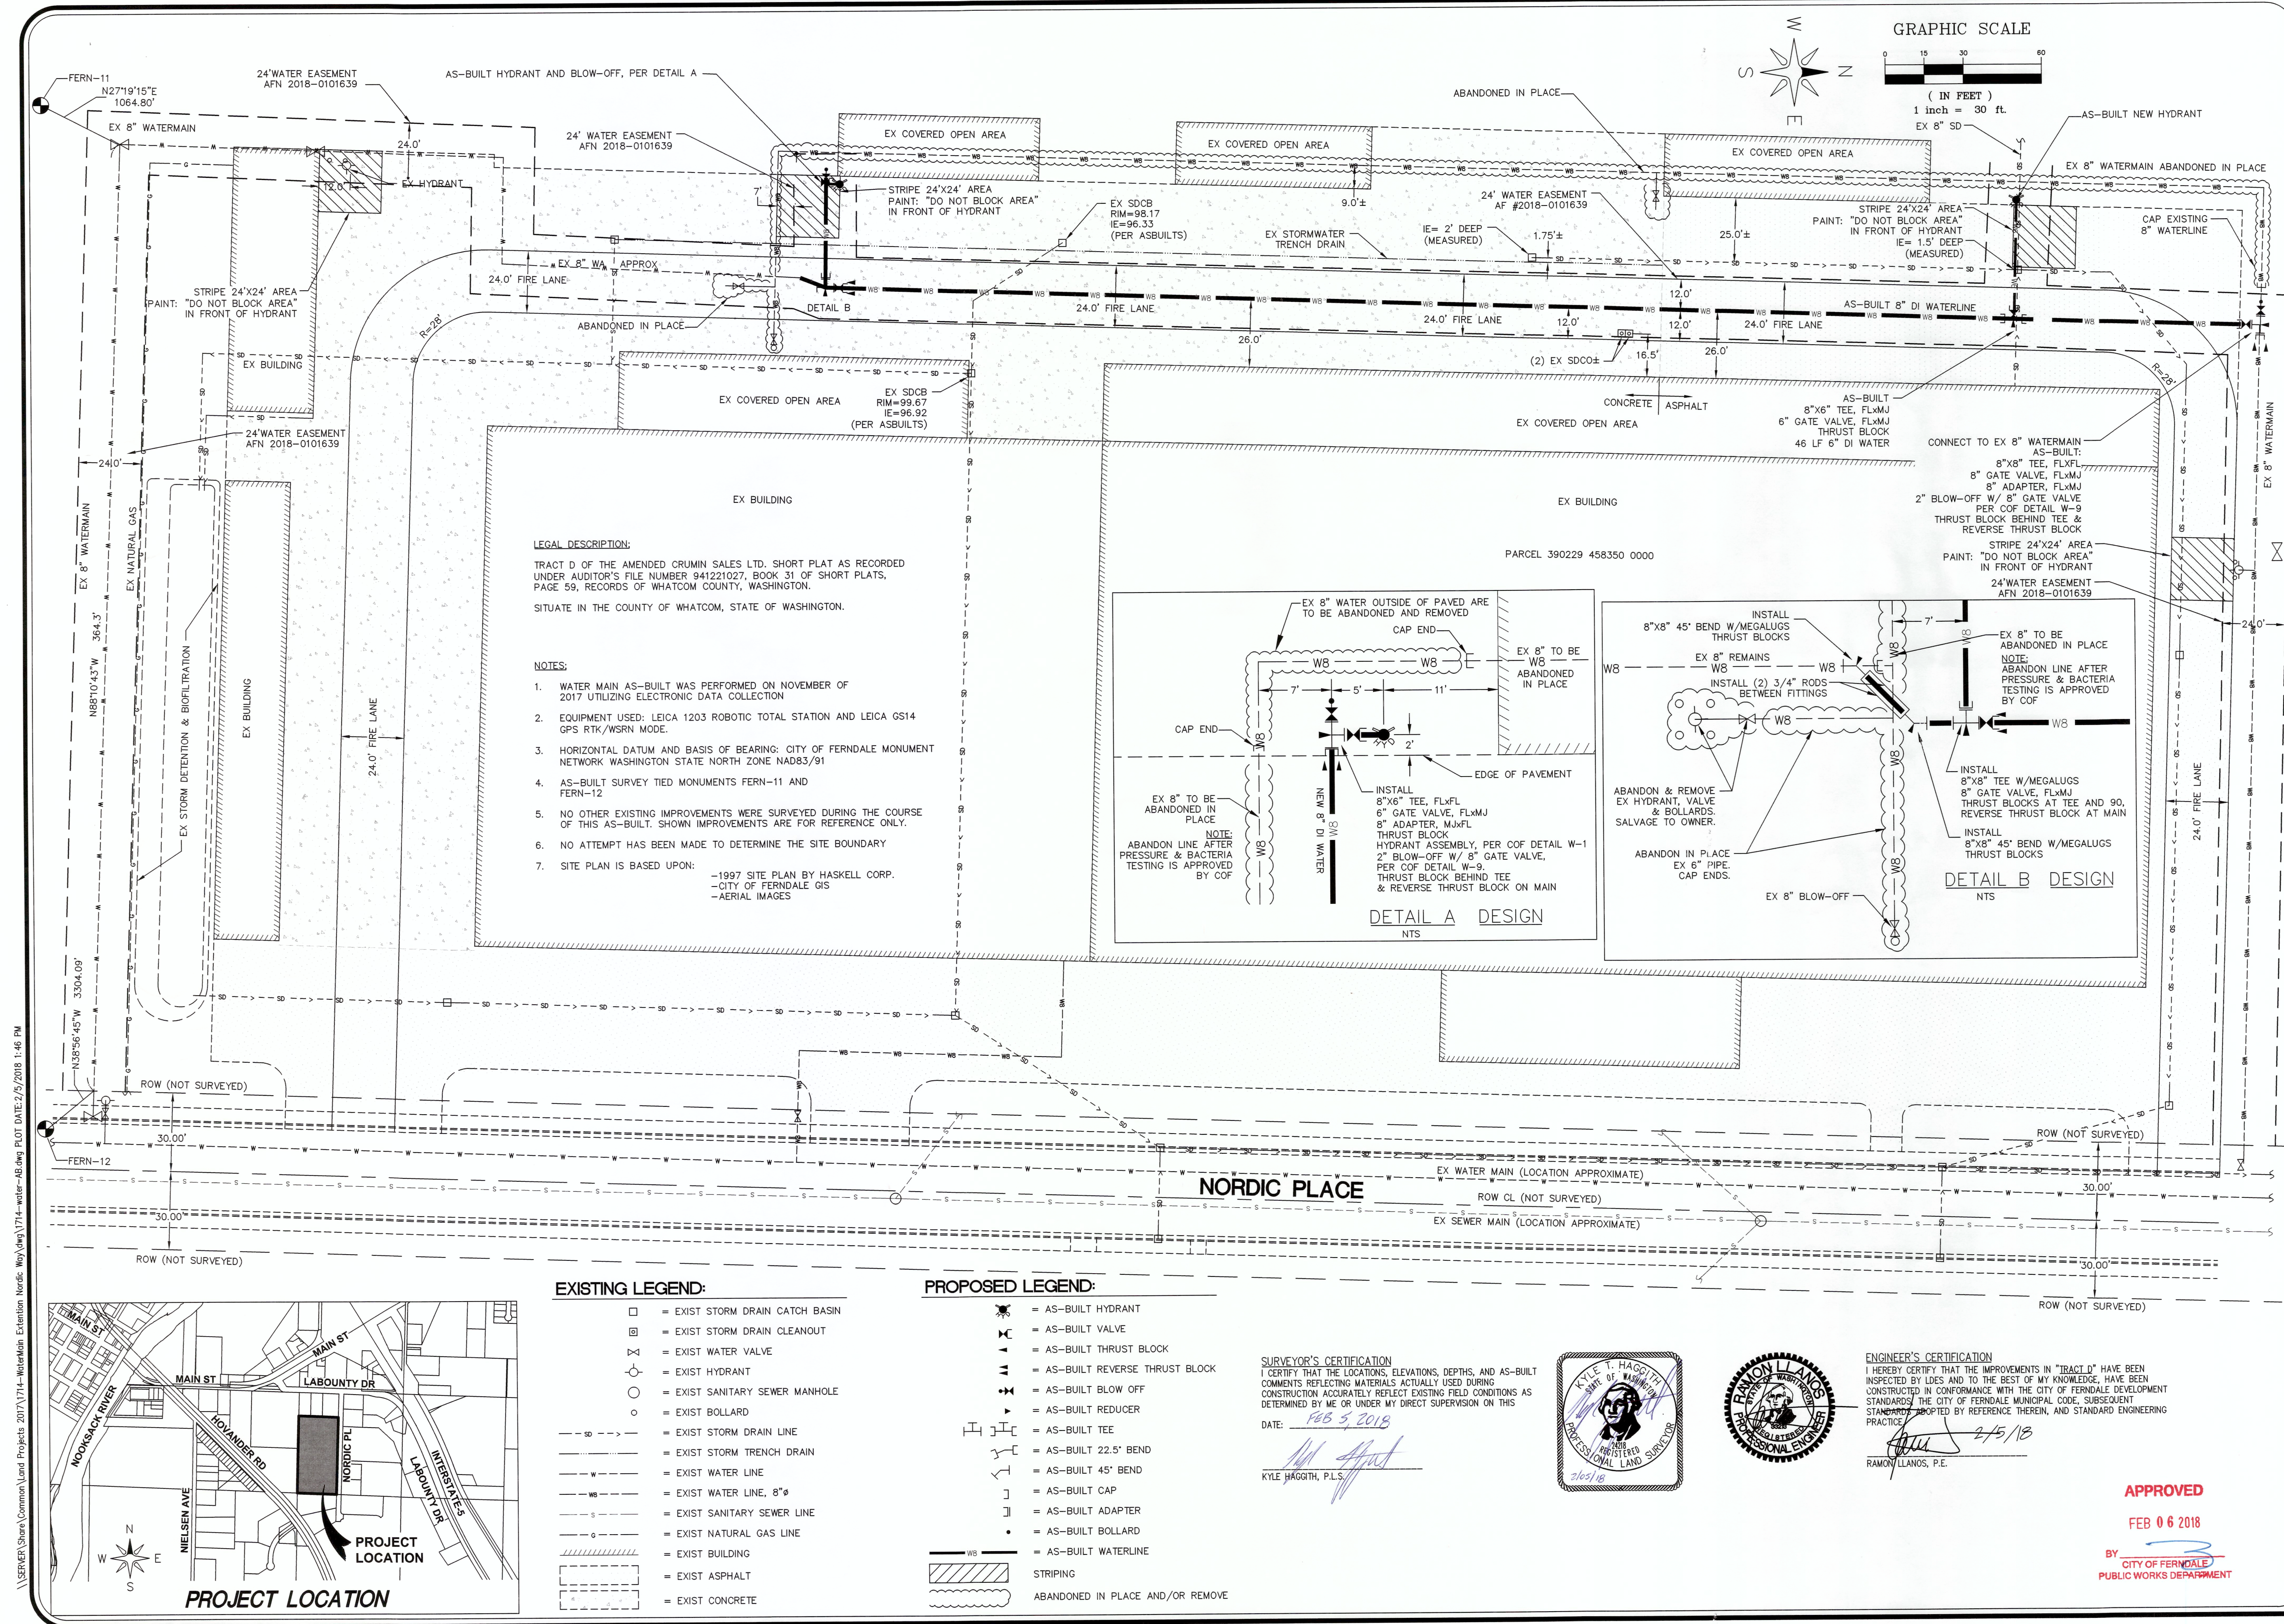

LDES, INC.
5160 INDUSTRIAL PL. #108
FERDALE, WA 98248
PHONE 360-383-0620
FAX 360-383-0639



JOB NO.: 1714
DWG. NAME: 1714-Water-AB.dwg
DESIGNED BY: RL
DRAWN BY: EH
CHECKED BY: RL

METRIE, INC
5575 NORDIC PLACE
FERDALE, WA 98248

FIRE LINE RELOCATION

CITY OF FERDALE, WHATCOM COUNTY, WASHINGTON
A PORTION OF THE NE 1/4 OF SECTION 29, TOWNSHIP 39 N, RANGE 2 E OF THE W.M.

AS-BUILT	2/1/18

NO. REVISION DATE

PROPOSED IMPROVEMENTS

SHEET

01

OF 01

AS-BUILT DRAWING

SURVEYOR'S CERTIFICATION
I CERTIFY THAT THE LOCATIONS, ELEVATIONS, DEPTHS, AND AS-BUILT COMMENTS REFLECTING MATERIALS ACTUALLY USED DURING CONSTRUCTION ACCURATELY REFLECT EXISTING FIELD CONDITIONS AS DETERMINED BY ME OR UNDER MY DIRECT SUPERVISION ON THIS DATE: FEB 5, 2018
KYLE HAGGITH, P.L.S.



ENGINEER'S CERTIFICATION
I HEREBY CERTIFY THAT THE IMPROVEMENTS IN "TRACT D" HAVE BEEN INSPECTED BY LDES AND TO THE BEST OF MY KNOWLEDGE, HAVE BEEN CONSTRUCTED IN CONFORMANCE WITH THE CITY OF FERDALE DEVELOPMENT STANDARDS, THE CITY OF FERDALE MUNICIPAL CODE, SUBSEQUENT STANDARDS ADOPTED BY REFERENCE THEREIN, AND STANDARD ENGINEERING PRACTICE.
2/5/18
RAMON LLANOS, P.E.

APPROVED
FEB 06 2018
BY CITY OF FERDALE
PUBLIC WORKS DEPARTMENT